



Discover.

TO: All Plan Holders
FROM: City of St. Charles, MO
PROJECT: Zumbahl Friedens Pavement Rehabilitation
DATE: November 17th, 2016
SUBJECT: Bid No. 4219 Addendum No. 1
FEDERAL PROJECT NUMBER: STP-7302(653)
CITY PROJECT NUMBERS: 14STR10

This addendum forms a part of the Contract Documents for the Zumbahl Friedens Pavement Rehabilitation Project. Contractors are required to acknowledge the receipt of addenda by signing and including all addenda with each bid form.

FAILURE TO ACKNOWLEDGE RECEIPT OF ADDENDUM MAY SUBJECT BIDDER TO DISQUALIFICATION.

Notice to Bidders:

1. Due to constructability concerns, the luminaire and associated bracket arm and wiring are being eliminated from pole 4 at the Bogey Hills Plaza South intersection on Zumbahl Road. Plan sheets have been adjusted to reflect this change. Additionally, a new itemized bid form has been uploaded which eliminates these items. Please use it when submitting your bid.

Name and Title of Signer (Print or type)
Contractor / Bidder Signature
_____ (Signature of person authorized to sign)
Date Signed:

**Department of
Public Works**


Engineering Division

City of Saint Charles
200 North Second Street
Saint Charles, MO 63301
636.949.3237
www.stcharlescitymo.gov

End of Addendum No. 1

SUMMARY OF QUANTITIES

TOTAL SUMMARY OF QUANTITIES				
BASE BID CONSTRUCTION				
LINE NO.	ITEM NUMBER	ITEM DESCRIPTION	UNIT	QUANTITY
ROADWAY ITEMS				
1	202-20.10	REMOVAL OF IMPROVEMENTS	LS	1
2	304-05.04	TYPE 5 AGGREGATE FOR BASE (4 IN. THICK)	SY	8884.5
3	413-60.00	PCCP JOINT / CRACK SEALING	LF	10000
4	603-99.02	ADJUST WATER VALVE TO GRADE	EA	1
5	604-20.10	ADJUST MANHOLE TO GRADE	EA	3
6	604-20.20	ADJUSTING BASIN OR INLET	EA	5
7	604-99.02	REPLACE PRECAST INLET STONE	EA	4
8	608-30.06	6 IN. CONCRETE MEDIAN STRIP	SY	120.6
9	608-50.08	PAVED APPROACH, 8 IN.	SY	602.2
10	609-10.10	CONCRETE CURB, TYPE "S"	LF	99
11	609-20.11	INTERGRAL CURB (6 IN.), TYPE A	LF	2511
12	613-99.05	FULL DEPTH PAVEMENT REPAIR, 8" THICK	SY	4700
13	616-10.05	CONSTRUCTION SIGNS	SF	473
14	616-10.08	ADVANCED WARNING RAIL SYSTEM	EA	4
15	616-10.09	FLAG ASSEMBLY	EA	20
16	616-10.25	CHANNELIZER (TRIM LINE)	EA	200
17	616-10.30	TYPE III MOVEABLE BARRICADE	EA	8
18	616-10.40	FLASHING ARROW PANEL	EA	4
19	616-10.98	CHANGEABLE MESSAGE SIGN, CONTRACTOR FURNISHED / CONTRACTOR RETAINED	EA	2
20	618-10.00	MOBILIZATION	LS	1
21	622-30.10	DIAMOND GRINDING (CONCRETE PAVEMENT)	SY	76400
22	627-40.00	CONTRACTOR FURNISHED SURVEYING AND STAKING	LS	1
SIGNALS / LIGHTING / SIGNING / STRIPING ITEMS				
23	620-51.20	TYPE 2 PREFORMED MARKING TAPE (GROOVED), 24 IN., WHITE	LF	347
24	620-51.30	TYPE 2 PREFORMED MARKING TAPE (GROOVED), RIGHT ARROW	EA	1
25	620-51.30	TYPE 2 PREFORMED MARKING TAPE (GROOVED), LEFT ARROW	EA	1
26	620-51.31	TYPE 2 PREFORMED MARKING TAPE (GROOVED), STRAIGHT ARROW	EA	1
27	620-51.32	TYPE 2 PREFORMED MARKING TAPE (GROOVED), COMBINATION STRAIGHT-RIGHT ARROW	EA	2
28	620-51.39	TYPE 2 PREFORMED MARKING TAPE (GROOVED), 12 IN., WHITE, YIELD LINE TRIANGLES	EA	34
29	620-60.00C	4 IN. WHITE WATERBORNE PAVEMENT MARKING PAINT, TYPE P BEADS	LF	8000
30	620-60.01C	4 IN. YELLOW WATERBORNE PAVEMENT MARKING PAINT, TYPE P BEADS	LF	28640
31	620-61.24	24 IN. WHITE WATERBORNE PAVEMENT MARKING PAINT, TYPE P BEADS	LF	1695
32	620-99.05	7 IN. CONTRAST WATERBORNE PAVEMENT MARKING PAINT, TYPE P BEADS (4 IN. WHITE ON BLACK)	LF	7160
33				
34				
35	902-27.08	POST, SIGNAL 8 FT. OR 2.4 M	EA	2
36	902-49.20	DETECTOR, PUSHBUTTON	EA	16
37	902-49.75	VEHICLE VIDEO DETECTION SYSTEM (NON-REIMBURSEABLE PAY ITEM)	EA	5
38	902-53.00	CONDUIT, 3 IN., TRENCH	LF	57
39	902-73.00	CONDUIT, 3 IN., PUSHED	LF	50
40				
41	902-83.08	CABLE, 16 AWG 2 CONDUCTOR	LF	1710
42	902-83.10	CABLE, 16 AWG 5 CONDUCTOR	LF	820
43	902-91.00	BASE, CONCRETE	CY	2.6
44	902-99.02	POST, SIGNAL 5 FT.	EA	4
45	902-99.02	SIGNAL HEAD, PEDESTRIAN (RELOCATE)	EA	4
46	902-99.02	DETECTOR, PUSHBUTTON (RELOCATE)	EA	3
47	903-50.68	SIGNAL SIGN, TYPE SHR2L-1	SF	16
BICYCLE / PEDESTRIAN FACILITIES ITEMS				
48	608-10.12	TRUNCATED DOME	SF	526
49	608-60.04	CONCRETE SIDEWALK (4" THICK)	SY	3655.0
50	608-99.02	CONCRETE CURB RAMP	EA	42
51	622-99.03	SIDEWALK GRINDING	LF	400.0
52	803-99.05A	SODDING	SY	333.0

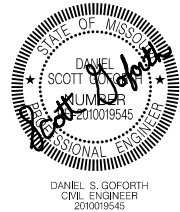


DATE PREPARED	
8/2016	
ROUTE	STATE
.	MO
DISTRICT	SHEET NO.
.	2
COUNTY	
ST. LOUIS	
JOB NO.	
STP-7302(653)	
PROJECT NAME	
ZUMBEHL RD	
SHEET NAME	
.	

SHEET	
1	OF 6
DISCLAIMER: THE PROFESSIONAL WHOSE SIGNATURE AND PERSONAL SEAL APPEAR HEREON ASSUMES RESPONSIBILITY ONLY FOR WHAT APPEARS ON THIS PAGE AND DISCLAIMS (PURSUANT TO SECTION 327.411 RSMO) SPECIFICATION, ESTIMATES, REPORTS OR OTHER DOCUMENTS OR INSTRUMENTS NOT SEALED BY THE UNDERSIGNED PROFESSIONAL, RELATING TO OR INTENDED TO BE USED FOR ANY PART OR PARTS OF THE PROJECT TO WHICH THIS PAGE REFERS.	

DESCRIPTION	DATE					
REMOVE LUMINAIRE	11/17/16	.	.	.	.	.



SAINT CHARLES
MISSOURI

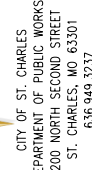

CITY OF ST. CHARLES
DEPARTMENT OF PUBLIC WORKS
200 NORTH SECOND STREET
ST. CHARLES, MO 63301
636.949.3237

ST. CHARLES OFFICE
400 N. 5TH STREET, SUITE 101
ST. CHARLES, MISSOURI 63301
TEL (636) 724-8300
FAX (636) 724-8304
stlouis@twm-inc.com




THOUVENOT,
WADE &
MOERCHEN, INC.
ENGINEERS ♦ SURVEYORS ♦ PLANNERS

PROFESSIONAL REGISTRATIONS LICENSE NO.
MISSOURI PROFESSIONAL ENGR. CORP. NO. 000528
MISSOURI LAND SURVEYING CORP. NO. 000346

FOR INFORMATIONAL PURPOSES ONLY

PROJECT A - SUMMARY OF QUANTITIES				
BASE BID CONSTRUCTION				
LINE NO.	ITEM NUMBER	ITEM DESCRIPTION	UNIT	QUANTITY
ROADWAY ITEMS				
1	202-20.10	REMOVAL OF IMPROVEMENTS	LS	1
2	304-05.04	TYPE 5 AGGREGATE FOR BASE (4 IN. THICK)	SY	8460.5
3	413-60.00	PCCP JOINT / CRACK SEALING	LF	10000
4	603-99.02	ADJUST WATER VALVE TO GRADE	EA	1
5	604-20.10	ADJUST MANHOLE TO GRADE	EA	3
6	604-20.20	ADJUSTING BASIN OR INLET	EA	2
7	604-99.02	REPLACE PRECAST INLET STONE	EA	4
8	608-30.06	6 IN. CONCRETE MEDIAN STRIP	SY	101.2
9	608-50.08	PAVED APPROACH, 8 IN.	SY	602.2
11	609-20.11	INTERGRAL CURB (6 IN.), TYPE A	LF	2511
12	613-99.05	FULL DEPTH PAVEMENT REPAIR, 8" THICK	SY	4590.6
13	616-10.05	CONSTRUCTION SIGNS	SF	473
14	616-10.08	ADVANCED WARNING RAIL SYSTEM	EA	4
15	616-10.09	FLAG ASSEMBLY	EA	20
16	616-10.25	CHANNELIZER (TRIM LINE)	EA	200
17	616-10.30	TYPE III MOVEABLE BARRICADE	EA	8
18	616-10.40	FLASHING ARROW PANEL	EA	4
19	616-10.98	CHANGEABLE MESSAGE SIGN, CONTRACTOR FURNISHED / CONTRACTOR RETAINED	EA	2
20	618-10.00	MOBILIZATION	LS	1
21	622-30.10	DIAMOND GRINDING (CONCRETE PAVEMENT)	SY	76400
22	627-40.00	CONTRACTOR FURNISHED SURVEYING AND STAKING	LS	1
SIGNALS / LIGHTING / SIGNING / STRIPING ITEMS				
23	620-51.20	TYPE 2 PREFORMED MARKING TAPE (GROOVED), 24" WHITE	LF	289
24	620-51.30	TYPE 2 PREFORMED MARKING TAPE (GROOVED), RIGHT ARROW	EA	1
25	620-51.30	TYPE 2 PREFORMED MARKING TAPE (GROOVED), LEFT ARROW	EA	1
26	620-51.31	TYPE 2 PREFORMED MARKING TAPE (GROOVED), STRAIGHT ARROW	EA	1
27	620-51.32	TYPE 2 PREFORMED MARKING TAPE (GROOVED), COMBINATION STRAIGHT-RIGHT ARROW	EA	2
29	620-60.00C	4 IN. WHITE WATERBORNE PAVEMENT MARKING PAINT, TYPE P BEADS	LF	8000
30	620-60.01C	4 IN. YELLOW WATERBORNE PAVEMENT MARKING PAINT, TYPE P BEADS	LF	28640
32	620-99.03	7 IN. CONTRAST WATERBORNE PAVEMENT MARKING PAINT, TYPE P BEADS (4 IN. WHITE ON BLACK)	LF	7160
BICYCLE / PEDESTRIAN FACILITIES ITEMS				
48	608-10.12	TRUNCATED DOMES	SF	190
49	608-60.04	CONCRETE SIDEWALK (4" THICK)	SY	3564.1
50	608-99.02	CONCRETE CURB RAMP	EA	29
51	622-99.03	SIDEWALK GRINDING	LF	400
52	803-99.05A	SODDING	SY	200.0


PROJECT B - SUMMARY OF QUANTITIES				
BASE BID CONSTRUCTION				
LINE NO.	ITEM NUMBER	ITEM DESCRIPTION	UNIT	QUANTITY
ROADWAY ITEMS				
1	202-20.10	REMOVAL OF IMPROVEMENTS	LS	1
2	304-05.04	TYPE 5 AGGREGATE FOR BASE (4 IN. THICK)	SY	424.0
6	604-20.20	ADJUSTING BASIN OR INLET	EA	3
8	608-30.06	6 IN. CONCRETE MEDIAN STRIP	SY	19.4
10	609-10.10	CONCRETE CURB, TYPE "S"	LF	99
12	613-99.05	FULL DEPTH PAVEMENT REPAIR, 8" THICK	SY	109.4
20	618-10.00	MOBILIZATION	LS	1
22	627-40.00	CONTRACTOR FURNISHED SURVEYING AND STAKING	LS	1
SIGNALS / LIGHTING / SIGNING / STRIPING ITEMS				
23	620-51.20	TYPE 2 PREFORMED MARKING TAPE (GROOVED), 24 IN., WHITE	LF	58
28	620-51.39	TYPE 2 PREFORMED MARKING TAPE (GROOVED), 12 IN., WHITE, YIELD LINE TRIANGLES	EA	34
31	620-51.24	24 IN. WHITE WATERBORNE PAVEMENT MARKING PAINT, TYPE P BEADS	LF	1695
33				
34				
35	902-27.08	POST, SIGNAL 8 FT. OR 2.4 M	EA	2
36	902-49.20	DETECTOR, PUSHBUTTON	EA	16
37	902-49.75	VEHICLE VIDEO DETECTION SYSTEM (NON-REIMBURSEABLE PAY ITEM)	EA	5
38	902-53.00	CONDUIT, 3 IN., TRENCH	LF	57
39	902-73.00	CONDUIT, 3 IN., PUSHED	LF	50
40				
41	902-83.08	CABLE, 16 AWG 2 CONDUCTOR	LF	1710
42	902-83.10	CABLE, 16 AWG 5 CONDUCTOR	LF	820
43	902-91.00	BASE, CONCRETE	CY	2.6
44	902-99.02	POST, SIGNAL 5 FT.	EA	4
45	902-99.02	SIGNAL HEAD, PEDESTRIAN (RELOCATE)	EA	4
46	902-99.02	DETECTOR, PUSHBUTTON (RELOCATE)	EA	3
47	903-50.68	SIGNAL SIGN, TYPE SHR2L-1	SF	16
BICYCLE / PEDESTRIAN FACILITIES ITEMS				
48	608-10.12	TRUNCATED DOMES	SF	336.0
49	608-60.04	CONCRETE SIDEWALK (4" THICK)	SY	90.9
50	608-99.02	CONCRETE CURB RAMP	EA	13
52	803-99.05A	SODDING	SY	133.0

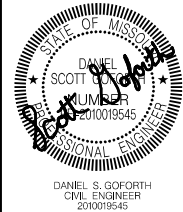

DATE PREPARED 8/2016	
ROUTE	STATE MO
DISTRICT	SHEET NO. 2
COUNTY ST. LOUIS	
JOB NO. STP-7302 (653)	
PROJECT NAME ZUMBEHL RD	
SHEET NAME	
SHEET 2 OF 6	

DISCLAIMER: THE PROFESSIONAL WHOSE SIGNATURE AND PERSONAL SEAL APPEAR HEREON ASSUMES RESPONSIBILITY ONLY FOR WHAT APPEARS ON THIS PAGE AND DISCLAIMS (PURSUANT TO SECTION 327.411 RSMO) SPECIFICATION, ESTIMATES, REPORTS OR OTHER DOCUMENTS OR INSTRUMENTS NOT SEALED BY THE UNDERSIGNED PROFESSIONAL, RELATING TO OR INTENDED TO BE USED FOR ANY PART OR PARTS OF THE PROJECT TO WHICH THIS PAGE REFERS.


DATE	DESCRIPTION								
11/17/16	REMOVE LUMINAIRE								

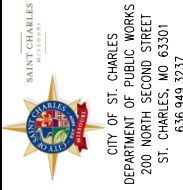

ST. CHARLES OFFICE
400 N. 5TH STREET, SUITE 101
ST. CHARLES, MISSOURI 63301
TEL (636) 724-8300
FAX (636) 724-8304
stlouisc@twm-inc.com

PROFESSIONAL REGISTRATIONS LICENSE NO.
MISSOURI PROFESSIONAL ENGR. CORP. NC 000528
MISSOURI LAND SURVEYING CORP. NC 000346




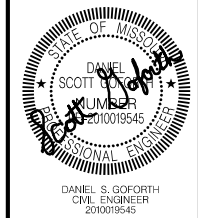

DATE PREPARED 8/2016	
ROUTE	STATE MO
DISTRICT	SHEET NO. 1:1
COUNTY ST. LOUIS	
JOB NO. STP-7302(653)	
PROJECT NAME ZUMBEHL RD	
SHEET NAME SG	
SHEET 2 OF 5	

DISCLAIMER:
THE PROFESSIONAL WHOSE
SIGNATURE AND PERSONAL
SEAL APPEAR HEREON
ASSUMES RESPONSIBILITY
ONLY FOR WHAT APPEARS
ON THIS PAGE AND
DISCLAIMS (PURSUANT TO
SECTION 327.411 RSMO)
SPECIFICATION, ESTIMATES,
REPORTS OR OTHER
DOCUMENTS OR
INSTRUMENTS NOT SEALED
BY THE UNDERSIGNED
PROFESSIONAL RELATING TO
OR INTENDED TO BE USED
FOR ANY PART OR PARTS
OF THE PROJECT TO
WHICH THIS PAGE REFERS.

DESCRIPTION	DATE
REMOVE LUMINAIRE	11/17/16

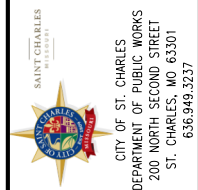


ST. CHARLES OFFICE
400 N. 5TH STREET, SUITE 101
ST. CHARLES, MISSOURI 63301
TEL (636) 724-8300
FAX (636) 724-8304
stlouisc@twm-inc.com


THOUVENOT, WADE & MOERCHEN, INC.
ENGINEERS • SURVEYORS • PLANNERS

ST. CHARLES OFFICE
400 N. 5TH STREET, SUITE 101
ST. CHARLES, MISSOURI 63301
TEL (636) 724-8300
FAX (636) 724-8304
stlouisc@twm-inc.com


THOUVENOT, WADE & MOERCHEN, INC.
ENGINEERS • SURVEYORS • PLANNERS

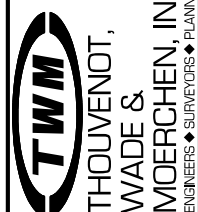

REV.

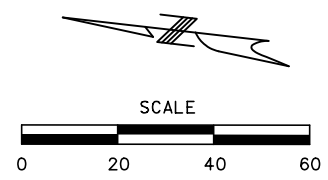

- SIGNAL PLAN NOTES:**
- (1) SEE SIGNAL PLAN SHEET 1 FOR TRAFFIC SIGNAL LEGEND & GENERAL NOTES.
- (2) UTILIZE EXISTING PEDESTRIAN SIGNAL HEADS FROM THE INTERSECTION OF REGENCY PARKWAY & ZUMBEHL ROAD. (SEE SIGNAL PLAN SHEET 3) REMOVE PEDESTRIAN SIGNAL HEADS FROM THE EAST-WEST X-ING ON THE NORTH SIDE OF THE INTERSECTION & RELOCATE TO SIGNAL POSTS 5 & 6 AT BOGEY HILLS PLAZA SOUTH INTERSECTION, AS SHOWN.

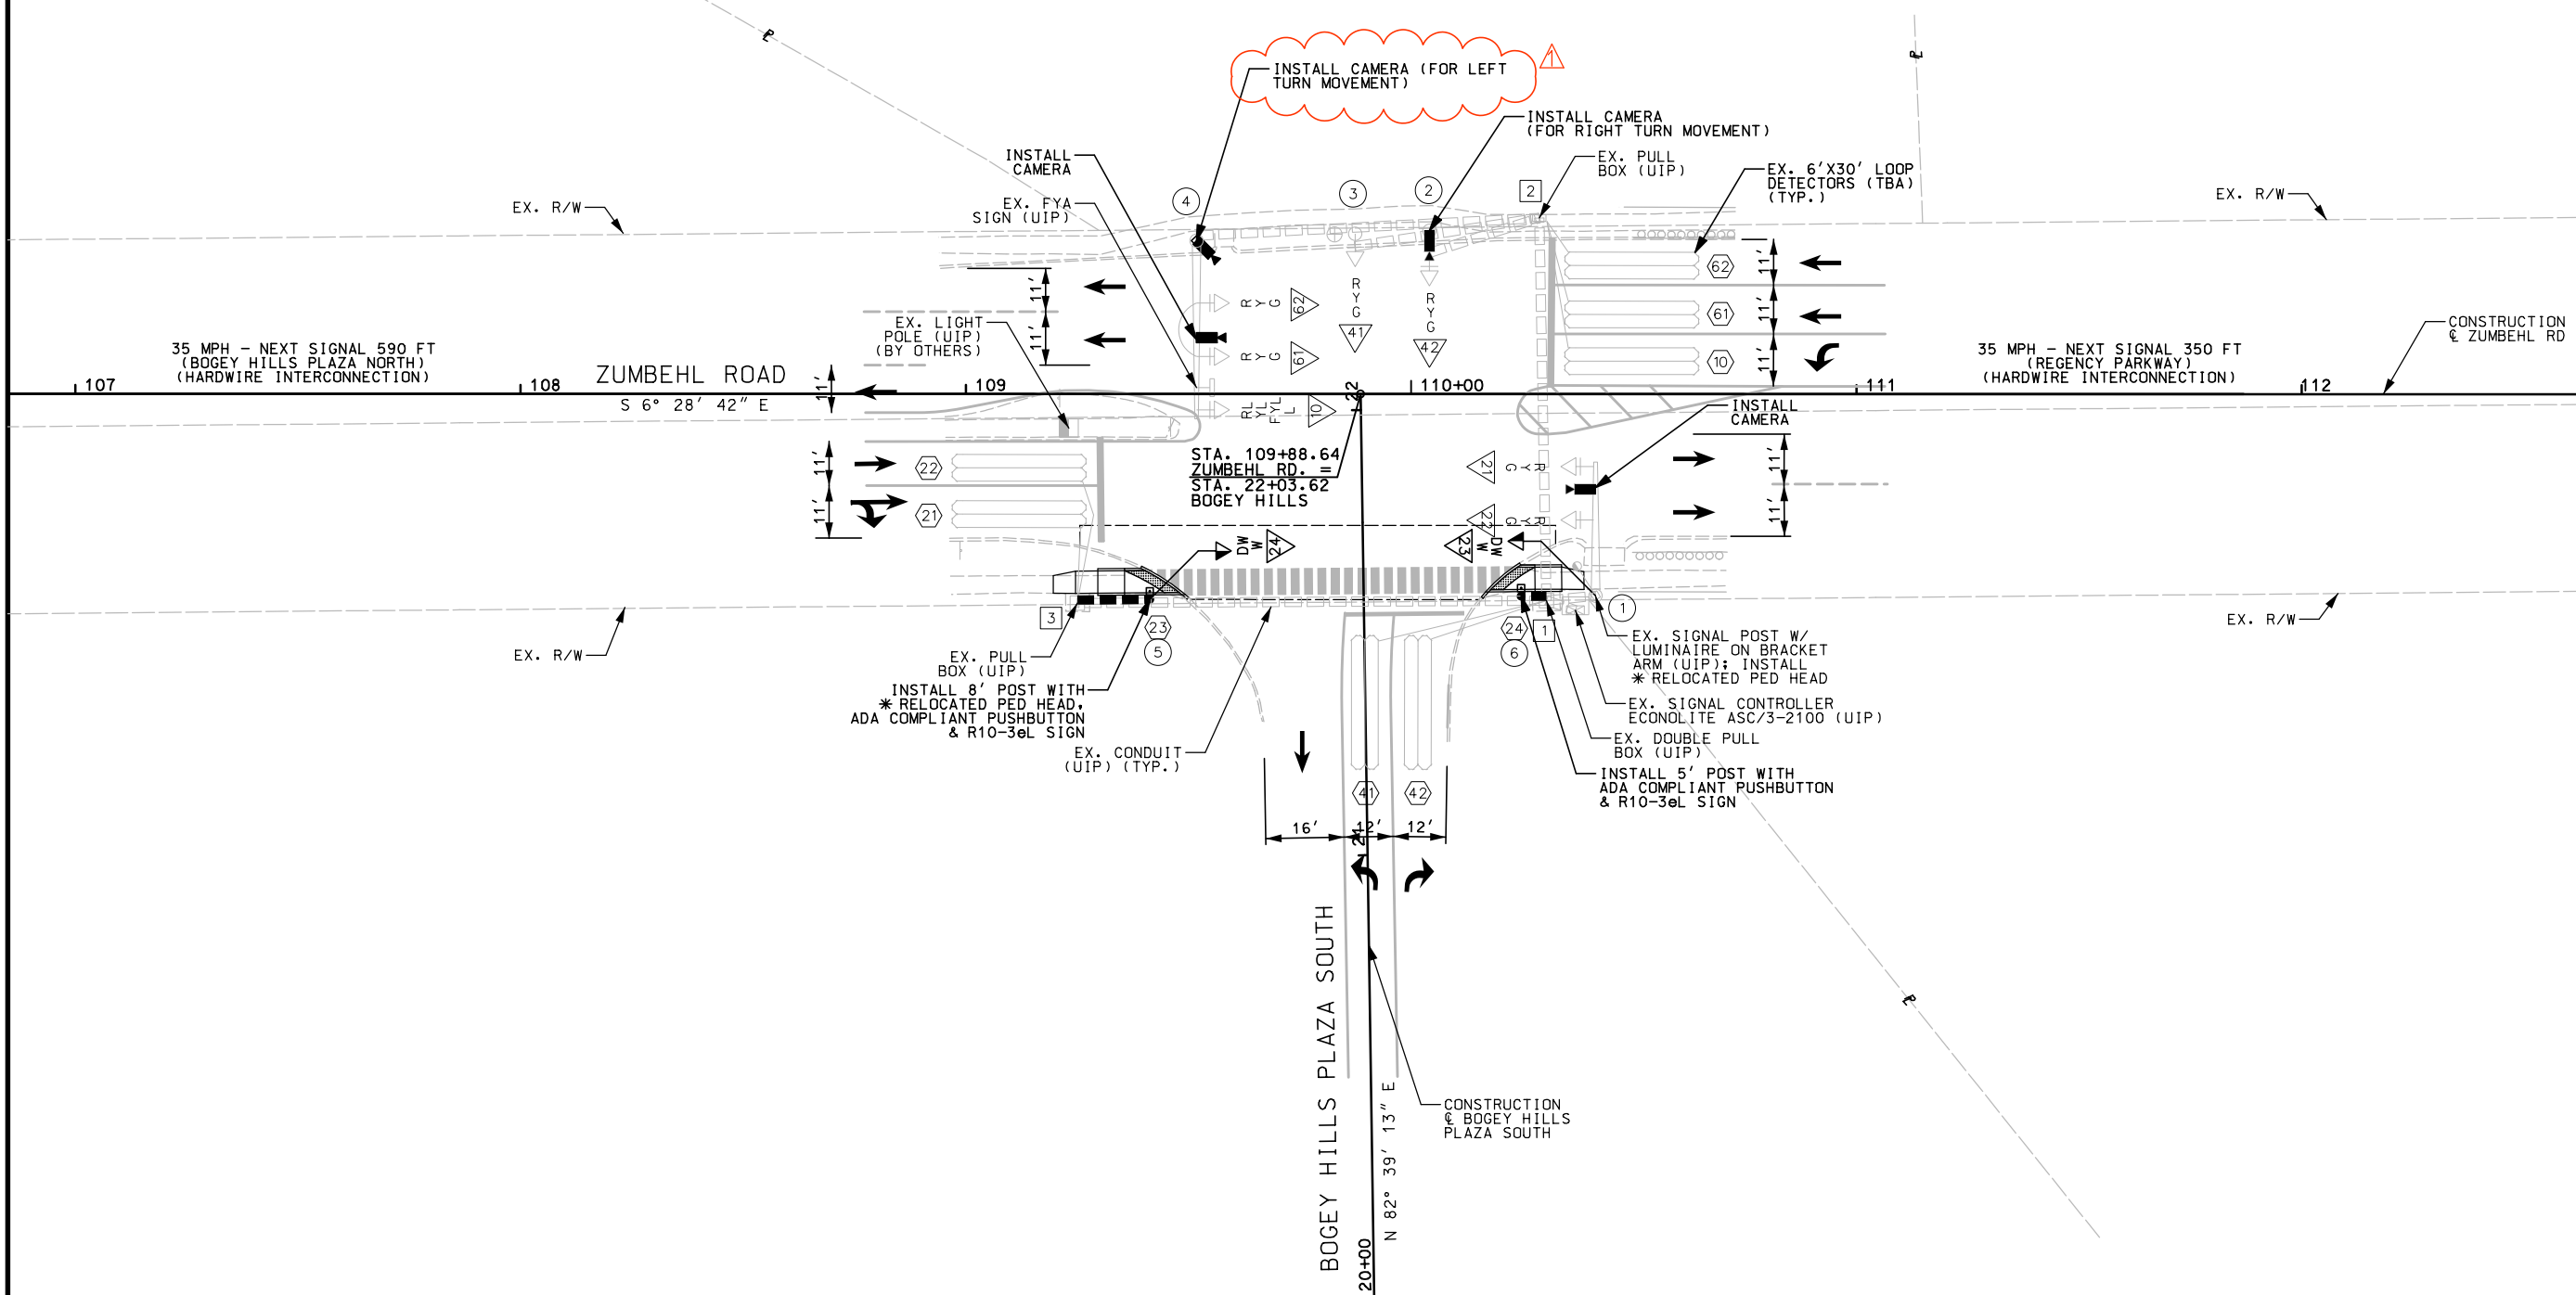


POST NUMBER	PULL BOX NUMBER	LOCATION			BASE										PULL BOX					POST																																																																																																																																																																																																																																																																																																																																																																																																																																																																																																																																																																																																																																																																																																																																																																																																																																																																																																																																																																																																																																																																																																																																																																																													
		APPROACH	STATION	OFFSET	A				F				C	CONCRETE ** (CU. YDS.)	PREFORM		CONC.	DRAIN TYPE *	TOP MOUNT	POST	TYPE C & CL									TYPE B & BL												INCLUDED ANGLE	LUMINAIRE BRACKET ARM																																																																																																																																																																																																																																																																																																																																																																																																																																																																																																																																																																																																																																																																																																																																																																																																																																																																																																																																																																																																																																																																																																																																																																						
					9	9.5	10	10.5	11	12	9	9.5			10	10.5					11	12	CLASS 1	CLASS 2	CLASS 3	CLASS 5	STANDARD	DOUBLE, TYPE A	DOUBLE, TYPE B	ARM LENGTH	SIGNAL SPACING	SIGN SPACING	ARM LENGTH	LEFT ARM E				RIGHT ARM K					4 FT.	6 FT.	8 FT.	10 FT.	12 FT.	15 FT.																																																																																																																																																																																																																																																																																																																																																																																																																																																																																																																																																																																																																																																																																																																																																																																																																																																																																																																																																																																																																																																																																																																																																																	
																																		SIGNAL SPACING	SIGN SPACING	SIGNAL SPACING	SIGN SPACING	L	M	N	N'								L	M	N	N'																																																																																																																																																																																																																																																																																																																																																																																																																																																																																																																																																																																																																																																																																																																																																																																																																																																																																																																																																																																																																																																																																																																																																													
																																																					I	II	A	B	C	D	D'	E	K	E	K	E	K	F	G	H	H'	F	G	H	H'	L	M	N	N'	L	M	N	N'																																																																																																																																																																																																																																																																																																																																																																																																																																																																																																																																																																																																																																																																																																																																																																																																																																																																																																																																																																																																																																																																																																																																
																																																																																		A	B	C	D	D'	E	K	E	K	E	K	F	G	H	H'	L	M	N	N'	L	M	N	N'																																																																																																																																																																																																																																																																																																																																																																																																																																																																																																																																																																																																																																																																																																																																																																																																																																																																																																																																																																																																																																																																																																									
ZUMBEHL ROAD & BOGEY HILLS PLAZA SOUTH INTERSECTION																																																																																																																																																																																																																																																																																																																																																																																																																																																																																																																																																																																																																																																																																																																																																																																																																																																																																																																																																																																																																																																																																																																																																																																																																	
5			109+41.31	46.15' RT.																																																																																																																																																																																																																																																																																																																																																																																																																																																																																																																																																																																																																																																																																																																																																																																																																																																																																																																																																																																																																																																																																																																																																																																																													

NOT TO SCALE

WIRING DIAGRAM

* ALL DASHED SIGNAL EQUIPMENT TO BE REMOVED.

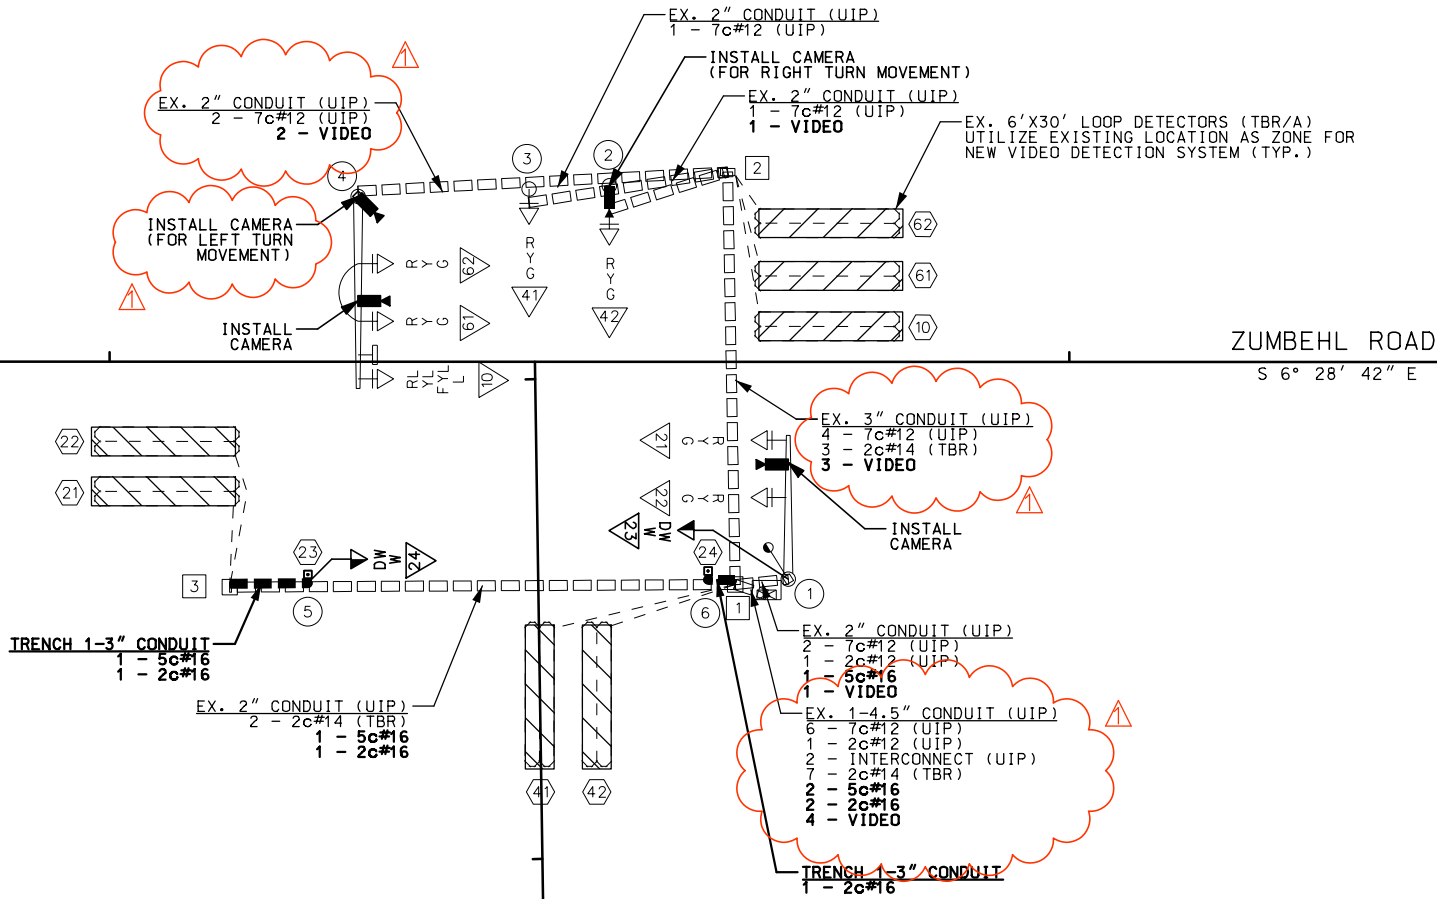


WIRING DIAGRAM NOTES:

- (1) SEE SIGNAL PLAN SHEET 1 FOR TRAFFIC SIGNAL GENERAL NOTES.
(2) AS-BUILTS NOT AVAILABLE FOR INTERSECTION; INFORMATION PROVIDED WAS BASED ON FIELD INSPECTION AND MAY NOT REPRESENT ACTUAL FIELD CONDITIONS. CONTRACTOR SHALL VERIFY INFORMATION PRIOR TO BEGINNING ANY WORK.

LEGEND

- EXISTING CONTROLLER
- POWER SUPPLY
- EXISTING SIGNAL HEAD
- PEDESTRIAN HEAD
- VIDEO DETECTOR
- EXISTING VIDEO DETECTOR
- PUSH BUTTON DETECTOR
- EXISTING PULL BOX
- EXISTING JUMPER CABLE
- CONDUIT (PUSHED OR TRENCHED)
- EXISTING CONDUIT (UIP)
- VIDEO DETECTION ZONE
- EXISTING VIDEO DETECTION ZONE
- 30 X 6 LOOP DETECTOR
- EXISTING LUMINAIRE
- EXISTING MAST ARM
- EXISTING TOP MOUNT POST
- 5' PUSHBUTTON POST
- PULL BOX NUMBER
- POST NUMBER
- SIGN HEAD PHASE
- DETECTOR PHASE

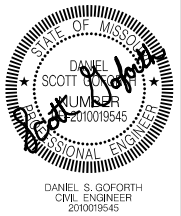

DATE PREPARED 8/2016	
ROUTE	STATE MO
DISTRICT	SHEET NO. 1-8
COUNTY ST. LOUIS	
JOB NO. STP-7302(653)	
PROJECT NAME ZUMBEHL RD	
SHEET NAME WD	
SHEET 2 OF 5	

DISCLAIMER:
THE PROFESSIONAL WHOSE
SIGNATURE AND PERSONAL
SEAL APPEAR HEREON
ASSUMES RESPONSIBILITY
ONLY FOR WHAT APPEARS
ON THIS PAGE AND
DISCLAIMS (PURSUANT TO
SECTION 327.411 RSMO)
SPECIFICATION, ESTIMATES,
REPORTS OR OTHER
DOCUMENTS OR
INSTRUMENTS NOT SEALED
BY THE UNDERSIGNED
PROFESSIONAL RELATING TO
OR INTENDED TO BE USED
FOR ANY PART OR PARTS
OF THE PROJECT TO WHICH
THIS PAGE REFERS.

DATE	DESCRIPTION
11/17/16	REMOVE LUMINAIRE



ST. CHARLES OFFICE
400 N. 5TH STREET, SUITE 101
ST. CHARLES, MISSOURI 63301
TEL (636) 724-8300
FAX (636) 724-8304
stlouisc@twn-inc.com

PROFESSIONAL REGISTRATIONS LICENSE NO.
MISSOURI PROFESSIONAL ENGR. CORP. NO. 000528
MISSOURI LAND SURVEYING CORP. NO. 000346



ZUMBEHL ROAD & BOGEY HILLS PLAZA SOUTH
INTERSECTION

D-37D

ZUMBEHL FRIEDENS PAVEMENT REHABILITATION PROJECT

ITEMIZED BID: The bidder should complete the following section in accordance with Sec 102.7. The bidder proposes to furnish all labor, materials, equipment, services, etc. required for the performance and completion of the work, as follows:

ITEMIZED BID FORM

ITEM NO.	DESCRIPTION	QUANTITY (REIMB.)	QUANTITY (NON-REIMB.)	TOTAL QUANTITY	UNIT	UNIT PRICE	UNIT PRICE WRITTEN IN WORDS	TOTAL COST
	ROADWAY ITEMS							
202-20.10	REMOVAL OF IMPROVEMENTS	1	-	1	LS			
304-05.04	TYPE 5 AGGREGATE FOR BASE (4 IN. THICK)	8884.4	-	8884.4	SY			
413-60.00	PCCP JOINT / CRACK SEALING	10000	-	10000	LF			
603-99.02	ADJUST WATER VALVE TO GRADE	1	-	1	EA			
604-20.10	ADJUST MANHOLE TO GRADE	3	-	3	EA			
604-20.20	ADJUSTING BASIN OR INLET	5	-	5	EA			
604-99.02	REPLACE PRECAST INLET STONE	4	-	4	EA			
608-30.06	6 IN. CONCRETE MEDIAN STRIP	120.6	-	120.6	SY			
608-50.08	PAVED APPROACH, 8 IN.	602.2	-	602.2	SY			
609-10.10	CONCRETE CURB, TYPE "S"	99	-	99	LF			
609-20.11	INTEGRAL CURB (6 IN.) TYPE A	2511	-	2511	LF			
613-99.05	FULL DEPTH PAVEMENT REPAIR, 8 IN.	4700	-	4700	SY			
616-10.05	CONSTRUCTION SIGNS	473	-	473	SF			
616-10.08	ADVANCED WARNING RAIL SYSTEM	4	-	4	EA			
616-10.09	FLAG ASSEMBLY	20	-	20	EA			
616-10.25	CHANNELIZER (TRIM LINE)	200	-	200	EA			
616-10.30	TYPE III MOVEABLE BARRICADE	8	-	8	EA			
616-10.40	FLASHING ARROW PANEL	4	-	4	EA			
616-10.98	CHANGEABLE MESSAGE SIGN, CONTRACTOR FURNISHED/CONTRACTOR RETAINED	2	-	2	EA			
618-10.00	MOBILIZATION	1	-	1	LS			
622-30.10	DIAMOND GRINDING (CONCRETE PAVEMENT)	76400	-	76400	SY			
627-40.00	CONTRACTOR FURNISHED SURVEYING AND STAKING	1	-	1	LS			
	SUBTOTAL ROADWAY ITEMS							

	SIGNALS / LIGHTING / SIGNING / STRIPING ITEMS						
620-51.20	TYPE 2 PREFORMED MARKING TAPE (GROOVED), 24 IN., WHITE	347	-	347	LF		
620-51.30	TYPE 2 PREFORMED MARKING TAPE (GROOVED), RIGHT ARROW	1	-	1	EA		
620-51.30	TYPE 2 PREFORMED MARKING TAPE (GROOVED), LEFT ARROW	1	-	1	EA		
620-51.31	TYPE 2 PREFORMED MARKING TAPE (GROOVED), STRAIGHT ARROW	1	-	1	EA		
620-51.32	TYPE 2 PREFORMED MARKING TAPE (GROOVED), COMBINATION STRAIGHT-RIGHT ARROW	2	-	2	EA		
620-51.39	TYPE 2 PREFORMED MARKING TAPE (GROOVED), 12 IN., WHITE, YIELD LINE TRIANGLES	34	-	34	EA		
620-60.00C	4 IN. WHITE WATERBORNE PAVEMENT MARKING PAINT, TYPE P BEADS	8000	-	8000	LF		
620-60.01C	4 IN. YELLOW WATERBORNE PAVEMENT MARKING PAINT, TYPE P BEADS	7160	-	7160	LF		
620-61.24	24 IN. WHITE WATERBORNE PAVEMENT MARKING PAINT, TYPE P BEADS	1695	-	1695	LF		
620-99.03	6 IN. CONTRAST WATERBORNE PAVEMENT MARKING PAINT, TYPE P BEADS (4 IN. WHITE ON BLACK)	28640	-	28640	LF		
902-27.08	POST, SIGNAL 8 FT.	2	-	2	EA		
902-49.20	DETECTOR, PUSHBUTTON	16	-	16	EA		
902-49.75	VEHICLE VIDEO DETECTION SYSTEM	-	5	5	EA		
902-53.00	CONDUIT, 3 IN. TRENCH	57	-	57	LF		
902-73.00	CONDUIT, 3 IN. PUSHED	50	-	50	LF		
902-83.08	CABLE, 16 AWG 2 CONDUCTOR	1710	-	1710	LF		
902-83.10	CABLE, 16 AWG 5 CONDUCTOR	820	-	820	LF		
902-91.00	BASE, CONCRETE	3.0	-	3.0	CY		
902-99.02	POST, SIGNAL 5 FT.	4	-	4	EA		
902-99.02	SIGNAL HEAD, PEDESTRIAN (RELOCATE)	4	-	4	EA		
902-99.02	DETECTOR, PUSHBUTTON (RELOCATE)	3	-	3	EA		

903-50.68	SIGNAL SIGN, TYPE SHR2L-1	16	-	16	SF			
	SUBTOTAL SIGNALS / LIGHTING / SIGNING / STRIPING ITEMS							
	BICYCLE / PEDESTRIAN FACILITIES ITEMS							
608-10.12	TRUNCATED DOMES	526	-	526	SF			
608-60.04	CONCRETE SIDEWALK (4 IN. THICK)	3655	-	3655	SY			
608-99.02	CONCRETE CURB RAMP	42	-	42	EA			
622-99.03	SIDEWALK GRINDING	400	-	400	LF			
803-99.05A	SODDING	333	-	333	SY			
	SUBTOTAL BICYCLE / PEDESTRIAN FACILITIES ITEMS							
	TOTAL PRICE (BASE BID) (ADD ROADWAY ITEMS TOTAL, SIGNALS/LIGHTING/SIGNING/STRIPING ITEMS TOTAL, BICYCLE/PEDESTRIAN FACILITIES ITEMS TOTAL)							

COMPANY

PHONE NUMBER

ADDRESS

BY:

TITLE

DATE