

Charlie A. Dooley
County Executive

Saint Louis
COUNTY
HIGHWAYS & TRAFFIC
PUBLIC WORKS

Sheryl L. Hodges, D.E., P.E., L.P.G.
Director

October 21, 2014

ADDENDUM NO. 2

Notice to All Persons and Firms Proposing
to Submit a Bid or Furnish Materials for
Mason Road Bridge No. 211
St. Louis County Project No. AR-1133
Federal Project No. STP-5574(604)

The construction contract for this project has been revised as follows:

No. 1

Replace Special Provision No. 100.10.2 "Completion of Project" with the attached:

100.10.2 COMPLETION OF PROJECT

No. 2

Replace Special Provision No. 100.10.3 "Working Restrictions" with the attached:

100.10.3 WORKING RESTRICTIONS

No. 3

Replace Special Provision No. 100.80.4 "Project Assurances" with the attached:

100.80.4 PROJECT ASSURANCES

No. 4

Replace Special Provision No. 200.40.1 "Removal of Guardrail-Discard" with the attached:

200.40.2 REMOVAL OF GUARDRAIL-SALVAGE

No. 5

Replace Special Provision No. 700.40.5 "Modular Block Retaining Wall (Miscellaneous Requirements)" with the attached:

700.40.5 MODULAR BLOCK RETAINING WALL (MISCELLANEOUS REQUIREMENTS)

No. 6

Replace Special Provision No. 1000.10.2 "Internally Cured Concrete (ICC)" with the attached:

1000.10.2 INTERNALLY CURED CONCRETE (ICC)

No. 7

Replace Corrected Bid Document, "BID" pg. 306 of 345 as attached.

No. 8

Delete Plan Sheet Nos. 2, 3, 5, 6, 7, 8, 9, 29, 34, 37, 40, 41, 42, 43, 46, 47, 48, 50, 51, 52 & 57.

No. 9

Insert New Plan Sheet Nos. 2, 3, 5, 6, 7, 8, 9, 29, 34, 37, 40, 41, 42, 43, 46, 47, 48, 50, 51, 52 & 57.

No. 10

Insert New Plan Sheet No. 50A

REVISED ITEMIZED BID SHEET NOS. 331 OF 345 TO 337 OF 345 ARE ATTACHED AND REFLECT THE CHANGES NOTED IN ITEM NOS. 8, 9, AND 10 ABOVE. FAILURE TO SUBSTITUTE THE ITEMIZED BID SHEETS MAY RESULT IN REJECTION OF THE BID.

REVISED BID DOCUMENT, "BID", IS ATTACHED AND SHOWS THE CHANGES NOTED IN ITEM NO. 7 ABOVE. FAILURE TO SUBSTITUTE THIS BID DOCUMENT MAY RESULT IN REJECTION OF THE BID.

Addendum No. 2
October 21, 2014
Page 3

**ATTENTION BIDDERS: CHECK THE SECOND STATEMENT ON ADDENDUM
ACKNOWLEDGEMENT SHEET NO. 330 OF 345 OF THE BID DOCUMENTS AND
COMPLETE APPROPRIATELY.**



Daniel R. Naunheim, P.E.
Division Manager, Design

DRN/KJJ/jlh

*Attachments: Itemized Bid Sheets, Bid Document, Plan Sheets, Special Provisions and
Addendum Acknowledgement (**Please sign and return.**)*

October 21, 2014

ADDENDUM ACKNOWLEDGEMENT

ADDENDUM NO. 2

FROM: St. Louis County Department of Highways and Traffic

RE: Mason Road Bridge No. 211
St. Louis County Project No. AR-1133
Federal Project No. STP-5574(604)

**PACKAGE INCLUDES THIS ACKNOWLEDGEMENT AND
ADDENDUM NOTICE AND REVISED BID SHEET, BID
DOCUMENT, AND/OR OTHER ITEMS.**

(21 pages & 22 plan sheets total)

IF YOU DID NOT RECEIVE ALL PAGES, CALL (314) 615-8581.

**UPON RECEIPT OF THIS PACKAGE, PLEASE SIGN AND
DATE (IN THE INDICATED LOCATIONS BELOW), AND FAX
THIS ACKNOWLEDGEMENT TO THE DEPARTMENT OF
HIGHWAYS & TRAFFIC AT (314) 615-8194 (Attn: Karen Jones,
DESIGN DIVISION) TO VERIFY RECEIPT**

COMPANY _____

RECEIVED BY _____

DATE _____

100.10.2 COMPLETION OF PROJECT

- A. The work on this project shall commence on the date specified in the "Notice To Proceed" and completed no later than November 1, 2015 from said commencement date unless additional time is granted by the Director. Due to seasonal limitations, sodding and crack sealing may be completed after the dates shown on the schedule.

Liquidated damages in the amount of \$1,100 per day will be charged after the expiration of the time stipulated for each and every calendar day that all work remains uncompleted.

Liquidated damages in the amount of \$1,100 per day will be charged after the expiration of the ninety (90) calendar day road closure limitation of Mason Road (see JSP 100.10.3 part C).

- B. An additional \$200.00 per hour will be charged should temporary striping/markings not begin within the time limits specified in section 621.3.2 of the "St. Louis County Standard Specifications for Highway Construction".

100.10.2 COMPLETION OF PROJECT

- A. The work on this project shall commence on the date specified in the "Notice To Proceed" and completed no later than November 1, 2015 from said commencement date unless additional time is granted by the Director. Due to seasonal limitations, sodding and crack sealing may be completed after the dates shown on the schedule.

Liquidated damages in the amount of \$1,100 per day will be charged after the expiration of the time stipulated for each and every calendar day that all work remains uncompleted.

Liquidated damages in the amount of \$1,100 per day will be charged after the expiration of the ninety (90) calendar day road closure limitation of Mason Road (see JSP 100.10.3 part C).

- B. An additional \$200.00 per hour will be charged should temporary striping/markings not begin within the time limits specified in section 621.3.2 of the "St. Louis County Standard Specifications for Highway Construction".

100.10.3 WORKING RESTRICTIONS

- A. On each of the project sites, the Contractor shall confine his operations and restrict the storage of equipment and materials to the easement areas shown on the plans. The Contractor will not be permitted to operate equipment or store material on roadways or drives that are normally in use by the public.
- B. The Contractor shall use every precaution to prevent damage to private and public utility lines, conduits, and other improvements. The Contractor will be responsible for all damage to any utility or other such improvement due to his operations, and shall repair or replace as necessary any such damaged facility or make payment to the owner for repair or replacement. Trees and shrubs in the easement areas not specifically marked To Be Removed (TBR) shall be carefully preserved.
- C. The contractor shall limit the closure of Mason Road at the project location to ninety (90) calendar days.

Access During Work: The Contractor will ensure that Golf Club Investment Company ("GCI") will have reasonable access to and from Mason Road and to and from each of Parcel 5 and Parcel 7, including access to and from the house located on Parcel 5 and the maintenance facility located on Parcel 7, during all phases of work on the Mason Road Bridge Project. The County will take all reasonable steps to minimize disruption to Parcel 5 and Parcel 7 during work.

- D. No direct payment will be made for compliance with this provision.

100.80.4 PROJECT ASSURANCES

The following agreements will require the Contractor's compliance:

A. Location, Parcel No. 5 & 7:

Access During Work: The Contractor will ensure that Golf Club Investment Company ("GCI") will have reasonable access to and from Mason Road and to and from each of Parcel 5 and Parcel 7, including access to and from the house located on Parcel 5 and the maintenance facility located on Parcel 7, during all phases of work on the Mason Road Bridge Project. The Contractor will take all reasonable steps to minimize disruption to Parcel 5 and Parcel 7 during work.

B. General:

The Contractor will limit the closure of Mason Road at the project location to ninety (90) calendar days.

Timing of Work On Mason Road Bridge Project. The Contractor will ensure that all work performed on the Mason Road Bridge Project, including work performed by any of the County's agents and designees will be performed before December 15, 2015.

Removal of Construction Debris and Installation of Sidewalks: The Contractor shall remove all construction debris and pavement which is disturbed by the Mason Road Bridge Project. The Contractor will install sidewalks within the County's right of way from Mulberry Row Court to Belleville Springs Drive.

No direct payment shall be made for any additional time, special equipment, or additional labor to comply with these requirements.

200.40.2 REMOVAL OF GUARDRAIL - SALVAGE

The Contractor will carefully remove all guardrails and posts to be salvaged as directed by the Engineer. The salvaged guardrail is to become the property of St. Louis County. The Contractor shall deliver the guardrail to St. Louis County Maintenance District Headquarters located at 11201 Schaefer Road. The Contractor shall load and stack the guardrail on timbers or other means to facilitate removal from the vehicle by St. Louis County personnel. The Contractor shall notify Mr. Terry Mitchell at (314) 615-1107, a minimum of 48 hours prior to delivery. The Contractor will be required to dispose of any guardrail which has been damaged as approved by the Engineer. The cost of removal of the guardrail and delivery to the above address, or disposal of damaged guardrail, shall be included under Pay Item No. 202-20.10, Removal of Improvements.

700.40.5 MODULAR BLOCK RETAINING WALL (MISCELLANEOUS REQUIREMENTS)

The Contractor will be required to fill any open space in joints between the modular block wall and any adjacent structure (building, concrete wall, etc.) or pavement (sidewalk, ramp, etc.) with a weatherproof caulk. The color of the caulk shall be approved by the Engineer prior to use.

For the proposed retaining wall on Parcel 6, the contractor will allow the owners of the Enclave at Bellerive a choice of 4 colors for the retaining wall and that the wall material shall be a tumbled stone modular block.

No direct payment shall be made for any additional time, special equipment, or additional labor to comply with these requirements.

1000.10.2 INTERNALLY CURED CONCRETE (ICC)

Description.

This specification shall apply to Slab on Steel, Reinforced Concrete Slab Overlay, Slab on Prestressed Concrete Deck Beams, Concrete Approach Pavement, Bridge Approach Slabs, Safety Barriers, and Sidewalk on Structure where applicable. This specification shall be used for modifying pavement and/or structural concrete used in this project (PCCP, High Early or Very Early Opening Strength PCCP Repairs; Class B-1, B-2 or MB-2). Concrete shall be modified with lightweight fine aggregate (LWA) substituted for a portion of the standard fine aggregate using intermediate expanded shale, clay or slate (ESCS) lightweight fine aggregate to aid the curing process internally.

The conventional concrete mixture being modified shall satisfy all project requirements and specifications for constituent materials and for both fresh and hardened concrete properties.

The ICC mixture shall meet all project requirements and specifications for constituent materials and for both fresh and hardened concrete properties, including the additional requirements in this specification.

Materials and Design.

All materials shall conform to Division 1000, Materials Details, and specifically as follows:

Lightweight Aggregate. Lightweight aggregate for internal curing shall conform to the requirements in ASTM C 1761 *Standard Specification for Lightweight Aggregate for Internal Curing of Concrete*.

All materials, proportioning, air-entraining, mixing, slump, and transporting of internally cured concrete (ICC) shall be in accordance with Section 501, 502, 703 or 704, as applicable, with the following modifications:

1. Design an internal cure concrete mixture with lightweight fine aggregate, proportioned according to the American Concrete Institute Manual of Concrete Practice, ACI 211.2, Standard Practice for Selecting Proportions for Structural Lightweight Concrete. Produce a homogeneous mixture of cementitious materials, fine aggregate, lightweight fine aggregate, coarse aggregate, air entraining agent, water-reducing and set-retarding admixture, and water as designed.
2. Use a minimum total cementitious content for PCCP, High Early or Very Early Opening Strength PCCP Repairs; Class B-1, B-2 or MB-2 in accordance with Section 501.3.3. Use Type III cement as specified or Type I/II cement with the maximum allowable percentage of at least one supplementary cementitious material.
3. Substitute lightweight fine aggregate, meeting the requirements of ASTM C 1761, by volume of the standard fine aggregate. The lightweight fine aggregate shall also meet the chemical and physical requirements listed below.

Chemical Requirements	Test Method	Minimum	Maximum
Organic Impurities	ASTM C 40	Shall not produce a color darker than the standard solution (3)	
Staining, stain index	ASTM C 641	--	60

Chemical Requirements	Test Method	Minimum	Maximum
Loss on Ignition, percent	ASTM C 114	--	5
Physical Property	Test Method	Minimum	Maximum
Clay Lumps and Friable Particles, percent	ASTM C 142	--	2.0
Grading	ASTM C 136 and as modified by ASTM C 330	In accordance with Table I of ASTM C 1761	
Oven Dry Loose Density, lb/ft ³	ASTM C 29 (shovel method)	--	70
Relative Density (specific gravity) of pre-wetted LWA	ASTM C 127	As reported	
Water Absorption, percent	ASTM C 1761, Section 10	5	--
Desorption @ 94% Relative Humidity, percent released	ASTM C 1761, Section 11	85	--

4. **Stockpile Construction and Maintenance.** Construct lightweight fine aggregate stockpile(s) at the production facility so as to maintain uniform moisture throughout the pile. Using a sprinkler system approved by the Materials Engineer, continuously and uniformly sprinkle the stockpile(s) with potable water for a minimum of 48 hours. If a steady rain of comparable intensity occurs, the producer may turn off the sprinkler system at the direction of the Materials Engineer, until the rain ceases. At the end of the wetting period, or after the rain ceases, allow the stockpile(s) to drain for 12 to 15 hours immediately prior to use, unless otherwise directed by the Materials Engineer.
5. **Mix Design.** After the materials have been accepted for this work, determine the proportions for ICC and equivalent batch masses based on trials made with materials to be used in the work. Make appropriate adjustments to the specific gravity (Bulk SSD) and fineness modulus of the combined fine aggregate when developing the mix design.

At least 14 days prior to concrete placement, provide the Chief Materials Engineer with a copy of the trial mix design with data in accordance with Section 501 and as follows:

- a. The Chief Materials Engineer, or his representative, will approve the batch weights prior to use. Use these values to manufacture all high performance concrete with lightweight fine aggregate for this project, and periodically correct the batch weights to account for changes in the fine aggregate fineness modulus and aggregate moisture contents.
6. Achieve a minimum 28-day compressive strength as specified in Sec 501 for the mix designation used.

CONSTRUCTION DETAILS

A. Apply the provisions of Section 501 and the following modifications:
Add the following to Section 501.12.8 Handling of Materials:

- i. The minimum absolute volume of lightweight fine aggregate needed to replace normal weight fine aggregate shall be determined from the weight of internal moisture required for internal curing. The weight of internal moisture shall be 7 pounds per 100 pounds of total cementitious material per cubic yard. Use the following formula to compute the absolute volume, in cubic feet, of pre-wetted lightweight aggregate per cubic yard of concrete.

$$LWA_{AV} = \frac{0.07 (\text{total weight of cementitious material}) (1 + \text{absorption}) / ((\text{absorption})(\text{desorption}))}{62.4 \times \text{Lightweight Aggregate Relative Density}}$$

Where:

LWA_{AV} = Absolute volume of pre-wetted lightweight aggregate per cubic yard of concrete, ft^3/yd^3 ;

The total weight of cementitious material is expressed in lbs;

The absorption and desorption values are expressed as decimal fractions; and

The absorption and desorption values used to compute LWA_{AV} shall be for the specific source of lightweight fine aggregate selected for use in the internally cured concrete mixture.

- ii. Batch the lightweight fine aggregate with some mixing water first, and then routinely batch the fine aggregate, coarse aggregate, admixtures, cementitious, and remaining mixing water and mix completely.

B. **ICC Mixture.** The proportions of the ICC mixture shall be determined by modifying the proportions of the conventional normal weight concrete mixture in the following manner: the volume of pre-wetted lightweight aggregate that corresponds to LWA_{AV} computed above shall replace an equal volume of normal weight fine aggregate. Other minor adjustments to the mixture may be made to achieve mixture performance requirements. Trial batches shall be conducted to demonstrate that the internally cured concrete mixture satisfies project requirements. Submit the internally cured concrete mixture design and any test results as required by the contract documents.

Submittals shall include the absorption and desorption values for the selected source of lightweight aggregate that were used to compute the quantity of pre-wetted lightweight aggregate required to supply the water for internal curing.

Construction.

The ICC mixture shall be batched, transported, placed and finished to meet all requirements specified in the contract documents for the conventional normal weight concrete mixture.

The free moisture content of the pre-wetted lightweight aggregate shall be determined immediately prior to batching as specified above. Batching weights shall be adjusted to account for the free moisture in the lightweight fine aggregate.

Water absorbed in the lightweight aggregate is retained within the aggregate during mixing and does not affect the quantity of mix water. Therefore, batching weights shall not be adjusted for the absorbed moisture on the pre-wetted lightweight aggregate.

Density of ICC should be greater than 135 pcf.

Acceptance.

Physical Properties. Physical properties of the mix shall be in accordance with Section 501.

Method of Measurement.

Measurement for the ICC PCCP, High Early or Very Early Opening Strength PCCP Repairs; Class B-1, B-2 or MB-2 concrete shall be in accordance with the contract special provisions, Sec 502 or Sec 703.4.

Basis of Payment.

The work performed and the materials furnished under this item will be paid for in accordance with the contract special provisions, Sec 502 or Sec 703.5 and at the contract unit price for each of the pay items included in the contract.

7. ITEMIZED BID. The undersigned submits the following itemized bid and hereby authorizes the Director to correct any multiplication of "Unit Price" by "Quantity" as shown under "Amount" when copying the itemized bid sheet(s) into any contract.
8. TIME FOR COMPLETION. If this bid is accepted the undersigned hereby agrees that work will begin not later than the authorization date in the Notice to Proceed and will be diligently prosecuted at such rate and in such manner as, in the judgment of the Director, is necessary for the completion of the work within the time specified as follows:

Completion Date: November 1, 2015

9. LIQUIDATED DAMAGES. The undersigned further agrees that, should he fail to complete the work on the date, or in the time specified, or reopen the roadway within the 90 calendar day road closure limit, or such additional time as may be allowed by the Director under the contract, the amount of liquidated damages to be recovered, in accordance with the requirements of Section 108.7 of the Standard Specifications, shall survive as follows:

Liquidated Damages Per Day: \$1,100.00

Failure to begin temporary striping within the time specified:

Liquidated Damages Per Hour: \$ 200.00

10. BID GUARANTEE. The undersigned submits and attaches to this bid a bid guarantee meeting the following requirements: Each Bid shall be accompanied by a certified check or cashier's check equal to five (5) percent of the total bid, payable to "**Treasurer, St. Louis County**", to the use of the County, or a bidders bond, in like sum, executed by a surety company authorized to do business in the State of Missouri, as a guarantee on the part of the bidder that if its bid be accepted, it will, within ten (10) days after receipt of notice of such acceptance, enter into a contract and bond to do the work advertised; and, in case of default, forfeit such bid guaranty. The provisions of Section 103.4.1 shall also apply to this bid guaranty. Bid guarantees will be returned as per Section 103.3, Standard Specifications.
11. SUPERVISION OF WORK. The undersigned intends to have the following person(s) supervise the work:

ITEMIZED BID

FEDERAL PROJECT NO. STP-5574(604)
 COUNTY PROJECT NO. AR-1133

PAGE 1 OF 7

ITEM NO.	ITEM DESCRIPTION	UNIT	QUANTITY	UNIT PRICE	AMOUNT
ROADWAY ITEMS					
201-20.10	Clearing and Grubbing	L.S.	1		
202-20.10	Removal of Improvements	L.S.	1		
202-22.30	Removal of Rigid Pavement	S.Y.	563		
203-10.00	Class "A" Excavation	C.Y.	7216.6		
203-10.30	Land Disturbance Permits	L.S.	1		
304-05.04	Type 5 Aggregate Base (4" Thick)	S.Y.	5729.7		
404-12.72	Superpave Asphaltic Concrete Mixture SP125 (PG 70-22)DLP *	TON	461.1		
405-30.10	Type "C" Bituminous Concrete (Pavement) *	TON	27.2		
405-30.30	Type "X" Bituminous Concrete (Base) *	TON	2040.2		
407-10.27	Tack-Emulsified Asphalt (SS-1H) *	GAL.	410		
408-10.15	Prime-Liquid Asphalt (MC30) *	GAL.	1350		
502-11.06	Concrete Pavement (6" Non-reinforced)	S.Y.	87.6		
502-11.07	Concrete Pavement (7" Non-reinforced) *	S.Y.	176.7		

ITEMIZED BID

**FEDERAL PROJECT NO. STP-5574(604)
COUNTY PROJECT NO. AR-1133**

PAGE 2 OF 7

ITEM NO.	ITEM DESCRIPTION	UNIT	QUANTITY	UNIT PRICE	AMOUNT
504-10.20	Concrete Approach Pavement	S.Y.	222		
509-11.06	Concrete Base (6" Non-reinforced) *	S.Y.	205.7		
603-10.09	Expose Water Service House Leads (Less than 2")	EACH	1		
603-10.10	Relocating House Water Service Lead	L.F.	80		
603-10.20	Relocating Water Service Valve and Box	EACH	2		
603-10.25	Relocating Water Service Meter and Box	EACH	1		
604-12.01	Single Curb Inlet, Untrapped	EACH	11		
604-14.04	Area Inlet, Single, Open 4 Sides, Untrapped	EACH	1		
604-19.27	Manhole	EACH	2		
604-20.30	Adjusting Manhole to Grade	EACH	1		
604-23.04	Hydrodynamic Separator (4')	EACH	2		
604-40.11	Pipe Collar, Type "A" (Concrete)	EACH	2		
605-10.10	Class "A" Underdrain	L.F.	88		
606-10.10	Guardrail, Type "A"	L.F.	20		

* INDICATES CHANGES DUE TO ADDENDUM NO. 2 REVISIONS

ITEMIZED BID

FEDERAL PROJECT NO. STP-5574(604)
 COUNTY PROJECT NO. AR-1133

PAGE 3 OF 7

ITEM NO.	ITEM DESCRIPTION	UNIT	QUANTITY	UNIT PRICE	AMOUNT
606-23.00	Transition Section	EACH	3		
606-30.97	Crashworthy Guardrail Terminal, Modified (25.0' Length)	EACH	3		
608-50.06	Paved Approach (6")	S.Y.	25.6		
608-50.07	Paved Approach (7")	S.Y.	126.5		
609-10.15	Concrete Curb, Modified Type "S"	L.F.	47		
609-10.42	Concrete Gutter, Type "B"	L.F.	251.5		
609-10.53	Curb and Gutter, Vertical *	L.F.	2034.4		
611-50.30	Heavy Stone Revetment	S.Y.	190.5		
612-10.20	Moveable Barricades with Model "B" Amber Flashers (2 Each per Barricade)	EACH	6		
612-30.10	Standard Traffic Control Devices	L.S.	1		
612-70.20	Changeable Message Board (Noiseless), Rental	EACH	2		
615-10.00	Office for Engineer	MO.	10		
616-10.05	Construction Signs	S.F.	186.25		
616-10.25	Channelizer (Trim Line)	EACH	62		

ITEMIZED BID

FEDERAL PROJECT NO. STP-5574(604)
COUNTY PROJECT NO. AR-1133

PAGE 4 OF 7

ITEM NO.	ITEM DESCRIPTION	UNIT	QUANTITY	UNIT PRICE	AMOUNT
616-10.95	Edge Drop-Off Treatment	L.F.	1932		
617-20.01	Concrete Median Barrier, Type "B" Modified	L.F.	169		
619-00.00	Mobilization	L.S.	1		
622-10.01	Temporary Pavement Markings, Tape (Includes Removal)	S.F.	200		
726-23.15	15" Class III Reinforced Concrete Pipe Culvert (Gasket Type)	L.F.	777		
726-25.15	15" Class V Reinforced Concrete Pipe Culvert (Gasket Type)	L.F.	131		
726-54.08	8" Polyvinyl Chloride Pipe	L.F.	20		
726-54.12	12" Polyvinyl Chloride Pipe	L.F.	26.9		
732-00.15	15" Flared End Section	EACH	2		
802-30.00	Type 3 Mulch (Vegetative with an Overspray)	ACRE	1		
803-10.00	Sodding	S.Y.	1603.4		
805-10.00	Seeding	ACRE	1.1		
806-55.00	Storm Water Pollution Prevention Plan (SWPPP)	L.S.	1		
	SUBTOTAL Roadway Items				

ITEMIZED BID

FEDERAL PROJECT NO. STP-5574(604)
 COUNTY PROJECT NO. AR-1133

PAGE 5 OF 7

ITEM NO.	ITEM DESCRIPTION	UNIT	QUANTITY	UNIT PRICE	AMOUNT
STRUCTURAL ITEMS					
202-10.20	Removal of Bridges	L.S.	1		
202-22.17	Removal of Asbestos (Bridge Demolition)	L.S.	1		
206-10.00	Class 1 Excavation	C.Y.	1507		
503-10.00	Bridge Approach Slab	S.Y.	238		
606-20.00	Bridge Anchor Section	EACH	3		
606-20.01	Bridge Anchor Section (Modified) *	EACH	1		
607-10.60	Pedestrian Fence (Structure)	L.F.	200		
607-30.25	Aluminum Handrail (Structure)	L.F.	252		
702-10.12	Structural Steel Piles (12")	L.F.	480		
702-70.00	Pile Point Reinforcement	EACH	16		
703-03.00	Bridge Deck Surface Penetration Sealer	S.F.	2070		
703-40.03	Class "B-1" Concrete (Substructure) *	C.Y.	149		
703-42.15	Safety Barrier Curb (Bridges, Cast-in-Place)	L.F.	99		

ITEMIZED BID

FEDERAL PROJECT NO. STP-5574(604)
 COUNTY PROJECT NO. AR-1133

PAGE 6 OF 7

ITEM NO.	ITEM DESCRIPTION	UNIT	QUANTITY	UNIT PRICE	AMOUNT
703-42.30	Slab on Prestressed Concrete Deck Beams	S.Y.	230		
703-44.40	Bridge Plaque	EACH	1		
703-90.13	Modular Block Wall (h>4')	S.F.	2500		
705-14.48	Prestressed Concrete Members, Box Section, 48' Span	EACH	7		
710-60.00	Reinforcing Steel (Epoxy-Coated) (Grade 60) *	LBS.	13300		
715-10.00	Vertical Drain at End Bents	EACH	2		
	SUBTOTAL Structural Items				
COUNTY TRAFFIC SIGNAL ITEMS					
904-93.10	Temporary Signal Installation	EACH	2		
	SUBTOTAL County Traffic Signal Items				
PEDESTRIAN AND BICYCLE ITEMS					
608-60.04	Concrete Sidewalk (4" Thick) *	S.Y.	709		
608-60.06	Concrete Sidewalk (6" Thick)	S.Y.	14.6		
608-60.07	Concrete Sidewalk, Curb Ramp (7" Thick)	S.Y.	6.9		
608-60.98	Truncated Domes for Curb Ramps (New Construction)	S.F.	16		


* INDICATES CHANGES DUE TO ADDENDUM NO. 2 REVISIONS

ITEMIZED BID

FEDERAL PROJECT NO. STP-5574(604)
COUNTY PROJECT NO. AR-1133

PAGE 7 OF 7


ITEM NO.	ITEM DESCRIPTION	UNIT	QUANTITY	UNIT PRICE	AMOUNT
	SUBTOTAL Pedestrian and Bicycle Items				
	PROJECT TOTAL				

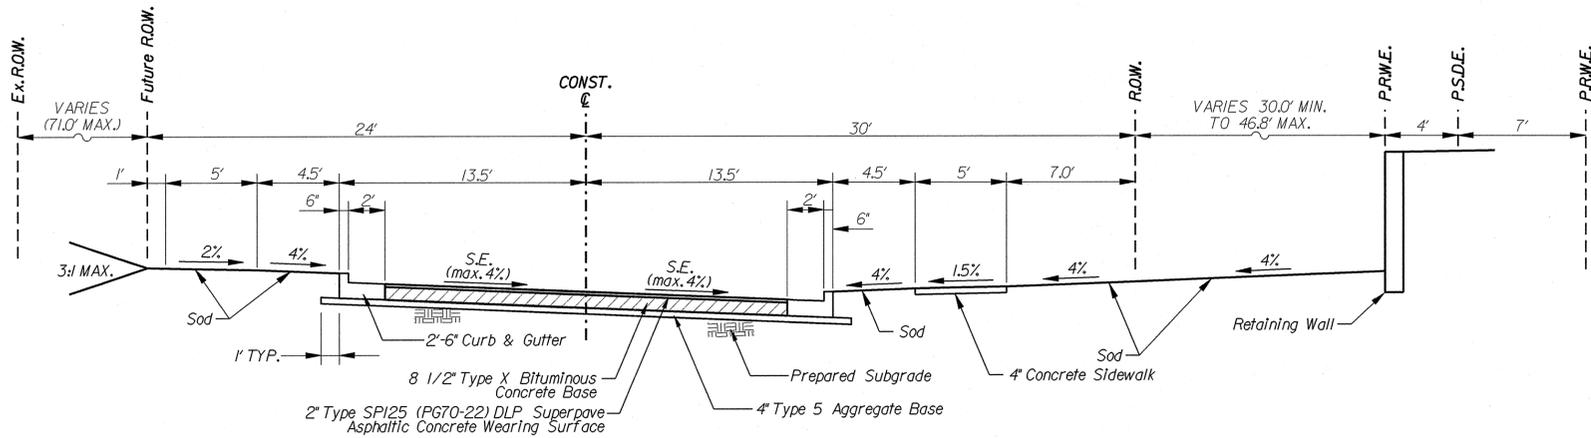

TYPICAL SECTION - MASON ROAD
STA. 6+38.12 TO STA. 12+38.78

NOTES:


- Retaining wall Sta. 7+49.80 to Sta. 10+01.29.
- Bridge Sections Sta. 12+38.78 to Sta. 13+99.29.

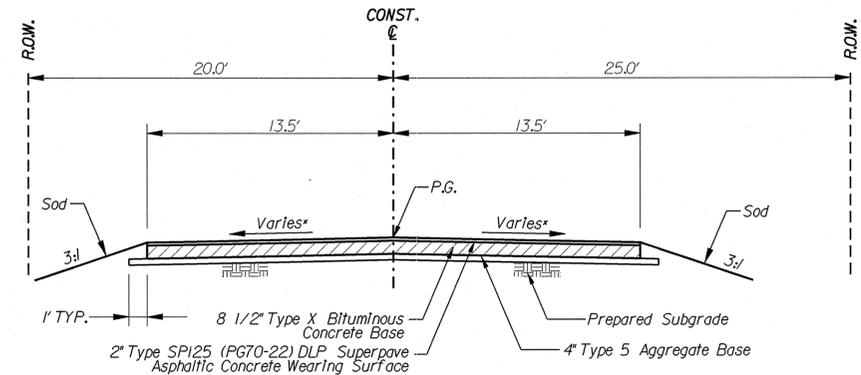

TYPICAL SECTION - MASON ROAD
STA. 16+09.14 TO STA. 18+66.00

NOTES:


- Bellerive Springs Dr. at Rt. edge of pavement, Sta. 16+09.14 to Sta. 16+98.87.

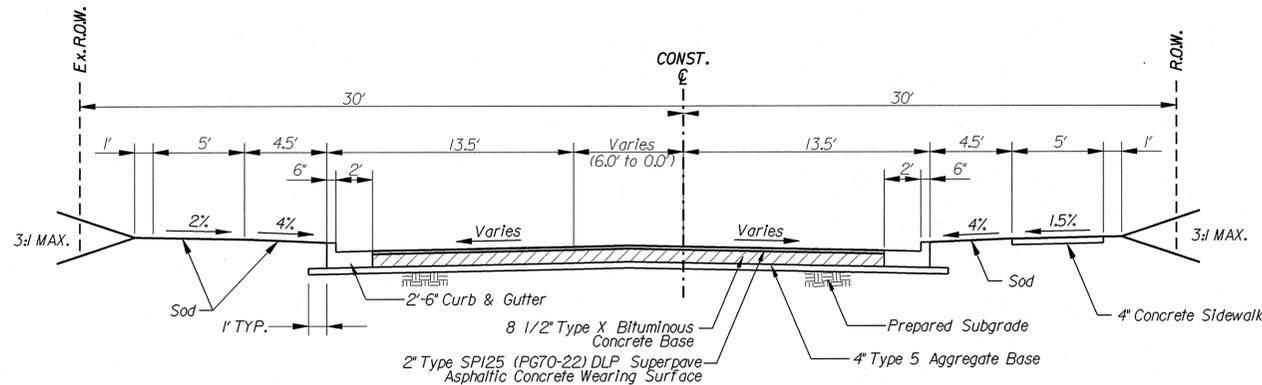

TYPICAL SECTION - MASON ROAD
STA. 4+08.00 TO STA. 6+38.12

NOTES:



- Sidewalk begins at Sta. 2+92.89, 24' RT. Transitions from 24' Rt. to 18.0' Rt. Sta. 3+95.92 to Sta. 4+08.00.

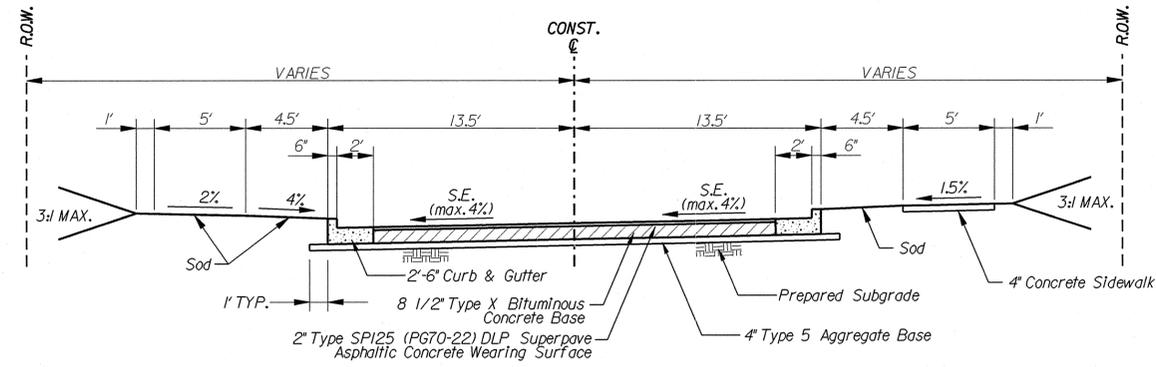

TYPICAL SECTION - MASON ROAD
STA. 13+99.29 TO STA. 16+09.14

NOTES:

- Bridge Section from Sta. 12+68.78 to Sta. 13+99.29

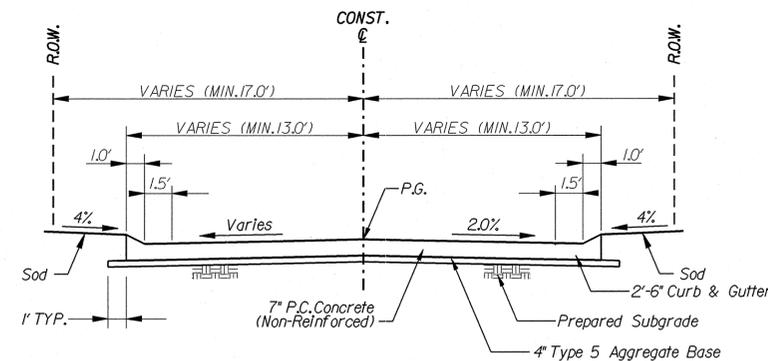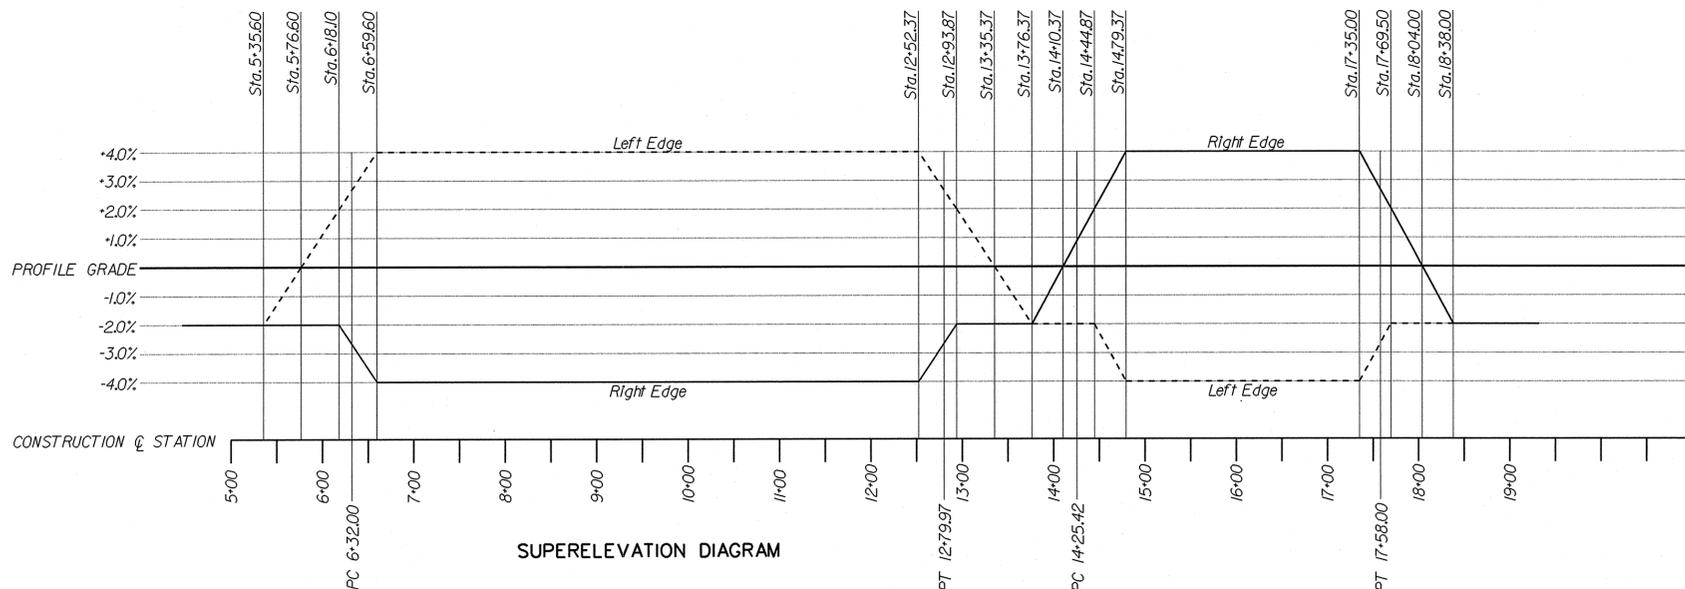

TYPICAL SECTION - BELLERIVE SPRINGS DRIVE

COUNTY PROJECT NO. AR-1133	
FEDERAL PROJECT NO. STP-5574(604)	
E-W GATEWAY TIP NO. 5808-13	
MSD: P-29044-00	
MSD BASE MAP: 18P1	
REVISIONS	DESCRIPTION
ADDENDUM NO. 2	
REV. DATE	BY APP. FOR
1	KJL

DISCLAIMER OF RESPONSIBILITY:
I hereby specify that the design and construction of the project is limited to the information provided in this sheet, and I hereby disclaim any other drawings, specifications, estimates, reports or other documents or instruments used for any part of the engineering project or survey.



DATE: **10/21/2014**

PREPARED BY:
DESIGN DIVISION
1050 N. LINDBERGH BLVD.
1ST FLOOR
ST. LOUIS, MISSOURI 63132
(314) 615-8543

JOSEPH W. KULESSA
PROFESSIONAL ENGINEER
LICENSE NO. PE-201000841

Saint Louis COUNTY HIGHWAYS & TRAFFIC
PUBLIC WORKS
Sheryl L. Hodges, D.E., P.E., LPG
Director

MASON ROAD BRIDGE NO. 211


TYPICAL SECTIONS

DESIGNED: **E. C. DAM**

DRAWN: **K. J. JONES**

CHECKED: **J. W. KULESSA**

SHEET SEQUENCE:
5 OF 57

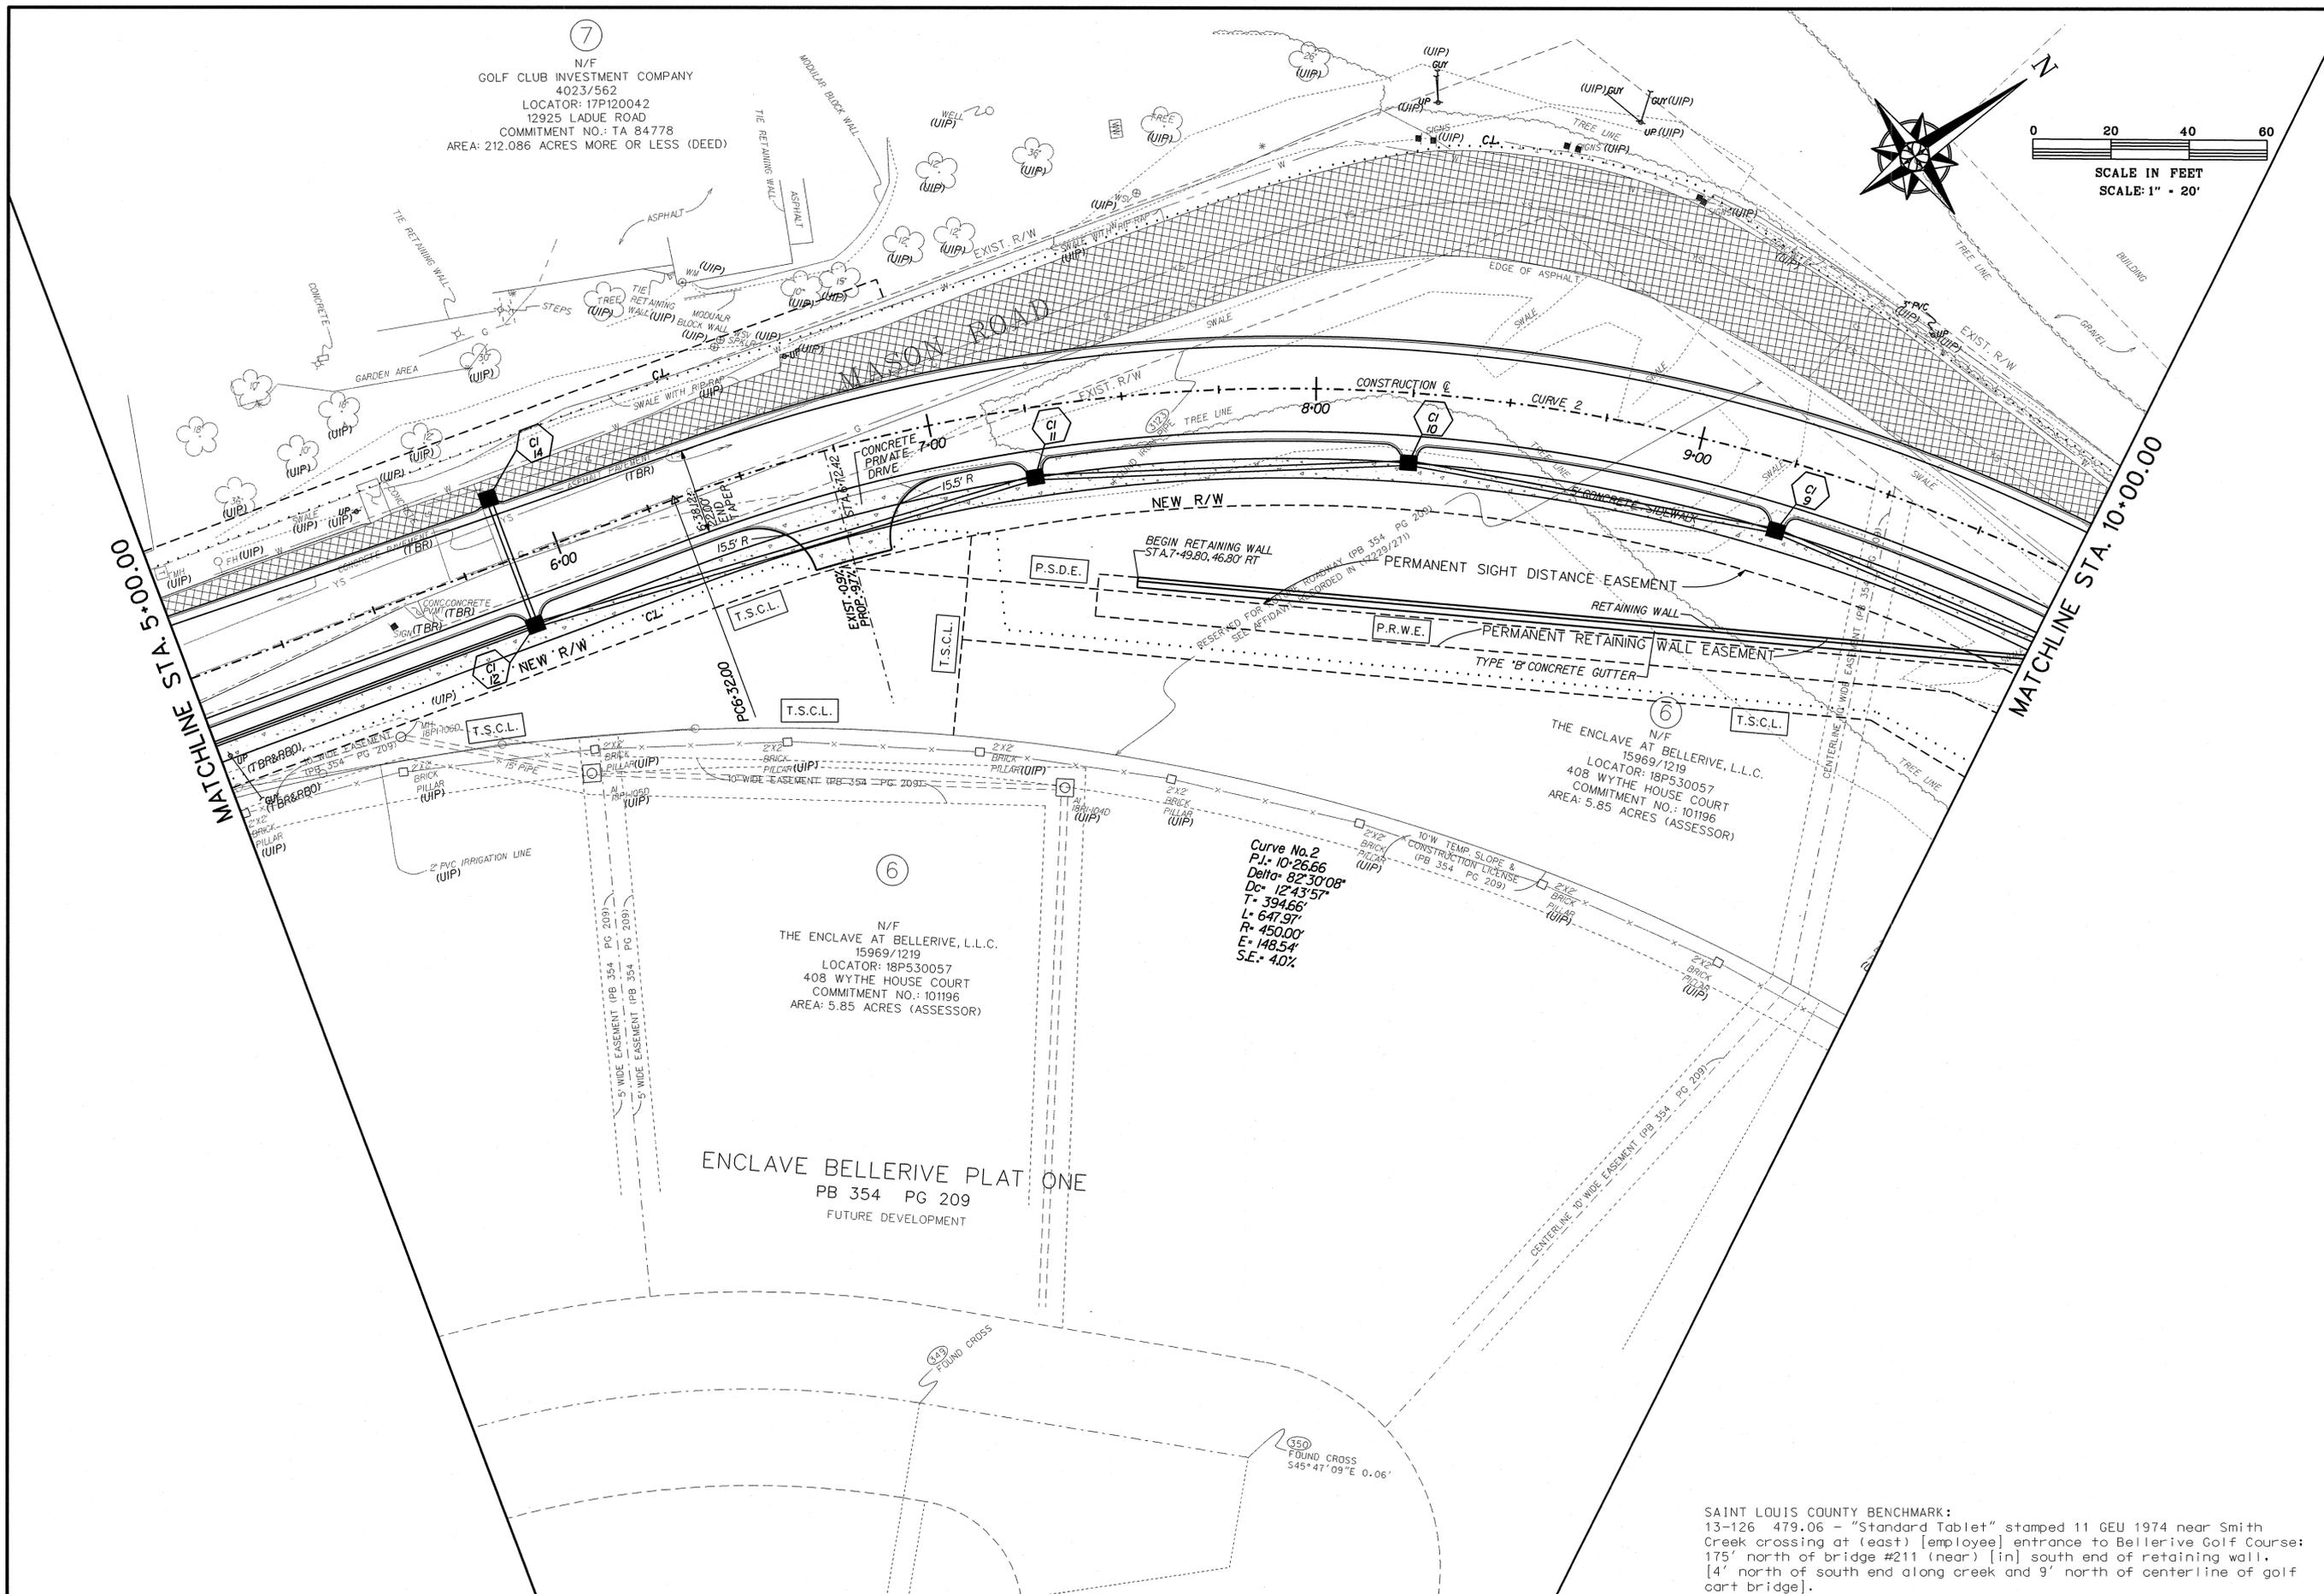

7
N/F
GOLF CLUB INVESTMENT COMPANY
4023/562
LOCATOR: 17P120042
12925 LADUE ROAD
COMMITMENT NO.: TA 84778
AREA: 212.086 ACRES MORE OR LESS (DEED)



0 20 40 60
SCALE IN FEET
SCALE: 1" = 20'

COUNTY PROJECT NO.
AR-1133
FEDERAL PROJECT NO.
STP-5574(604)
E-W GATEWAY TIP NO.
5808-13
MSD: P-29044-00
MSD BASE MAP:
18P1

REV	DATE	BY	APP	DESCRIPTION
1	10/21/14	KJ		ADDENDUM NO. 2

DISCLAIMER OF RESPONSIBILITY
I hereby specify that this project is authorized by my seal and limited to this sheet, and I hereby disclaim any liability for any other drawings, specifications, estimates, reports or other documents or instruments used for any part of the engineering project or survey.



DATE: 10/21/2014

PREPARED BY:
DESIGN DIVISION
1050 N. LINDBERGH BLVD.
1ST FLOOR
ST. LOUIS, MISSOURI 63132
(314) 615-8643
JOSEPH W. KULESSA
PROFESSIONAL ENGINEER
LICENSE NO. PE-201000841



Saint Louis COUNTY
HIGHWAYS & TRAFFIC
PUBLIC WORKS
Sheryl L. Hodges, D.E., P.E., LPG
Director

MASON ROAD BRIDGE
NO. 211
PLAN SHEET 2 OF 4

DESIGNED:
E.C. DAM
DRAWN:
K.J. JONES
CHECKED:
J.W. KULESSA
SHEET SEQUENCE:
7 OF 57

SAINT LOUIS COUNTY BENCHMARK:
13-126 479.06 - "Standard Tablet" stamped 11 GEU 1974 near Smith Creek crossing at (east) [employee] entrance to Bellerive Golf Course; 175' north of bridge #211 (near) [in] south end of retaining wall, [4'] north of south end along creek and 9' north of centerline of golf cart bridge].

N/F
 GOLF CLUB INVESTMENT COMPANY
 4023/562
 LOCATOR: 17P120042
 12925 LADUE ROAD
 COMMITMENT NO.: TA 84778
 AREA: 212.086 ACRES MORE OR LESS (DEED)

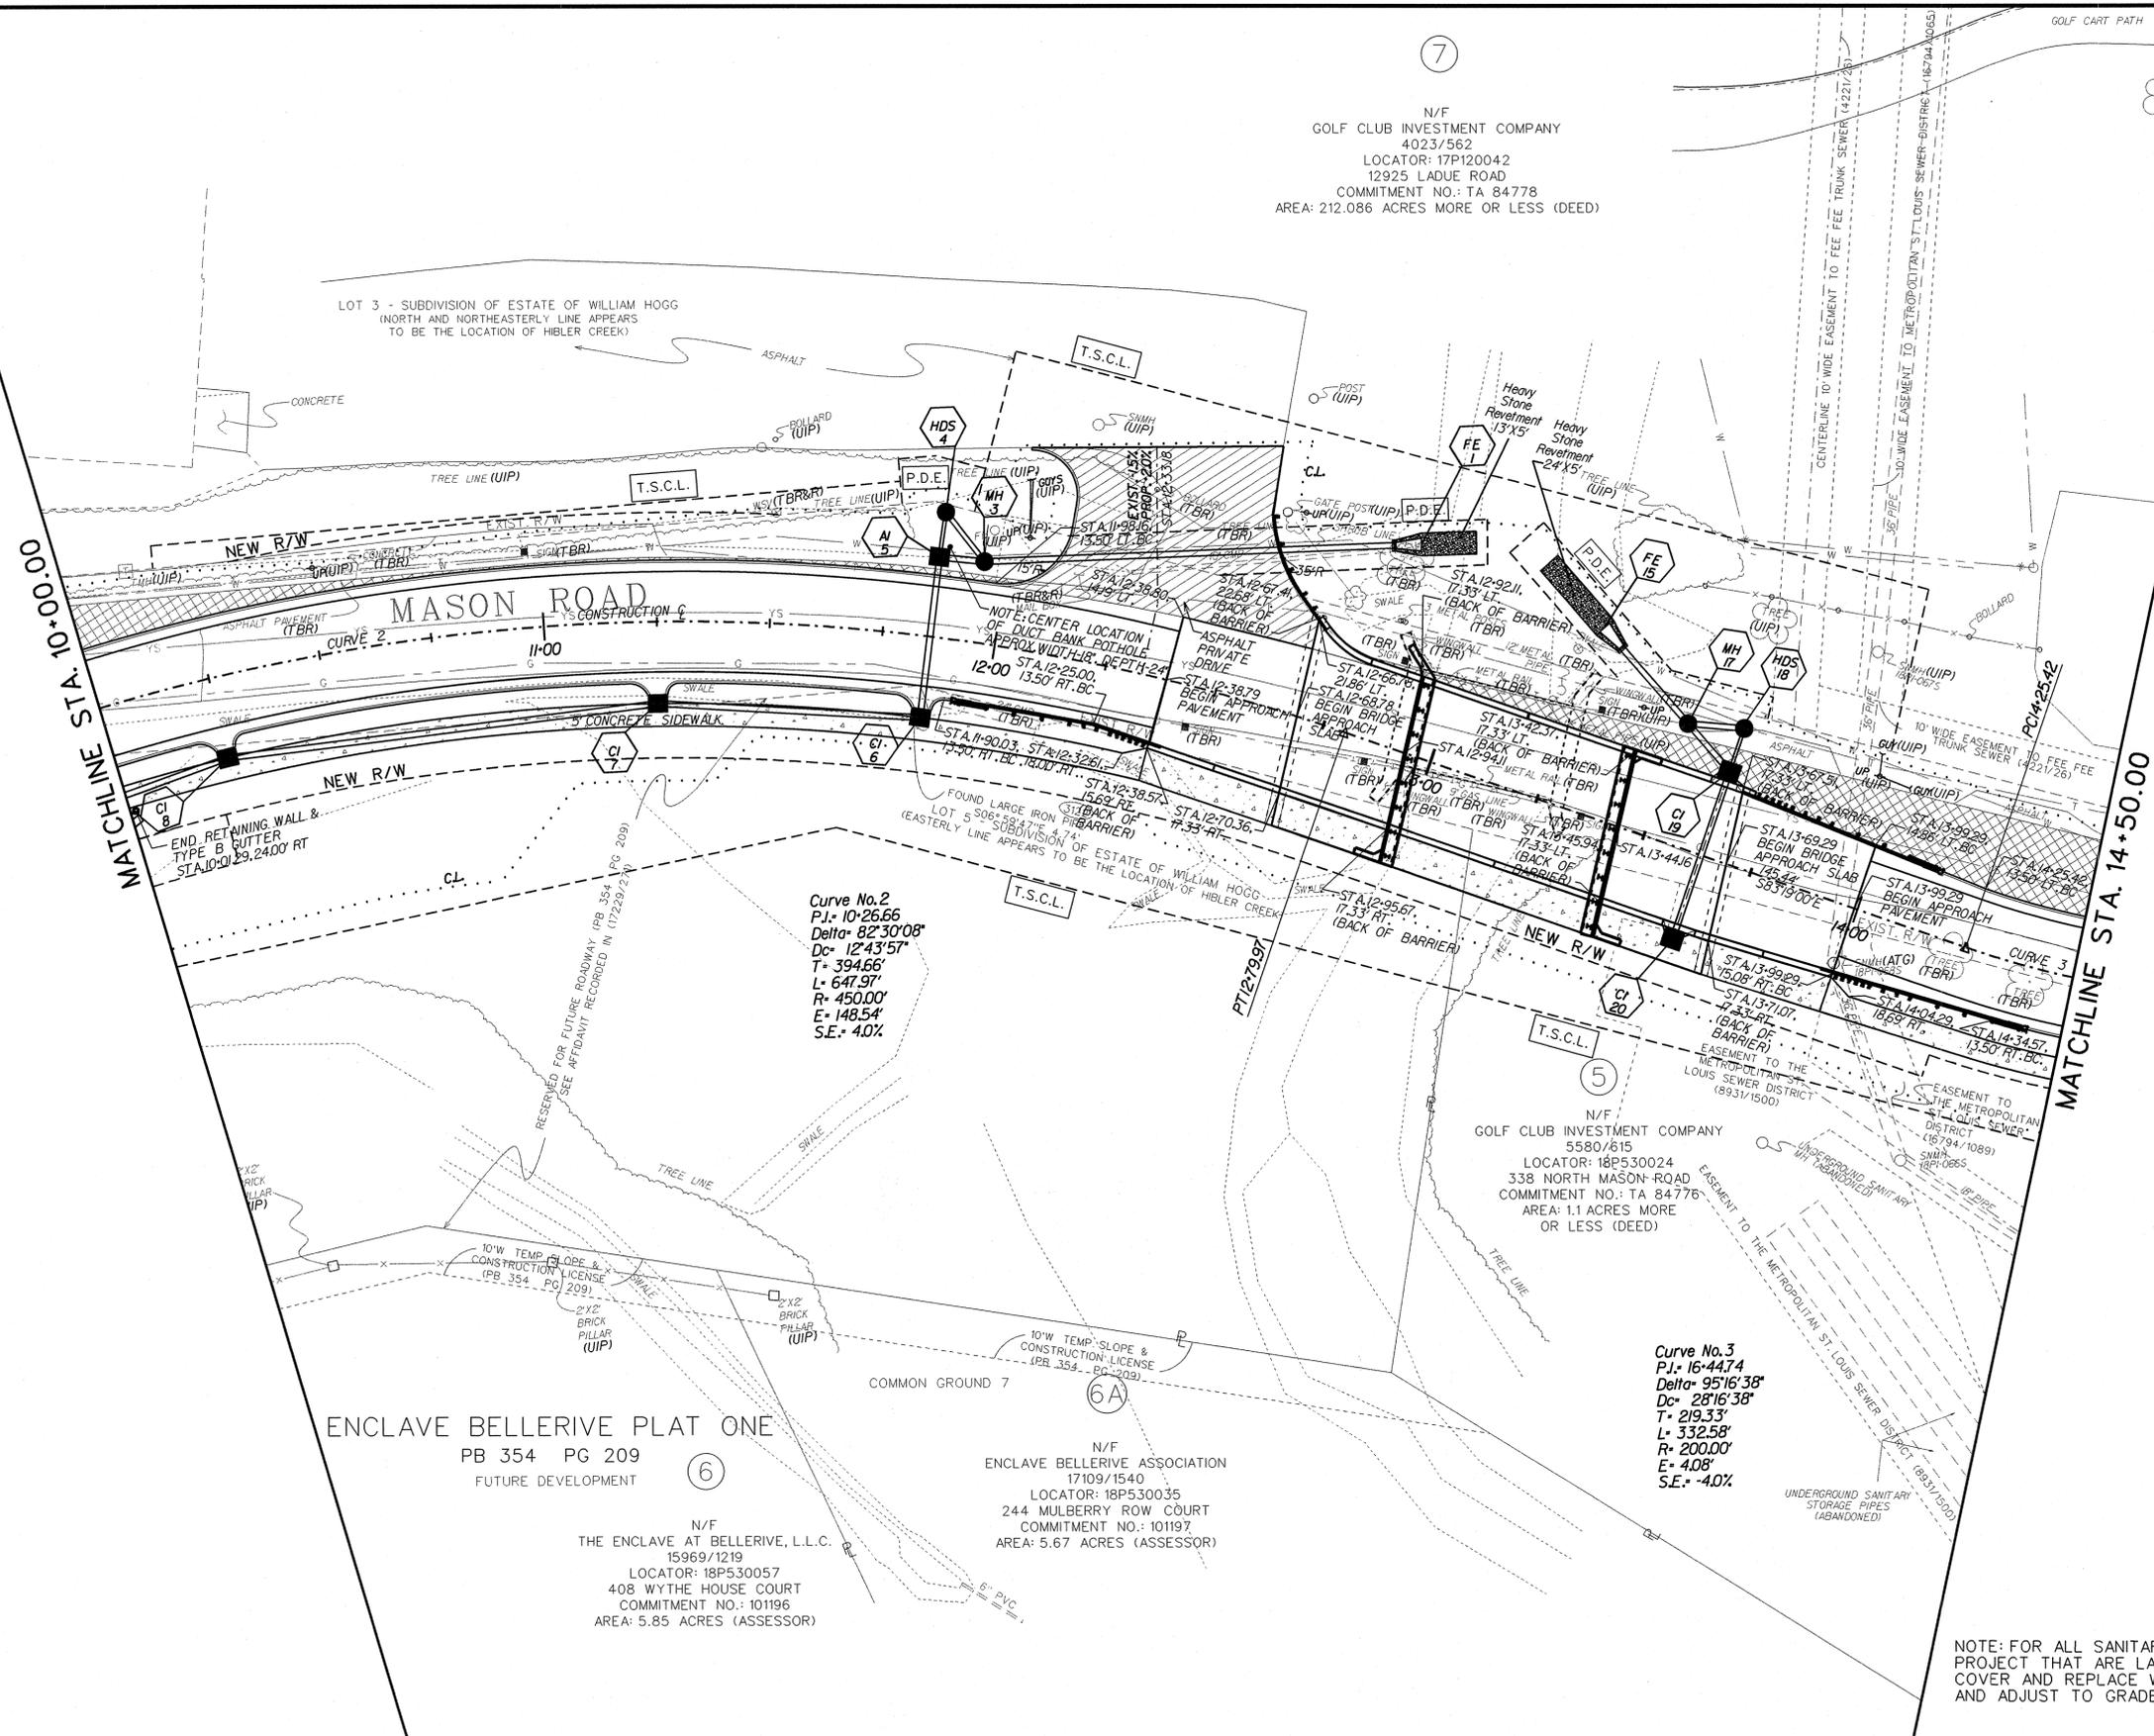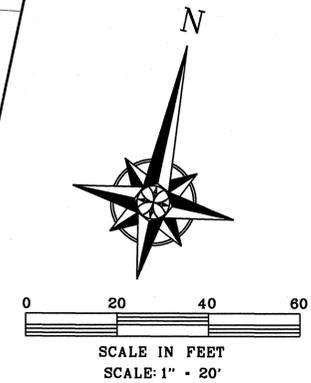

ENCLAVE BELLERIVE PLAT ONE
 PB 354 PG 209
 FUTURE DEVELOPMENT
 N/F
 THE ENCLAVE AT BELLERIVE, L.L.C.
 15969/1219
 LOCATOR: 18P530057
 408 WYTHE HOUSE COURT
 COMMITMENT NO.: 101196
 AREA: 5.85 ACRES (ASSESSOR)

N/F
 ENCLAVE BELLERIVE ASSOCIATION
 17109/1540
 LOCATOR: 18P530035
 244 MULBERRY ROW COURT
 COMMITMENT NO.: 101197
 AREA: 5.67 ACRES (ASSESSOR)

N/F
 GOLF CLUB INVESTMENT COMPANY
 5580/615
 LOCATOR: 18P530024
 338 NORTH MASON ROAD
 COMMITMENT NO.: TA 84776
 AREA: 1.1 ACRES MORE OR LESS (DEED)

Curve No. 3
 P.I.: 16+44.74
 Delta: 95°16'38"
 Dc: 28'16'38"
 T: 219.33'
 L: 332.58'
 R: 200.00'
 E: 4.08'
 S.E.: -4.0%


Curve No. 2
 P.I.: 10+26.66
 Delta: 82°30'08"
 Dc: 12'43'57"
 T: 394.66'
 L: 647.97'
 R: 450.00'
 E: 148.54'
 S.E.: 4.0%

COUNTY PROJECT NO. AR-1133	
FEDERAL PROJECT NO. STP-5574(604)	
E-W GATEWAY TIP NO. 5808-13	
MSD: P-29044-00	
MSD BASE MAP: 18P1	
REVISIONS	DESCRIPTION
REV. DATE BY APP. ADDENDUM NO. 2	
1 10-13-14 KJU	
DISCLAIMER OF RESPONSIBILITY: I hereby certify that the work shown on this drawing was prepared by me or under my direct supervision and that I am a duly licensed Professional Engineer in the State of Missouri. I am not responsible for any errors or omissions in this drawing, and I accept no liability for any damages, claims, or other legal proceedings arising out of or in connection with the use of any part of the engineering project or survey data shown on this drawing.	
DATE: 10/21/2014	
PREPARED BY:	DESIGN DIVISION 1050 N. LINDBERGH BLVD. 1ST FLOOR ST. LOUIS, MISSOURI 63132 (314) 616-8693
	JOSEPH W. KULESSA PROFESSIONAL ENGINEER LICENSE NO. PE-201000841
Sheryl L. Hodges, D.E., P.E., LPG Director	
MASON ROAD BRIDGE NO. 211	PLAN SHEET 3 OF 4
DESIGNED: E.C. DAM	
DRAWN: K.J. JONES	
CHECKED: J.W. KULESSA	
SHEET SEQUENCE: 8 OF 57	

SAINT LOUIS COUNTY BENCHMARK:
 13-126 479.06 - "Standard Tablet" stamped 11 GEU 1974 near Smith Creek crossing at (east) [employee] entrance to Bellerive Golf Course; 175' north of bridge #211 (near) [in] south end of retaining wall, [4'] north of south end along creek and 9' north of centerline of golf cart bridge).

MATCHLINE STA. 14+50.00

7

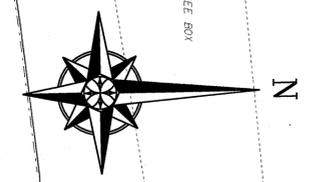

N/F
GOLF CLUB INVESTMENT COMPANY
4023/562
LOCATOR: 17P120042
12925 LADUE ROAD
COMMITMENT NO.: TA 84778
AREA: 212.086 ACRES MORE OR LESS (DEED)

Curve No.3
P.I.: 16+44.74
Delta: 95°16'38"
Dc: 28°16'38"
T: 219.33'
L: 332.58'
R: 200.00'
E: 4.08'
S.E.: -4.0%

LOT 2 - SUBDIVISION OF THE ESTATE OF ALTON HIBLER
(SOUTHWESTERLY LINE APPEARS TO BE THE LOCATION OF HIBLER CREEK)

LOT 2 - SUBDIVISION OF THE ESTATE OF ALTON HIBLER
(SOUTH AND SOUTHWESTERLY LINE APPEARS TO BE THE LOCATION OF HIBLER CREEK)

N/F
GOLF CLUB INVESTMENT COMPANY
5580/615
LOCATOR: 18P530024
338 NORTH MASON ROAD
COMMITMENT NO.: TA 84776
AREA: 1.1 ACRES MORE OR LESS (DEED)

RIGHT OF WAY RESERVATION TO BE
DEDICATED TO ST. LOUIS COUNTY
UPON DEMAND (PB 298 PG 47)

Bellerive Springs Drive
Curve No.1
P.I.: 0+23.60
Delta: 26°08'10"
Dc: 125°24'43"
T: 10.60'
L: 20.84'
R: 45.69'
E: 12'

Bellerive Springs Drive
Curve No.2
P.I.: 0+73.24
Delta: 29°26'11"
Dc: 38°11'50"
T: 39.40'
L: 77.06'
R: 150.00'
E: 5.09'

BELLERIVE SPRINGS
PB 298 PG 47

BELLECOUER PLAT 4
PB 100 PG 98

BELLECOUER PLAT 4
PB 100 PG 98

N/F
LARRY I. HARTING, ROBERT A. WALPERT & ROBIN WALPERT
8780/190
LOCATOR: 18P540342
12816 BELLERIVE SPRINGS DRIVE
COMMITMENT NO.: TA 84775
AREA: 124,222 SQUARE FEET MORE OR LESS
(RECORD PLAT)

BELLERIVE SPRINGS
PB 298 PG 47

N/F
MAYER MANORS, INC.
16884/935
LOCATOR: 18P540100
844 COULANGE COURT
COMMITMENT NO.: TA 84773
AREA: 44,683 SQUARE FEET MORE OR LESS
(CALCULATED FROM RECORD PLAT)

N/F
JAMES H. FRELICH
12181/472
LOCATOR: 18P540144
850 COULANGE COURT
COMMITMENT NO.: TA 84772
AREA: 44,204 SQUARE FEET MORE OR LESS
(CALCULATED FROM RECORD PLAT)

N/F
RAFFI & LYDIA KACHIGIAN
14193/552
LOCATOR: 18P540265
12821 BELLERIVE SPRINGS DRIVE
COMMITMENT NO.: TA 84774
AREA: 22,394 SQUARE FEET MORE OR LESS
(RECORD PLAT)

SAINT LOUIS COUNTY BENCHMARK:
13-126 479.06 - "Standard Tablet", stamped 11 GEU 1974 near Smith Creek
crossing at (east) [employee] entrance to Bellerive Golf Course; 175'
north of bridge #211 (near) [in] south end of retaining wall, [4'] north
of south end along creek and 9' north of centerline of golf cart bridge).

COUNTY PROJECT NO.
AR-1133
FEDERAL PROJECT NO.
STP-6574(604)
E-W GATEWAY TIP NO.
5808-13
MSD:
P-29044-00
MSD BASE MAP:
18P1

REV	DATE	BY	APP	DESCRIPTION
1	10/21/2014	KUJ		ADDENDUM NO. 2

DISCLAIMER OF
RESPONSIBILITY
I hereby specify that the
information contained herein
is based on the data and
information furnished to me
and is not to be used for
any purpose other than
that for which it was
prepared. I am not
responsible for the
accuracy or completeness
of the information
furnished to me or for
the results of the
design or construction
based on the information
furnished to me.




DATE: 10/21/2014

PREPARED BY:
DESIGN DIVISION
1050 N. LINDBERGH BLVD.
1ST FLOOR
ST. LOUIS, MISSOURI 63132
(314) 618-6693
JOSEPH W. KULESSA
PROFESSIONAL ENGINEER
LICENSE NO. PE-2010000841

Saint Louis
COUNTY
HIGHWAYS & TRAFFIC
PUBLIC WORKS
Sheryl L. Hodges, D.E., P.E., LPG
Director


MASON ROAD BRIDGE
NO. 211
PLAN SHEET 4 OF 4

DESIGNED:
E.C. DAM
DRAWN:
K.J. JONES
CHECKED:
J.W. KULESSA
SHEET SEQUENCE:
9 OF 57

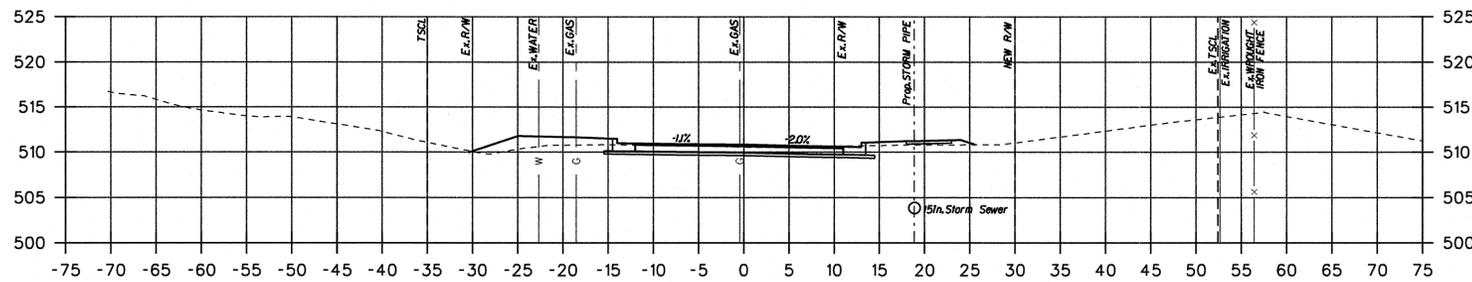


F=25.7 CY
C=64.6 CY

F=20.3 SF
C=32.1 SF

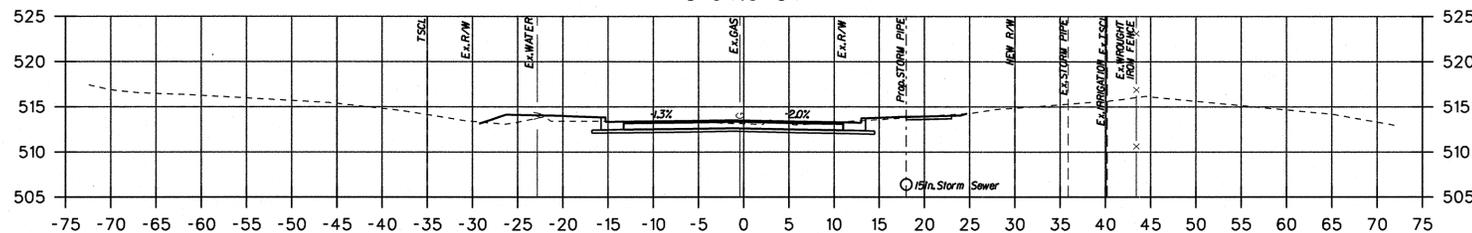


F=10.0 CY
C=81.5 CY

F=7.4 SF
C=37.7 SF

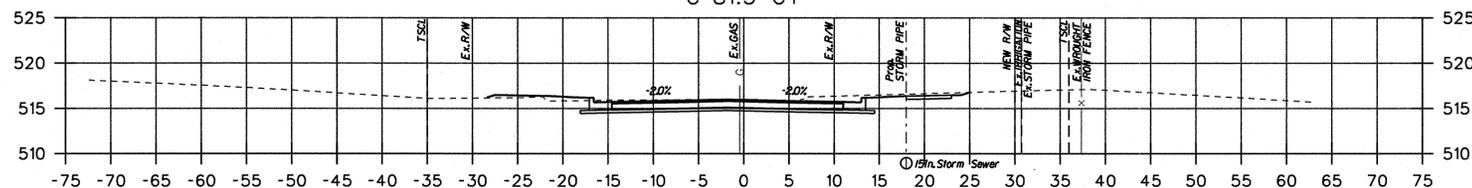


F=10.1 CY
C=100.5 CY

F=3.4 SF
C=50.4 SF

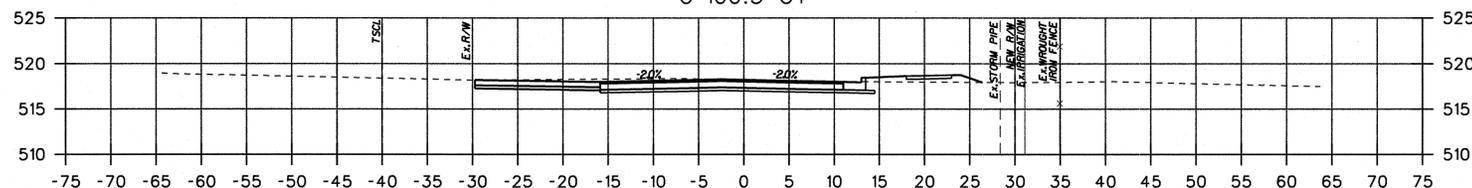


F=7.0 CY
C=53.9 CY

F=7.5 SF
C=58.2 SF

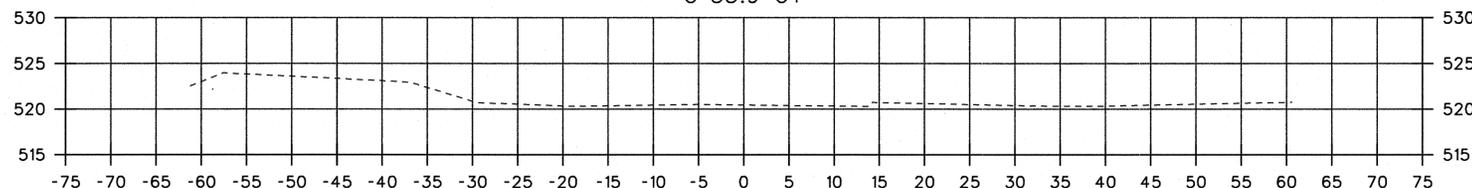

F=0.0 CY
C=0.0 CY


F=0.0 SF
C=0.0 SF

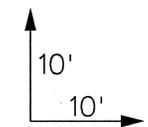

COUNTY PROJECT NO.
AR-1133
FEDERAL PROJECT NO.
STP-5574(604)
E-W GATEWAY TIP NO.
5808-13
MSD: P-29044-00
MSD BASE MAP:
18P1

REV	DATE	BY	APP	DESCRIPTION
1	10-21-14	KJ		ADDENDUM NO. 2

DISCLAIMER OF RESPONSIBILITY
I hereby specify that the documents prepared by me or under my supervision and control are to be used for the project and site described herein only and are not to be used for any other project or site. I am not responsible for the accuracy of the data provided to me or for the results of the design or construction of the project or site. I am not responsible for the actions of any contractor or subcontractor. I am not responsible for the actions of any government agency or authority. I am not responsible for the actions of any other person or entity. I am not responsible for the actions of any natural force or event. I am not responsible for the actions of any man-made force or event. I am not responsible for the actions of any other person or entity. I am not responsible for the actions of any natural force or event. I am not responsible for the actions of any man-made force or event.

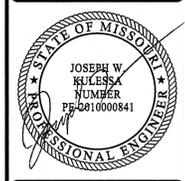


DATE: 10/21/2014

PREPARED BY:
DESIGN DIVISION
1050 N. LINDBERGH BLVD.
1ST FLOOR
ST. LOUIS, MISSOURI 63132
(314) 615-8543
JOSEPH W. KULESSA
PROFESSIONAL ENGINEER
LICENSE NO. PE-2010000841

Saint Louis COUNTY
HIGHWAYS & TRAFFIC
PUBLIC WORKS
Sheryl L. Hodges, D.E., P.E., LPG
Director


MASON ROAD BRIDGE
NO. 211
CROSS SECTIONS
(1 of 6)

DESIGNED:
E.C. DAM
DRAWN:
K.J. JONES
CHECKED:
J.W. KULESSA
SHEET SEQUENCE:
29 OF 57

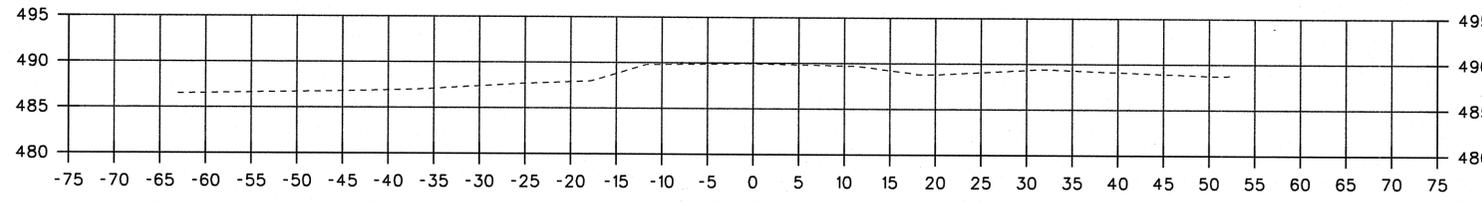


19+00.00
 F=7.6 CY
 C=28.7 CY

F=0.0 SF
 C=0.0 SF

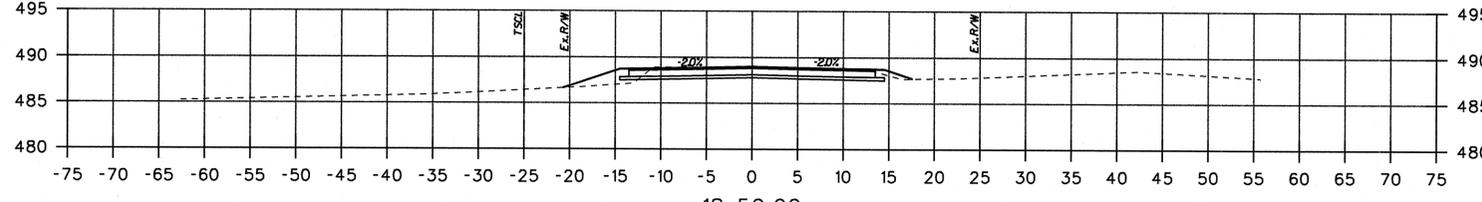


18+50.00
 F=13.3 CY
 C=55.6 CY

F=8.2 SF
 C=31.0 SF

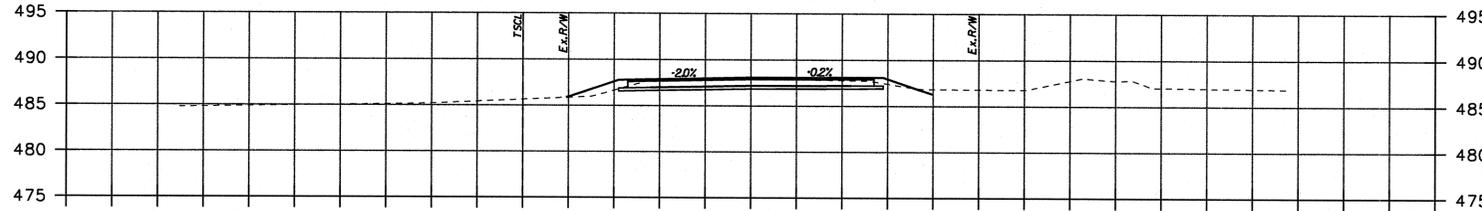


18+00.00
 F=9.3 CY
 C=55.7 CY

F=6.2 SF
 C=29.0 SF

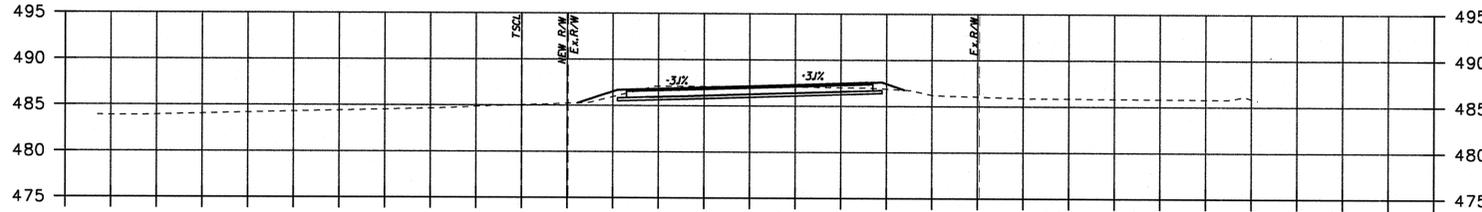


17+50.00
 F=6.7 CY
 C=53.6 CY

F=3.8 SF
 C=31.1 SF

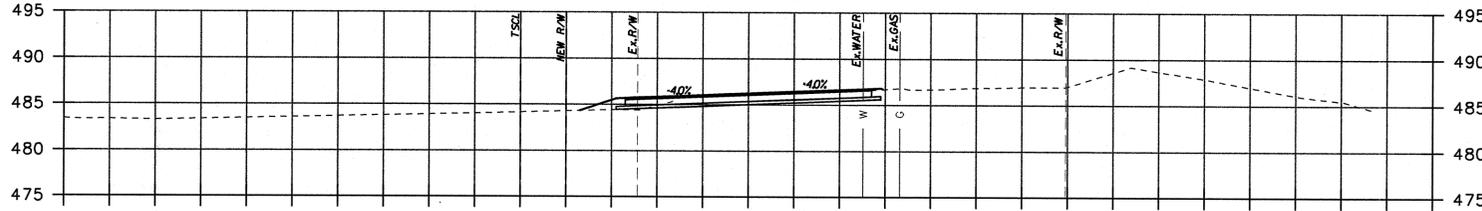


17+00.00
 F=6.3 CY
 C=72.6 CY

F=3.4 SF
 C=26.7 SF

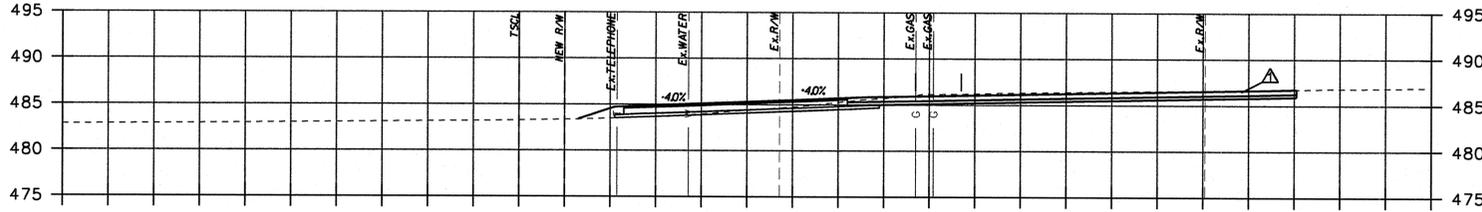

16+50.00 at Bellerive Springs Drive
 F=17.6 CY
 C=55.6 CY

F=3.4 SF
 C=51.7 SF

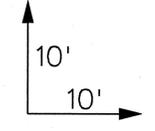

COUNTY PROJECT NO. AR-1133				
FEDERAL PROJECT NO. STP-5574(604)				
E-W GATEWAY TIP NO. 5808-13				
MSD: P-29044-00				
MSD BASE MAP: 18P1				
REV	DATE	BY	APP	DESCRIPTION
1	10/21/14	KJJ		ADDENDUM NO. 2

DISCLAIMER OF RESPONSIBILITY
 I hereby specify that the design shown on this sheet is the property of the engineer and is not to be used for any other project without the written consent of the engineer. The engineer assumes no responsibility for any errors or omissions in the design or for any consequences resulting from the use of the design for any part of the engineering project or survey.



DATE: 10/21/2014

PREPARED BY:
 DESIGN DIVISION
 1080 N. LINDBERGH BLVD.
 ST. LOUIS, MISSOURI 63132
 (314) 615-8843
 JOSEPH W. KULESSA
 PROFESSIONAL ENGINEER
 LICENSE NO. PE-2010000841

Saint Louis COUNTY HIGHWAYS & TRAFFIC PUBLIC WORKS
 Sheryl L. Hodges, D.E., P.E., LPG
 Director

MASON ROAD BRIDGE NO. 211
 CROSS SECTIONS (6 of 6)

DESIGNED: E.C. DAM
 DRAWN: K.J. JONES
 CHECKED: J.W. KULESSA
 SHEET SEQUENCE: 34 OF 57

Roadway Quantities			
Item		Total	Item No.
Type 5 Aggregate Base (4" Thick)	sq. yd.	222	304-05.04
Concrete Approach Pavement	sq. yd.	222	504-10.20
Class A Underdrain	lin. ft.	88.0	605-10.10
Guardrail Type A	lin. ft.	20	606-10.10
Guardrail Transition Section	each	3	606-23.00
Crashworthy Guardrail Terminal, Modified (25' Length)	each	3	606-30.97
Heavy Stone Revetment	sq. yd.	170.0	611-50.30

Structure Quantities					
Item		Substr.	Superstr.	Total	Item No.
Removal of Bridges	lump sum		1.0	1.0	202-10.20
Asbestos Abatement	lump sum		1	1	202-22.17
Bridge Approach Slab	sq. yd.		238	238	503-10.10
Bridge Anchor Section	each		3	3	606-20.00
Bridge Anchor Section (Modified)	each		1	1	606-21.01
Pedestrian Fence (Structure)	lin. ft.		200	200	607-10.60
Concrete Median Barrier, Type "B" Modified	lin. ft.		169	169	617-20.01
Bridge Deck Surface Penetration Sealer	sq. ft.		2,070	2,070	703-03.00
Safety Barrier Curb (Bridges, Cast-in-Place)	lin. ft.		99	99	703-42.15
Slab on Prestressed Concrete Deck Beams	sq. yd.		230	230	703-42.30
Bridge Plaque	each		1	1	703-44.40
Prestressed Concrete Members, Box Section, 48' Span	each		7.0	7.0	705-14.48
Class 1 Excavation	cu. yd.	1,370		1,370	206-10.00
Structural Steel Piles (12")	lin. ft.	480		480	702-10.12
Pile Point Reinforcement	each	16		16	702-70.00
Class "B-1" Concrete (Substructure)	cu. yd.	149		149	703-40.03
Modular Block Wall (H greater than 4')	sq. ft.	2,500		2,500	703-90.13
Reinforcing Steel (Epoxy Coated) (Grade 60)	pound	13,300		13,300	710-60.00
Vertical Drain at End Bent	each	2		2	715-10.00

GENERAL NOTES:

Design Specifications:
2008 AASHTO LRFD 4th Edition, with 2008 Interims
Load and Resistance Factor Design

Design Loading:
HL-93 (LRFD Superstructure, LRFD Substructure)
30 psf Future Wearing Surface
Earth 120 pcf
Superstructure: Simply Supported for DL & LL

Standard Specifications:
Saint Louis County Standard Specifications for Highway Construction

Design Unit Stresses:
Class B-1 Concrete (Substructure) $f'c = 4,000$ psi
Class B-1 Concrete (Superstructure-Barrier) $f'c = 4,000$ psi
Class Modified B-2 (MB-2) (Superstructure-Slab) $f'c = 4,000$ psi
Reinforcing Steel (Epoxy-Coated) (Grade 60) $f_y = 60,000$ psi
Steel Pile (ASTM A709 Grade 50) $f_y = 50,000$ psi

For prestressed concrete deck beam stresses, see Bridge Sheet Nos. 10 & 11.

Reinforcing Steel:
Minimum clearance to reinforcing steel shall be 1-1/2" unless otherwise noted.

Miscellaneous:

High strength bolts, nuts, and washers will be sampled for quality assurance as specified in MoDOT's Engineering Policy Guide Sec. 106 and Field Section (FS-712) from MoDOT's Materials Manual. Two (2) additional samples must be provided for testing in addition to the minimum number shown on the design drawings unless otherwise noted.


"Sec" refers to the sections in the standard and supplemental specifications unless specified otherwise.

Traffic Handling:
Mason Road will be closed to vehicular traffic during construction.

Roadway Striping:
Final striping to be completed by St. Louis County forces.

Bridge Location:
Township = 45N
Range = 5E
Section = 08

Foundation Data			
Bent No.		1	2
H-Piles	Type	Foundation	Foundation
	Pile Type and Size	HP12 X 84	HP12 X 84
	Number	8	8
	Approximate Length	foot	30.0
	Nominal Axial Compressive Resistance	kip	812
	Minimum Tip Penetration	EI. 455.73	EI. 456.73
	Criteria for Minimum Tip Penetration	Penetrate anticipated soft geotechnical layers	Penetrate anticipated soft geotechnical layers
	Pile Standard	702.1	702.1

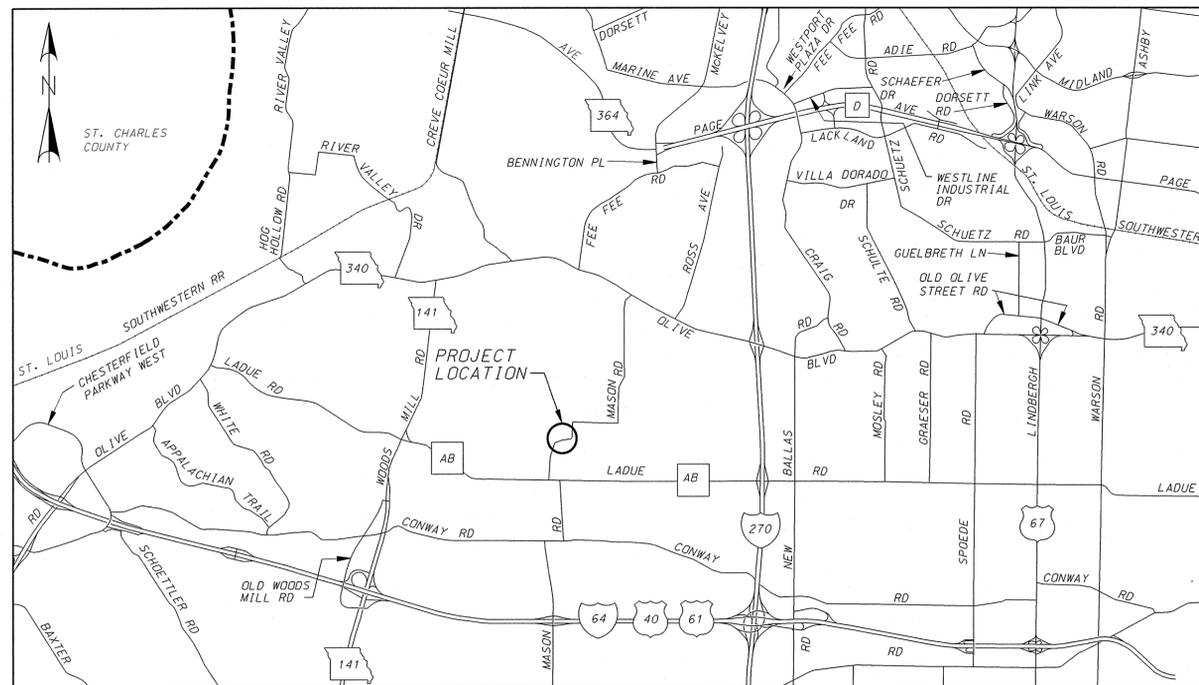

LOCATION MAP

BRIDGE SHEET INDEX	
1.	GENERAL PLAN & ELEVATION
2.	QUANTITIES AND GENERAL NOTES
3.	BORING LOGS
4.	TEMPORARY WORK AREAS AT ABUTMENTS
5.	END BENT NO. 1 PLAN & ELEVATION
6.	END BENT NO. 1 WING WALL & IN-FILL WALL DETAILS
7.	END BENT NO. 2 PLAN & ELEVATION
8.	END BENT NO. 2 WING WALL & IN-FILL WALL DETAILS
9.	VERTICAL DRAIN AT END BENT
10.	17" X 48" PRESTRESSED CONCRETE DECK BEAM DETAILS
11.	17" X 48" PRESTRESSED CONCRETE DECK BEAM DETAILS CONTINUED
12.	SLAB CROSS SECTION
13.	PLAN OF SLAB & SLAB POURING SEQUENCE
14.	FENCE ON STRUCTURE
15.	CONCRETE BARRIER & GUARDRAIL PLAN AND LAYOUT
15A.	BRIDGE ANCHOR SECTION (MODIFIED)
16.	SAFETY BARRIER CURB SLIP FORM OPTION
17.	BAR LIST
18.	APPROACH SLAB DETAILS
19.	AS BUILT PILE DATA
20.	BRIDGE PLAQUE

THIS DRAWING IS NOT TO SCALE, FOLLOW DIMENSIONS

BRIDGE SHEET NO.
2 OF 20

ST. LOUIS COUNTY BRIDGE NO.
211

MODOT BRIDGE NO.
096B211

COUNTY PROJECT NO.
AR-1133

FEDERAL PROJECT NO.
STP-5574(604)

E-W GATEWAY TIP NO.
5808-13

MSD:
P-0029044-00

MSD BASE MAP:
18P1

REV.	DATE	BY	APP.	DESCRIPTION
1	10/20/14	DAH	PRT	ADDENDUM NO. 2

DISCLAIMER OF LIABILITY: The undersigned hereby certifies that the drawings, specifications, and documents or instruments relating to or intended to be used for any part of the engineering project or survey are the work of the undersigned or under the direct supervision and control of the undersigned.



DATE:
20-OCT-2014

PREPARED BY:
DESIGN DIVISION
1050 N. WEST FLOOR
CREVE COEUR, MISSOURI 63132
(314) 615-8543
DANIEL A. HOWELL
PROFESSIONAL ENGINEER
LICENSE NO. 2011015754

Saint Louis COUNTY
HIGHWAYS & TRAFFIC
PUBLIC WORKS
Sheryl L. Hodges, D.E., P.E., LPG
Director


MASON ROAD
BRIDGE NO. 211
OVER SMITH CREEK
QUANTITIES AND
GENERAL NOTES

DESIGNED:
D.A. HOWELL


DRAWN:
D.A. HOWELL

CHECKED:
P.R. THEBEAU

SHEET SEQUENCE:
37 OF 57

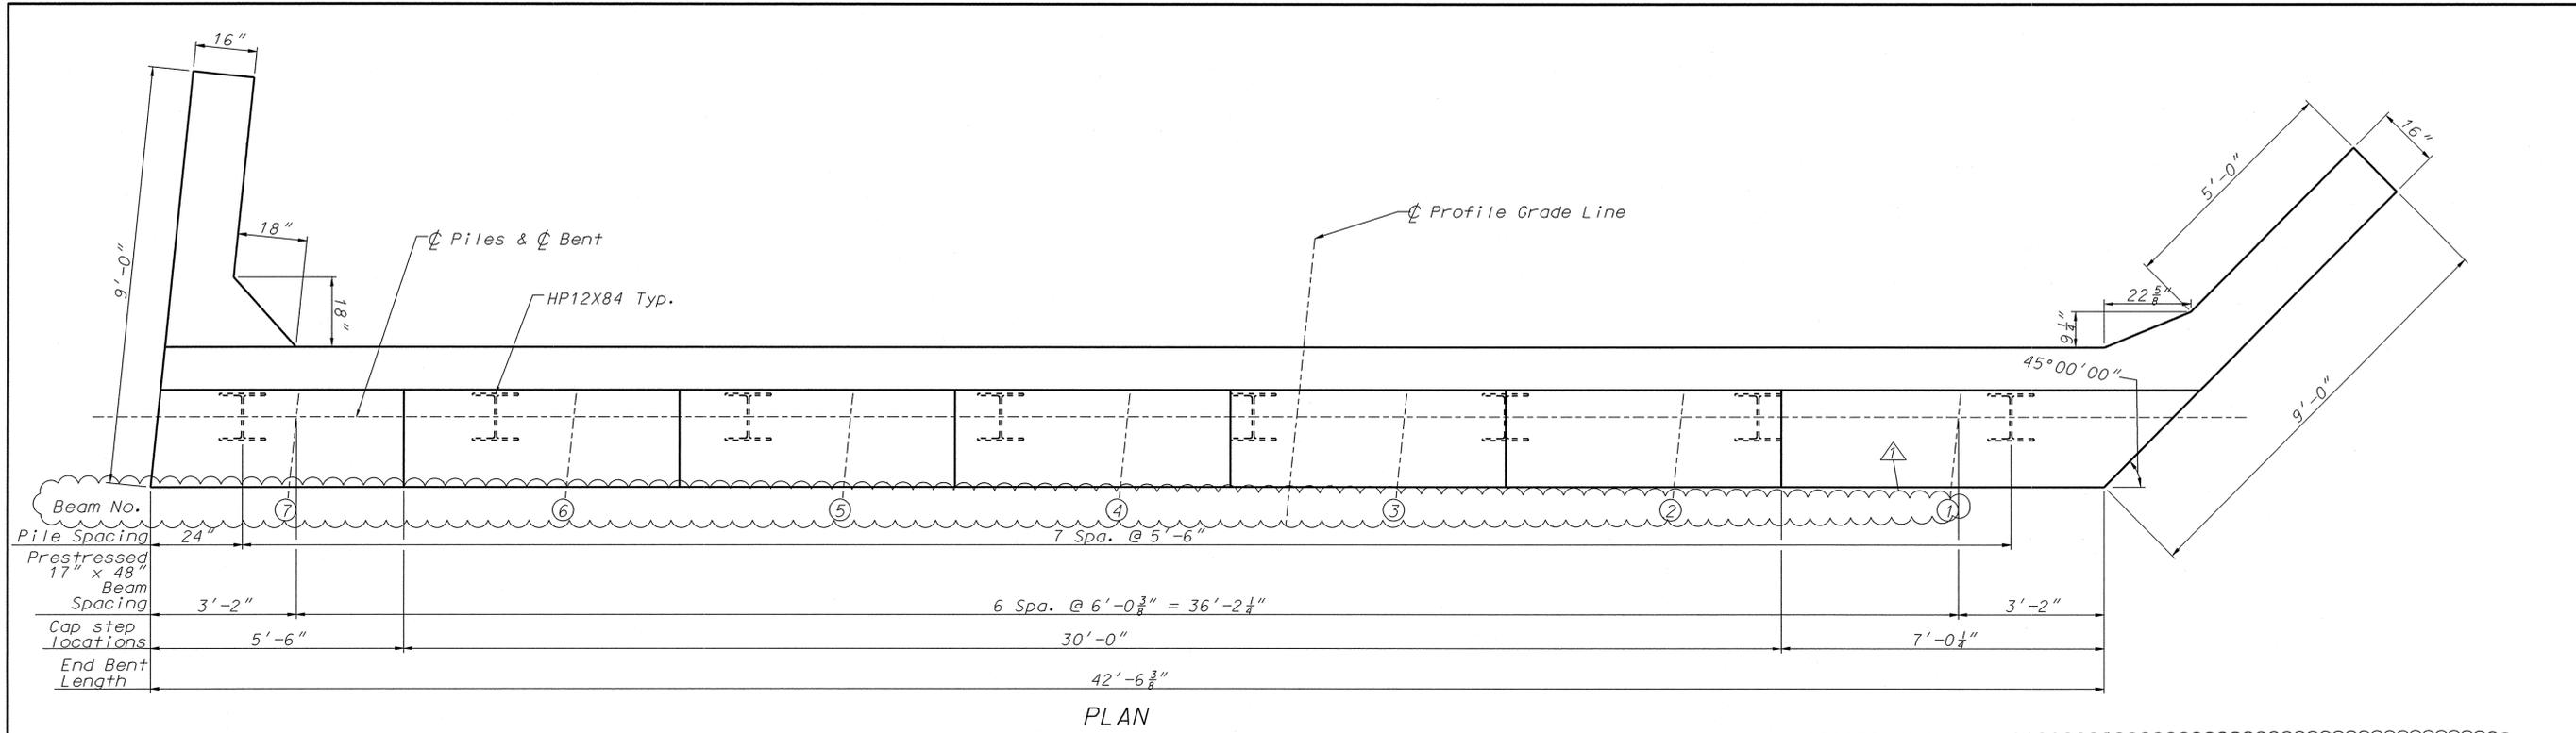

PLAN

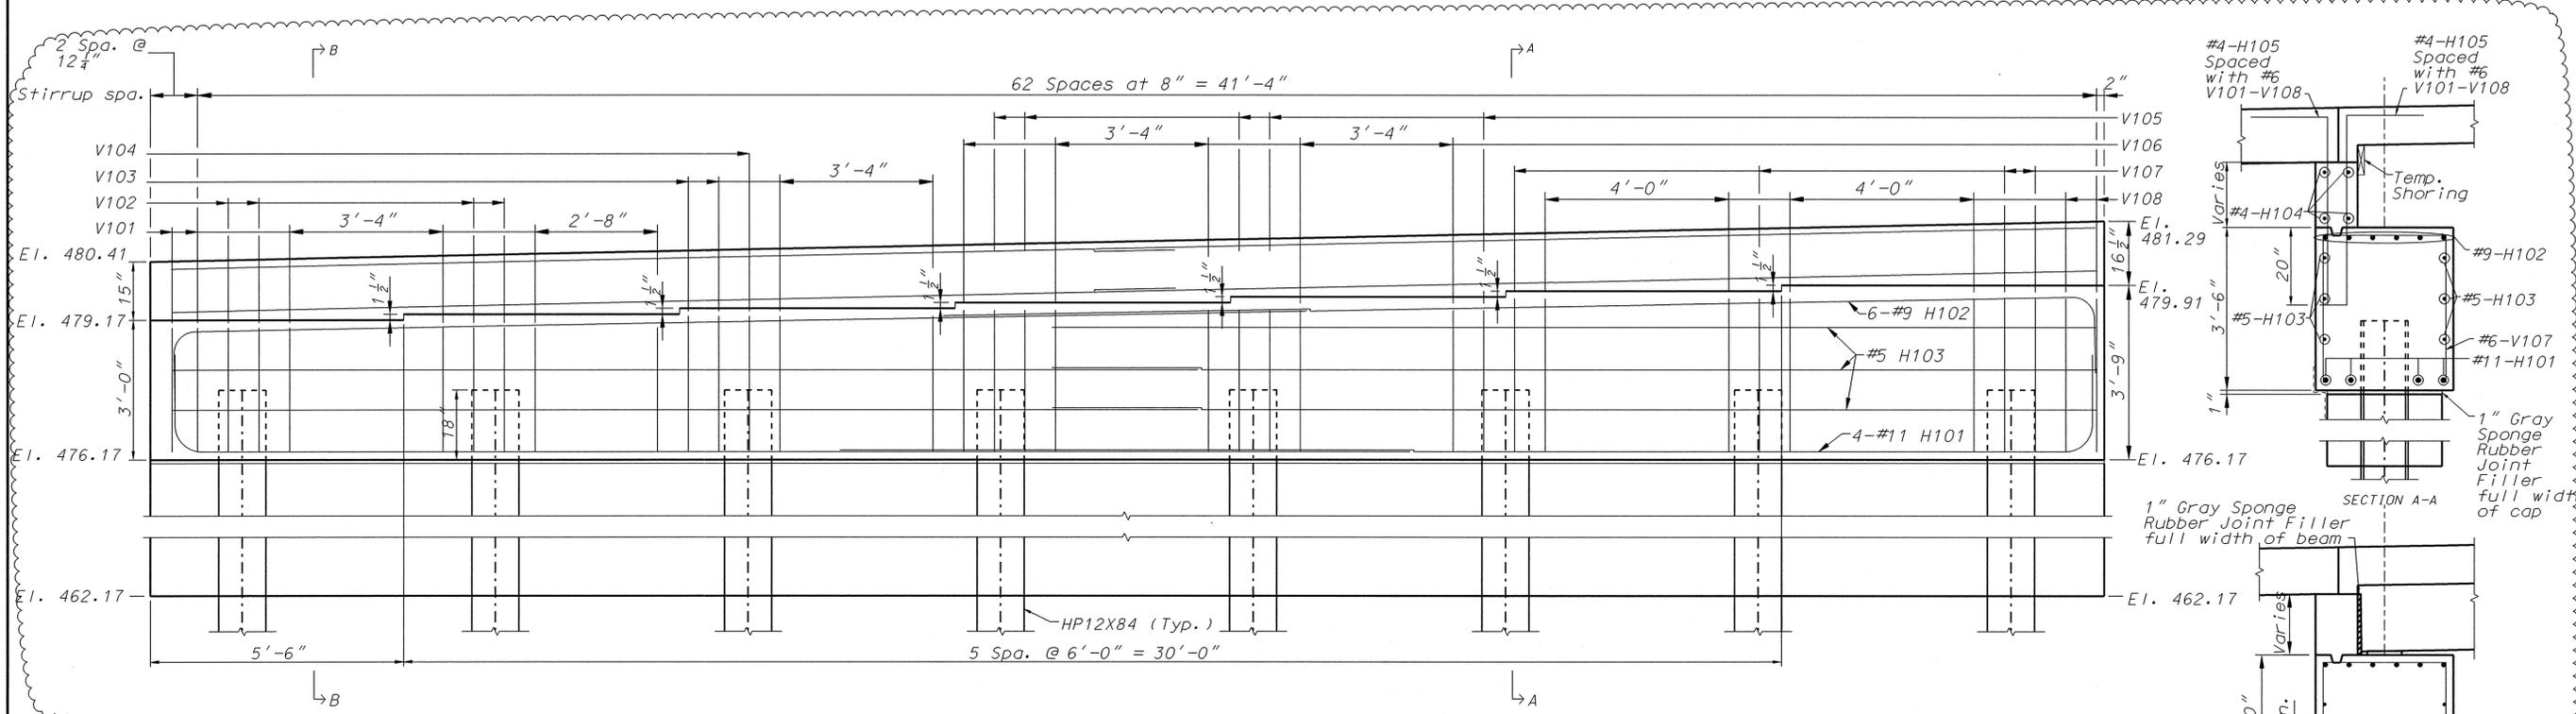

ELEVATION

SECTION THRU KEY

BAR SIZE	LAP LENGTH (IN.)
#5	39
#9	96
#11	150

Notes:
 1) See Bridge Sheet No. 6 of 20 for wing wall and infill wall details
 2) Longitudinal bars indicate lap splicing as shown.
 Contractor has option to provide single continuous bar if available for the lengths shown.

Updated for Superelevation

Note:
 Refer to Section A-A for reinforcing not shown

COUNTY PROJECT NO. AR-1133	
FEDERAL PROJECT NO. STP-5574(604)	
E-W GATEWAY TIP NO. 5808-13	
MSD: P-0029044-00	
MSD BASE MAP: 18P1	
REVISIONS	DESCRIPTION
REV. DATE	BY APP. DAH PRT
1	10/20/14
ADDENDUM NO. 2	

DISCLAIMER OF LIABILITY: I hereby certify that the documents intended to be authorized by my seal are those which I have prepared, and I hereby disclaim any responsibility for all other drawings, specifications, documents, or instruments relating to or intended to be used for any part of the engineering project or survey.



DATE: 20-OCT-2014

PREPARED BY:
 DESIGN DIVISION
 1050 N. WEST FLOOR
 CREVE COEUR, MISSOURI 63132
 (314) 616-8543

DANIEL A. HOWELL
 PROFESSIONAL ENGINEER
 LICENSE NO. 2011015754

Sheryl L. Hodges, D.E., P.E., LPG
 DIRECTOR

SAINT LOUIS COUNTY
 HIGHWAYS & TRAFFIC
 PUBLIC WORKS

MASON ROAD
 BRIDGE NO. 211
 OVER SMITH CREEK

END BENT NO. 1
 PLAN & ELEVATION

DESIGNED: D.A. HOWELL

DRAWN: D.A. HOWELL

CHECKED: P.R. THEBEAU


SHEET SEQUENCE: 40 OF 57

THIS DRAWING IS NOT TO SCALE, FOLLOW DIMENSIONS


BRIDGE SHEET NO. 5 OF 20

MODOT BRIDGE NO. 096B2111

ST. LOUIS COUNTY BRIDGE NO. 211

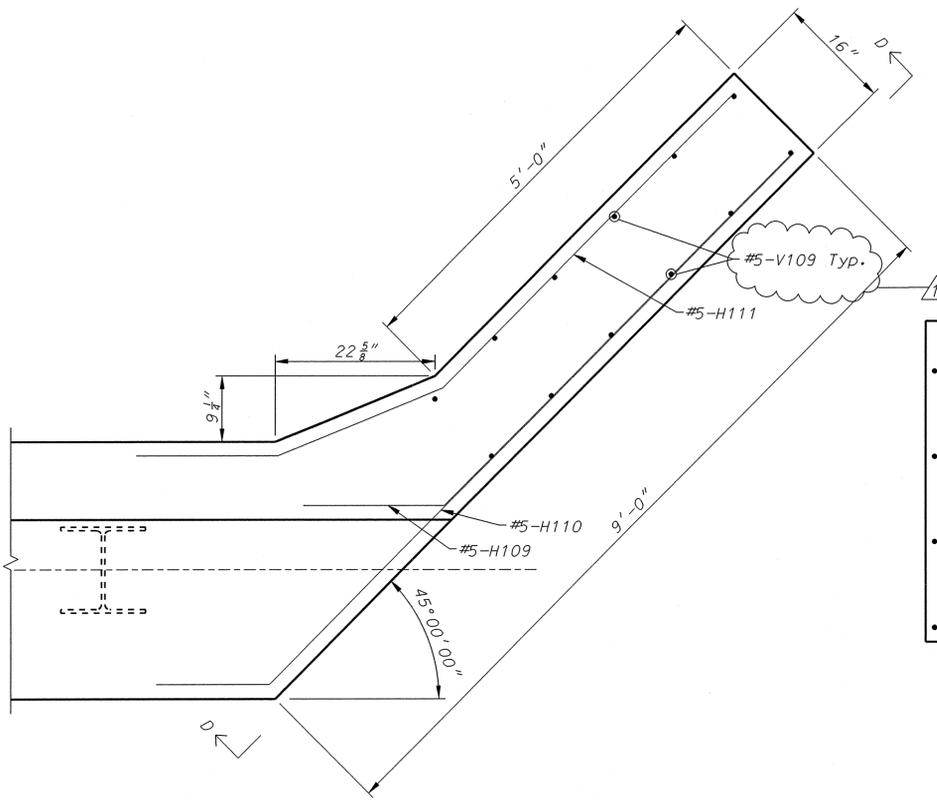


BENT NO. 1 PARTIAL PLAN

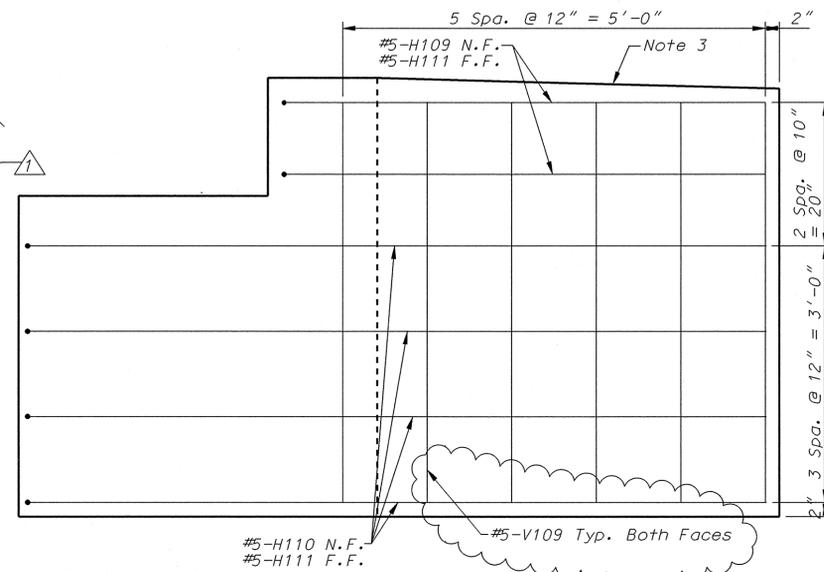


VIEW D-D


- NOTES:
1. Stem reinforcing not shown for clarity.
 2. N.F. = Near Face
F.F. = Far Face
 3. Top of wing wall shall match longitudinal grade at bottom of approach slab.

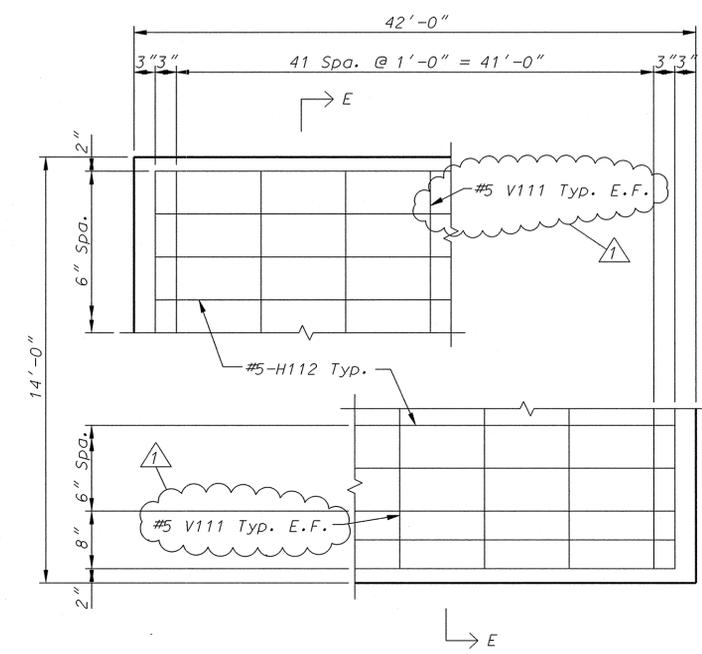

IN-FILL WALL ELEVATION

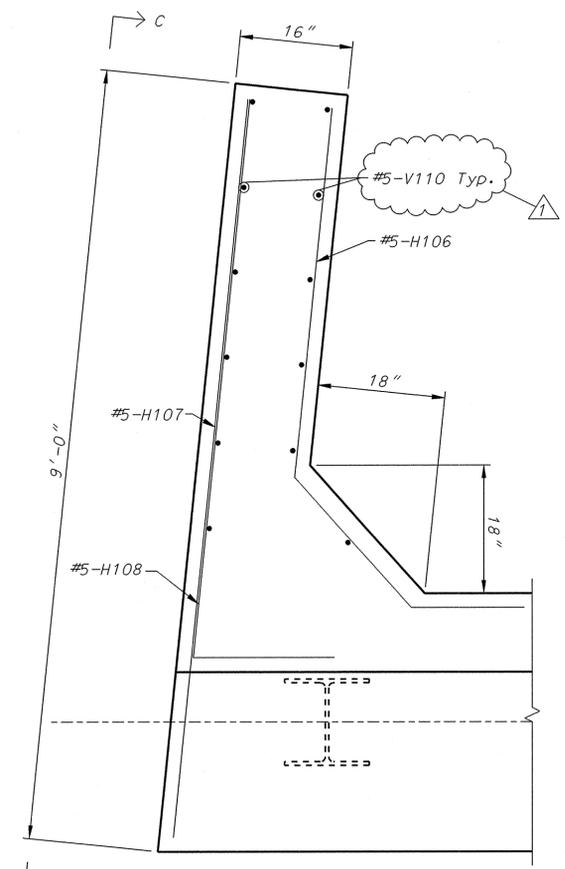


BENT NO. 1 PARTIAL PLAN

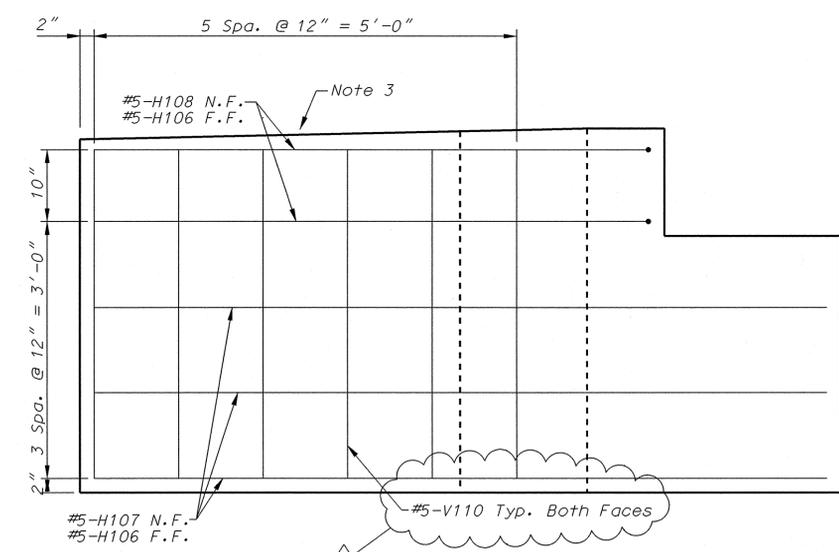

VIEW C-C

- NOTES:
1. Stem reinforcing not shown for clarity
 2. N.F. = Near Face
F.F. = Far Face
 3. Top of wing wall shall match longitudinal grade at bottom of approach slab.

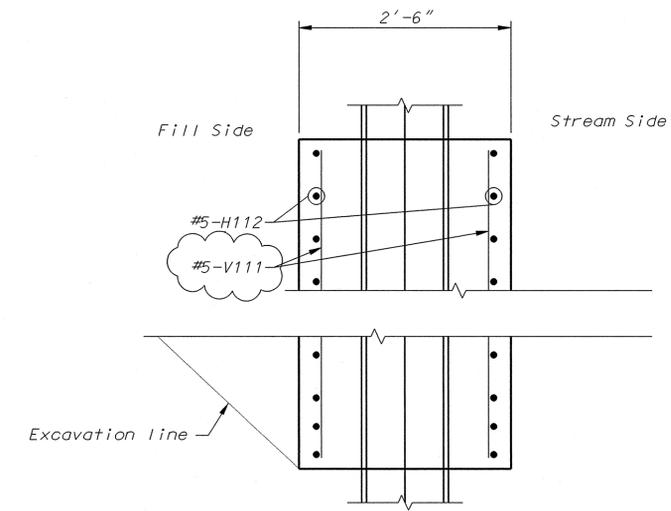

SECTION E-E

- Notes:
1. Temporary stream diversion required for in-fill wall construction. Refer to Bridge Sheet No. 4.

THIS DRAWING IS NOT TO SCALE, FOLLOW DIMENSIONS

BRIDGE SHEET NO. 6 OF 20


ST. LOUIS COUNTY BRIDGE NO. 211

MODOT BRIDGE NO. 096B2111

COUNTY PROJECT NO. AR-1133	
FEDERAL PROJECT NO. STP-5674(604)	
E-W GATEWAY TIP NO. 5808-13	
MSD: P-29044-00	
MSD BASE MAP: 18P1	
REVISIONS	DESCRIPTION
REV. DATE	BY APP. DAH/PT
1	10/20/14
DISCLAIMER OF LIABILITY: I hereby certify that the documents intended to be authorized by my seal are the work of me, and I hereby disclaim any responsibility for all other drawings, specifications, documents or instruments relating to or intended to be used for any part of the engineering project or survey.	
DATE: 20-OCT-2014	
PREPARED BY:	DESIGN DIVISION 1060 N. BROADWAY BLVD 1ST FLOOR CREVE COEUR, MISSOURI 63132 (314) 615-8543
DANIEL A. HOWELL PROFESSIONAL ENGINEER LICENSE NO. 2011015754	
MASON ROAD BRIDGE NO. 211 OVER SMITH CREEK	END BENT NO. 1 WING WALL & IN-FILL WALL DETAILS
DESIGNED: D.A. HOWELL	
DRAWN: D.A. HOWELL	
CHECKED: P.R. THEBEAU	
SHEET SEQUENCE: 41 OF 57	

REV	DATE	BY	APP	DESCRIPTION
1	10/20/14	DAH	PRT	ADDENDUM NO. 2

DISCLAIMER OF LIABILITY: The undersigned hereby certifies that the documents intended to be authorized by my seal are my own work, and I hereby disclaim any responsibility for all other drawings, specifications, documents or instruments used for any part of the engineering project or survey.

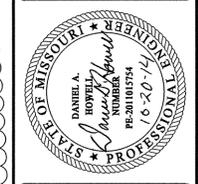


DATE: 20-OCT-2014
 PREPARED BY: DESIGN DIVISION, 1060 N. 1ST FLOOR, CREVE COEUR, MISSOURI 63132
 DANIEL A. HOWELL, PROFESSIONAL ENGINEER, LICENSE NO. 2011015754


SAINT LOUIS COUNTY HIGHWAYS & TRAFFIC PUBLIC WORKS
 SHERYL L. HODGES, D.E., P.E., LPG Director

MASON ROAD BRIDGE NO. 211 OVER SMITH CREEK
 END BENT NO. 2
 PLAN & ELEVATION

DESIGNED: D.A. HOWELL
 DRAWN: D.A. HOWELL
 CHECKED: P.R. THEBEAU
 SHEET SEQUENCE: 42 OF 57

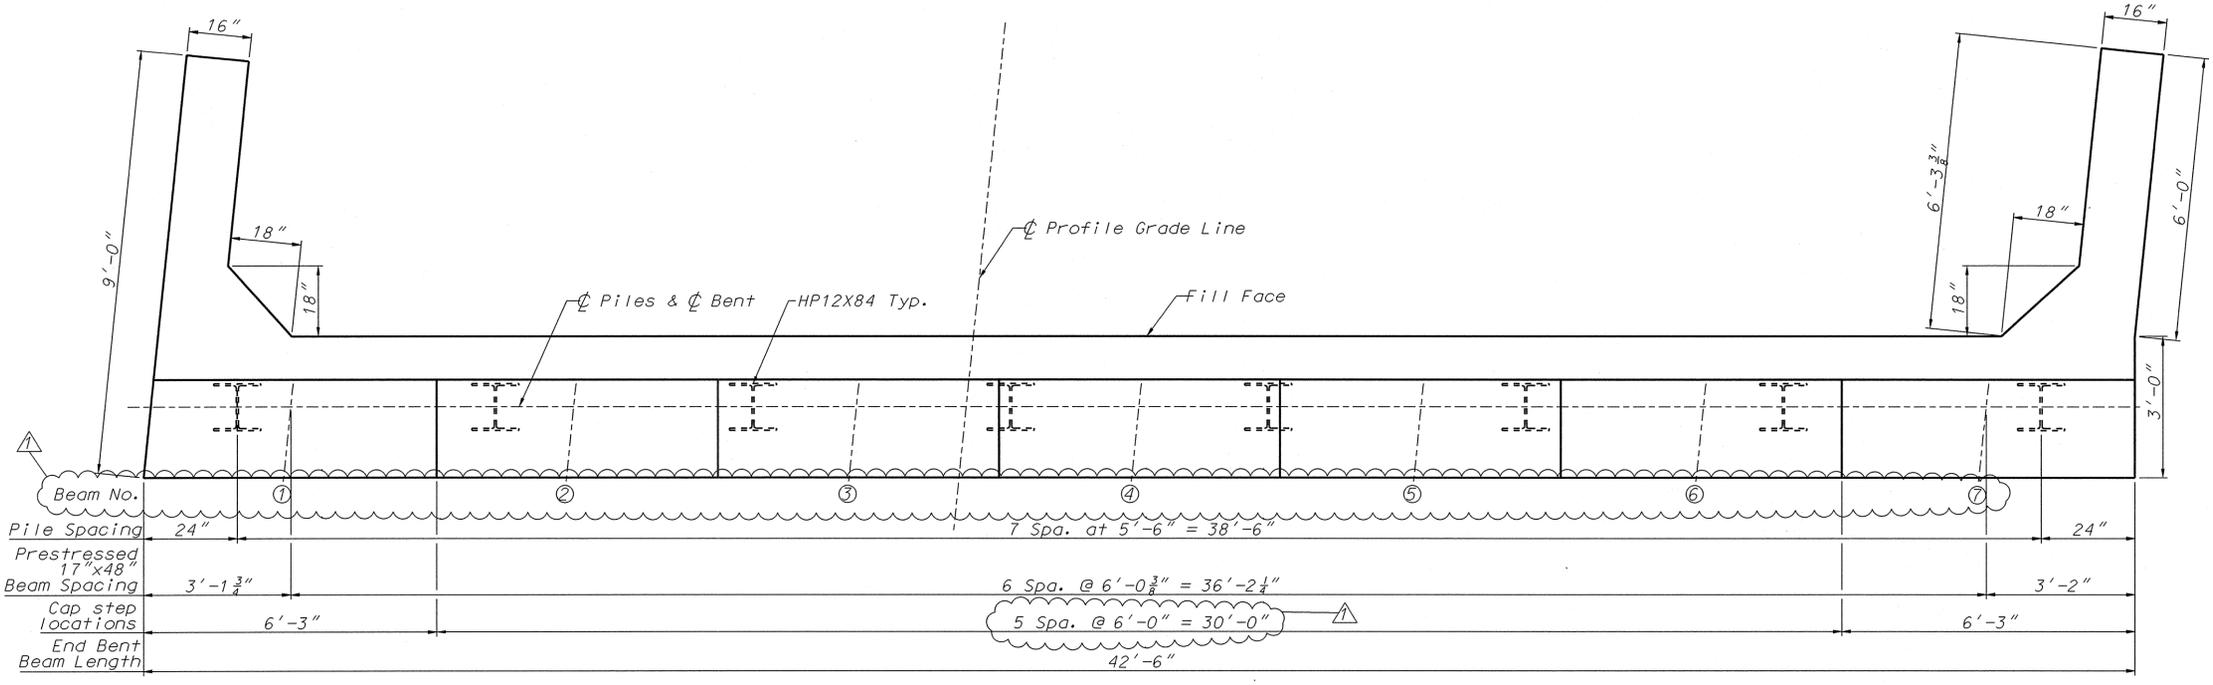


PLAN

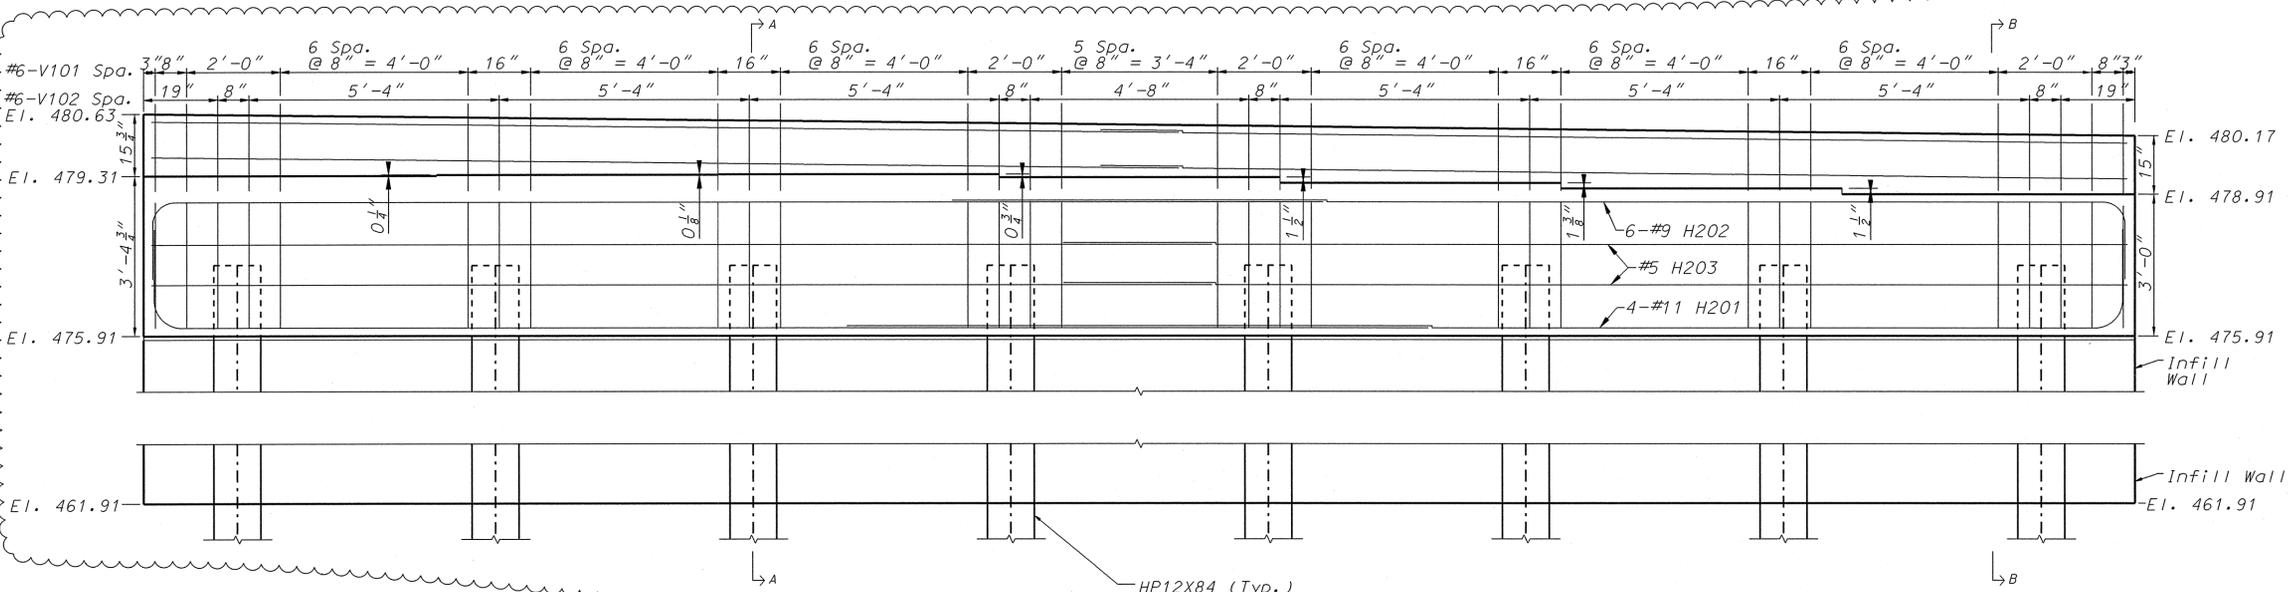



ELEVATION

BAR SIZE	LAP LENGTH (IN.)
#4	20
#5	39
#9	96
#11	150


Notes:
 1) See Bridge Sheet 8 for wing wall and infill wall details
 2) Longitudinal bars indicate lap splicing as shown.
 Contractor has option to provide single continuous bar if available for the lengths shown.

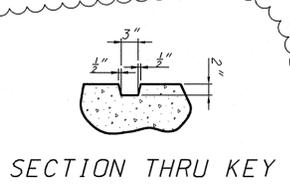


Updated for Superelevation

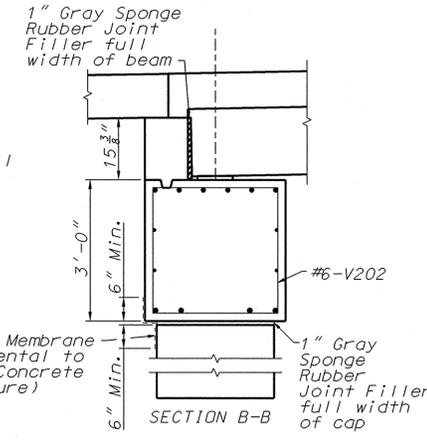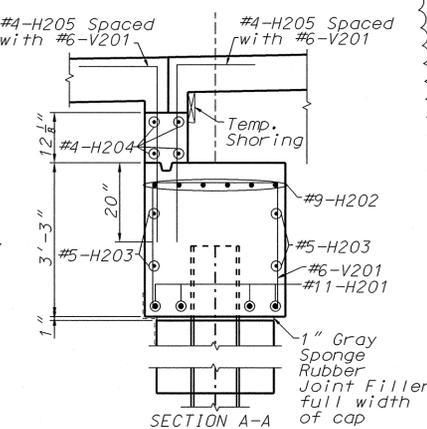


Note: Refer to Section A-A for reinforcing not shown

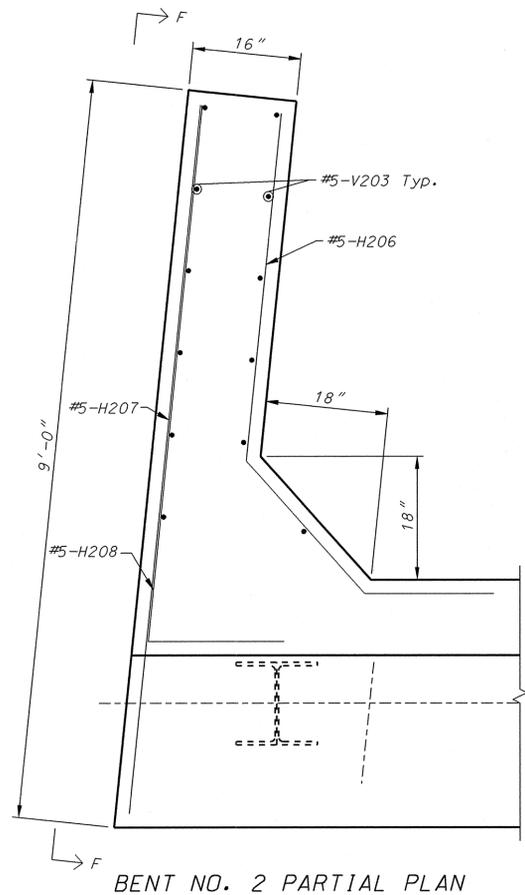

BENT NO. 2 PARTIAL PLAN

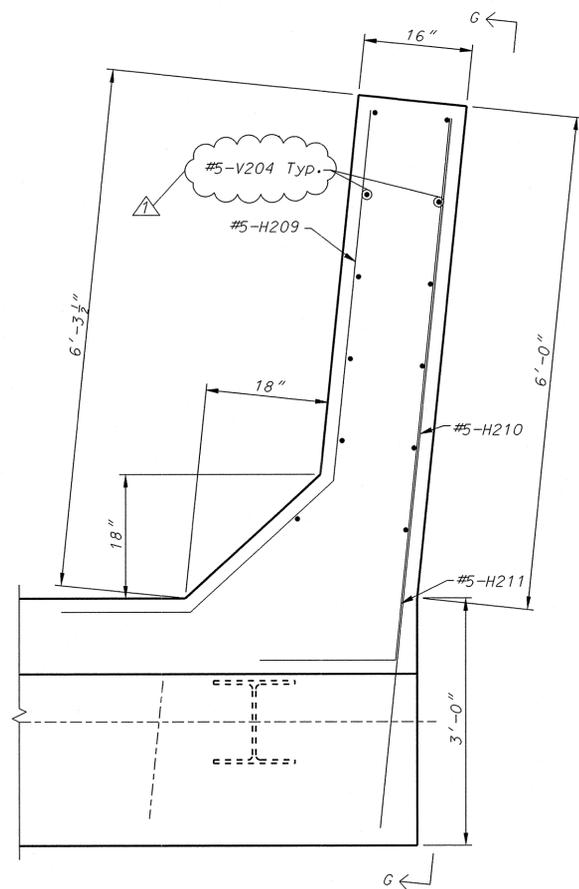


BENT NO. 2 PARTIAL PLAN

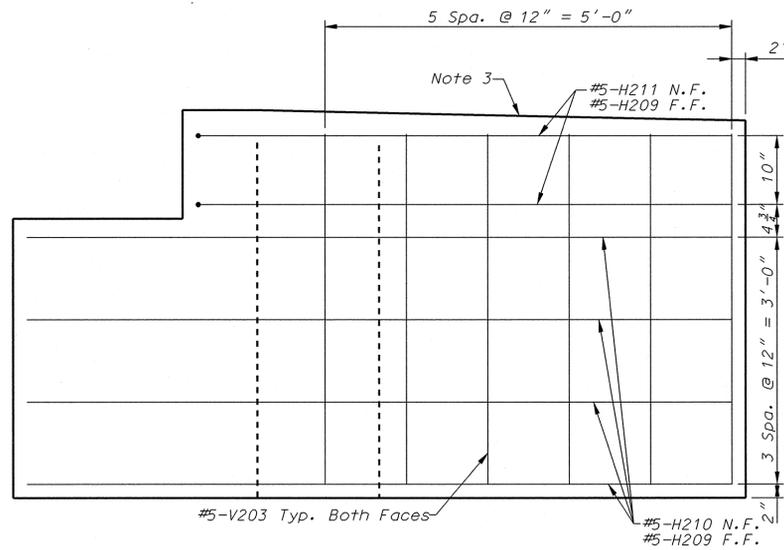


NOTES:
 1. Stem reinforcement not shown for clarity
 2. N.F. = Near Face
 F.F. = Far Face
 3. Top of wing wall shall match longitudinal grade at bottom of approach slab.

VIEW G-G

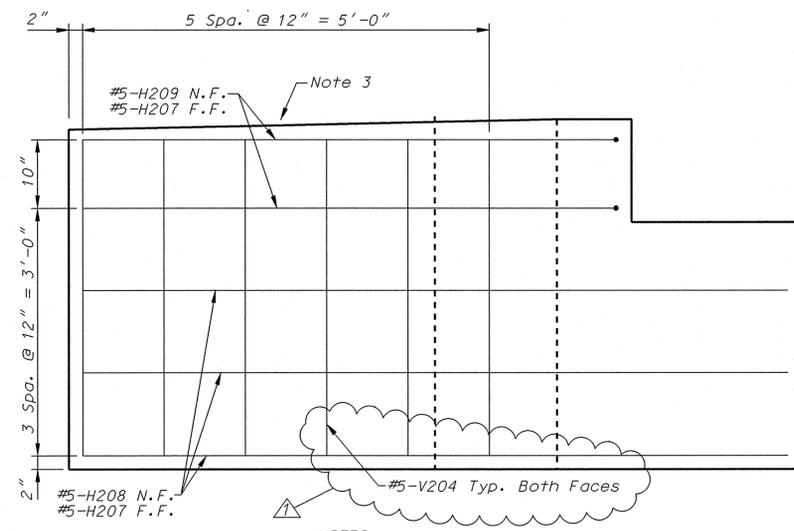


NOTES:
 1. Stem reinforcement not shown for clarity
 2. N.F. = Near Face
 F.F. = Far Face
 3. Top of wing wall shall match longitudinal grade at bottom of approach slab.

VIEW F-F

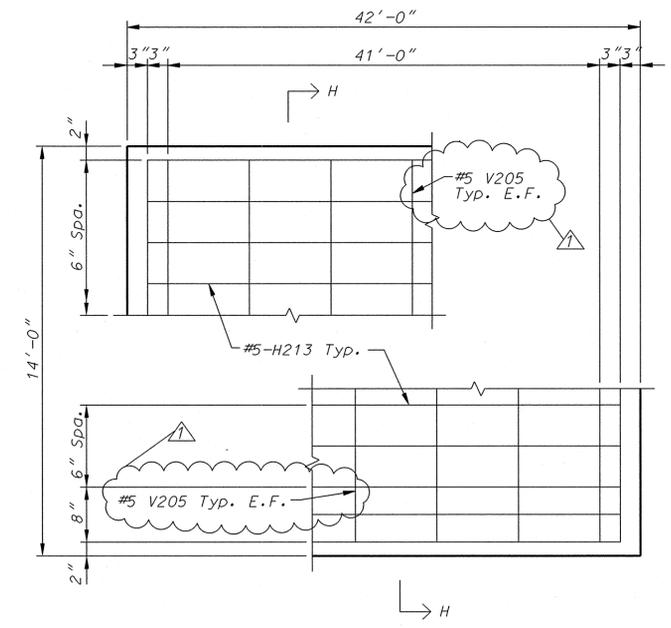

IN-FILL WALL ELEVATION

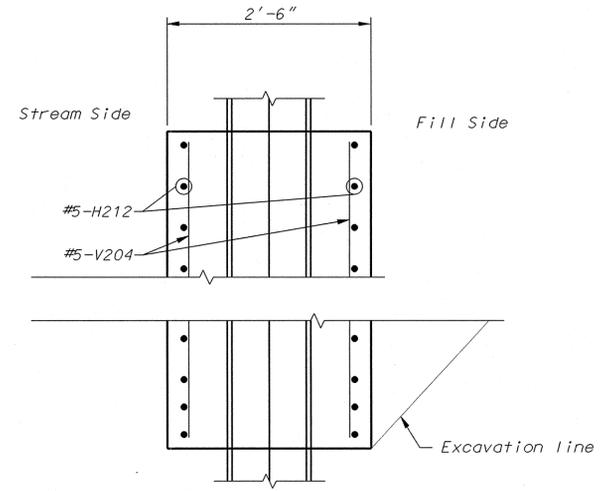

Notes:
 1. Temporary stream diversion may be required for in-fill wall construction. Refer to Bridge Sheet No. 4 of 20.

SECTION H-H

COUNTY PROJECT NO.	AR-1133
FEDERAL PROJECT NO.	STP-5574(604)
E-W GATEWAY TIP NO.	5808-13
MSD:	P-29044-00
MSD BASE MAP:	18P1
REVISIONS	DESCRIPTION
REV. DATE	BY APP. DAH PRT
1	10/20/14
	ADDENDUM NO. 2

DISCLAIMER OF LIABILITY: I, the undersigned, hereby certify that the documents intended to be authorized by my seal are those of my own design, and I hereby disclaim any responsibility for all other drawings, specifications, documents or instruments relating to or intended to be used for any part of the engineering project or survey.



DATE: 20-OCT-2014

PREPARED BY:
 DESIGN DIVISION
 1050 N. 1ST FLOOR
 CREVE COEUR, MISSOURI 63132
 (314) 615-8543
 DANIEL A. HOWELL
 PROFESSIONAL ENGINEER
 LICENSE NO. 2011015754

St. Louis County
COUNTY
 HIGHWAYS & TRAFFIC
 PUBLIC WORKS
 Sheryl L. Hodges, D.E., P.E., LPG
 Director

MASON ROAD
 BRIDGE NO. 211
 OVER SMITH CREEK
 END BENT NO. 2
 WING WALL &
 IN-FILL WALL DETAILS

DESIGNED: D.A. HOWELL

DRAWN: D.A. HOWELL

CHECKED: P.R. THEBEAU


SHEET SEQUENCE:
 43 OF 57

THIS DRAWING IS NOT TO SCALE, FOLLOW DIMENSIONS

BRIDGE SHEET NO.
 8 OF 20


ST. LOUIS COUNTY BRIDGE NO.
 211

MODOT BRIDGE NO.
 096B2111

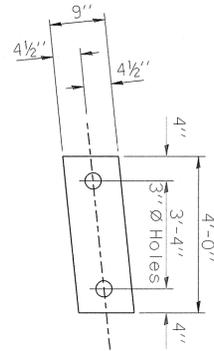

1" THICK ELASTOMERIC BEARING PAD

The cost of all fabric bearing pads shall be considered completely covered by the cost of the 17" x 48" Deck Beams.

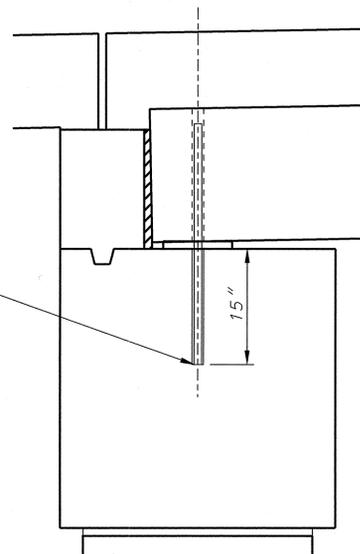


1"Ø x 2'-7" dowel rod in 1 1/2"Ø holes drilled into cap (2 per beam)

SECTION THROUGH END BENT AT GIRDER


Note:
Dowel rods to be epoxied to depth shown as per Job Special Provision 700.40.2.

THEORETICAL CAST-IN-PLACE SLAB + HAUNCH THICKNESS (at ℓ of girder)

	(ℓ brg - ℓ brg.)				
	ℓ brg.	.25	.50	.75	ℓ brg.
Girder no. 1	9 7/8"	8 1/2"	8"	8 1/2"	9 7/8"
Girder no. 2	9 7/8"	8 1/2"	8"	8 1/2"	9 7/8"
Girder no. 3	9 7/8"	8 1/2"	8"	8 1/2"	9 7/8"
Girder no. 4	9 7/8"	8 1/2"	8"	8 1/2"	9 7/8"
Girder no. 5	9 7/8"	8 1/2"	8"	8 1/2"	9 7/8"
Girder no. 6	9 7/8"	8 1/2"	8"	8 1/2"	9 7/8"
Girder no. 7	9 7/8"	8 1/2"	8"	8 1/2"	9 7/8"

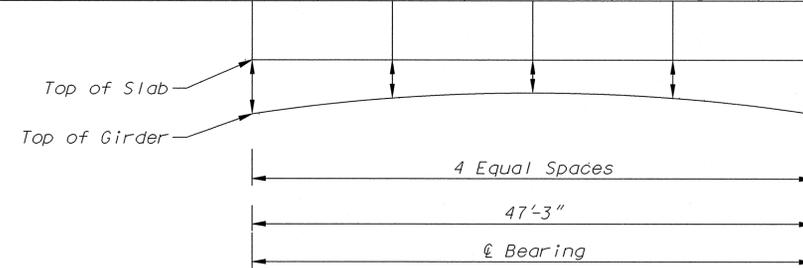

THEORETICAL CAST-IN-PLACE OVERLAY THICKNESS DIAGRAM

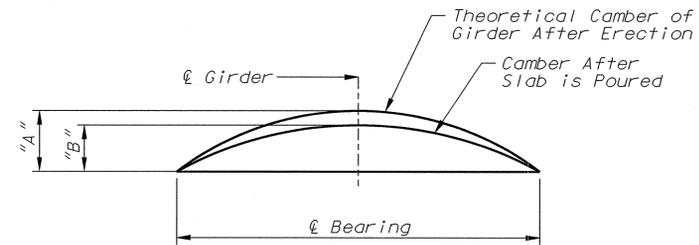

"A"	"B"
2 1/8"	1 1/8"

GIRDER CAMBER DIAGRAM

THEORETICAL TOP OF GIRDER ELEVATIONS (at ℓ of girder prior to forming slab/sidewalk)

	(ℓ brg - ℓ brg.)				
	ℓ brg.	.25	.50	.75	ℓ brg.
Girder no. 1	481.41	481.35	481.23	481.05	480.81
Girder no. 2	481.29	481.25	481.17	481.02	480.82
Girder no. 3	481.16	481.17	481.11	481.01	480.84
Girder no. 4	481.04	481.06	481.02	480.93	480.77
Girder no. 5	480.91	480.93	480.89	480.80	480.65
Girder no. 6	480.79	480.81	480.77	480.68	480.53
Girder no. 7	480.66	480.69	480.65	480.56	480.41



COUNTY PROJECT NO. **AR-1133**
 FEDERAL PROJECT NO. **STP-5574(604)**
 E-W GATEWAY TIP NO. **5808-13**
 MSD: **P-0029044-00**
 MSD BASE MAP: **18P1**

REV.	DATE	BY	APP.	DESCRIPTION	
				ADDENDUM NO.	NO.
1	10/20/14	DAH	PRT		

DISCLAIMER OF LIABILITY: I hereby certify that the documents intended to be authorized by my seal are my own work, and I hereby disclaim any responsibility for all other Drawings, Specifications, documents or instruments relating to or intended to be used for any part of the engineering project or survey.



DATE: **20-OCT-2014**

PREPARED BY:
 DESIGN DIVISION
 1050 N. HIGHWAY BLVD.
 1ST FLOOR
 CREVE COEUR, MISSOURI 63132
 (314) 615-8543
 DANIEL A. HOWELL
 PROFESSIONAL ENGINEER
 LICENSE NO. 2011015714

Saint Louis COUNTY
HIGHWAYS & TRAFFIC
PUBLIC WORKS
 Sheryl L. Hodges, D.E., P.E., LPG
 Director

MASONR ROAD BRIDGE NO. 211 OVER SMITH CREEK
17" X 48" PRESTRESSED CONCRETE DECK BEAM DETAILS CONTINUED

DESIGNED: **D.A. HOWELL**

DRAWN: **D.A. HOWELL**

CHECKED: **P.R. THEBEAU**

SHEET SEQUENCE: **46 OF 57**

ST. LOUIS COUNTY BRIDGE NO. **211**

BRIDGE SHEET NO. **11 OF 20**

MODOT BRIDGE NO. **096B211**

REV.	DATE	BY	APP.	DESCRIPTION
1	10/21/14	DAH	PRT	ADDENDUM NO. 2

DISCLAIMER OF LIABILITY: I hereby certify that the documents intended to be authorized by my seal are my own work, and I hereby disclaim any responsibility for all other drawings, specifications, documents or instruments relating to or intended to be used for any part of the engineering project or survey.




DATE: 20-OCT-2014
 PREPARED BY: DESIGN DIVISION, 1050 N. 1ST FLOOR, CREVE COEUR, MISSOURI 63132, (314) 615-8543
 DANIEL A. HOWELL, PROFESSIONAL ENGINEER, LICENSE NO. 201015154


St. Louis COUNTY HIGHWAYS & TRAFFIC PUBLIC WORKS
 Sheryl L. Hodges, D.E., P.E., LPG Director

MASON ROAD BRIDGE NO. 211 OVER SMITH CREEK
 SLAB CROSS SECTION


DESIGNED: D.A. HOWELL
 DRAWN: D.A. HOWELL
 CHECKED: P.R. THEBEAU
 SHEET SEQUENCE: 47 OF 57

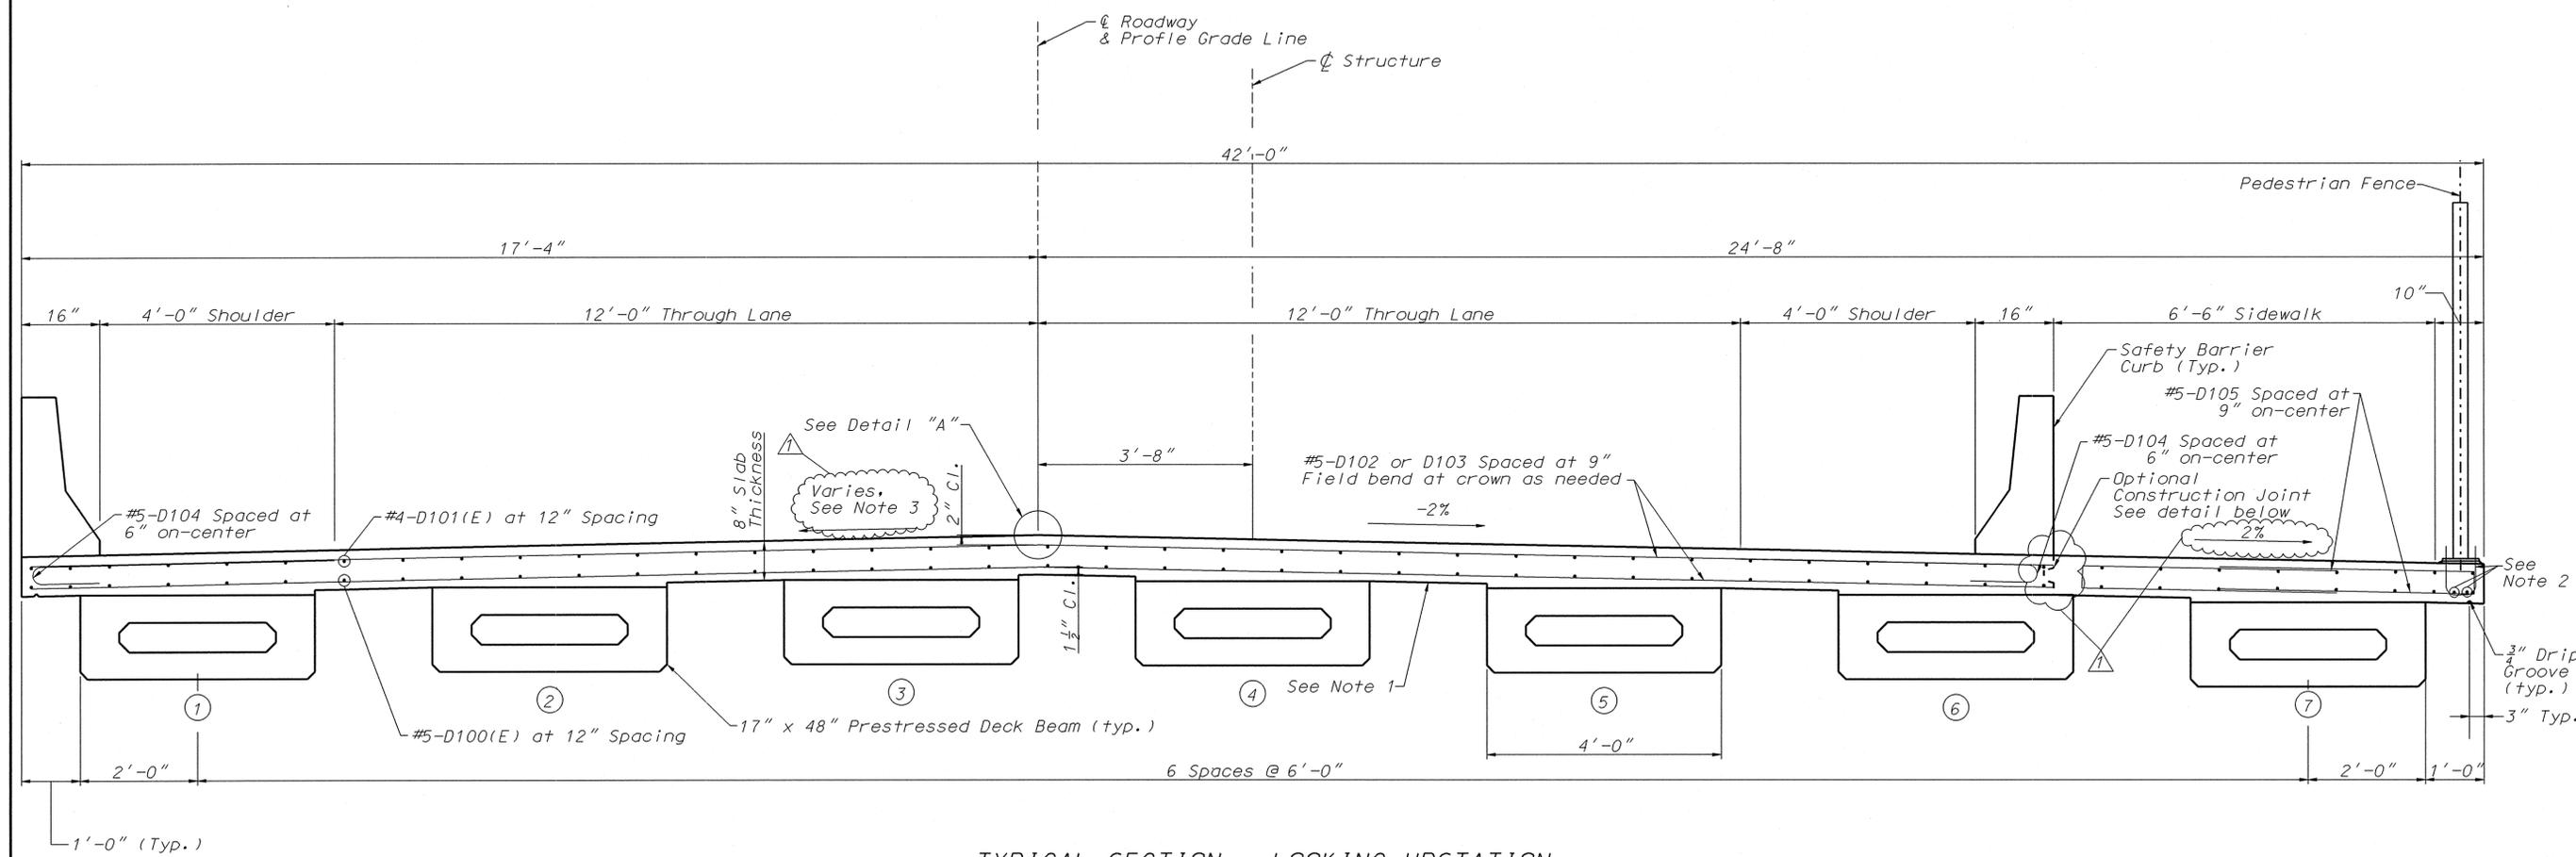

TYPICAL SECTION - LOOKING UPSTATION

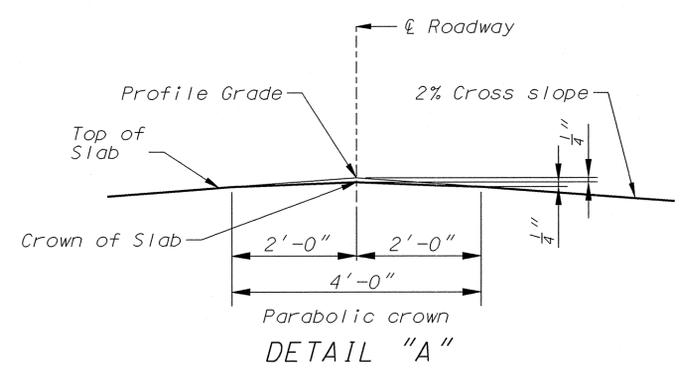

DETAIL "A"

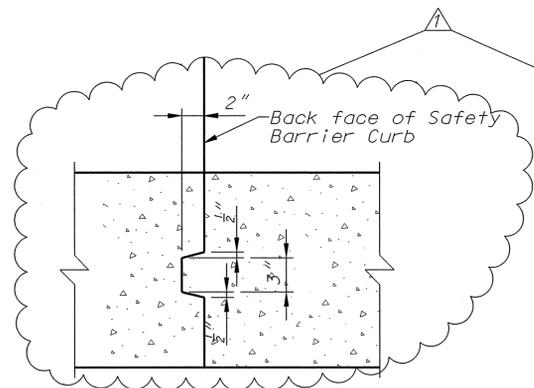

SECTION THRU KEY

- Notes:
1. Contractor shall provide temporary shoring between beams during casting of the deck.
 2. Sidewalk anchorage 'U' bars and longitudinal steel are paid for under the unit price for "Chain Link Fence on Structure", per Item 5.1, and are not included in the bar list for the deck steel.
 3. Cross slope varies from +2.04% at End Bent No. 1 to -0.27% at End Bent No. 2 measured from the crown of roadway. See Sheet 5 of 57 for Superelevation Diagram.

THIS DRAWING IS NOT TO SCALE, FOLLOW DIMENSIONS

REV.	DATE	BY	APP.	DESCRIPTION
1	10/20/14	DAH	PT	ADDENDUM NO. 2

DISCLAIMER OF LIABILITY:
I hereby specify that the documents intended to be authorized by my seal are those shown on this drawing and I hereby disclaim any responsibility for all other drawings, specifications, documents or instruments relating to or intended to be used for any part of the engineering project or survey.



DATE:
20-OCT-2014

PREPARED BY:
DESIGN DIVISION
1050 N. WASHINGTON BLVD.
CREVE COEUR, MISSOURI 63132
(314) 615-8543

DANIEL A. HOWELL
REGISTERED ENGINEER
LICENSE NO. 201015754



MASON ROAD
BRIDGE NO. 211
OVER SMITH CREEK


PLAN OF SLAB
& SLAB POURING
SEQUENCE

DESIGNED:
D.A. HOWELL


DRAWN:
D.A. HOWELL

CHECKED:
P.R. THEBEAU

SHEET SEQUENCE:
48 OF 57

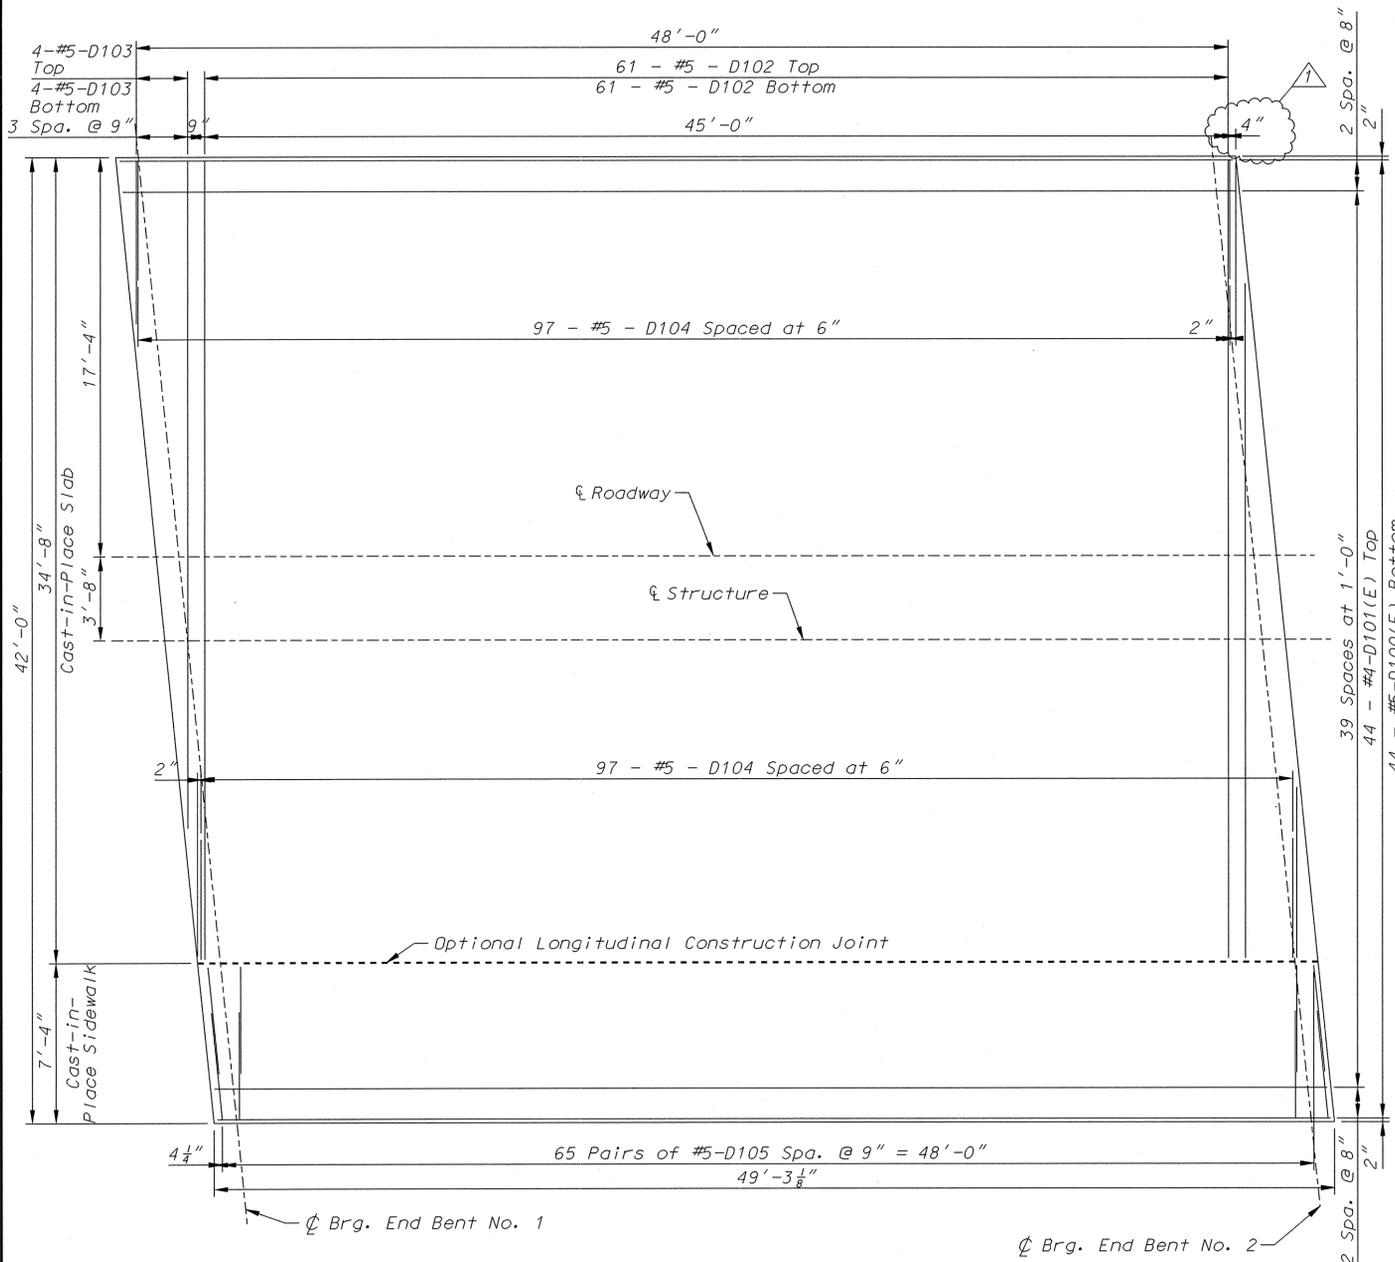

REINFORCED CONCRETE SLAB PLAN

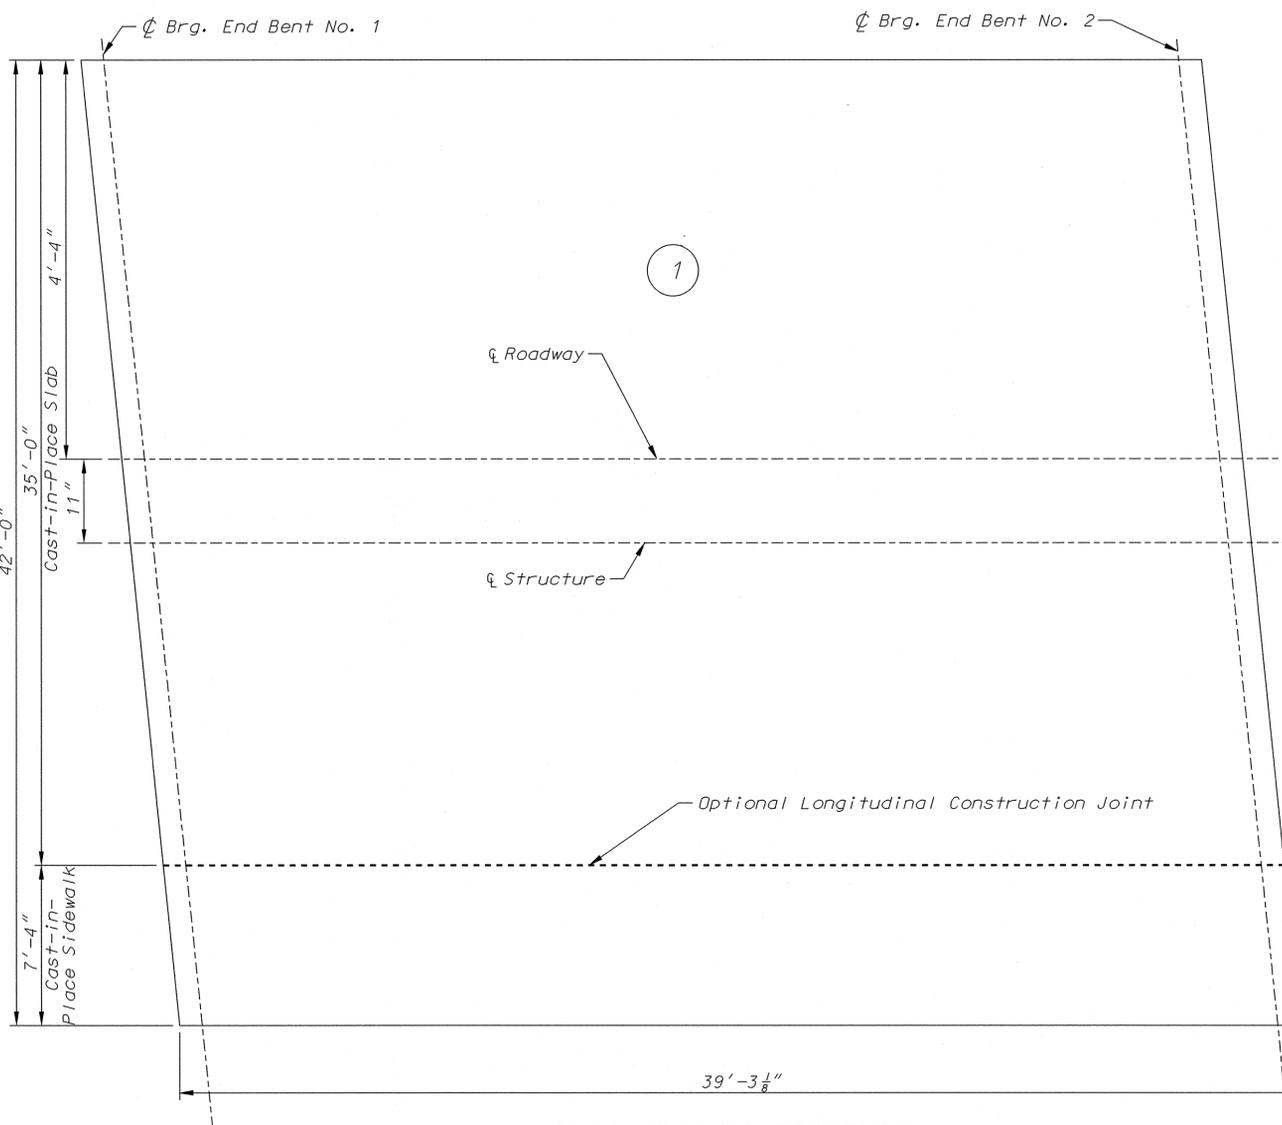

SLAB POURING SEQUENCE

	Sequence of Pours		Min. rate of pour cu. yds./hr.	
	Direction		With retarder	No retarder
	1		25	--
Basic sequence	Either direction		25	--

REV	DATE	BY	APP.	DESCRIPTION
1	10/20/14	DAH	PRT	ADDENDUM NO. 2

DISCLAIMER OF LIABILITY: I hereby specify that the documents intended to be authorized by my seal are my own work and I hereby disclaim any responsibility for all other drawings, specifications, documents or instruments relating to or intended to be used for any part of the engineering project on survey.



DATE: 20-OCT-2014


PREPARED BY: DESIGN DIVISION, 1050 N. UNIVERSITY BLVD., 1ST FLOOR, CREVE COEUR, MISSOURI 63132, (314) 616-8543
 DANIEL A. HOWELL, LICENSE NO. 2011018754



MASON ROAD BRIDGE NO. 211 OVER SMITH CREEK
 CONCRETE BARRIER & GUARDRAIL PLAN AND LAYOUT


DESIGNED: D.A. HOWELL
 DRAWN: D.A. HOWELL
 CHECKED: P.R. THEBEAU

SHEET SEQUENCE: 50 OF 57

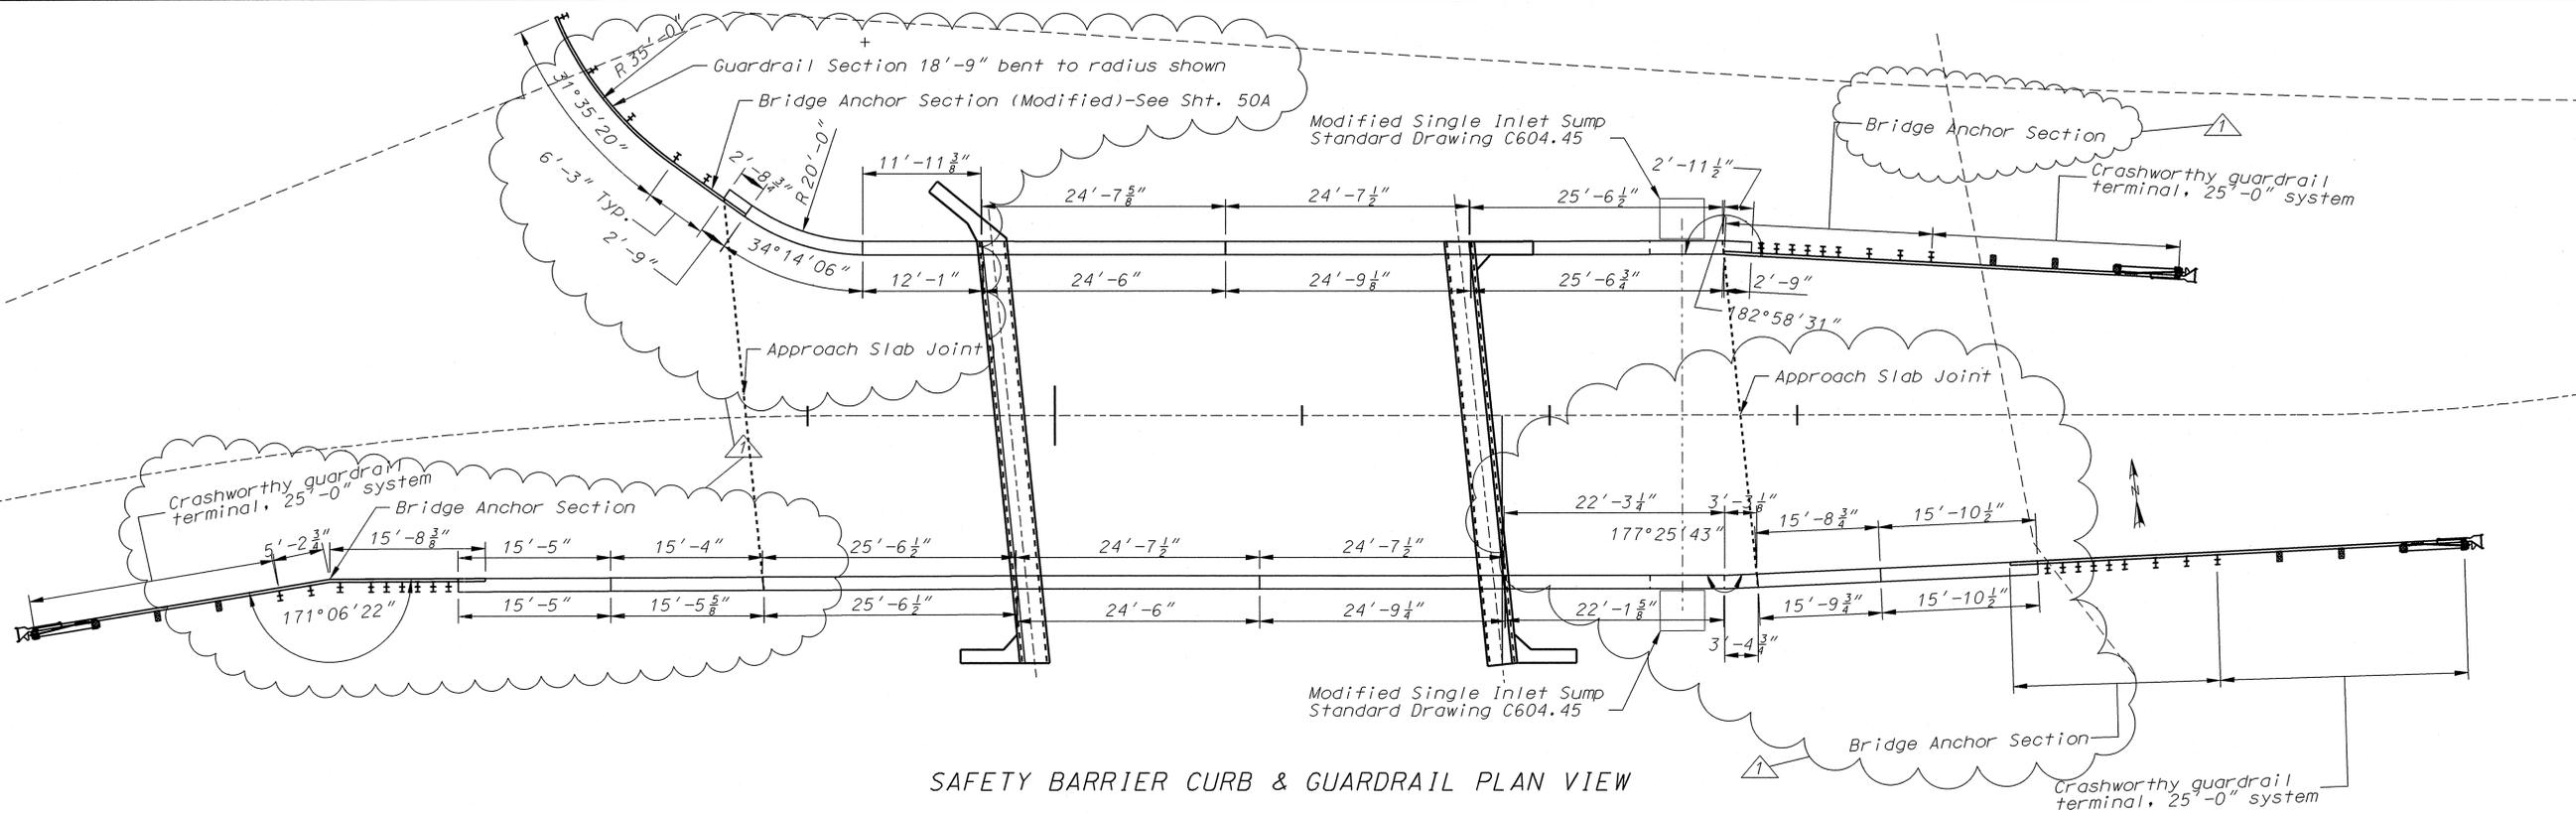


SAFETY BARRIER CURB & GUARDRAIL PLAN VIEW

NOTES:
 1. Bridge Anchor Section is detailed on Std. Drawing C606.22.
 2. Crashworthy guardrail terminal, 25'-0" system is detailed on Std. Drawing C606.33.

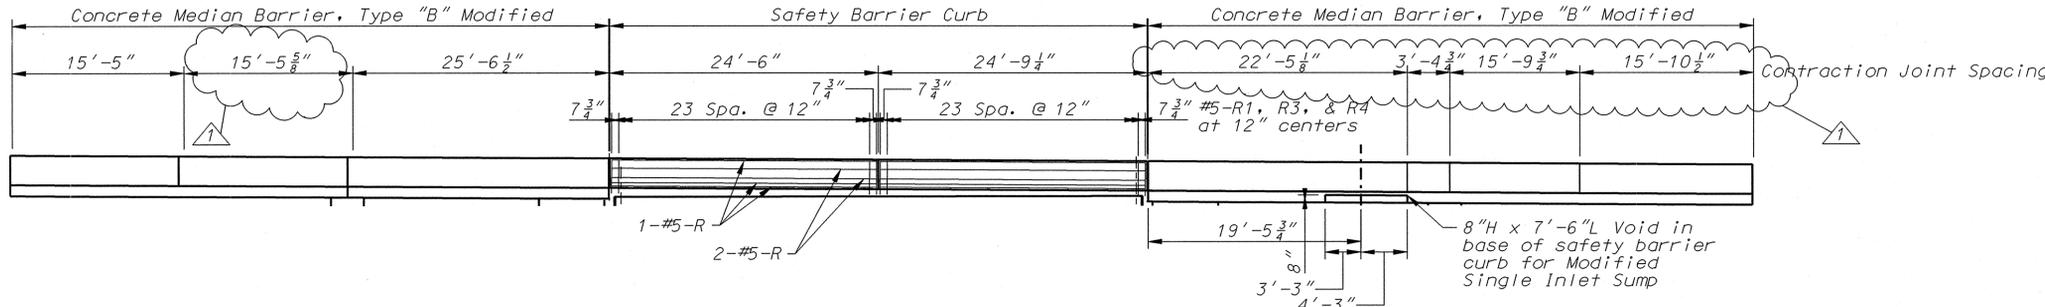


CONCRETE RAIL - SOUTH ELEVATION

NOTE:
 Refer to MoDOT Std. 617.10H "Permanent Concrete Traffic Barrier at MSE Wall Type B Modified" for Concrete Median Barrier, Type "B" Modified reinforcing steel

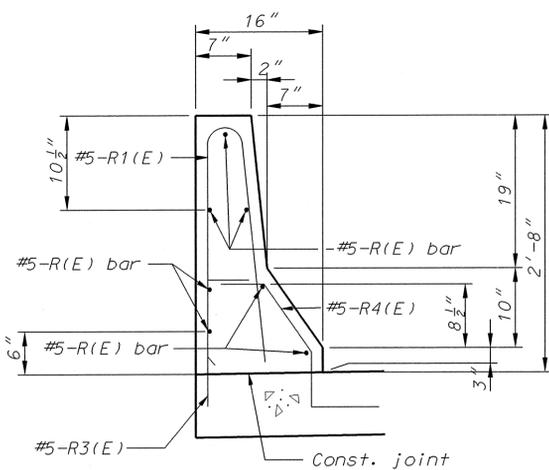


SAFETY BARRIER CURB REINFORCING

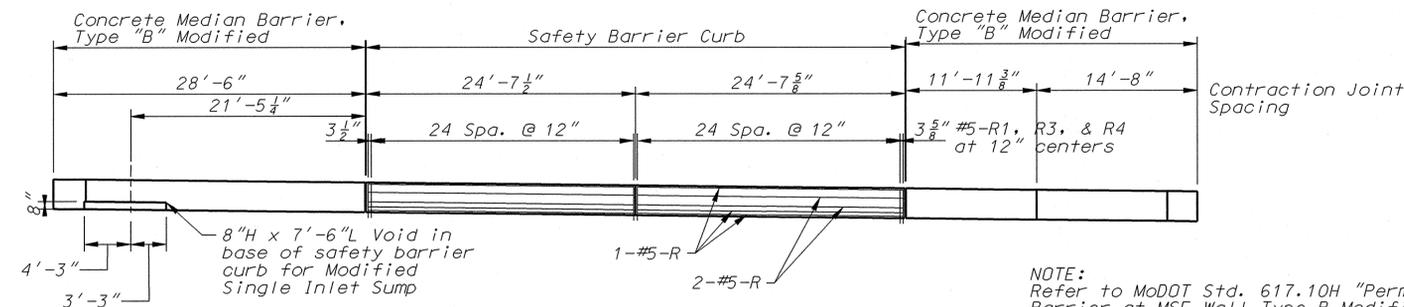





CONCRETE RAIL - NORTH ELEVATION

NOTE:
 Refer to MoDOT Std. 617.10H "Permanent Concrete Traffic Barrier at MSE Wall Type B Modified" for Concrete Median Barrier, Type "B" Modified reinforcing steel

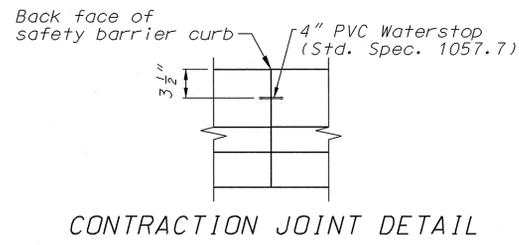

CONTRACTION JOINT DETAIL

THIS DRAWING IS NOT TO SCALE, FOLLOW DIMENSIONS

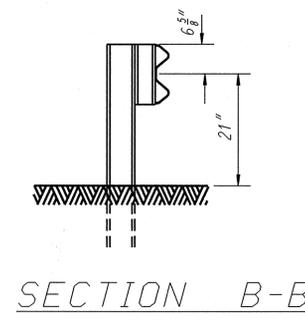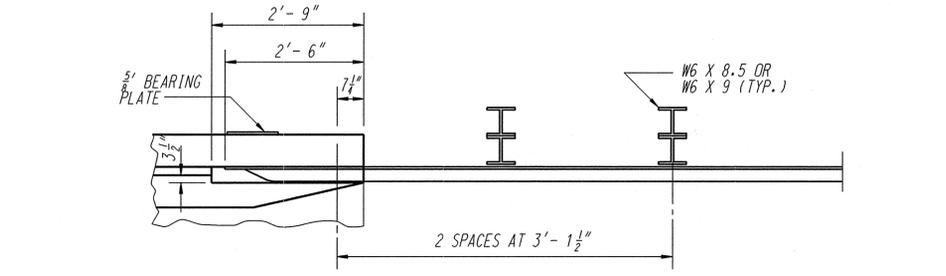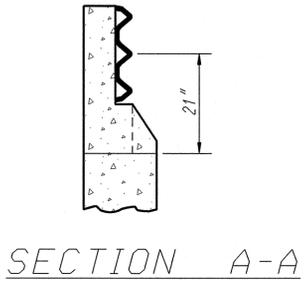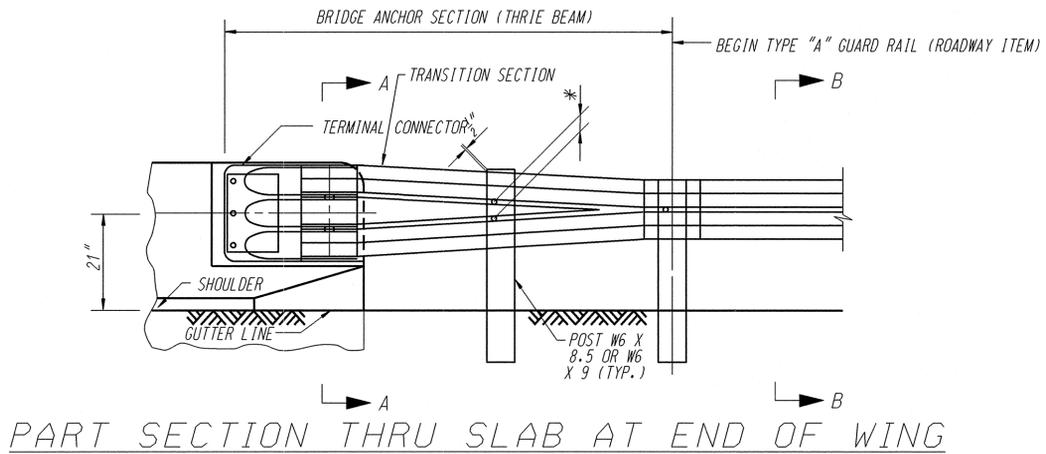

GENERAL NOTES

- Do not scale drawing. Follow dimensions.
- The Thrie Beam Rail, Terminal Connector and Transition Section for the Bridge Anchor Section shall be made of steel and shall be 12 gage. Zinc coating shall be Type 2.
- For protective coating and material requirements, see Section 1040 of the Saint Louis County Standard Specifications.
- Rail posts shall be set perpendicular to the roadway profile grade and vertically in cross section.
- Washers shall be used at all post bolts (between bolt head and beam). They shall be rectangular in shape (3" x 1 3/4" x 3/8" min.) and flat, or when necessary of such design as to fit the contour of the beam. Washers shall have a 1/16" x 1" slotted hole.
- Use 5/8" Button-Head, Oval Shoulder Bolts with Hex Nuts at all slots. (Thickness of Hex Nuts = 5/8").
- The Bearing Plate shall be fabricated from A36 steel and galvanized.
- ALL LAP SPLICES, INCLUDING TERMINAL CONNECTORS, SHALL BE MADE IN THE DIRECTION OF TRAFFIC.
- For Guard Rail requirements refer to the Construction Details for "Guard Rail," Standard Drawing C606.01.
- (* Verify by Rail Transition Producer.

REV	DATE	BY	APP.	DESCRIPTION
1	10/20/14	DAH	PR	ADDENDUM NO. 2

DISCLAIMER OF LIABILITY: I hereby certify that the documents intended to be authorized by my seal are my own work, and I hereby disclaim any responsibility for all other drawings, specifications, documents or instruments relating to or intended to be used for any part of the engineering project or survey.




DATE: 20-OCT-2014

PREPARED BY: DESIGN DIVISION, 1050 N. BARKER BLVD., 1ST FLOOR, CREVE COEUR, MISSOURI 63132, (314) 616-8543
 PROFESSIONAL ENGINEER


Saint Louis COUNTY HIGHWAYS & TRAFFIC PUBLIC WORKS
 Sheryl L. Hodges, D.E., P.E., LPG Director

MASON ROAD BRIDGE NO. 211 OVER SMITH CREEK
 MODIFIED BRIDGE ANCHOR SECTION


DESIGNED: D.A. HOWELL
 DRAWN: D.A. HOWELL
 CHECKED: P.R. THEBEAU
 SHEET SEQUENCE: 50A OF 57

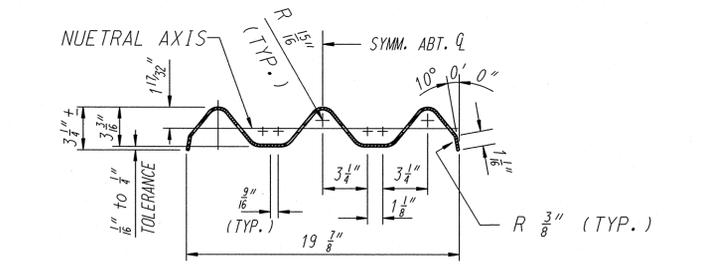


SECTION THRU THRIE BEAM RAIL

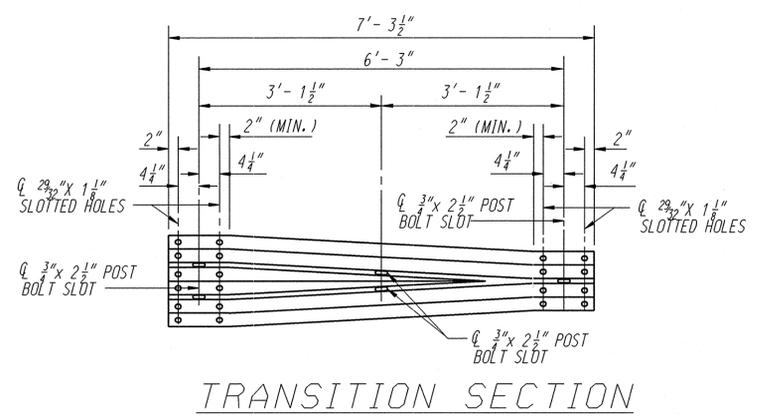


TRANSITION SECTION

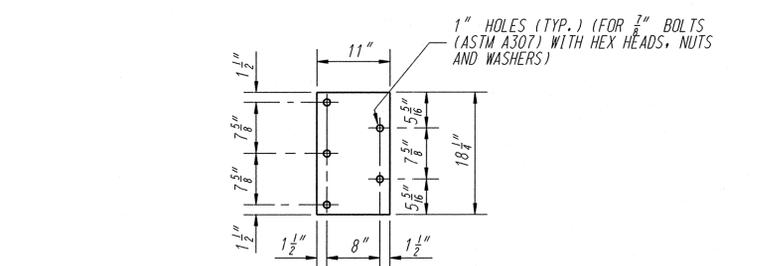

5/8" BEARING PLATE

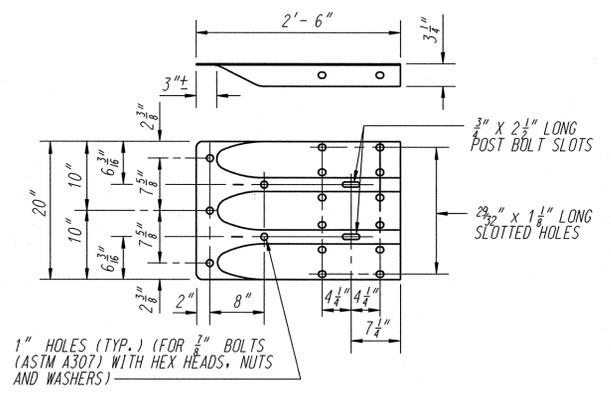

TERMINAL CONNECTOR

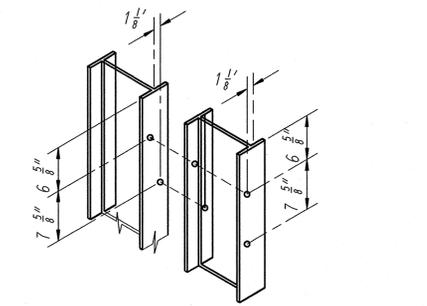

HOLE PUNCHING DETAILS (FOR STEEL POSTS & BLOCKS)

Sheet Added

COUNTY PROJECT NO.	AR-1133		
FEDERAL PROJECT NO.	STP-5574(604)		
E-W GATEWAY TIP NO.	5808-13		
MSD:	P-0029044-00		
MSD BASE MAP:	18P1		
REVISIONS			
REV. DATE	BY	APP. DAH	PR. T
1	10/20/14		

DISCLAIMER OF LIABILITY: I hereby certify that the documents intended to be authorized by my seal are my own work and I hereby disclaim any responsibility for all other drawings, specifications, documents or instruments relating to or intended to be used for any part of the engineering project or survey.



DATE: 20-OCT-2014

PREPARED BY: DESIGN DIVISION, 1050 N. DELAWARE BLVD., 1ST FLOOR, CREVE COEUR, MISSOURI 63132, (314) 615-8543

SAINT LOUIS COUNTY HIGHWAYS & TRAFFIC PUBLIC WORKS, Sheryl L. Hodges, D.E., P.E., LPG, Director


MASON ROAD BRIDGE NO. 211 OVER SMITH CREEK SAFETY BARRIER CURB SLIP FORM OPTION

DESIGNED: D.A. HOWELL

DRAWN: D.A. HOWELL

CHECKED: P.R. THEBEAU


SHEET SEQUENCE: 51 OF 57

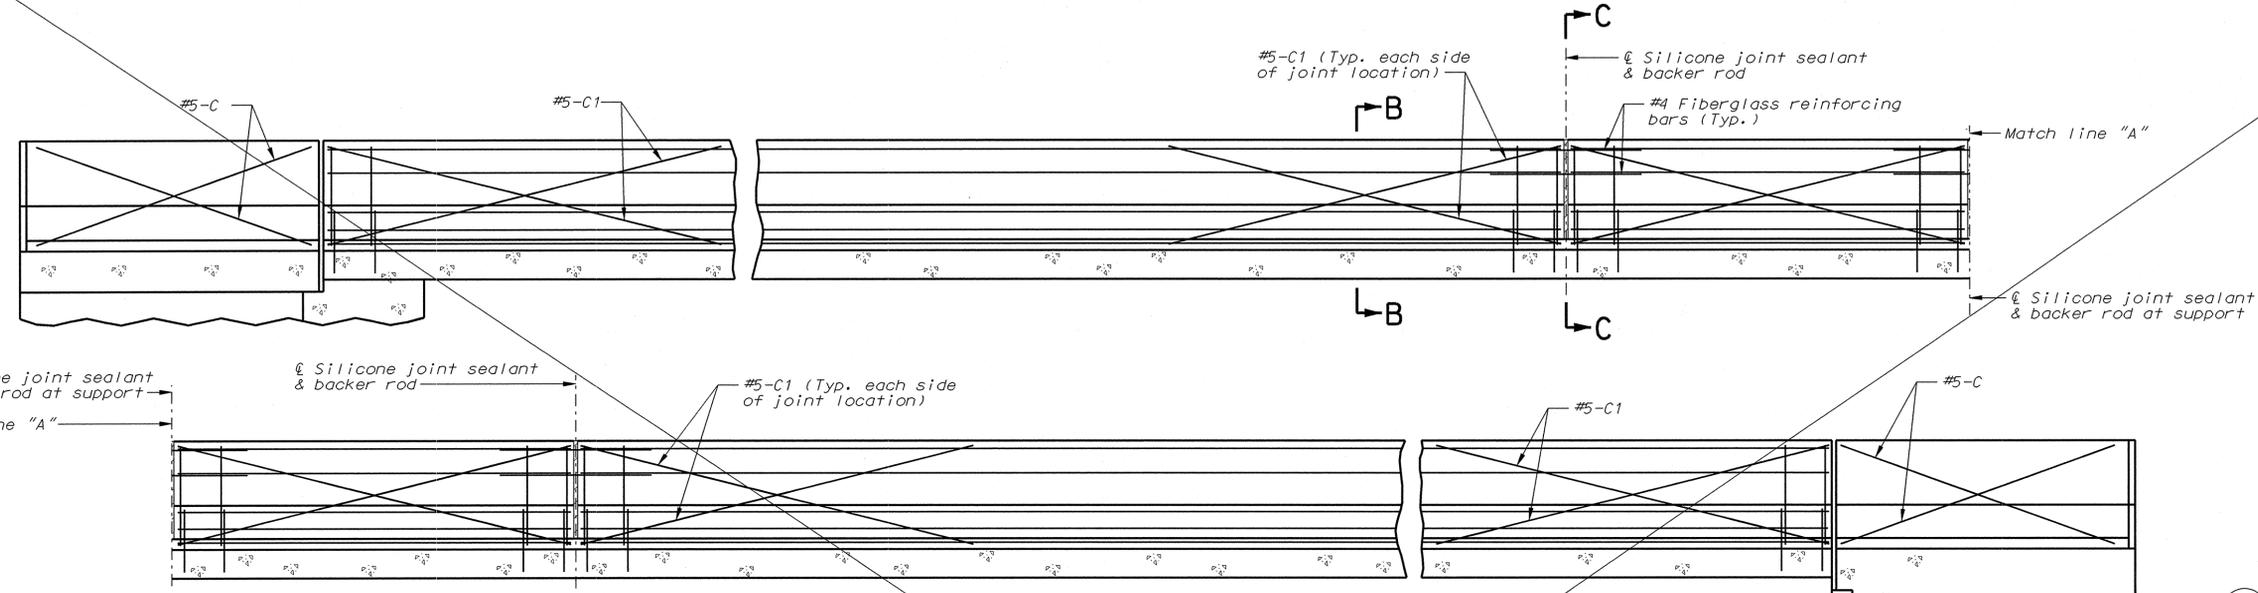

TYPICAL SECTION NEAR LEFT SAFETY BARRIER CURB AT SUPPORT LOCATIONS (OPTIONAL SLIP-FORM BRIDGE SAFETY BARRIER CURB)


Sheet Deleted

Notes:
 Top of safety barrier curb shall be built parallel to grade with barrier curb joints (except at end bents) normal to grade.
 Payment for all concrete and reinforcement, complete in place, will be considered completely covered by the contract unit price for safety barrier curb per linear foot.
 Concrete in the safety barrier curb shall be Class B-1.
 Measurement of safety barrier curb is to the nearest linear foot for each structure, measured along the outside top of slab from end of wing to end of wing.
 The curb shall be cured by application of Type 1-D or Type 2 Liquid Membrane-Forming Compound in accordance with Sec 1055. Surface sealing for concrete in accordance with Sec 703 is not required. Application of linseed oil at the contractor's expense is permitted.

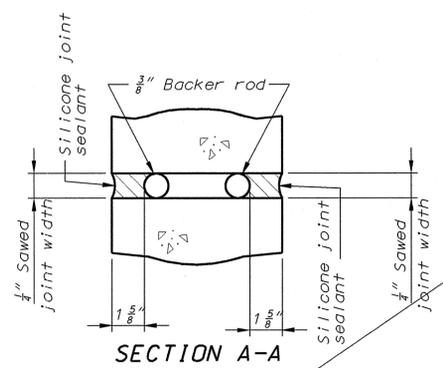


Note:
 Cost of silicone joint sealant and backer rod, complete in place, will be considered completely covered by the contract unit price for Safety Barrier Curb.


Notes:
 Joint sealant and backer rods shall be used on all slip-form barrier curbs instead of joint filler and shall be in accordance with Sec 717 for silicone joint sealant for saw cut and formed joints.
 Plastic waterstop shall not be used with slip-form option.
 C Bars (Slip-form option only) shall be used in addition to cast-in-place conventional forming reinforcement for bridge safety barrier curb.
 For Slip-Form option, all sides of the safety barrier curb shall have a vertically broomed finish and the curb top shall have a transversely broomed finish.
 Concrete traffic barrier delineators shall be placed on top of the safety barrier curb as shown on Missouri Standard Plans 617.10 and in accordance with Sec 617. Delineators on bridges with two-lane, two-way traffic shall have retroreflective sheeting on both sides. Concrete traffic barrier delineators will be considered completely covered by the contract unit price for "Safety Barrier Curb".
 Joints will be required every 10 feet for slip form barrier option. Contractor is responsible for modifications to reinforcement steel for the extra joint locations.

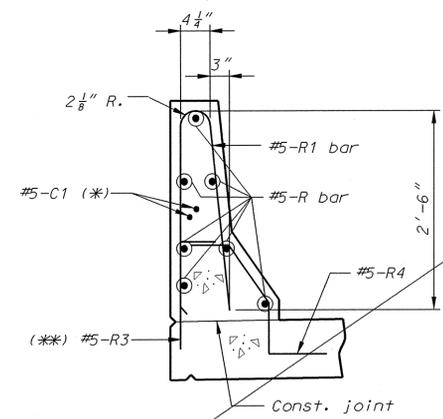


Notes: PART SECTION B-B
 (*) Each side of joint location.
 (***) The R3 bar and #5 bottom transverse slab bar in cantilever (P/S panels only) combination may be furnished as one bar at the contractor's option.

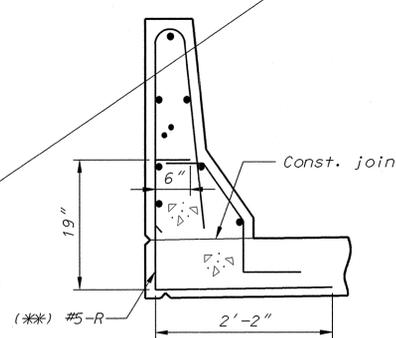


PART SECTION B-B (Optional #5-R bar shown)

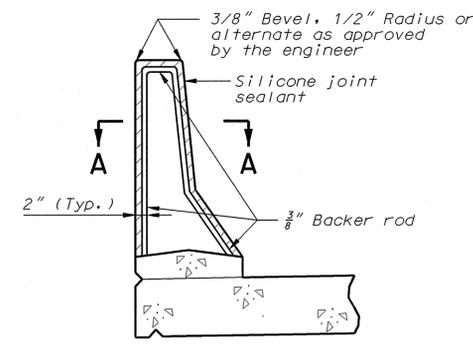

SECTION THRU JOINT

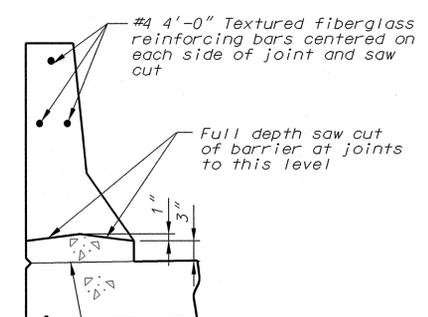

PART SECTION C-C

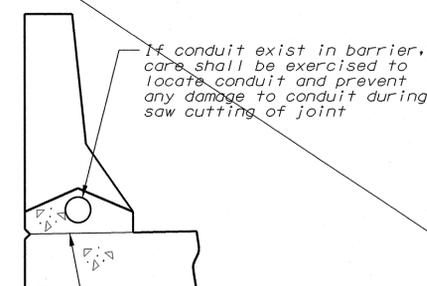

PART SECTION C-C (Use when conduit required)

OPTIONAL SLIP-FORM BRIDGE SAFETY BARRIER CURB (Left barrier curb shown, right barrier curb similar.)

THIS DRAWING IS NOT TO SCALE, FOLLOW DIMENSIONS

BRIDGE SHEET NO. 16 OF 20

ST. LOUIS COUNTY BRIDGE NO. 211
 MODOT BRIDGE NO. 096B211

GENERAL NOTES:

Design Specifications:
 AASHTO LRFD Bridge Design Specifications, 4th Ed., with 2008 Interims.
 Seismic Acceleration Coefficient = 0.18g
 Soil Site Class C (Very Dense Soil and Soft Rock Profile)

Construction Specifications:
 St. Louis County Standard Specifications for Highway Construction, June 1, 2013. "Sec" refers to the sections in this standard specification unless specified otherwise.

Design Loading:
 Refer to Geotechnical Report for additional details.
 Earth/Granular Backfill: Min. of 110 pcf
 Backfill min. angle of internal friction = 17 degrees
 Equivalent Fluid Pressure (Active): $47h + 0.38q$
 Equivalent Fluid Pressure (At-Rest): $68h + 0.55q$
 Where h = depth below adjacent grade (ft)
 q = surcharge load, psf
 Note: A live load surcharge will be required behind the wall for a driveway for a future residence.

Design Unit Stresses:
 Class B Concrete (Retaining Wall): $f'c = 4,000$ psi
 Reinforcing Steel (Epoxy-Coated): $f_y = 60,000$ psi
 Allowable gross bearing pressure: $Q = 5,500$ psi

TEMPORARY EXCAVATION:

Where applicable, temporary excavation slopes shall be consistent with current OSHA regulations. Soils at the site are anticipated to be classified as OSHA Type C soils. OSHA guidelines provide for temporary slopes for Type C soils to be constructed at 1 vertical on 1.5 horizontal (1V:1.5H) or flatter.

Temporary slopes left exposed could undergo sloughing and result in an unstable situation. The contractor should evaluate stability and failure consequences before open cut slopes are made. All cost to restore area, including roadway pavement, to its original condition will be the responsibility of the Contractor.

SHORING AND STAGED CONSTRUCTION


Temporary retention systems or staged construction may be required due to construction limits shown, proximity to adjacent structures, and possible utilities. If staged construction is chosen, excavation shall be limited to one day's work of excavation and wall construction.

Any cost to provide temporary retention system or staged construction will be considered as cost incidental to the excavation and construction of the retaining walls.

MSE WALL DESIGN:

Block Wall Requirements:
 Wall manufacturers and geogrid reinforcing shall be selected from Missouri Department of Transportation's pre-approved list of manufacturers.

Estimated Quantities for Small Modular Block Wall		
Item		Total
Modular Block Wall (over 4' height)	sq. ft.	2500

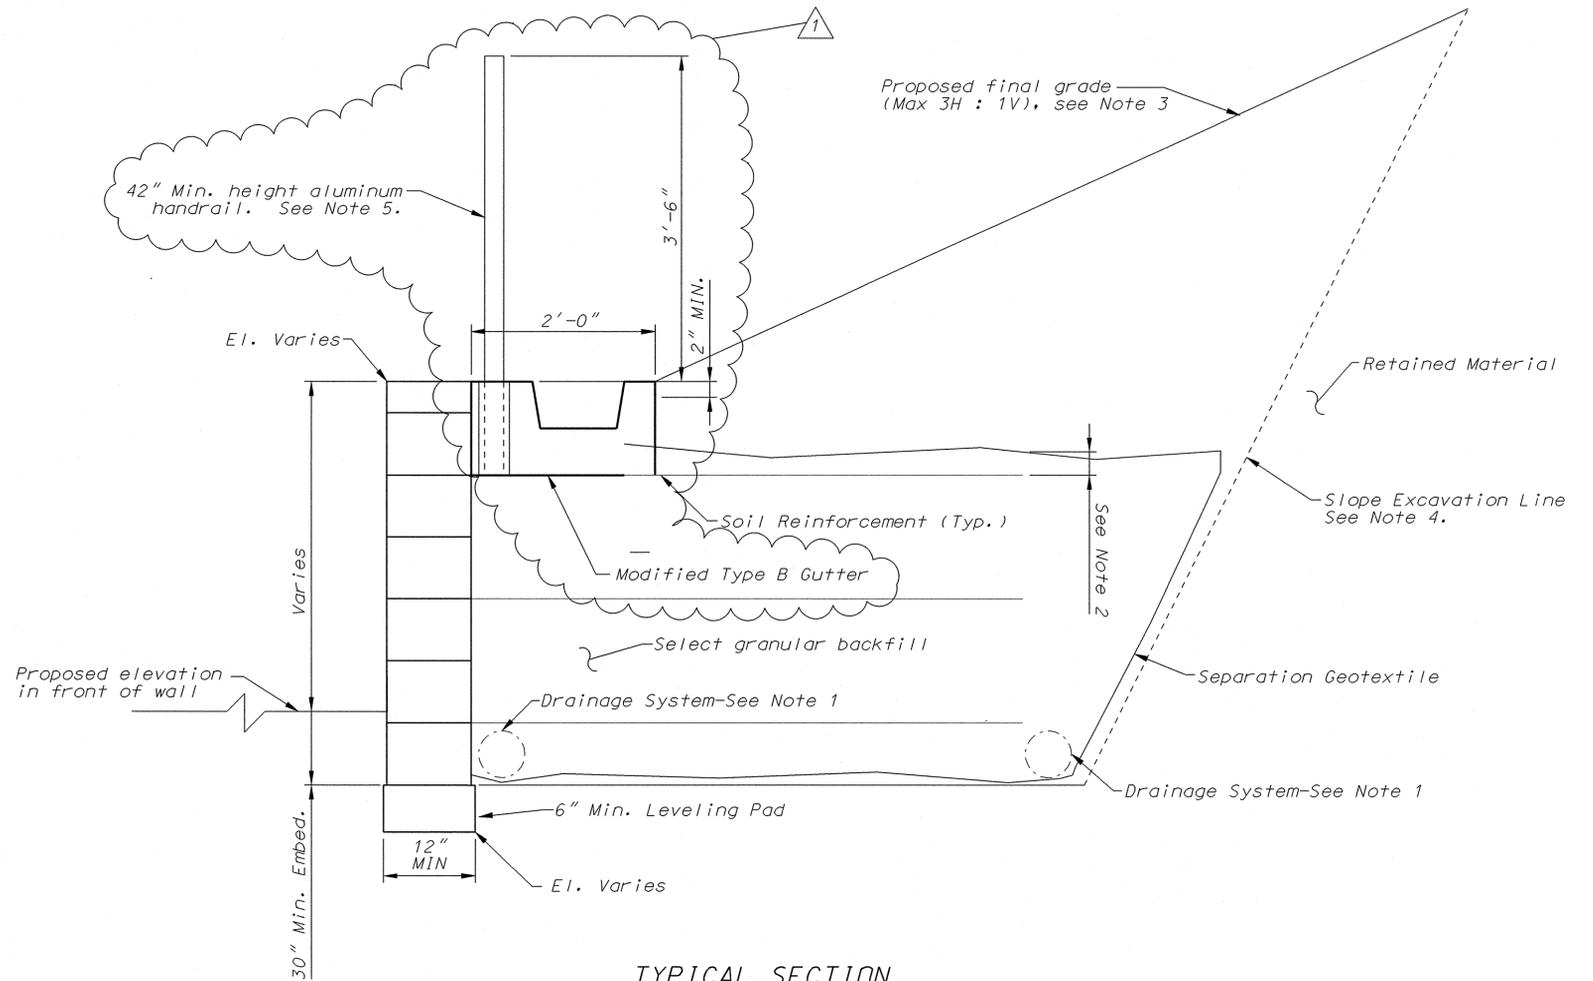

TYPICAL SECTION

- NOTE:**
1. Provide a minimum of 6" diameter perforated PVC or PE pipe unless larger size pipes are required by the wall manufacturer.
 2. Topmost layer of reinforcement shall be fully covered with select granular backfill for structural system, as approved by the wall manufacturer, before placement of the Separation Geotextile
 3. Final grade varies along length of wall. Refer to roadway drawings for additional details.
 4. Slope excavation line limited to construction limits shown on Wall Sheet 1. Temporary shoring may be required if excavation line exceeds construction limits shown.
 5. Aluminum handrail system and anchorage requirements are detailed on St. Louis County Std. Drawing C607.13. General Note 3 will be modified such that the pay item will be for "Aluminum Handrail (Structural)," bid item 607-30.25.

THIS DRAWING IS NOT TO SCALE, FOLLOW DIMENSIONS

WALL SHEET NO. 2 OF 2

ST. LOUIS COUNTY BRIDGE NO.

MODOT BRIDGE NO.

COUNTY PROJECT NO. AR-1494	
FEDERAL PROJECT NO. STP-5574(604)	
E-W GATEWAY TIP NO. 5808-13	
MSD: P-0029044-00	
MSD BASE MAP: 18P1	
REVISIONS	DESCRIPTION
REV. DATE	BY APP. DAH/PRT
1	10/20/14
ADDENDUM NO. 2	
DISCLAIMER OF LIABILITY: I, the undersigned, hereby certify that the documents intended to be authorized by my seal are those of the project and I hereby disclaim any responsibility for all other drawings, specifications, documents or instruments relating to or intended to be used for any part of the engineering project or survey.	
DATE: 20-OCT-2014	
PREPARED BY:	DESIGN DIVISION 1050 N. LINDBERGH BLVD. 1ST FLOOR CREVE COEUR, MISSOURI 63132 (314) 615-8543
DANIEL A. HOWELL REGISTERED PROFESSIONAL ENGINEER LICENSE NO. 201015754	
Sheryl L. Hodges, D.E., P.E., LPG Director	
MASON ROAD BRIDGE NO. 211	RETAINING WALL GENERAL NOTES, TYP. SECTION & QUANTITIES
DESIGNED: D.A. HOWELL	
DRAWN: D.A. HOWELL	
CHECKED: P.R. THEBEAU	
SHEET SEQUENCE: 57 OF 57	