

#### ADDENDUM NO. 3 TO CONTRACT DOCUMENTS, SPECIFICATIONS AND PLANS FOR IMPROVEMENTS TO THE ST. JOSEPH ROSECRANS MEMORIAL AIRPORT ST. JOSEPH, MISSOURI MODOT PROJECT NO. 22-012A-1

To All Bidders: You are requested to make all changes and/or additions contained in this addendum to the Bidding Documents. Failure to acknowledge this Addendum in Proposal shall result in rejection of bid. Bidders are informed that the above referenced Questions with Corresponding Answers, Contract Documents, Specifications, and Plans are modified as follows as of December 2, 2022

#### CONTRACT DOCUMENTS/SPECIFICATIONS/PLANS

#### **Contract Documents:**

#### 1. <u>Contract Documents</u>

Revision: Added Missouri and Federal Prevailing Wages have been to contract documents under Section 4-43 Part D

#### 2. <u>Contract Documents</u>

Revision: Removed Section 3 60-05 entirely from Section 60 as there is no need to provide a dedicated trailer for the RPR

#### 3. <u>Contract Documents</u>

Revision: Section 4 Part C Item 2. Removed "There shall be \$1,000,000 penalty, paid to the airport, for each deviation from these security provisions" entirely from Item 2.

4. Pre-Bid Meeting Minutes and Attendee List

Revision: Added to Contract Documents.

#### Plans:

5. <u>Plans</u>

Sheet S-200

Revision: Foundation Plan Note I Updated: Exterior Perimeter Footings:  $T/FT = \underline{93'}$ 



#### 6. <u>Plans</u>

Sheet A-101 Floor Plan Revision: Revised floor perimeter linework for clarity.

#### 7. <u>Plans</u>

Sheet A-202 Building Elevations Revision: Added Sheet A-202 Building Elevations

#### 8. <u>Plans</u>

Sheet A-451 Interior Elevations Revision: Revised FEC and DEFIB locations.

#### 9. <u>Plans</u>

Sheet A-601 Door Schedule, Types, and Details Revision: Revised FEC and DEFIB locations.

#### 10. <u>Plans</u>

Sheet G-001 Vault Cover Sheet Revision: Sheet Index Updated to remove Sheet S-400.

#### **Questions:**

- 11. What is the project's Address?a) A Ave, St. Joseph MO 64503.
- 12. Is the builder's risk to be carried by the owner or contractor?a) The builder's risk is to be carried by the contractor per Section 3 Section 90.
- 13. Is this project in a flood plane or flood zone?a) The airport site is within FEMA Zone B.
- 14. What specification section outlines the project's insurance requirements?
  - a) Refer to Section 3 Section 70-11 and 70-21.



- 15. Will the electrician be responsible for all power and low voltage wiring?a) Yes.
- 16. Are DBE / Missouri Prevailing Wages Published?
  - a) All DBE Requirements can be found in Contract Documents, refer to section X. Missouri and Federal Prevailing Wages have been added to contract documents under Section 4-43 Part D.
- 17. Could you let me know if there will be any trees, shrubs, irrigation systems or any other landscaping on this project?
  - a) There are no trees, shrubs, or irrigation systems. Please see erosion control plan for limits of seeding. Please see General Notes in Enlarged Planter Plan A-531 for specialized lawn seed.
- 18. Is there any foundation wall elevations available? It appears that the foundation walls are at least 5' above grade on the elevation drawings on the architectural drawings.
  - a) The finish floor is shown correctly, the slab elevation is 100' due to the flood plane concerns.
- 19. What is the thickness of the ramp and outdoor patio concrete slabs?
  - a) Ramp and patio slabs are to be the same as the interior slab 5"
- 20. Who is responsible for providing the Defib shown on the plans?
  - a) Contractor to provide Automatic Defibrillator. Refer to revised location per Addendum 3.
- 21. Who is responsible for providing the photos for the historical wall display?
  - a) The Owner, RPR, or A&E will provide the photos for the historical display.
- 22. Is Door and Frame 018A missing from the schedule?
  - a) No, Door Schedule has been revised for clarity.
- 23. What is the thickness of the asphalt for the parking lot? It shows a 2" surface but no base thickness.
  - a) The parking lot and access road pavement sections are shown on sheet C-220, details A, B, and C. The pavement section consists of a 2-inch asphaltic surface course, over a 5-inch asphaltic base course, over 6-inches of <sup>3</sup>/<sub>4</sub>" max crushed stone, over geogrid Tensar TX-140 or approved equal. Please note that the loading dock concrete pavement section is shown in detail E on the same sheet.
- 24. Is the interim access road supposed to be paved with asphalt also? If so what thickness.
  - a) The interim interior access road pavement section is shown on sheet C-220, detail B, as 2- inch asphaltic surface course, over a 3-inch asphaltic base course, over 6-inches of <sup>3</sup>/<sub>4</sub>" max crushed stone, over geogrid Tensar TX-140 or approved equal.
- 25. Why do the parking lot demolition limits extend past the new grading plan limits?



- a) The demolition limits in the plan are correct. The intent is to give contractor room to maneuver and construct the slope.
- 26. Will there be any contractor provisions for construction power for the vault work?
  - a) There will be no provisions for the contractor for construction power for the vault work.
- 27. Can Schedule I be awarded separately than Schedule II?
  - a) No, they are planned to be awarded together for a total Phase 1 Package. Separate awards are not intended. If funding is not available however Schedule I takes precedent.
- 28. Is the contractor laydown area given exact for Schedule I?
  - a) No, it is representational. As long as employee and parking lot access is unrestricted and the contractor maintains a well-kept laydown area, it can extend beyond what is shown.
  - b) Contractor must coordinate with airport.
- 29. Please clarify the scope of work associated with the electric manhole located near the north-west corner of the new terminal building?
  - a) This manhole will be installed to intercept the existing Evergy electric line which runs under the apron and runway to supply power to facilities on the west side of the runway. Evergy will cut into the existing conduit and pull the existing conductors (from the west) into the new manhole.
  - b) New conductors will be installed by Evergy (from the east, in the contractor installed conduit) and will be spliced to the existing conductors in the new manhole. This work will need to be closely coordinated with Evergy and the airport to minimize the impact of any power outages caused by this work.

## Missouri Division of Labor Standards WAGE AND HOUR SECTION



MICHAEL L. PARSON, Governor

# **Annual Wage Order No. 29**

#### Section 011 BUCHANAN COUNTY

In accordance with Section 290.262 RSMo 2000, within thirty (30) days after a certified copy of this Annual Wage Order has been filed with the Secretary of State as indicated below, any person who may be affected by this Annual Wage Order may object by filing an objection in triplicate with the Labor and Industrial Relations Commission, P.O. Box 599, Jefferson City, MO 65102-0599. Such objections must set forth in writing the specific grounds of objection. Each objection shall certify that a copy has been furnished to the Division of Labor Standards, P.O. Box 449, Jefferson City, MO 65102-0449 pursuant to 8 CSR 20-5.010(1). A certified copy of the Annual Wage Order has been filed with the Secretary of State of Missouri.

Original Signed by Todd Smith, Director Division of Labor Standards

Filed With Secretary of State:

March 10, 2022

Last Date Objections May Be Filed: April 11, 2022

Prepared by Missouri Department of Labor and Industrial Relations

### Building Construction Rates for BUCHANAN County

	**Prevailing	
OCCUPATIONAL TITLE	Hourly	
	Rate	
Asbestos Worker	\$67.48	
Boilermaker	\$28.90*	
Bricklayer	\$56.91	
Carpenter	\$54.67	
Lather	\$34.07	
Linoleum Layer		
Millwright		
Pile Driver		
Cement Mason	\$28.90*	
Plasterer		
Communications Technician	\$28.90*	
Electrician (Inside Wireman)	\$53.90	
Electrician Outside Lineman	\$28.90*	
Lineman Operator		
Lineman - Tree Trimmer		
Groundman		
Groundman - Tree Trimmer		
Elevator Constructor	\$28.90*	
Glazier	\$28.90*	
Ironworker	\$66.31	
Laborer	\$43.28	
General Laborer	φ <del>4</del> 3.20	
First Semi-Skilled		
Second Semi-Skilled		
	¢54.40	
Mason Markla Mason	\$54.10	
Marble Mason		
Marble Finisher		
Terrazzo Worker		
Terrazzo Finisher		
Tile Setter		
Tile Finisher		
Operating Engineer	\$28.90*	
Group I		
Group II		
Group III		
Group III-A		
Group IV		
Group V		
Painter	\$40.08	
Plumber	\$65.60	
Pipe Fitter	,	
Roofer	\$53.35	
Sheet Metal Worker	\$68.44	
Sprinkler Fitter	\$28.90*	
Truck Driver	\$41.63	
Truck Control Service Driver	÷ 11.00	
Group I		
Group II Group III		
Group IV		

\*The Division of Labor Standards received fewer than 1,000 reportable hours for this occupational title. The public works contracting minimum wage is established for this occupational title using data provided by Missouri Economic Research and Information Center.

\*\*The Prevailing Hourly Rate includes any applicable fringe benefit amounts for each occupational title as defined in Section 290.210 RSMo.

## Heavy Construction Rates for BUCHANAN County

	**Prevailing
OCCUPATIONAL TITLE	Hourly
	Rate
Carpenter	\$62.33
Millwright	
Pile Driver	
Electrician (Outside Lineman)	\$28.90*
Lineman Operator	
Lineman - Tree Trimmer	
Groundman	
Groundman - Tree Trimmer	
Laborer	\$45.77
General Laborer	
Skilled Laborer	
Operating Engineer	\$55.44
Group I	
Group II	
Group III	
Group IV	
Truck Driver \$28.9	
Truck Control Service Driver	
Group I	
Group II	
Group III	
Group IV	

Use Heavy Construction Rates on Highway and Heavy construction in accordance with the classifications of construction work established in 8 CSR 30-3.040(3).

Use Building Construction Rates on Building construction in accordance with the classifications of construction work established in 8 CSR 30-3.040(2).

If a worker is performing work on a heavy construction project within an occupational title that is not listed on the Heavy Construction Rate Sheet, use the rate for that occupational title as shown on the Building Construction Rate Sheet.

\*The Division of Labor Standards received fewer than 1,000 reportable hours for this occupational title. The public works contracting minimum wage is established for this occupational title using data provided by Missouri Economic Research and Information Center.

\*\*The Prevailing Hourly Rate includes any applicable fringe benefit amounts for each occupational title as defined in Section 290.210 RSMo.

#### OVERTIME and HOLIDAYS

#### OVERTIME

For all work performed on a Sunday or a holiday, not less than twice (2x) the prevailing hourly rate of wages for work of a similar character in the locality in which the work is performed or the public works contracting minimum wage, whichever is applicable, shall be paid to all workers employed by or on behalf of any public body engaged in the construction of public works, exclusive of maintenance work.

For all overtime work performed, not less than one and one-half (1½) the prevailing hourly rate of wages for work of a similar character in the locality in which the work is performed or the public works contracting minimum wage, whichever is applicable, shall be paid to all workers employed by or on behalf of any public body engaged in the construction of public works, exclusive of maintenance work or contractual obligation. For purposes of this subdivision, **"overtime work"** shall include work that exceeds ten hours in one day and work in excess of forty hours in one calendar week; and

A thirty-minute lunch period on each calendar day shall be allowed for each worker on a public works project, provided that such time shall not be considered as time worked.

#### HOLIDAYS

January first; The last Monday in May; July fourth; The first Monday in September; November eleventh; The fourth Thursday in November; and December twenty-fifth;

If any holiday falls on a Sunday, the following Monday shall be considered a holiday.

1091	When a material or assembly is specified by "brand name or equal" and the Contractor elects to furnish the
1092	specified "or equal," the Contractor shall be required to furnish the manufacturer's certificate of compliance for
1093	each lot of such material or assembly delivered to the work. Such certificate of compliance shall clearly identify
1094	each lot delivered and shall certify as to:
1095	

- a. Conformance to the specified performance, testing, quality or dimensional requirements; and,
- 1096 1097 1098
- b. Suitability of the material or assembly for the use intended in the contract work.
- 1100 The RPR shall be the sole judge as to whether the proposed "or equal" is suitable for use in the work.
- 1101

1104

1109

1111

1114

1117

1099

1102 The RPR reserves the right to refuse permission for use of materials or assemblies on the basis of certificates of 1103 compliance.

1105 **60-04 PLANT INSPECTION**. The RPR or their authorized representative may inspect, at its source, any 1106 specified material or assembly to be used in the work. Manufacturing plants may be inspected from time to time 1107 for the purpose of determining compliance with specified manufacturing methods or materials to be used in the 1108 work and to obtain samples required for acceptance of the material or assembly.

- 1110 Should the RPR conduct plant inspections, the following conditions shall exist:
- 1112**a.** The RPR shall have the cooperation and assistance of the Contractor and the producer with whom1113the Contractor has contracted for materials.
- 1115b.The RPR shall have full entry at all reasonable times to such parts of the plant that concern the<br/>manufacture or production of the materials being furnished.
- 1118c.If required by the RPR, the Contractor shall arrange for adequate office or working space that may be1119reasonably needed for conducting plant inspections. Place office or working space in a convenient1120location with respect to the plant.
- 1121

1122 It is understood and agreed that the Owner shall have the right to retest any material that has been tested and 1123 approved at the source of supply after it has been delivered to the site. The RPR shall have the right to reject only 1124 material which, when retested, does not meet the requirements of the contract, plans, or specifications

1125

1148 60-06 STORAGE OF MATERIALS. Materials shall be stored to assure the preservation of their quality and fitness for the work. Stored materials, even though approved before storage, may again be inspected prior to their 1149 use in the work. Stored materials shall be located to facilitate their prompt inspection. The Contractor shall 1150 coordinate the storage of all materials with the RPR. Materials to be stored on airport property shall not create an 1151 obstruction to air navigation nor shall they interfere with the free and unobstructed movement of aircraft. Unless 1152 otherwise shown on the plans and/or CSPP, the storage of materials and the location of the Contractor's plant 1153 and parked equipment or vehicles shall be as directed by the RPR. Private property shall not be used for storage 1154 1155 purposes without written permission of the Owner or lessee of such property. The Contractor shall make all arrangements and bear all expenses for the storage of materials on private property. Upon request, the Contractor 1156 shall furnish the RPR a copy of the property Owner's permission. 1157

- 1159 All storage sites on private or airport property shall be restored to their original condition by the Contractor at 1160 their expense, except as otherwise agreed to (in writing) by the Owner or lessee of the property.
- 60-07 UNACCEPTABLE MATERIALS. Any material or assembly that does not conform to the requirements
   of the contract, plans, or specifications shall be considered unacceptable and shall be rejected. The Contractor shall
   remove any rejected material or assembly from the site of the work, unless otherwise instructed by the RPR.
- 1166 Rejected material or assembly, the defects of which have been corrected by the Contractor, shall not be returned 1167 to the site of the work until such time as the RPR has approved its use in the work.
- 60-08 OWNER FURNISHED MATERIALS. The Contractor shall furnish all materials required to
   complete the work, except those specified, if any, to be furnished by the Owner. Owner-furnished
   materials shall be made available to the Contractor at the location specified.
- 1173 All costs of handling, transportation from the specified location to the site of work, storage, and installing 1174 Owner-furnished materials shall be included in the unit price bid for the contract item in which such 1175 Owner-furnished material is used.
- 1176

1158

1161

1165

1168

1172

1177 After any Owner-furnished material has been delivered to the location specified, the Contractor shall be 1178 responsible for any demurrage, damage, loss, or other deficiencies that may occur during the Contractor's 1179 handling, storage, or use of such Owner-furnished material. The Owner will deduct from any monies due 1180 or to become due the Contractor any cost incurred by the Owner in making good such loss due to the 1181 Contractor's handling, storage, or use of Owner-furnished materials.

- 1182
- 1183 1184

1185

#### **END OF SECTION 60**

Issued for Bid November 2022 1148 60-06 STORAGE OF MATERIALS. Materials shall be stored to assure the preservation of their quality and fitness for the work. Stored materials, even though approved before storage, may again be inspected prior to their 1149 use in the work. Stored materials shall be located to facilitate their prompt inspection. The Contractor shall 1150 coordinate the storage of all materials with the RPR. Materials to be stored on airport property shall not create an 1151 obstruction to air navigation nor shall they interfere with the free and unobstructed movement of aircraft. Unless 1152 otherwise shown on the plans and/or CSPP, the storage of materials and the location of the Contractor's plant 1153 and parked equipment or vehicles shall be as directed by the RPR. Private property shall not be used for storage 1154 1155 purposes without written permission of the Owner or lessee of such property. The Contractor shall make all arrangements and bear all expenses for the storage of materials on private property. Upon request, the Contractor 1156 shall furnish the RPR a copy of the property Owner's permission. 1157

- 1159 All storage sites on private or airport property shall be restored to their original condition by the Contractor at 1160 their expense, except as otherwise agreed to (in writing) by the Owner or lessee of the property.
- 60-07 UNACCEPTABLE MATERIALS. Any material or assembly that does not conform to the requirements
   of the contract, plans, or specifications shall be considered unacceptable and shall be rejected. The Contractor shall
   remove any rejected material or assembly from the site of the work, unless otherwise instructed by the RPR.
- 1166 Rejected material or assembly, the defects of which have been corrected by the Contractor, shall not be returned 1167 to the site of the work until such time as the RPR has approved its use in the work.
- 60-08 OWNER FURNISHED MATERIALS. The Contractor shall furnish all materials required to
   complete the work, except those specified, if any, to be furnished by the Owner. Owner-furnished
   materials shall be made available to the Contractor at the location specified.
- 1173 All costs of handling, transportation from the specified location to the site of work, storage, and installing 1174 Owner-furnished materials shall be included in the unit price bid for the contract item in which such 1175 Owner-furnished material is used.
- 1176

1158

1161

1165

1168

1172

1177 After any Owner-furnished material has been delivered to the location specified, the Contractor shall be 1178 responsible for any demurrage, damage, loss, or other deficiencies that may occur during the Contractor's 1179 handling, storage, or use of such Owner-furnished material. The Owner will deduct from any monies due 1180 or to become due the Contractor any cost incurred by the Owner in making good such loss due to the 1181 Contractor's handling, storage, or use of Owner-furnished materials.

- 1182
- 1183 1184

1185

#### **END OF SECTION 60**

Issued for Bid November 2022

#### PART C – LOCAL PROVISIONS

#### 4229 **1. HAUL ROADS:**

4226 4227 4228

4230

4243

4244 4245

4247

4248 4249

4250

4251

4252

The Contractor shall obtain approval from the Engineer prior to establishing haul roads within the airport 4231 property. Once established, the haul roads shall be utilized for all equipment traffic, and the equipment 4232 shall not be allowed to stray or wander away from the established routes. The haul roads shall be the 4233 responsibility of the Contractor and shall be maintained and kept in good order at all times. Water, when 4234 4235 required, shall be applied at the locations and in the amounts necessary to minimize dust and dirt in the air operations area. Haul roads across any active runway or taxiway shall be kept clean and in good order 4236 at all times. The Contractor shall repair any damage caused by the movement of equipment on any of the 4237 haul roads, whether in designated or undesignated areas. After completion of the project, the Contractor 4238 4239 shall be required to re-grade any unpaved portions of the haul road and to reseed the area with local native grasses to match the existing conditions of the area. The performance of any work as specified by this 4240 provision, including watering, maintenance, and repair of the haul roads, shall not be measured and paid 4241 4242 for directly, but shall be considered as necessary and incidental to the work.

Establishment of haul roads off of Airport property shall be the sole responsibility of the Contractor.

#### 4246 2. AIRPORT SECURITY:

The Contractor is responsible for all vehicles and personnel on the airport property. All authorized vehicles and construction equipment must display a three foot by three foot flag with international orange and white 12 inch squares displayed in full view above the vehicles. Passengers in any unauthorized vehicles shall be the responsibility of the Contractor. The Contractor shall be held responsible to uphold the above security stipulations stated in the CSPP at all times during the progress of the construction project. No deviations from the security measures shall be allowed at any time.

4254 4255

4257

4258 4259

4260

4261 4262

4263 4264

4270

4273

4275

4279

#### 4256 3. RADIO COMMUNICATIONS:

The Contractor's superintendent and flagman shall be required to <u>monitor transceiver radios</u> tuned to the ATCT/CTAF 126.9 MH<sub>z</sub> and Ground Control Bi-Weekly MH<sub>z</sub>, frequency <u>at all times</u>. Radios shall be supplied by the Contractor. Such radios shall be used to obtain proper clearance in regard to the movement of equipment, trucks, etc., on the airport. Further, any unusual occurrences in the flight pattern of approaching or departing aircraft shall be acknowledged by all concerned so that operation of the airport and the construction work can be safely carried on at all times.

#### 4265 **4. WORK SCHEDULE:**

4266
4267 Immediately after the award of contract, the Contractor shall file with the Engineer a time chart or
4268 schedule of proposed progress, a plan of construction and proposed detailed methods of carrying out the
4269 work, including a full statement of equipment and equipment layout for the job.

4271 The Sponsor reserves the right to request changes in the sequence of project schedules if such change is 4272 required in the interest of safety or airport operation.

#### 4274 5. CONTRACTOR'S QUALITY CONTROL PROGRAM:

4276The contractor and their chosen testing laboratory shall submit a quality control plan submitted and<br/>approved prior to the Notice to Proceed (NTP). The quality control plan should contain the following<br/>items:



#### ST. JOSEPH ROSECRANS MEMORIAL AIRPORT RENOVATIONS PHASE 1 MODOT Project No. 22-012A-1 Pre-Bid Conference

November 30th, 2022, 2:00 P.M. Call in +1 937-240-2430 PIN: 920428310#

Schedule I: New Terminal Building and all necessary Site and Utility Work

Schedule II: New Electrical Vault and all necessary Site and Utility Work

#### 1. RECORDING OF ATTENDEES

- A. Recording of attendees, firm represented, email, address and phone number.
- B. Attendance and Meeting Minutes will be sent by addendum to all plan holders.

#### 2. INTRODUCTIONS & PROJECT DESCRIPTION

- A. Airport Representatives
  - 1. Julius Rice, Airport Manager
  - 2. Chris Cordonnier, Airport Operations
  - 3. Abe Forney, Public Works Director
- B. Airport Engineering / Architect Jviation, a Woolpert Company
  - 1. Joe Pestka, Program Director
  - 2. Kevin Costello, Project Manager
  - 3. Adam Acree, Team Lead
  - 4. Derek Johnson, P.E., Civil Engineer
  - 5. Joel Wiechmann, P.E., Electrical Engineer
- C. Project Overview –

#### a. Schedule I: New Terminal Building and all necessary Site and Utility Work

- i. A portion of the work is Federally Funded
- ii. The Schedule I Terminal Building has been designed to replace the existing Administrative Building which is combined with an Air Traffic Control Tower. The Terminal Building will be a steel framed building with steel joists, using footings for the foundation, with masonry and glass as the building shell. It will be a general use building that will include a lobby, restaurant and dining area, outdoor patio, office space, pilot's lounge, restrooms, ramps and entrance and exit stairs, associated parking positions, storm sewer collection pipes and inlets, sanitary sewer and water line installation, electrical/telephone/data system services, gas, parking lot lighting, paving, signage and striping, as well as all necessary grading and earthwork.
- iii. The 1<sup>st</sup> step in phasing must be disconnection of geothermal well field and installation of new air source heat pumps for the existing building to replace the existing building's heating and cooling systems per the phasing plan.
- iv. The existing administrative building and ATCT will be used and occupied throughout the project. Entry and parking in front of the building must be left accessible throughout the life of the project.
- v. Haul Routes, roadwork, and contractor accessibility
- vi. Utility installation; utilities to existing Terminal / ATCT must remain in service throughout the project



- vii. Utility routes and terminations for Phase II
- viii. Site work; fill dirt must come from an undesignated offsite source
- ix. Silt Fences and Erosion Control Permitting and Barricades
- x. No movable furniture is included in the contract; refer to keynotes
- xi. Contractor is responsible for relocating kitchen equipment

#### b. Schedule II: New Electrical Vault and all necessary Site and Utility Work

- i. A portion of the work is Federally Funded
- ii. The existing Power Building will be used throughout the life of the Project. Runway Lighting Power, and Lighting Controls will only be switched over as the final step in construction.
- iii. Contractor accessibility and security access
- iv. FOD Control
- v. Utility Routes
  - -Conduits under runway to be installed by others
- vi. Site Work
- vii. Working near and around an active AOA

#### 3. BID OPENING DATE & TIME

- A. Date: Due by Dec.13th, 2022 at 1:00 P.M.
- B. Mailed to: City of St. Joseph at Purchasing Room 201, 1100 Frederick Ave, St. Joseph, MO 64503
- C. Opened at: City of St. Joseph at Purchasing Room 201
- D. Bid security: 5% of bid amount.
- E. Bid proposal: Complete and Bid Proposal Summary including Schedule I and II Total.
- F. Award: The bid will be based on the total base bid for all awarded schedules based on the availability of funding.

#### 4. DBE GOALS

A. 4.00% of the contract amount per section 4-5 Part 4.

#### 5. QUALIFICATION OF BIDDERS

A. Qualifications shall be furnished per Section 20-02. Each bidder shall furnish the Owner satisfactory evidence of his or her competency and financial responsibility to perform the proposed work.

#### 6. CRITICAL CONTRACT DATES

- A. Notice of Award: Up to 120 Calendar Days from Bid Opening which is April 11, 2023
- B. Notice to Proceed: January 2023 to Mid-April 2023. Will be coordinated with the contractor and their schedule.
- C. Project Time: 300 Calendar Days for Construction completion.

#### 7. SAFETY PLAN COMPLIANCE DOCUMENT

A. Safety Plan Compliance Document:

The Contractor shall submit a SPCD per AC 150/5370-26. The Contractor's SPCD shall identify specific methods, sequencing, and phasing that he/she intends to use in order to accomplish the project work. The final SPCD shall be a coordinated effort between the

Owner/Sponsor, the Engineer, and the Contractor. The Contractor's SPCD must be submitted to the Airport and Engineer one week prior to the issuance of a Notice to Proceed. No Notice to Proceed shall be issued until the SPCD has been approved. A sample of an SPCD can be given upon request.

The items to be included in this SPCD include but are not limited to:

- 1. Specific hazard equipment and lighting to be used on the project.
- 2. Construction equipment heights.
- 3. Contractor's contacts, subcontractor's contacts, and Airport contacts (including after hours contact procedures).

#### 8. BONDING

- A. Payment Bond: 100% of Bid Amount.
- B. Performance Bond: 100% of Bid Amount

#### 9. ARCHITECT/ENGINEER'S/ RPR's FIELD OFFICE

A. This will not be required and will be removed as part of Addendum #2.

#### **10. LIQUIDATED DAMAGES**

A. As compensation per the Contract Document, the Contractor shall be assessed a liquidated damage of \$750 per calendar day as well as A&E/RPR wage reimbursement for each day that the work remains uncompleted beyond the contract period.

#### **11. SAFETY AND PHASING**

A. Phasing sheets are attached to the Agenda for discussion.

#### **12. ADDENDUM UPDATE**

- A. Addendum # 1 was provided on November 28th.
- B. Addendum # 2 will follow. It will include all of the meeting minutes along with questions and answers, and answers not given at the meeting.

#### **13. MISCELLANEOUS**

- A. Construction and building materials sold to the contractors and subcontractors for use on public works owned by City of St. Joseph, are exempt from State Sales and Use Taxes. However, such materials will be subject to any Sales and Use Taxes imposed by local cities and counties.
- B. Quality Acceptance Testing and required Special Inspections shall be performed by an independent testing agency employed by the Engineer. The contractor must provide Quality Control testing for certain work elements.
- C. The contractor will be responsible for any permitting required. However, there will be no building permit required since this is outside of the city limits of St. Joseph.

#### 14. QUESTIONS

- A. Questions will be taken via email until COB on Monday the 5th
- B. Final anticipated addendum will be sent out Wednesday the 7th



#### **15. PROJECT SITE TOUR**




Pre-Bid Meeting Sign In

Time: 2:00 P.M.	ovember 30, 2022 / Rosecrans Memorial Airport T		Construct New Terminal Building and Electrical Vault MODOT Project No. 22-012A-01
Name	Company	Telephone No.	E-mail
RUMWE HAERTAN	Pinwals Electric	816-279-1800	dume e privile electric inc. con
Ern Uchten	Lehr Construction	416-232-4431	eric B/clacon struction ( orb
Jon Lemp	LEIDE CONST CO	816 23 2 - 4431	Jonelch - construction .com
Rawly Schuck	The WALifiper	814-232-4820	Tand). Schulte coursed min to
DRANDON MILLER	WALDINGLER	816-262-6025	Brondon. Miller & waldinger. com
ach Schurman	Lawhon Const. Co.	BIG-279-6366	zech@lowhonconst.com
ustin shrene	Herner Construction	816 - 232 - 4551	justin @ hame car fuction . con
helby Suath	RS Electric	816 - 844 - 2594	shelby@rselectriccosp.com
OR GIRBONK	KADIEAN	913 375 0750	- rgibbons @ kadean.com
adeltarms	E.L. Crawford	816 233-2594	- wade@elcrawford.com
<u>lill Manis</u>	Dulius Kaoz Cowst.	913-682-3550	Will @ JKaaz. Com
ICUARD SADLEN	ALJ MUELLER CONST	<u>B16-233-6055</u>	RSADLER QALT MOLLER CON
ren Wiedmer Kelly Owens	Lee Grover Const.	(816) 279-7919	brycenw_lgcestcglobal.net
rrs (14Rtor LIF	Seaman & Schuske	816-261-7206	Kowens a Seamon Schuske . Com
SFFFFMISCHER	ECIKARIOS	816-752-0920	) JEFFRECKARDS FLOORING
son INGARON	Musselmon + Mall	8K. 705 7272	tinghran e musselman Andhalluan


#### Virtual Attendee Sign In


Name	Company / Organization
Greg Fisher	Maryville Glass and Lock
Andrea	MD Electric
Derek Johnson	Jviation a Woolpert Company
Adam Acree	Jviation a Woolpert Company
Joel Wiechmann	Jviation a Woolpert Company
Ed Hyatt	FAA
Andrew Hanks	MODOT

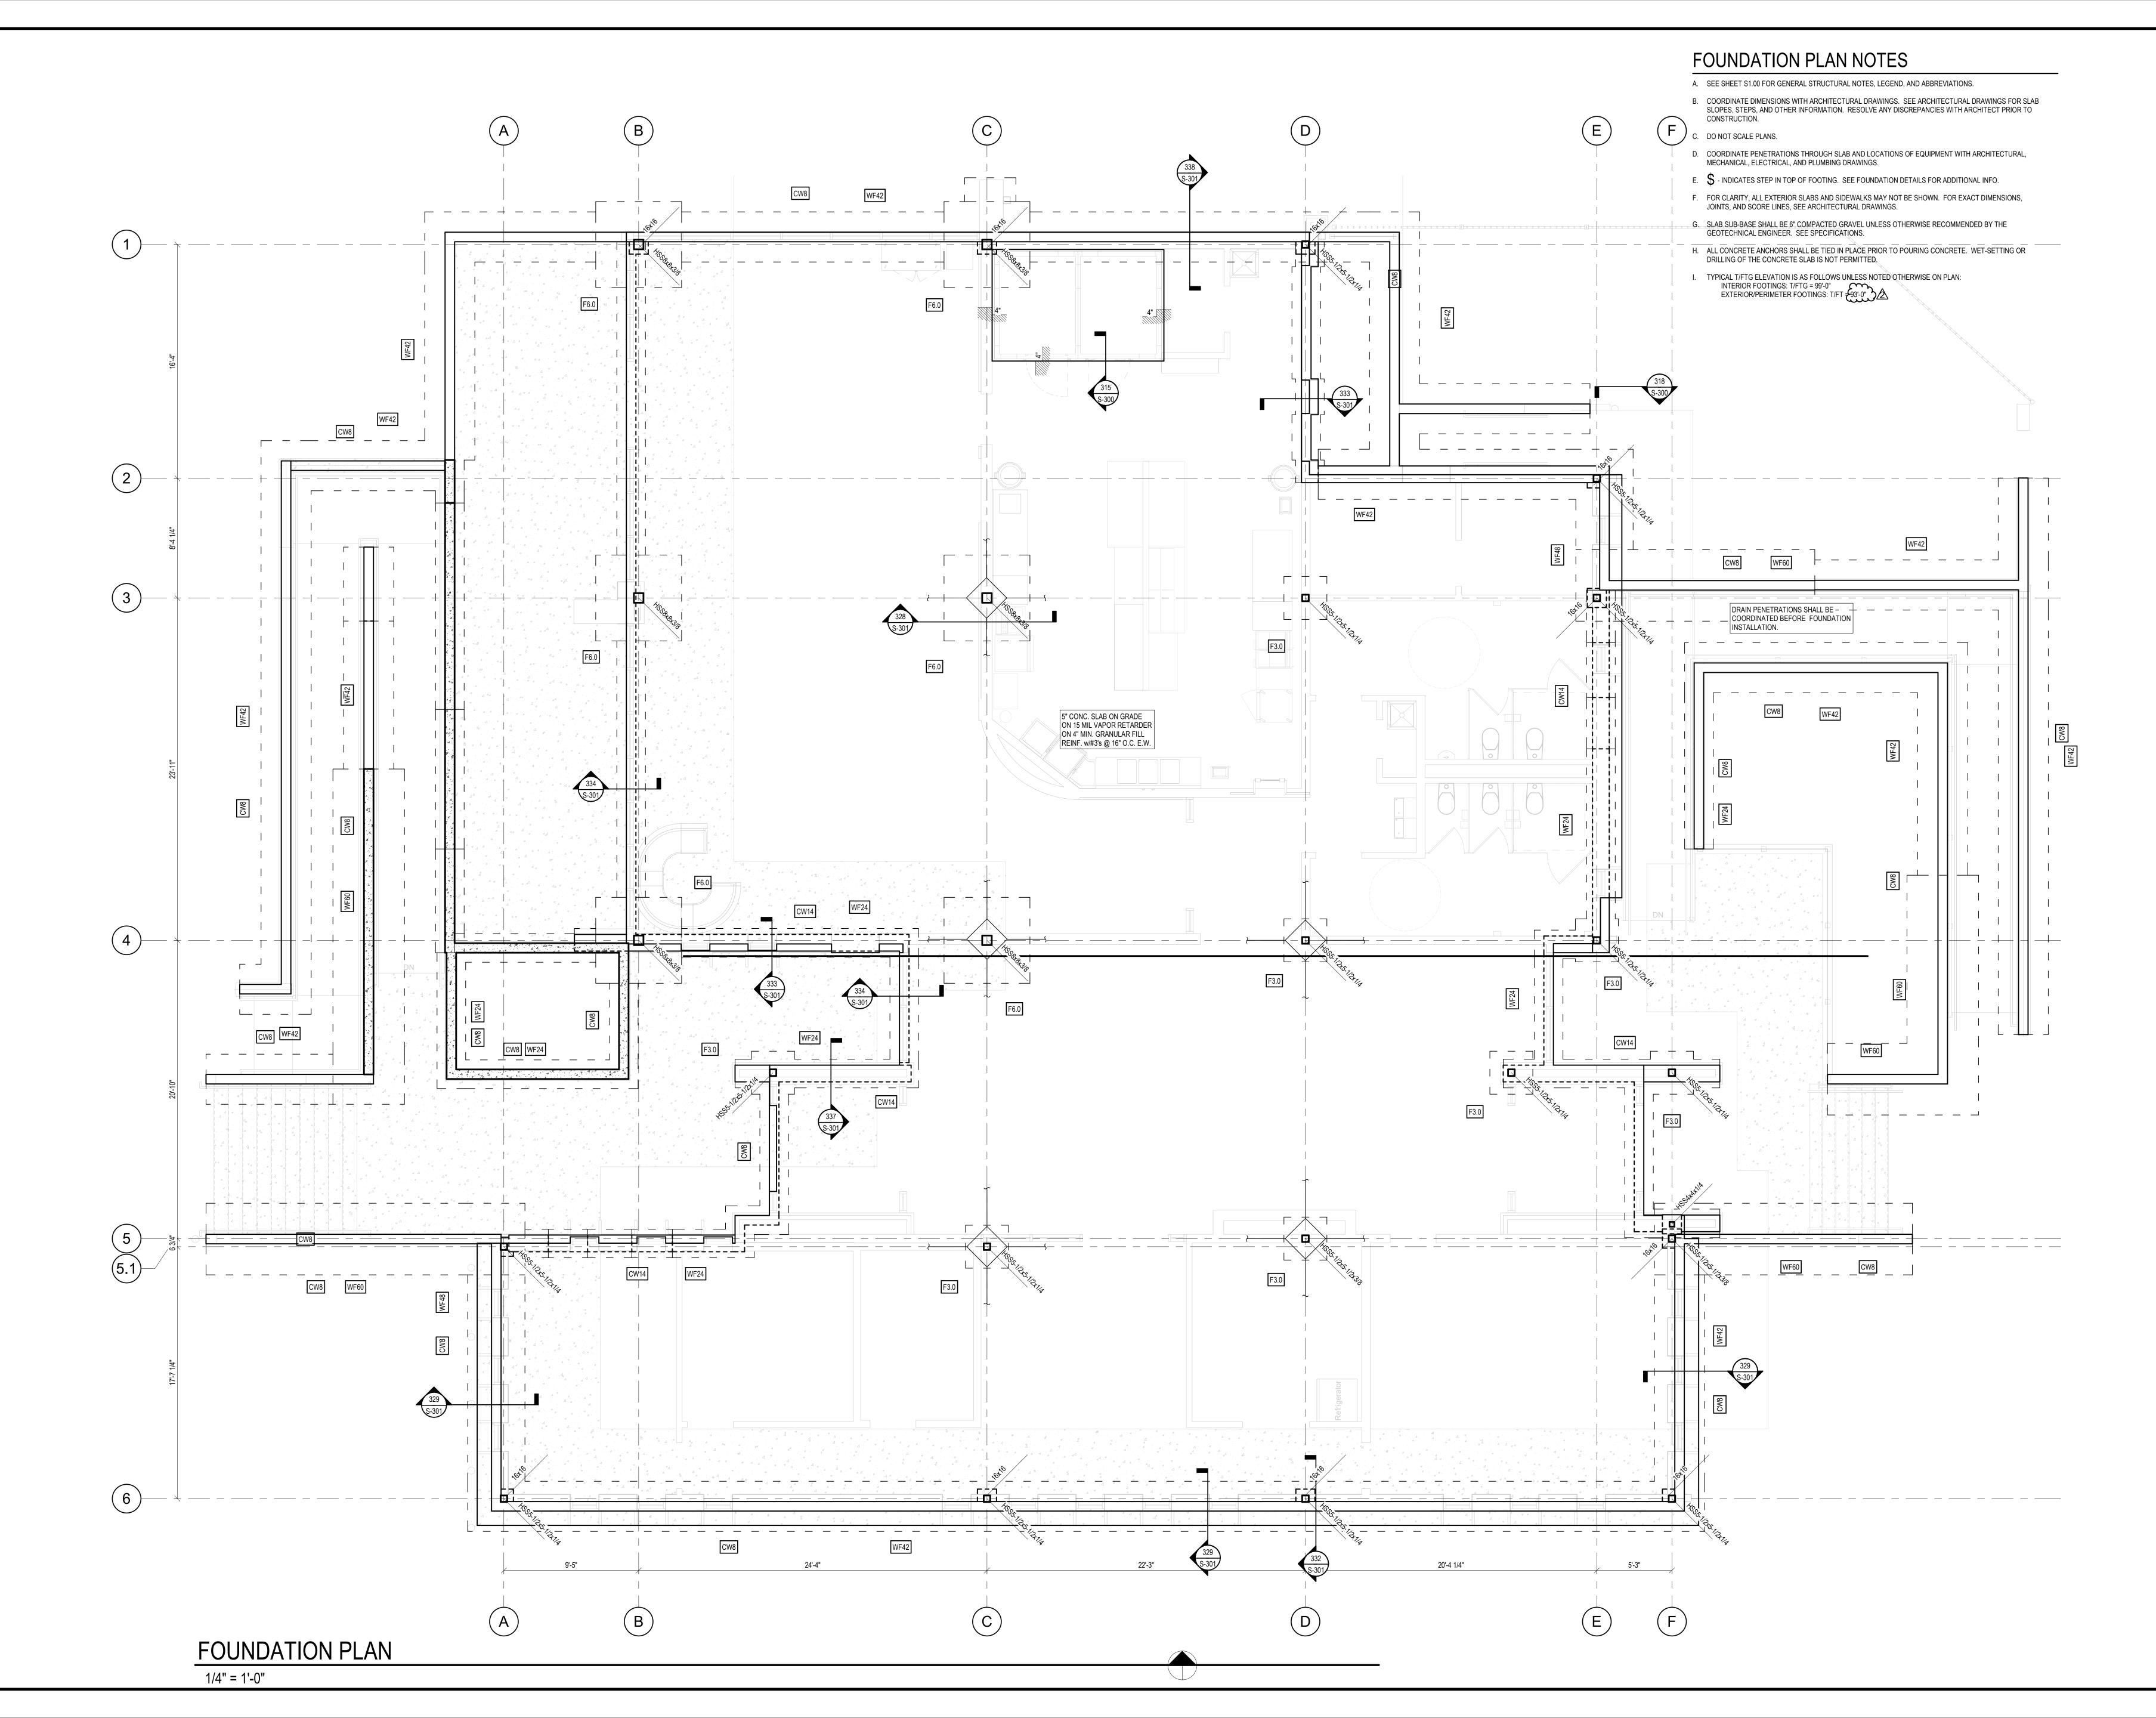


NDATION PLAN 12/1/2022 1:21:22 PM BIM 360://Jviation\_ St Joseph Airport/STJ\_ADMIN BLDG\_Struc\_R20.



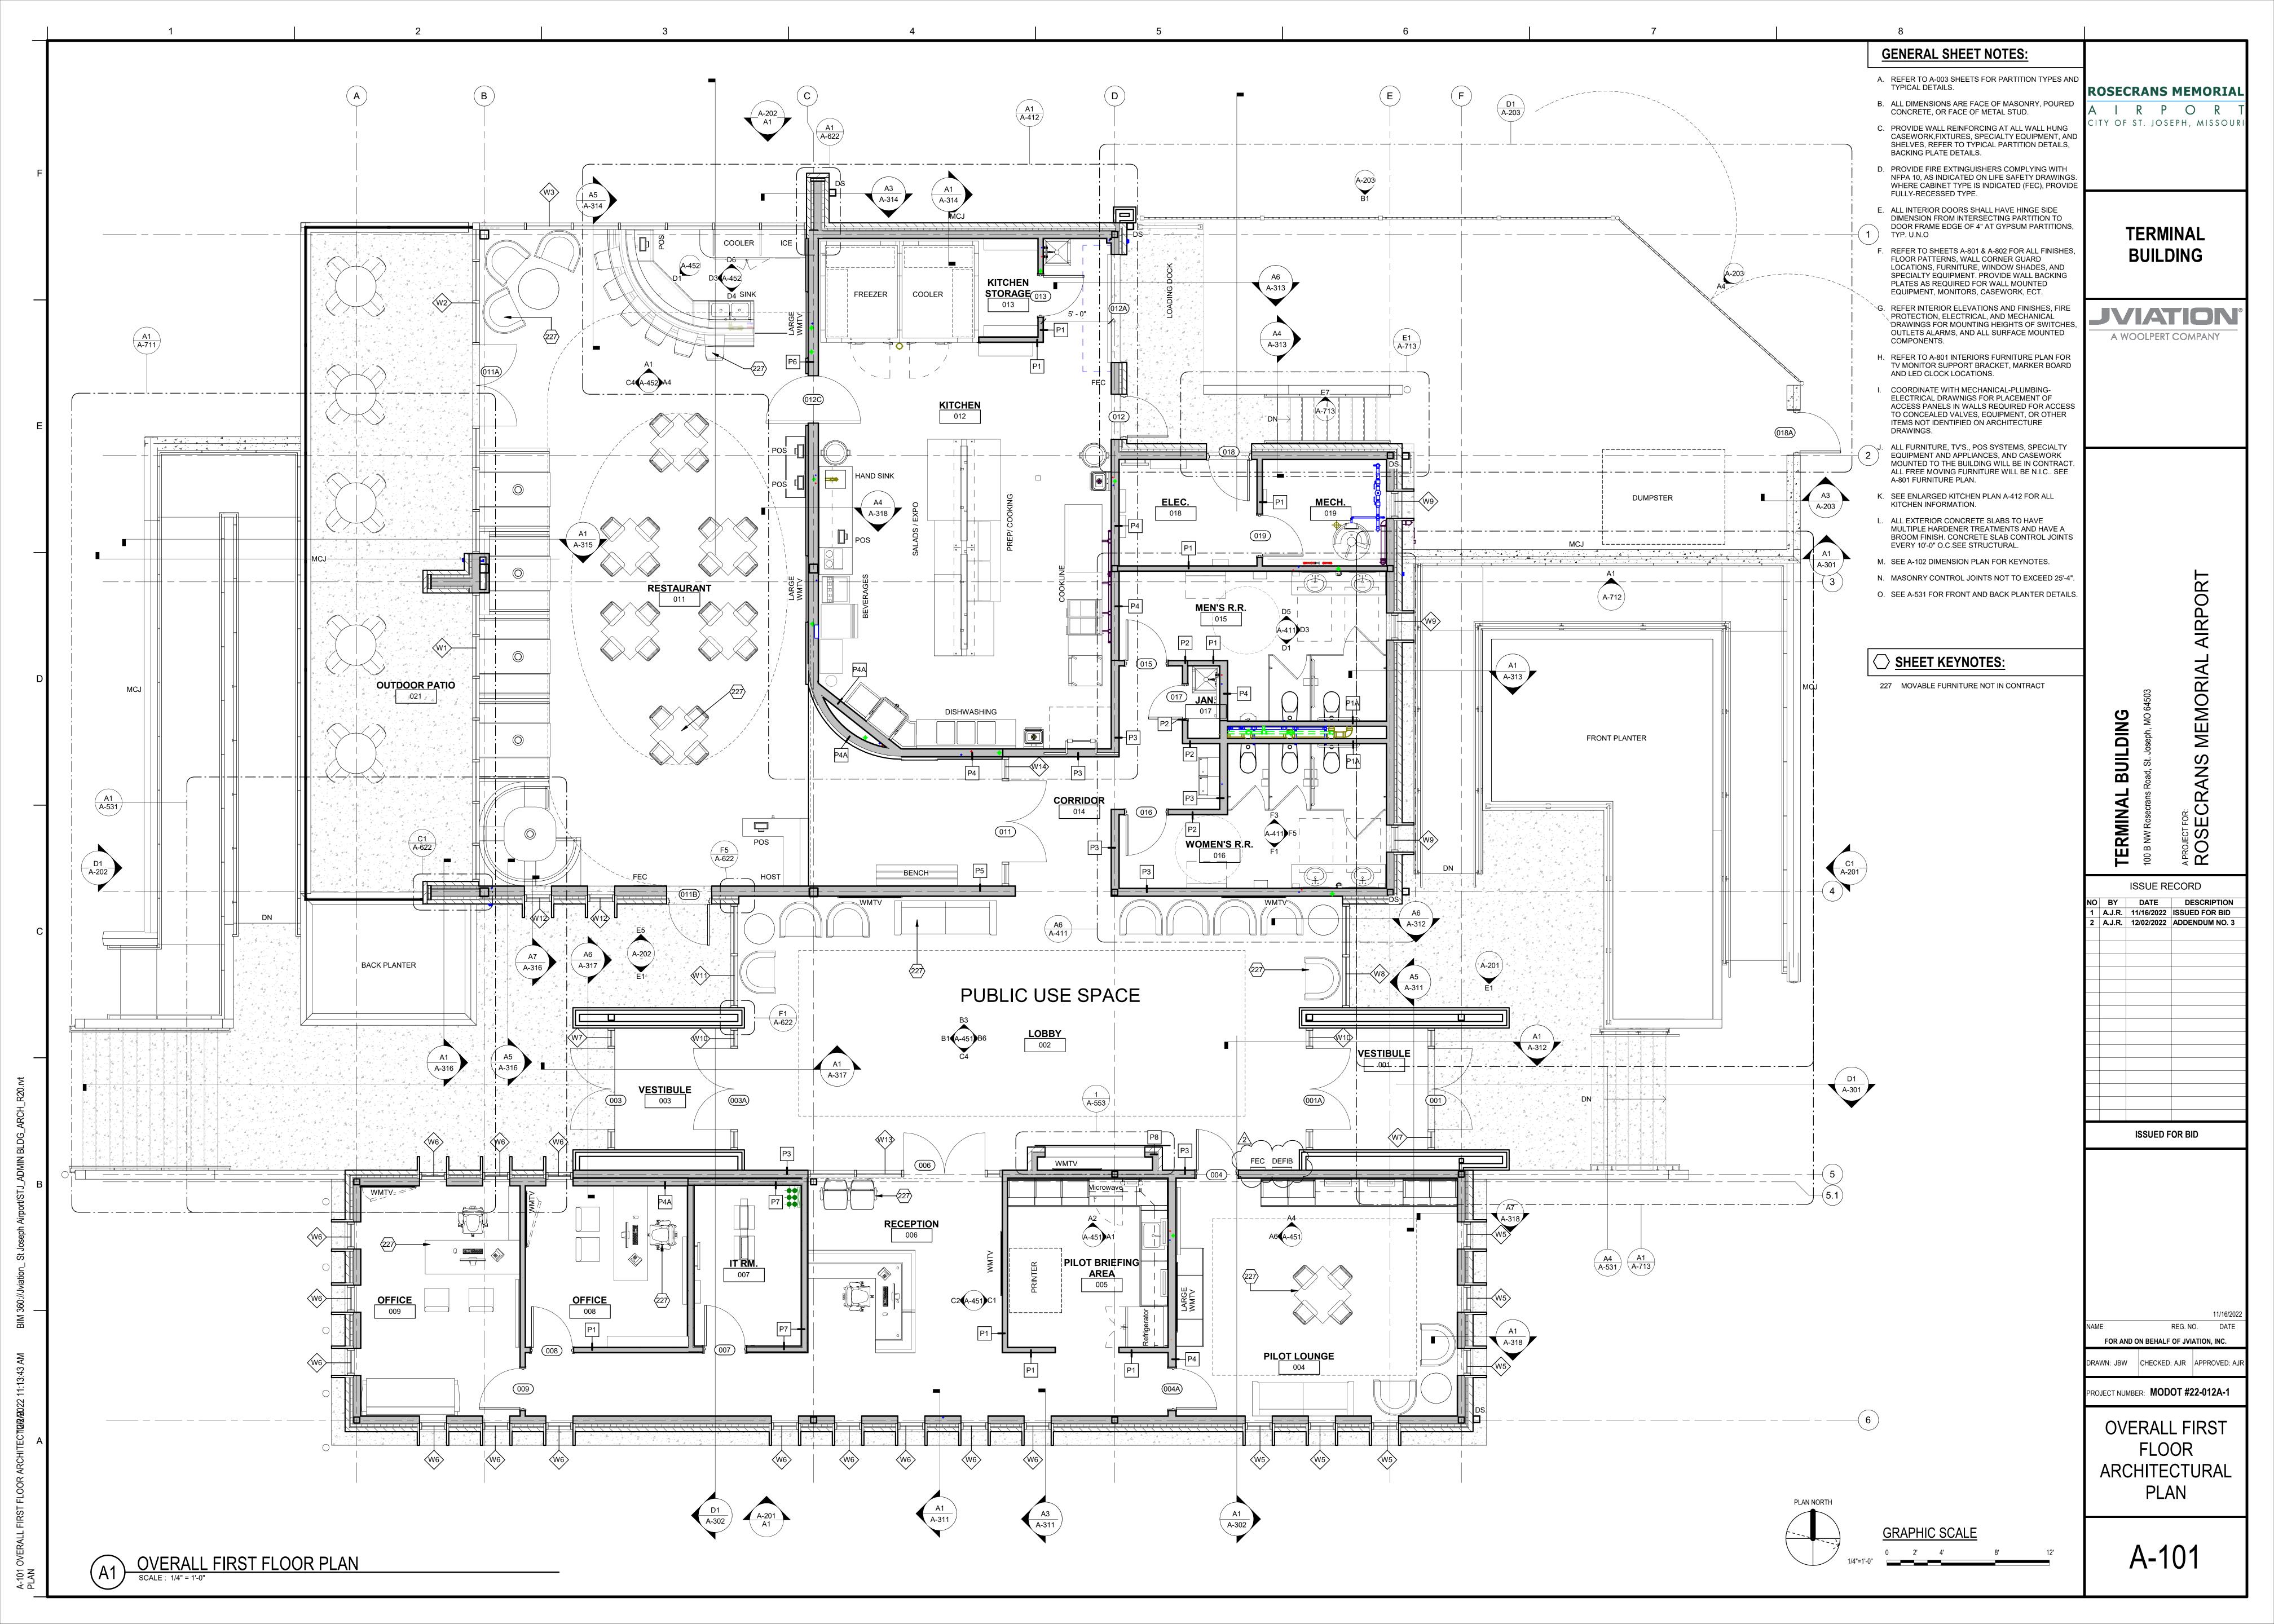

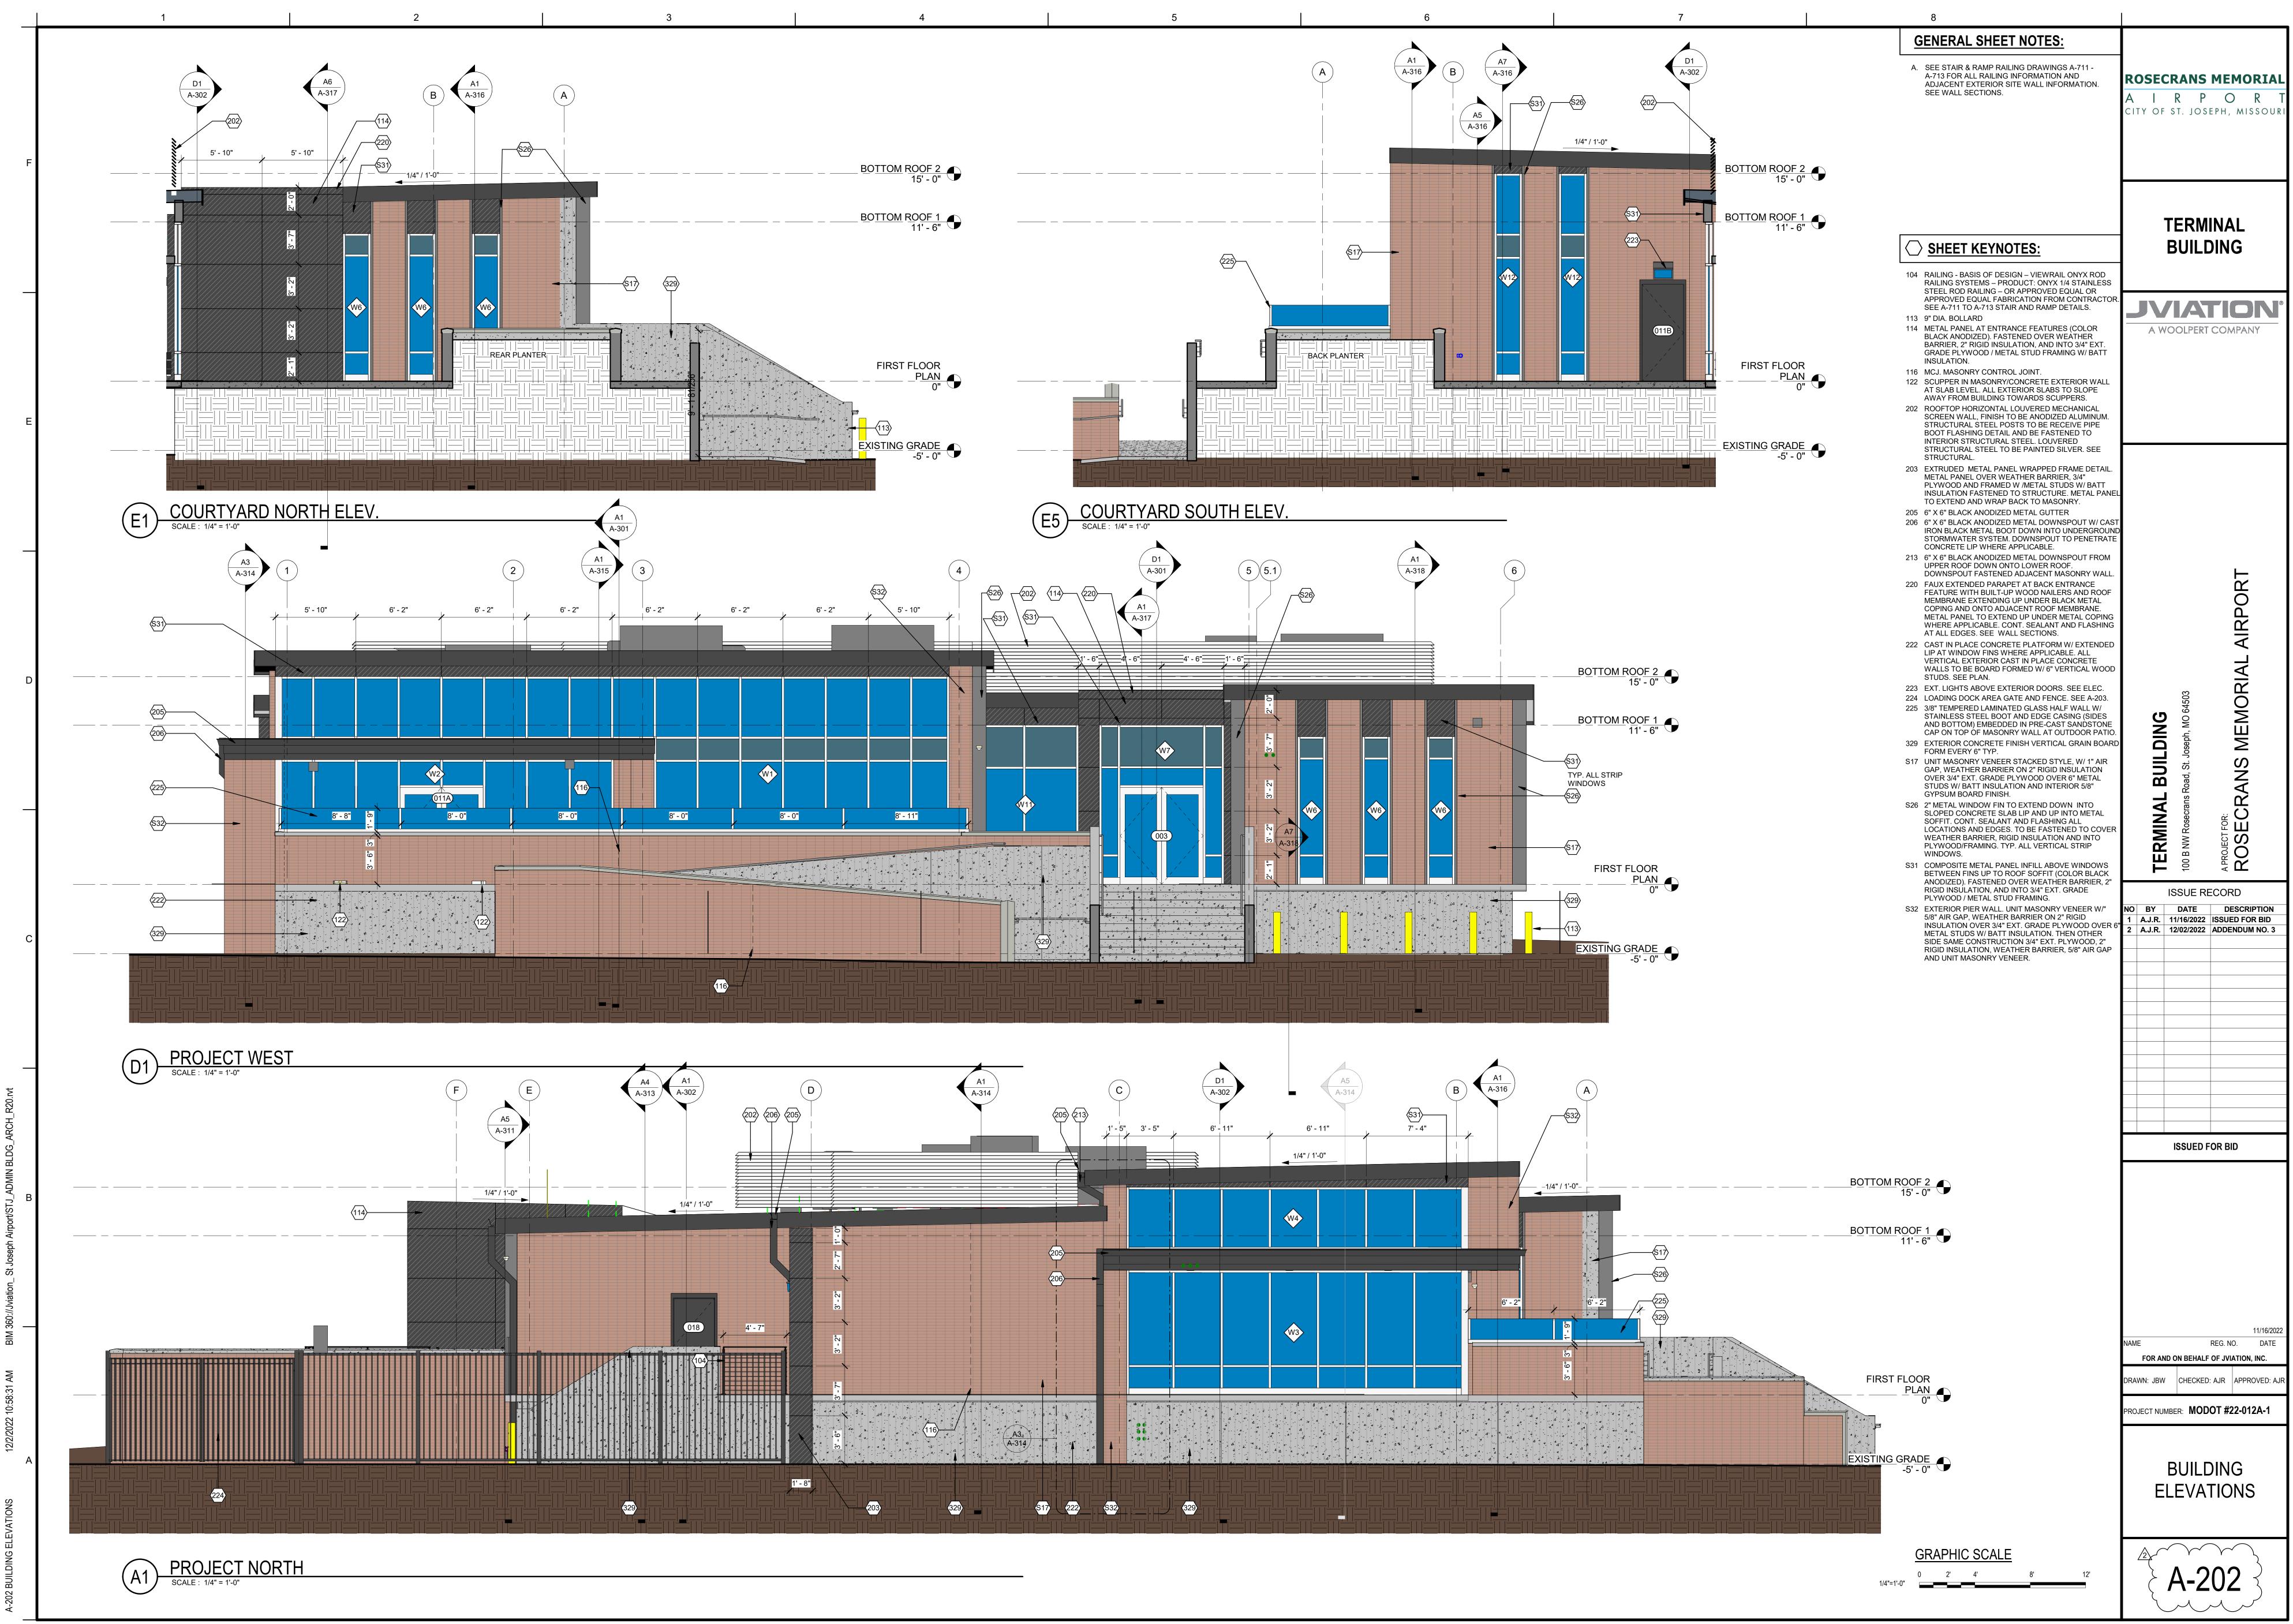

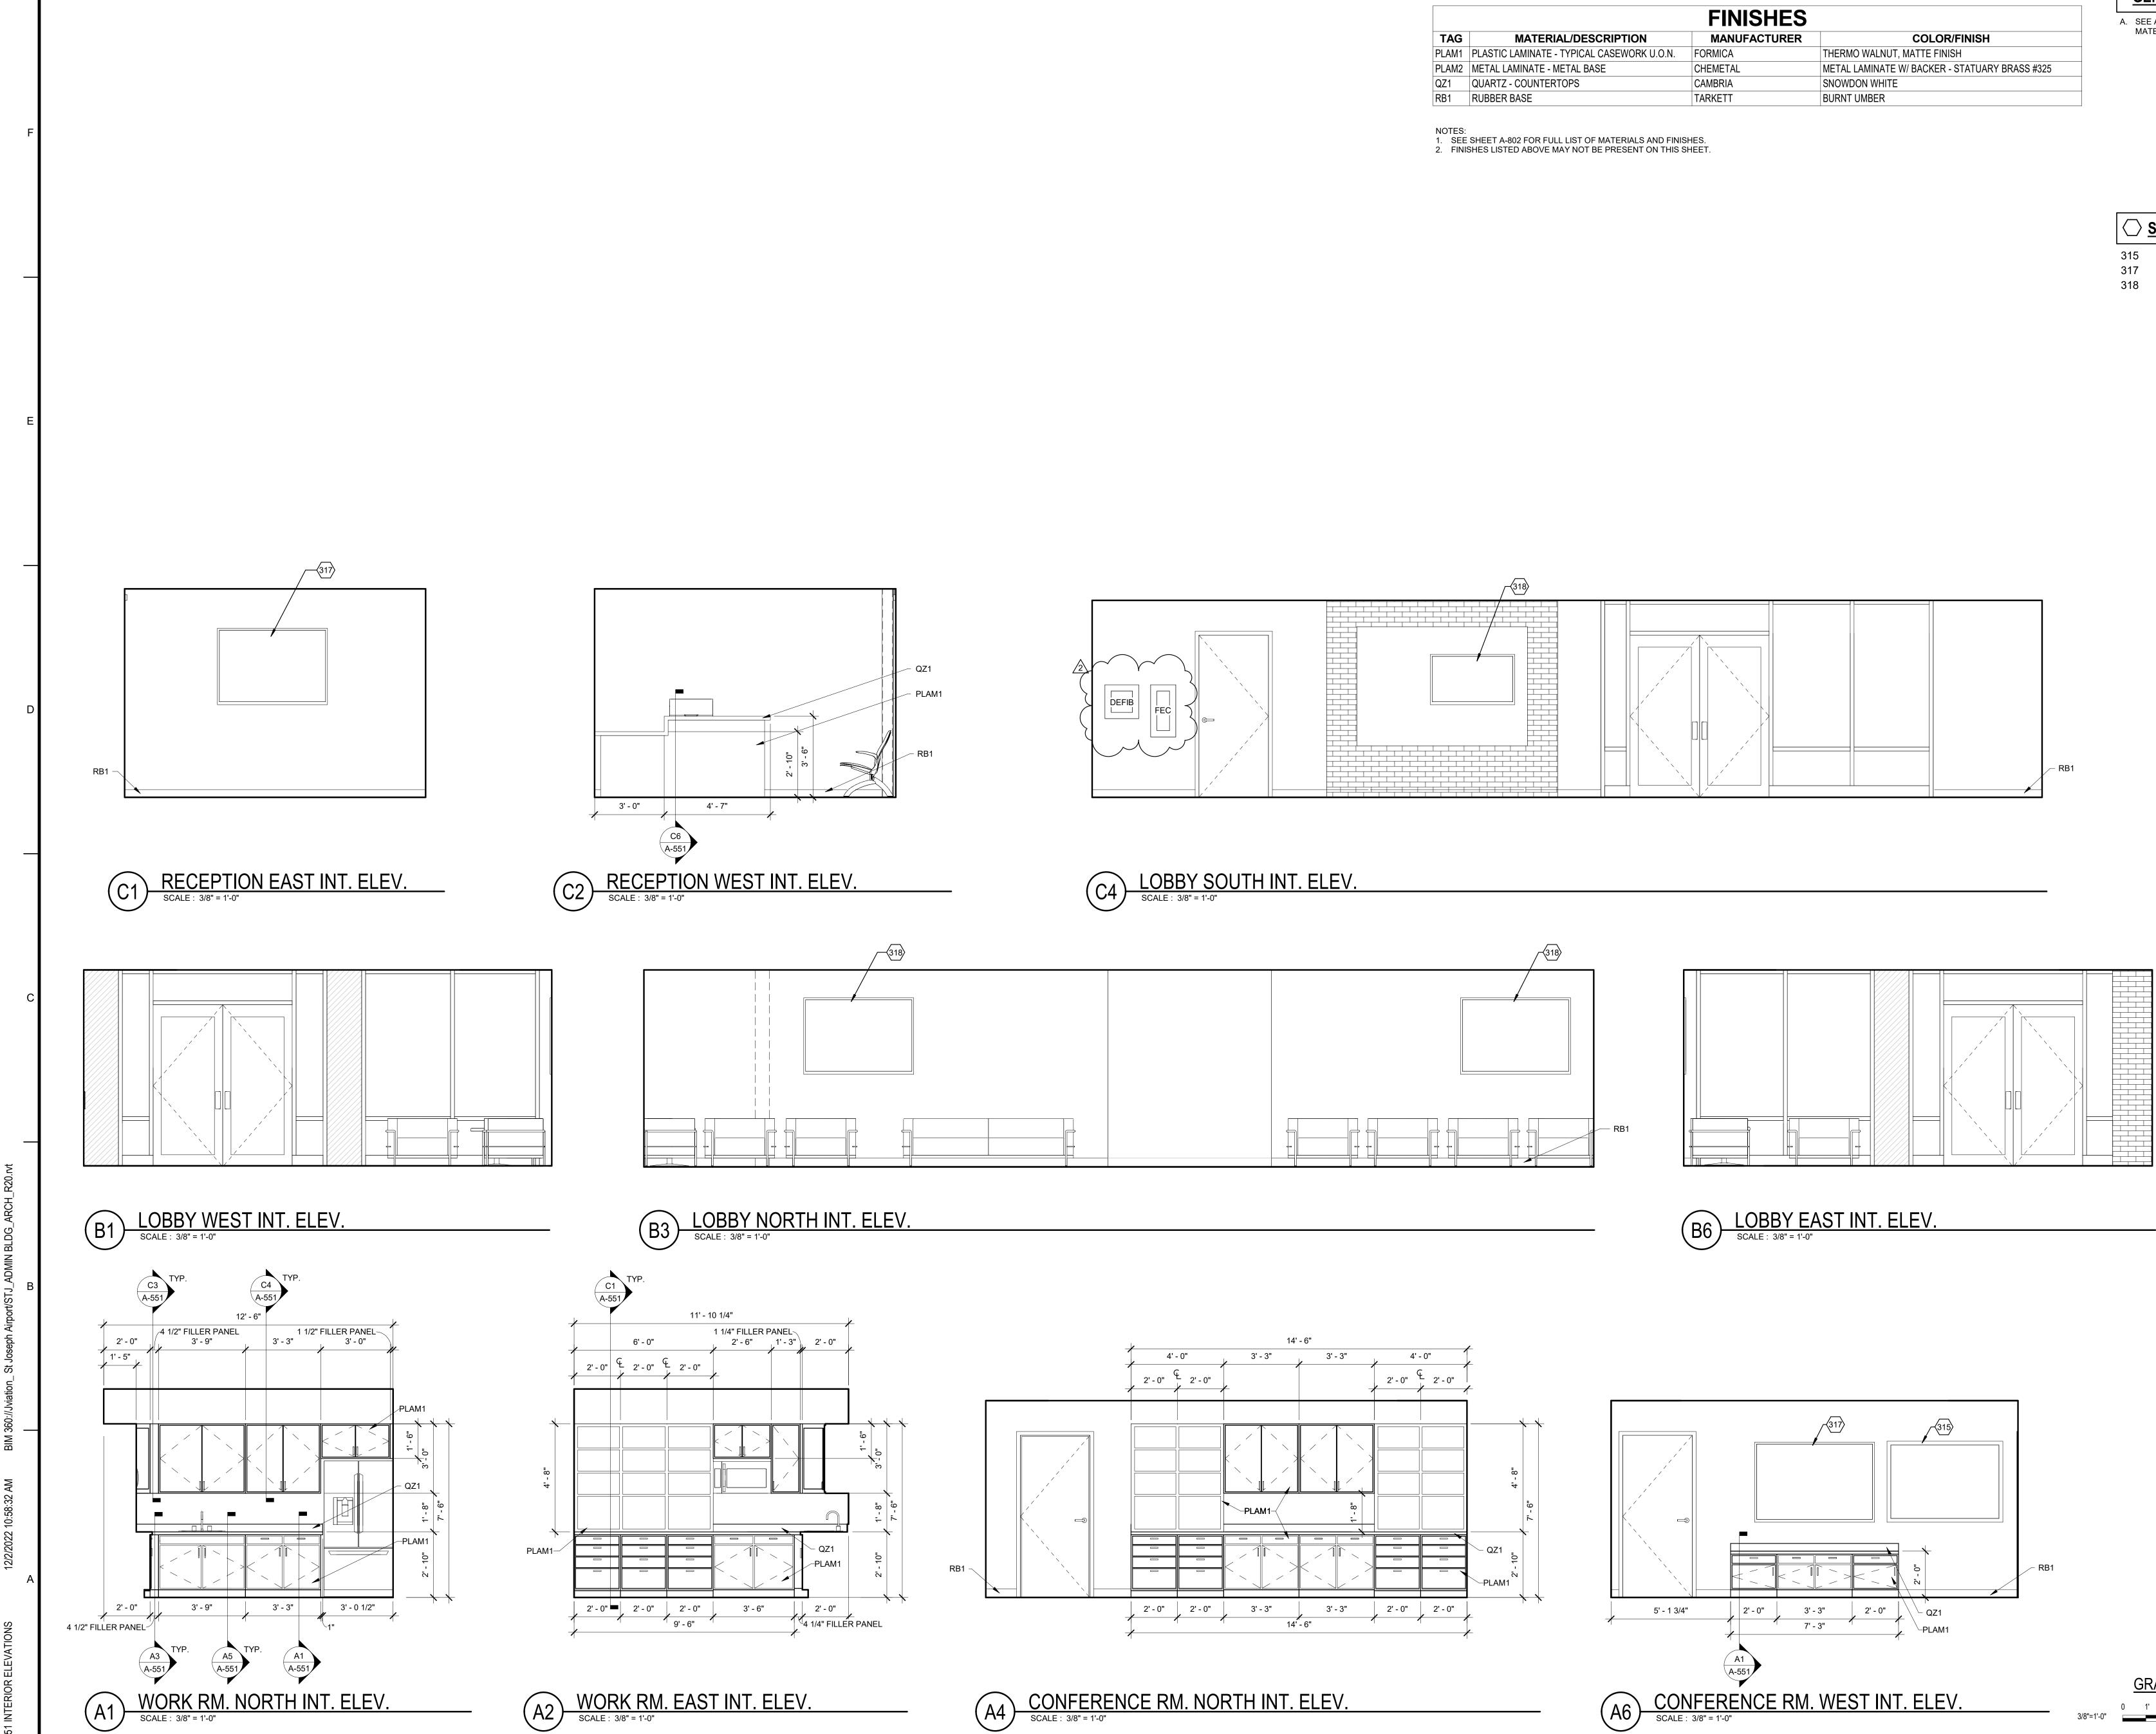



		FINISHES	
TAG	MATERIAL/DESCRIPTION	MANUFACTURER	COLOR/FINISH
PLAM1	PLASTIC LAMINATE - TYPICAL CASEWORK U.O.N.	FORMICA	THERMO WALNUT, MATTE FINISH
PLAM2	METAL LAMINATE - METAL BASE	CHEMETAL	METAL LAMINATE W/ BACKER - STATUARY BRASS #325
QZ1	QUARTZ - COUNTERTOPS	CAMBRIA	SNOWDON WHITE
RB1	RUBBER BASE	TARKETT	BURNT UMBER

7

1

6

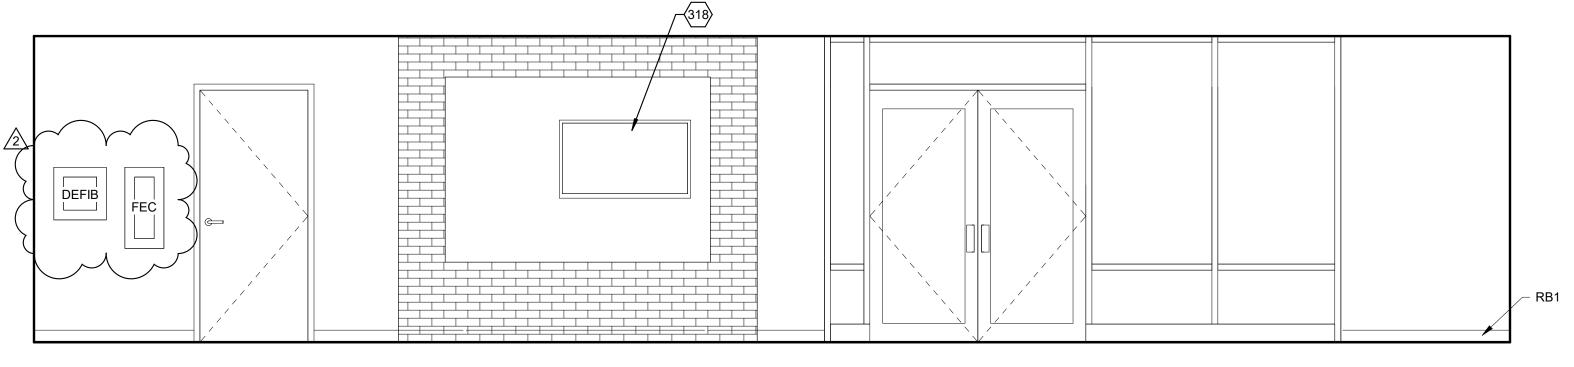

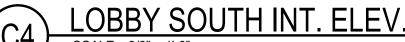

32

20

; 10: )22

12/2


## **GENERAL SHEET NOTES:**


A. SEE A-802 FINISH LEGEND FOR FULL DESCRIPTION OF MATERIAL SELECTIONS.

SHEET KEYNOTES:
-----------------


- DRY ERASE MARKER BOARD LARGE WALL MOUNTED TV 65"
- MEDIUM WALL MOUNTED TV 48"

<u>GRAPHIC SCALE</u> 0 1' 2' 3' 4' 6' 

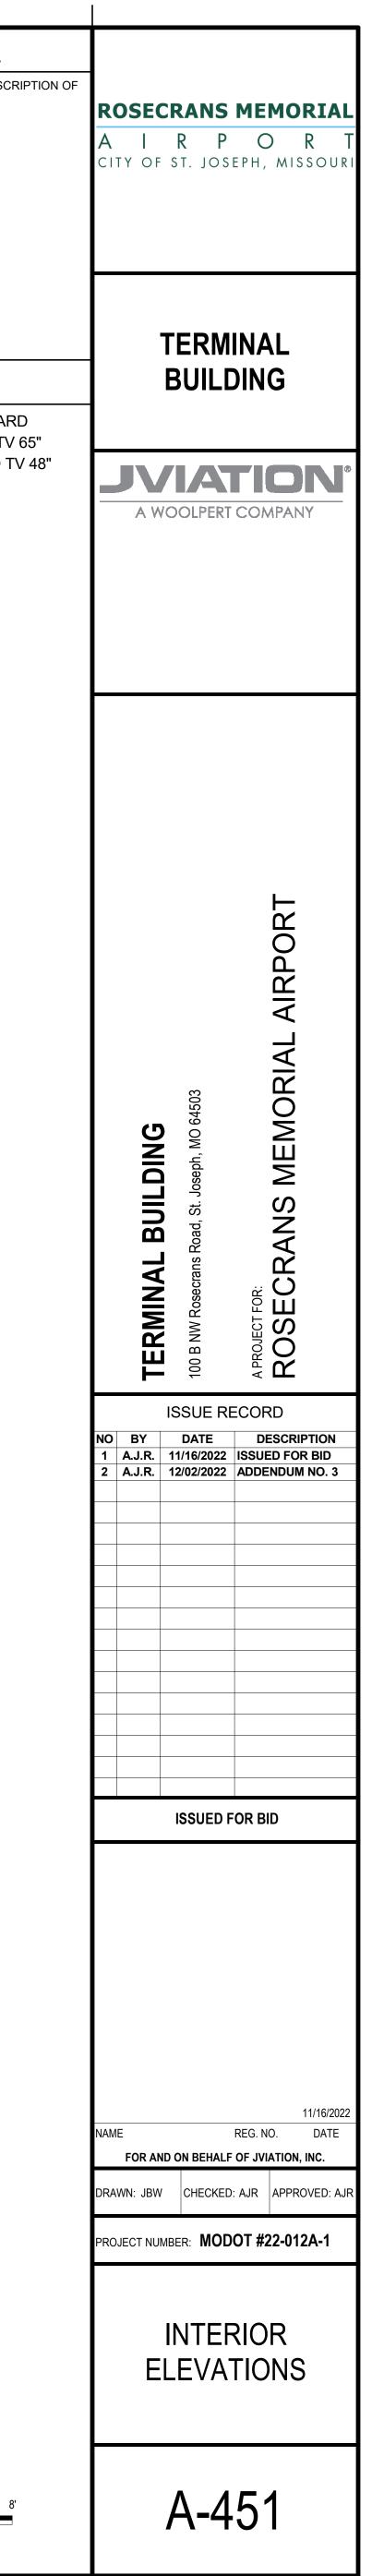

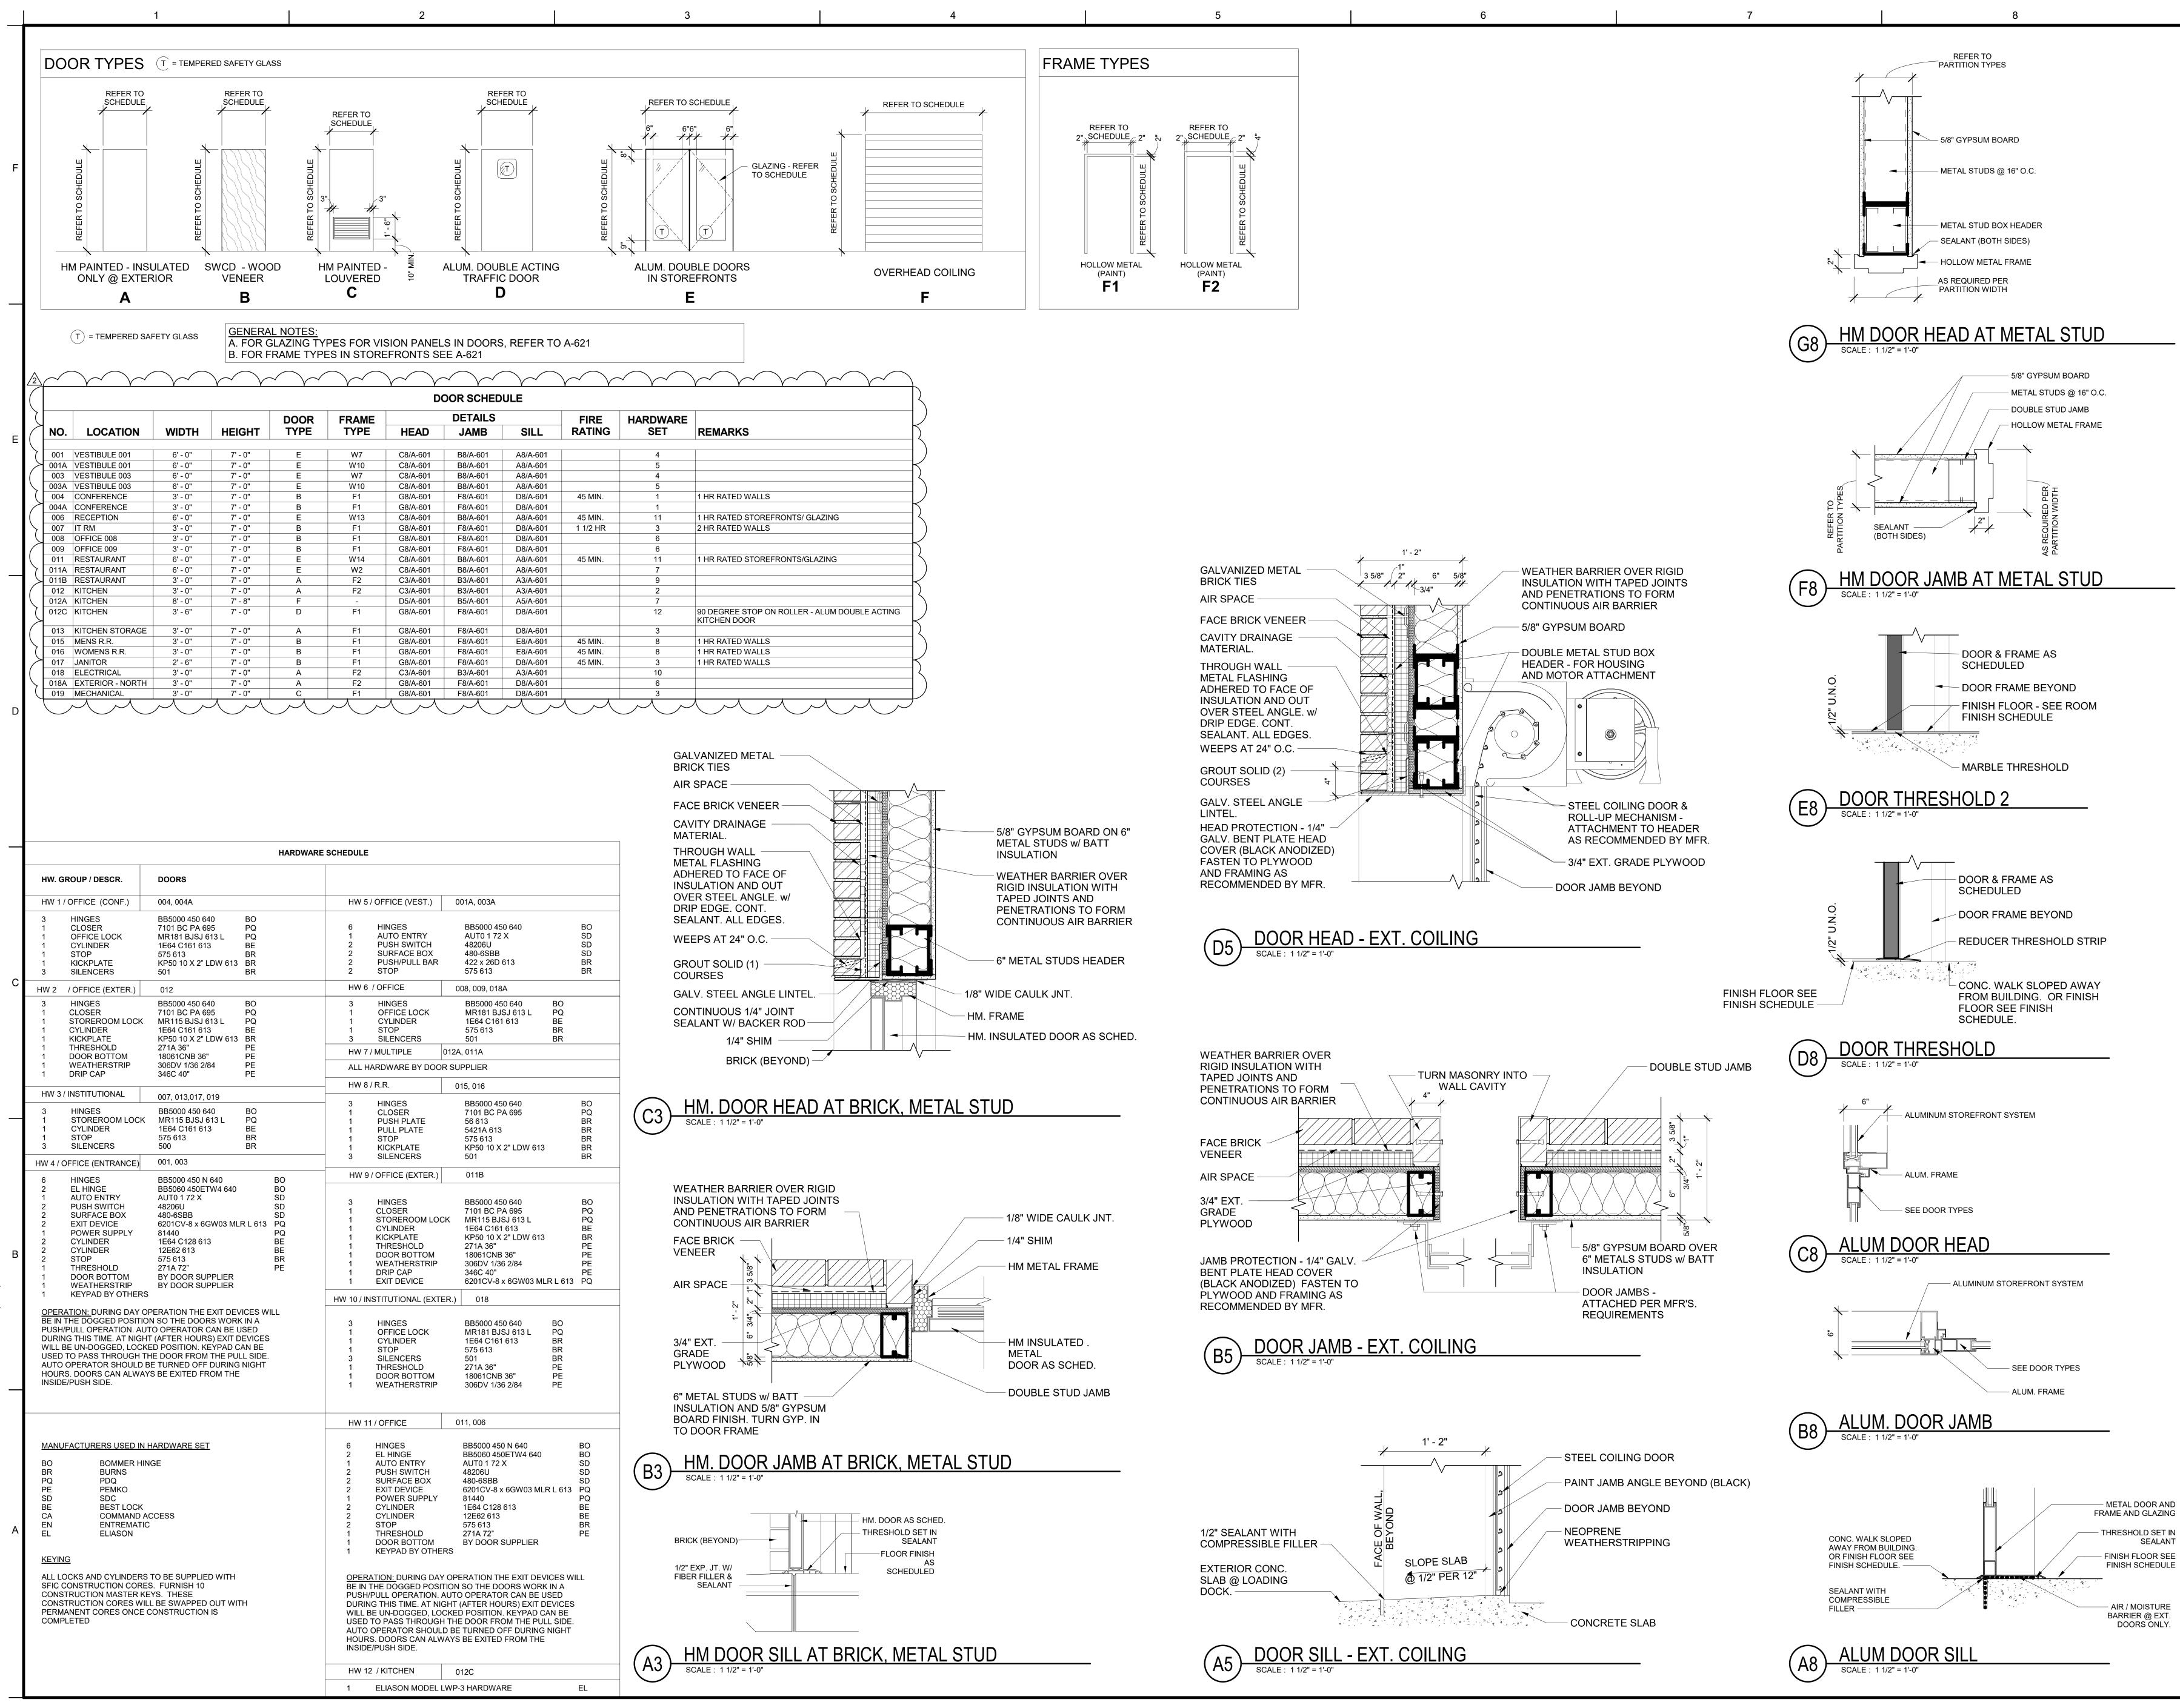


∞

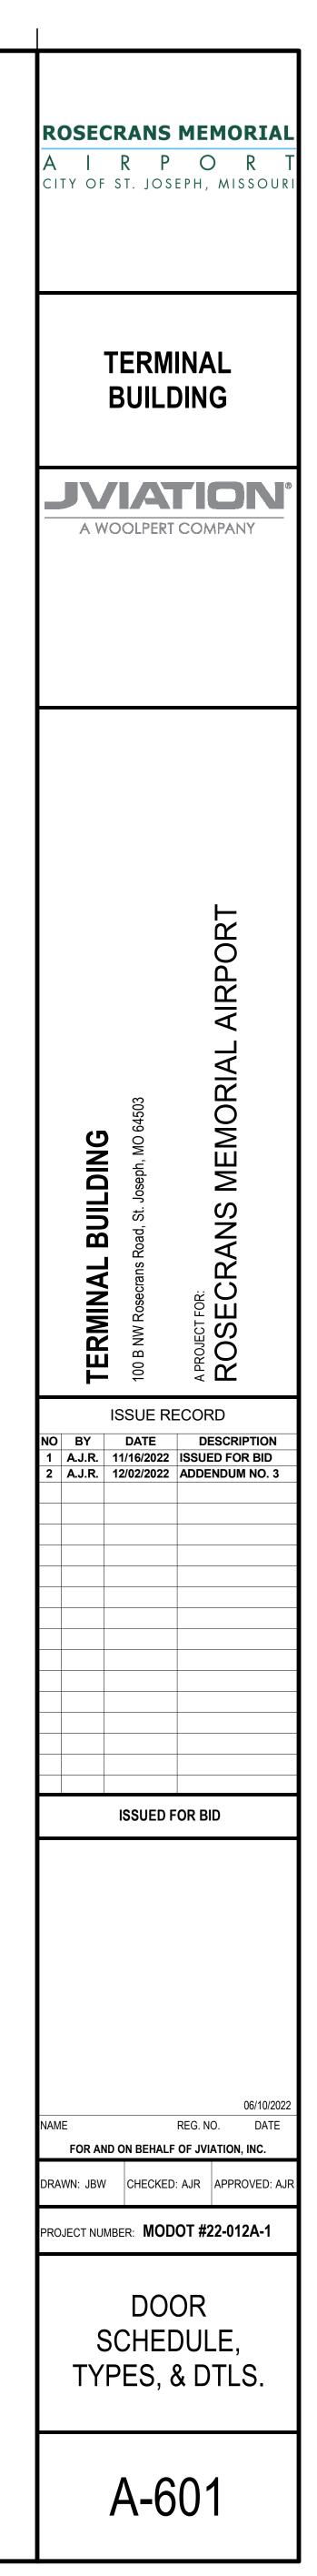

SEALANT

# SCHEDULE II ELECTRICAL VAULT BUILDING **ROSECRANS MEMORIAL AIRPORT** MODOT PROJECT NO. 22-012A-1

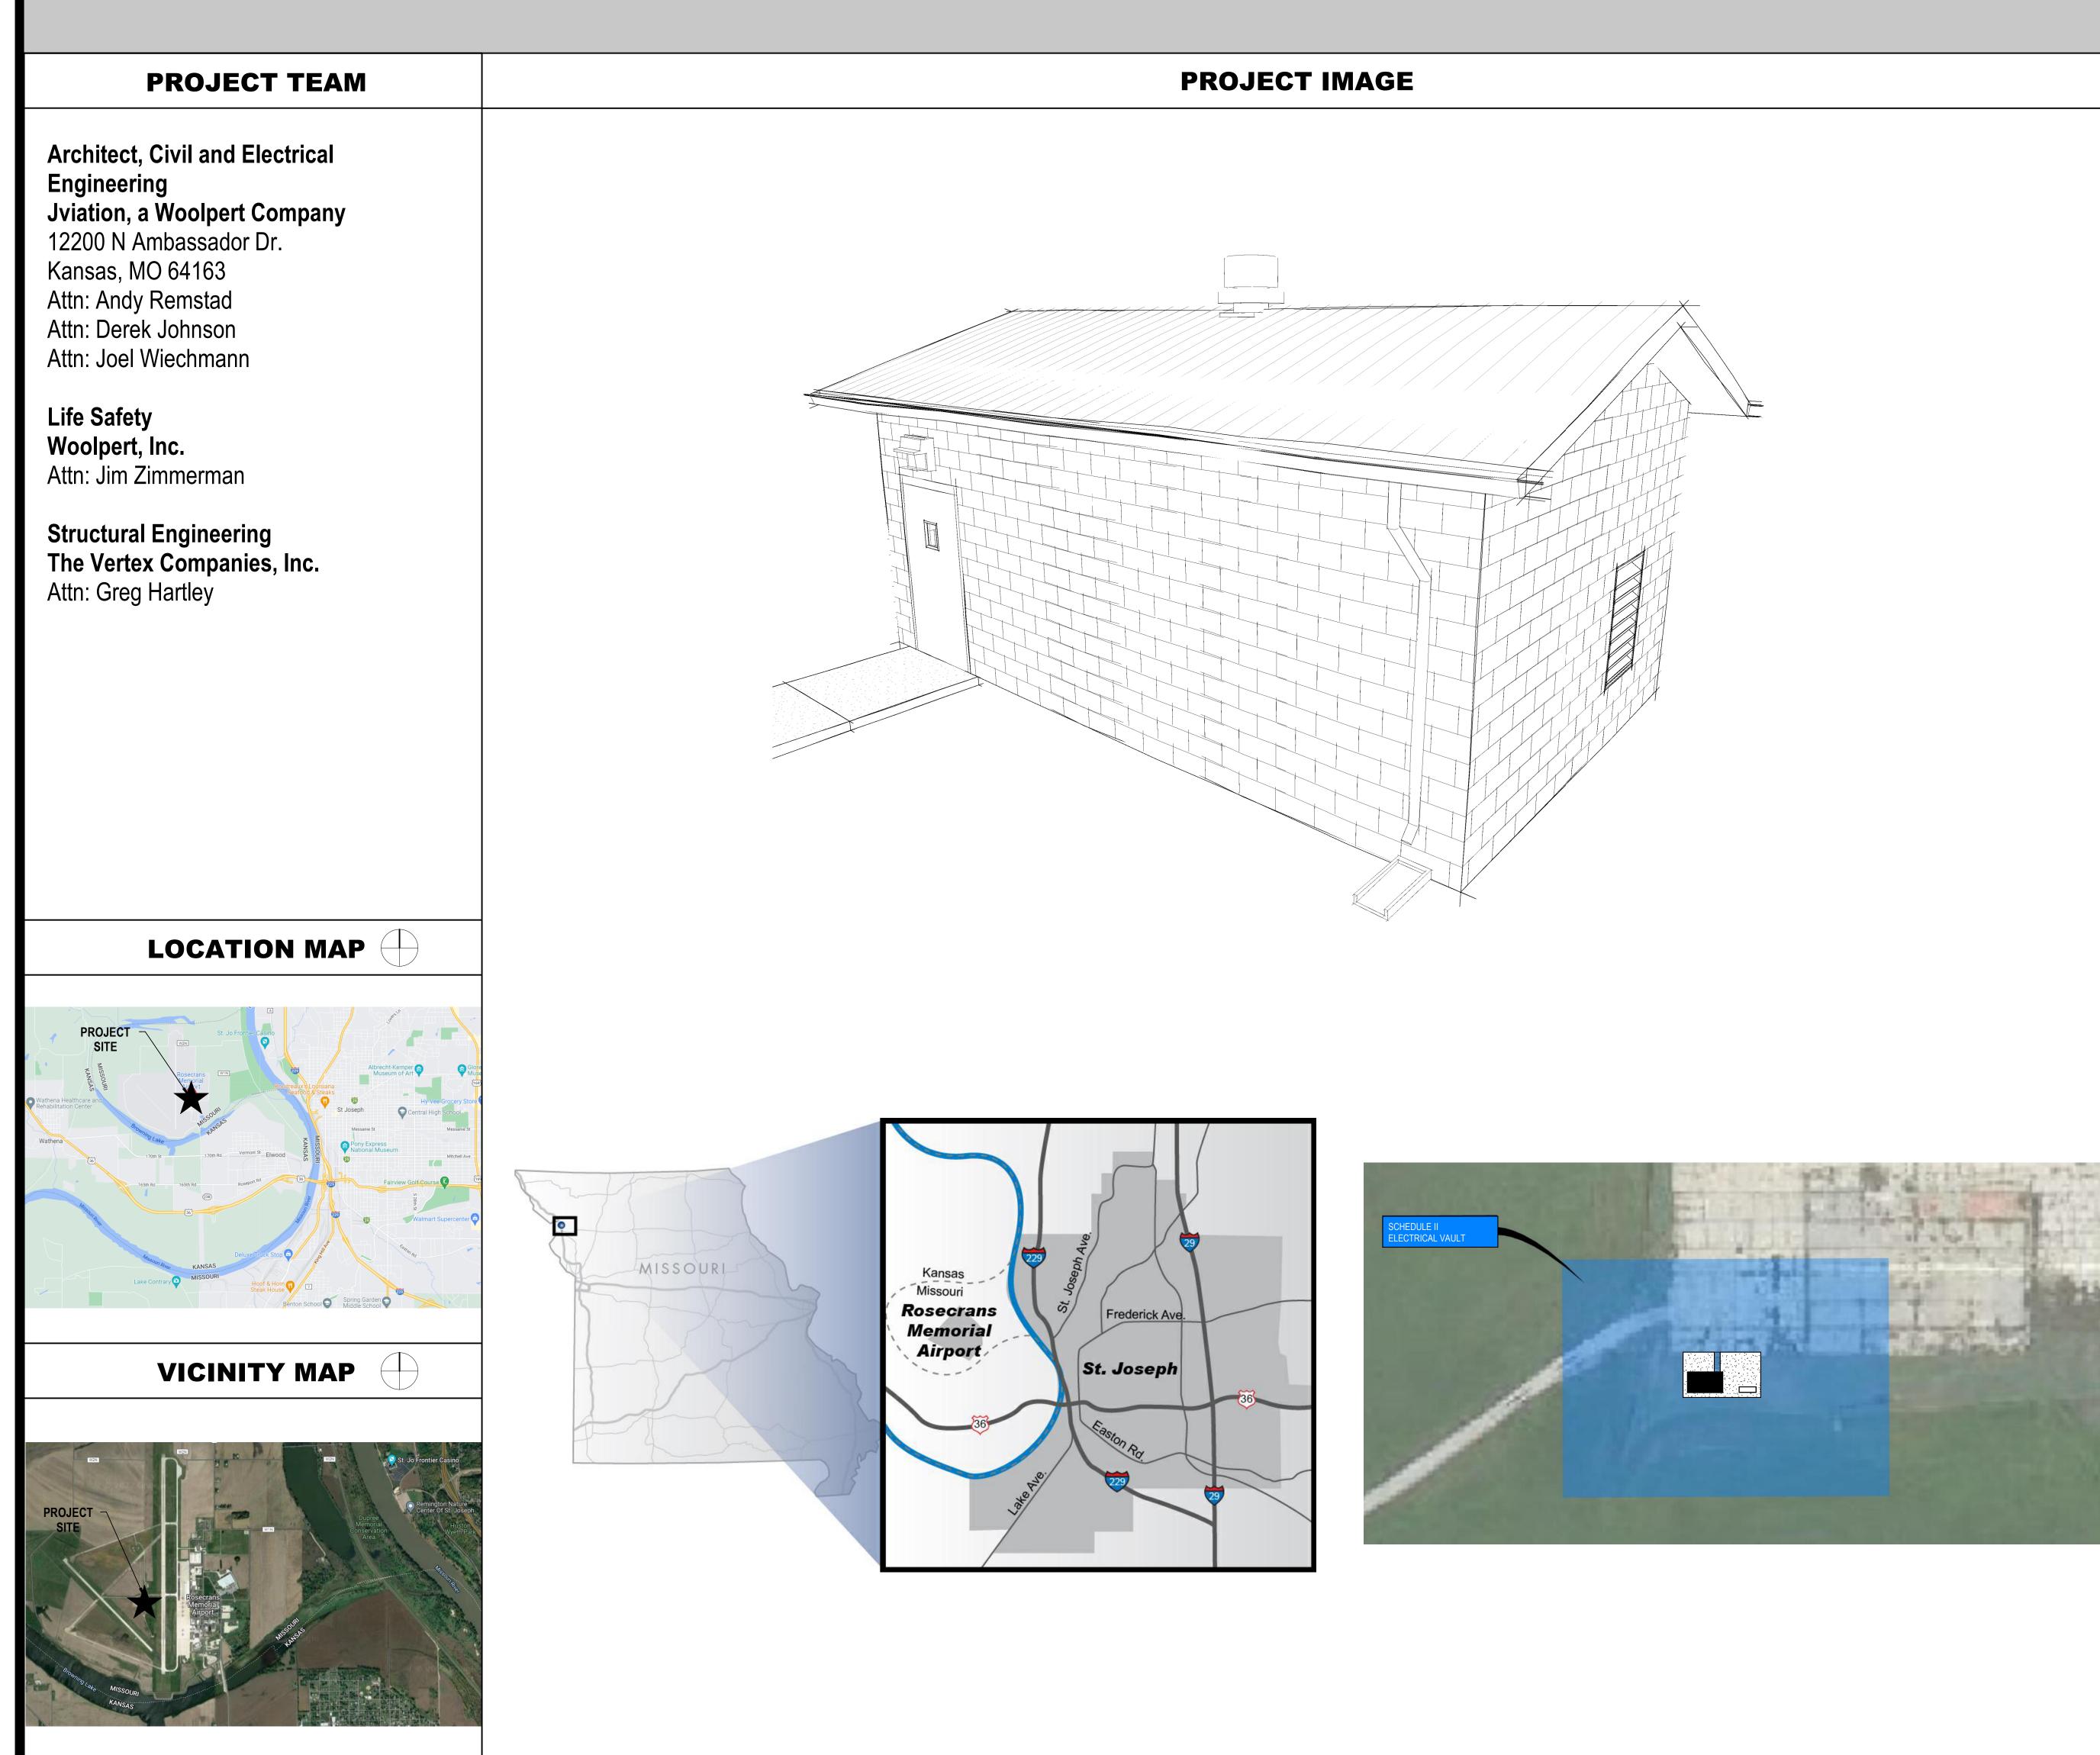

BIM 36

80

11:03:

)22

ISSUED FOR BID - 11-16-2022

	NUMBER	
(	NUN NUN	
ح		
Ś	SHEET	SHEET NAME
(	GENERAL	
کم	G-001	COVER SHEET
Ś	G-002	MASTER LEGEND & ABBREVIATIONS
(	LIFE SAFET	Y
کم	LS101	CODE SUMMARY AND LIFE SAFETY PLAN
Ś	CIVIL	
(	C-050	VAULT PHASING PLAN
2	C-300	VAULT GRADING, PLAN & PROFILE
{	C-301	VAULT GRADING, PLAN & PROFILE
	STRUCTUR	4L
}	S-100	GENERAL NOTES AND SPECIAL INSPECTIONS
5	S-200	FOUNDATION AND ROOF FRAMING PLAN
4	S-300	TYPICAL FOUNDATION AND FRAMING DETAILS
}	ARCHITECT	URAL
(	A-101	FLOOR PLAN AND ELEVATIONS
4	A-102	BUILDING SECTIONS
}	A-501	DETAILS
(	ELECTRICA	L
کم	E-300	ELECTRICAL PLAN
X	E-350	ELECTRICAL DETAILS
$2^{1}$	M	

