


MISSOURI STATE HIGHWAY DEPARTMENT

FED. ROAD DIST. NO.	STATE	FED. AID PROJ. NO.	FISCAL YEAR	SHEET NO.	TOTAL SHEETS
5	MO.		19	13	

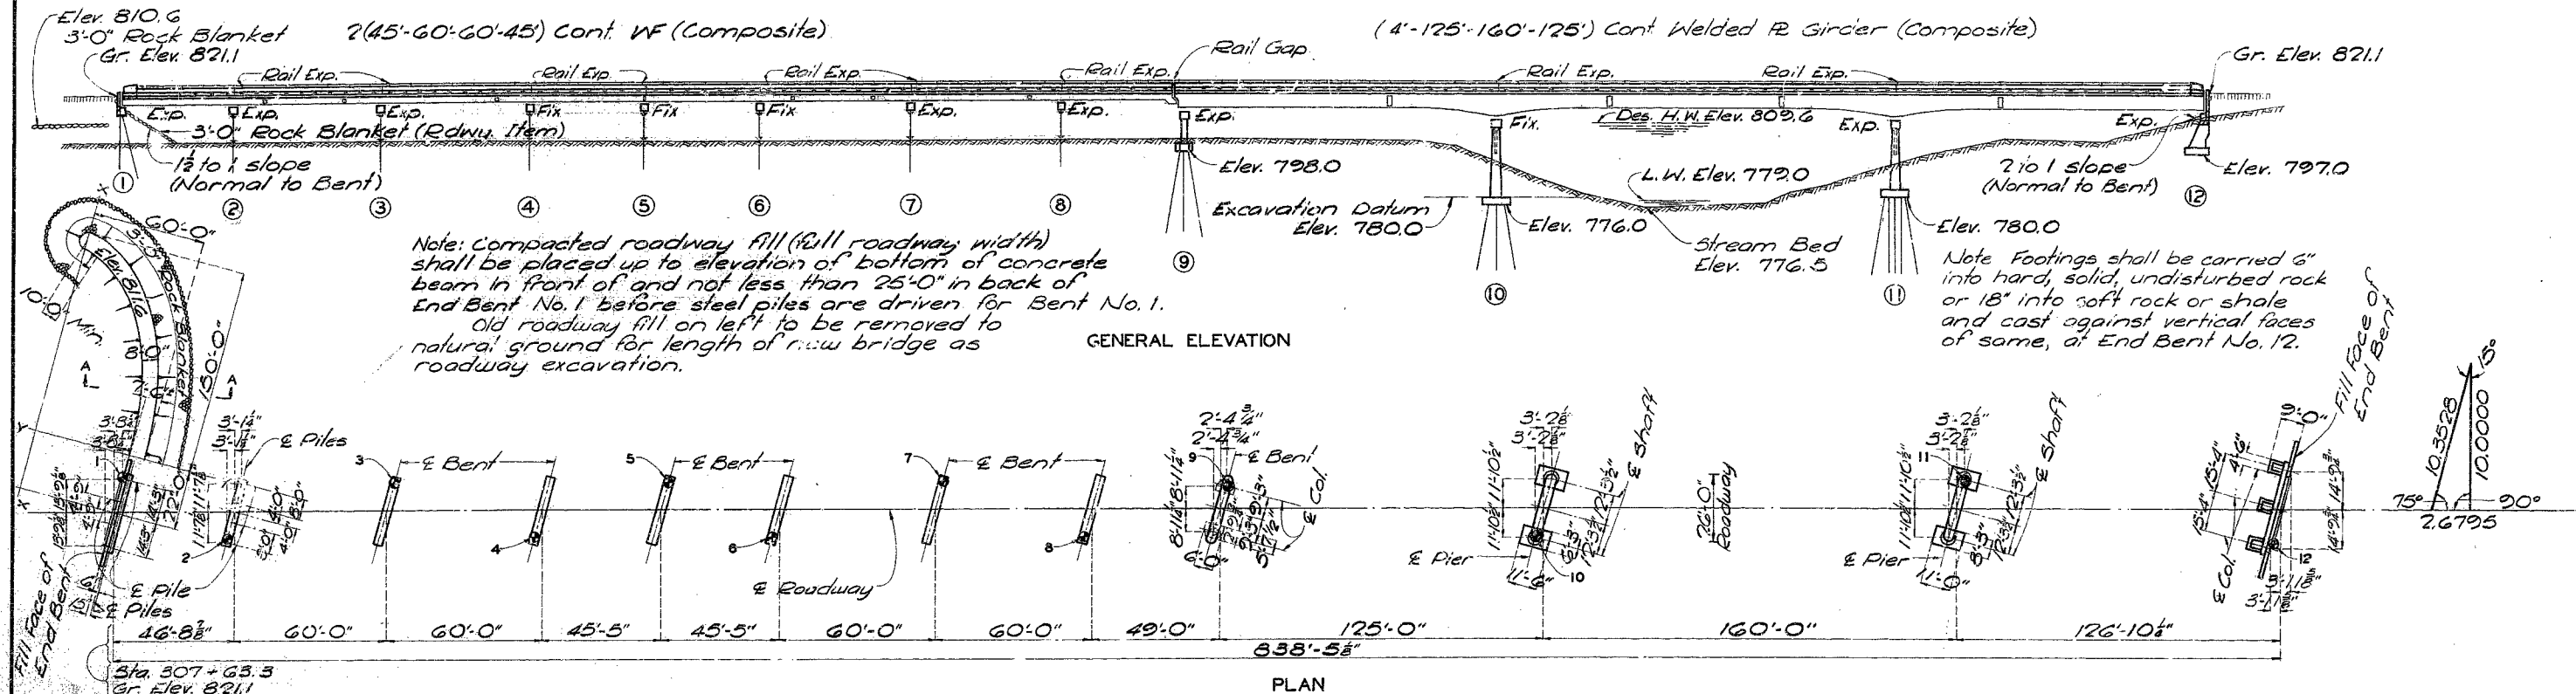


Note: Compacted roadway fill (full roadway width) shall be placed up to elevation of bottom of concrete beam in front of and not less than 25'-0" in back of End Bent No. 1 before steel piles are driven for Bent No. 1. Old roadway fill on left to be removed to natural ground for length of new bridge as roadway excavation.

Note: Footings shall be carried 6" into hard, solid, undisturbed rock or 18" into soft rock or shale and cast against vertical faces of same, at End Bent No. 12.

ESTIMATED QUANTITIES			
ITEM	SUBSTR.	SUPERSTR.	TOTAL
Class 1 Excavation for Structures	Cu. Yd. 525		525
Class 2 Excavation for Structures	Cu. Yd. 40		40
Steel Piles-in-Place (10")	Lin. Ft. 2216		2216
Steel Pile Cut-offs (10")	Lin. Ft. 114		114
Steel Piles-in-Place (12")	Lin. Ft. 556		556
Steel Pile Cut-offs (12")	Lin. Ft. 84		84
Class B Concrete	Cu. Yd. 251.0		251.0
Class B1 Concrete	Cu. Yd. 633.1		633.1
Reinforcing Steel	Lb. 30,170	181,740	211,910
Fabricated Structural Carbon Steel (WF-Beam span)	Lb. 182,800		191,000
Fabricated Structural Carbon Steel (R Gdr. span)	Lb. 343,600		343,600
Bridge Rail (Single tube type)	Lin. Ft. 1,650		1,650

Note: For Boring Data see sheet No. 30 of 17. * Indicates location of Boring.

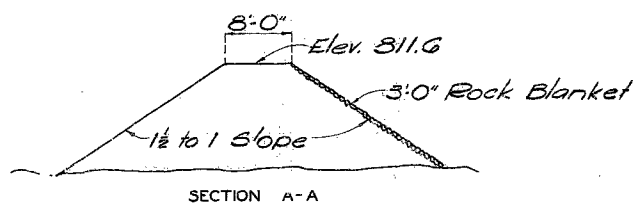

GENERAL NOTES:

SPECIFICATIONS:
A.A.S.H.O. - 1961

DESIGN LOADING:
H15-44 (15'/sq. ft. Future Wearing Surface)
Earth-120', Equivalent Fluid Pressure 30'


DESIGN UNIT STRESSES:
Class B Concrete (substructure) $f'_c = 1,200$ psi
Class B1 Concrete (superstructure) $f'_c = 1,600$ psi
Reinforcing Steel $f_y = 70,000$ psi
Structural Steel (A.S.T.M. A36-G2T) $f_y = 70,000$ psi
Steel Pile (A.S.T.M. A36-G2T) $f_b = 9,000$ psi

SURFACE SEAL:
Superstructure deck to be surface sealed.

FABRICATED STEEL:
Field connections, High Strength Bolts $\frac{3}{4}$ " ϕ , holes $\frac{13}{16}$ " ϕ except as noted.

WELDING:
Details of welded joints shown are for manual arc welding except as noted.

Note: No payment for excavation will be allowed at End Bent No. 1. Estimated weight of Fab. Str. Carbon Stl. (WF-Beam span) includes weight of Angles required for bent No. 2, 3, 4, 5, 6 - and 8. Levee to be removed (See Road Plans)

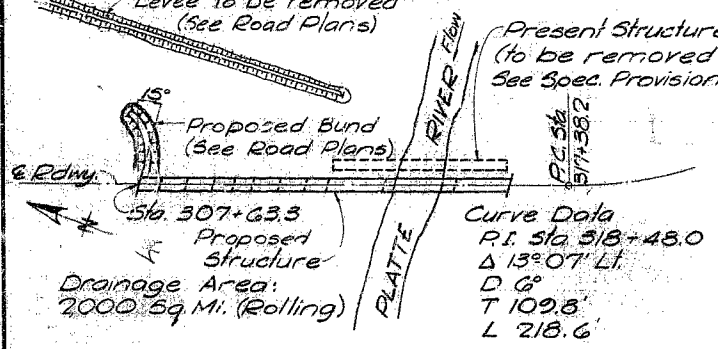

		FOOTING AND PILE DATA											
		BENT OR PIER NO.											
		1	2	3	4	5	6	7	8	9	10	11	12
SPREAD FOOTING	Foundation Material												Rock
	Design Bearing Tons/Sq. Ft.												7.0
BEARING PILE	Pile Type and Size	10BP42	10BP42	10BP42	10BP42	10BP42	10BP42	10BP42	10BP42	10BP42	12BP53	12BP53	
	Number	4	4	4	4	4	4	4	4	6	12	16	
	Approximate Length Ft.	60	65	65	65	65	65	65	65	45	20	25	
	Plan Bearing Tons	37	55	55	55	37	55	55	55	55	70	46	
	Minimum Required Bearing Tons	24	44	44	44	34	44	44	44	43	69	45	
Hammer		Power			Heavy Power			Power			Heavy Power		

Note: All pile shall be driven to practical refusal on or into solid rock or other point bearing material of not less than the Plan Bearing shown, unless excessive splicing is required to obtain Plan Bearing, in which case the engineer will authorize a lesser bearing, but in no case less than the Minimum Required Bearing. Where heavy power hammer is specified all piling shall be driven with an approved power hammer developing an energy of not less than 19,000 ft. lbs. and having a ram weighing not less than 4,500 lbs.

Note: This drawing is not to scale. Follow dimensions.

B.M. #3 Elev. 816.54 "a" in N.W. Cor. of S.W. Bridge Abut. 30' Lt. Sta. 316+00


BRIDGE OVER PLATTE RIVER
STATE ROAD FROM RTE. F SOUTHEAST TO EDGERTON
ABOUT 7.0 MILES E. OF JEARBORN
PROJECT NO. S-816 (2) (SZ) STA. 307+63.3
PLATTE COUNTY

SUBMITTED BY: *D.P. Jenkins* DATE: 10/2/65
APPROVED BY: *M.J. Miller* DATE: 10/2/65

DESIGNED March 1965 BY TAM
DETAILED June 1965 BY Bryan
CHECKED Sept. 1965 BY Ault

MISSOURI STATE HIGHWAY DEPARTMENT

FED. ROAD DIST. NO.	STATE	FED. AID PROJ. NO.	FISCAL YEAR	SHEET NO.	TOTAL SHEETS
5	MO.		19	15	

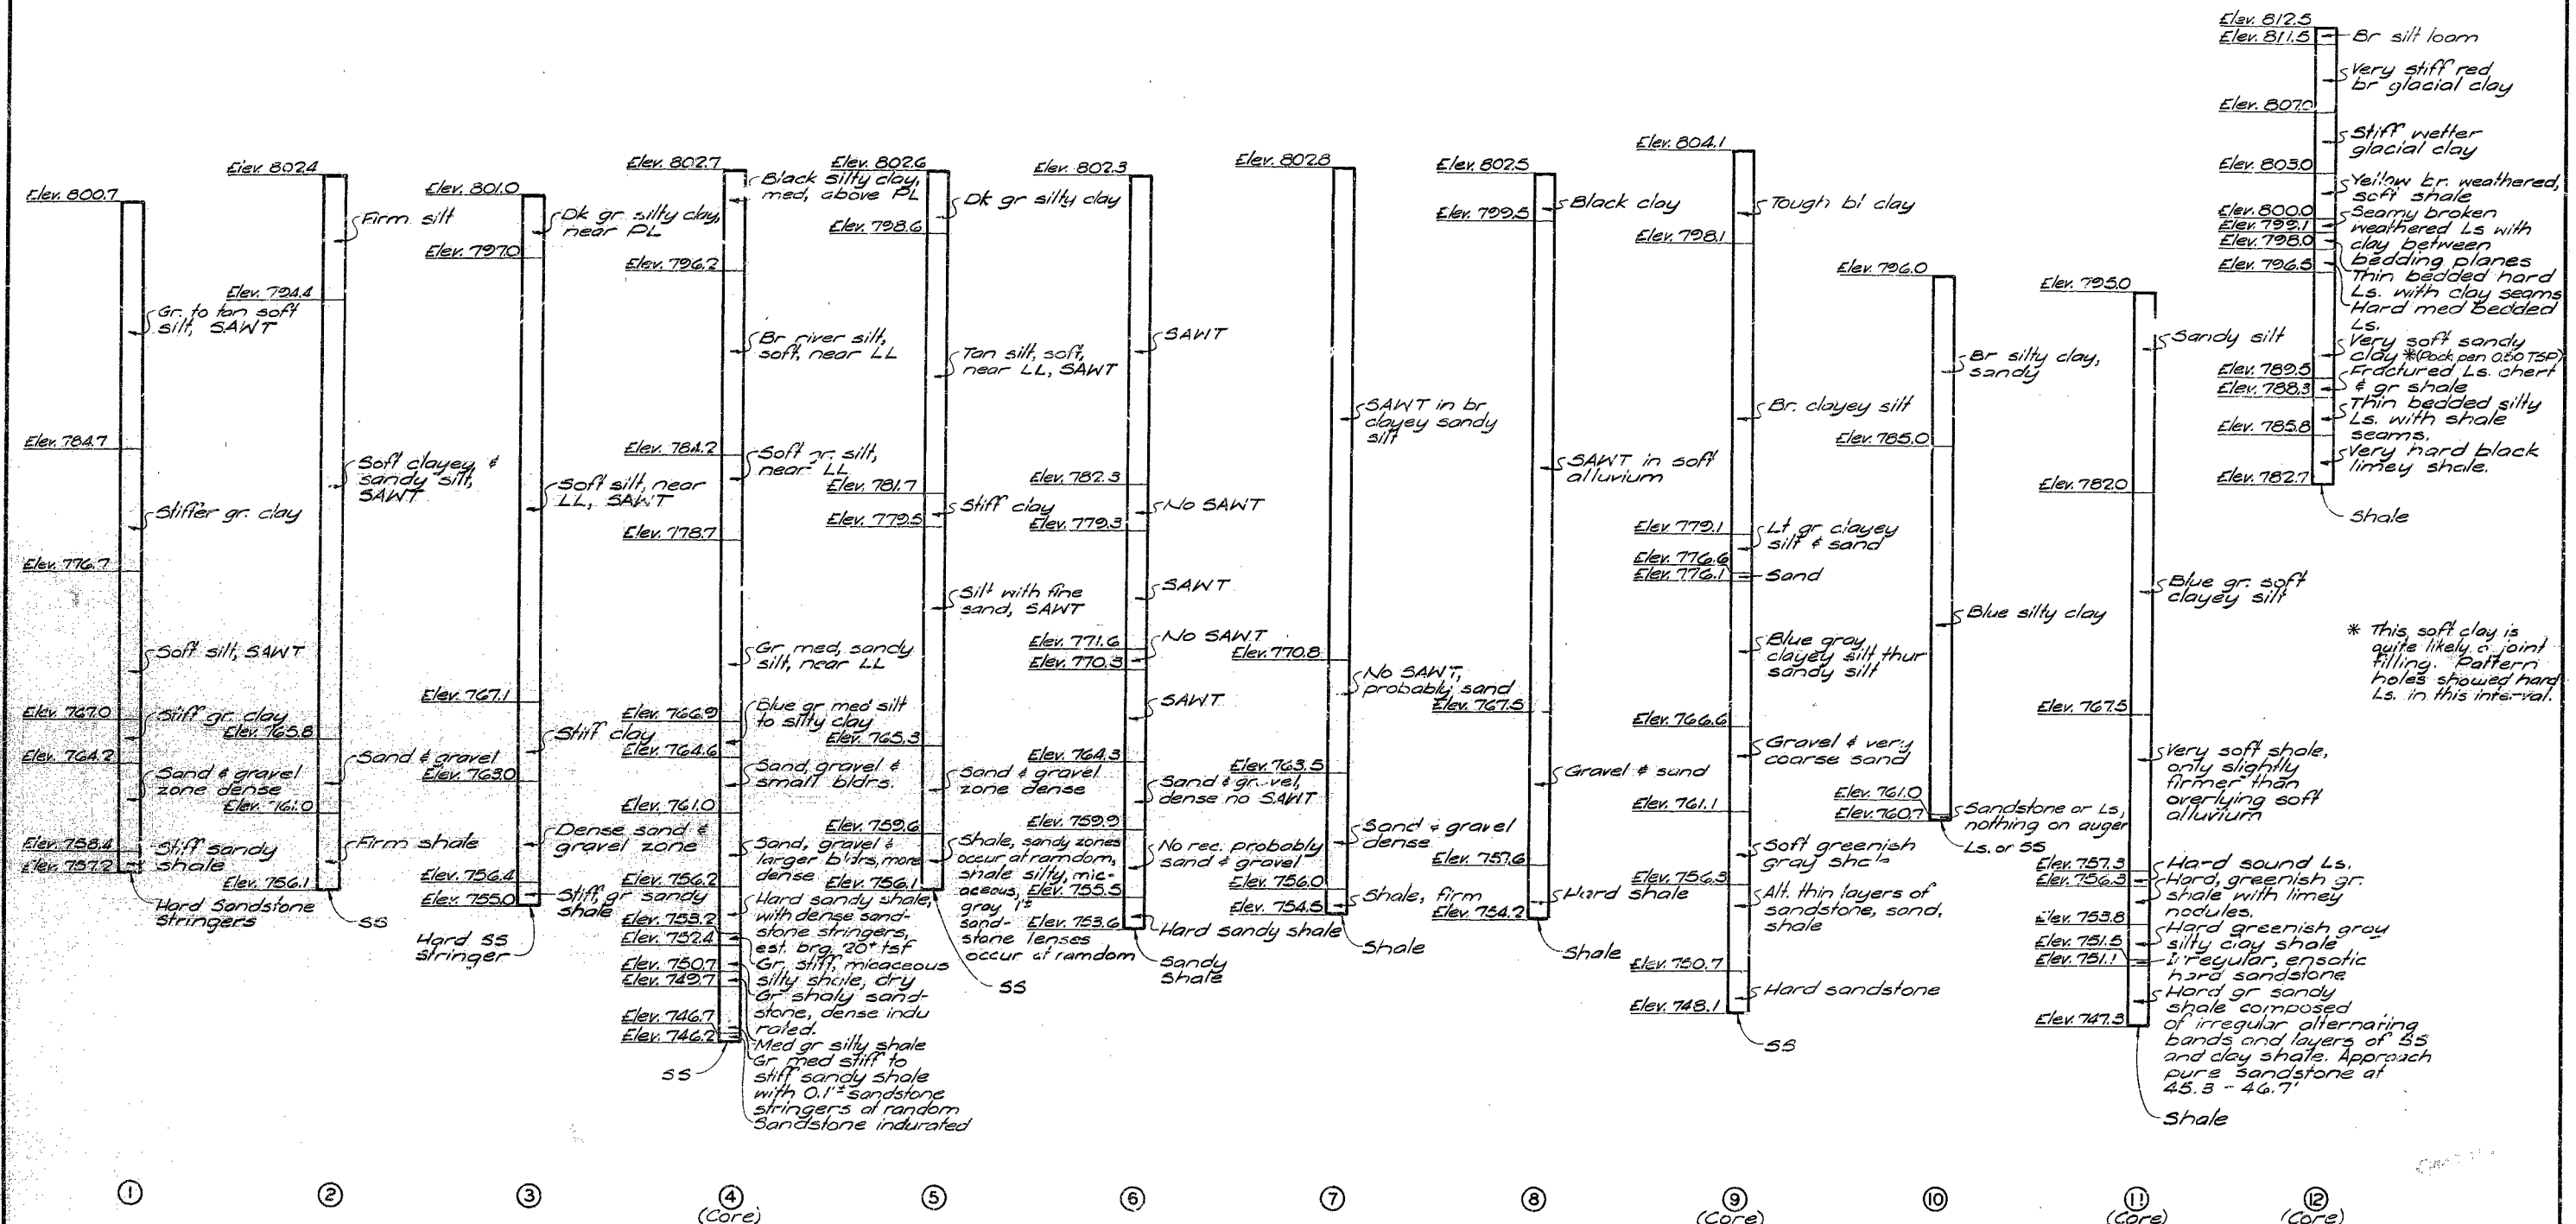

BORING DATA
 Note: "SAWT": Shoved augers without turning.

BRIDGE OVER PLATTE RIVER
 STATE ROAD FROM RTE. F SOUTHEAST TO EDGERTON
 ABOUT 70 MILES E. OF DEARBORN
 PROJECT NO. S-616(2) (SZ) STA. 307+63.3
 PLATTE COUNTY

DETAILED May 1965 BY Bryan
 CHECKED Sept. 1965 BY Ault

Note: This drawing is not to scale. Follow dimensions.


Sheet No. 3 of 17.

S-25R


105

MISSOURI STATE HIGHWAY DEPARTMENT

FED. ROAD DIST. NO.	STATE	FED. AID PROJ. NO.	FISCAL YEAR	SHEET NO.	TOTAL SHEETS
5	MO.		19	16	

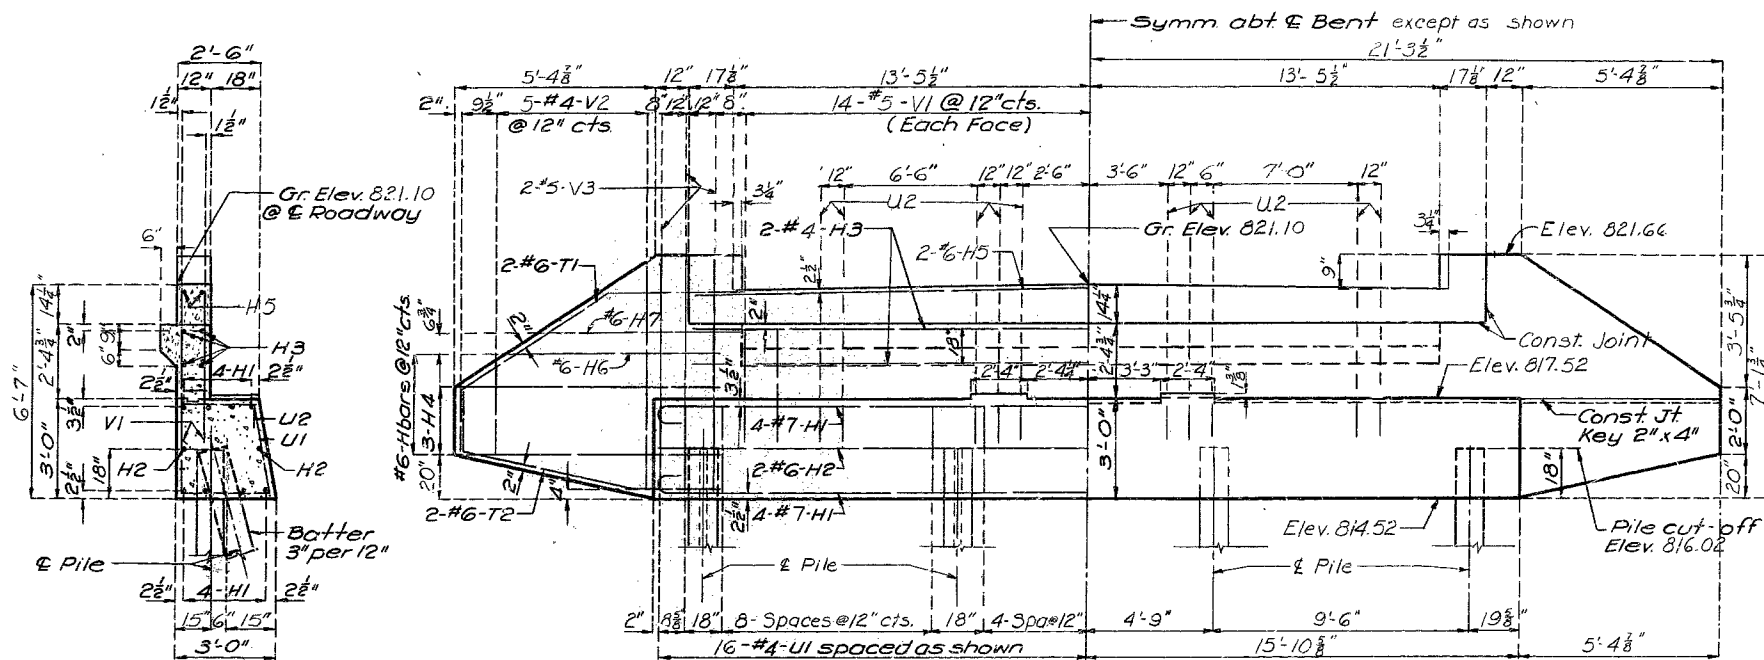


SECTION AT C

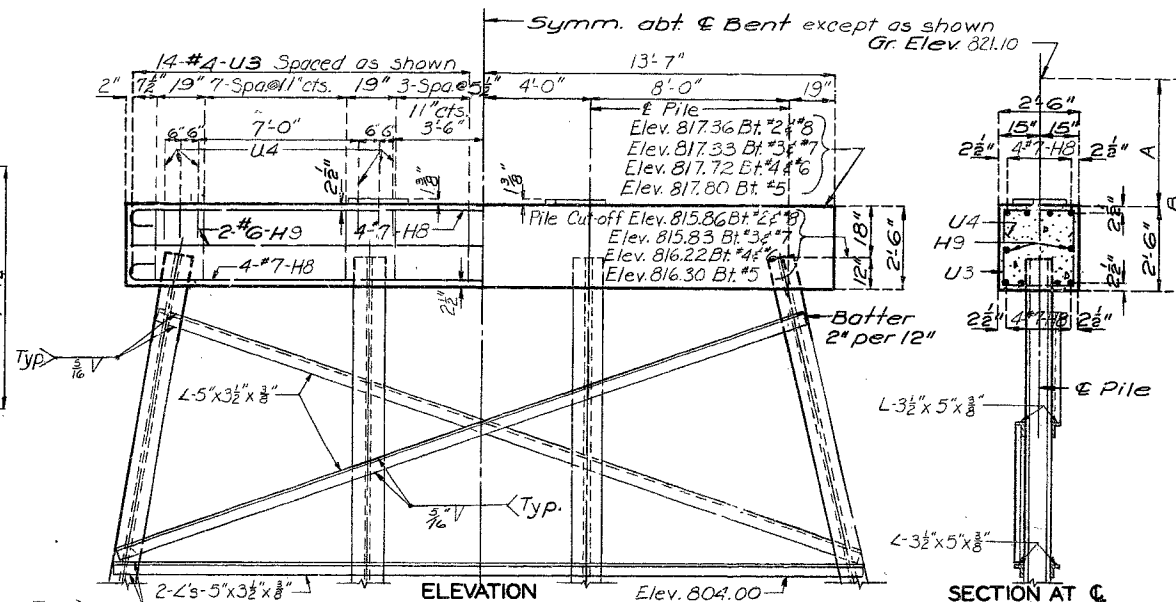


SECTION AT C


BENT	A	B
"2 8" 8	3'-8 3/8"	6'-2 3/8"
"3 8" 7	3'-9 3/8"	6'-3 3/8"
"4 8" 6	3'-4 1/2"	5'-10 1/2"
"5	3'-3 3/8"	5'-9 3/8"

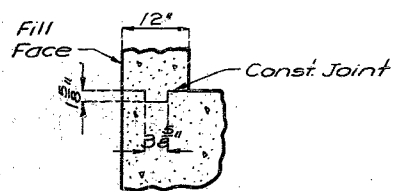


DETAIL OF KEYED CONST. JOINT

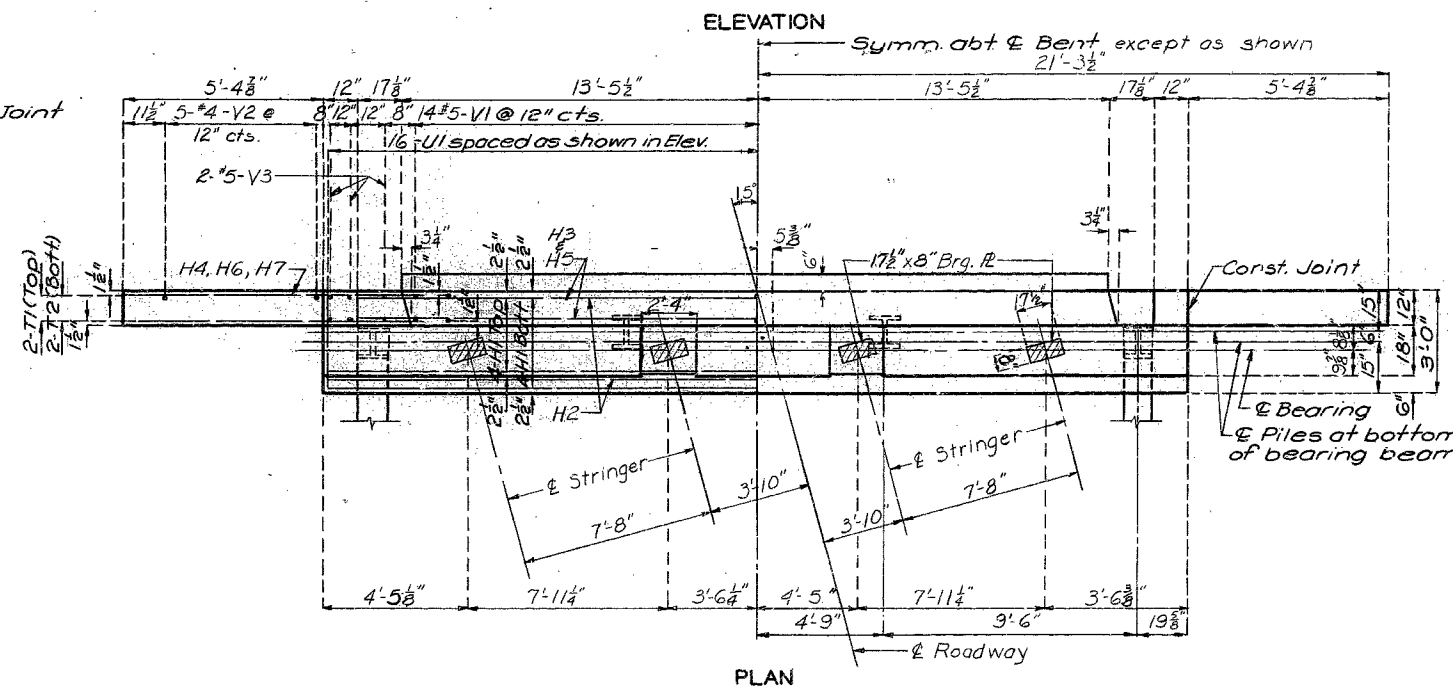


DETAILS OF END BENT NO. 1

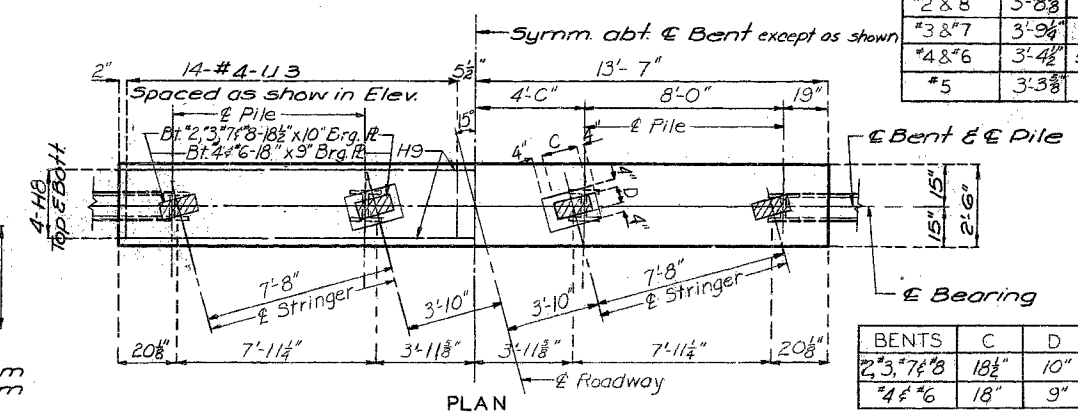

DETAILS OF INTERMEDIATE BENTS NO. 2,3,4,6,7&8

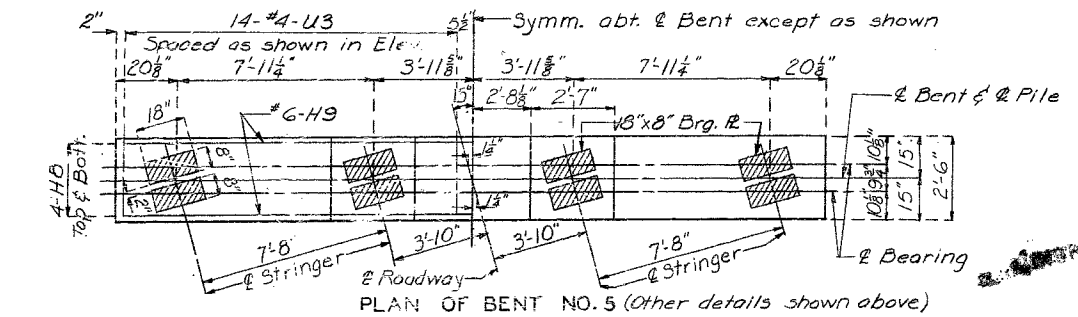

BENTS	C	D
"2 3" 7 1/2" 8	18 1/2"	10"
"4 4" 6	18"	9"

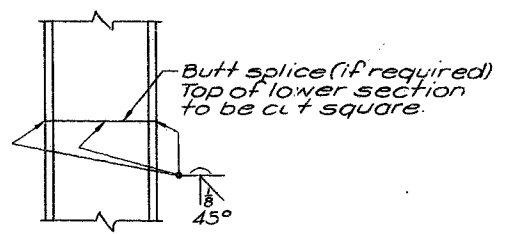

DETAIL OF STEEL PILE SPLICE

Note: Fill at end bent No. 1 shall not be carried above bottom of beam and wings until adjacent superstructure span is in place.
Top of backwall and expansion device for end bent No. 1 to conform to crown of roadway slab.
Backwall above upper construction joint shall not be poured until the structural steel of the expansion device has been installed and slab has been poured in adjacent span.

Note: This drawing is not to scale. Follow dimensions.

Sheet No. 4 of 17.

BRIDGE OVER PLATTE RIVER
STATE ROAD FROM RTE. F SOUTHEAST TO EDGERTON
ABOUT 7.0 MILES E. OF DEARBORN
PROJECT NO. S-616(2) (SZ) STA. 307+63.3
PLATTE COUNTY

S-25R

106


No. 9.1 Revised Mar. 1964

DETAILED APRIL 1965 BY CARTER
CHECKED Sept. 1965 BY AULT

NO CONSTRUCTION LINES

MISSOURI STATE HIGHWAY DEPARTMENT

FED. ROAD DIST. NO.	STATE	FED. AID PROJ. NO.	FISCAL YEAR	SHEET NO.	TOTAL SHEETS
5	MO.		19	17	

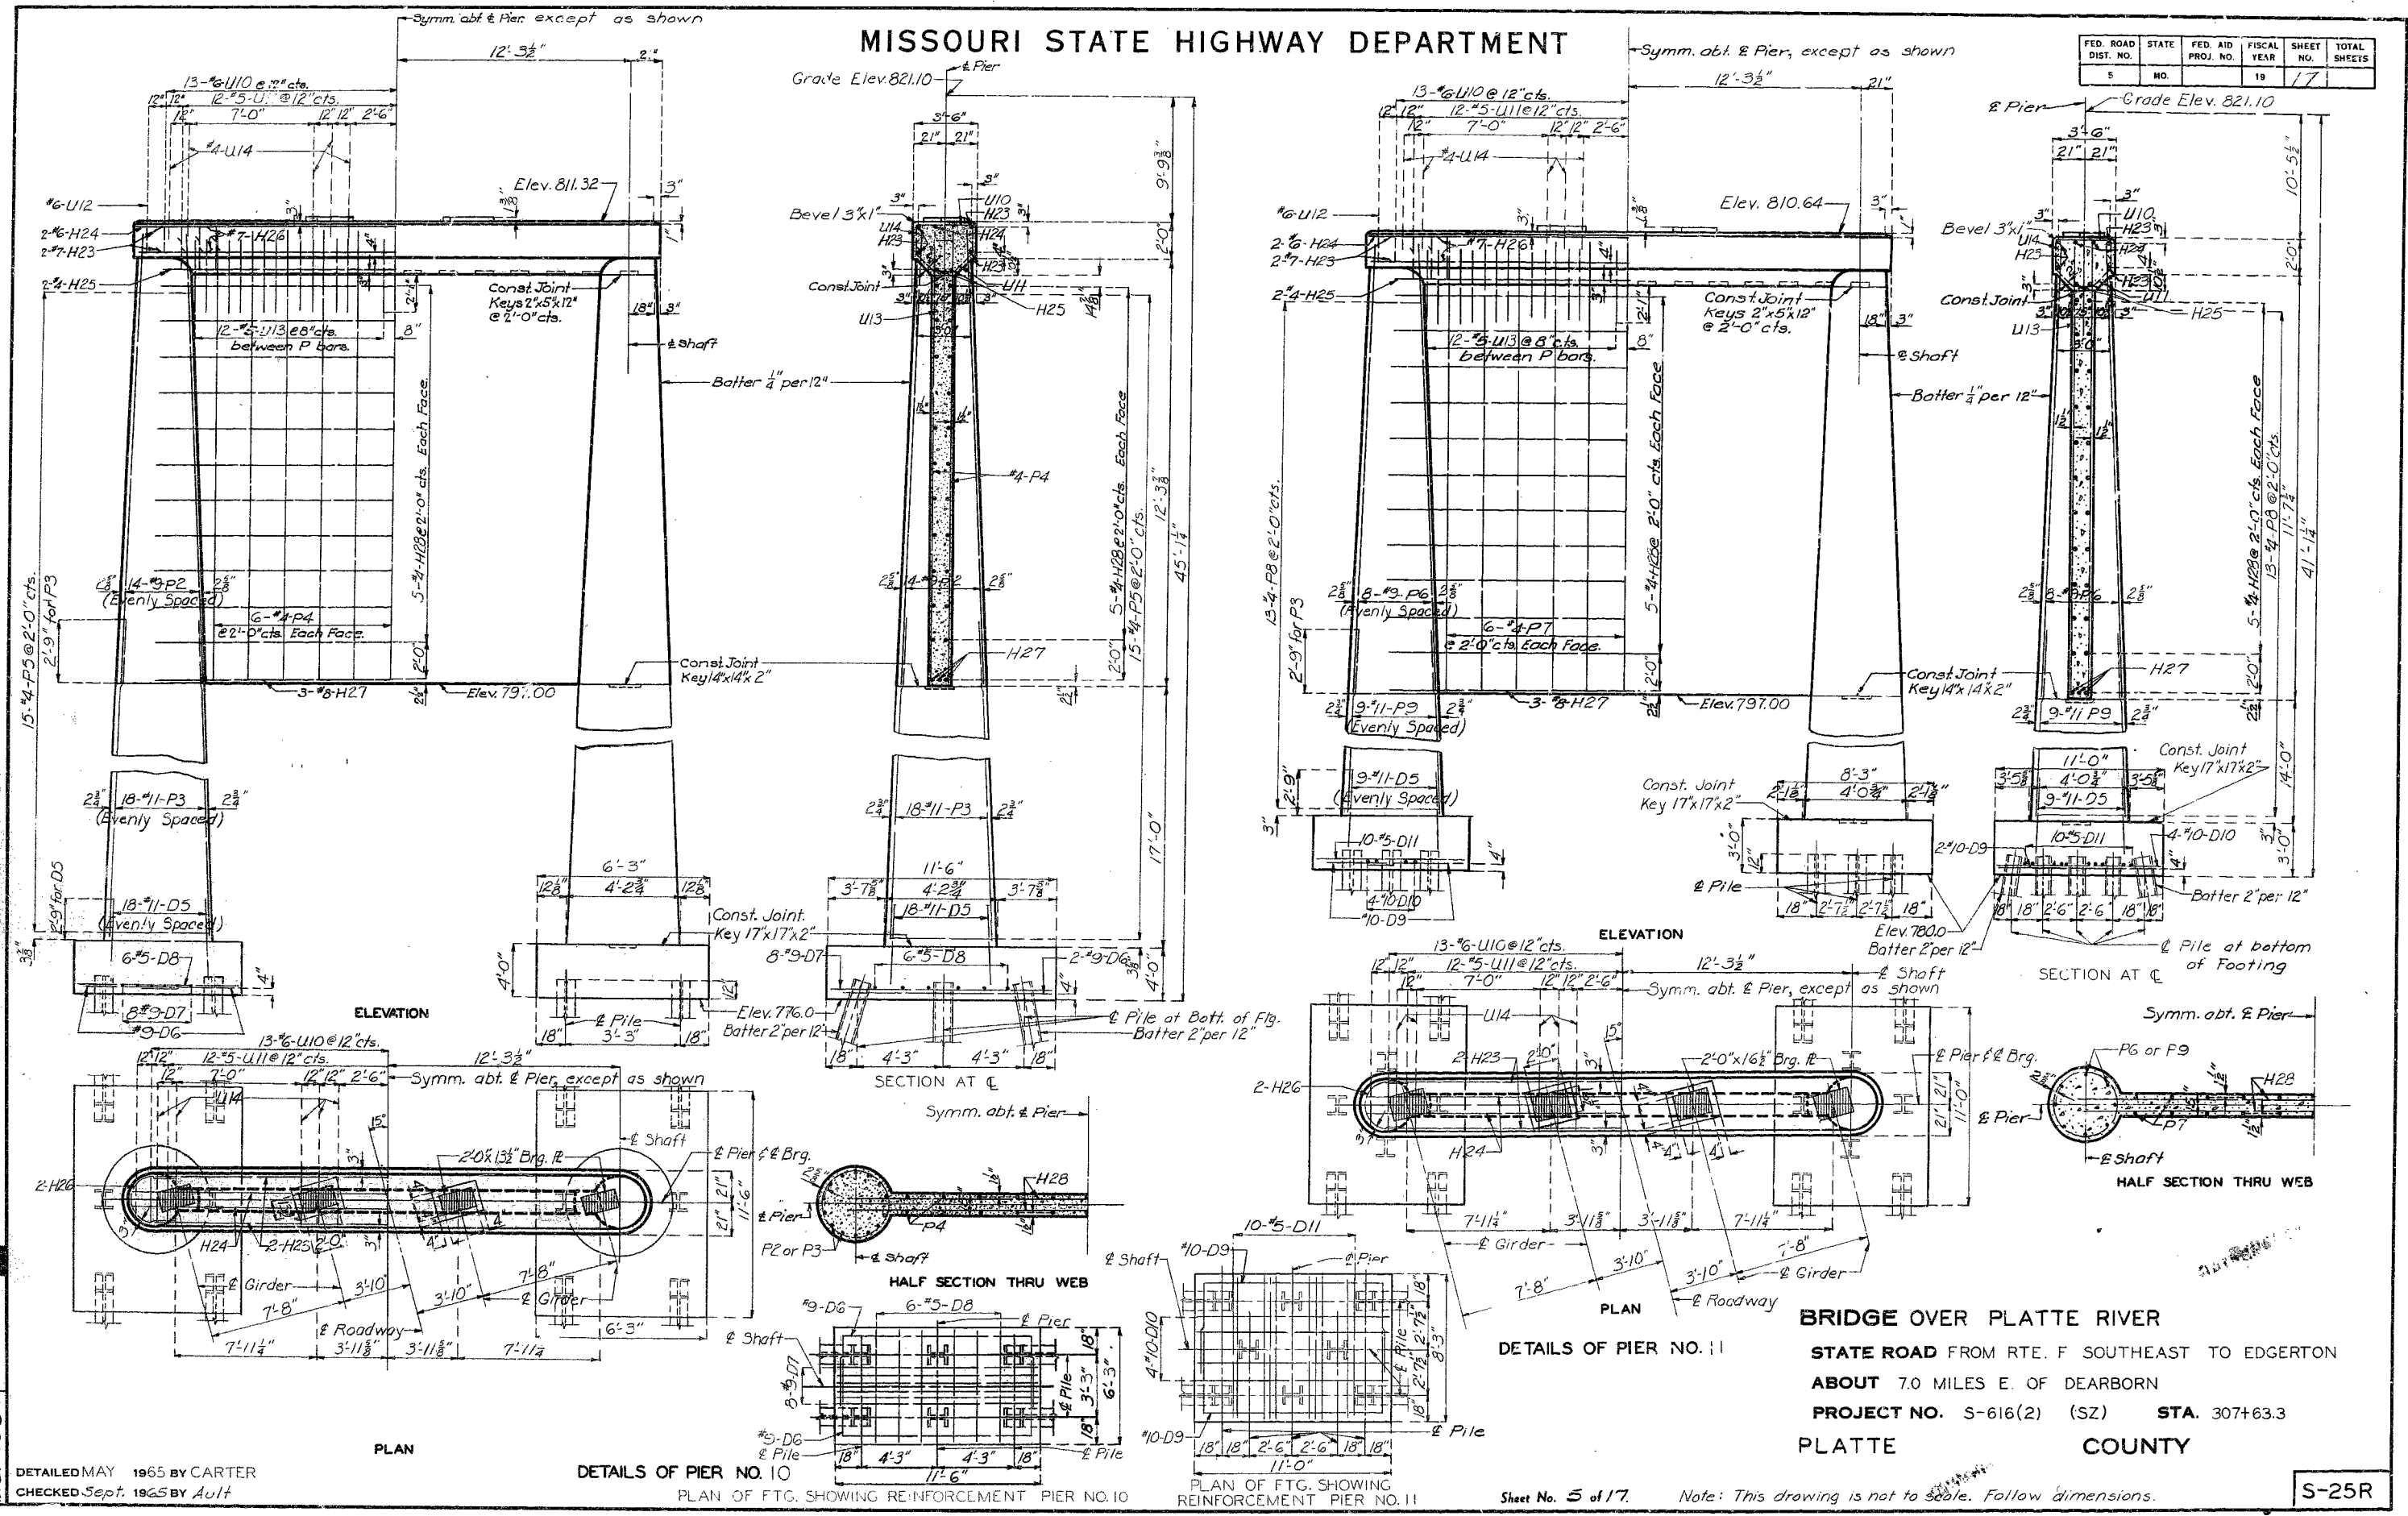

BRIDGE OVER PLATTE RIVER
 STATE ROAD FROM RTE. F SOUTHEAST TO EDGERTON
 ABOUT 7.0 MILES E. OF DEARBORN
 PROJECT NO. S-616(2) (SZ) STA. 307+63.3
 PLATTE COUNTY

DETAILS OF PIER NO. 11

DETAILS OF PIER NO. 10

PLAN OF FTG. SHOWING REINFORCEMENT PIER NO. 11

PLAN OF FTG. SHOWING REINFORCEMENT PIER NO. 10

Sheet No. 5 of 17. Note: This drawing is not to scale. Follow dimensions.

S-25R

107



No. 20.2 Revised
 Mar. 1964

DETAILED MAY 1965 BY CARTER
 CHECKED Sept. 1965 BY Ault

NO CONSTRUCTION CHANGES

MISSOURI STATE HIGHWAY DEPARTMENT

FED. ROAD DIST. NO.	STATE	FED. AID PROJ. NO.	FISCAL YEAR	SHEET NO.	TOTAL SHEETS
5	MO.		19	13	

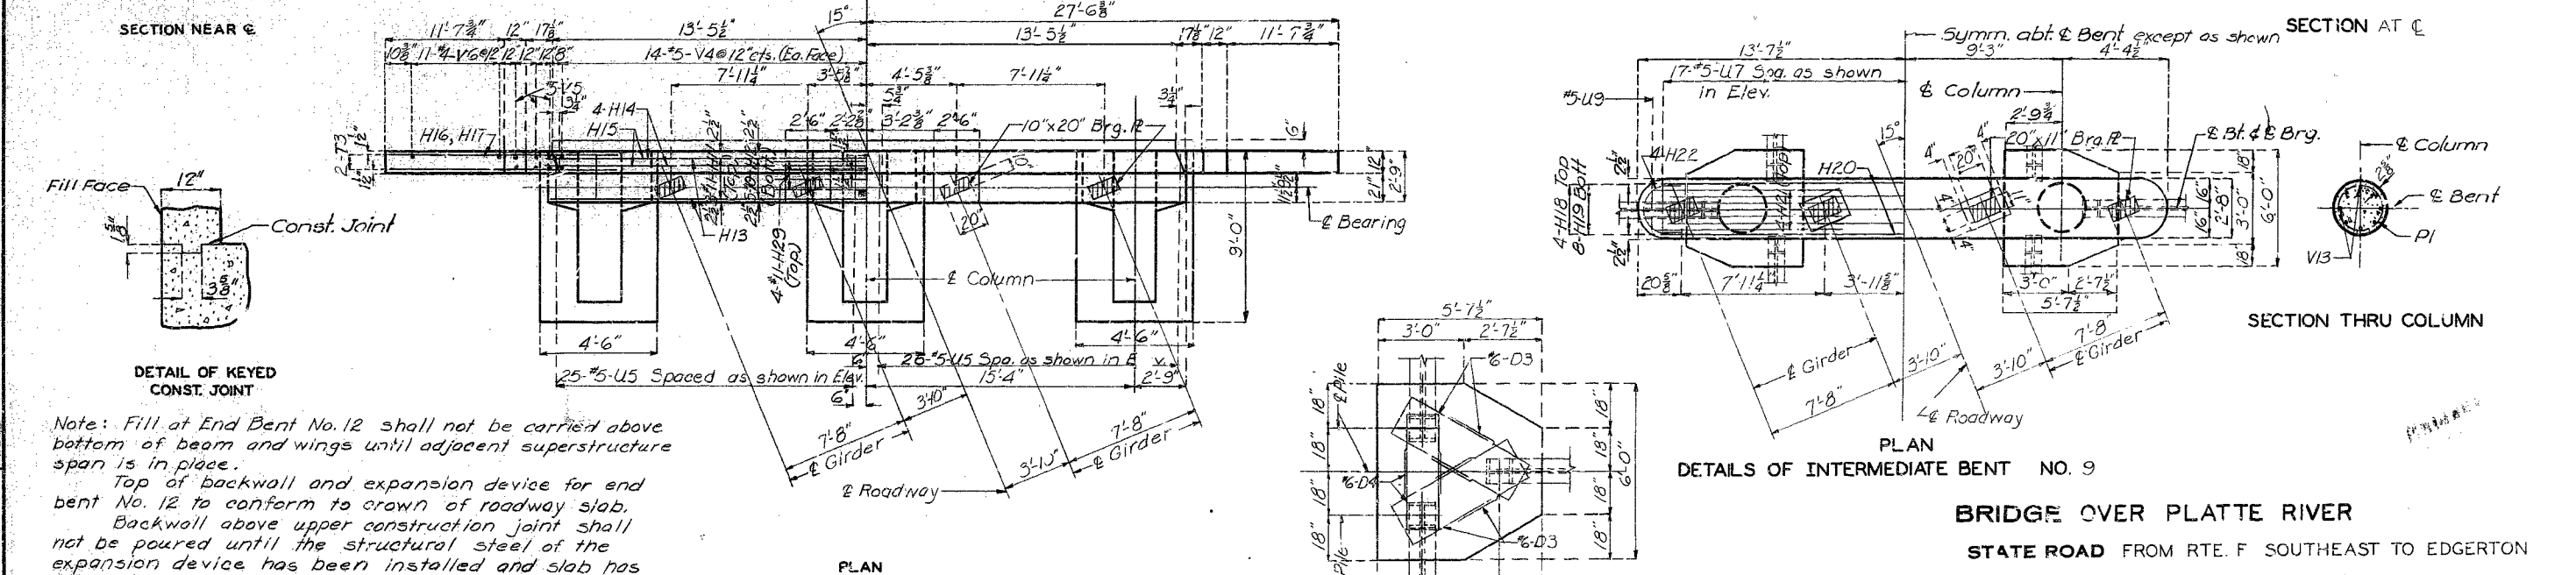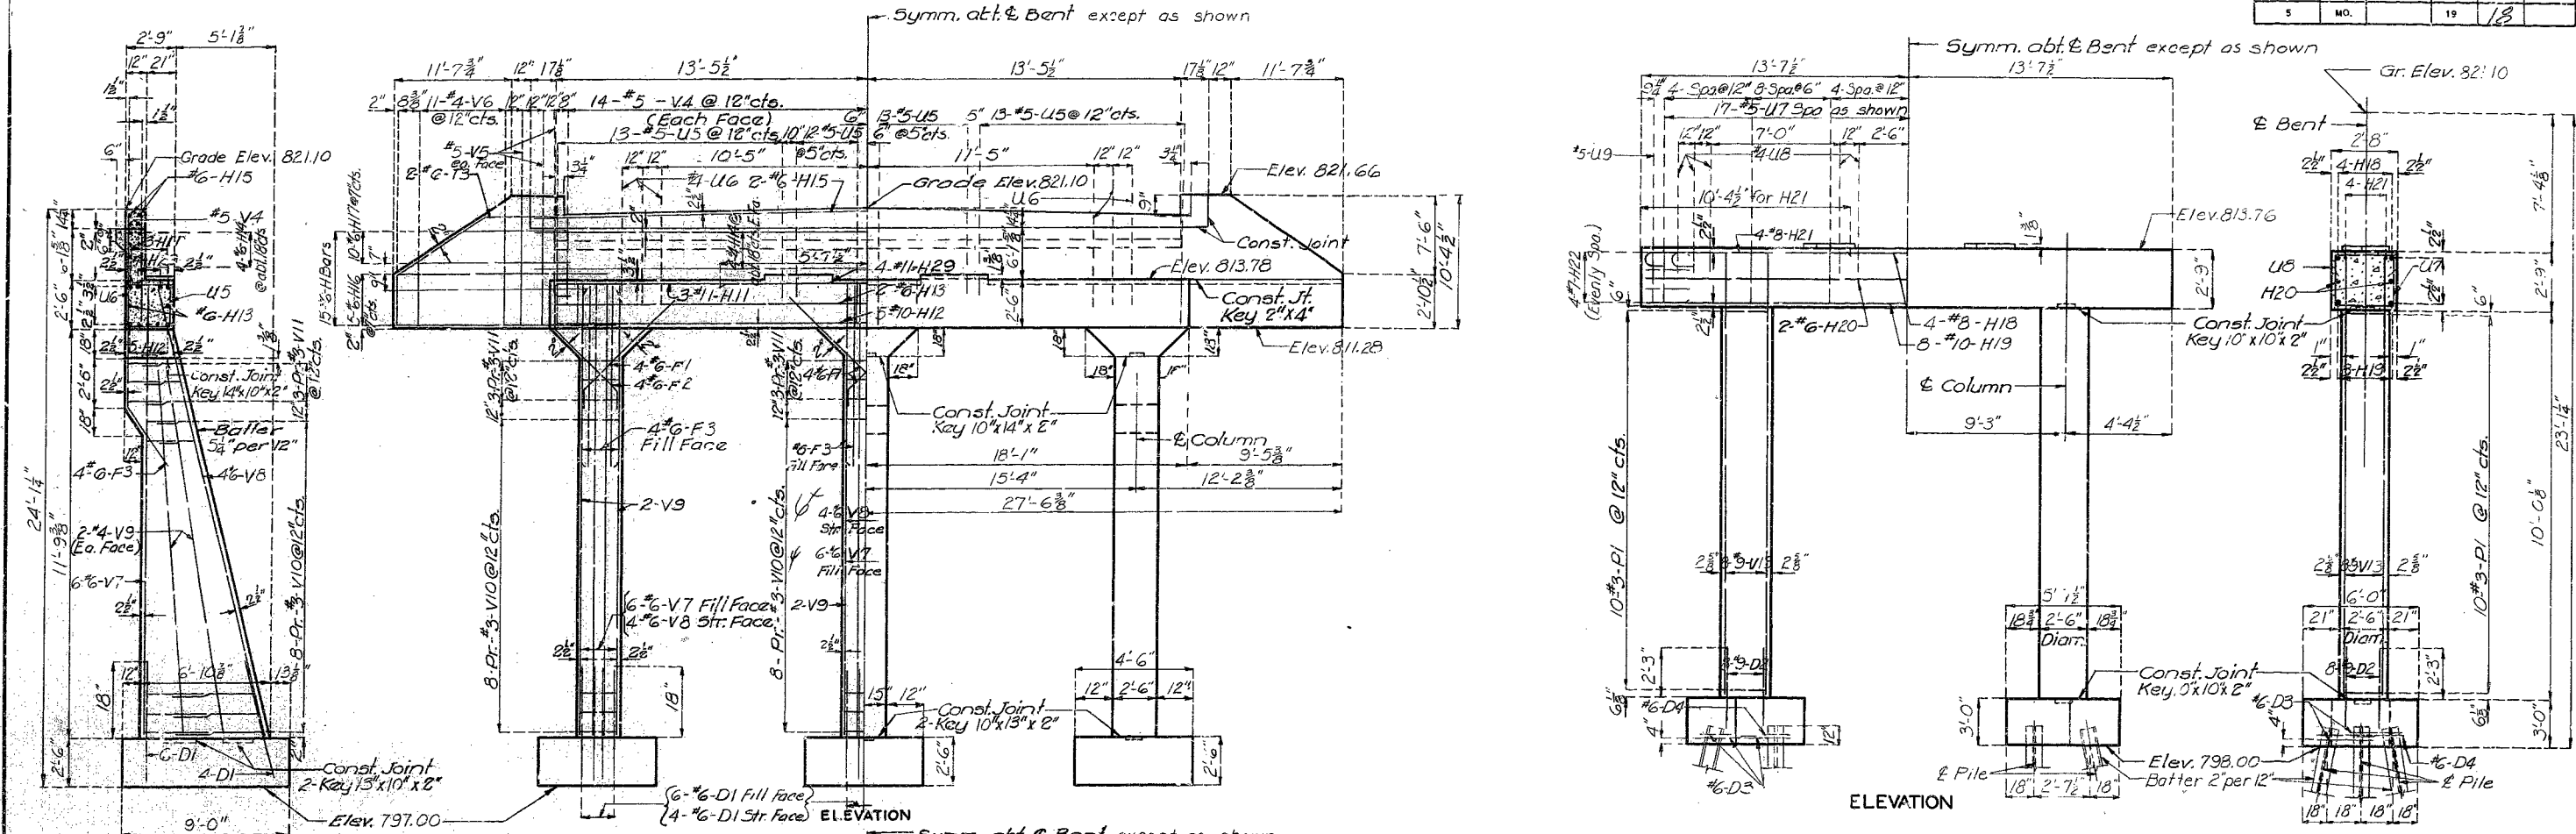

Note: Fill at End Bent No. 12 shall not be carried above bottom of beam and wings until adjacent superstructure span is in place.
 Top of backwall and expansion device for end bent No. 12 to conform to crown of roadway slab.
 Backwall above upper construction joint shall not be poured until the structural steel of the expansion device has been installed and slab has been poured in adjacent span.

108

DETAILED MAY 1965 BY CARTER
 CHECKED Sept. 1965 BY Ault

Note: This drawing is not to scale. Follow dimensions.

Sheet No. 6 of 17.


SEE FINAL PLANS IN DWG. LIB.

BRIDGE OVER PLATTE RIVER
 STATE ROAD FROM RTE. F SOUTHEAST TO EDGERTON
 ABOUT 7.0 MILES E. OF DEARBORN
 PROJECT NO. S-616 (2) (SZ) STA. 307+63.3
 PLATTE COUNTY

S-25R

MISSOURI STATE HIGHWAY DEPARTMENT

FED. ROAD DIST. NO.	STATE	FED. AID PROJ. NO.	FISCAL YEAR	SHEET NO.	TOTAL SHEETS
5	MO.		19	19	

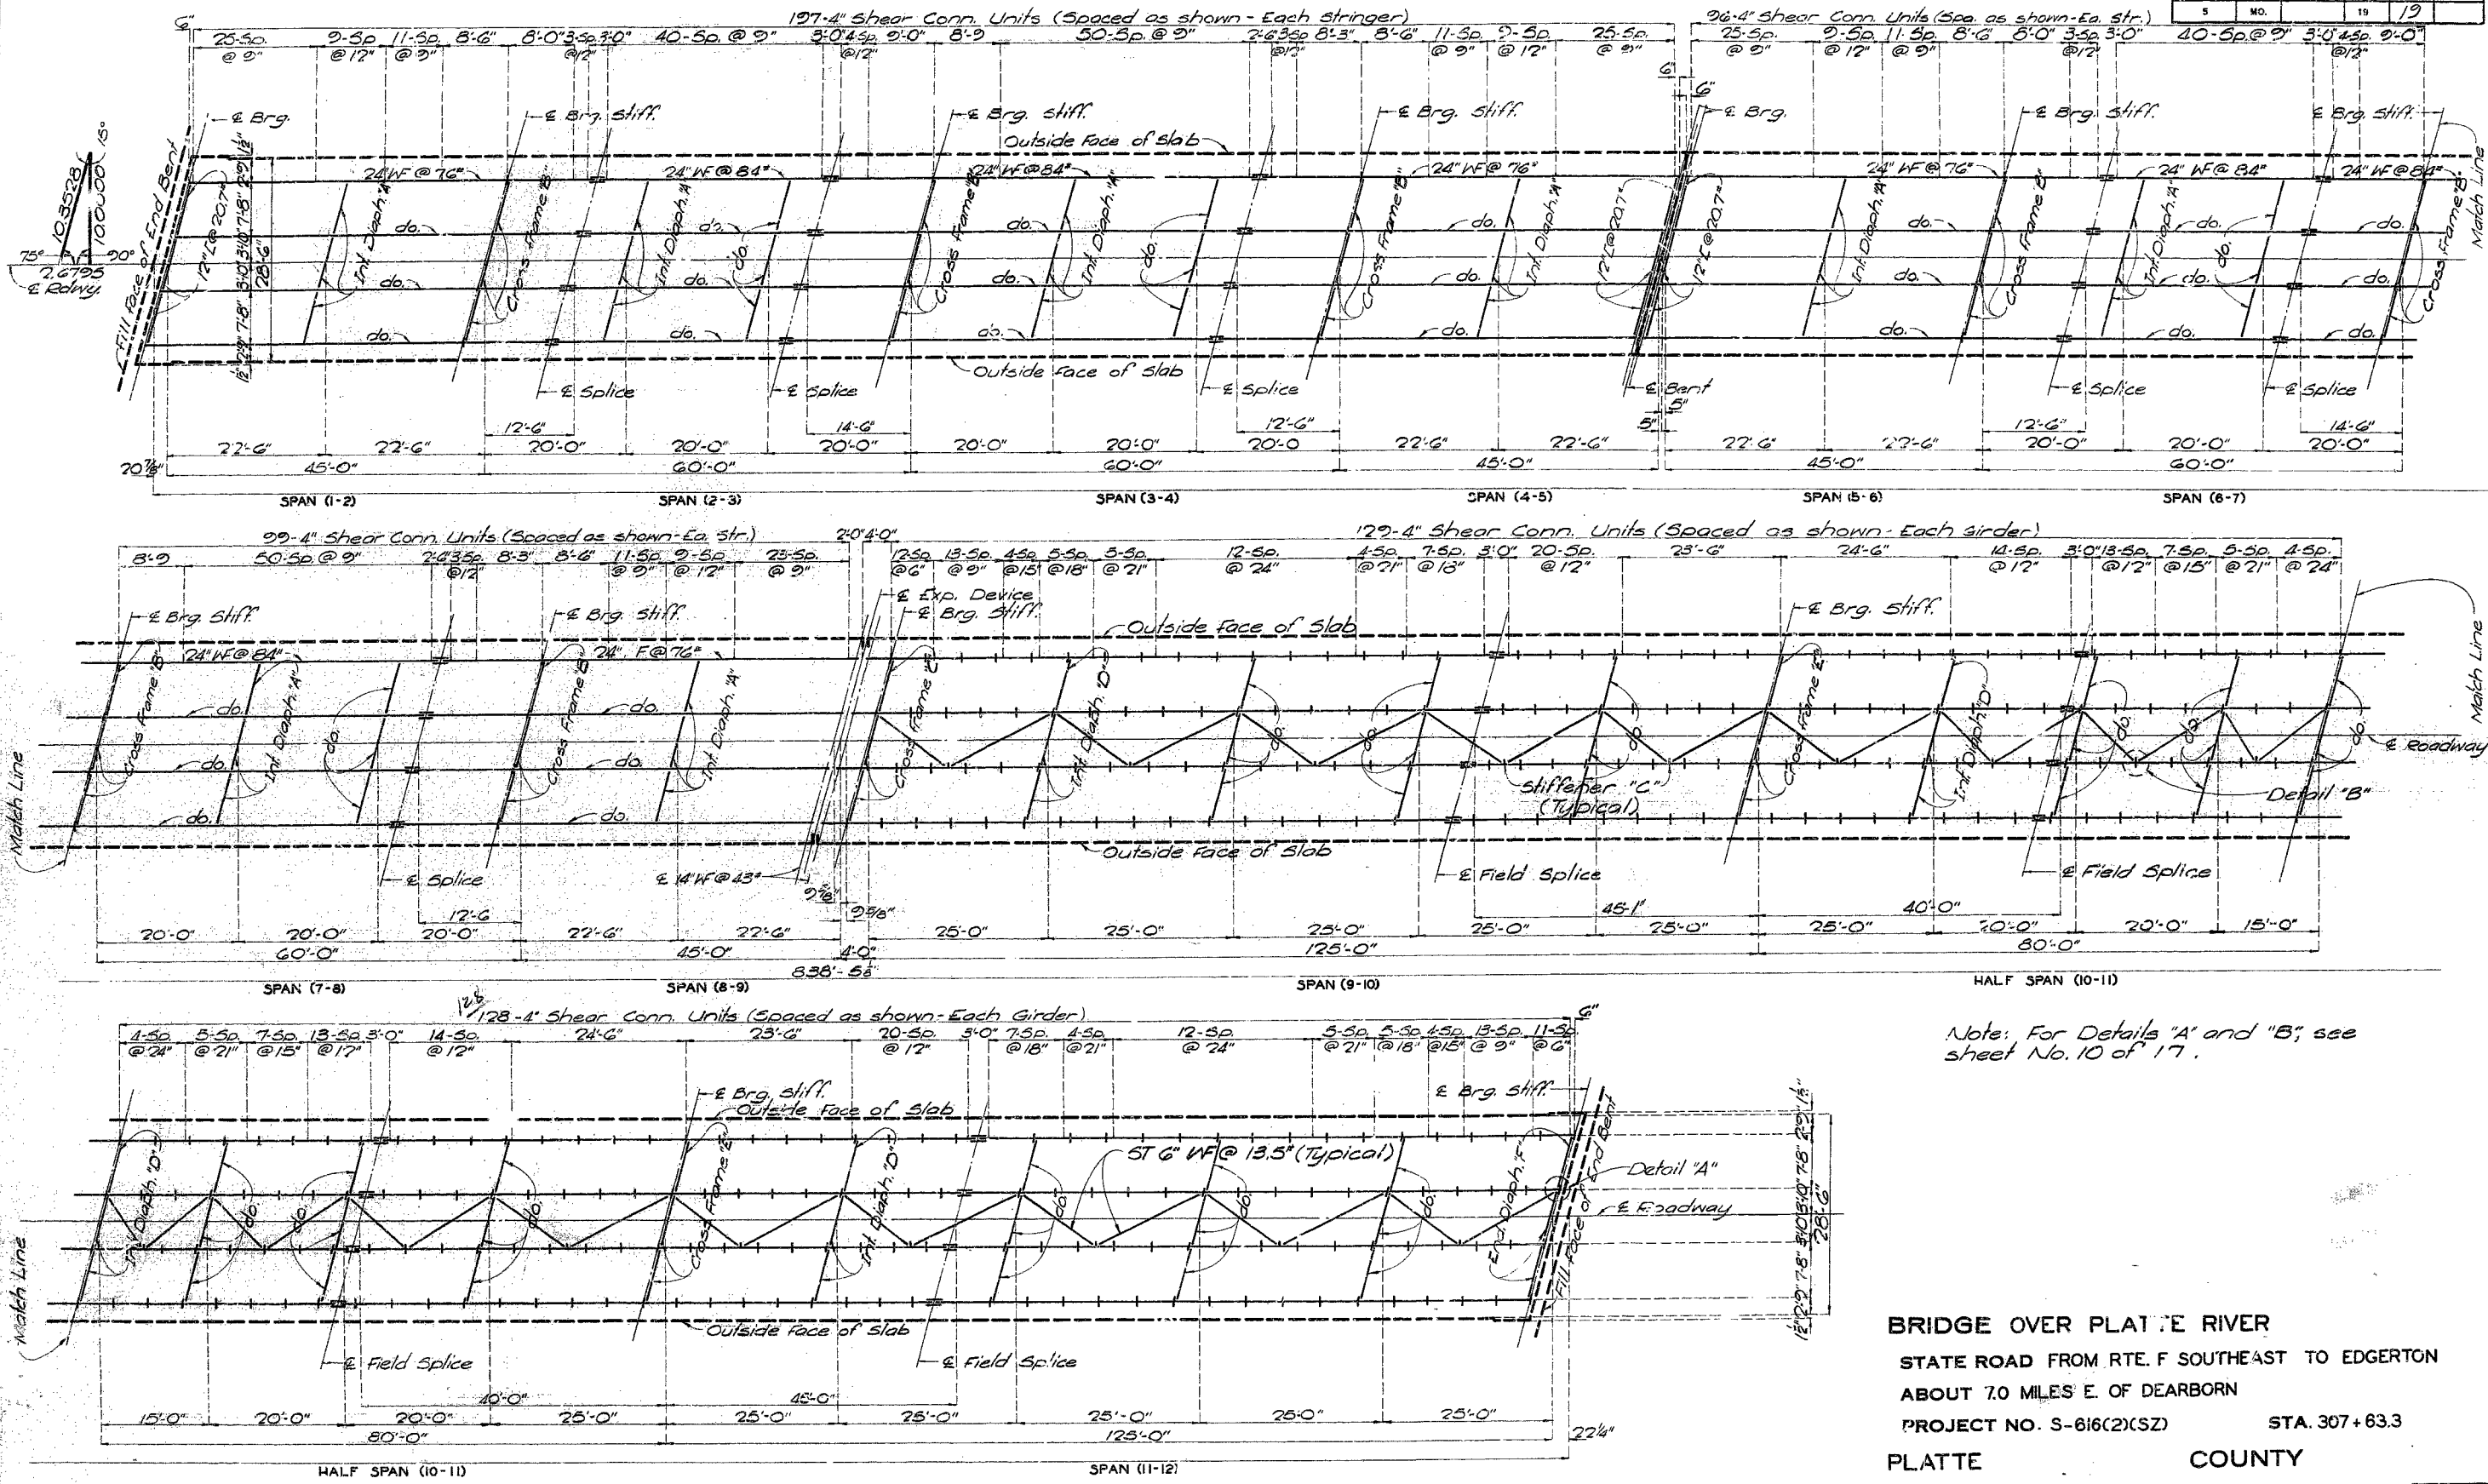

Note: For Details "A" and "B", see sheet No. 10 of 17.

BRIDGE OVER PLATTE RIVER
 STATE ROAD FROM RTE. F SOUTHEAST TO EDGERTON
 ABOUT 7.0 MILES E. OF DEARBORN
 PROJECT NO. S-616(2)(SZ) STA. 307+63.3
 PLATTE COUNTY

109

DETAILED Jun, 1965 BY Bryan
 CHECKED Sept, 1965 BY Ault

Note: This drawing is not to scale. Follow dimensions.

PLAN OF STRUCTURAL STEEL


Sheet No. 7 of 17.

S-25 R


NO CONSTRUCTION CHANGES

MISSOURI STATE HIGHWAY DEPARTMENT


FED. ROAD DIST. NO.	STATE	FED. AID PROJ. NO.	FISCAL Y. AR	SHEET NO.	TOTAL SHEETS
5	MO.		19	20	

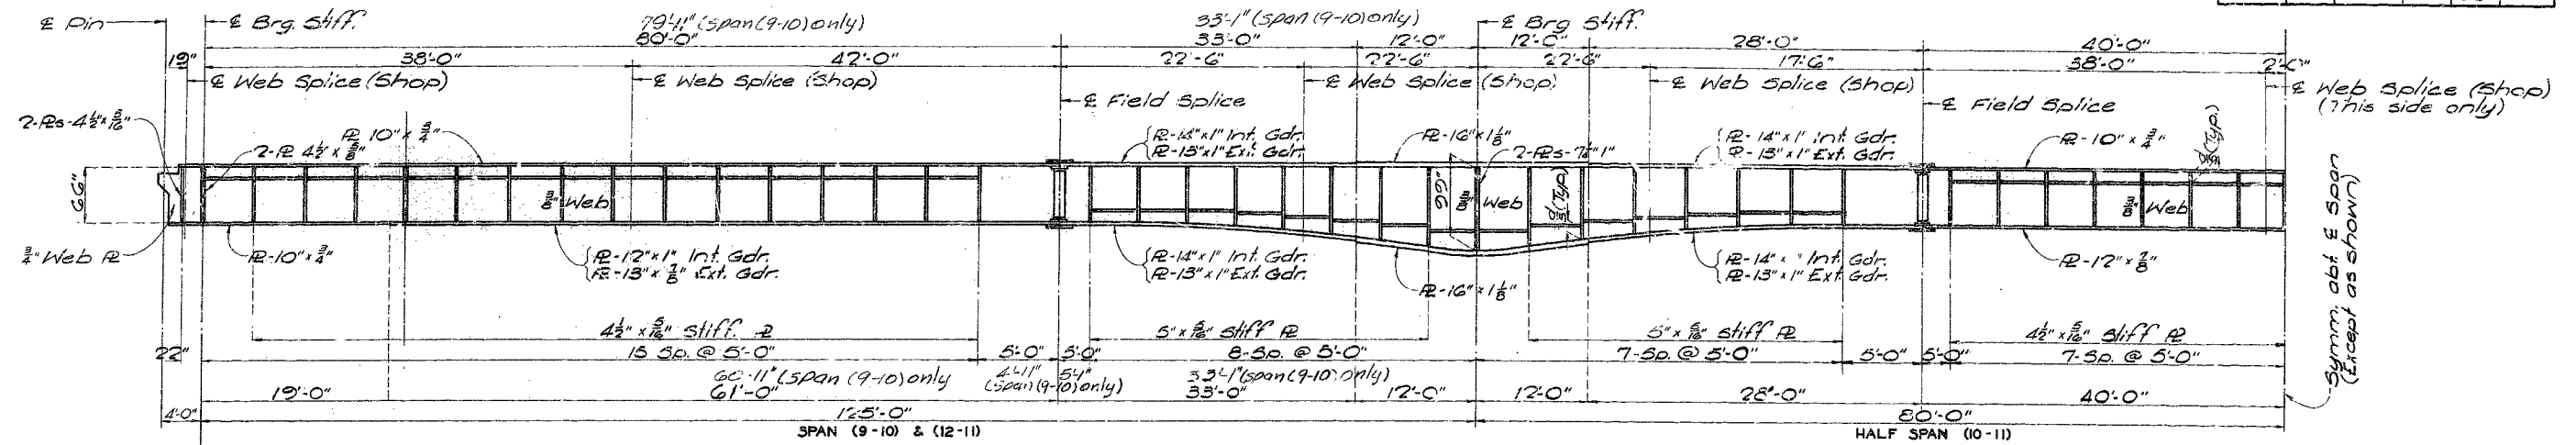

Note: Longitudinal web stiffeners shall be 4" x 3/8" and shall be placed on the inside of exterior girders and on either side of interior girder. Transverse intermediate web stiffeners shall be placed on both sides of each girder. For Camber of Plate Girder, See Sheet No. 15 of 17.

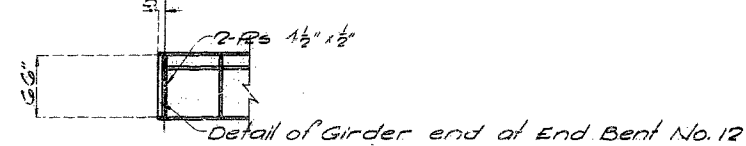



HALF ELEVATION OF GIRDERS

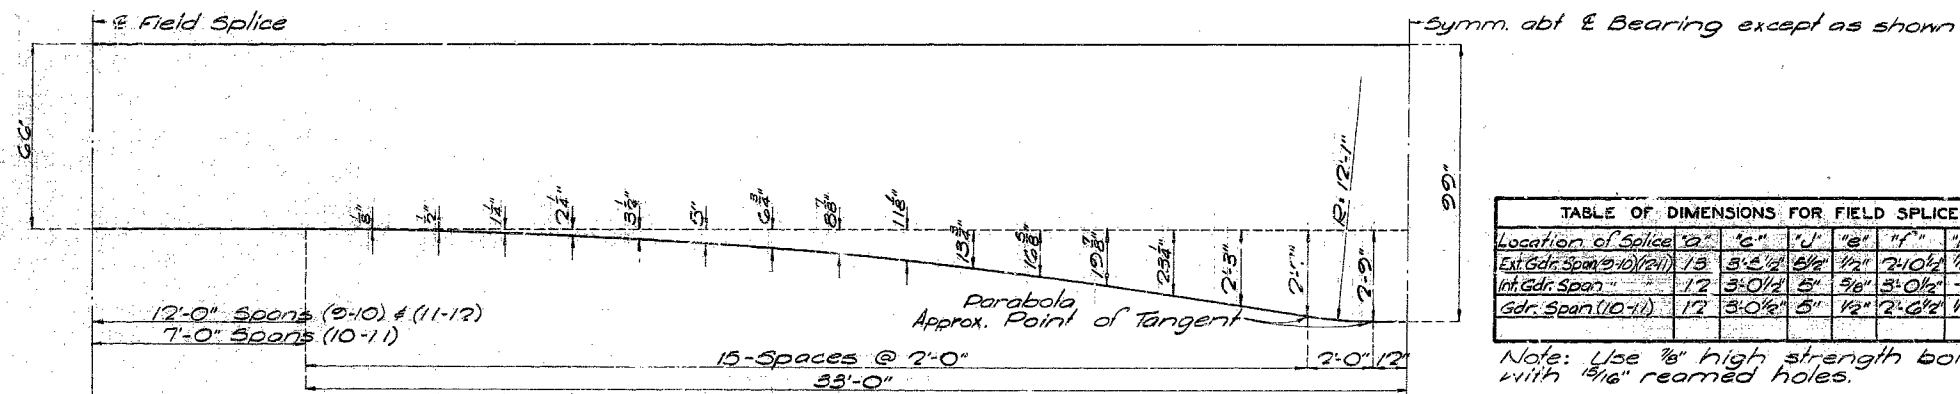

DETAIL OF GIRDER HAUNCH AT INT. SUPPORTS

Location of Splice	12"	14"	16"	18"	20"	24"	30"
Ext. Gdr. Span (9-10) (11-12)	13	5'-5 1/2"	5'-7 1/2"	5'-9 1/2"	5'-11 1/2"	6'-3 1/2"	6'-7 1/2"
Int. Gdr. Span	12	3'-0 1/2"	3'-2 1/2"	3'-4 1/2"	3'-6 1/2"	3'-8 1/2"	3'-10 1/2"
Gdr. Span (10-11)	12	3'-0 1/2"	3'-2 1/2"	3'-4 1/2"	3'-6 1/2"	3'-8 1/2"	3'-10 1/2"



Note: Use 3/8" high strength bolts with 3/4" reamed holes.

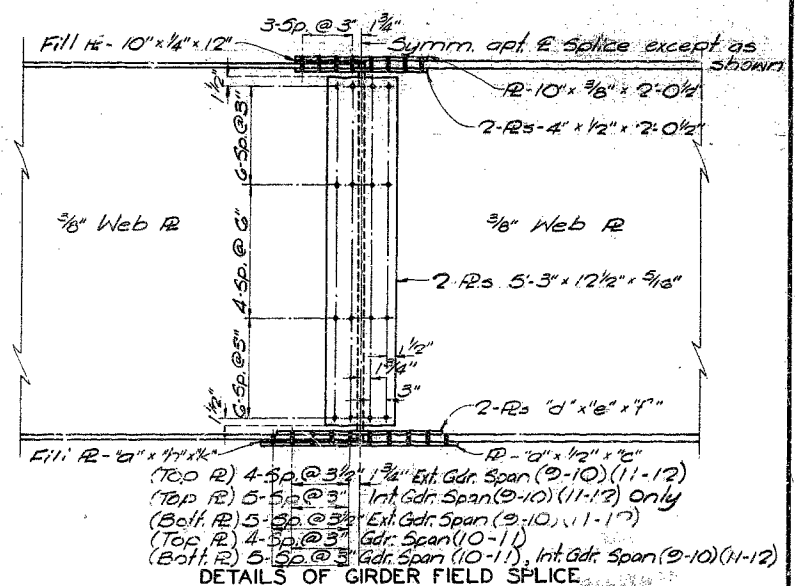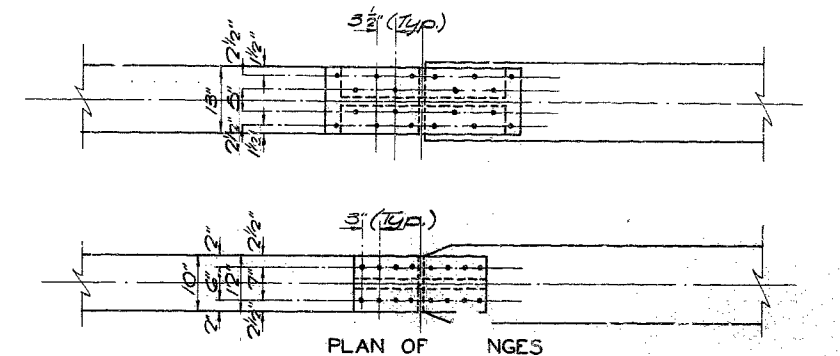

BRIDGE OVER PLATTE RIVER

STATE ROAD FROM RTE. F SOUTHEAST TO EDGERTON
ABOUT 70 MILES E. OF DEARBORN
PROJECT NO. S-616 (2) (S2) STA. 307 + 63.3
PLATTE COUNTY

Flange Thickness	Min. Size Filler Weld
1/2" inclusive	W = 3/16"
Over 1/2" to 3/4"	W = 1/4"
Over 3/4" to 1 1/2"	W = 5/16"

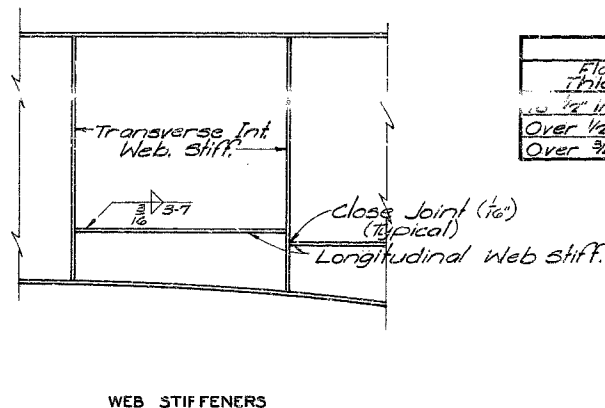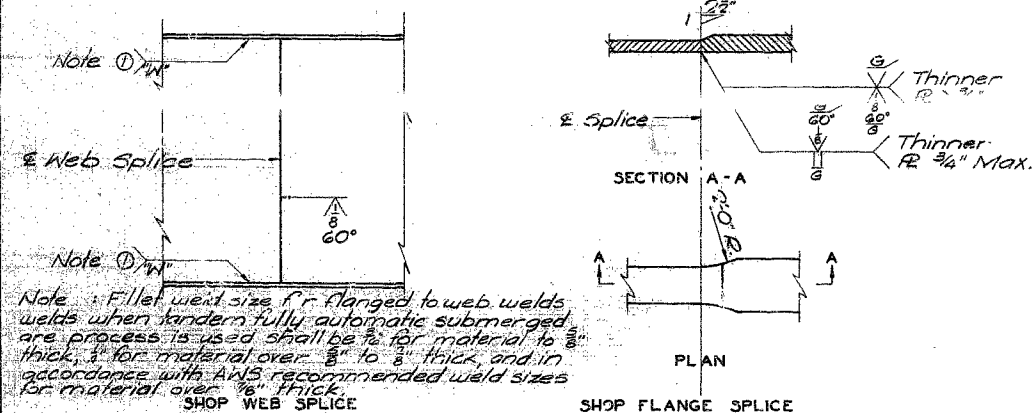

110
 Detailed Jun. 1965 by Bryan
 Checked Sept. 1965 by Ault

Note: This drawing is not to scale. Follow dimensions.


Sheet No. 8 of 17.

S-25 R


NO CONSTRUCTION CHANGES

MISSOURI STATE HIGHWAY DEPARTMENT


FED. ROAD DIST. NO.	STATE	FED. AID PROJ. NO.	FISCAL YEAR	SHEET NO.	TOTAL SHEETS
5	MO.		19	27	

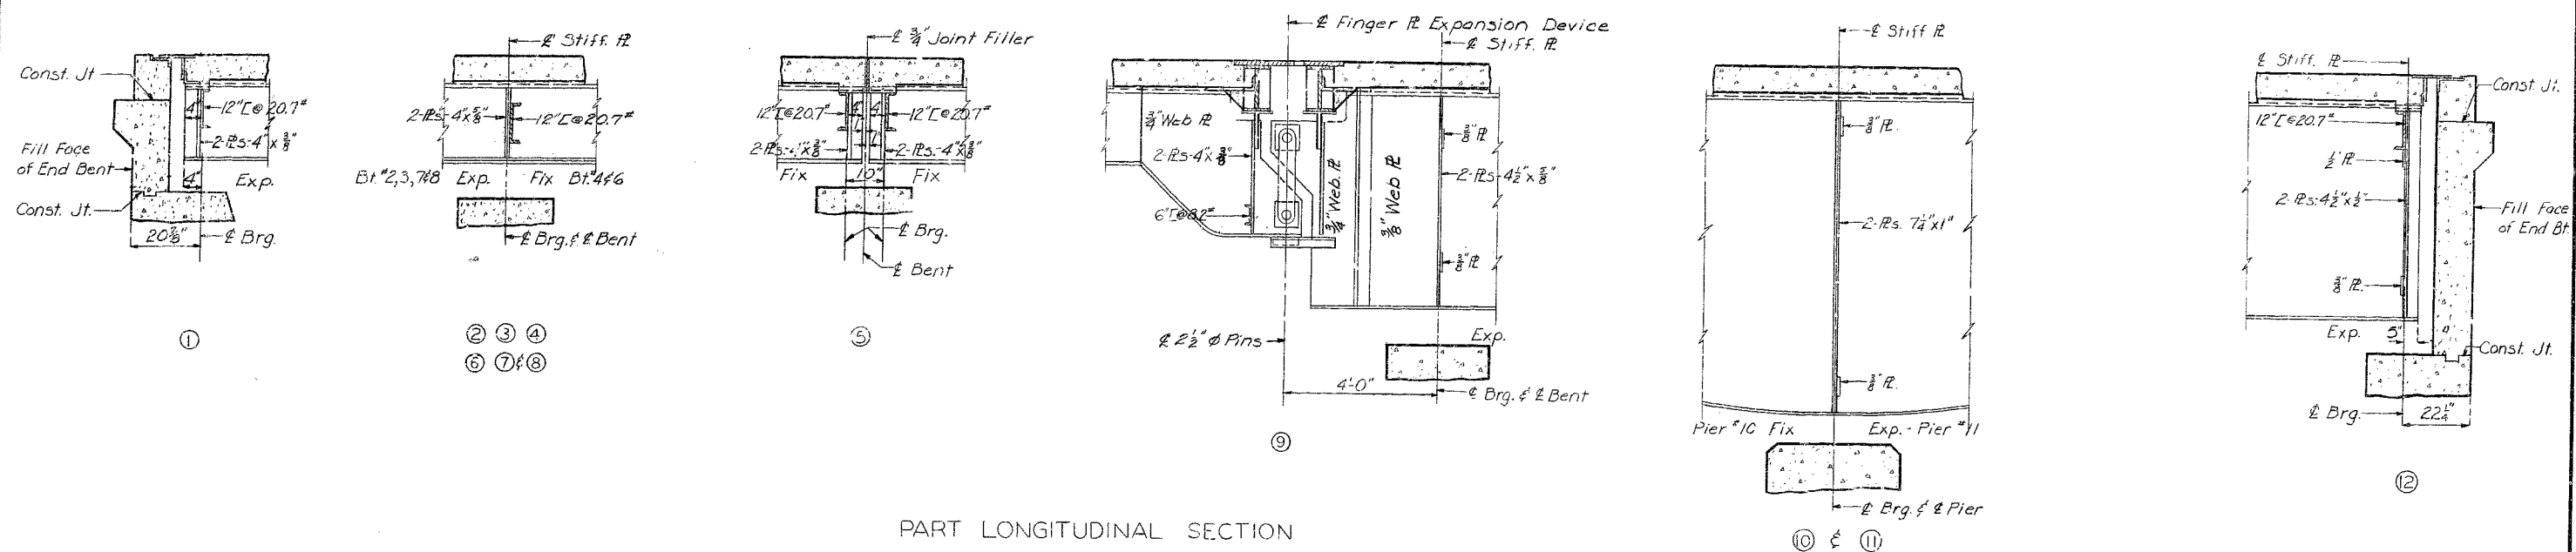

PART LONGITUDINAL SECTION

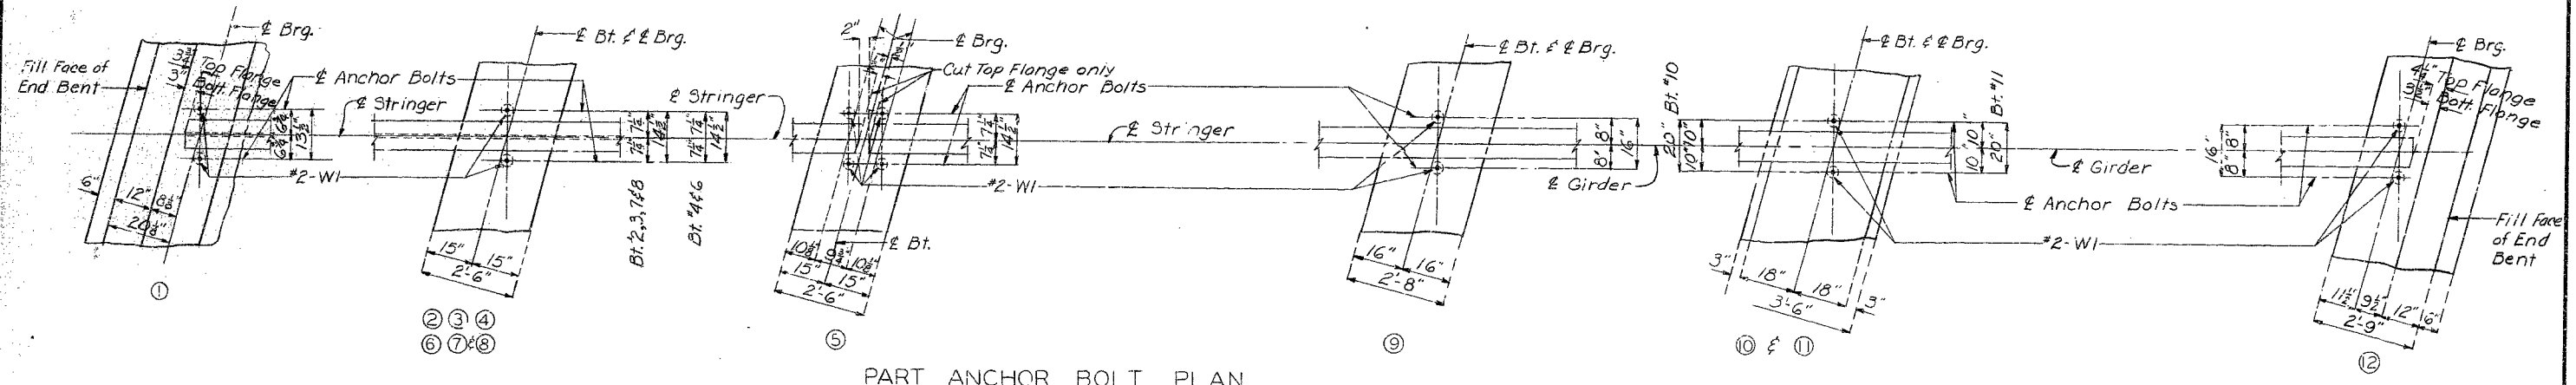

PART ANCHOR BOLT PLAN

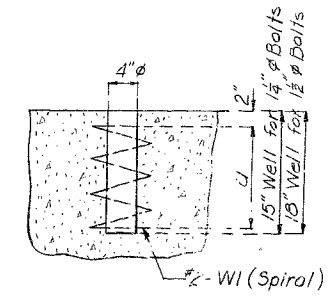

"a" = 12" for 1/4" Bolts
 "a" = 15" for 1/2" Bolts

BRIDGE OVER PLATTE RIVER
 STATE ROAD FROM RTE. F SOUTHEAST TO EDGERTON
 ABOUT 7.0 MILES E. OF DEARBORN
 PROJECT NO. S-616(2) (SZ) STA. 307+63.3
 PLATTE COUNTY

DETAILED MAY 1965 BY CARTER
 CHECKED Sept. 1965 BY AULT





Note: This drawing is not to scale. Follow dimensions.

Sheet No. 9 of 17.

S-25R



MISSOURI STATE HIGHWAY DEPARTMENT

FED. ROAD DIST. NO.	STATE	FED. AID PROJ. NO.	FISCAL YEAR	SHEET NO.	TOTAL SHEETS
5	MO.		19	22	

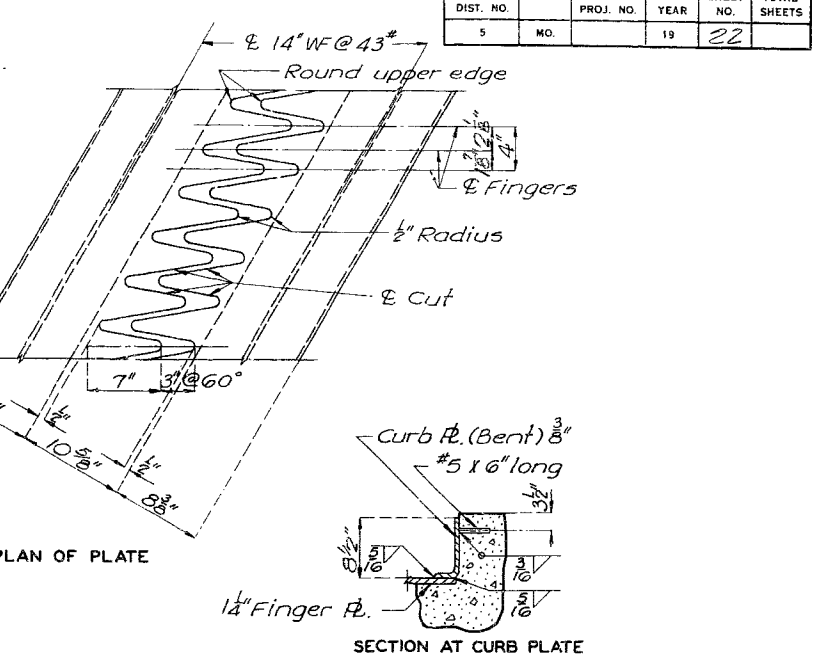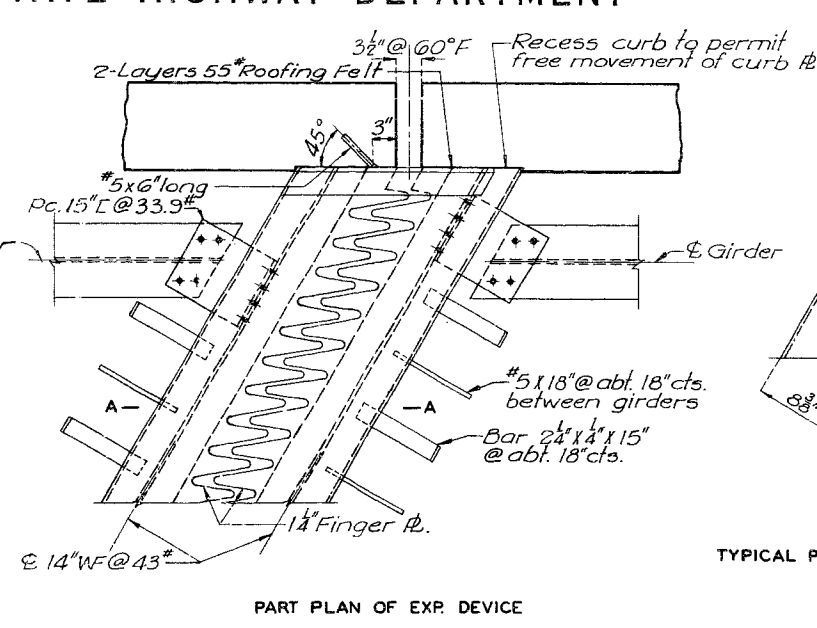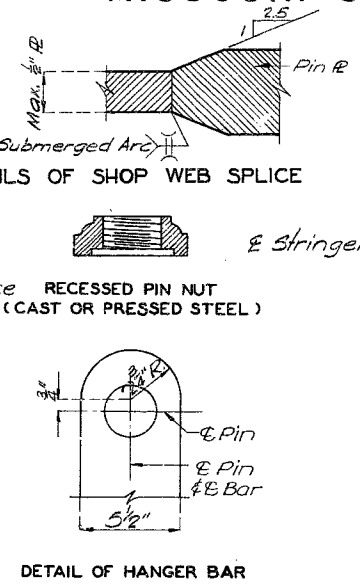
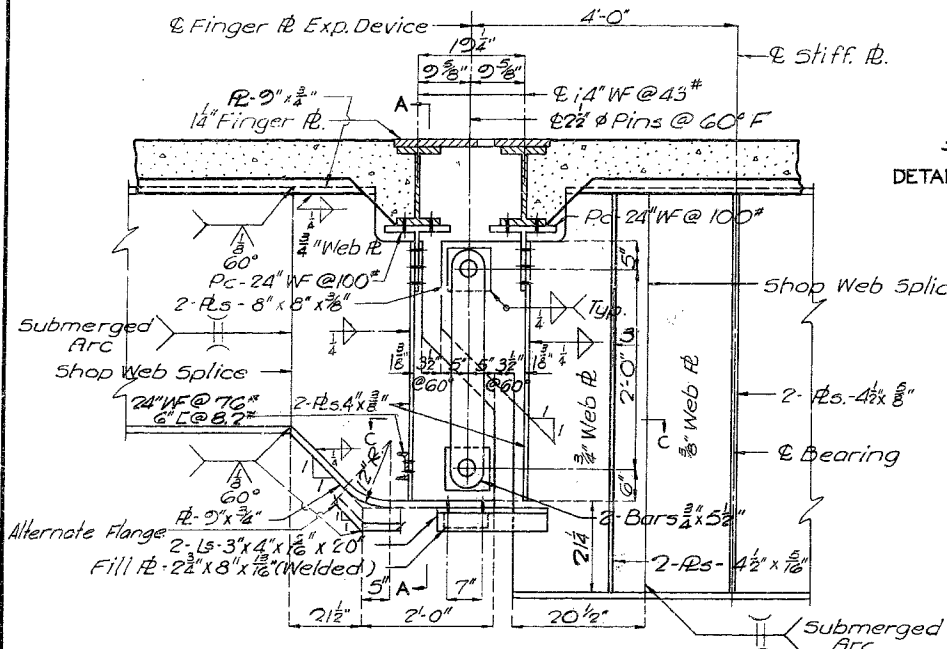


Note: Finger plates shall be cut with a gas torch from one plate 25' x 14". The surface of cut shall be perpendicular to the surface of plate. The cut shall not exceed 5" in width. The centerline of cut shall not deviate more than 1/8" from the position of centerline cut shown above. No part of expansion device may be spliced. 1 1/2" finger plate and 14" WF @ 43" shall be bent to conform to crown of roadway. All holes shown to be subpunched 1/8" and reamed to 1/8" in field.




SECTION SHOWING HANGER CONNECTION
(For Section A-A, see sheet No. 11 of 17)
(Near Bt. No. 9)

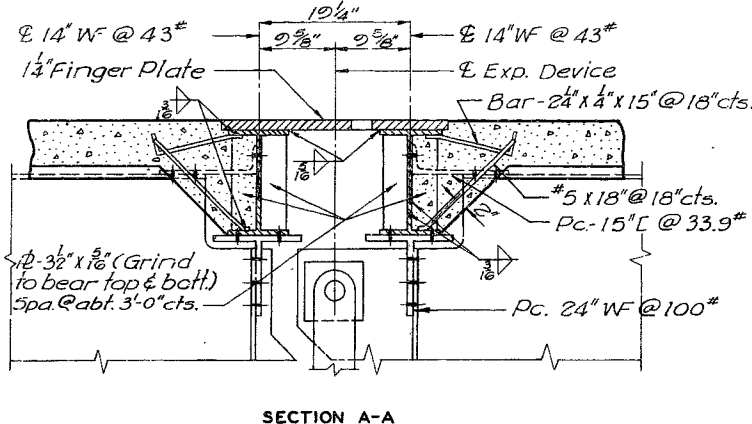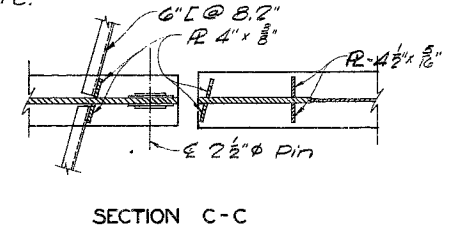


DETAILS OF FINGER PLATE EXPANSION DEVICE
(Near Bent No. 9)

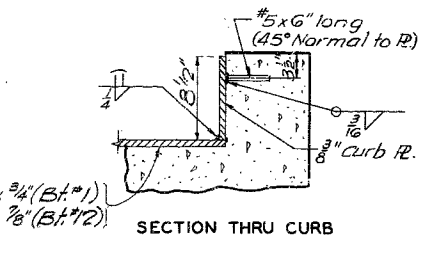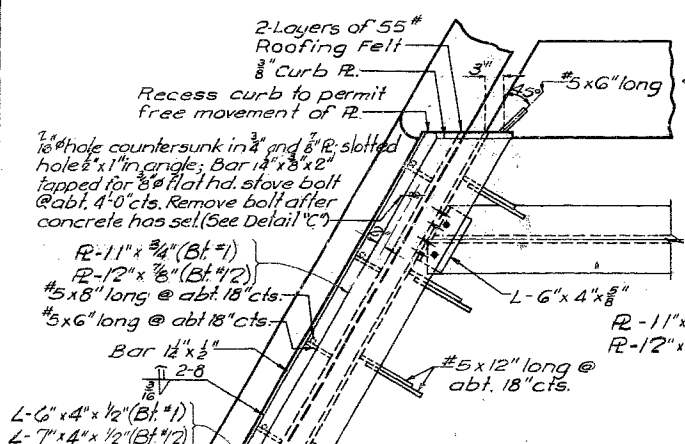

Note: Expansion Device shall be fabricated in one section and shall be bent to conform to crown and grade of roadway. No. 5 bars for expansion device shall be structural grade. Approved stud welded anchors may be used in lieu of #5 bars shown. Use 2 Layers of 55# Roofing Felt between the sliding contact surface of curb plate and concrete backwall.

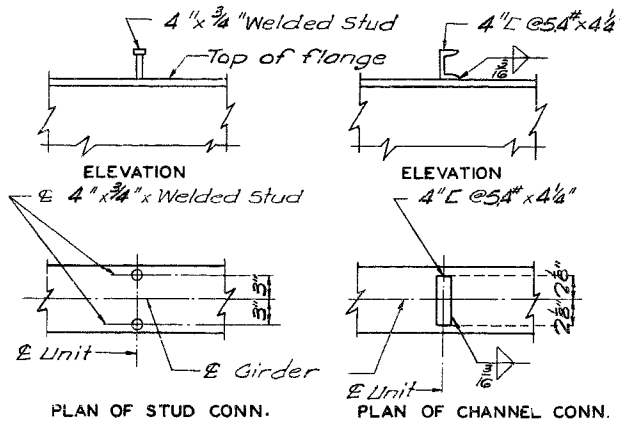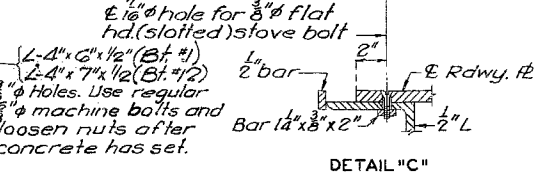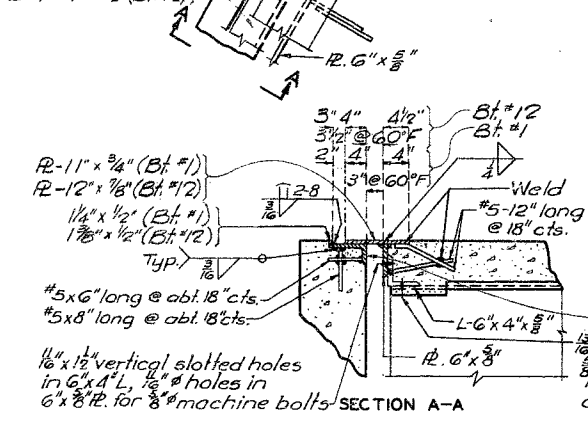

Note: Locate channel connectors with back toward ends of spans.

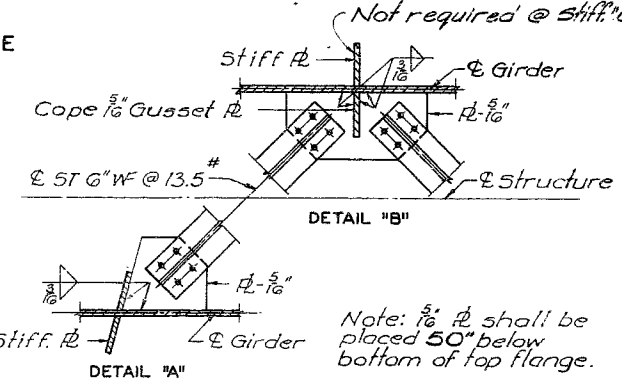

Note: 5/8" Pl. shall be placed 50" below bottom of top flange.

BRIDGE OVER PLATTE RIVER
STATE ROAD FROM RTE. F SOUTHEAST TO EDGERTON
ABOUT 70 MILES E. OF DEARBORN
PROJECT NO. S-616 (2) (S2) STA. 307+63.3
PLATTE COUNTY

DETAILED Jun. 1965 BY Bryan
CHECKED Sep. 1965 BY Ault

Note: This drawing is not to scale. Follow dimensions.


Sheet No. 10 of 17.

S-25 R

112


MISSOURI STATE HIGHWAY DEPARTMENT

FED. ROAD DIST. NO.	STATE	FED. AID PROJ. NO.	FISCAL YEAR	SHEET NO.	TOTAL SHEETS
5	MO.		19	23	


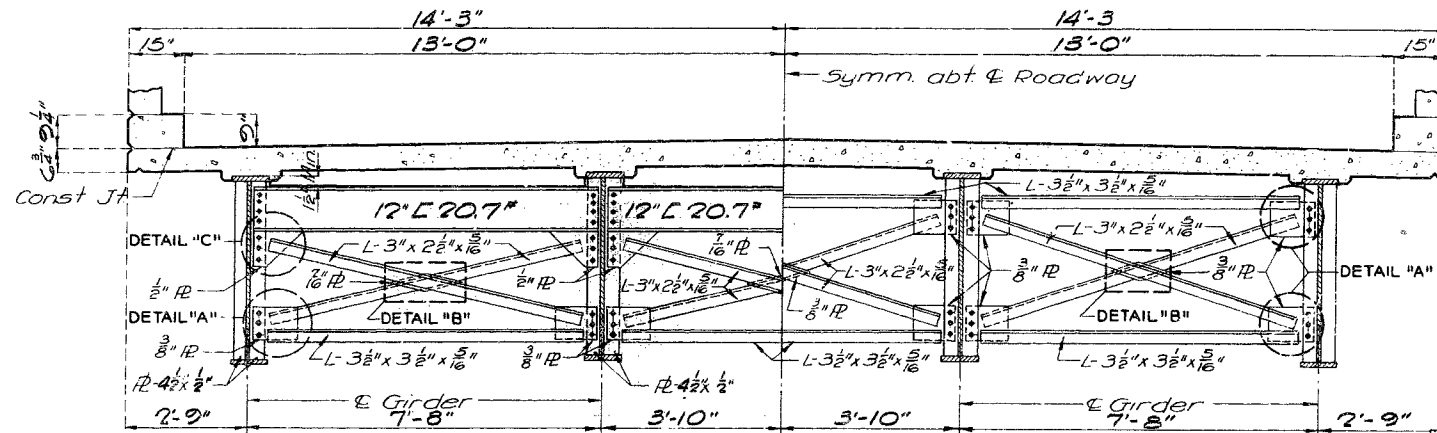


HALF SECTION SHOWING END DIAPHRAGMS "F"


HALF SECTION SHOWING INT. DIAPHRAGMS "D"
HALF SECTION NEAR CROSS FRAMES "C"

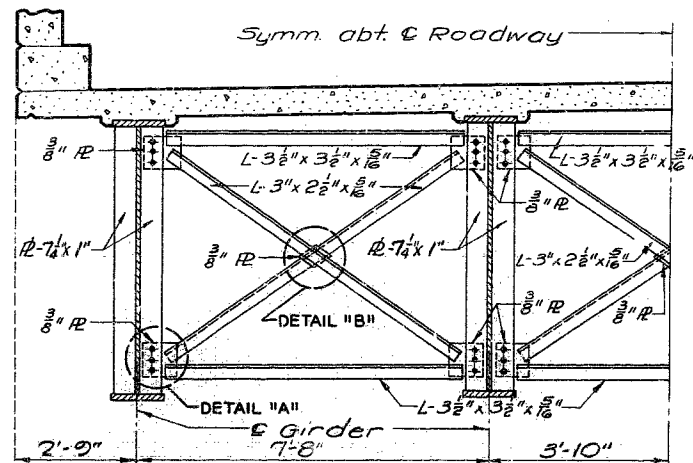

HALF SECTION NEAR CROSS FRAMES "E"

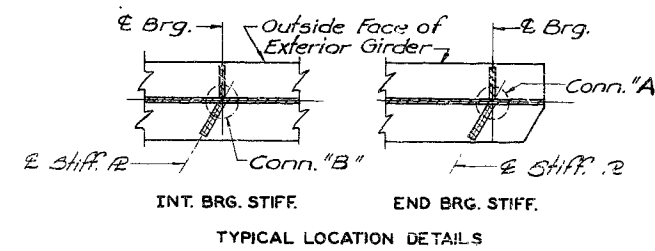
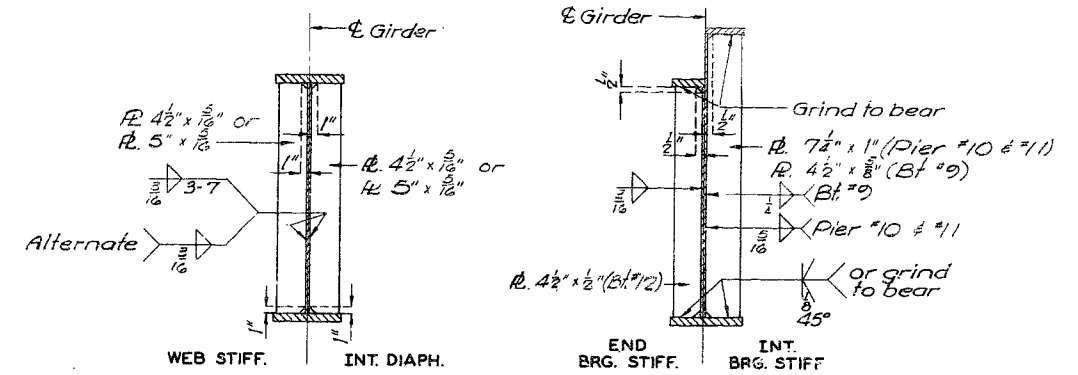


Note: Intermediate web stiffeners shall be fitted to form a close joint (1/8") top and bottom.

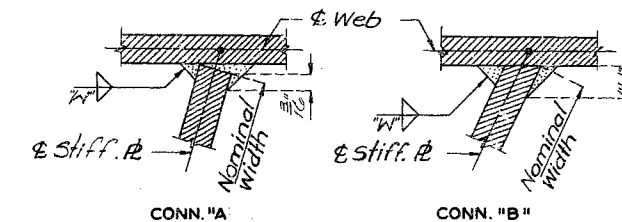

Material Thickness	"W"
To 1/2" incl.	3/16"
Over 1/2" to 3/4"	1/4"
Over 3/4" to 1 1/2"	5/16"

WELDING DETAILS
(R Girder)

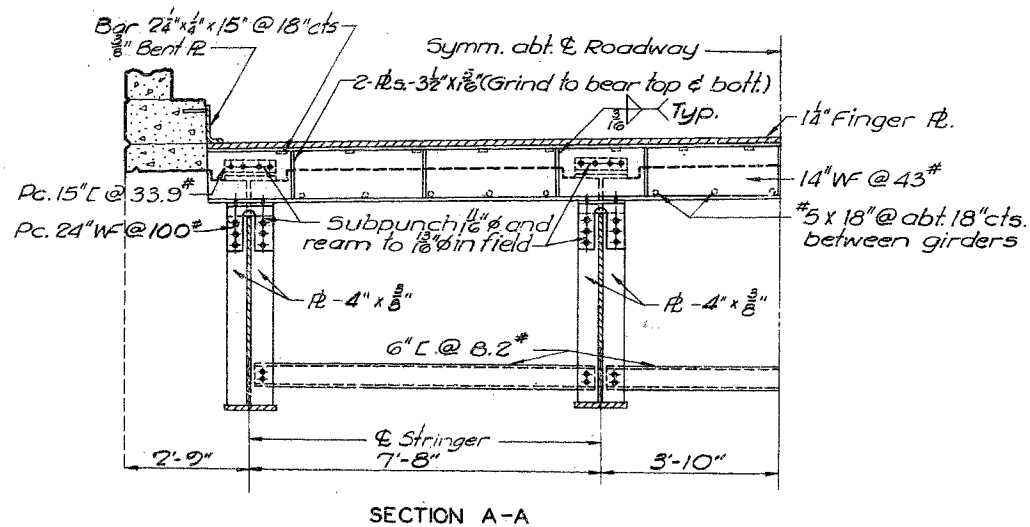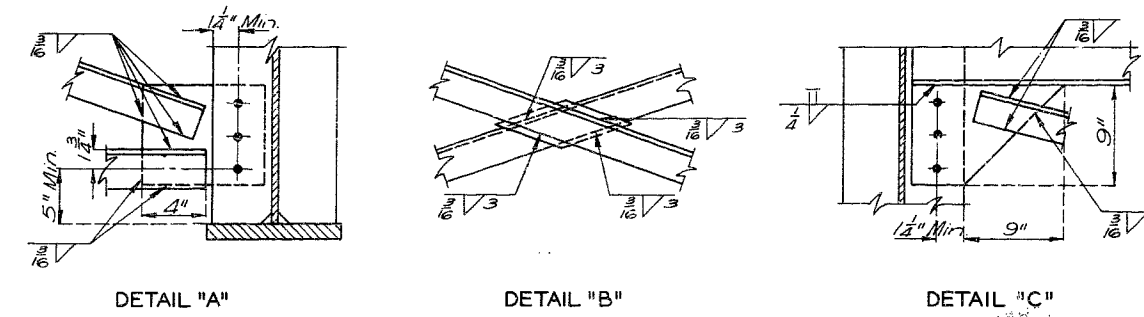

SECTION A-A

BRIDGE OVER PLATTE RIVER
STATE ROAD FROM RTE. F SOUTHEAST TO EDGERTON
ABOUT 70 MILES E. OF DEARBORN
PROJECT NO. S-618(2)(SZ) STA. 307+63.3
PLATTE COUNTY

DETAILED Jun 1965 BY Bryan
CHECKED Sept. 1965 BY Ault

Note: This drawing is not to scale. Follow dimensions.


Sheet No. 11 of 17.

S-25R

118


MISSOURI STATE HIGHWAY DEPARTMENT

FED. ROAD DIST. NO.	STATE	FED. AID PROJ. NO.	FISCAL YEAR	SHEET NO.	TOTA. SHEETS
5	MO.		19	24	

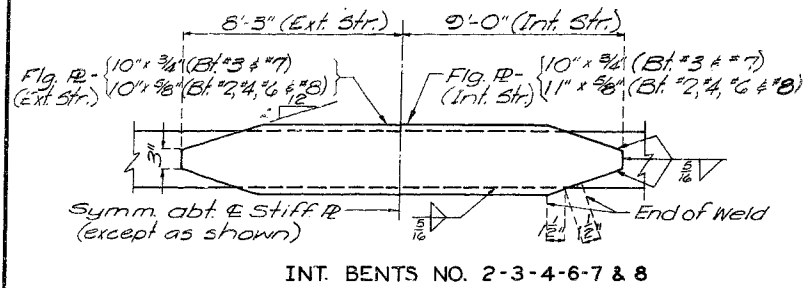

INT. BENTS NO. 2-3-4-6-7 & 8


DETAILS OF FLANGE PLATES - TOP & BOTTOM FLANGE

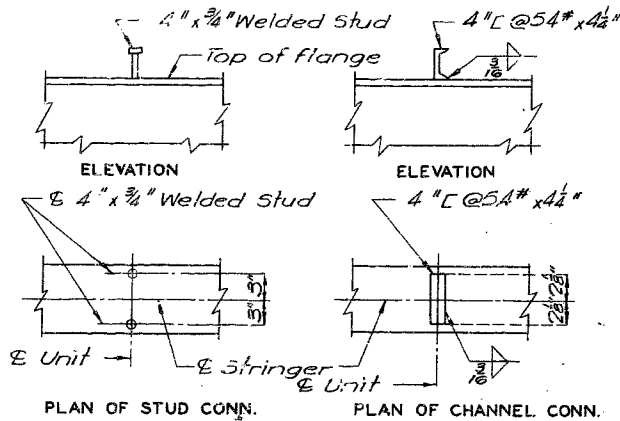

PLAN OF STUD CONN. PLAN OF CHANNEL CONN.

Note: Locate channel connectors with back toward ends of spans.


DETAILS OF SHEAR CONNECTORS (WF Bm. Spans)

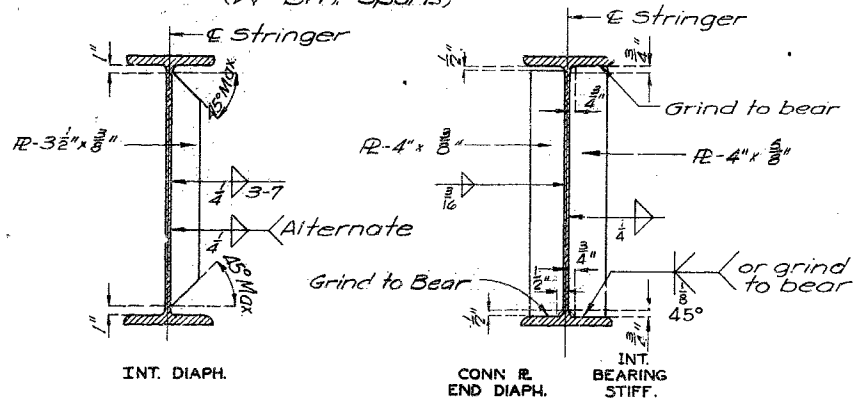

INT. DIAPH.

CONN. R. END DIAPH.

INT. BEARING STIFF.

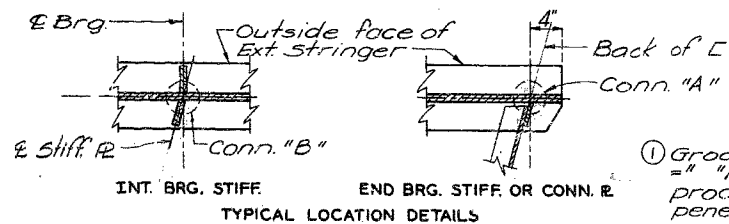


INT. BRG. STIFF

END BRG. STIFF OR CONN. R.

TYPICAL LOCATION DETAILS

① Groove weld penetration = "Min. Only welding processes having good penetration will be permitted on groove welds.

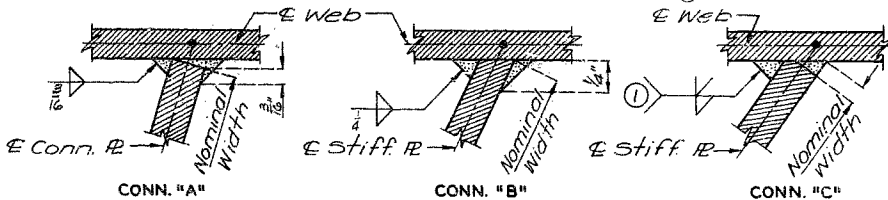

CONN. "A"

CONN. "B"

CONN. "C"

WELDING DETAILS (WF Beam Spans)

Note: This drawing is not to scale. Follow dimensions.


NOTES: TYPE "D" BEARINGS

Lead plates under bearings shall be approximately 3" thickness and weigh 8#/sq. ft. Cost of lead plates shall be included in price bid for other items. "Estimated weight" does not include weight of anchor bolts.


Rockers and pedestals shall be machined after welding.

Where flat surface is indicated, tolerance shall be .003 in/in in any direction.


Anchor Bolts for Type "D" Bearings shall be 1 1/4" dia and 1 1/2" swaged bolts and shall extend 12" into concrete, with hexagon nuts and plain washers for Fixed Bearings, no nuts for Expansion Bearings.

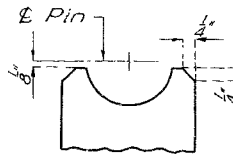

END VIEW OF WEB EXPANSION BEARING

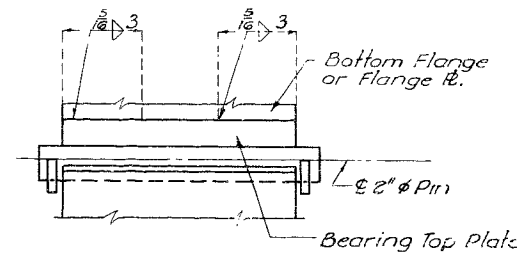

WELDING DETAILS

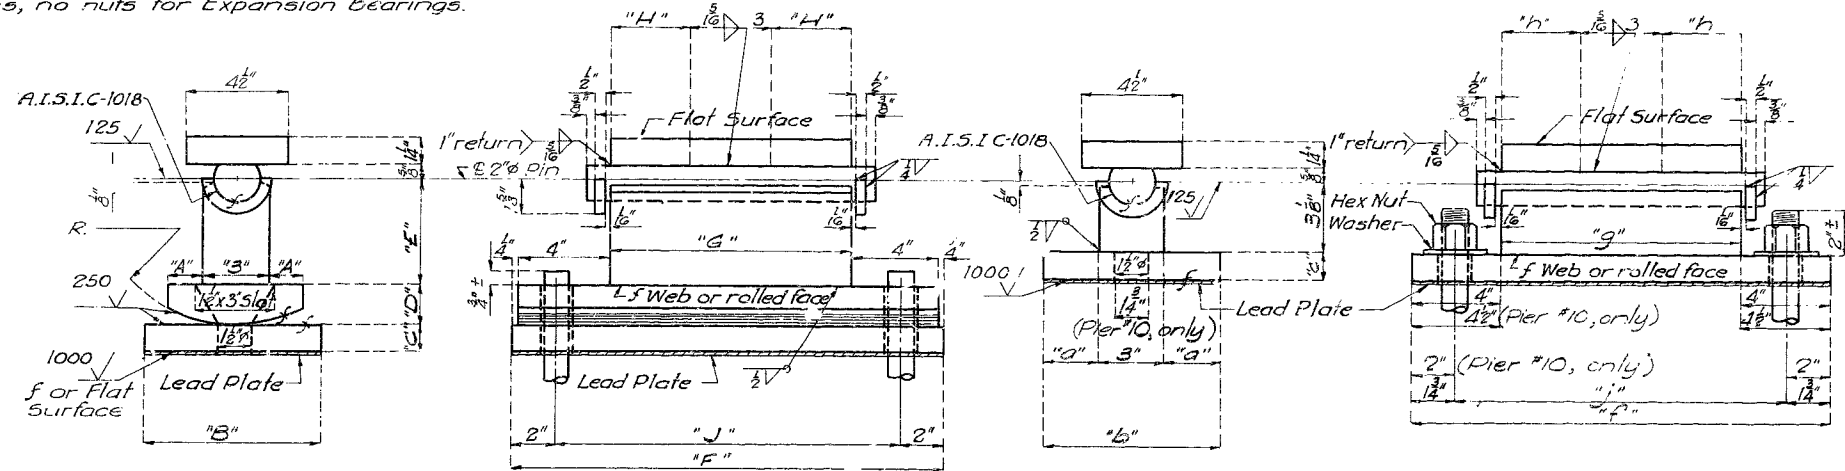


Required: 4 @ Bts. No. 1, 2, 3, 7, 8, 9 & 12
4 @ Pier No. 11

TYPE "D" BEARINGS (Estimated Weight 10,206#)

Required: 4 @ Bts. No. 4 & 6
8 @ Bt. No. 5
4 @ Pier No. 10

Bent	E-F	"A"	"B"	"C"	"D"	"E"	"F"	"G"	"H"	"J"	"R"	"a"	"b"	"c"	"f"	"g"	"h"	"j"
1	E	1 1/2"	8"	1"	1 3/8"	5 1/4"	17 1/2"	9"	3"	13 1/2"	6 1/2"							
2	E	1 1/2"	10"	1 1/4"	1 3/8"	5 1/8"	18 1/2"	10"	3 1/2"	14 1/2"	7"							
3	E	1 1/2"	10"	1 3/4"	1 3/8"	5 1/8"	18 1/2"	10"	3 1/2"	14 1/2"	7"							
4	F											3"	2"	1 1/4"	18"	10"	3 1/2"	14 1/2"
5	F											2 1/2"	3"	1"	18"	10"	3 1/2"	14 1/2"
6	F											3"	2"	1 1/4"	18"	10"	3 1/2"	14 1/2"
7	E	1 1/2"	10"	1 3/4"	1 3/8"	5 1/8"	18 1/2"	10"	3 1/2"	14 1/2"	7"							
8	E	1 1/2"	10"	1 3/4"	1 3/8"	5 1/8"	18 1/2"	10"	3 1/2"	14 1/2"	7"							
9	E	1 1/2"	11"	1 3/4"	1 3/8"	5 3/8"	20"	11 1/2"	4 1/4"	16"	7 1/2"							
10	F											5 1/4"	13 1/2"	2"	24"	15"	6"	20"
11	E	2"	16 1/2"	2 3/4"	2 1/8"	8 3/8"	24"	15 1/2"	3 1/4"	20"	10 1/2"							
12	E	1 1/2"	10"	1 1/2"	1 3/4"	5 3/4"	20"	11 1/2"	4 1/4"	16"	7 1/2"							

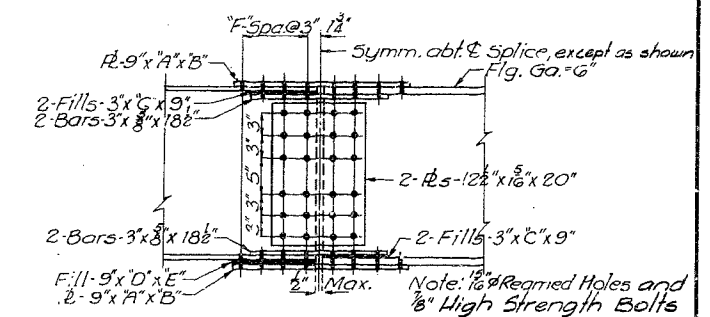

WF SIZES	"A"	"B"	"C"	"D"	"E"	"F"	"G"
24" WF @ 76# to 84#	3/8"	18 1/2"	15 ga	7 ga	9"	7"	2
84# to 84"	1/2"	2'-0 1/2"					3

DETAIL OF 24" WF BEAM SPLICE

BRIDGE OVER PLATTE RIVER

STATE ROAD FROM RTE. F SOUTHEAST TO EDGERTON

ABOUT 7.0 MILES E. OF DEARBORN

PROJECT NO. S-616 (2)(SZ)

STA. 307+63.3

PLATTE

COUNTY

DETAILED Jun. 1965 BY Bryon
CHECKED Sept. 1965 BY Ault


Sheet No. 12 of 17.

S-25 R


MISSOURI STATE HIGHWAY DEPARTMENT

FED. ROAD DIST. NO.	STATE	FED. AID PROJ. NO.	FISCAL YEAR	SHEET NO.	TOTAL SHEETS
5	MO.		19	25	


Note: Longitudinal Reinforcing steel shall be placed so that ends shall not be more than 1" from 1/8 plate at Exp. Device.

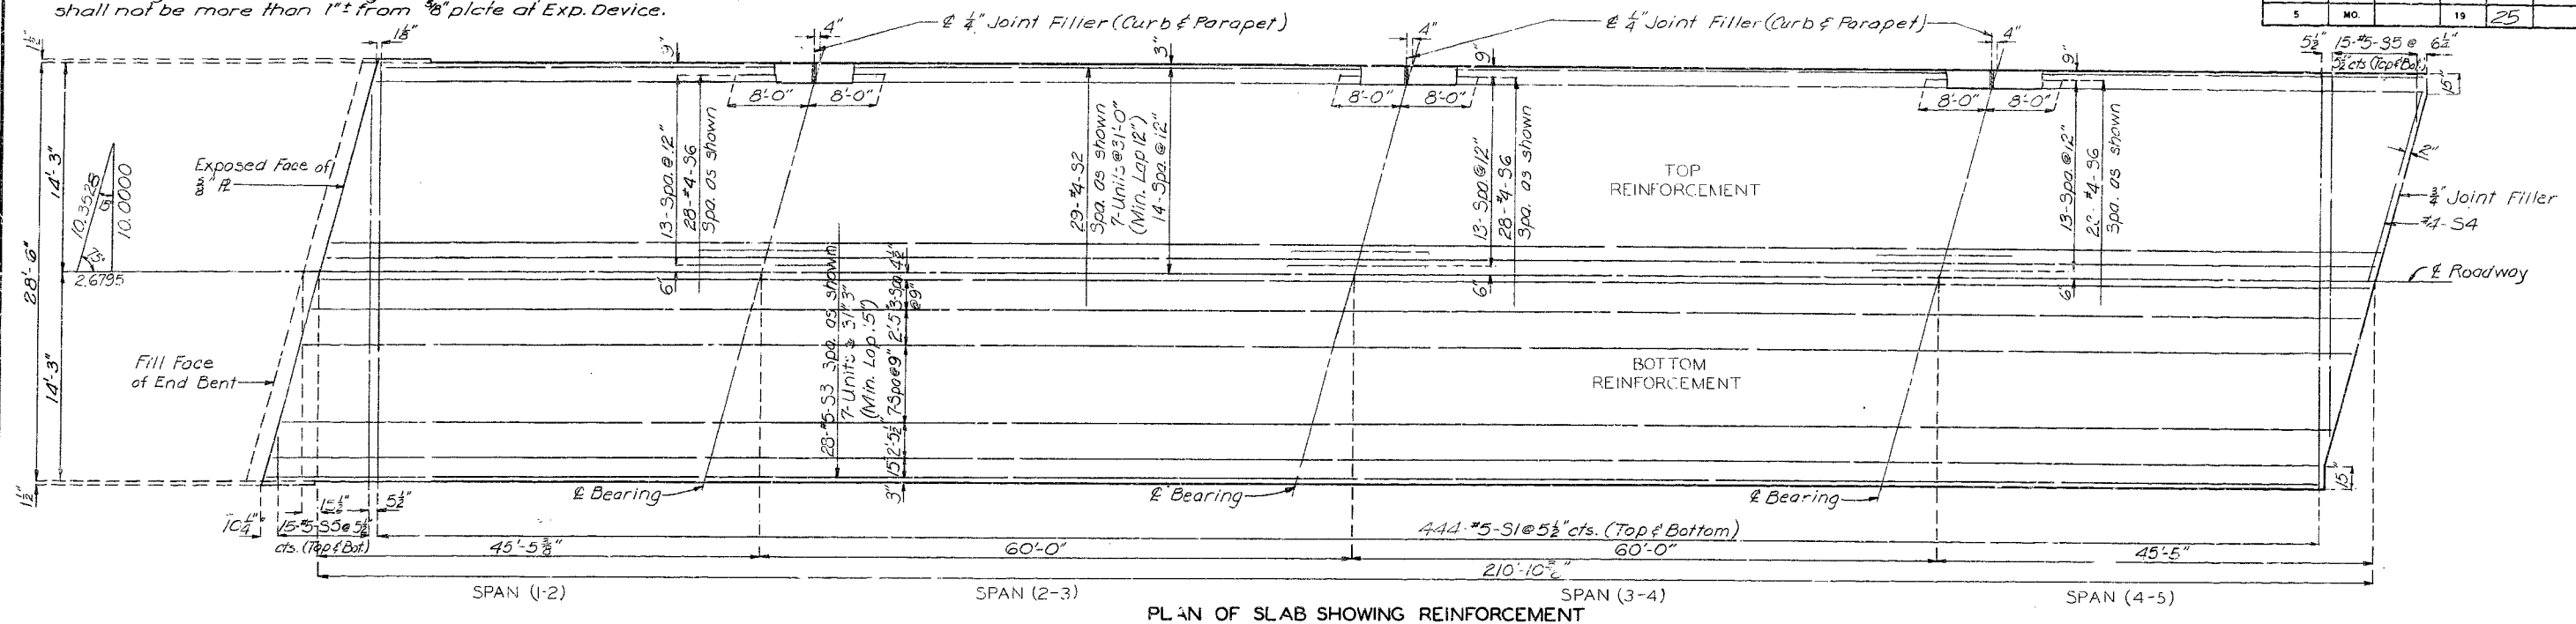

PLAN OF SLAB SHOWING REINFORCEMENT

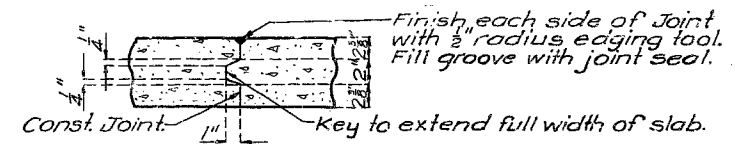

SECTION A-A

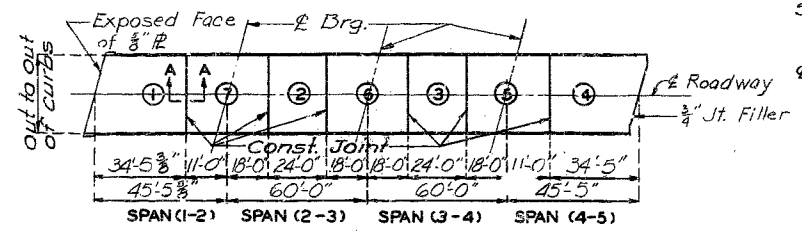

Symm. abt. &

Ext. Str.	3/8"	1/2"	5/8"	3/4"	1"	1 1/8"	1 1/4"	1 1/2"	1 3/4"	1 7/8"	2"	2 1/8"	2 1/4"	2 1/2"	2 3/4"	3"	3 1/8"	3 1/4"	3 1/2"	3 3/4"	4"	
Int. Str.	3/8"	1/2"	5/8"	3/4"	1"	1 1/8"	1 1/4"	1 1/2"	1 3/4"	1 7/8"	2"	2 1/8"	2 1/4"	2 1/2"	2 3/4"	3"	3 1/8"	3 1/4"	3 1/2"	3 3/4"	4"	
Top of Stringer	3/4"	3/4"	3/4"	3/4"	3/4"	3/4"	3/4"	3/4"	3/4"	3/4"	3/4"	3/4"	3/4"	3/4"	3/4"	3/4"	3/4"	3/4"	3/4"	3/4"	3/4"	3/4"

SPAN (1-2)(3-4) SPAN (2-3)(4-3)


THEORETICAL SLAB HAUNCHING DIAGRAM

Symm. abt. &

Ext. Str.	0"	1/8"	3/8"	1/2"	5/8"	3/4"	1"	1 1/8"	1 1/4"	1 1/2"	1 3/4"	1 7/8"	2"	2 1/8"	2 1/4"	2 1/2"	2 3/4"	3"	3 1/8"	3 1/4"	3 1/2"	3 3/4"	4"	
Int. Str.	0"	1/8"	3/8"	1/2"	5/8"	3/4"	1"	1 1/8"	1 1/4"	1 1/2"	1 3/4"	1 7/8"	2"	2 1/8"	2 1/4"	2 1/2"	2 3/4"	3"	3 1/8"	3 1/4"	3 1/2"	3 3/4"	4"	
Top of Stringer	3/4"	3/4"	3/4"	3/4"	3/4"	3/4"	3/4"	3/4"	3/4"	3/4"	3/4"	3/4"	3/4"	3/4"	3/4"	3/4"	3/4"	3/4"	3/4"	3/4"	3/4"	3/4"	3/4"	3/4"


SPAN (1-2)(3-4) SPAN (2-3)(4-3)

11% Structural Steel DEAD LOAD DEFLECTION (WF BEAM SPAN)

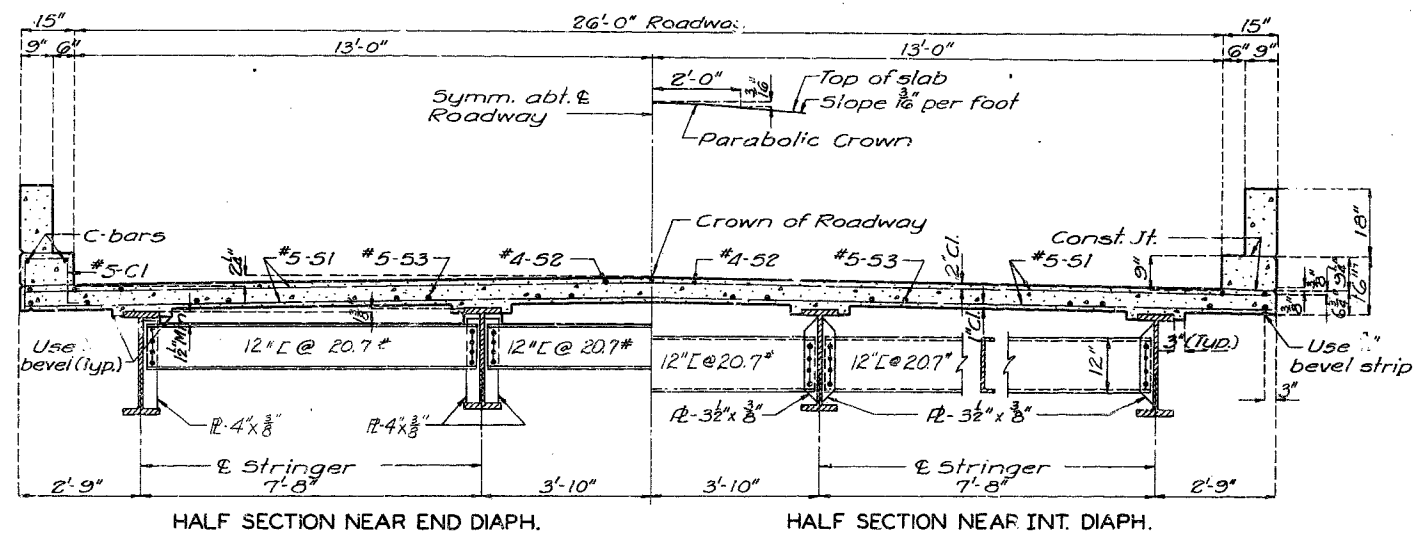

HALF SECTION NEAR END DIAPH.

HALF SECTION NEAR INT. DIAPH.

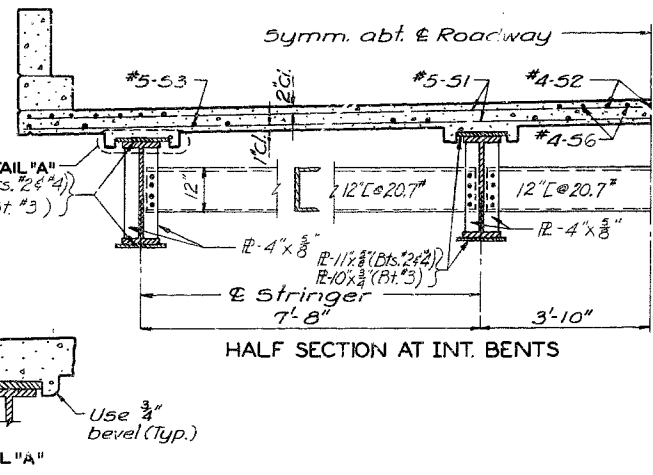

DETAIL 'A'

Note: For details on reinforcement of curb and parapet not shown see sheets No. 16 & 17 of 17.

BRIDGE OVER PLATTE RIVER
 STATE ROAD FROM RTE. F SOUTHEAST TO EDGERTON
 ABOUT 7.0 MILES E. OF DEARBORN
 PROJECT NO. S-616(2) (S2) STA. 307+63.3
 PLATTE COUNTY

Note: The contractor shall observe the basic pouring sequence and shall pour and satisfactorily finish the slab pours at a rate of not less than 12 cubic yards per hour. However, he may use one of the larger alternate pours if he elects to use an approved oscillating screed type, self-propelled mechanical finishing machine and can demonstrate to the engineer that he can pour and satisfactorily finish the slab pours at a rate of not less than 25 cubic yards per hour. Finishing machine loads will not be permitted on concrete less than 48 hours old.

SLAB POURING SEQUENCE

Basic Sequence	Sequence of Pours						
	Direction						
Alternate "A" Pours	1	2	3	4	5	6	7
Alternate "B" Pours	1+7+2	1 to 6	6+3	2 to 5	3 to End		
Alternate "C" Pours	1+7+2	1 to 6	6+3+5+4				
Alternate "D" Pours	1+7+2+6+3+5+4	End to End					

DETAILED JUNE 1965 BY CARTER
 CHECKED Sept. 1965 BY Ault

Note: This drawing is not to scale. Follow dimensions.


Sheet No. 13 of 17.

S-25R


MISSOURI STATE HIGHWAY DEPARTMENT

FED. ROAD DIST. NO.	STATE	FED. AID PROJ. NO.	FISCAL YEAR	SHEET NO.	TOTAL SHEETS
5	MO.		19	26	


Note: Longitudinal Reinforcing steel shall be placed so that ends shall not be more than 1" from 14" WF 43# at Exp. Device.

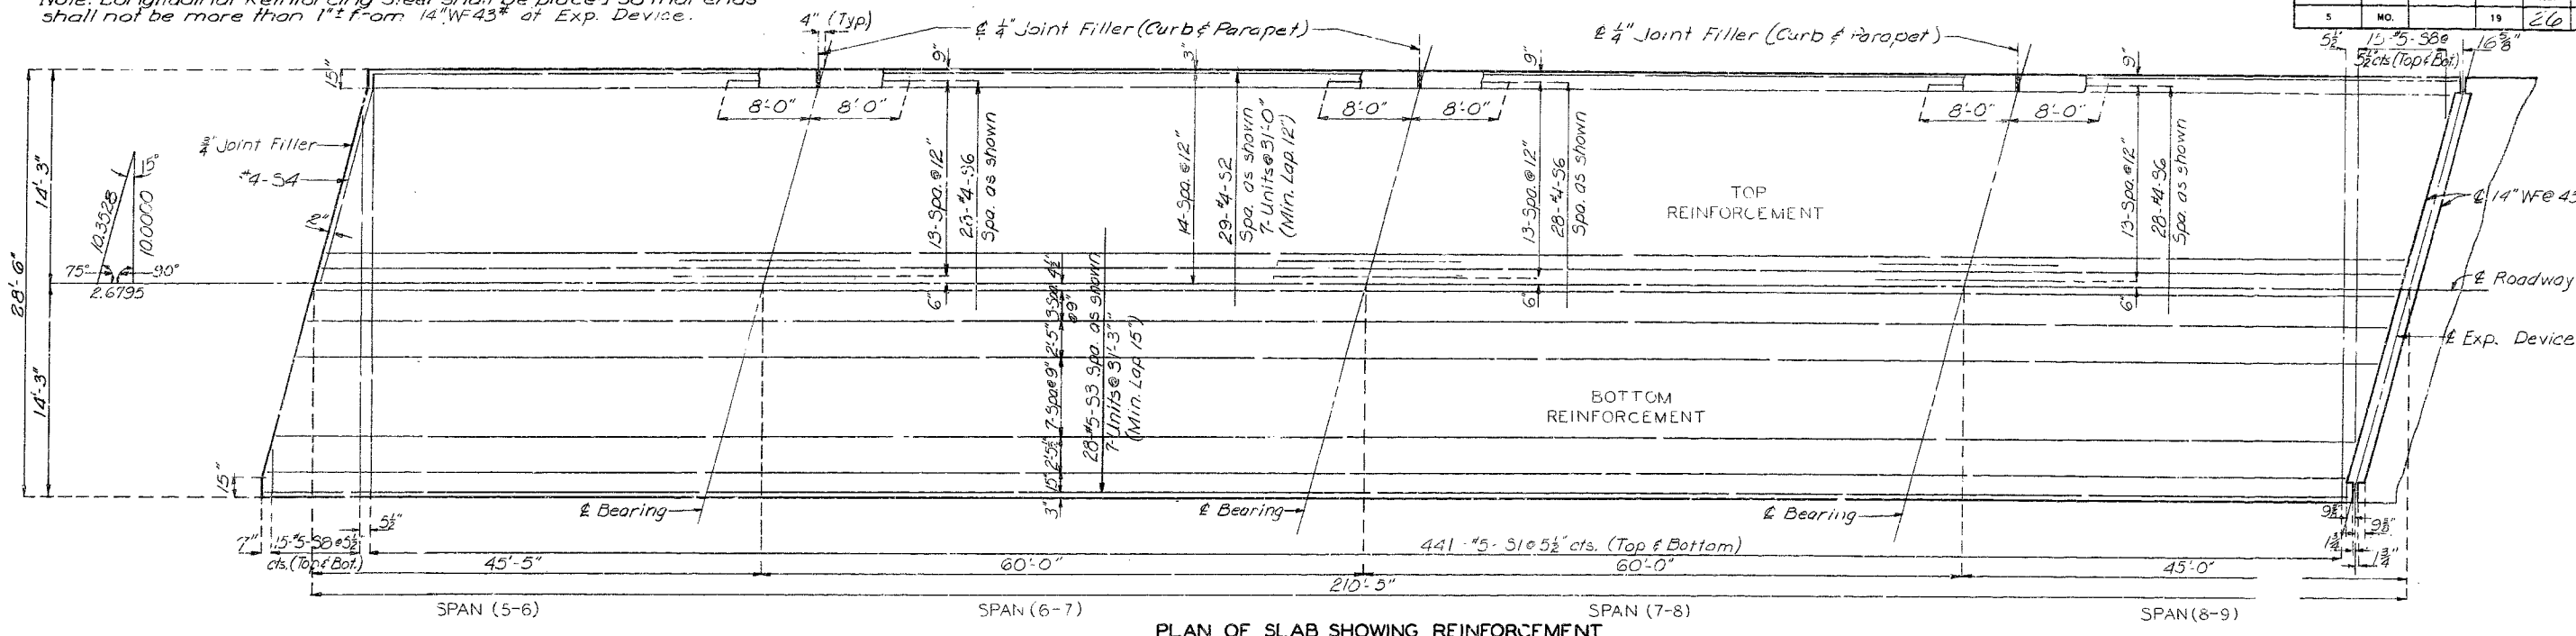


PLAN OF SLAB SHOWING REINFORCEMENT

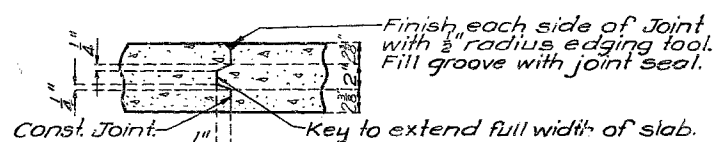


SECTION A-A

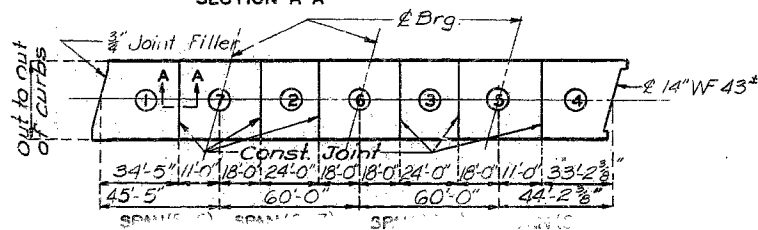


THEORETICAL SLAB HAUNCHING DIAGRAM

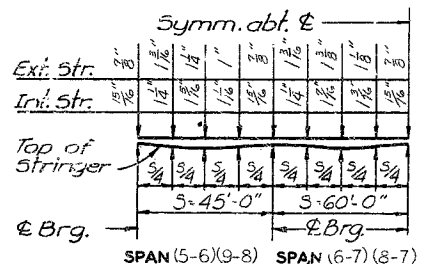

THEORETICAL SLAB HAUNCHING DIAGRAM

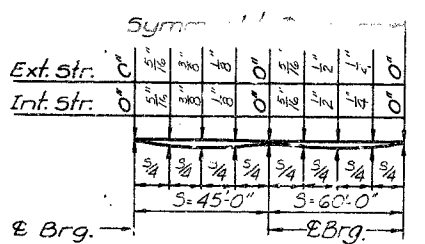


11% Structural Steel DEAD LOAD DEFLECTION (WF BEAM SPAN)

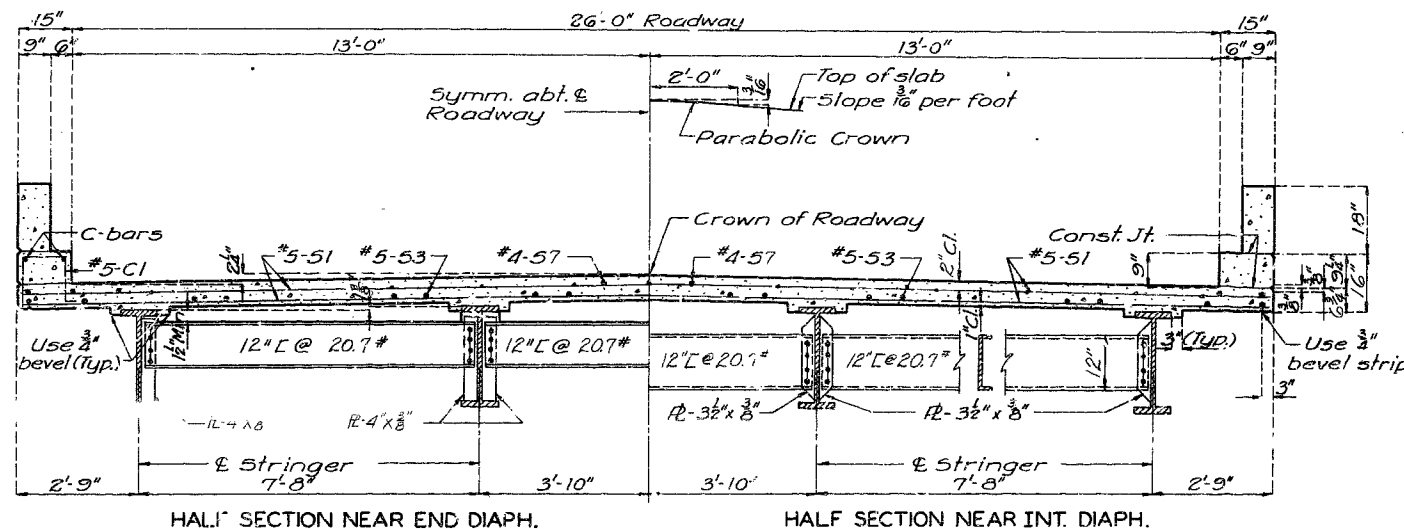

HALF SECTION NEAR END DIAPH.

HALF SECTION NEAR INT. DIAPH.

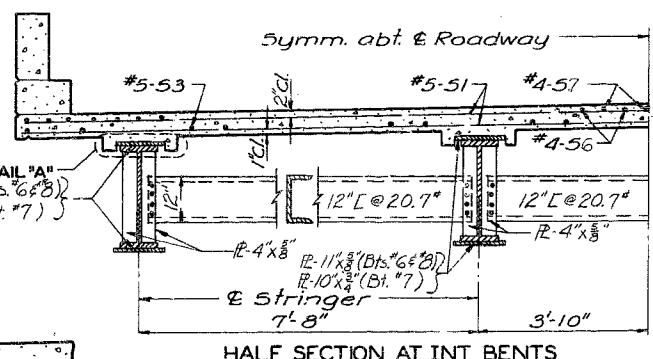

HALF SECTION AT INT. BENTS

Note: For details and reinforcement of curb and parapet not shown see sheets No. 16 & 17 of 17.

BRIDGE OVER PLATTE RIVER
 STATE ROAD FROM RTE. F SOUTHEAST TO EDGERTON
 ABOUT 7 1/2 MILES E. OF DEARBORN
 PROJECT NO. S-616(2)(SZ) STA. 307+63.3
PLATTE COUNTY

Basic Sequence	Sequence of Pours						
	1	2	3	4	5	6	7
Alternate "A" Pours	1	7+2	6+3	5+4			
Alternate "B" Pours	1+7+2		6+3	5+4			
Alternate "C" Pours	1+7+2		6+3+5+4				
Alternate "D" Pours	1+7+2+6+3+5+4						

SLAB POURING SEQUENCE

Note: The contractor shall observe the basic pouring sequence and shall pour and satisfactorily finish the slab pours at a rate of not less than 12 cubic yards per hour. However, he may use one of the longer alternate pours if he elects to use an approved oscillating screed type, self-propelled mechanical finishing machine and can demonstrate to the engineer that he can pour and satisfactorily finish the slab pours at a rate of not less than 25 cubic yards per hour. Finishing machine loads will not be permitted on concrete less than 48 hours old.

No. 41, E.G. 3A Revised
Oct 1964
Dec 1964

DETAILED JUNE 1965 BY CARTER
 CHECKED Sept. 1965 BY Ault

Note: This drawing is not to scale. Follow dimensions.

Sheet No. 14 of 17.




S-25R

116

MISSOURI STATE HIGHWAY DEPARTMENT

FED. ROAD DIST. NO.	STATE	FED. AID PROJ. NO.	FISCAL YEAR	SHEET NO.	TOTAL SHEETS
5	MO.		58	27	


Note: Longitudinal Reinforcing steel shall be placed so that ends shall not be more than 1" from 3/8" plates at Exp. Device and web 14" WF #43.

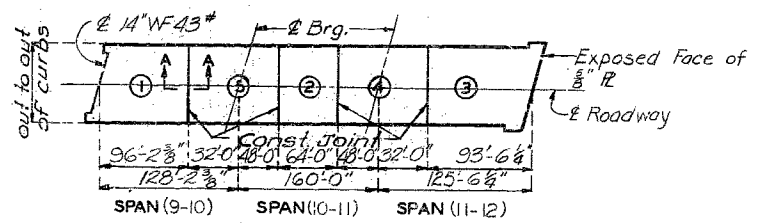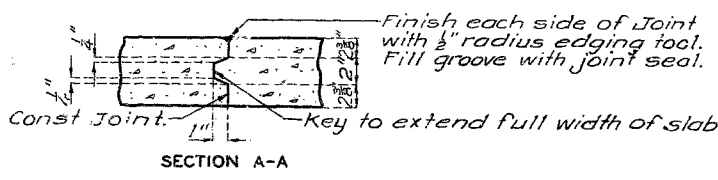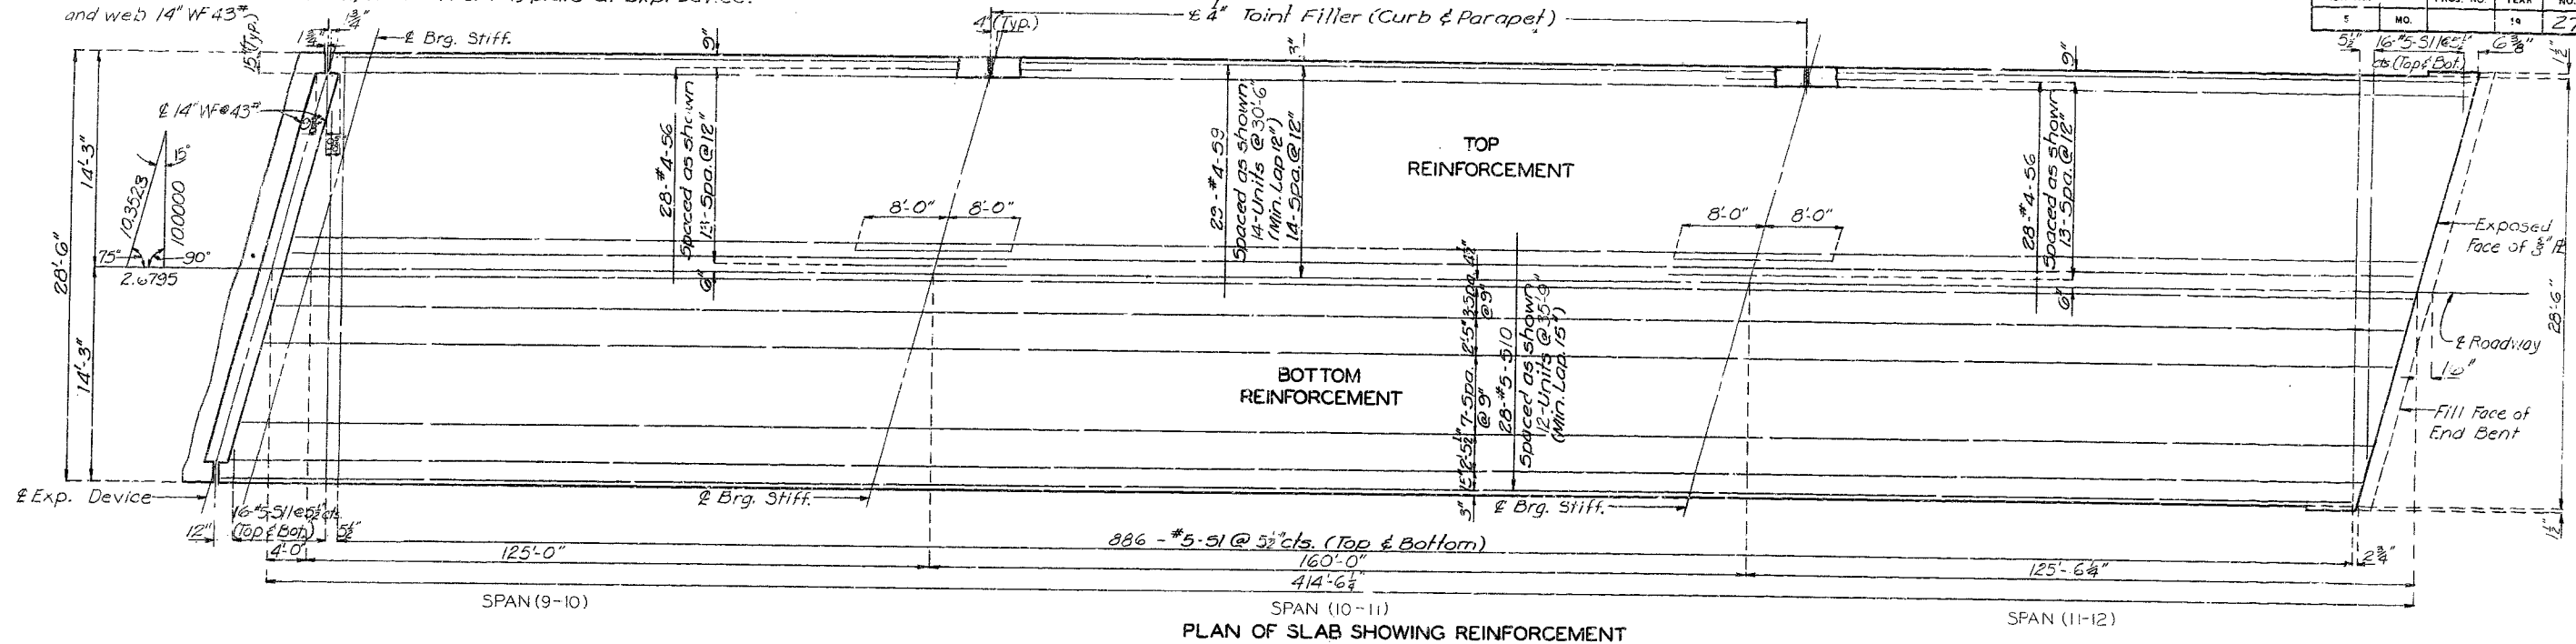

	Sequence of Pours				
	Direction				
Basic Sequence	1	2	3	4	5
Alternate "A" Pours	1	3+2	4+3		
Alternate "B" Pours	1+5+2	4+3			
Alternate "C" Pours	1+5+2+4+3				

Note: The contractor shall observe the basic pouring sequence and shall pour and satisfactorily finish the slab pours at a rate of not less than 25 cubic yards per hour. However, he may use one of the longer alternate pours if he elects to use an approved oscillating screed type, self-propelled mechanical finishing machine and can demonstrate to the engineer that he can pour and satisfactorily finish the slab pours at a rate of not less than 48 cubic yards per hour. Finishing machine loads will not be permitted on concrete less than 48 hours old.

SLAB POURING SEQUENCE

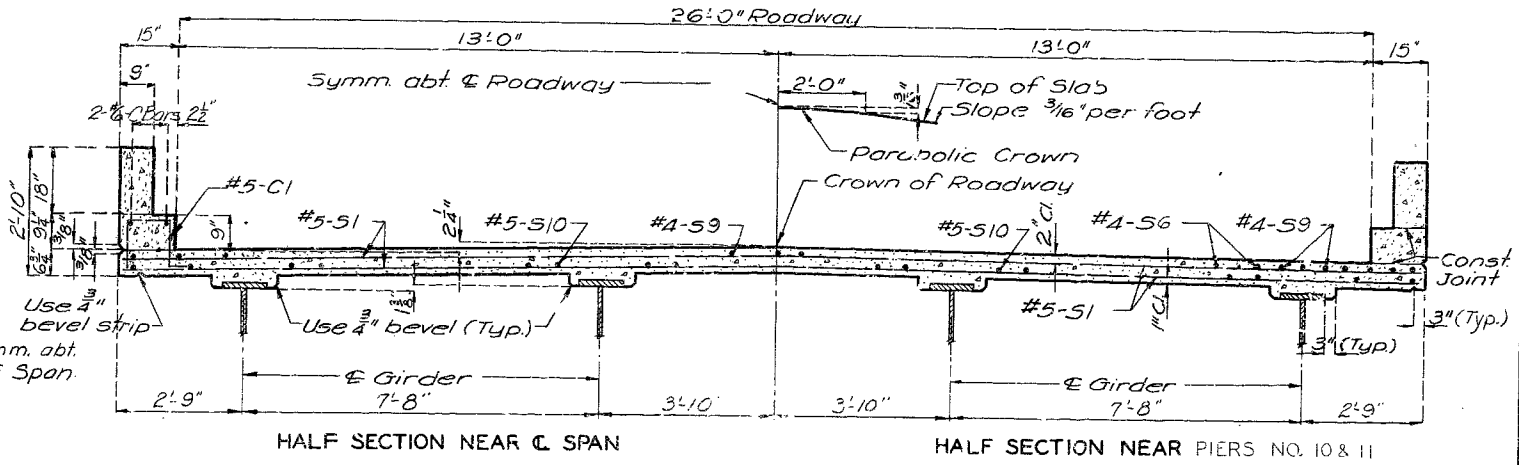

Note: For details of curb and handrail not shown see sheets 16 & 17 of 17.

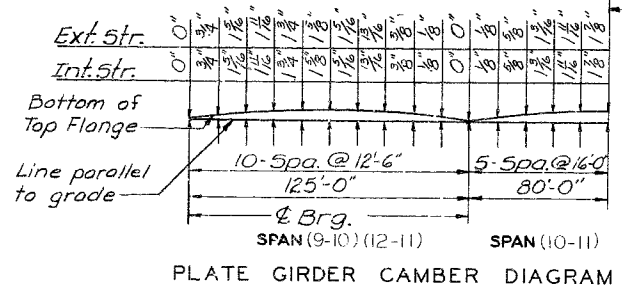


PLATE GIRDER CAMBER DIAGRAM

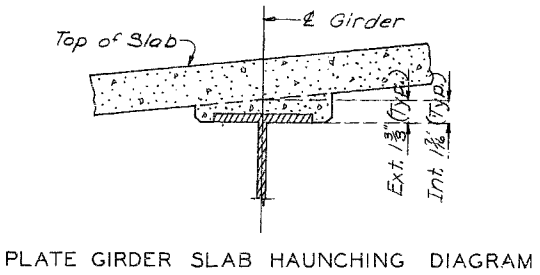


PLATE GIRDER SLAB HAUNCHING DIAGRAM

BRIDGE OVER PLATTE RIVER
 STATE ROAD FROM RTE. F SOUTHEAST TO EDGERTON
 ABOUT 7.0 MILES E. OF DEARBORN
 PROJECT NO. S-616 (2)(SZ) STA. 307+63.3
 PLATTE COUNTY

DETAILED JUNE 1965 BY CARTER
 CHECKED SEPT. 1965 BY AULT


Note: This drawing is not to scale. Follow dimensions.

Sheet No. 15 of 17.

S-25R

MISSOURI STATE HIGHWAY DEPARTMENT

FED. ROAD DIST. NO.	STATE	FED. AID PROJ. NO.	FISCAL YEAR	SHEET NO.	TOTAL SHEETS
5	MO.		19	28	

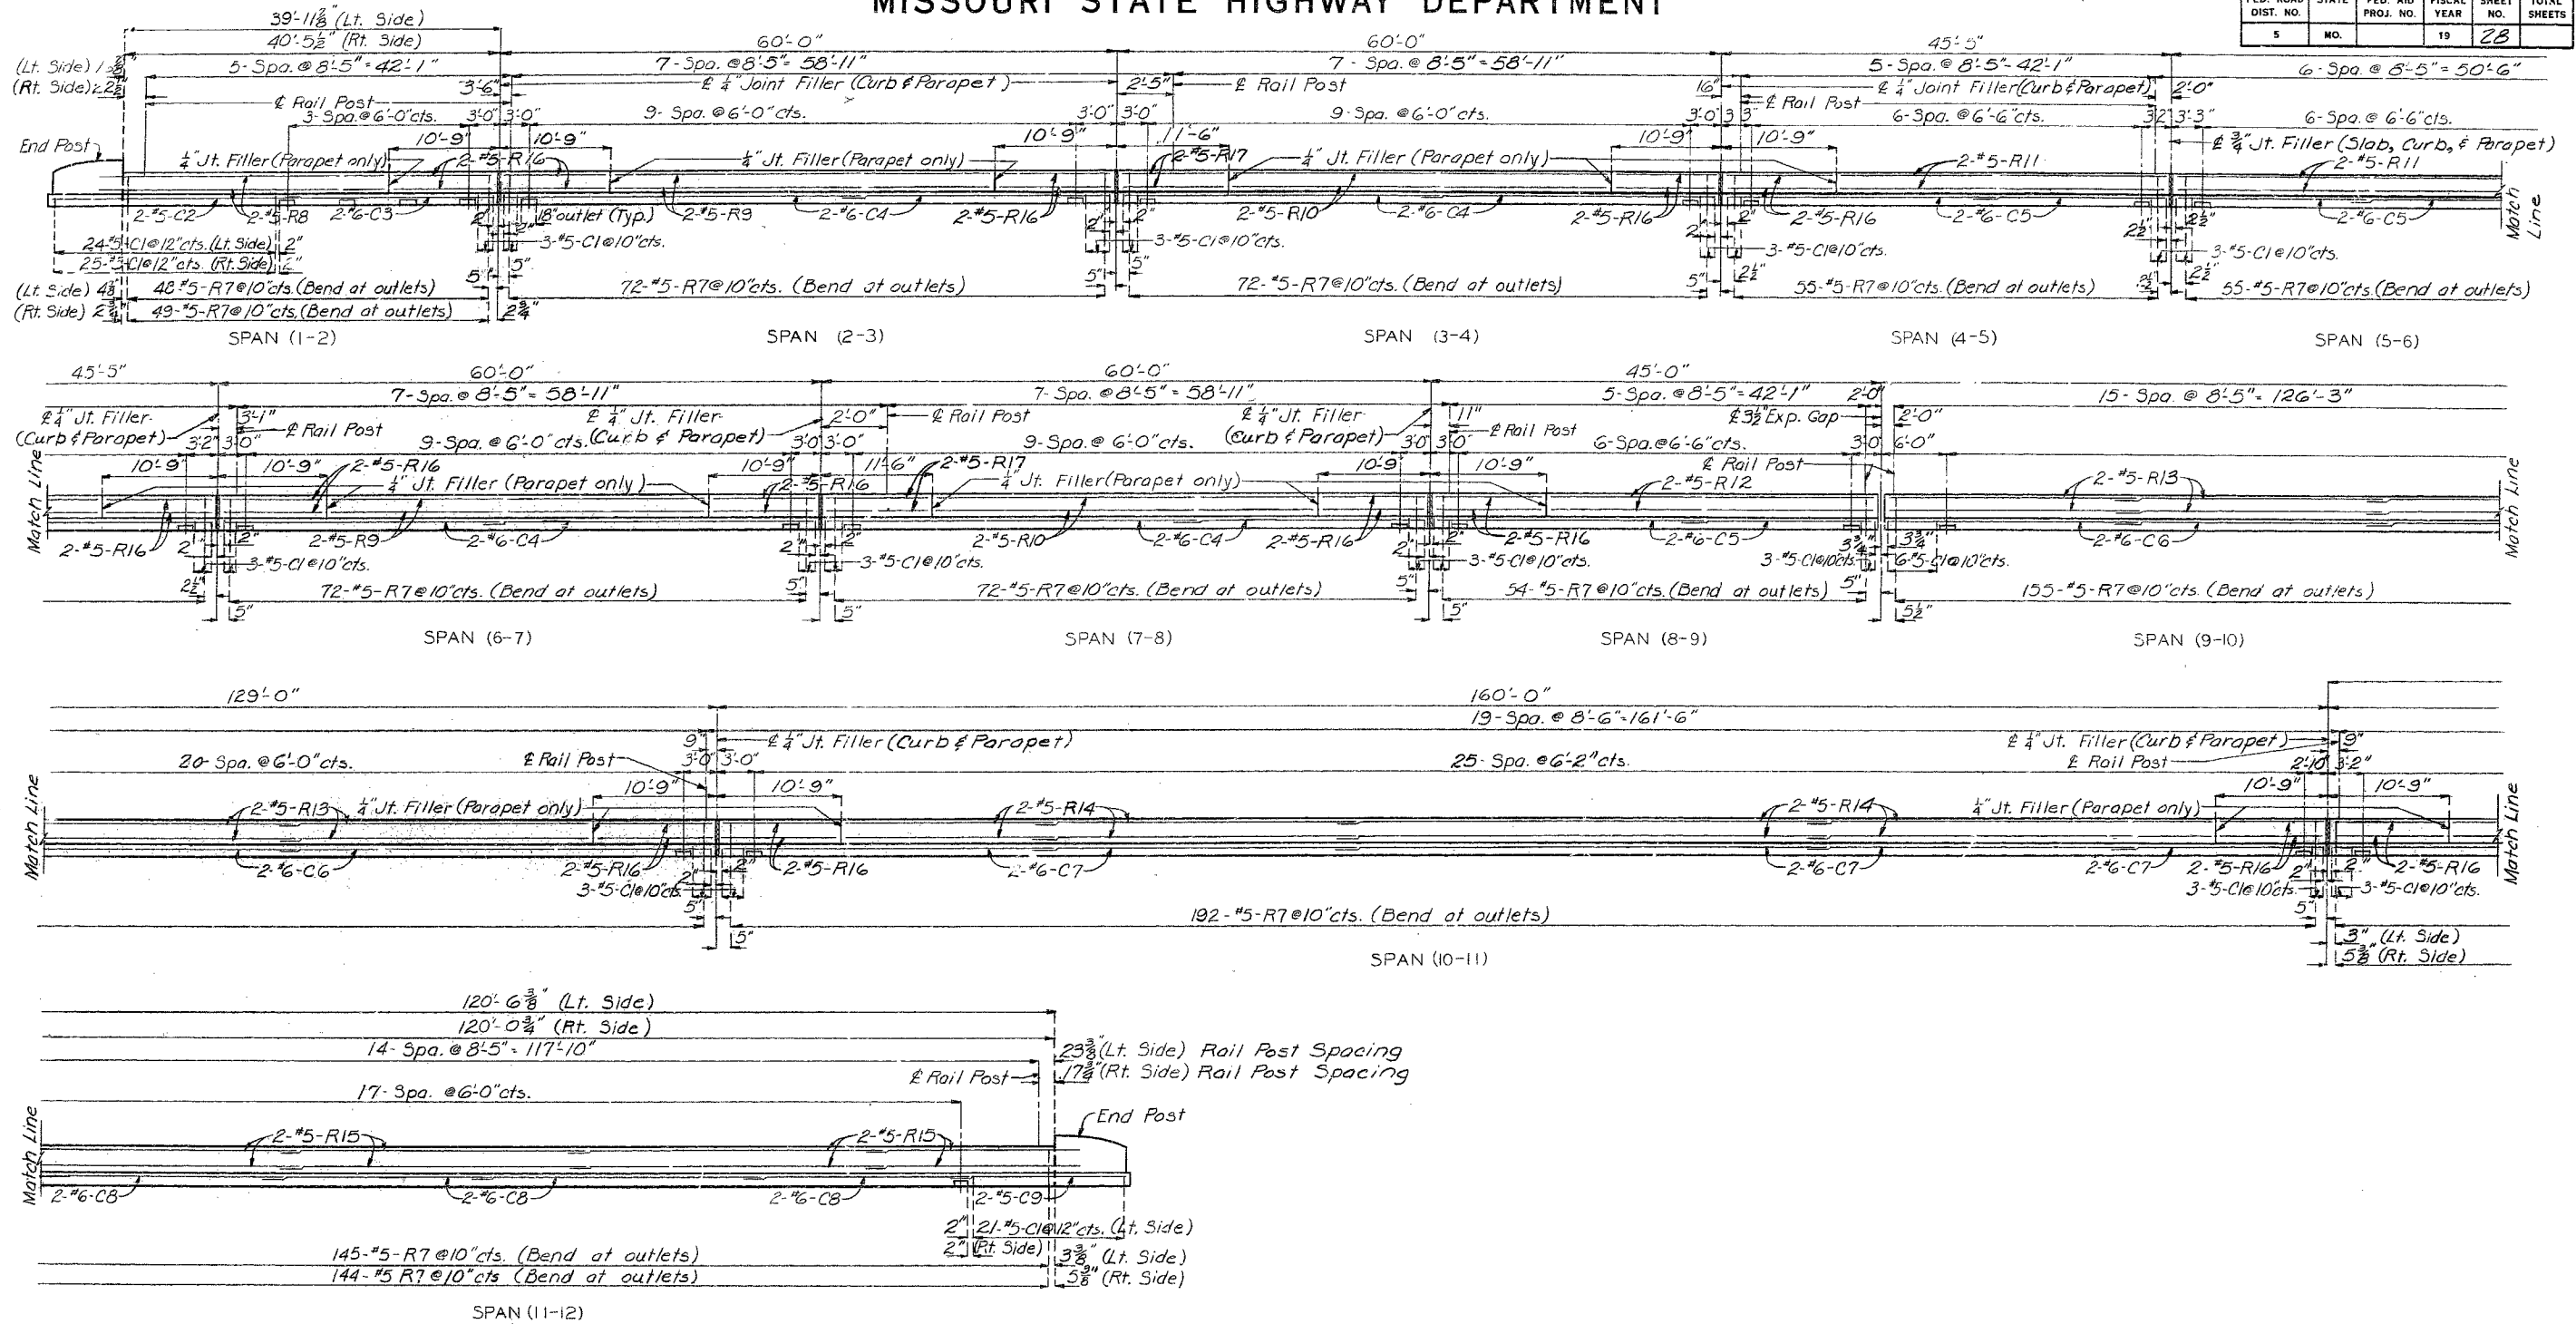

ELEVATION OF CURB AND PARAPET (LEFT SIDE)
(Right side similar except as shown)

Note: For details and reinforcement of curb & parapet not shown see Sheet No. 17 of 17.

BRIDGE OVER PLATTE RIVER
STATE ROAD FROM RTE. F SOUTHEAST TO EDGERTON
ABOUT 7.0 MILES E. OF DEARBORN
PROJECT NO. S-616 (2) (SZ) STA. 307+63.3
PLATTE COUNTY

118

FED. ROAD DIST. NO.	STATE	FED. AID PROJ. NO.	FISCAL YEAR	SHEET NO.	TOTAL SHEETS
5	MO.		19	29	

MISSOURI STATE HIGHWAY DEPARTMENT

GENERAL NOTES:

All handrail posts shall be set normal to grade. Aluminum tube handrail shall be bent to conform to vertical and horizontal alignment of parapet.

Aluminum washer shims between top of parapet and post base may be used for adjusting handrail alignment. Maximum thickness of shims to be $\frac{1}{8}$ ". Where more tilting of post is required for proper alignment, concrete bearing areas shall be ground down.

All parts of handrail, except anchor bolts, nuts, washers, and set screws are to be of aluminum material.

The contract unit price per linear foot of "Bridge Rail" shall include furnishing and erecting the handrail complete with anchor bolts, shims and insulating compound.

All fillets $\frac{1}{4}$ " except as noted.

All drafts 3° except as noted.

Pipe rail to be fabricated in two or three panel lengths unless otherwise approved.






Omit set screw on side near Filled Joint in parapet at all expansion posts.

Top of curbs and parapets to be built parallel to grade. Vertical faces of end post to be vertical.

All exposed edges of end posts, parapets and curbs shall have $\frac{1}{2}$ " radius.

If the contractor desires, he may use drive fit cast aluminum end caps instead of welded aluminum closure plates.

Integrally cast test coupons and a coat of clear lacquer specified in Std. Spec. 56.2.4 and 56.3.5 respectively will not be required for these rail posts.

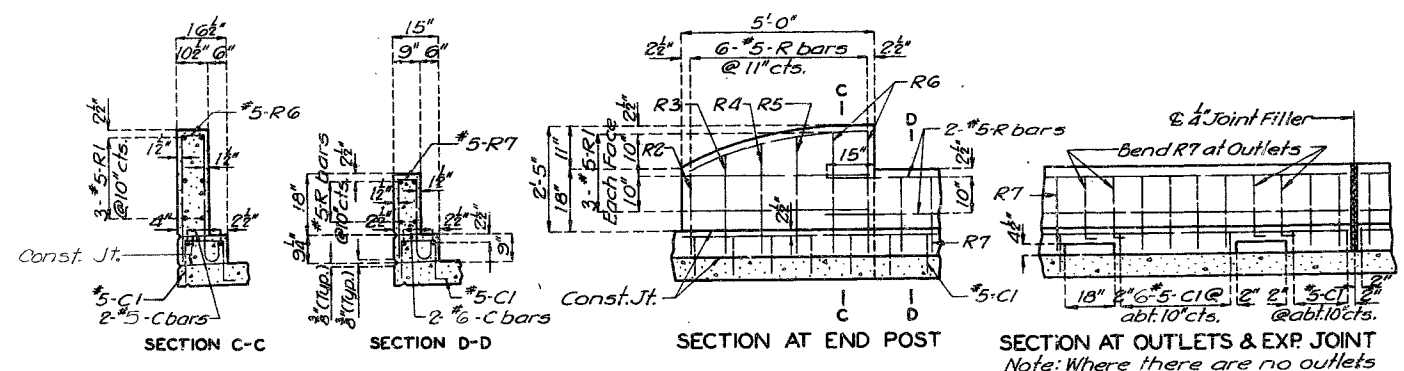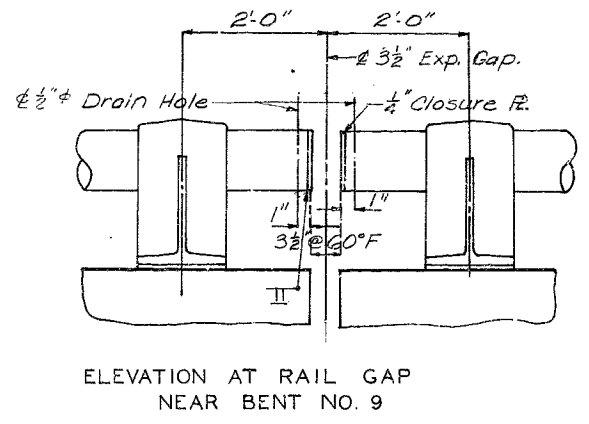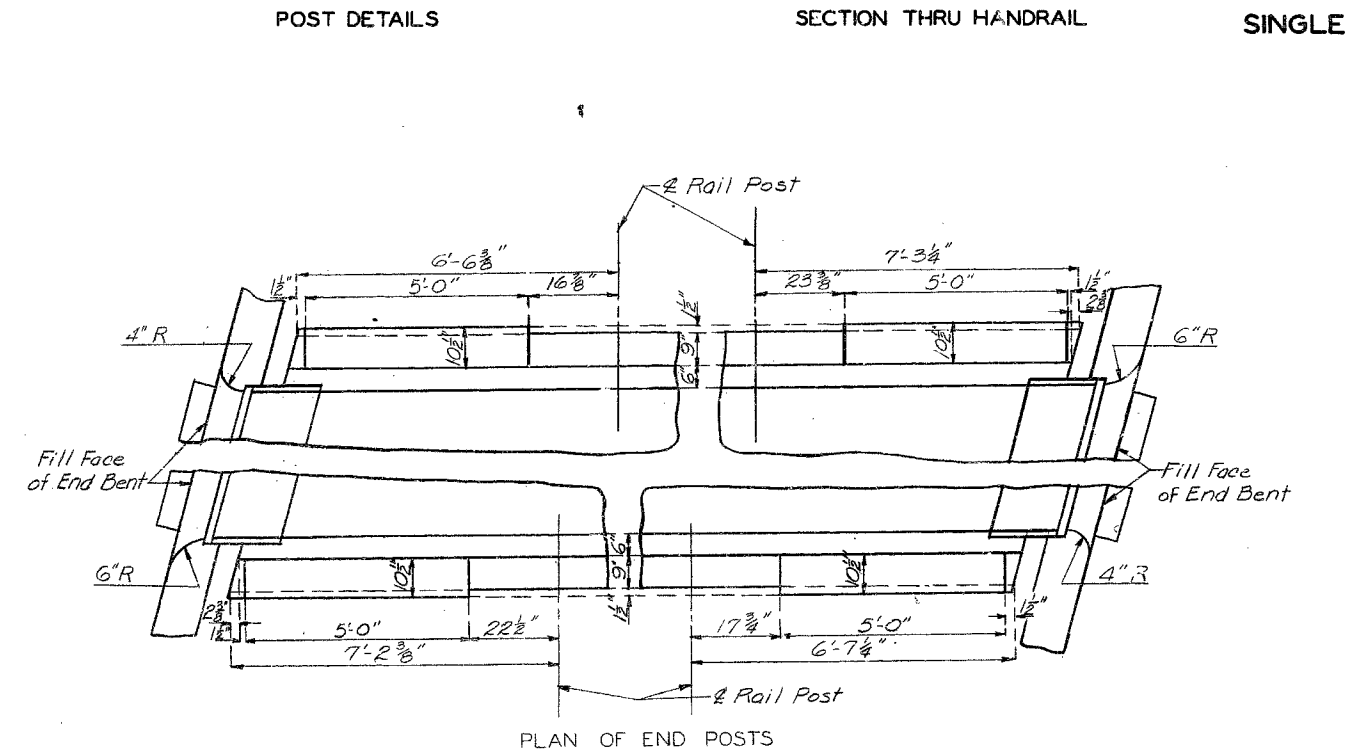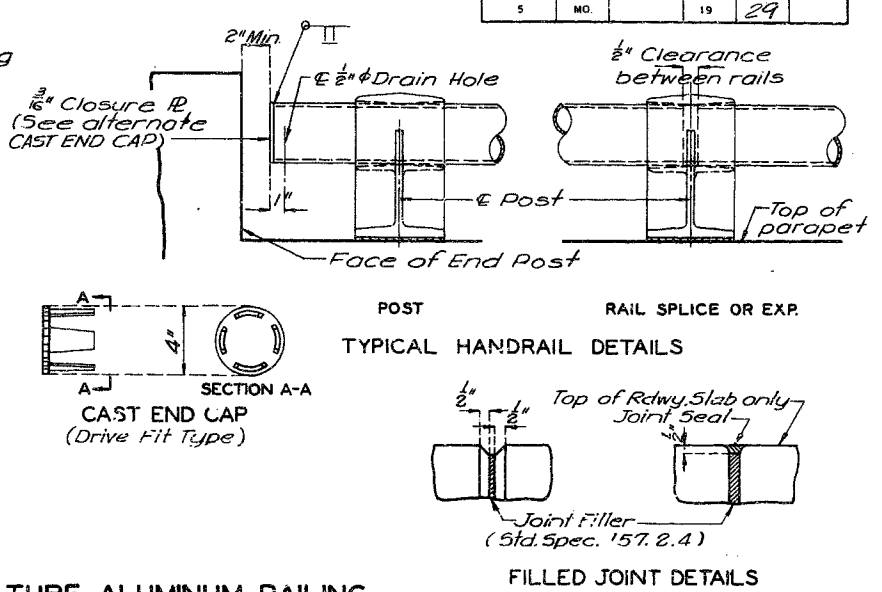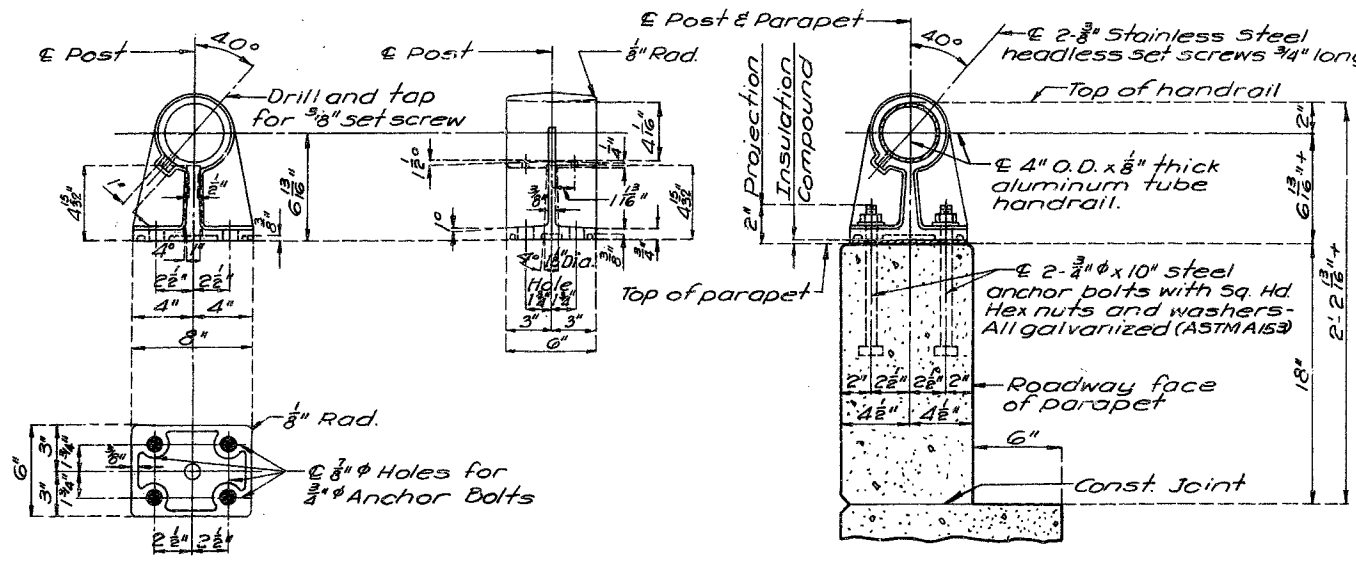

Note: For horizontal curb and parapet bars use minimum lap of 15" for #5 and 18" for #6.

END POST ORDINATES: Shows a diagram of the end post ordinates with dimensions: 5'-0" total width, 18" height, and 3-5pa @ 16" cts.

Note: For elevation of curb & parapet see Sheet No. 16 of 17.

BRIDGE OVER PLATTE RIVER
 STATE ROAD FROM RTE. F SOUTHEAST TO EDGERTON
 ABOUT 7.0 MILES E. OF DEARBORN
 PROJECT NO. S-616(2) (SZ) STA. 307+63.3
 PLATTE COUNTY

Note: This drawing is not to scale. Follow dimensions.

Sheet No. 17 of 17.

119


No. 15.2
 Revised
 NOV 1963
 MAY 1965

DETAILED JUNE 1965 BY CARTER
 CHECKED Sept. 1965 BY AULT


S-25R

MISSOURI STATE HIGHWAY DEPARTMENT


FED. ROAD DIST. NO.	STATE	FED. AID PROJ. NO.	FISCAL YEAR	SHEET NO.	TOTAL SHEETS
5	MO		19	13	

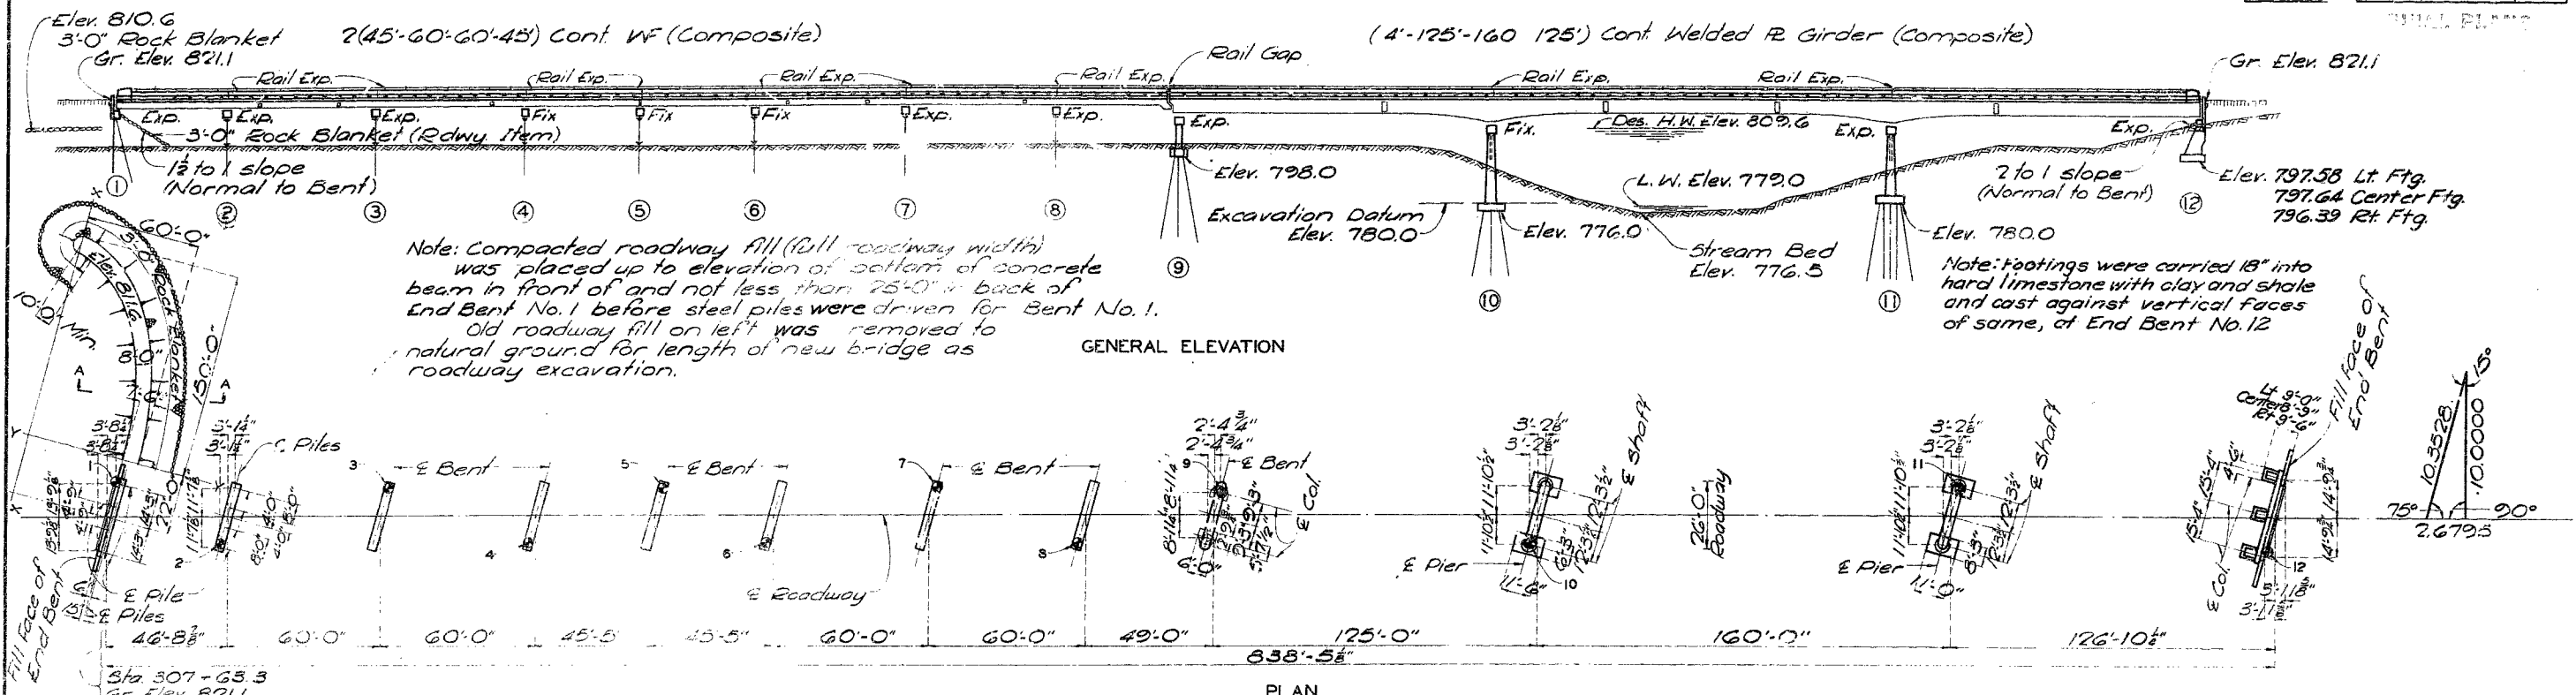

Note: Compacted roadway fill (full roadway width) was placed up to elevation of bottom of concrete beam in front of and not less than 25'-0" in back of End Bent No. 1 before steel piles were driven for Bent No. 1. Old roadway fill on left was removed to natural ground for length of new bridge as roadway excavation.

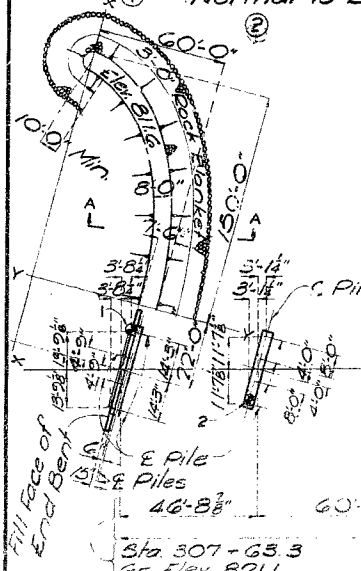

Note: For Boring Data see sheet No. 30 of 17. * Indicates location of Boring.

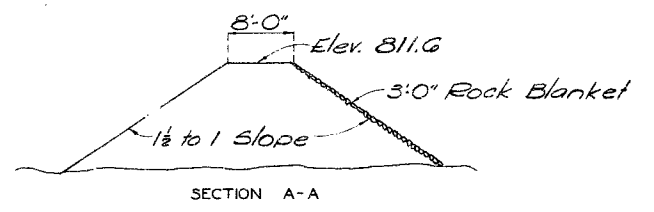

GENERAL NOTES:
 SPECIFICATIONS:
 A.A. 3.H.O. - 1961
 DESIGN LOADING:
 H15-44 (15"/sq. ft. Future Wearing Surface)
 Earth-120", Equivalent Fluid Pressure 30"
 DESIGN UNIT STRESSES:
 Class B Concrete (substructure) $f'_c = 1,200$ psi
 Class B1 Concrete (superstructure) $f'_c = 1,600$ psi
 Reinforcing Steel $f'_s = 20,000$ psi
 Structural Steel (A.S.T.M. A36-G2T) $f'_s = 20,000$ psi
 Steel Pile (A.S.T.M. A36-G2T) $f'_b = 2,000$ psi
 SURFACE SEAL:
 Superstructure deck surface sealed.
 FABRICATED STEEL:
 Field connections, High Strength Bolts $\frac{3}{4}$ " ϕ , holes $\frac{13}{16}$ " ϕ except as noted.
 WELDING:
 Details of welded joints shown are for manual arc welding except as noted.

ITEM	FINAL QUANTITIES		
	Substr.	Superstr.	Total
Removal of Bridge			
Class 1 Excavation for Structures	465.5		465.5
Class 2 Excavation for Structures	39.5		39.5
Steel Piles-in-Place (10")	2265		2265
Steel Pile Cut-offs (10")	73		73
Steel Piles-in-Place (12")	517		517
Steel Pile Cut-offs (12")	123		123
Class B Concrete	250.9		250.9
Class B1 Concrete	634.3		634.3
Reinforcing Steel	30,170	181,740	211,910
Fabricated Structural Carbon Steel (WF-Bm span)		190,790	190,790
Fabricated Structural Carbon Steel (R.Gdr. span)		343,570	343,570
Bridge Rail (Single tube type)		1,649	1,649
Cl. 1 Exc. for Structures Below Plan El. (Contingent)	1.0		1.0
Test Holes	28		28

Note: For quantity of concrete in bridge structure, see sheet No. 1. For weight of steel, see sheet No. 2.

BENT OR PIER NO.	FOOTING AND PILE DATA											
	1	2	3	4	5	6	7	8	9	10	11	12
Foundation Material												Rock
Design Bearing Tons/Sq. Ft.												70
Pile Type and Size	10BP42	10BP42	10BP42	10BP42	10BP42	10LP42	10BP42	10BP42	10BP42	12BP53	12BP53	
Number	4	4	4	4	4	4	4	4	4	6	12	16
Rate Length Ft.	60	65	65	65	65	65	65	65	65	45	20	25
Driving Tons	37	55	55	55	37	55	55	55	55	70	46	
Minimum Required Bearing Tons	24	44	46	44	34	44	46	44	43	62	45	
Hammer	Power	Heavy Power	Power	Power	Power	Heavy Power	Power	Power	Power	Power	Power	

Piles were driven to practical refusal on or into solid rock or other point bearing material at the location shown in the Plan Bearing shown.

Heavy power hammer is specified all piling were driven with an approved power hammer developing an energy of not less than 19,000 ft. lbs. and having a ram weighing not less than 4500 lbs.

B.M. Elev. 821.71 "E" on N.E. Cor. Wing Wall
 Sta. 307+63.3
 Elev. 821.72 "D" on S.W. Cor. Wing Wall
BRIDGE OVER PLATTE RIVER Sta. 316+0.73
 STATE ROAD FROM RTE. F SOUTHEAST TO EDGERTON
 ABOUT 7.0 MILES E. OF DEARBORN
 PROJECT NO. S-616 (2) (SZ) STA. 307+63.3
PLATTE COUNTY


SUBMITTED BY: D.T. [Signature] DATE: 10/4/65
 APPROVED BY: W.J. [Signature] DATE: 10/4/65

STD. 54.00
 S-25R

021

MISSOURI STATE HIGHWAY DEPARTMENT

FED. ROAD DIST. NO.	STATE	FED. AID PROJ. NO.	FISCAL YEAR	SHEET NO.	TOTAL SHEETS
5	MO.		19	18	

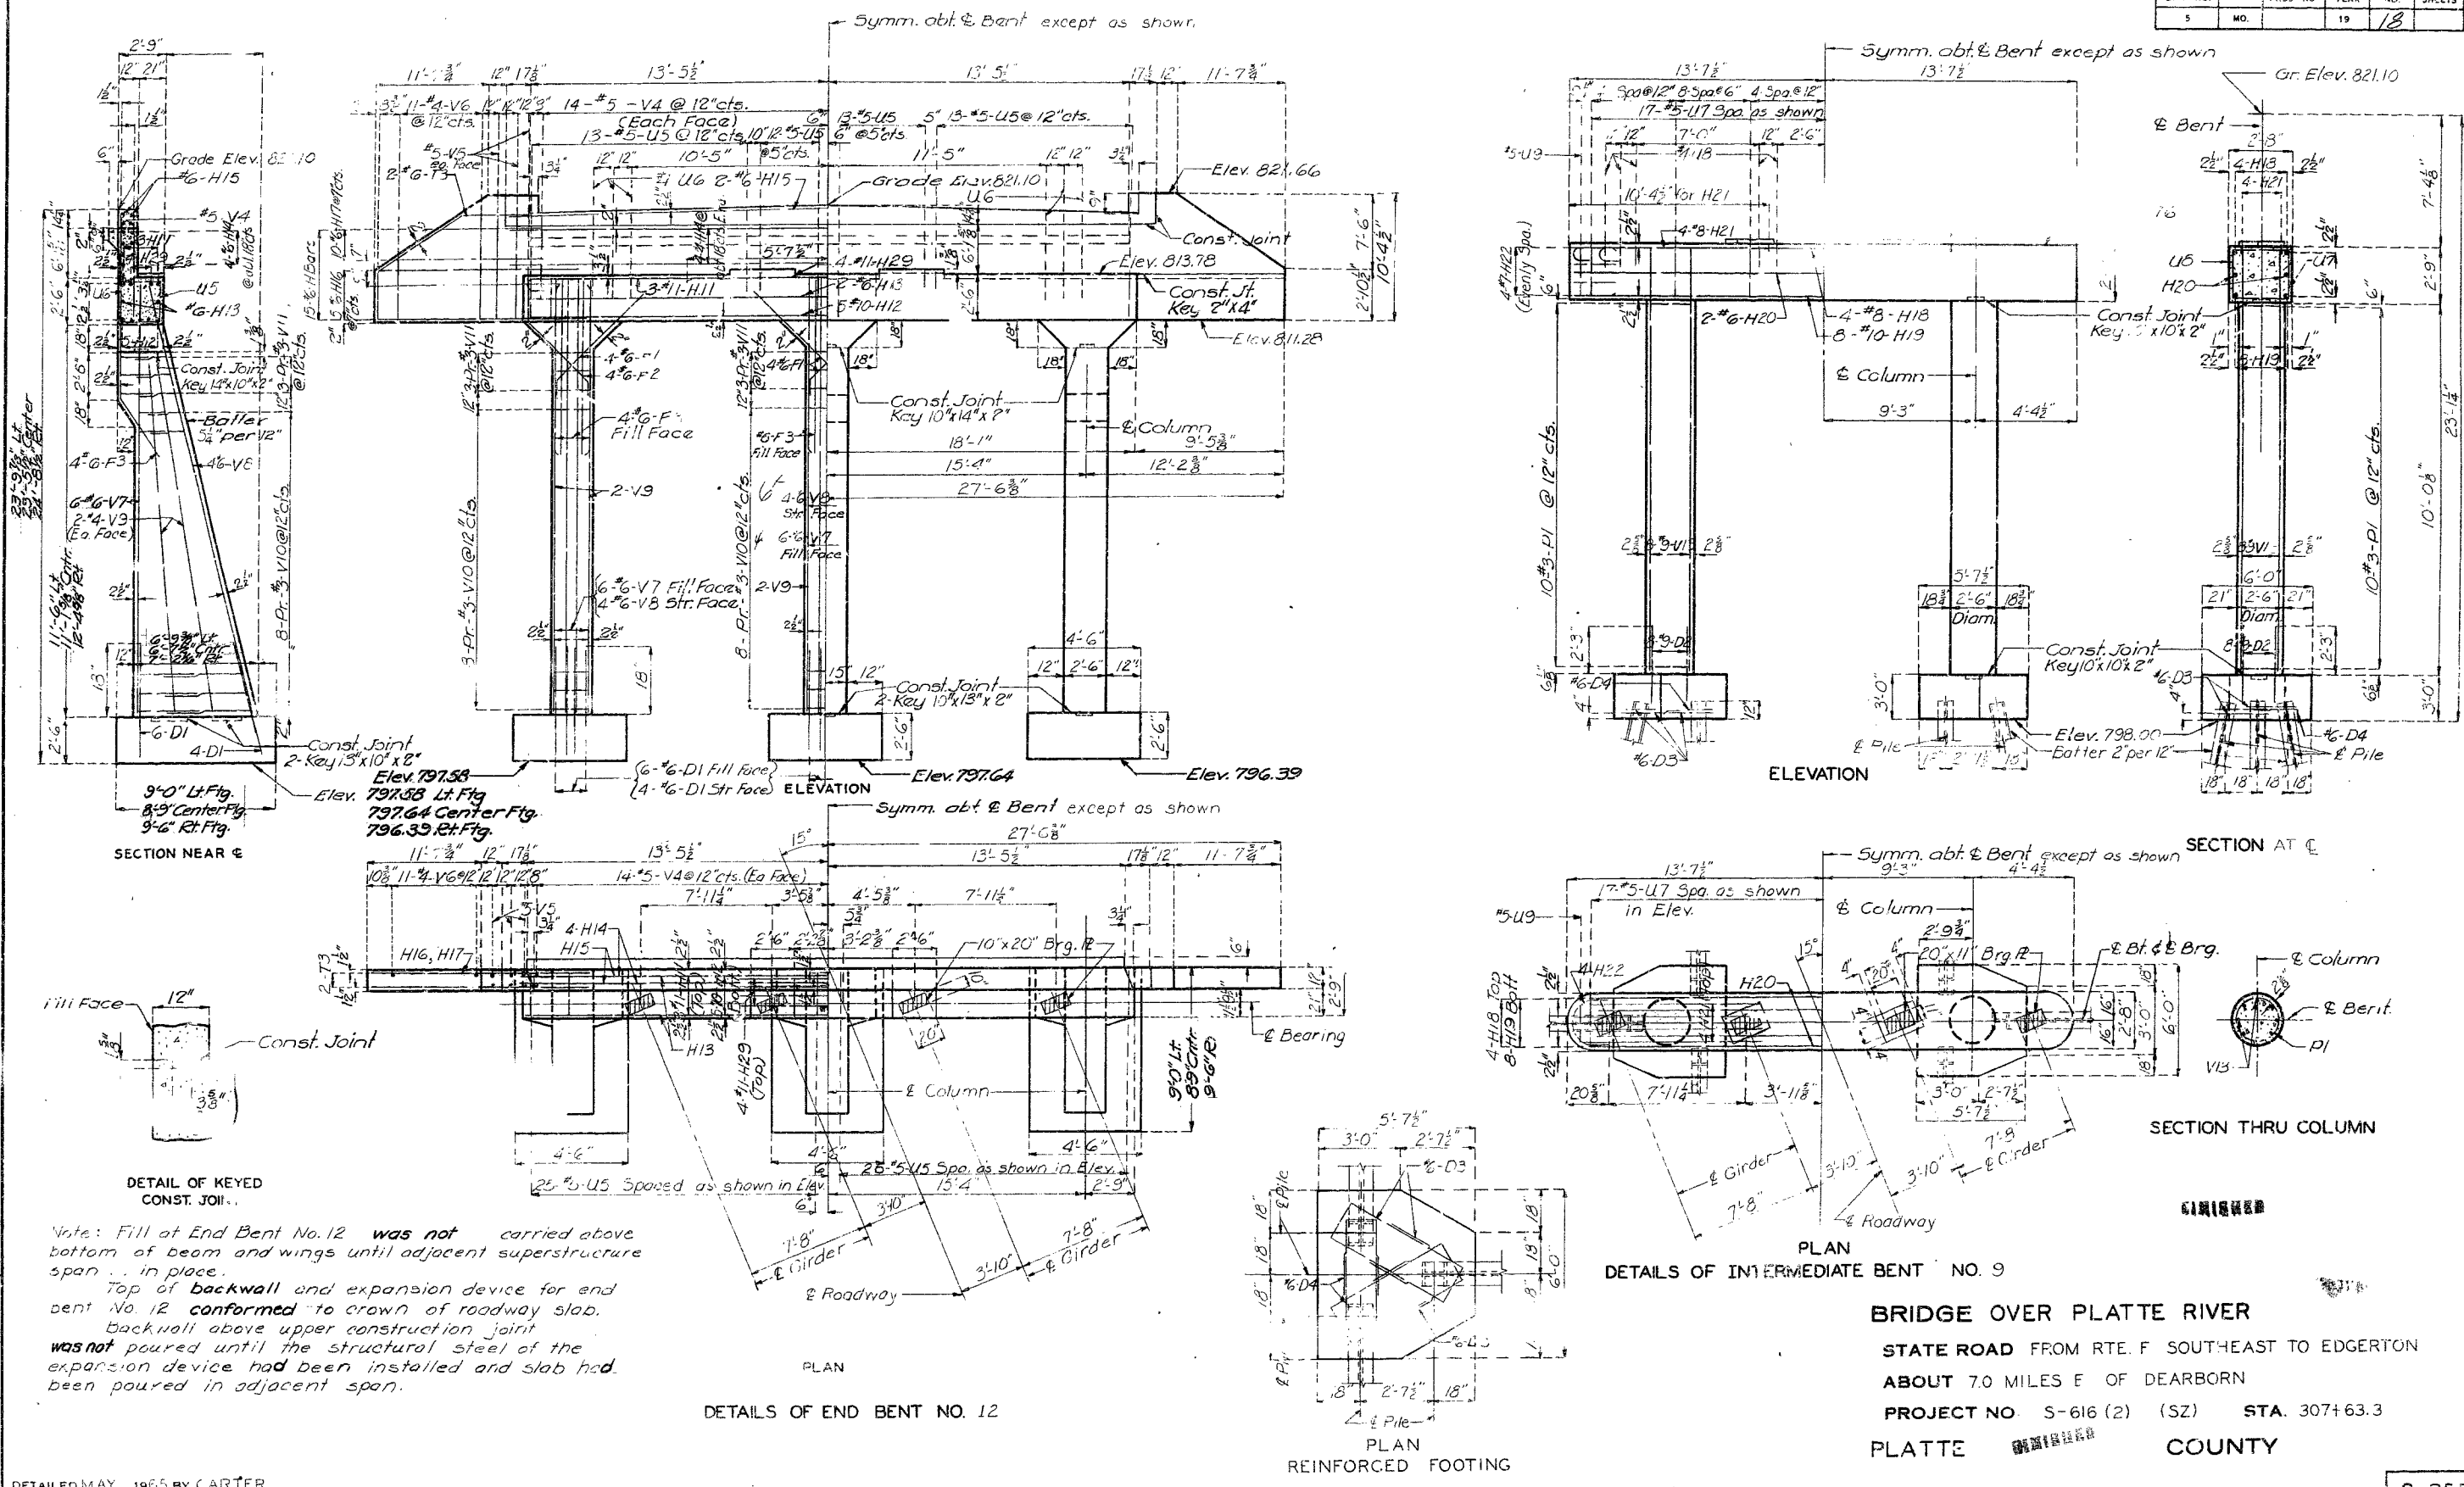

Note: Fill at End Bent No. 12 was not carried above bottom of beam and wings until adjacent superstructure span in place.
 Top of backwall and expansion device for end bent No. 12 conformed to crown of roadway slab.
 Backwall above upper construction joint was not poured until the structural steel of the expansion device had been installed and slab had been poured in adjacent span.

Note: This drawing is not to scale. Follow dimensions.

Sheet No. 2 of 2

FINAL PLANS


BRIDGE OVER PLATTE RIVER
 STATE ROAD FROM RTE. F. SOUTHEAST TO EDGERTON
 ABOUT 7.0 MILES E. OF DEARBORN
 PROJECT NO. S-616 (2) (SZ) STA. 307+63.3
 PLATTE COUNTY

S-25R

121


MISSOURI STATE HIGHWAY DEPARTMENT

FED. ROAD DIST. NO.	STATE	FED. AID PRG. NO.	FISCAL YEAR	SHEET NO.	TOTAL SHEETS
5	MO.		19		

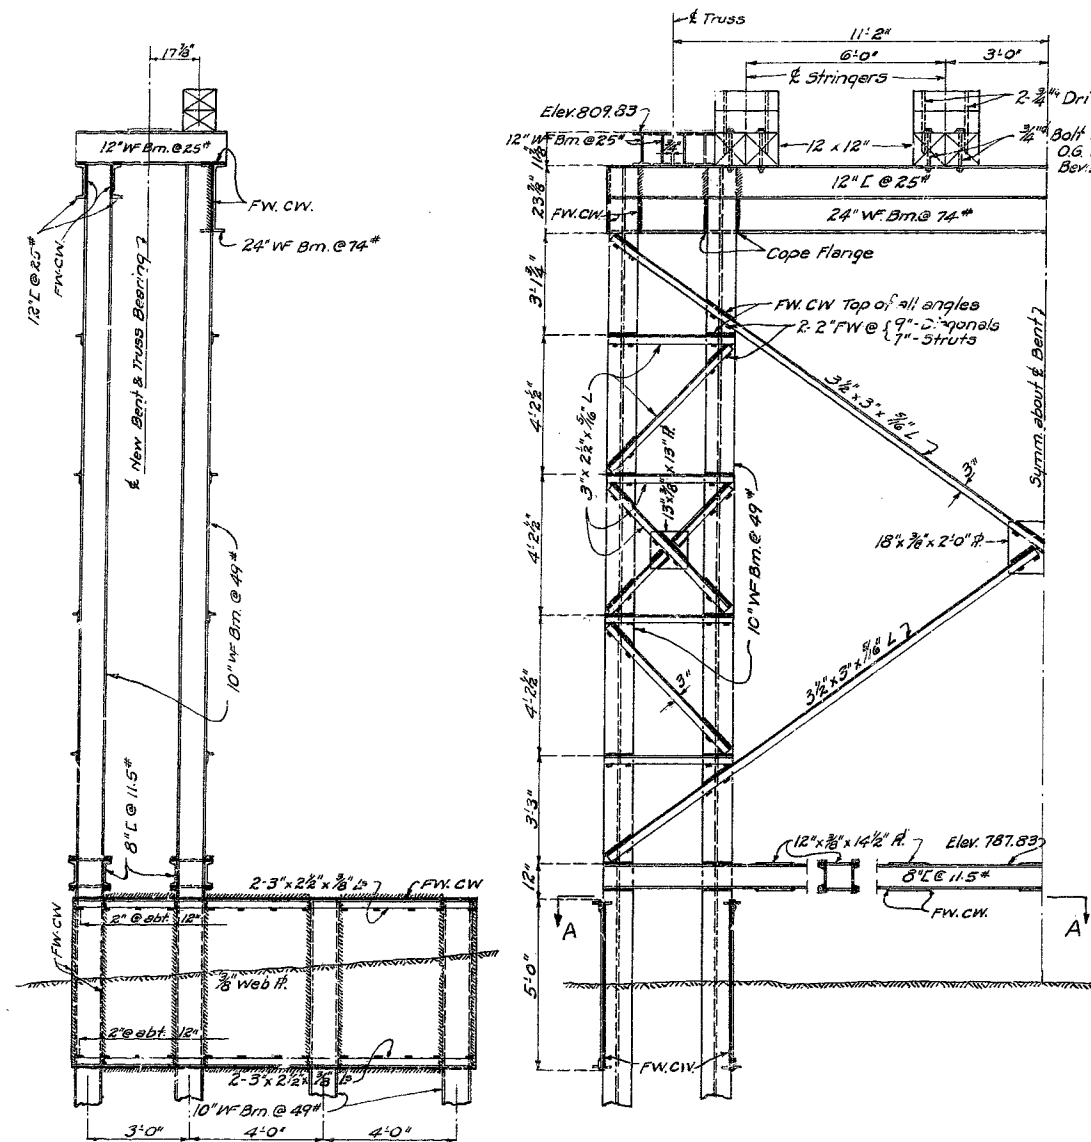


END ELEVATION C-C

HALF ELEVATION

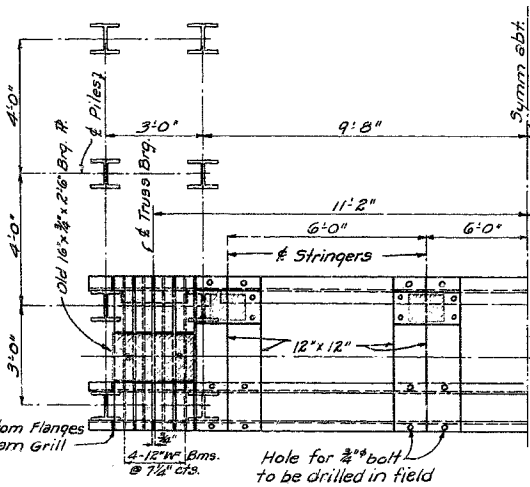


HALF PLAN


Note: Bracing not shown for sake of clearance

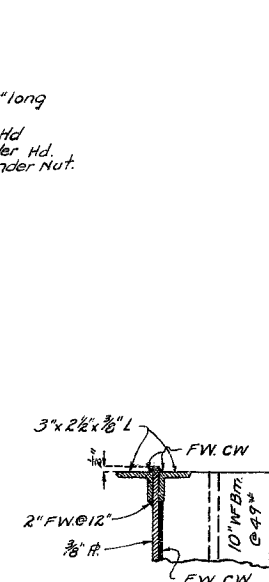


DETAIL "A"

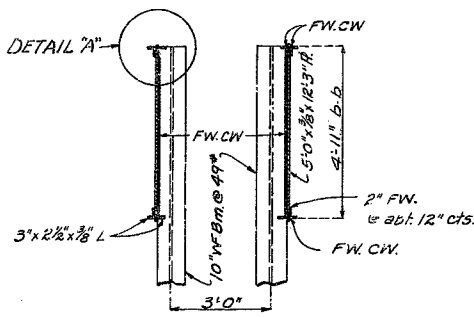

SECTION B-B

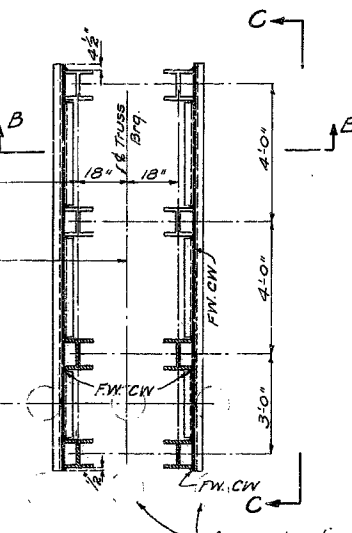


HALF SECTION A-A

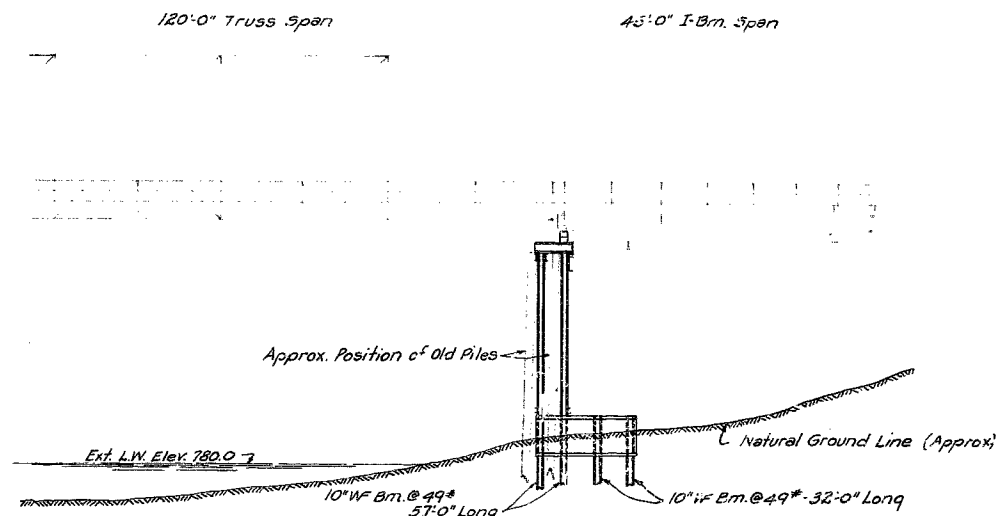

PART ELEVATION

Note: All piles shall be driven with a steam hammer developing not less than 1000 ft. lbs. at each full stroke of the piston to practical refusal into cemented gravel, boulders, shale or solid rock.

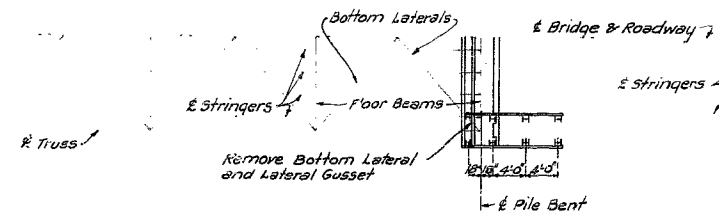


PART HALF PLAN


ESTIMATED QUANTITIES		
Fabricated Structural steel	Lbs.	12482
10" WF Bm. Piles in Place	Lin. Ft.	664
10" WF Bm. Pile Cut-Offs	Lin. Ft.	48
1/4" Weld Metal	Lin. Ft.	580

CONSTRUCTION PROCEDURE

Remove expansion devices and laminated floor necessary to drive new piles.
Remove bottom laterals and lateral gussets in end panel.

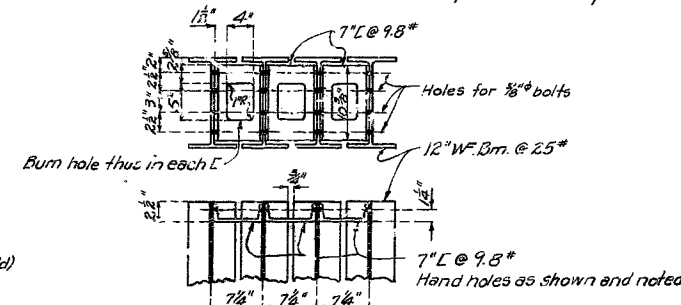

DETAILS OF I-BEAM GRILL

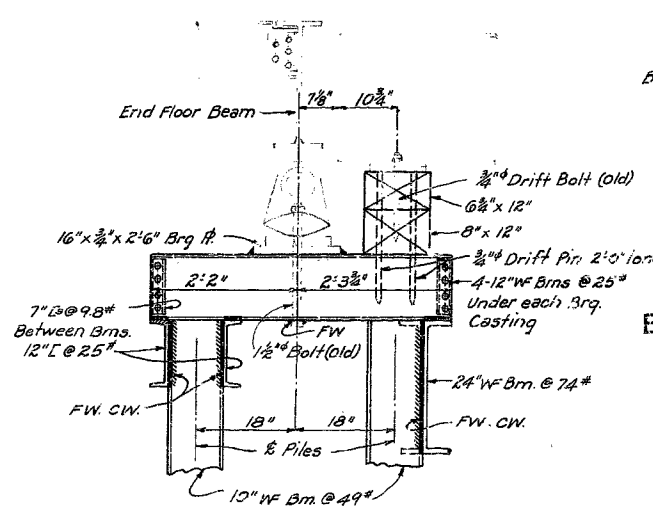

DETAIL OF TRUSS BEARING

Note: Heavy lines indicate new work. Light lines indicate old work.

BRIDGE OVER PLATTE RIVER

STATE ROAD FROM DEARBORN TO EDGERTON
ABOUT 2.0 MILES N.W. OF EDGERTON
PROJECT NO. SZ STA. 312+50
PLATTE COUNTY

FINISHED

SUBMITTED BY _____ DATE _____
BRIDGE ENGINEER

APPROVED BY _____ DATE _____
CHIEF ENGINEER

S-25 A



102

Drawn April 1937 By JMM.
Checked April 1937 By C.W.

FINISHED
Sheet 1

MISSOURI HIGHWAY AND TRANSPORTATION COMMISSION

State	Proj. No.	Sheet No.
MO		B1
SEC/SUR 1	TWP 54N RGE 34W	

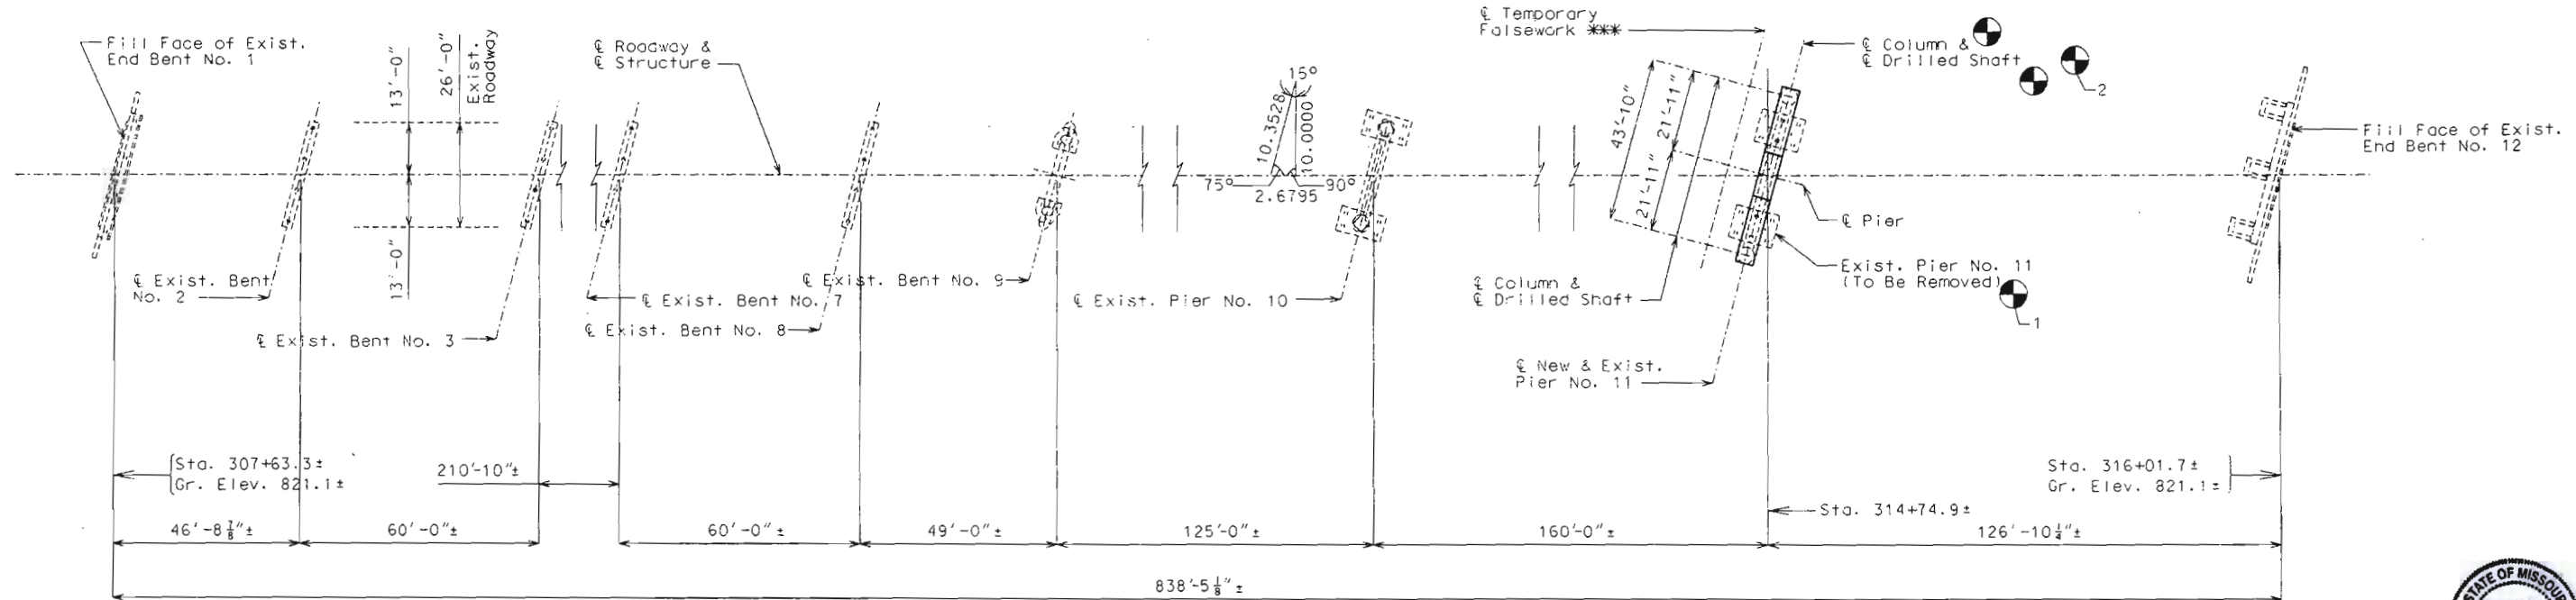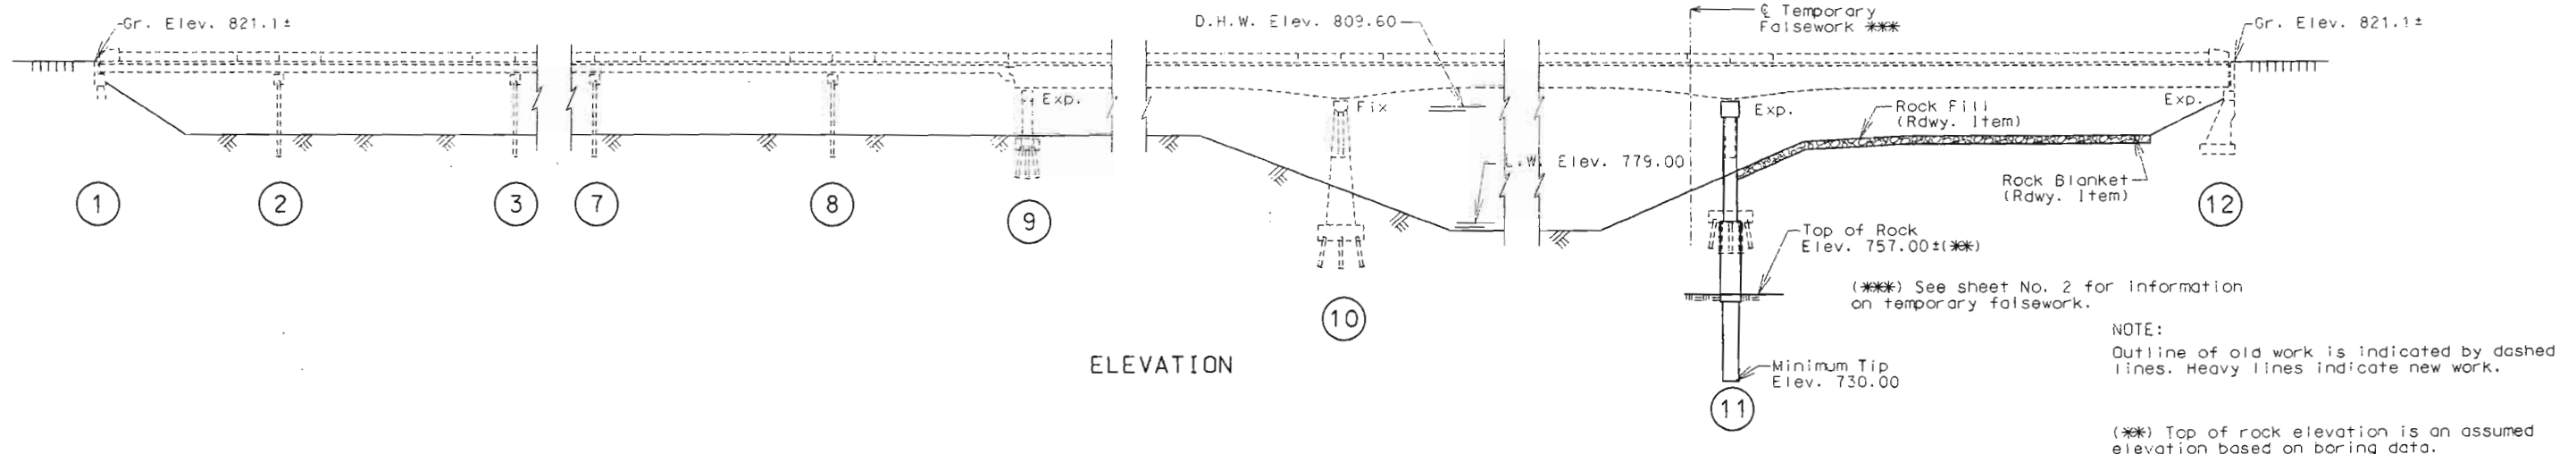

PLAN



Notice and Disclaimer Regarding Boring Log Data

The locations of all recent subsurface borings for this structure are shown on the bridge plan sheet for this structure.

Boring data for the numbered locations is shown on sheet no. 3. The Boring data for all locations indicated, as well as any other boring logs or other factual records of subsurface data and investigations performed by the department for the design of the project, is available from the Project Contact upon written request as outlined in the project special provisions.

No greater significance or weight should be given to the boring data depicted on the plan sheets than is subsurface data available from the district or elsewhere.

The Commission does not represent or warrant that any such boring data accurately depicts the conditions to be encountered in constructing this project.

A contractor assumes all risks it may encounter in basing its bid prices, time or schedule of performance on the boring data depicted here or those available from the district, or on any other documentation not expressly warranted, which the contractor may obtain from the Commission.

B.M. Elev. 821.72 "□" on S.W. Cor. Wing Wall
Sta. 316+01.73

REPAIRS TO BRIDGE OVER PLATTE RIVER

STATE ROAD FROM RTE. F SOUTHEAST TO EDGERTON
ABOUT 7 MILES EAST OF DEARBORN

PROJECT NO. STA. 307+63.3±
JOB NO. J4S1368 RTE. Z

Designed Jan. 1999
Detailed Feb. 1999
Checked Feb. 1999

PLATTE COUNTY
Date: 3/10/99

STD. 706.35
S00253

ESTIMATED QUANTITIES				
ITEM		SUBSTR.	SUPERSTR.	TOTAL
Removal of Existing Pier no. 11	Lump Sum			1
Temporary Falsework	Lump Sum			1
Supplementary Foundation Test Holes (NX)	Lin. Ft.	20		20
Supplementary Cored Holes	Lin. Ft.	38		38
Drilled Shafts (8'-0" Dia.)	Lin. Ft.	24		24
Rock Sockets (7'-6" Dia.)	Lin. Ft.	52		52
Supplementary Television Inspection	Each	1		1
Class B1 Concrete (Substructure)	Cu. Yds.	114.8		114.8
Laminated Neoprene Bearing Pads (Steel Structures)	Each		4	4
Reinforcing Steel (Bridges)	Pound	48,040		48,040

NOTE: The cost of furnishing, fabricating and installing Neoprene Bearing Pads, complete in-place, will be paid for at the contract unit price for Laminated Neoprene Bearing Pads (Steel Structures), per each.

GENERAL NOTES:

DESIGN SPECIFICATIONS:

AASHTO-1996 and Interim 1997
Load Factor Design.
Seismic Performance Category A

DESIGN LOADINGS:

H15-44
Fatigue Case II
15#/Sq. Ft. Future Wearing Surface

REINFORCING STEEL:

Minimum clearance to the reinforcing steel shall be 1-1/2", unless otherwise shown.

All reinforcing bars in top of substructure beam or cap shall be spaced to clear anchor bolt wells for bearings by at least 1/2".

MISC.


Contractor shall verify all dimensions in field before ordering materials.
Bridge will be closed to traffic during construction.
No construction live load shall be allowed on bridge.

DESIGN UNIT STRESSES:

Class B1 Concrete (Substructure) f'c = 4,000 psi.

Reinforcing Steel (Grade 60) fy = 60,000 psi.

Bearings shall be 60 Durometer Neoprene Pads.
The neoprene pad shall be bonded to the bearing seat with an epoxy adhesive as approved by the bearing manufacturer for bonding neoprene to concrete.

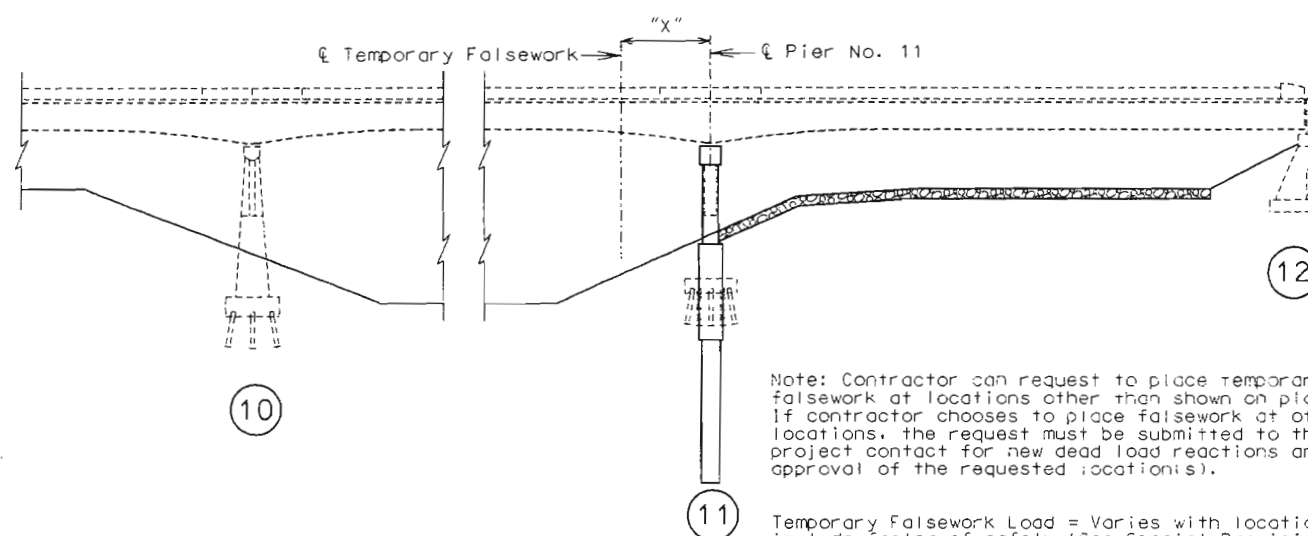

Note: Contractor can request to place temporary falsework at locations other than shown on plans. If contractor chooses to place falsework at other locations, the request must be submitted to the project contact for new dead load reactions and approval of the requested locations).

Temporary Falsework Load = Varies with location (see table) and does not include factor of safety (See Special Provisions)

Use 4x4 Temporary Timber Blocking as bearing stiffeners for falsework and jacking points. Place on each side of existing web or brg. stiffener as required by design.

Dim. "x"	INT. GDR. DEAD LOAD REACTION (TONS)(PER GDR.)	EXT. GDR. DEAD LOAD REACTION (TONS)(PER GDR.)
10'-0"	88 tons	77 tons
15'-0"	86 tons	75 tons

DRILLED SHAFT DATA		
PIER NO. 11	Left(1)	Right(2)
Foundation Material	Shale	Shale
Approximate length (Ft.)	38	38
Design Side Friction (Tons/Sq. Ft.)	0.57	0.57


PAY LIMITS FOR EACH SHAFT AND SOCKET	
Drilled Shaft	Rock Socket
12'-0"	26'-0"

DRILLED SHAFT NOTES :

The top of sound rock is assumed at the elevation determined from the borings. The pay length is based on this assumed top of rock elevation.


Prior to placing drilled shaft casings the contractor shall be required to drill an NX size core hole at each shaft for additional subsurface investigation. The holes shall be located by the Engineer and shall extend at least 10 ft. below the bottom of socket elevation. See Special Provisions.



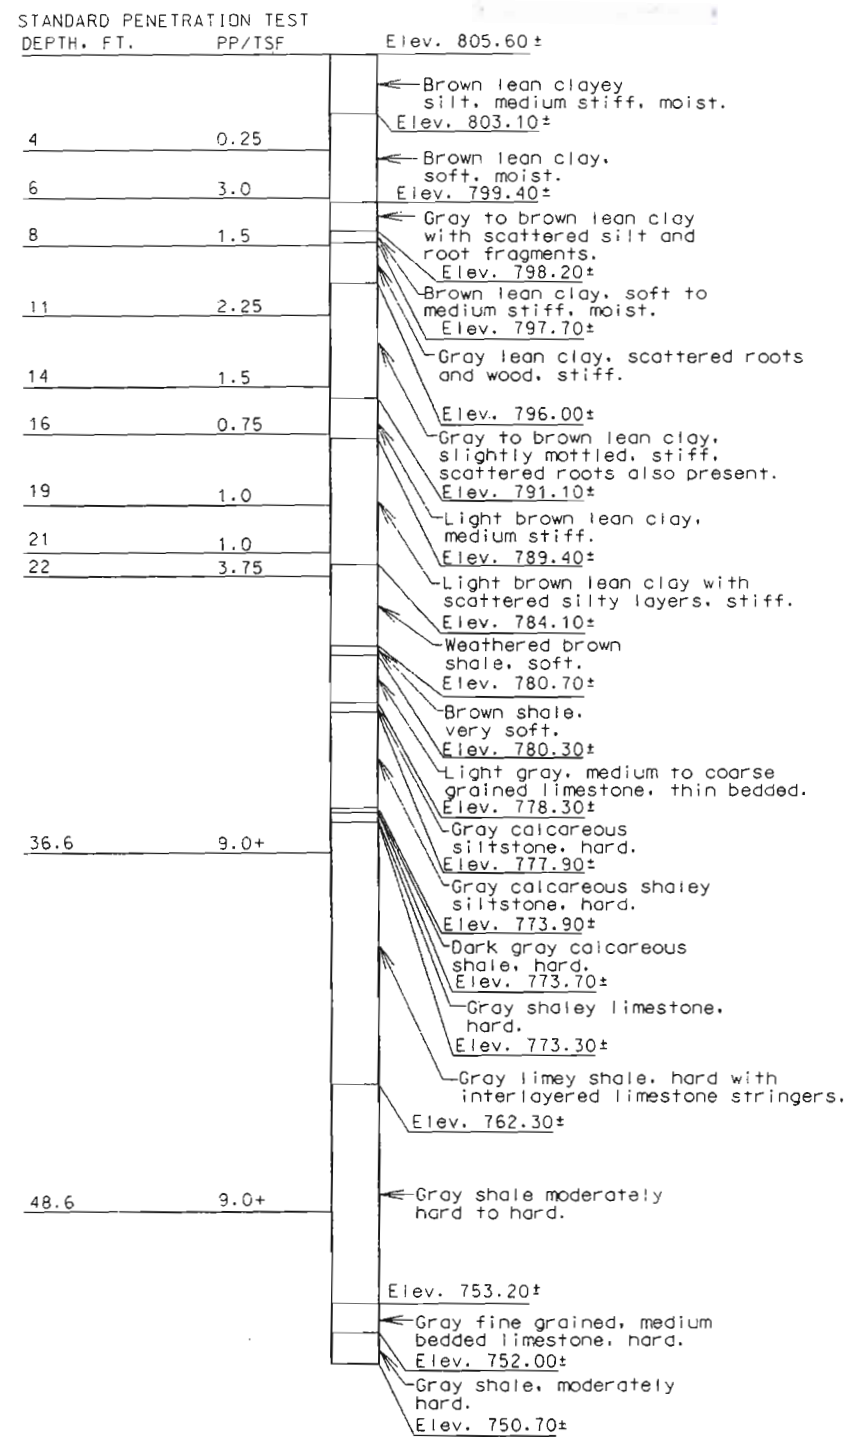

①
CORE

Note: For location of borings see sheet No. 1.

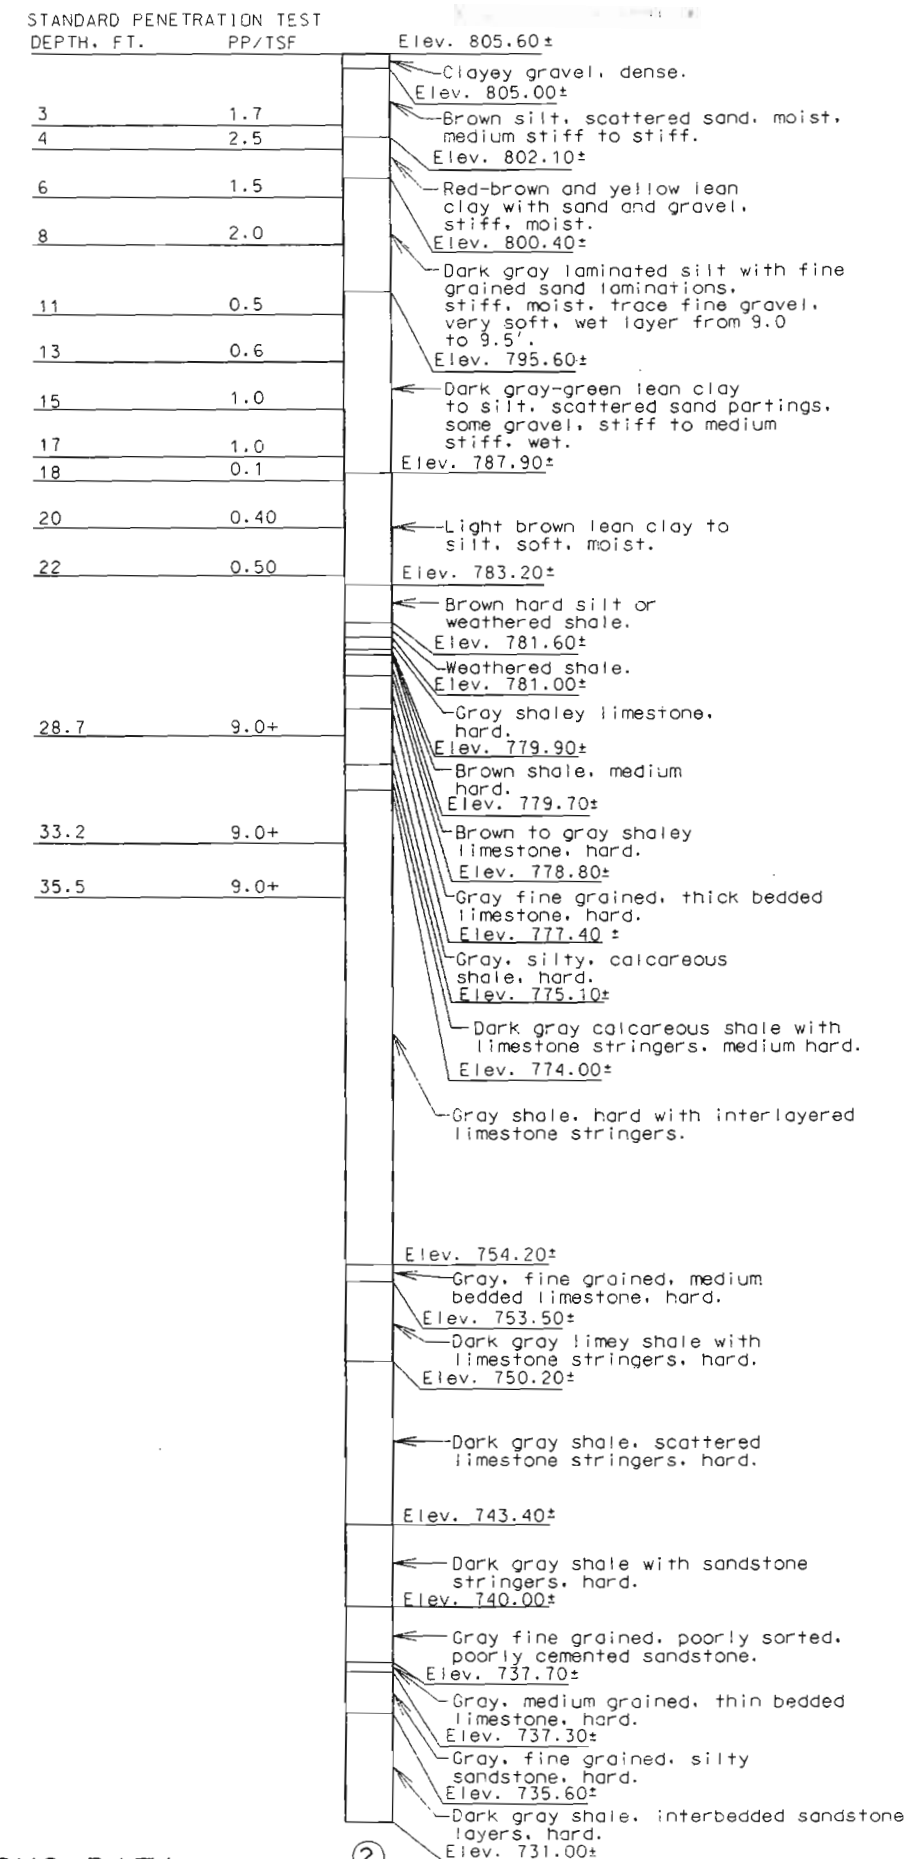


②
CORE

Note: This drawing is not to scale. Follow dimensions.

BORING DATA





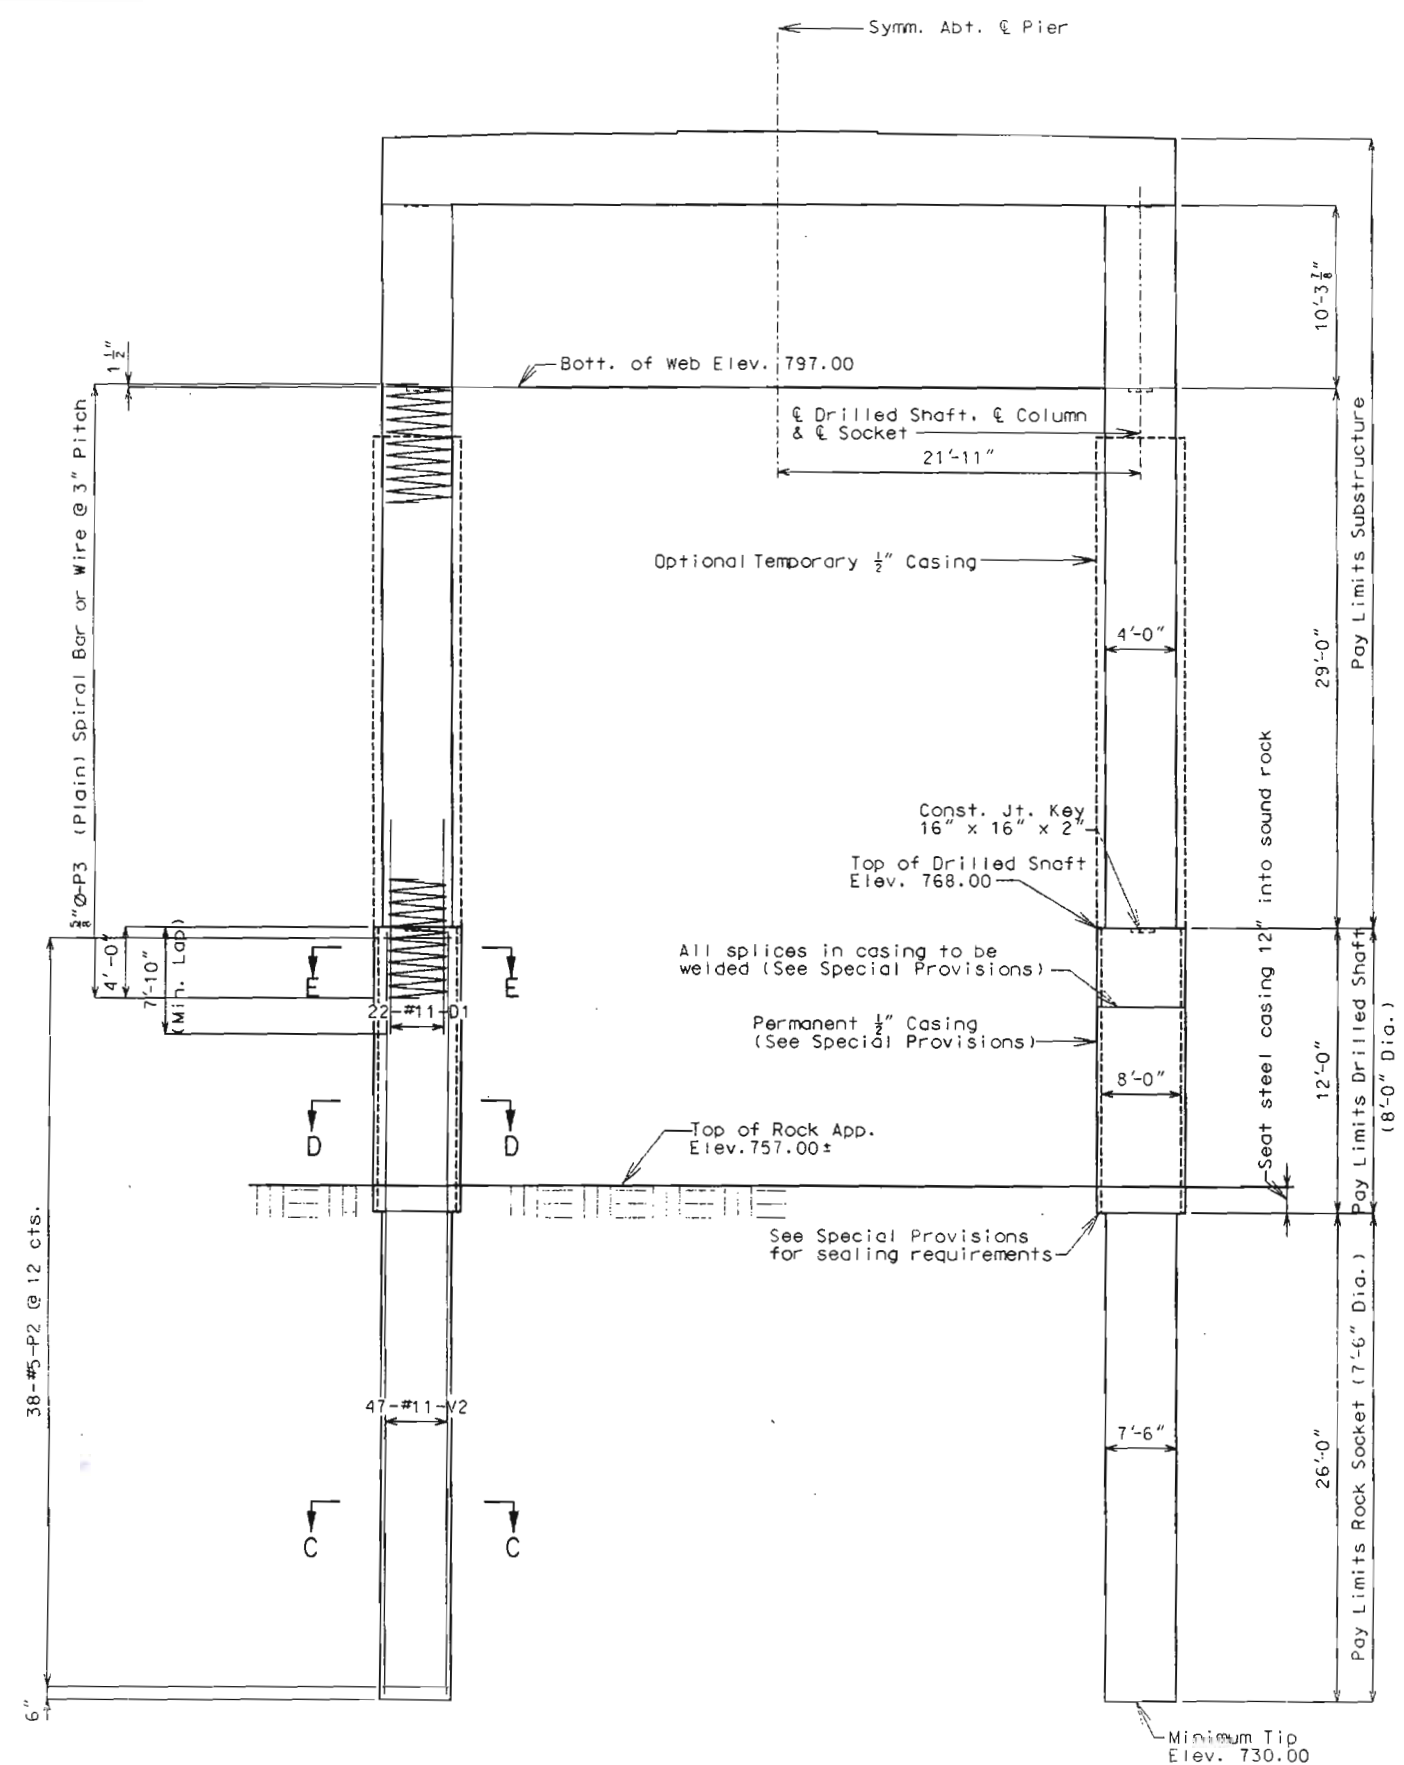

ELEVATION OF DRILLED SHAFTS & ROCK SOCKETS

DETAILS OF PIER NO. 11

Note: This drawing is not to scale. Follow dimensions.

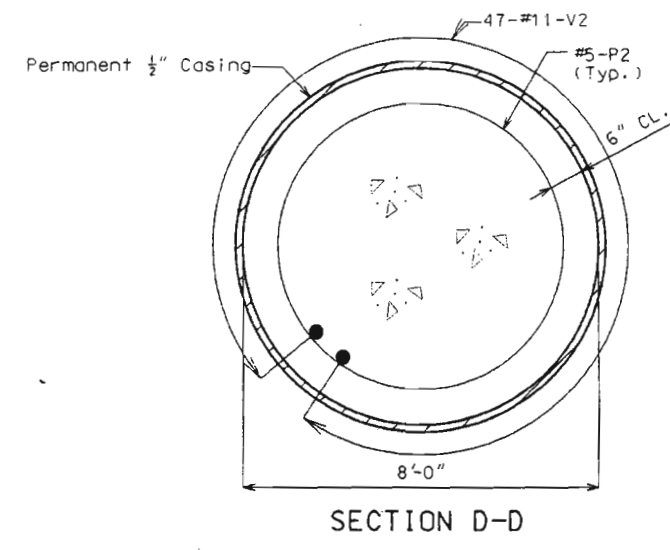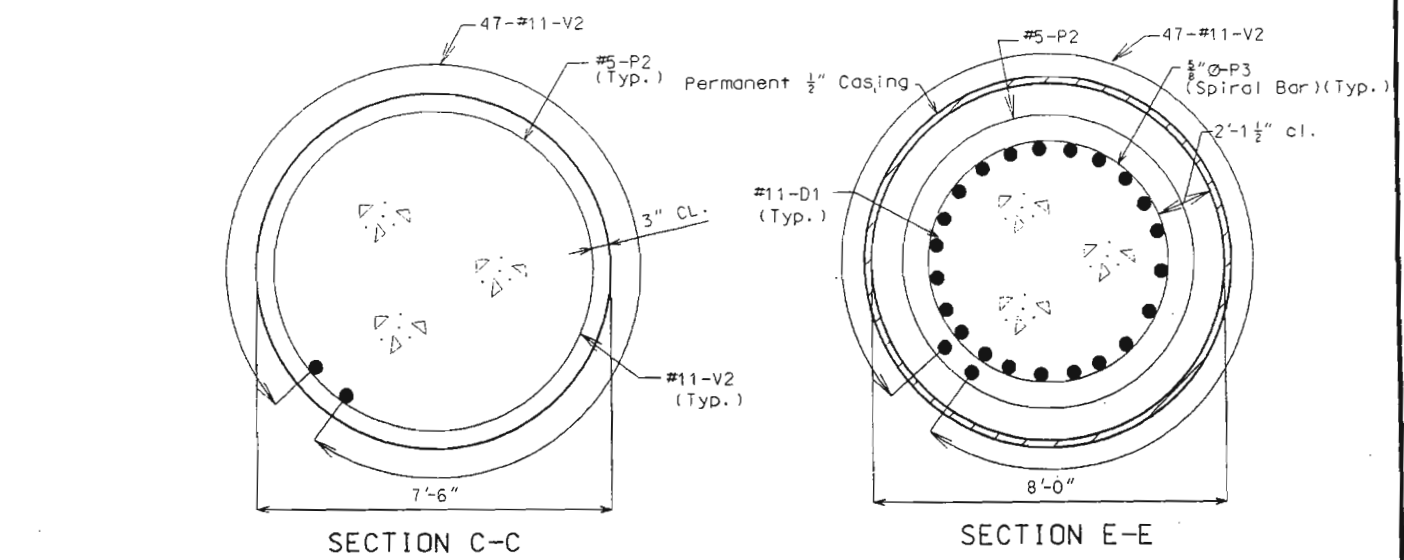

NOTE:

The contract unit price for "Drilled Shafts (8'-0" Dia.)" shall be full compensation for construction of the drilled shafts within the pay limits shown here and sheet No. 2. The contract price does not include reinforcing steel.


The contract unit price for "Rock Sockets (7'-6" Dia.)" shall be full compensation for construction of the rock sockets within the pay limits shown here and sheet No. 2. The contract price does not include reinforcing steel.

ESTIMATED QUANTITIES FOR DRILLED SHAFTS & ROCK SOCKETS	
ITEM	QUANTITY
Reinforcing Steel	pound 26,380

Note: All reinforcement in drilled shafts and rock sockets are included in Substructure Quantities.




Detailed Feb. 1999
Checked Feb. 1999

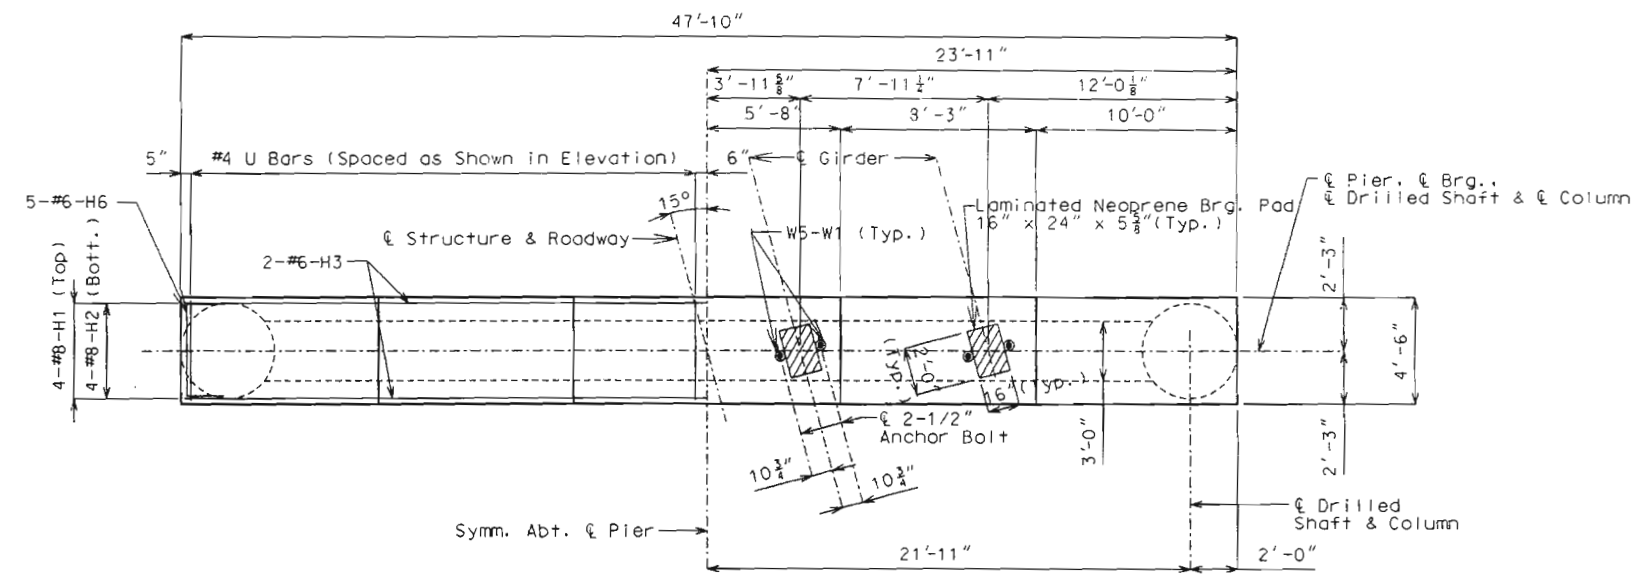


PLAN

NOTE: Column and web reinforcement not shown for clarity. See sheet No. 4. For details of $\frac{3}{8}$ " ϕ P bar in column below web. All reinforcing bars in the tops of substructure beams or caps shall be spaced to clear anchor bolt wells for bearings by at least $\frac{1}{2}$ ".

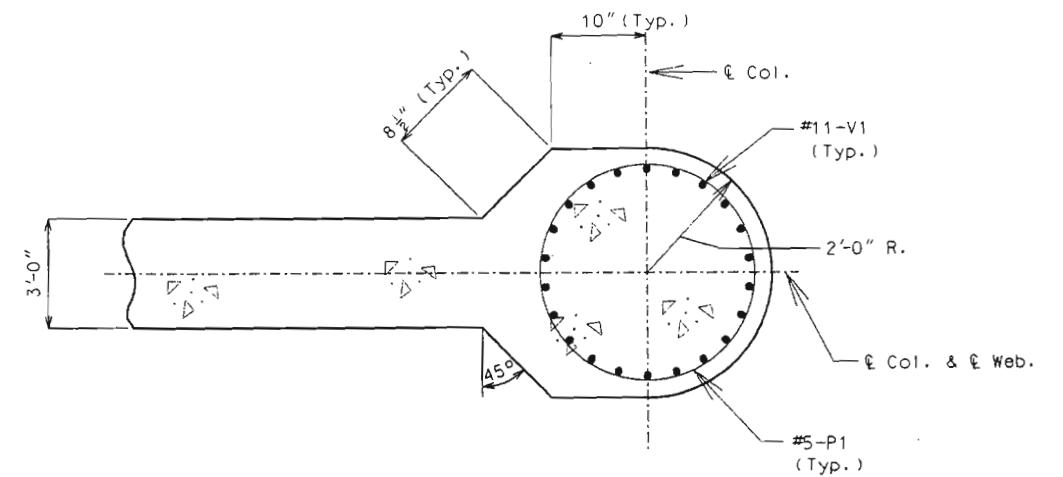


SECTION B-B

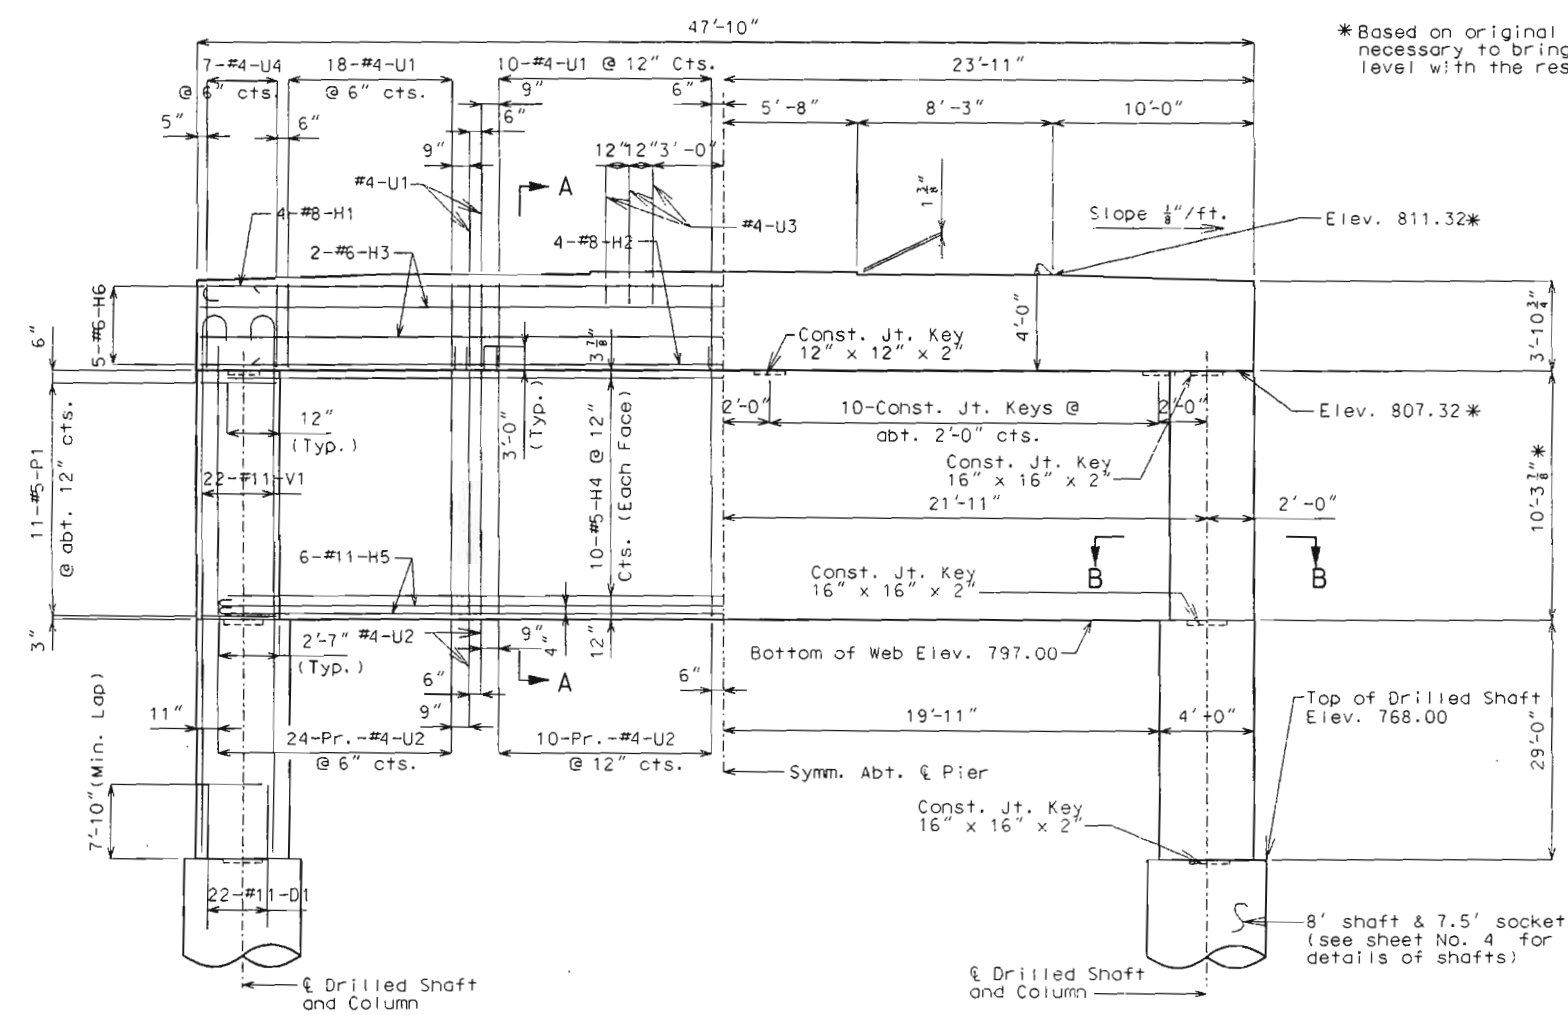

ELEVATION

*Based on original plans. Measure in field and adjust as necessary to bring top of bridge deck above pier no. 11 level with the rest of the bridge.

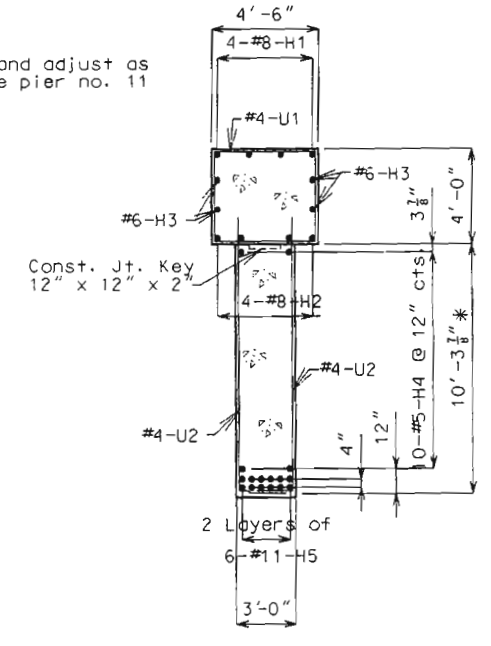

SECTION A-A

ITEM	QUANTITY
Supplementary Foundation Test Holes (NX)	Lin. Ft. 20
Supplementary Cored Holes	Lin. Ft. 38
Drilled Shafts (8'-0" Dia.)	Lin. Ft. 24
Rock Sockets (7'-6" Dia.)	Lin. Ft. 52
Supplementary Television Inspection	Each 1
Class B1 Concrete (Substructure)	Cu. Yd. 114.8
Reinforcing Steel (Bridges)	pound 48,040

Note: These quantities are included in the estimated quantities table on sheet No. 2.





Detailed Feb. 1999
Checked Feb. 1999






Note: This drawing is not to scale. Follow dimensions.

DETAILS OF PIER NO. 11

Sheet No. 5 of 8

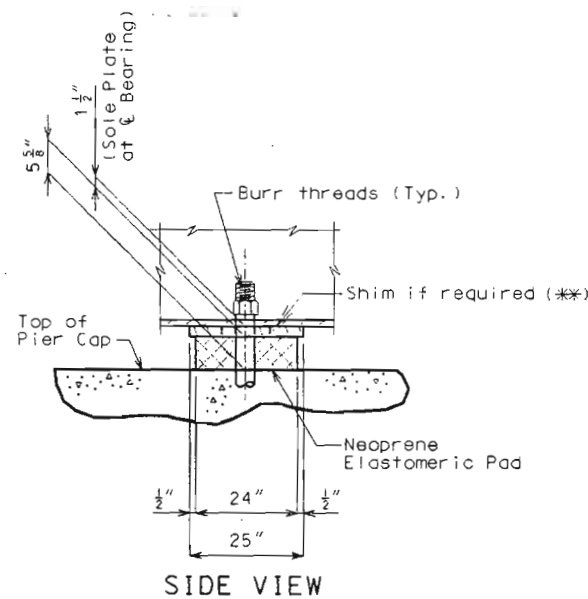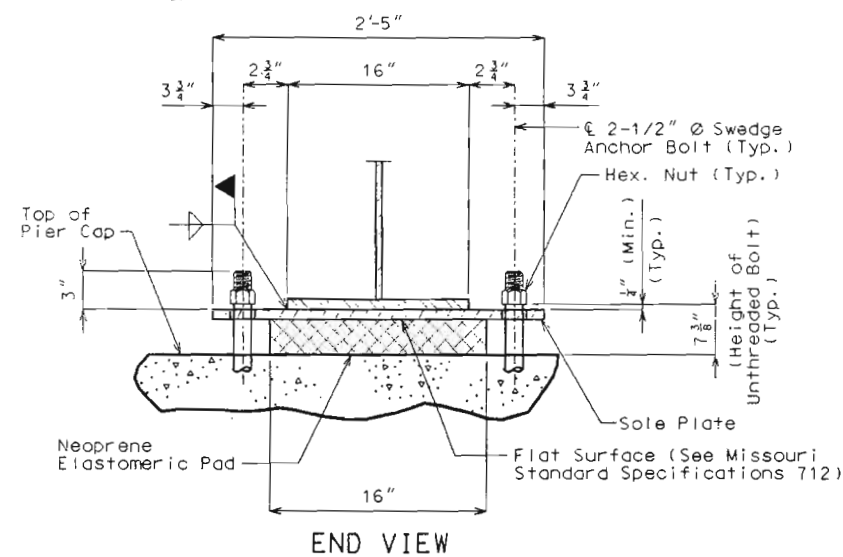


(**) Shims shall be used if the bottom flange of the existing girders are not level with the top of the pier cap. They shall not be used to compensate for erroneous top of pier cap elevation.

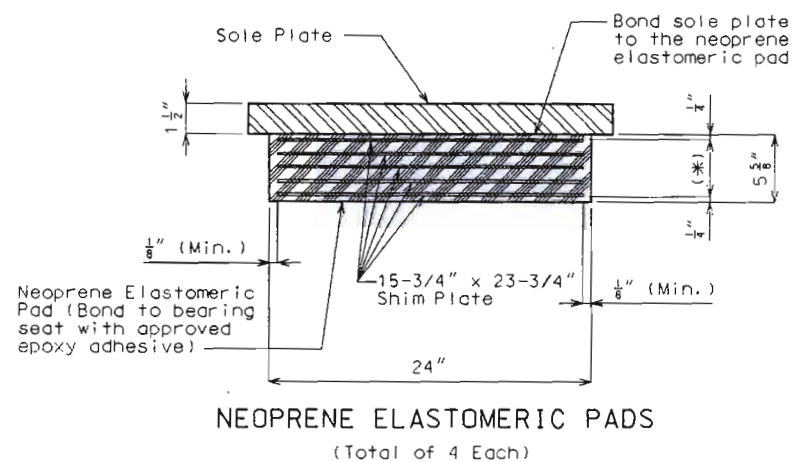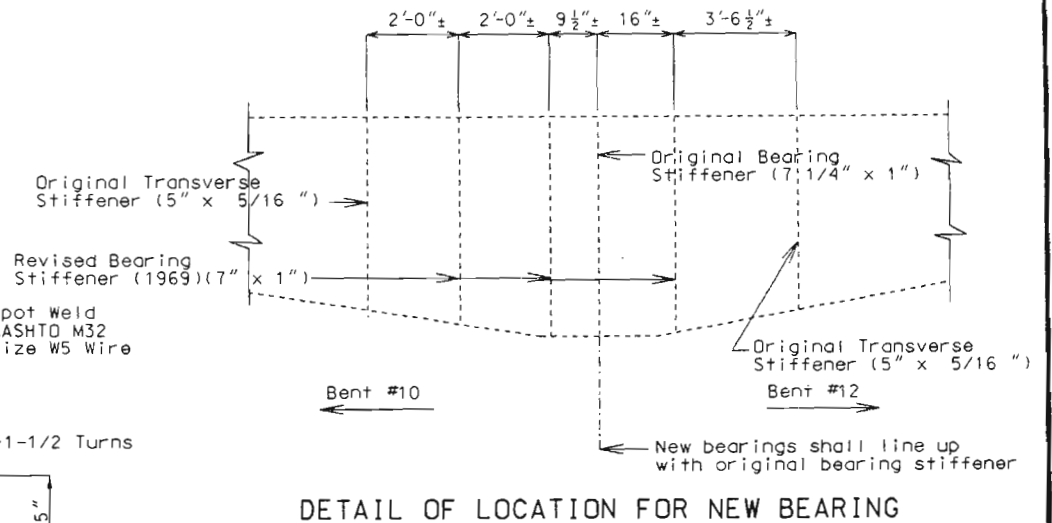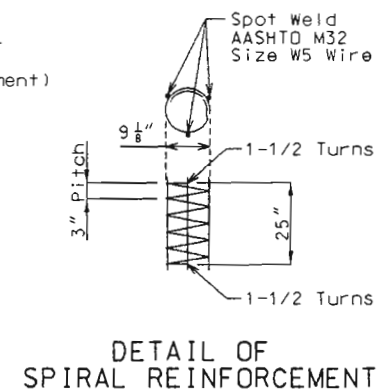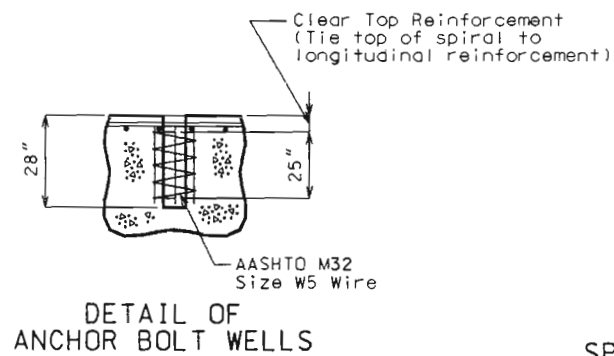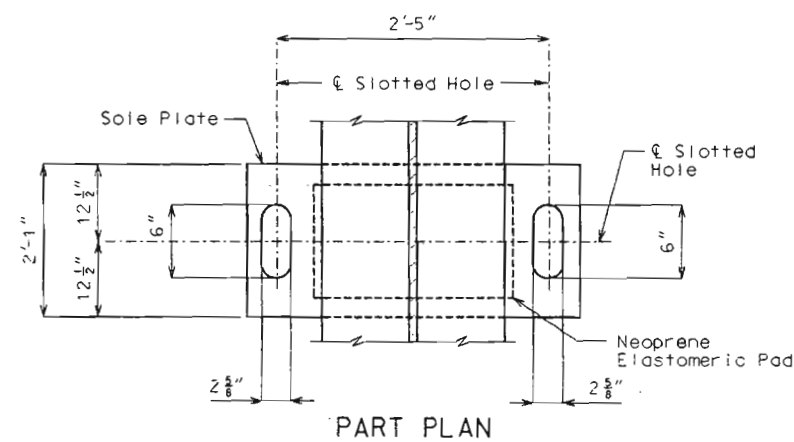


NEOPRENE ELASTOMERIC PADS
(Total of 4 Each)

(*) Layers of 1/2" elastomer alternating with 11 gage or 5/8" shim plate.

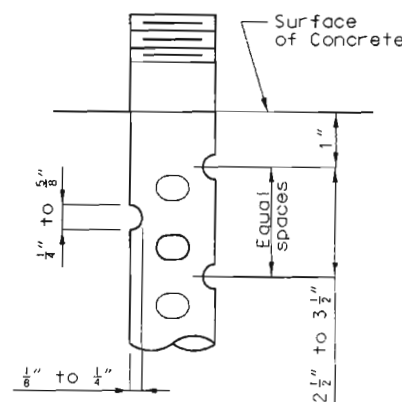

DETAIL FOR 3/4" Ø THRU
2-1/2" Ø ANCHOR BOLTS

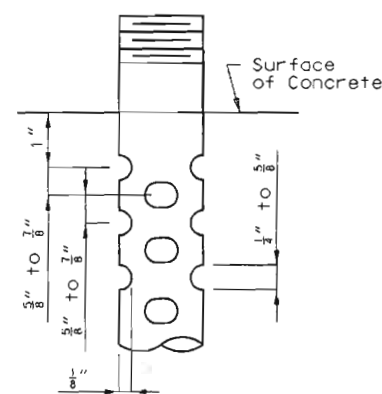

OPTIONAL DETAIL FOR 1-3/8" Ø
THRU 2-1/2" Ø ANCHOR BOLTS

SWEDGE ANCHOR BOLT DETAILS

GENERAL NOTES:

Anchor bolts shall be 2-1/2" diameter ASTM A709 Grade 50W steel swaged bolts and shall extend 25" into the concrete with ASTM A194-2, 2H or ASTM A563-C, C3, D, DH, DH3 heavy hexagon nuts. Actual manufacturer's certified mill test reports (chemical and mechanical) shall be provided. Swedging shall be 1" less than the extension into the concrete.

All structural steel for the anchor bolts and heavy hexagon nuts shall be coated with a minimum of two coats of inorganic zinc primer (5 mils minimum) or galvanized in accordance with ASTM A153.

Neoprene Elastomeric Pads shall be 60 Durometer. The neoprene pad shall be bonded to the bearing seat with an epoxy adhesive as approved by the bearing manufacturer for bonding neoprene to concrete.

The sole plate (and any required shims) shall be furnished with the bearing and field welded to the girders.

Structural steel for the sole plate (and any required shims) shall be ASTM A709 Grade 36 and shall be coated with a minimum of 2 coats of inorganic zinc primer (5 mils minimum).

The accepted quantity of the elastomeric bearing assemblies, complete-in-place, will be paid for at the contract unit price for Laminated Neoprene Bearing Pads (Steel Structures), each.

Payment for the sole plate, shim plates (if any), anchor bolts and heavy hexagon nuts shall be included in the cost of the bearing assembly. See Special Provisions.



DETAILS OF LAMINATED NEOPRENE BEARINGS (STEEL STRUCTURES)



BILL OF REINFORCING STEEL

BILL OF REINFORCING STEEL


NO. REQ'D.	MARK NO.	LOCATION	EPOXY (E)	SHAPE NO.	STIRRUP (S)	SUBSTR. (X)	VARIES (Y)	DIMENSIONS							NOMINAL LENGTH	ACTUAL LENGTH	WEIGHT			
								B	C	D	E	F	H	K						
SIZE	MARK							FT.	IN.	FT.	IN.	FT.	IN.	FT.	IN.	FT.	IN.	FT.	IN.	LBS.
		PIER NO. 11																		
4	8 H1	BEAM		18	X			47	7.000					49	5	49	5			528
4	8 H2	BEAM		20	X			47	7.000					47	7	47	7			508
4	6 H3	BEAM		20	X			47	7.000					47	7	47	7			286
20	5 H4	WEB		20	X			41	10.000					41	10	41	10			873
12	11 H5	WEB		18	X			45	0.000					48	2	48	2			3071
10	6 H6	BEAM		10	S	X				22.000	4	2.000		7	10	7	6			113
22	5 P1	COLUMN		16	X			3	9.000					12	10	12	10			294
2	5 P3	COLUMN		35	X			3	9.000	3.000	33	1.500		1574	6	1574	6			3284
60	4 U1	BEAM		13	S	X		4	3.000	3	7.750	4	3.000	3	7.750					655
144	4 U2	WEB		19	S	X		13	2.500	2	9.000			16	0	15	11			1531
6	4 U3	BEAM		10	S	X				6.000	4	3.000		5	3	5	1			20
14	4 U4	BEAM		10	S	X				3	7.750	4	3.000		11	7	11	5		107
44	11 V1	COLUMN		17	X			42	8.000					44	3	44	3			10344
8	W5 W1	A.B. WELLS		22	X			2	1.000	9.125				33	2	33	2			44
		DRILL SHAFTS																		
44	11 D1	COLUMN		20	X			15	8.000					15	8	15	8			3662
76	5 P2	COLUMN		16	X			7	0.000					23	1	23	1			1830
94	11 V2	COLUMN		20	X			41	10.000					41	10	41	10			20892

NO. REQ'D.	MARK NO.	LOCATION	EPOXY (E)	SHAPE NO.	STIRRUP (S)	SUBSTR. (X)	VARIES (Y)	DIMENSIONS							NOMINAL LENGTH	ACTUAL LENGTH	WEIGHT			
								B	C	D	E	F	H	K						
SIZE	MARK							FT.	IN.	FT.	IN.	FT.	IN.	FT.	IN.	FT.	IN.	FT.	IN.	LBS.

State	Proj. No.	Sheet No.
MO		137

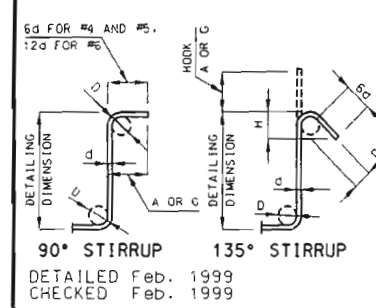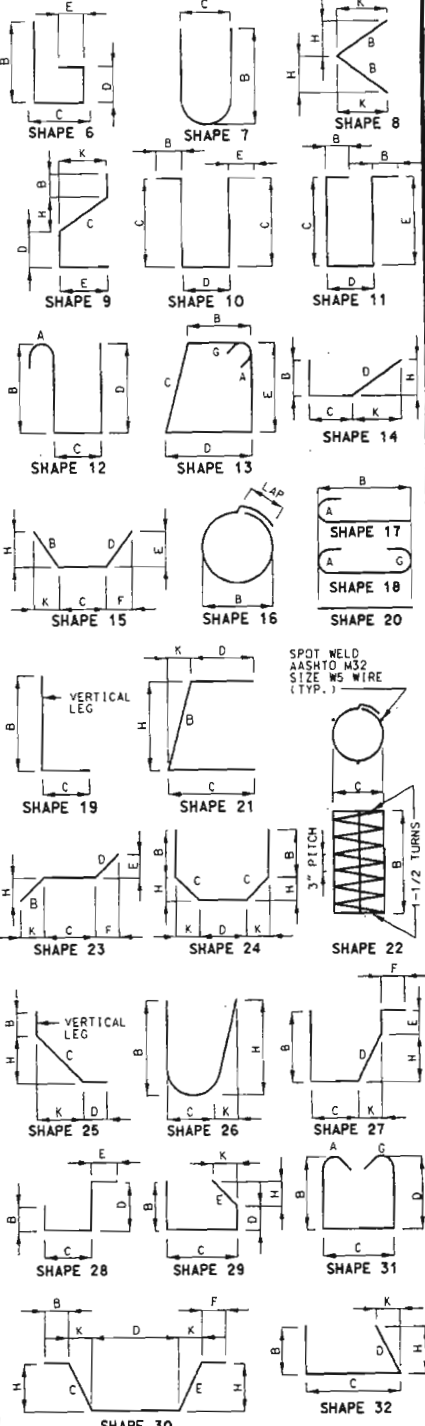


BAR SIZE	D (IN.)	90° HOOK		135° HOOK	
		A OR G	H	A OR G	APPROX. H
#4	2"	4-1/2"	4-1/2"	4-1/2"	3"
#5	2-1/2"	6"	5-1/2"	3-3/4"	
#6	4-1/2"	12"	8"	4-1/2"	

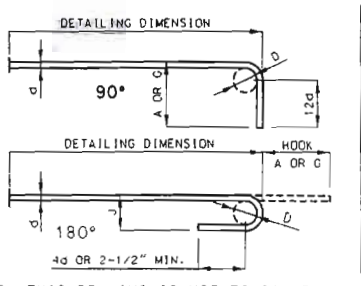

BAR SIZE	D (IN.)	180° HOOKS		90° HOOKS	
		A OR G	J	A OR G	
#3	2-1/4"	5"	3"	6"	
#4	3"	6"	4"	8"	
#5	3-3/4"	7"	5"	10"	
#6	4-1/2"	8"	6"	12"	
#7	5-1/4"	10"	7"	14"	
#8	6"	11"	8"	16"	
#9	9-1/2"	15"	11-3/4"	19"	
#10	10-3/4"	17"	13-1/4"	22"	
#11	12"	19"	14-3/4"	2'-0"	
#14	18-1/4"	2'-3"	21-3/4"	2'-7"	


NOTE:
 ALL STANDARD HOOKS AND BENDS OTHER THAN 180 DEG. TO BE BENT WITH THE SAME PROCEDURE AS FOR 90 DEG. STD. HOOKS.
 HOOKS AND BENDS SHALL BE IN ACCORDANCE WITH THE PROCEDURES AS SHOWN ON THIS SHEET.
 E = EPOXY COATED REINFORCEMENT.
 S = STIRRUP.
 X = BAR IS INCLUDED IN SUBSTRUCTURE QUANTITIES.
 V = BAR DIMENSIONS VARY IN EQUAL INCREMENTS BETWEEN DIMENSIONS SHOWN ON THIS LINE AND THE FOLLOWING LINE.
 NO. EA. = NUMBER OF BARS OF EACH LENGTH.
 NOMINAL LENGTHS ARE BASED ON OUT TO OUT DIMENSIONS SHOWN IN BENDING DIAGRAMS AND ARE LISTED FOR FABRICATOR'S USE (NEAREST INCH).
 ACTUAL LENGTHS ARE MEASURED ALONG CENTERLINE BAR TO THE NEAREST INCH.
 PAYWEIGHTS ARE BASED ON ACTUAL LENGTHS.
 FOUR ANGLE OR CHANNEL SPACERS ARE REQUIRED FOR EACH COLUMN SPIRAL. SPACERS ARE TO BE PLACED ON INSIDE OF SPIRALS. LENGTH AND WEIGHT OF COLUMN SPIRALS DO NOT INCLUDE SPLICES OR SPACERS.
 REINFORCING STEEL (GRADE 60) = 76.000 (PSI).

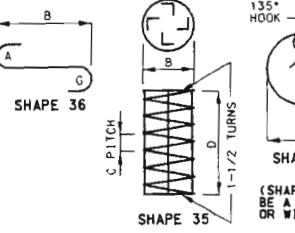

BENDING DIAGRAMS

STATE OF MISSOURI
 DENNIS W. HECKMAN
 LICENSED PROFESSIONAL ENGINEER
 NUMBER E-27141
 3/10/99
 Dennis W. Heckman

"AS BUILT DRILLED SHAFT" DATA			
"PIER NO. 11 (DRILLED SHAFT)"			
SHAFT NO.	BOTTOM OF DRILLED SHAFT (ELEV.)	BOTTOM OF ROCK SOCKET (ELEV.)	REMARKS
1			
2			

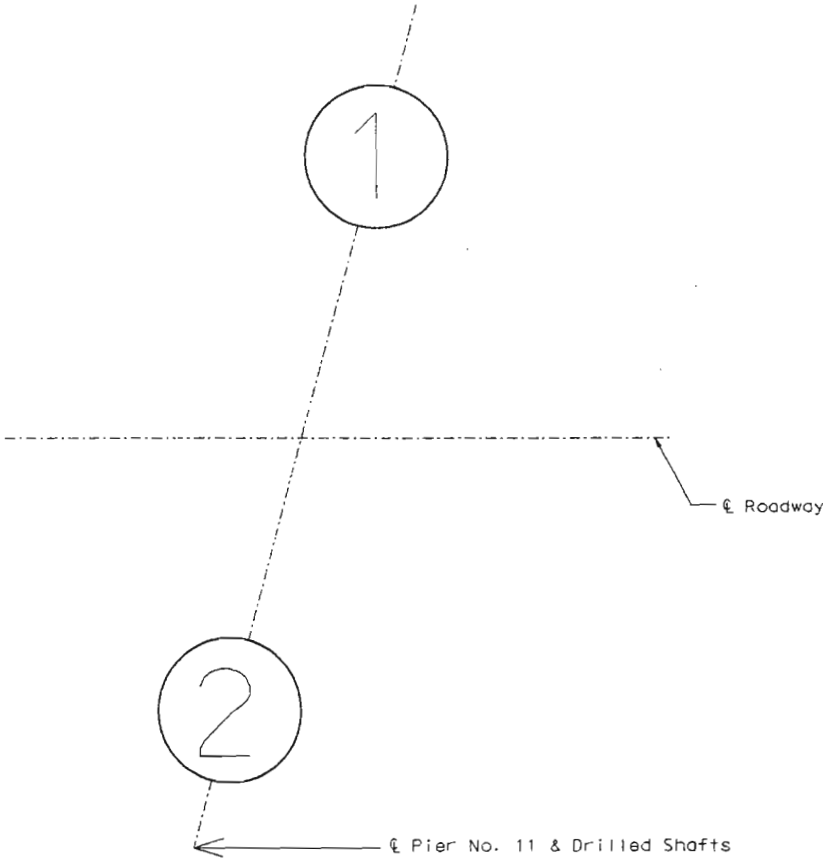

Detailed Feb. 1999
Checked Feb. 1999

Note: This drawing is not to scale. Follow dimensions.

Sheet No. 8 of 8

PLATTE COUNTY S00253




MISSOURI HIGHWAY AND TRANSPORTATION COMMISSION

State	Proj. No.	Sheet No.
MO	J451368	81
SEC/SUR 1	TWP 54N RGE 34W	
Contract ID - MO423-403		


FINAL PLAN
 I CERTIFY THAT THIS DRAWING ACCURATELY REFLECTS THE CONFIGURATION AND LOCATION OF THE ROADWAY AND APPURTENANCES AS CONSTRUCTED ON THIS PROJECT.

SIGNATURE
 DATE

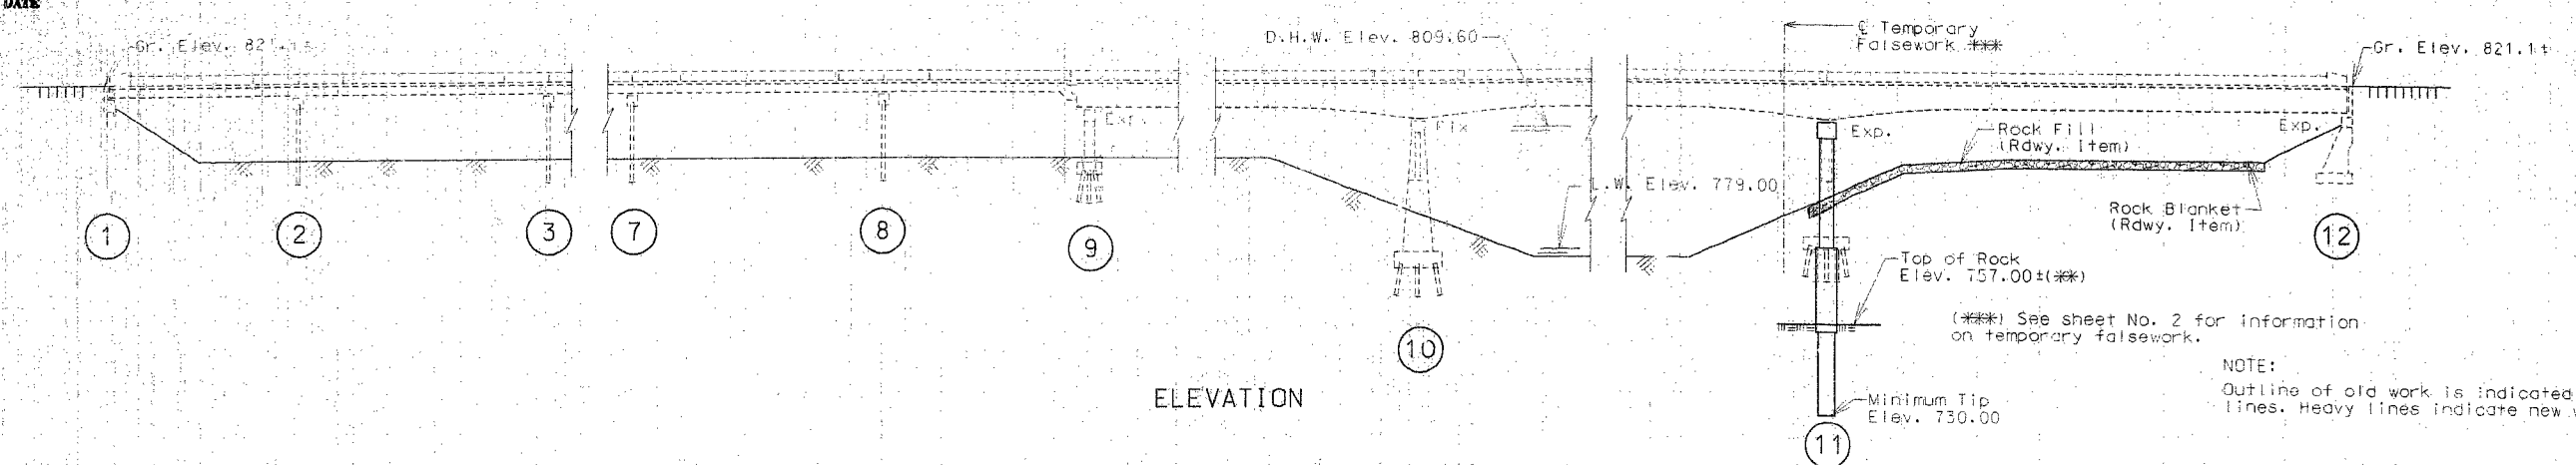

NOTE:
 Outline of old work is indicated by dashed lines. Heavy lines indicate new work.

(**) Top of rock elevation is an assumed elevation based on boring data.

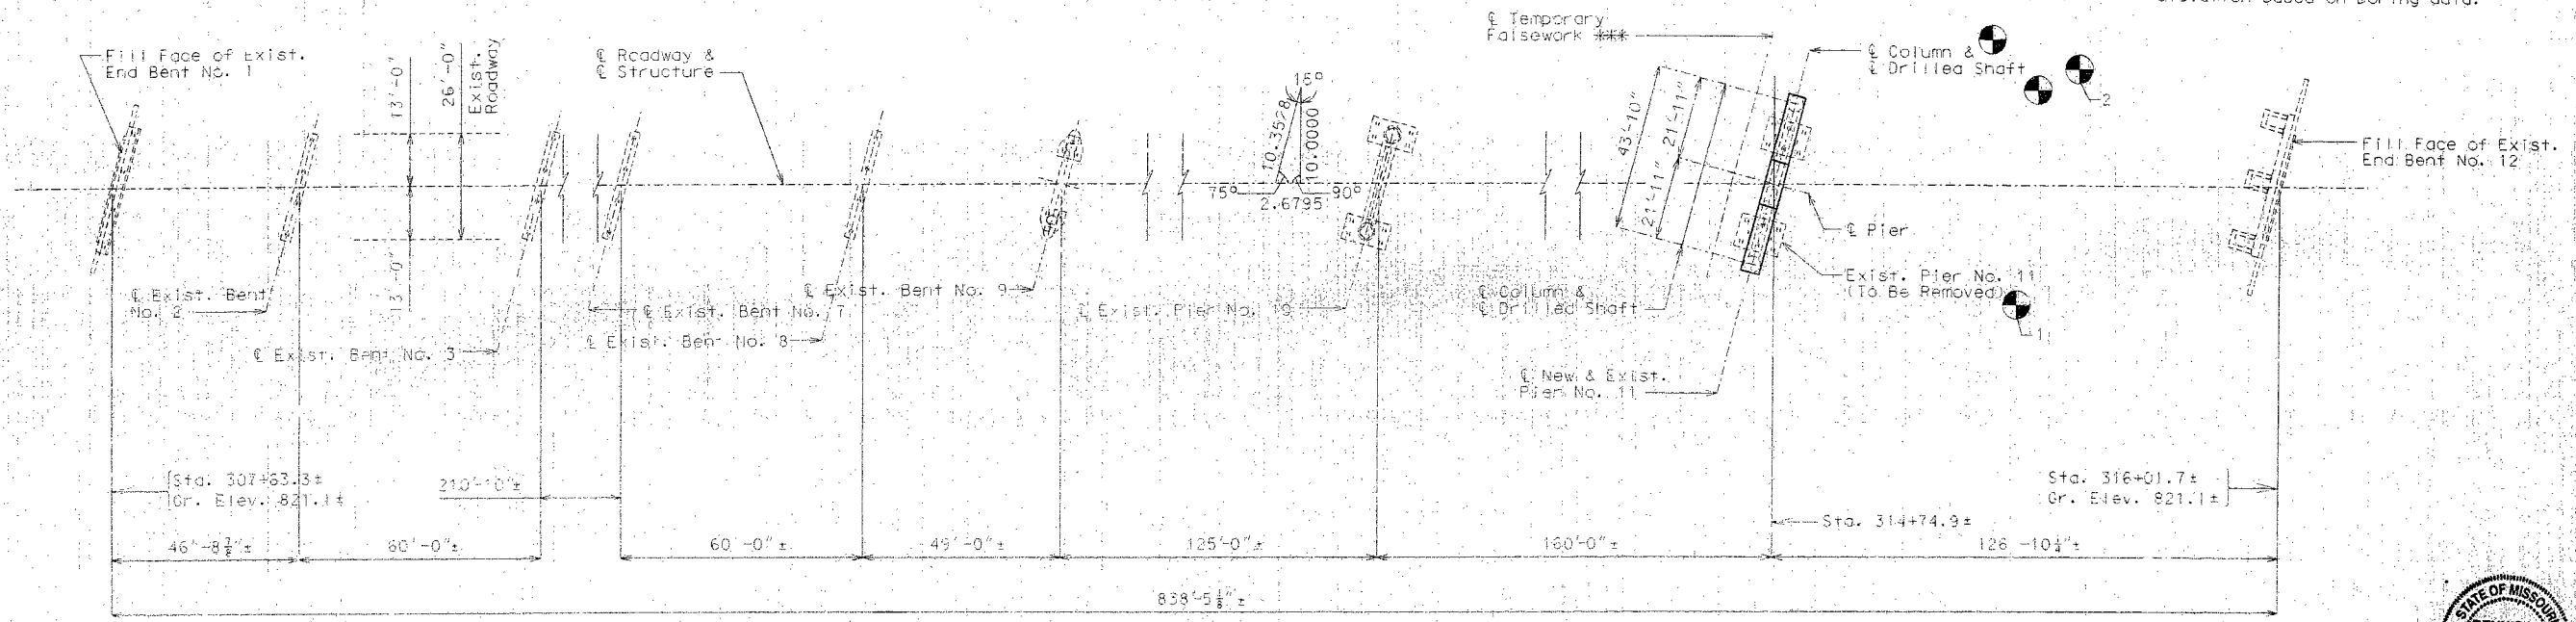

Indicates location of borings.

Notice and Disclaimer Regarding Boring Log Data

The locations of all recent subsurface borings for this structure are shown on the bridge plan sheet for this structure.
 Boring data for the numbered locations is shown on sheet no. 3.
 The boring data for all locations indicated, as well as any other boring logs or other factual records of subsurface data and investigations performed by the department for the design of this project, is available from the Project Contract upon written request as outlined in the project special provisions.

No greater significance or weight should be given to the boring data depicted on the plan sheets than is subsurface data available from the district or elsewhere.
 The Commission does not represent or warrant that any such boring data accurately depicts the conditions to be encountered in constructing this project.
 A contractor assumes all risks in relying upon any boring data, time or schedule of performance on the boring data depicted here or those available from the district or on any other documentation not expressly warranted, which the contractor may obtain from the Commission.

Note: This drawing is not to scale. For all dimensions. Sheet No. 1 of 8

Designed Jan. 1993
 Detail Feb. 1993
 Checked Feb. 1993

STATE OF MISSOURI
 REGISTERED PROFESSIONAL ENGINEER
DENNIS W. HECKMAN
 NUMBER E-2714
 2/1/99

B.M. Elev. 821.72 ± on S.W. Cor. Wing Wall
 Sta. 316+01.73

REPAIRS TO BRIDGE OVER PLATTE RIVER

STATE ROAD FROM RTE. F SOUTH-EAST TO EDGERTON
 ABOUT 7 MILES EAST OF DEARBORN
 PROJECT NO. STA. 307+63.3±
 JOB NO. J451368 RTE. Z

PLATTE COUNTY
 Date: 3/10/99
 STD. 706.35
S00253

FINAL QUANTITIES			
ITEM		SUBSTR.	SUPERSTR. TOTAL
Removal of Existing Pier no. 11	Lump Sum		1 ✓
Temporary Falsework	Lump Sum		1 ✓
Supplementary Foundation Test Holes (NX)	Lin. Ft.	20	20 ✓
Supplementary Cored Holes	Lin. Ft.	38	38 ✓
Drilled Shafts (8'-0" Dia.)	Lin. Ft.	24	24 ✓
Rock Sockets (7'-6" Dia.)	Lin. Ft.	52	52 ✓
Supplementary Television Inspection	Each	1	1 ✓
Class B1 Concrete (Substructure)	Cu. Yds.	114.8	114.8 ✓
Laminated Neoprene Bearing Pads (Steel Structures)	Each		4 ✓
Reinforcing Steel (Bridges)	Pound	48,040	48,040 ✓
CONTINGENT: CLASS B-2 Concrete for drilled shafts	Cu. Yds.	129.8	129.8

NOTE: The cost of furnishing, fabricating and installing Neoprene Bearing Pads, complete in-place, will be paid for at the contract unit price for Laminated Neoprene Bearing Pads (Steel Structures), per each.

GENERAL NOTES:

DESIGN SPECIFICATIONS:

AASHTO-1996 and Item 11 in 1997 Load Factor Design.

Seismic Performance Category A

DESIGN LOADINGS:

H15-44

Fatigue Case II

15#/Sq. Ft. Future Wearing Surface

REINFORCING STEEL:

Minimum clearance to the reinforcing steel shall be 1-1/2", unless otherwise shown.

All reinforcing bars in top of substructure beam or cap shall be spaced to clear anchor bolt wells for bearings by at least 1/2".

MISC:

Contractor shall verify all dimensions in field before ordering materials.

Bridge will be closed to traffic during construction. No construction live load shall be allowed on bridge.



DESIGN UNIT STRESSES:

Class B1 Concrete (Substructure) $f'c = 4,000$ psi.

Reinforcing Steel (Grade 60) $f_y = 60,000$ psi.

Bearings shall be 60 Durometer Neoprene Pads.

The neoprene pad shall be bonded to the bearing seat with an epoxy adhesive as approved by the bearing manufacturer for bonding neoprene to concrete.

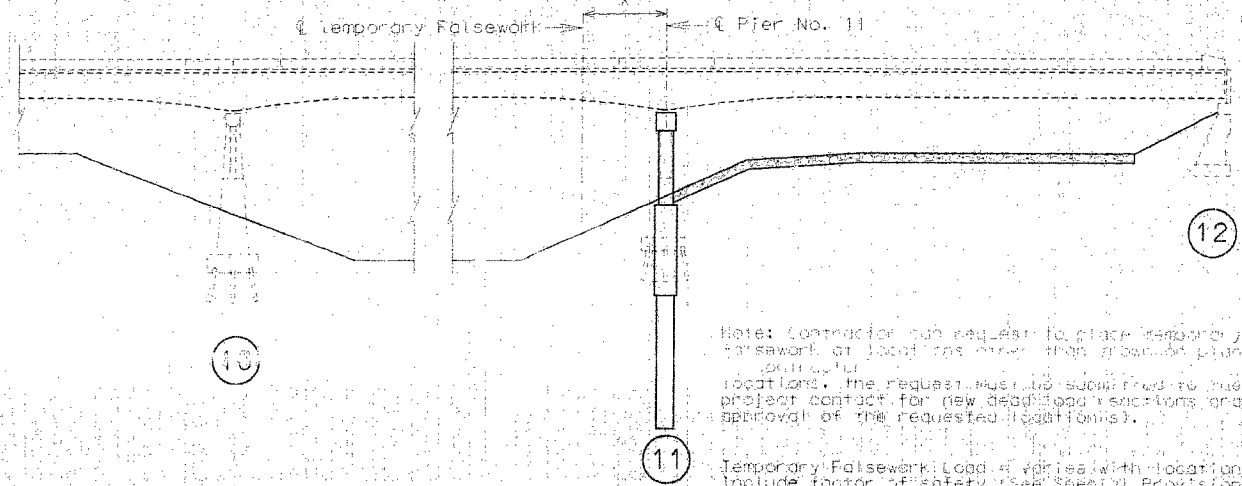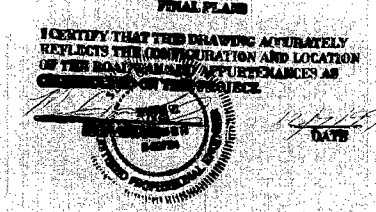

Note: Contractor can request to place temporary falsework at locations other than standard plans. Locations. The request must be shown from the project contract for new dead load reactions and approval of the requested locations.

Temporary Falsework Load w varies with location (see table) and does not include factor of safety (see Special Provisions).

Use 4x4 Temporary Timber Bracing as bearing stiffeners for falsework and backing points. Place on each side of existing web or brg. stiffener as required by design.

Dim. "X"	INT. GDR. DEAD LOAD REACTION (TONS) PER GDR.	EXT. GDR. DEAD LOAD REACTION (TONS) PER GDR.
10'-0"	85 tons	71 tons
15'-0"	86 tons	75 tons


DRILLED SHAFT DATA		
PIER NO. 11	Left(1)	Right(2)
Foundation Material	Shale	Shale
Approximate length (Ft.)	38	38
Design Side Friction (Tons/3q. Ft.)	0.57	0.57

PAY LIMITS FOR EACH SHAFT AND SOCKET	
Drilled Shaft	Rock Socket
12'-0"	26'-0"

DRILLED SHAFT NOTES:

The top of sound rock is assumed at the elevation determined from the logs. The pay length is based on this assumed top of rock elevation.

Prior to placing drilled shaft casing the contractor shall be required to drill an NX size core hole at each shaft for additional subsurface investigation. The holes shall be located by the Engineer and shall extend at least 10 ft. below the bottom of socket elevation. (See Special Provisions).

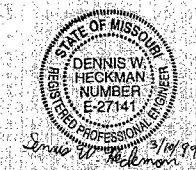

Derived Feb. 1999
Checked Feb. 1999

Note: This drawing is not to scale. Follow dimensions.

Sheet No. 2 of 6

PLATTE COUNTY

S00253

24 to 1

STANDARD PENETRATION TEST DEPTH, FT.	PP/TSF	Elev. 805.60±
4	0.25	Brown lean clayey silt, medium stiff, moist. Elev. 803.10±
6	3.0	Brown lean clay, soft, moist. Elev. 799.40±
8	1.5	Gray to brown lean clay with scattered silt and root fragments. Elev. 798.20±
11	2.25	Brown lean clay, soft to medium stiff, moist. Elev. 797.70±
14	1.5	Gray lean clay, scattered roots and wood, stiff. Elev. 796.00±
16	0.75	Gray to brown lean clay, slightly mottled, stiff, scattered roots also present. Elev. 791.10±
19	1.0	Light brown lean clay, medium stiff. Elev. 789.40±
21	1.0	Light brown lean clay with scattered silty layers, stiff. Elev. 784.10±
22	3.75	Weathered brown shale, soft. Elev. 780.70±
		Brown shale, very soft. Elev. 780.30±
		Light gray, medium to coarse grained limestone, thin bedded. Elev. 778.30±
36.6	9.0+	Gray calcareous siltstone, hard. Elev. 777.90±
		Gray calcareous shaley siltstone, hard. Elev. 773.90±
		Dark gray calcareous shale, hard. Elev. 773.70±
		Gray shaley limestone, hard. Elev. 773.30±
		Gray limey shale, hard with interlayered limestone stringers. Elev. 762.30±
43.6	9.0+	Gray shale moderately hard to hard. Elev. 753.20±
		Gray fine grained, medium bedded limestone, hard. Elev. 752.00±
		Gray shale, moderately hard. Elev. 750.70±

①
CORE

Note: For location of borings see sheet No. 1.

STANDARD PENETRATION TEST DEPTH, FT.	PP/TSF	Elev. 805.60±
3	1.7	Clayey gravel, dense. Elev. 805.00±
4	2.5	Brown silt, scattered sand, moist, medium stiff to stiff. Elev. 802.10±
6	1.5	Red-brown and yellow lean clay with sand and gravel, stiff, moist. Elev. 800.40±
8	2.0	Dark gray laminated silt with fine grained sand laminations, stiff, moist, trace fine gravel, very soft, wet layer from 9.0 to 9.5. Elev. 795.60±
11	0.5	Dark gray-green lean clay to silt, scattered sand partings, some gravel, stiff to medium stiff, wet. Elev. 787.90±
13	0.6	
15	1.0	
17	1.0	
18	0.1	
20	0.40	Light brown lean clay to silt, soft, moist. Elev. 783.20±
22	0.50	
		Brown hard silt or weathered shale. Elev. 781.60±
		Weathered shale. Elev. 781.00±
28.7	9.0+	Gray shaley limestone, hard. Elev. 779.90±
		Brown shale, medium hard. Elev. 779.70±
33.2	9.0+	Brown to gray shaley limestone, hard. Elev. 778.80±
35.5	9.0+	Gray fine grained, thick bedded limestone, hard. Elev. 777.40±
		Gray silty, calcareous shale, hard. Elev. 775.10±
		Dark gray calcareous shale with limestone stringers, medium hard. Elev. 774.00±
		Gray shale, hard with interlayered limestone stringers. Elev. 754.20±
		Gray, fine grained, medium bedded limestone, hard. Elev. 753.50±
		Dark gray limey shale with limestone stringers, hard. Elev. 750.20±
		Dark gray shale, scattered limestone stringers, hard. Elev. 743.40±
		Dark gray shale with sandstone stringers, hard. Elev. 740.00±
		Gray fine grained, poorly sorted, poorly cemented sandstone. Elev. 737.70±
		Gray, medium grained, thin bedded limestone, hard. Elev. 737.30±
		Gray, fine grained, silty sandstone, hard. Elev. 735.60±
		Dark gray shale, interbedded sandstone layers, hard. Elev. 731.00±

②
CORE

BORING DATA




Sheet No. 3 of 5

I CERTIFY THAT THIS DRAWING ACCURATELY REFLECTS THE INVESTIGATION AND LOCATION OF THE BORING(S) AND APPURTENANCES AS CONDUCTED BY ME OR MY EMPLOYEE

DATE

STATE OF MISSOURI
DENNIS W. HECKMAN
REGISTERED PROFESSIONAL ENGINEER
NUMBER E-27141
7/10/16
Dennis W. Heckman

216

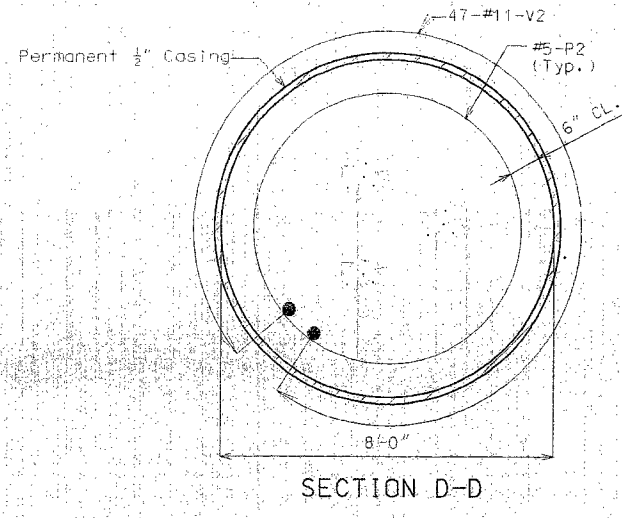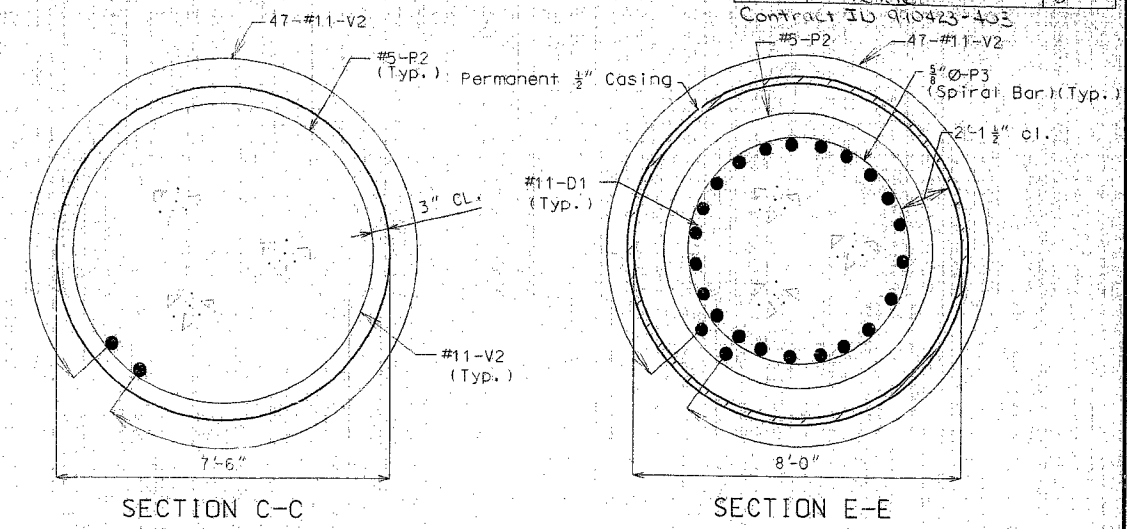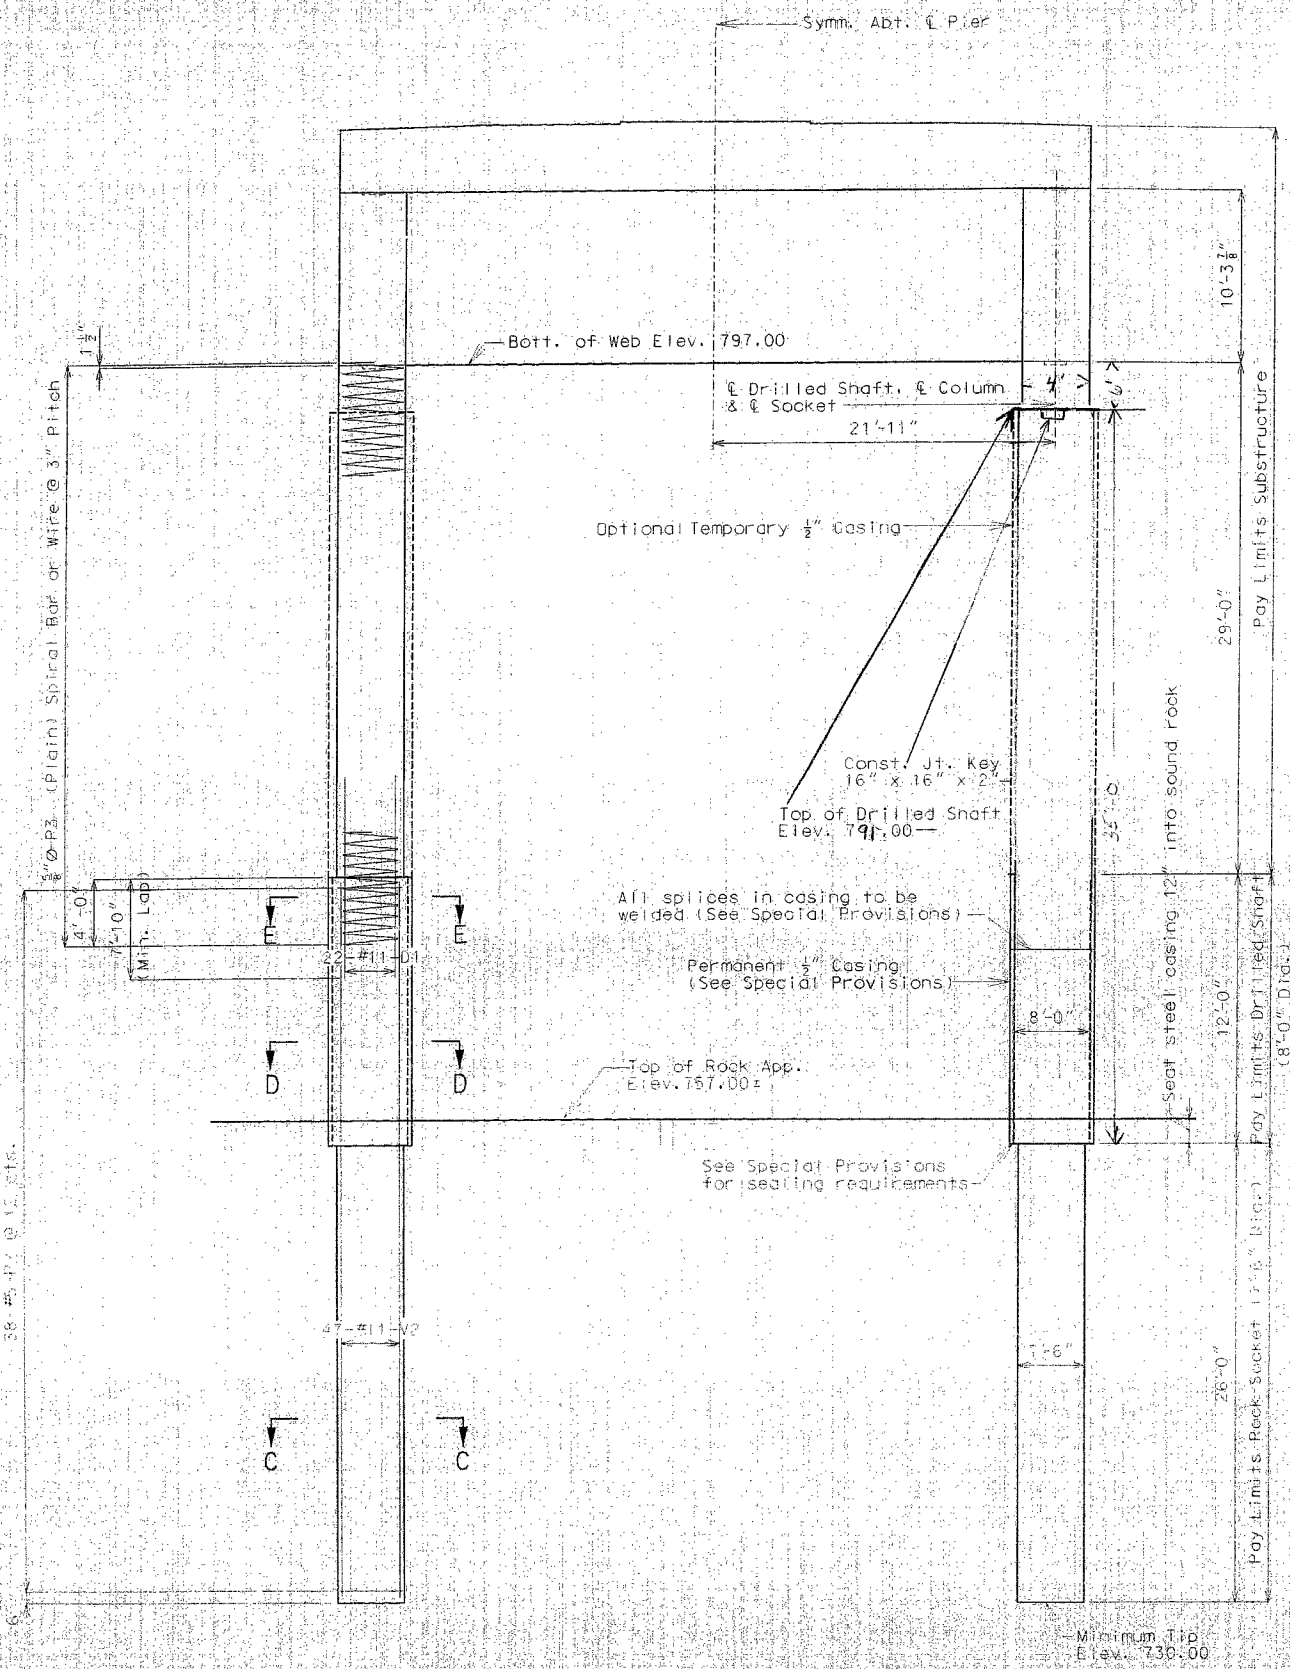

NOTE:
The contract unit price for "Drilled Shafts (8'-0" Dia.)" shall be full compensation for construction of the drilled shafts within the pay limits shown here and sheet No. 2. The contract price does not include reinforcing steel.

The contract unit price for "Rock Sockets (7'-6" Dia.)" shall be full compensation for construction of the rock sockets within the pay limits shown here and sheet No. 2. The contract price does not include reinforcing steel.

ESTIMATED QUANTITIES FOR DRILLED SHAFTS & ROCK SOCKETS		
ITEM		QUANTITY
Reinforcing Steel	pound	26,380

Note: All reinforcement in drilled shafts and rock sockets are included in Substructure Quantities.



STATE OF MISSOURI
REGISTERED PROFESSIONAL ENGINEER
DENNIS W. HECKMAN
NUMBER E-2714
3/16/99
Dennis W. Heckman

ELEVATION OF DRILLED SHAFTS & ROCK SOCKETS

DETAILS OF PIER NO. 11


Drawn Feb. 1999
Checked Feb. 1999

Note: This drawing is not to scale. Follow dimensions.

Sheet No. 4 of 8


PLATTE COUNTY S00253

257

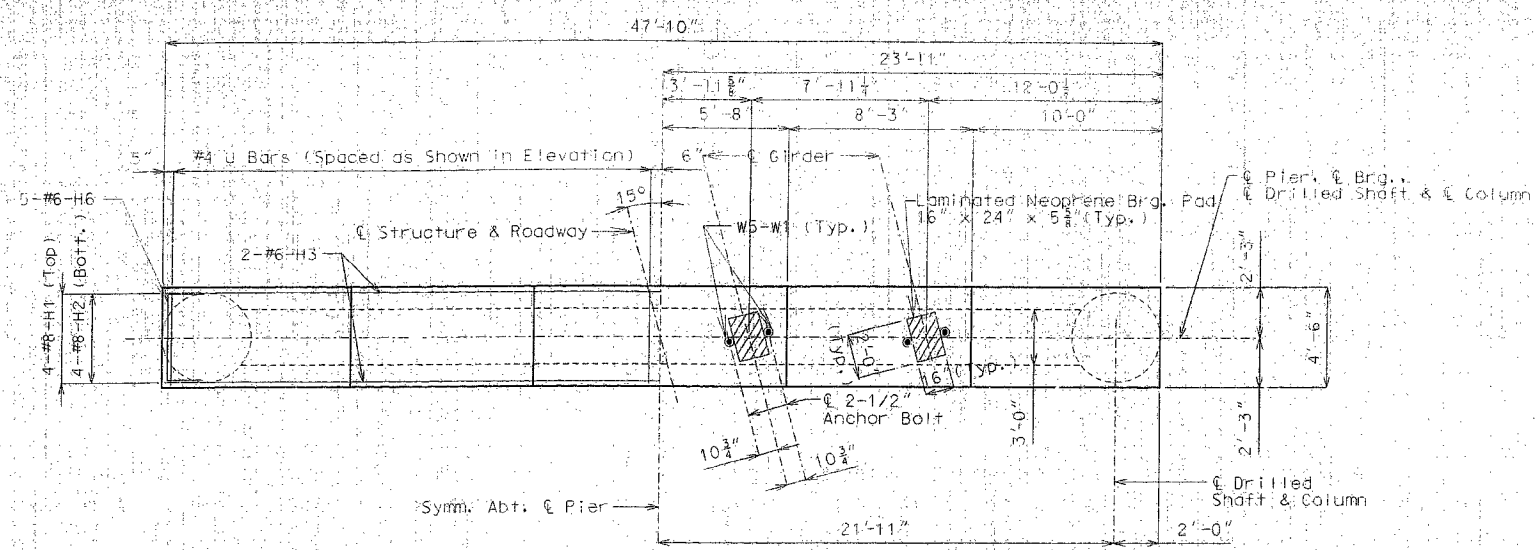


PLAN

NOTE: Column and web reinforcement not shown for clarity. See sheet No. 4. For details of $\frac{3}{8}$ " P bar in column below web. All reinforcing bars in the tops of substructure beams or caps shall be spaced to clear anchor bolt wells for bearings by at least $\frac{1}{2}$ ".

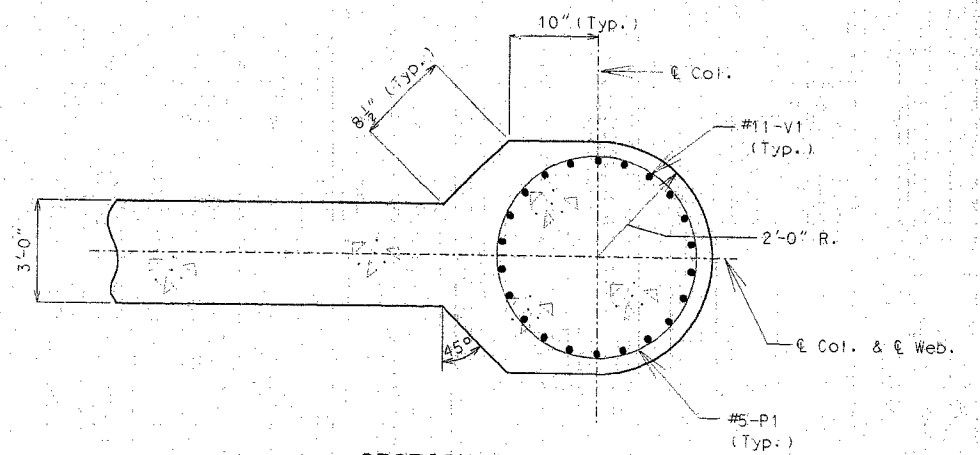


SECTION B-B

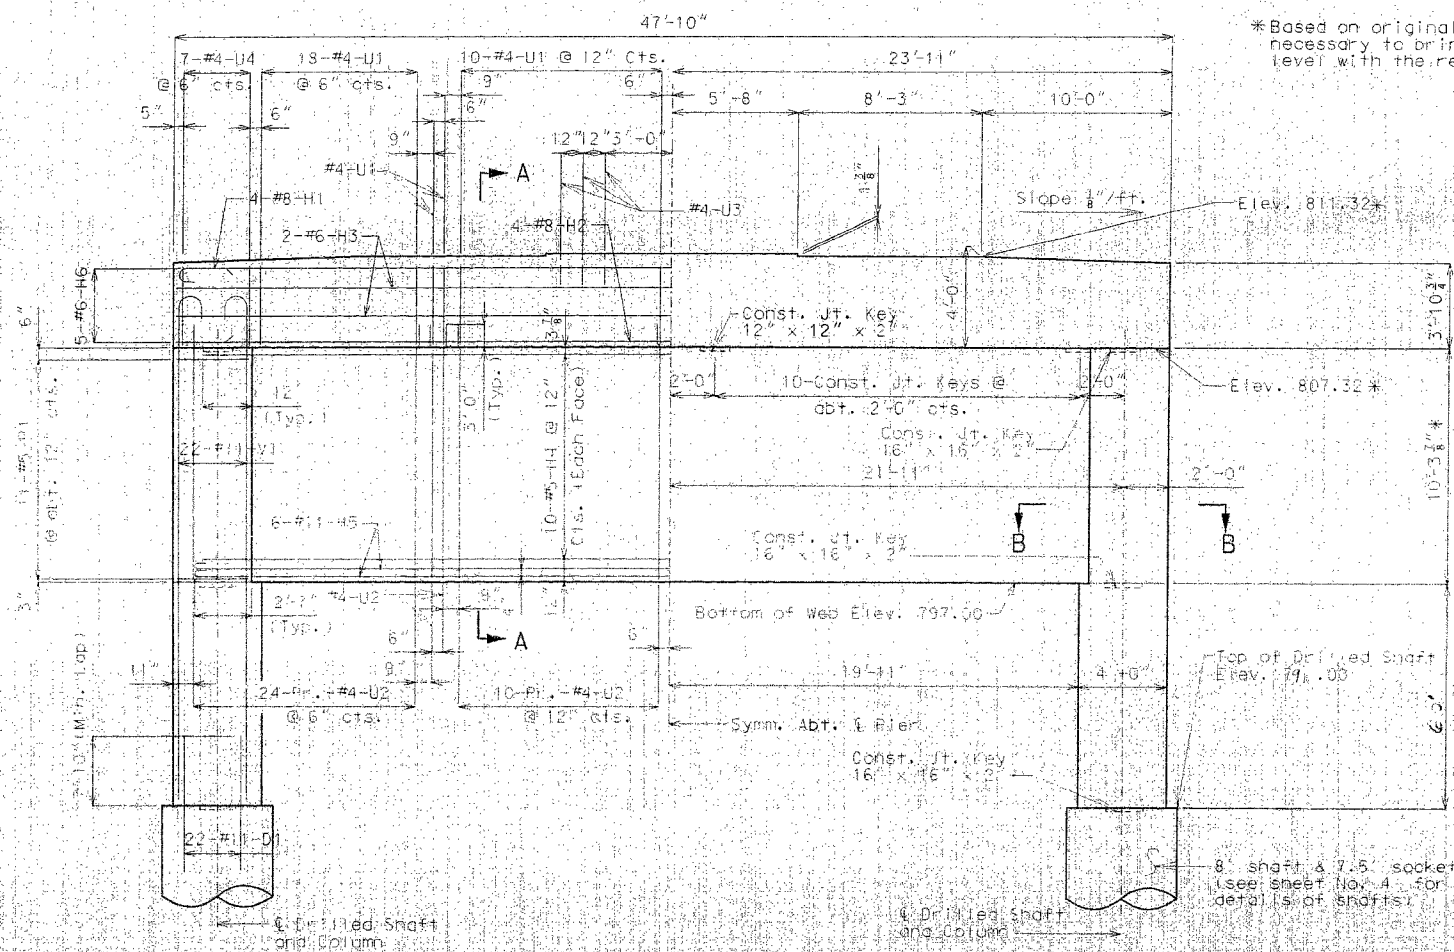

ELEVATION


*Based on original plans. Measure in field and adjust as necessary to bring top of bridge deck above pier no. 11 level with the rest of the bridge.

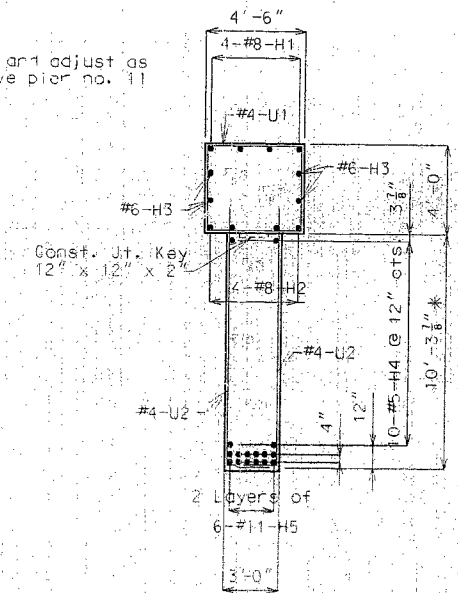

SECTION A-A

ITEM	QUANTITY
Supplementary Foundation Test Holes (NX)	Lin. Ft. 0
Supplementary Core Holes	Lin. Ft. 0
Drilled Shafts (8'-0" Dia.)	Lin. Ft. 24
Rock Sockets (7'-6" Dia.)	Lin. Ft. 52
Supplementary Television Inspection	Each 0
Class B1 Concrete (Substructure)	Cu. Yd. 114.8
Reinforcing Steel (Bridges)	pound 48,040

Note: These quantities are included in the estimated quantities table on sheet No. 2.

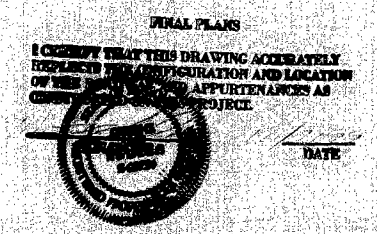

DETAILS OF PIER NO. 11

Detailled Feb. 1999
Checked Feb. 1999

Note: This drawing is not to scale. Follow dimensions.










Sheet No. 5 of 8

258

24 to 1

State	Proj. No.	Sheet No.
MO	J451365	86
Contract ID #40423-403		

(**) Shims shall be used if the bottom flange of the existing girders are not level with the top of the pier cap. They shall not be used to compensate for erroneous top of pier cap elevation.

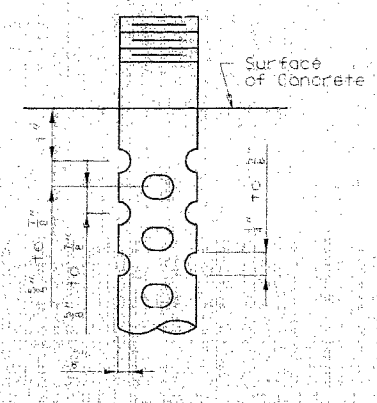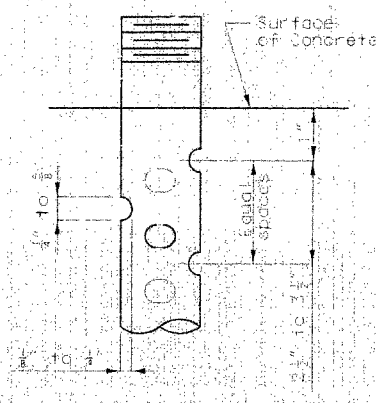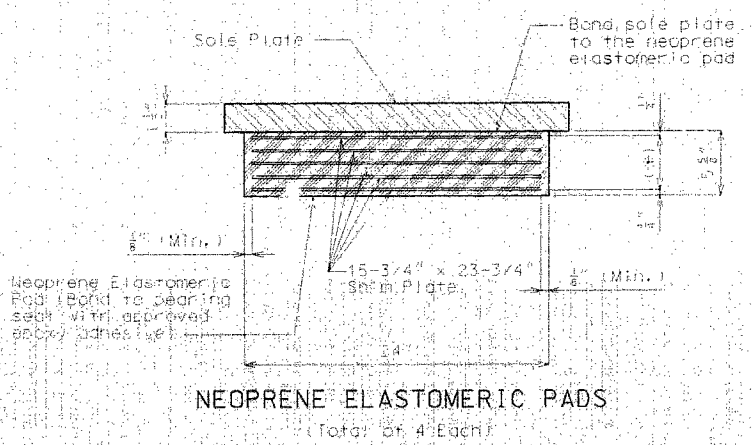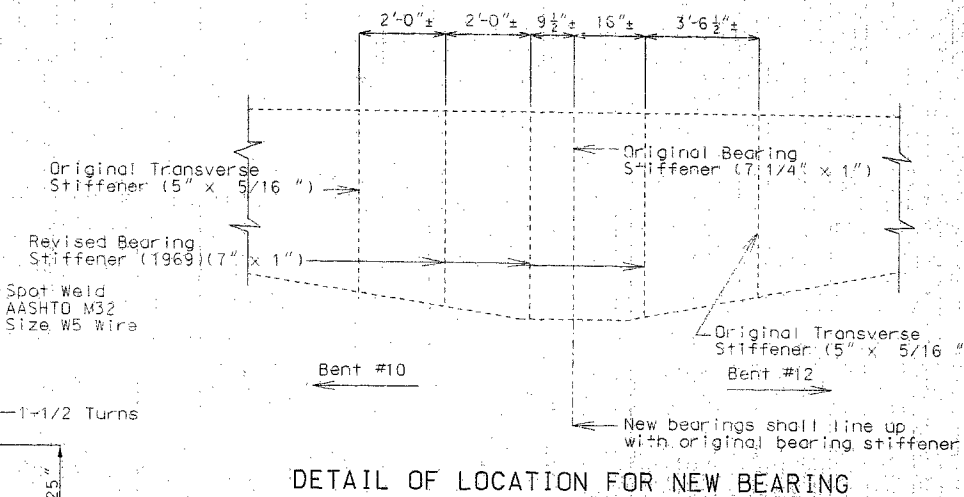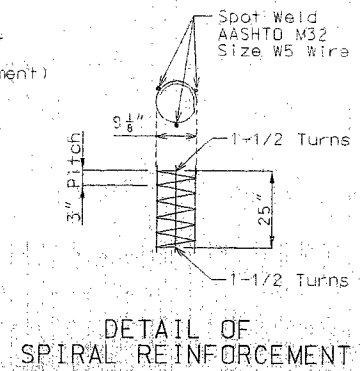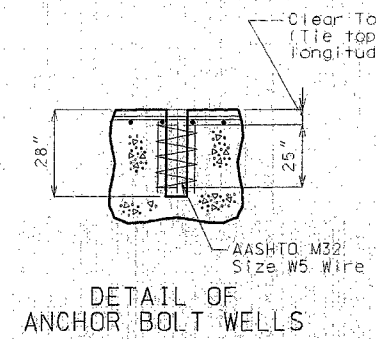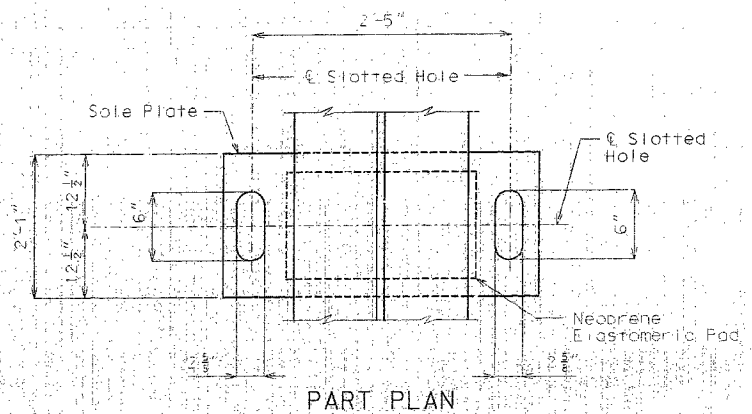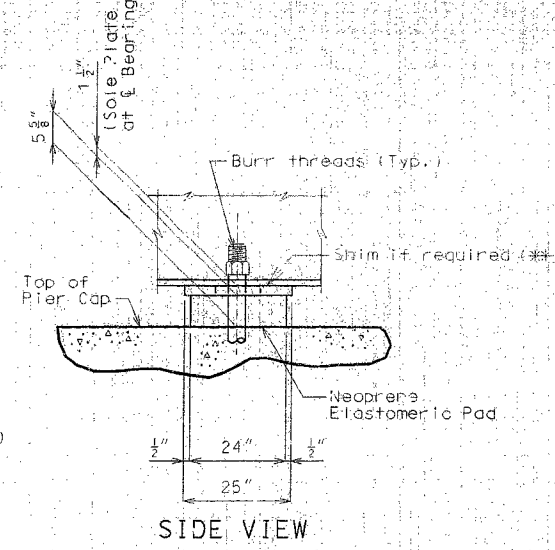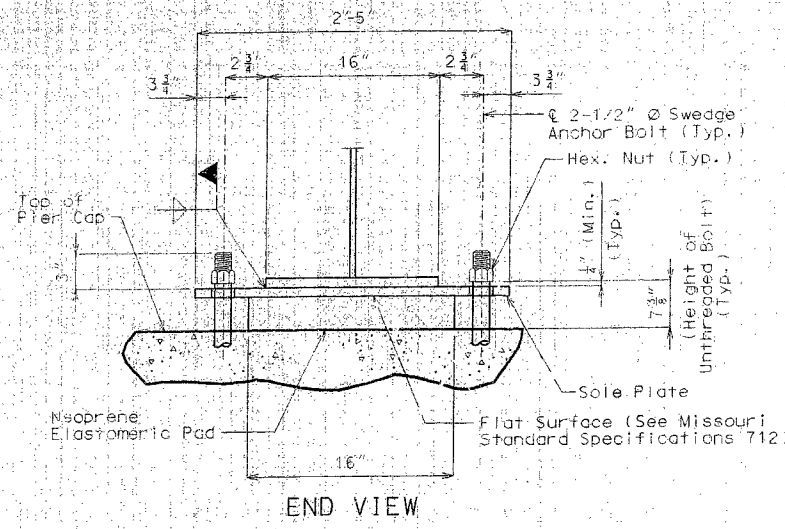

GENERAL NOTES:

Anchor bolts shall be 2-1/2" diameter, ASTM A709 Grade 50W steel swaged bolts and shall extend 25" into the concrete with ASTM A194-2, 2H or ASTM A563-0, C3, D, DH, DH3 heavy hexagon nuts. Actual manufacturer's certified mill test reports (chemical and mechanical) shall be provided. Swedging shall be 1" less than the extension into the concrete.

All structural steel for the anchor bolts and heavy hexagon nuts shall be coated with a minimum of two coats of inorganic zinc primer (5 mils minimum) or galvanized in accordance with ASTM A153.


Neoprene Elastomeric Pads shall be 60 Durometer. The neoprene pad shall be bonded to the bearing seat with an epoxy adhesive as approved by the bearing manufacturer for bonding neoprene to concrete.

The sole plate (and any required shims) shall be furnished with the bearing and field welded to the girders.

Structural steel for the sole plate (and any required shims) shall be ASTM A709 Grade 36 and shall be coated with a minimum of 2 coats of inorganic zinc primer (5 mils minimum).

The accepted quantity of the elastomeric bearing assemblies, complete-in-place, will be paid for at the contract unit price for Laminated Neoprene Bearing Pads (Steel Structures), each.

Payment for the sole plate, shim plates (if any), anchor bolts and heavy hexagon nuts shall be included in the cost of the bearing assembly. See Special Provisions.

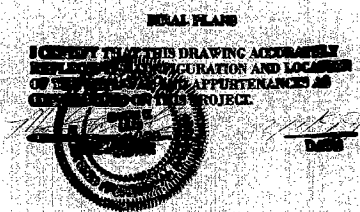

259

DETAILS OF LAMINATED NEOPRENE BEARINGS (STEEL STRUCTURES)

Revised Dec. 1998
Checked Feb. 1999

Note: This drawing is not to scale. Follow dimensions.

Sheet No. 6 of 8

PLATTE COUNTY S00253

24 to 1

FINAL PLANS
I CERTIFY THAT THIS DRAWING ACCURATELY REFLECTS THE CONFIGURATION AND LOCATION OF THE ROADWAY AND IMPROVEMENTS CONSTRUCTED OR TO BE CONSTRUCTED.




BILL OF REINFORCING STEEL

NO.	MARK NO.	LOCATION	EPOXY (E)	SHAPE NO.	STIRRUP (S)	SUBSTR. (X)	VARIES (V)	NO. EACH	DIMENSIONS													NOMINAL LENGTH	ACTUAL LENGTH	WEIGHT	
									B		C		D		E		F		H		K				
									FT.	IN.	FT.	IN.	FT.	IN.	FT.	IN.	FT.	IN.	FT.	IN.	FT.				IN.
4	8 H1	BEAM		18	X				47	7.000								49	5	49	5	528			
6	8 H2	BEAM		20	X				47	7.000								47	7	47	7	508			
4	6 H3	BEAM		20	X				47	7.000								47	7	47	7	286			
20	5 H4	WEB		20	X				41	10.000								41	10	41	10	873			
12	11 H5	WEB		18	X				45	0.000								48	2	48	2	3071			
10	6 H6	BEAM		10	S	X					22	0.000	4	2.000				7	6	7	6	113			
27	5 P1	COLUMN		18	X				3	9.000								12	10	12	10	294			
2	5 P2	COLUMN		35	X				3	9.000	3	0.000	33	1.500				1574	6	1574	6	3284			
60	4 U1	BEAM		13	S	X			1	7.500	3	7.750	4	3.000	3	7.750		16	7	16	7	895			
14	4 U2	WEB		19	S	X			13	2.500	2	9.000						16	10	15	11	1531			
5	3 U3	BEAM		19	S	X					6	9.000	4	3.000				5	3	5	3	20			
14	4 U4	BEAM		10	S	X					3	7.750	4	3.000				11	7	11	5	507			
44	11 V1	COLUMN		17	X				42	8.000								44	3	44	3	10344			
8	W5 #1	W.B. WELLS		22	X				2	1.000	9	1.25						33	2	33	2	44			
44	11 D1	COLUMN		20	X				15	8.000								15	8	15	8	3682			
76	5 P2	COLUMN		16	X				7	0.000								23	1	23	1	1630			
96	4 W5	COLUMN		30	X				4	15.000								41	10	41	10	20893			


BILL OF REINFORCING STEEL

NO.	MARK NO.	LOCATION	EPOXY (E)	SHAPE NO.	STIRRUP (S)	SUBSTR. (X)	VARIES (V)	NO. EACH	DIMENSIONS													NOMINAL LENGTH	ACTUAL LENGTH	WEIGHT	
									B		C		D		E		F		H		K				
									FT.	IN.	FT.	IN.	FT.	IN.	FT.	IN.	FT.	IN.	FT.	IN.	FT.				IN.


State MO Prof. No. J401305 Sheet No. 27

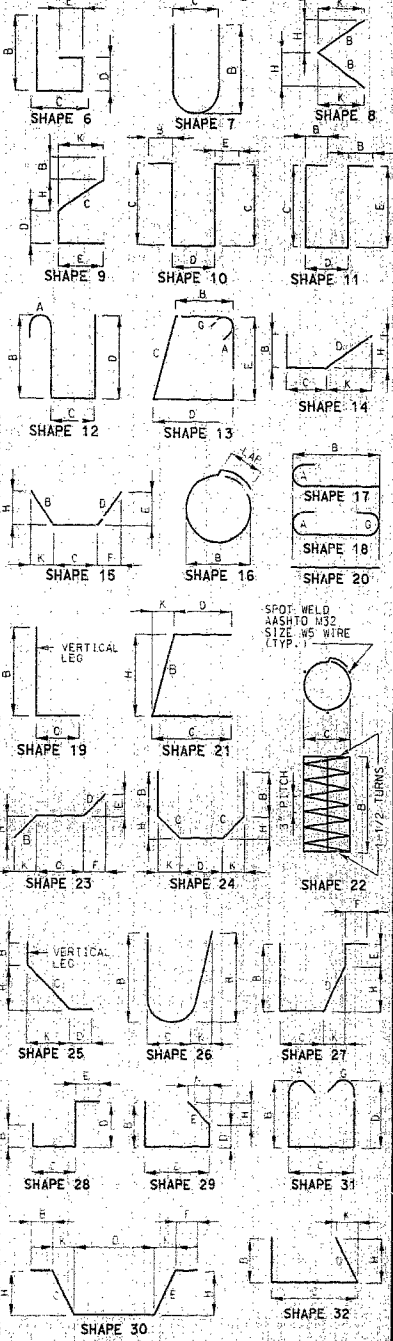

260


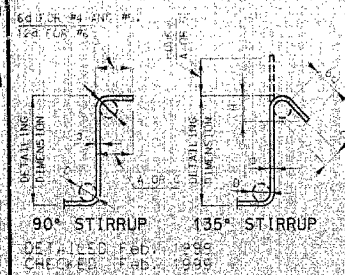


BAR SIZE (IN.)	D	90° HOOK		135° HOOK	
		A OR G	H	A OR G	H
#4	2"	4-1/2"	4-1/2"	4-1/2"	3"
#5	2-1/2"	6"	5-1/2"	5-1/2"	3-3/4"
#6	4-1/2"	12"	8"	8"	4-1/2"

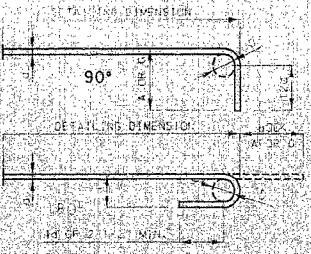

BAR SIZE (IN.)	D	ALL GRADES	
		180° HOOKS	90° HOOKS
#3	2-1/4"	5"	3"
#4	3"	6"	4"
#5	3-3/4"	7"	5"
#6	4-1/2"	8"	6"
#7	5-1/4"	10"	7"
#8	6"	11"	8"
#9	6-1/2"	15"	11-3/4"
#10	10-3/4"	17"	13-1/4"
#11	12"	19"	14-3/4"
#14	18-1/4"	27-3"	21-3/4"

NOTE:
 ALL INWARD HOOKS AND BENDS OTHER THAN 180 DEG. TO BE BENT WITH THE SAME PROCEDURE.
 HOOKS AND BENDS SHALL BE IN ACCORDANCE WITH THE PROCEDURES AS SHOWN ON THIS SHEET.
 C = EPOXY COATED REINFORCEMENT.
 S = STIRRUP.
 V = VARIES IS INCLUDED IN SUBSTRUCTURE QUANTITIES.
 X = BAR DIMENSIONS VARY IN EQUAL INCREMENTS BETWEEN DIMENSIONS SHOWN BY THIS LINE AND THE FOLLOWING LINE.
 NO. EACH = NUMBER OF BARS OF EACH LENGTH.
 NOMINAL LENGTHS ARE BASED ON OUT TO OUT DIMENSIONS SHOWN ON BENDING DIAGRAMS AND ARE LISTED FOR FABRICATOR TO THE NEAREST INCH.
 ACTUAL LENGTHS ARE MEASURED ALONG CENTERLINE BAR TO THE NEAREST INCH.
 PAYWEIGHTS ARE BASED ON ACTUAL LENGTHS.
 FOUR ANGLE OR ORANGE SPACERS ARE REQUIRED FOR EACH COLUMN SPHERE SPACERS ARE TO BE PLACED ON INSIDE OF SPHERES. BENT END WEIGHTS OF COLUMN SPHERES DO NOT INCLUDE SPLICES OR SPACER REINFORCING STEEL (GRADE 60) IF 60,000 PSI.

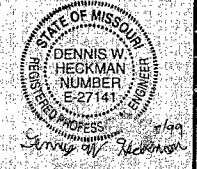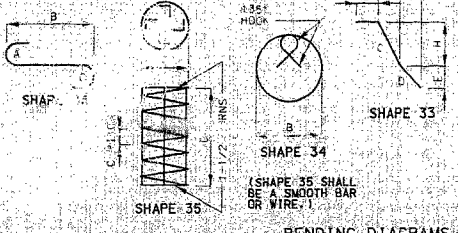

DETAILED FOR: 995
CHECKED BY: 999

NOTE: THIS DRAWING IS NOT TO SCALE. FOLLOW DIMENSIONS.


SHEET NO. 27 OF 28

PLATTE COUNTY

S00253

"AS BUILT DRILLED SHAFT" DATA			
"PIER NO. 11 (DRILLED SHAFT)"			
SHAFT NO.	BOTTOM OF DRILLED SHAFT (ELEV.)	BOTTOM OF ROCK SOCKET (ELEV.)	REMARKS
1	754.0	727.33	
2	759.0	729.0	

761

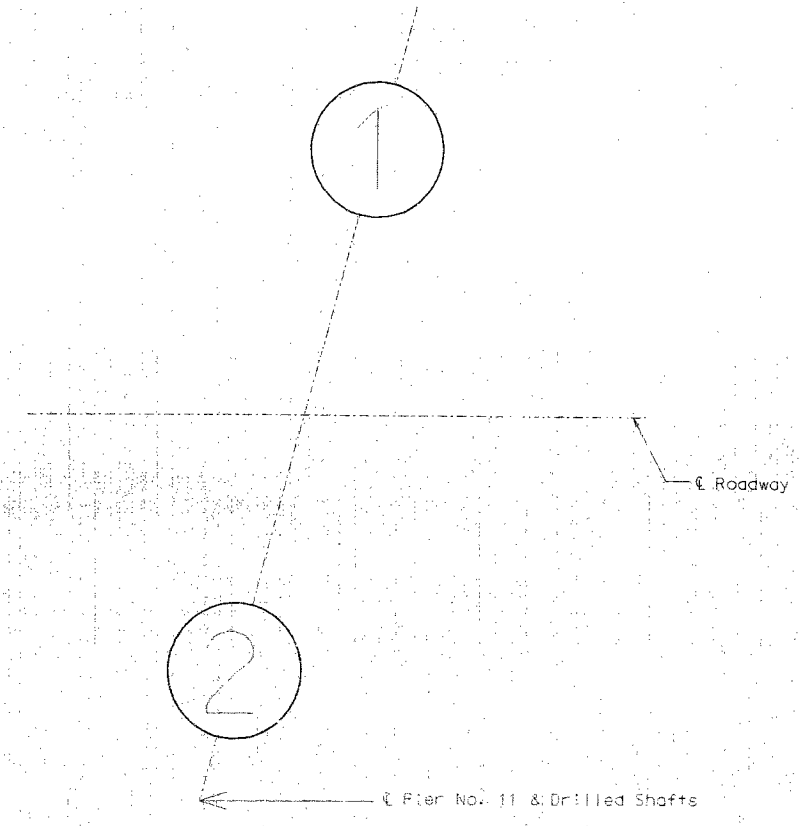

FIELD PLANS
 I CERTIFY THAT THIS DRAWING ACCURATELY
 REFLECTS THE CONFIGURATION AND LOCATION
 OF THE ROADWAY AND APPURTENANCES AS
 CONSTRUCTED BY THIS PROJECT



STATE OF MISSOURI
 DENNIS W. HECKMAN
 LICENSE NUMBER
 E-27141
 PROFESSIONAL ENGINEER
 3/10/99
 Dennis W. Heckman

Designed Feb. 1999
Checked Feb. 1999

Note: This drawing is not to scale. Follow dimensions.

Sheet No. 8 of 8

PLATTE COUNTY

PLATTE COUNTY

S00253

24 to 1