

12/19

Job No.	J9S3671
Replaces Bridge No.	N0877

# Missouri Department of Transportation Bridge Survey Location Request

Page 1 to be completed by District staff.

Bridge ove	er:	Apple	Creek			Route:	K	
County:	Perry	Sectio	n: 2	4	Township:	34 North	Range:	10 East
Latitu	ude: 37°38'20.5"N			Lor	ngitude:89°5	53'29.6"W		
District Conta	ct: Garrett Galyean (5	73-472	-5221)			Date:	11/16/20	23
	HIGH WATE	R ELE	VATIONS	AT PR	OPOSED E	RIDGE SITE		
	Recorded hi	gh wate	r elevation	s or elev	ation of high	water marks		
	Extreme	e High	Water (E⊦	HW) (Giv	e date(s) of oc	currence)		
Elevations and date(s) of same Location			Source	of informat	tion			
10.9" Below (1990) Below North End of Bridge Floor HW Book 8182								
Existing Brid	ge Overtopped ☐ Yes	□No⊠	Unknown	Existir	ng Roadway	Overtopped	□ Yes □No	⊠Unknown
				Appro	x. Overtopp	ing Location(s	s):	
						·		
		LOC	ATION O	F NEW	BRIDGE			
Replace in Existing Location  Provide details of any proposed changes to profile grade belor as an attachment.				de below				
Relocation (no	Relocation (near existing Structure)			ocation and d	rade of the	roadway		
New Route			across the	efloodp	olain, any pro	oposed/potent	ial channel	
Other:			or modific	ations,	etc. below o	or as an attach	ment.	

Additional Information:

## page 2 & subsequent pages to be completed by Bridge Division

Note:	Proposed elevations, distances, etc. are based on the best available data at the time the form was completed. Actual
	field conditions or recently acquired data may require deviation from the proposed values. Please contact the Bridge
	Division with concerns regarding the proposed values or if large deviations from these values are required.
Note:	The information below supplements the survey requirements noted in the EPG, please consult EPG 238 for additional
	surveying requirements.

Bridge Contact: Travis Stump, 573-522-8716, travis.stump@modot.mo.gov

Survey Type: 1D Survey			
------------------------	--	--	--

		Stream Crossir	ng Survey	Lo	ocation Details	(1D)		
	Item	Requirement	Standard (	Gui	dance	Specific Guidance		
.3)	C/L Profile	Terminal Point	Limit of Longest offset Profile L		Use Standar	d Guidanc	е	
6.1.0	Upstream Offset	Terminal Point	Same as Valley Sections E		Elevation =		575	
rofiles* 238.3.36.1	Profile	Offset Distance	On Natural	Gr	ound	Estimated Di	stance =	40
Profiles 238.3.3	Downstream	Terminal Point	Same as V	/alle	y Sections	Elevation =		575
EPG	Offset Profile	Offset Distance	On Natural	Gr	ound	Estimated Di	stance =	40
Ш)	Special	N/A						
		Length	Natural Stream		Section limits (Min. of 1000' each side of crossing.)	Use Natural Stream Guidand		iidance
Stream	nbed Profiles**		Drainage 500' Each Side of Crossing					
	38.3.36.3.6)		of Crossing  Drain. D  At Vertice Horizont Break Po		Nat. Stream 25'	Use Natural Stream Guidance		
					Drain. Ditch 50'			uidanca
		Elevation Intervals			At Vertical and Horizontal Break Points (200' max.)	(see EPG 238.3 slope change is	3.36.3.6 if a si	gnificant
Valley Sections			Natural Stream	5'	above EHW	Elevation =	575	
•	38.3.36.3.8), 50.3.1.1)	Terminal Point	Drainage Ditch	Ва	5' Beyond ankside Toe of evee	Distance =	N/A	

Item	Requirement	Standard (	Guidance	Specific Guidance
	Wate	er Surface P	rofile Data Needed?	☐ Yes
Water Surface Profile (EPG 238.3.36.3.7)	Locations with flowing water	Drainage Ditch	100' and 200' each side of Crossing	Use Water Surface Profile Standard Guidance

Item	Requirement	Standard Guidance	Specific Guidance
Typical Channel	Typical Channel Se	ection Data Needed? 🗌 Yes	⊠ No
Sections (EPG 238.3.36.3.9)	Within 300' each side of Centerline	Provide when Needed	

Pag	е	3

	(i.e., Culvert on Perennial and Intermittent Stream)	
--	--	--

Item	Requirement	Standard Guidance	Specific Guidance		
Existing Bridge Data	Existing Bridge Data Needed?				
Existing Bridge Bata	Description	Provide General Description	N/A		

Item	Requirement	Standard Guidance	Specific Gui	idance
		Other Bridge Data Needed?	Yes 🛛 No	
Other Bridges	Description	Provide General Description	N/A	
(EPG 238.3.36.3.10)	Profile Location	C/L Structure	N/A	
	Profile Terminal Point	5' above EHW	Elevation =	N/A

<sup>\*</sup> additional profiles may be needed for relocated routes

#### **Additional Information:**

## **Additional Documents Provided:**

Image & kmz file showing Valley Section Locations.

## Roadway Design Notes for Bridge Survey:

The Bridge Survey should include all the pertinent items listed in <u>EPG 747</u> and the <u>Bridge Survey Checklist.</u>


## **Bridge Design Notes:**


FEMA Zone A, no overtopping data in TMS.


<sup>\*\*</sup> at confluent streams provide proposed data for both streams as appropriate.

# MISSOURI STATE HIGHWAY DEPARTMENT

FED. ROA!	STATE	PED. AID PROJ. NO.	FISCAL YEAR	SHEET NO.	TOTAL SHEETS
5	NO.		19	12	

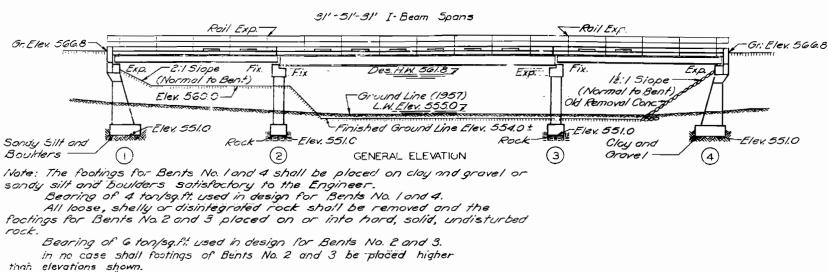

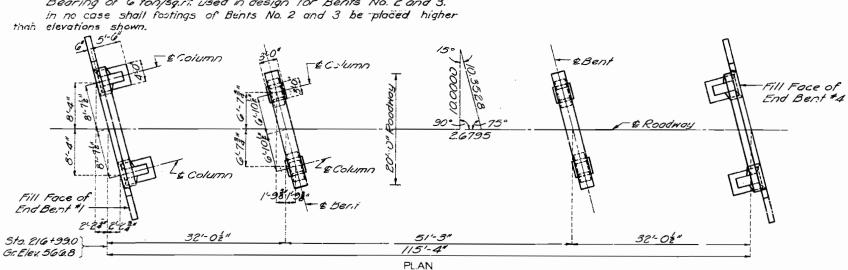

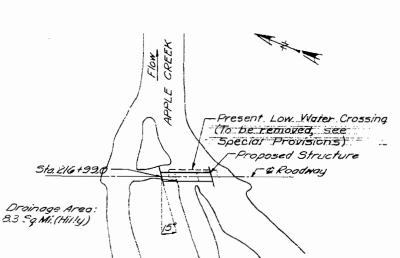

LOCATION SKETCH

GENERAL NOTES:

Design Specifications A.A.S.H.O. 1957 Loading: H15-44 (One Lane) Structural Steel Stress: 18,000 #/sq.in. Reinforcing Steel Stress: 20,000 //sq.in. Class "B" Concrete Stress: 1,200 \*/sq.in. All concrete sho! | be Class "B". Rivers ", holes A" except as noted

Field connections shall be riveted except as noted in handrail details or, if the Contractor desires to eliminate all field riveting on this project, he may use machine bolts for field connections. Heads and nuts of machine bolts shall be American Standard Regular.

Point: Shop, none: Field, contact surfaces of bolled field connections, one coot of red lead and surfaces inoccessible ofter erection, three coots of red lead. No other point to be applied by Contractor. Red lead required shall be furnished by Contractor. Payment for cleaning and pointing such Surfaces will be included in unit price bid for Fabricated Structural Steel.

Where joint filler is specified on the plans it shall conform with the requirements for Premoulded Material for Filler as given in Section 59-22D

of the Standard Specifications.

Ma	5/20	Least	Mark	Locotion	COMPLETE BILL OF REINFORCING STEEL	
		Bents			TO DIESECTION AND	ark Loco.k
6	16	234		Beam	2126" 318" 212" Superstruct	
10	19	21-9		1		
4	16	21.9		1	6 *6 3/-9* C	
4	16	23'-0		BK:WOII	6 6 31.6 0	
16	<b>*</b> 5	7494	H5	Wing	3'8" 2/'-1" 2'2" 19'-7" 12 °C 26'-0" C	
4	25	7430	HG	1	261-97 2/164 336 3 66-6 31	
8	14	7-6	VI	"	9-S3 CUT 18 9-S4 CUT 36 /8 5 24/913	
50	*4	3191	V2	BK'HO!	7 7 7 7 7 7 7 7 7 7 7 7 7 7 7 7 7 7 7 7	
4	*4	50	V3	Wing	( ** 30/04 0	
12	16	11-64	V4	Column	73" 2'-98" 32" 3'-102" 6" 6" 6" 76 4 26'-3 5	
16	16	1150	V5	/	70 4 20-5 50	6 1
8	*4	91.91	Vis	N		<del></del>
32	13	9000	Y7	"	25 4'-81" 5'-101" 20'-5" GI G"	
12	#6	7.0	.=/	Col. Hist.	7'-6' 9'-9" 20'-11 HI	
2	×6	7'-0"	ř2	N 11	10	
Ŗ	16	10-3"	<u> 7</u> /	Ning	8-V/C0132 GI-HI	7
28	16	419	<u>DI</u>	Footing	137 52	
41	*4	10-6	<u>UI</u>	Beam	5/.24	
14	*4		U2			F2
4	<b>#</b> 5	6-6"	<u>H7</u>	Hing	6'-6"	F4
		لِـــــا				
		Bents				
32	<b>NO</b>	4-04		Footing	'  'Y    'Z===k=1	
16	*6	7-9"	F3	Col.Hch.	82" 4'-0" F1 82" 6'-23" F3	
8	*8	7-6" 23-3"	<u>F4</u> 01	Beam	2332 F1-F3 F2-F4	
12	28		GE	Deam	1 1 1 1 1 1 1 1 1 1 1 1 1 1 1 1 1 1 1 1	
$\rightarrow$			<u>62</u> 63	<del>-,-</del>	Significant States of the stat	
	74		<u>G4</u>			
	13		PI	Column		
32	16		PZ	N CONTINI	23/2 U2	
	14		U3	Beam	2'-21 U4 208'P1 232"	
14	1/1		<u>U4</u>	1!	11" 45	
_	*4	3-0		//	17" V7	
	<del>-</del>				PI-U3	
$\neg$	-	-			1 1/2 04-03-47-01	

ESTIMATED QUANTITIES						
		Substr.	Superstr.	Total		
Class   Excavation for Structures	Cu. Yds.	10		10		
Class 2 Excavation for Structures	Cu.Yds.	.66		66		
Class "B" Concrete	Cu. Yds.	46.8	<i>5</i> 5:/	101.9		
Fobricated Structural Steel	L55.		48,280	48.280		
Gray Iron Alloy Costings	L <b>b3</b> .		430	430		
Reinforcing Steel	Lbs.	6,050	13,720	19,770		

Note: Excavation for Bridge made above Elev. 5560 will be paid for as Class I Excavation for Structure.

Excavation for Bridge mode below Elev. 5560 will be paid for as Class 2 Excavation for Structures.

\* Final pay weight for Fabricated Structural Steel will be based on using field rivets except for bolted connections specified

> B.M. \*G-Elev. 557.90 Noil in side 30" Sycamore 55'Lt. Sto. 217+90 (U.S.G.S. DATUM).

BRIDGE OVER APPLE CREEK

STATE ROAD FROM HIGHLAND TO MILLHEIM TO THE

ABOUT 24.5 MILES W. OF WITTENBERG **PROJECT NO.** S-993 (2) (SK) STA. 216+99.0

PERRY COUNTY

J. a. William no 7-21-1959 Box m. Whitton DATE 7-21-1959


STDC-HOR7 N--877


Drawn JULY 1959 by C.D.W. Checked July 1959 by W.F.D.

Note: This drawing is not to scale. Follow dimensions.


Sheet No. 1 of 6.


5 (8) 58 3

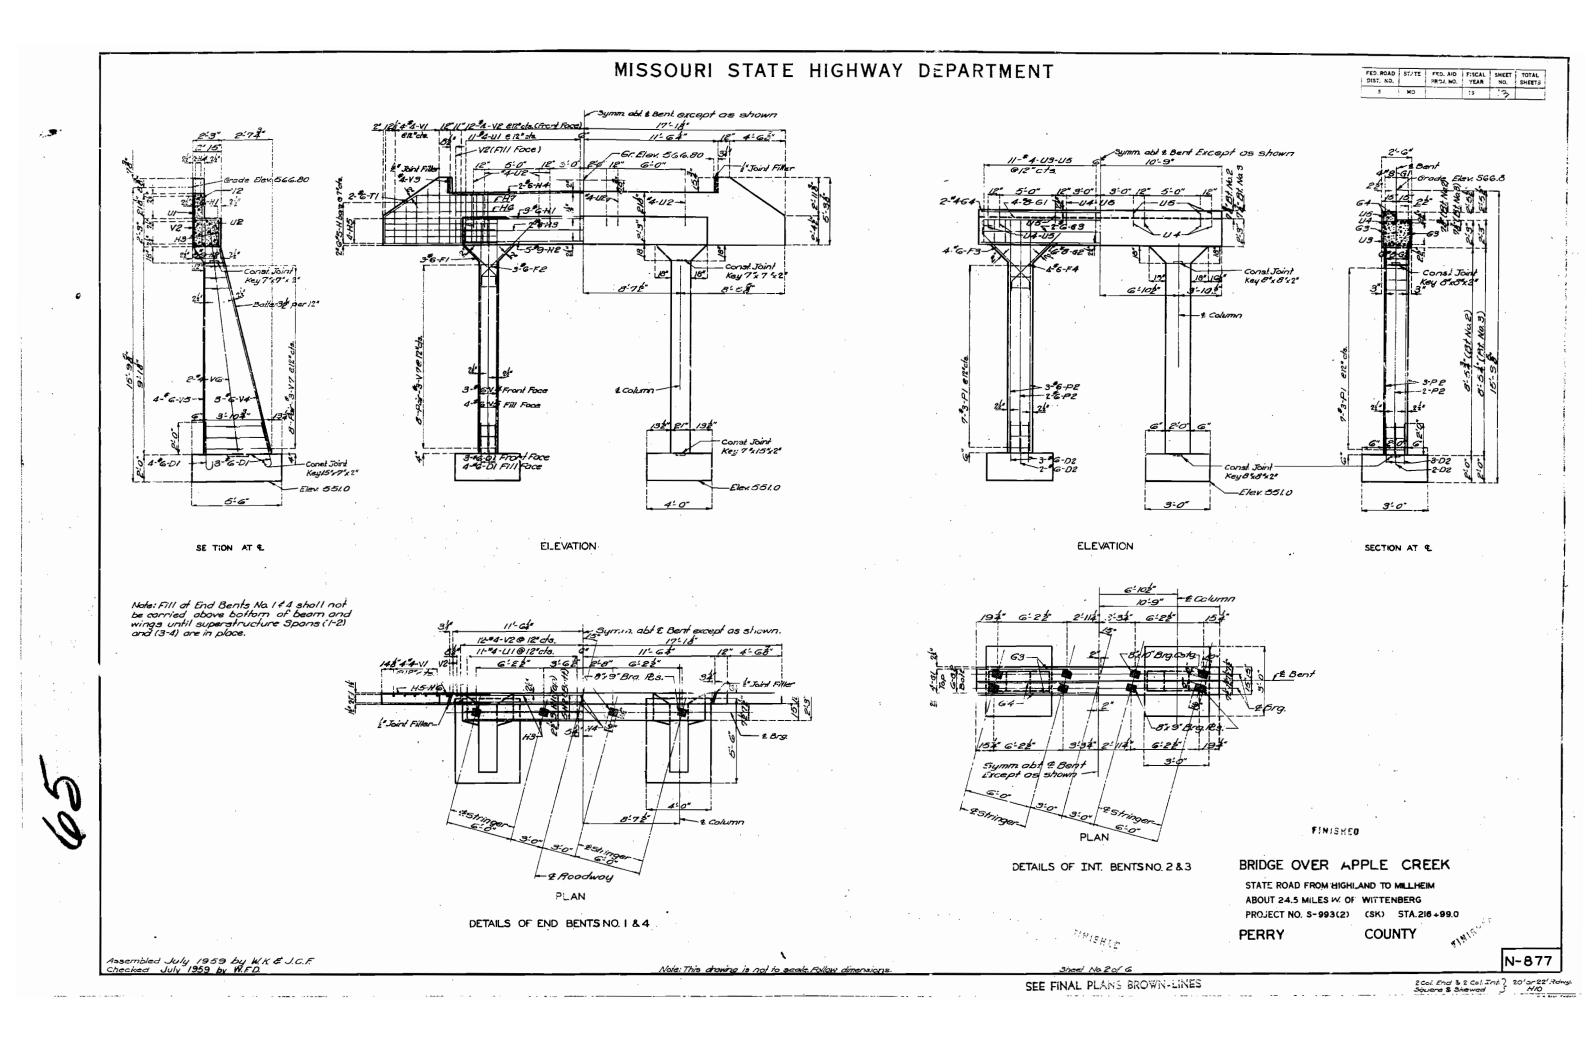


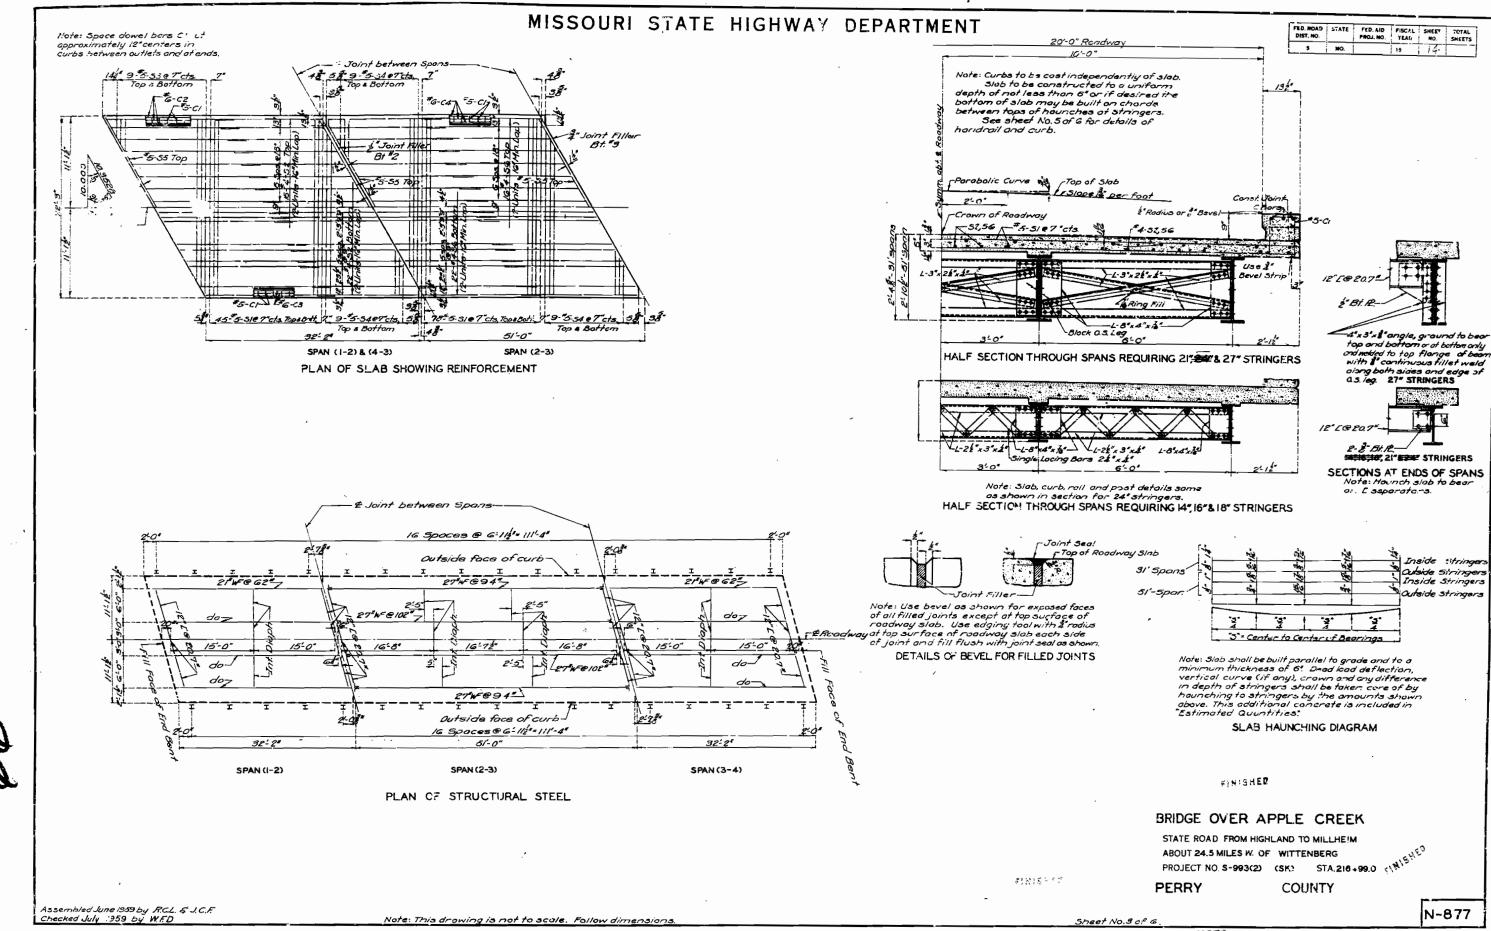

# MISSOURI STATE HIGHWAY DEPARTMENT

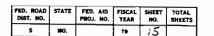

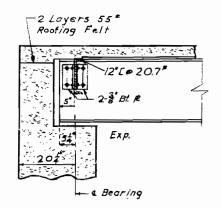


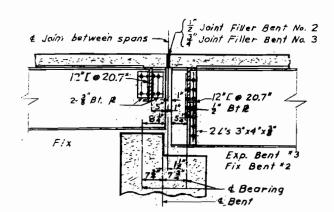


INT. BENTS NO. 2 & 3

END SPANS NO. 1 & 4

PART LONGITUDINAL SECTION

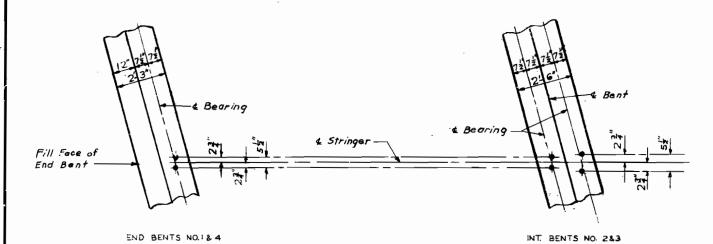


PART ANCHOR BOLT PLAN

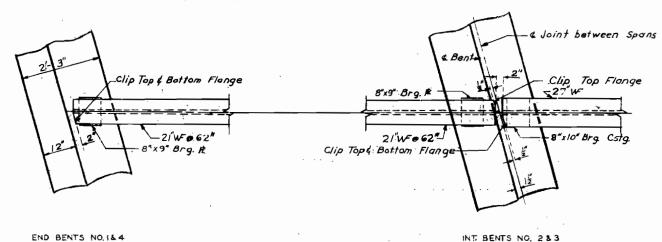


PART PLAN OF STRINGERS AT BENTS

Drawn July 1959 by R.C.L. Checked July 1959 by W.F.D.

Note: This drawing is not to scale. Follow dimensions.

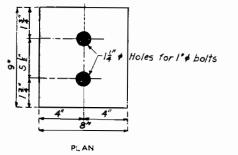

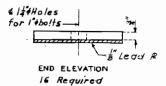

DETAILS OF STRUCTURAL STEEL PLATES

Spans (+2) (3-4)

Note: Material for 8"x9" plates to be .Structural Steel.

Anchor bolts shall be I't swedged boits, no head, Hex. nuts and shall extend 10" into concrete.

Lead plates under bearings shall be approximately \$" in thickness and weigh 8"1". Cost of lead plates shall be included in price bid for other items.

Bearing plates to be straightened to plane surfaces.

Bottom flange of beam shall have  $1\frac{\pi}{4}$  holes at fixed end and  $1\frac{\pi}{4}$  x  $2\frac{\pi}{2}$  slots at expansion end.


BRIDGE OVER APPLE CREEK

ABOUT 24.5 MILES W. OF WITTENBERG
PROJECT NO. S-993(2) SK) STA. 216 - 99.0

PERRY

COUNTY

N-877

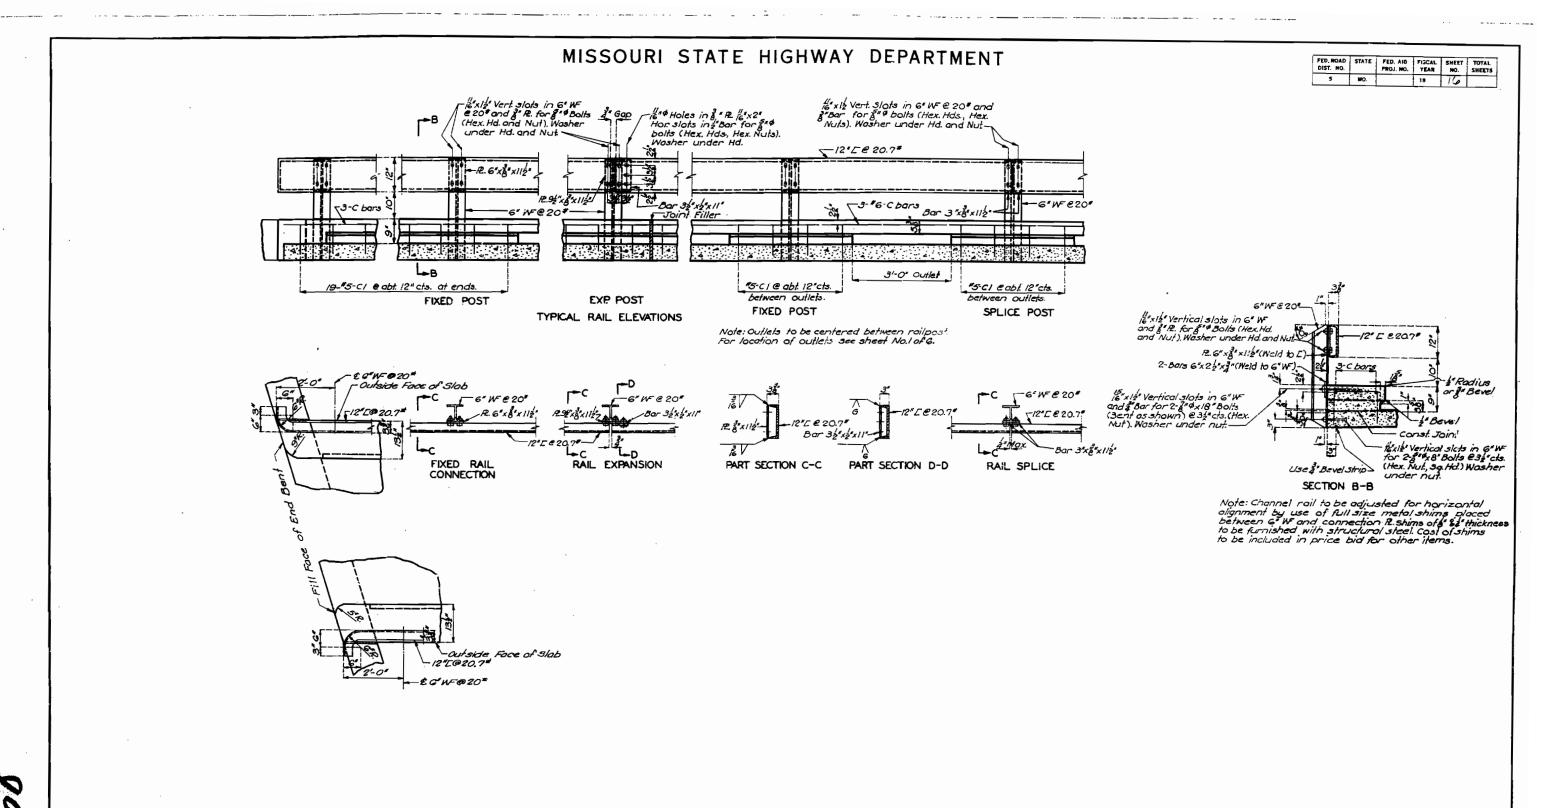

FINISHED

## BRIDGE OVER APPLE CREEK

STATE ROAD FROM HIGHLAND TO MILLHEIM
ABOUT 24.5 MILES IX. OF WITTENBERG
PROJECT NO. S-993(2) (SK) STA. 216+99.0

PERRY

COUNTY

18:2

Assembled June 1959 by LEGEVRS Checked July 1959 by W.F.D.


Note: This drowing is not to scale Follow dimensions.


Sheet No.5 of G.


FINISHED

NO CONSTRUCTION CHANGES

N-877

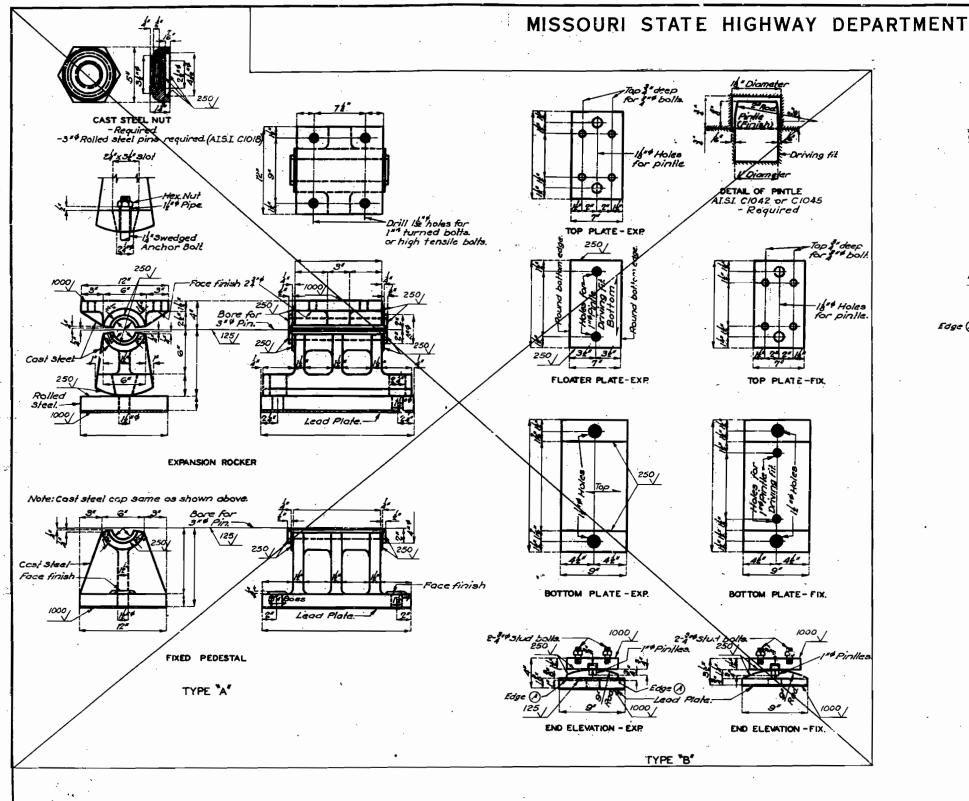

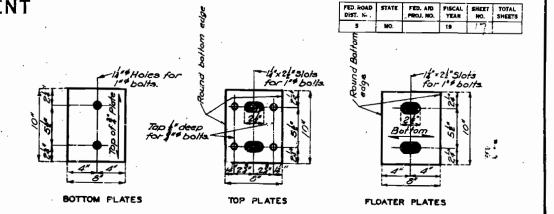

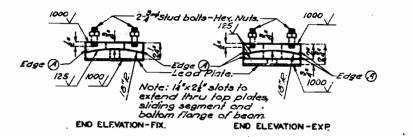

Required: 4 Sets 8"x10" Each set consists of 5 plates each. For 51'Span

TYPE "C"

#### GENERAL NOTES:

GENERAL NOTES:

Finish all surfaces as indicated.

All fillets for Type "A" costings shall have \( \frac{3}{2}\) "radius.

Material for Type "A" costings shall be Cost steel, except as noted Material for Type "B" and Type"c" castings shall be either gray from alloy or cost steel but payment will be made as Sray Iron Alloy.

All pins, botts, nu.ts, pipe steeves, rolled steel and pintles shall be paid for as Structural Steel.

Anchor, botts for Type "A" and Type "B" castings shall be | 12" swedged botts with Hex. nuts and shall extend | 12" into concrete.

Anchor botts for Type "C" castings shall be | 1" \( \frac{9}{2}\) swedged botts, with and shall extend | 10" into concrete. Top ends of anchor botts shall be above the top of castings but not higher than \( \frac{9}{2}\) be above the top surface of the bitom flange of beam.

Lead Potes under bearings shall be approximately \( \frac{9}{2}\) thickness and meigh \( \frac{9}{2}\) for top ends of lead pixtes shall be included in price bid for other items.

Edge (\( \frac{9}{2}\) to be rounded (\( \frac{1}{6}\) to \( \frac{9}{2}\) Radius)

KINISHER

### BRIDGE OVER APPLE CREEK

STATE ROAD FROM HIGHLAND TO MILLHEIM ABOUT 24.5 MILES W. OF WITTENBERG PROJECT NO.5-993(2) (SK) STA. 216+99.0

5}X13H44

**PERRY** 

COUNTY

DETAILS OF BEARING CASTINGS

Note: This drawing is not to scale. Follow cimensions.

Sheet No. G of G.


NO CONSTRUCTION CHANGES

Assembled June 1959 by RCL & C.D.W. Checked July 1959 by W.F.D.

N-877

# MISSOURI STATE HIGHWAY DEPARTMENT

PED. ROAD DIST. NO.	STATE	PED. AID PROJ. NO.			TOTAL
5	<b>M</b> 0.	5-993(2)	19	//	26

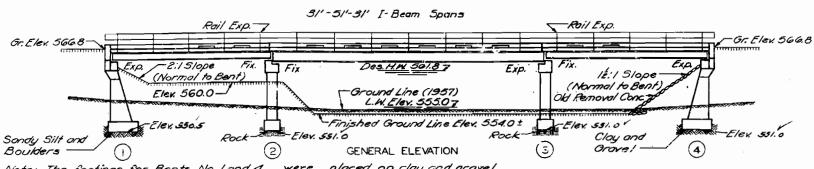


Note: The Poolings for Bents No. I and 4 were placed on clay and gravel sotisfactory to the Engineer.

Dearing UI 4 101/59 It. used in design for Bents No. I and 4.

All loose, shelly or disintegrated rock was removed and the footings for Bents No. 2 and 3 were placed into hard, solid, undisturbed

Bearing of G ton/sq.ft used in design for Eents No. 2 and 3

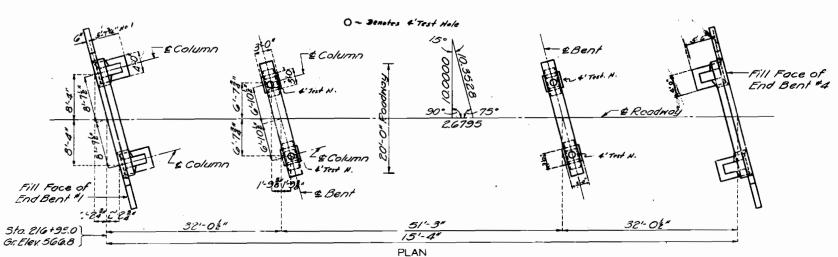

Constr'd Structure 510.216+99.0 8.3 Sq. Mi. (Hilly)

LOCATION SKETCH

GENERAL NOTES: Design Specifications A.A.S.H.O. 1957 Loading: H15-44 (One Lane)

Structural Steel Stress: 18,000 4/59 in. Reinforcing Steel Stress: 20,000 4/59 in. Class "B" Concrete Stress: 1,200 #/sq.in. All concrete was Class "B". Rivets \$", holes \$". except as noted

riveted except as noted in handrail details or, Field connections if the Contractor desires to eliminate all field riveting on this project, he may use machine boli's for field connections. Heads and nuts of machine bolts are American Standard Regular.

Paint: Shop, none: Field, contact surfaces of bolted field connections, one coot of red lead and surfaces inaccessible after erection, three coats of red lead. No other point was applied by Contractor. Red lead required was furnished by Contractor. Payment for cleaning and pointing such Where joint filler was specified on the plans it conformed with the requirements for Premoulded Material for Filler as given in Section 59-220 of the Stancard Specifications.

	COMPLETE BILL OF REINFORCING STEEL	
lo Size Length Mark Locution	Bending Sketches & Cutting Diagrams	No Size Length Wark Locat
End Bents No. 164	2-26 3-0" 2-26 2-	Superstructure 2º 176 º5 2'-9' Ci Cur
0 *9 11-9* H2 1 4 *6 21-9* H3 "		6 °6 31'-5' C2 " 6 °6 31'-6' C3 "
4 % 23'-0" HA BK:Woll	3'8" 21-1" 2:24 19:-7"	12 46 26-6 C4 .
4 5 7'3" HG "	24-9" 2/-9"	- 336 45 22-0 91 3102 - 152 4 16-9 5? "
8 4 7.6 VI " 50 4 3.9 V2 BKW011	9-\$3 CUT 'S 9-\$4 CUT 36	18 35 24.9 33 1
4 4 50° V3 Wing	73 2-98 32 3-104 6 6	. 6 45 22-9 35 1
16 16 11'00 V5 1		76 4 26-3 56
32 13 9-9 V7 11	2.9 4'-88° 3:01 5'-101° 20-8" GI	
2 *6 7'0" F1 Col.Hch	7'-6" 2'-9" 20'-11"HI	
8 *6 10-5" TI Wing	4-VICUT 8 8-V7 CUT 32 GI-HI	FI 3'-55"
4 4 10-6 UI BOAM	y 5'-2'	F3 DI 6'-0" F2
4 "4 3"-0" LIZ " 4 "5 6"-6" H7 Wing	2.112	6'-6" F4
Int. Bents No.243	E-51	2 2
32 *6 4-0" D2 Footing	8 4-0"FI	<b>1 3</b>
6 16 7-6 F4 1	270 82 6'-22"F3	<i>82"</i> F2 - F4
8 *8 23-3 01 Beam	FI-F3	72-14
4 16 21-3 33 1	2002 5	
28 #3 1-9 PI Column	9" C! 23! U2	
32 *6 10'-3" P2 " 14 *4 9'-3" U3 Beom	2'-21 U4 206'191	232
14 14 31-31 U4 11	17" V7 PI-U3	-UI
	U2-U4-U5-V7-CI	

ANTITIES			
	Substr.	Supersti	Total
Cu. Yds.	12.5	7	12.5
Cu./ds.	520	۲.	52.0
Cu. Yda.	47.1-1	55.11	102.2
Lbs.		42580	48580
Lbs.		430	430-
Lbs.	6050	137201	19770
Cu. H.	2.0.		2.0
	Cu. Yds, Cu. Yds, Cu Yds, Lbs. Lbs. Lbs.	Substr. Cu. Yds. 12.5 Cu. Yds. 52.0 Cu. Yds. 47.1 Lbs. Lbs. Lbs. 6050	Substr. Superstr.   Cu. Yds.   12.5     Cu. Yds.   52.0     Cu. Yds.   47.   65.   / /   Lbs.   4.580     Lbs.   4.050   13.710     Cu. Ht.   2.0

os Class I Excavation for Structures. Excavation for Bridge made below Elev. 5560 was paid for

Class 2 Excavation for Structures. \* Final pay weight for Fabricated Structural Steel was

based on using field rivets except for bolted connections specified for hondrail.

PRIDGE OVER APPLE CREEK

STATE ROAD FROM HIGHLAND TO MILLHEIM ABOUT 24.5 MILES W. OF WITTENBERG PROJECT NO. S-993(2) (SK) STA. 216+99.0

COUNTY FIRESHEE

B.M. "G"- Elex. - 56: 40 "B" on Top Lt. Ear ON END Bent No. 4

FINISHED

STD.CHOR7 N--377

Sheet No. 1A of &2


Note: This drawing is not to scale. Follow dimensions

**PINAL PLANS** 

FINAL PLANS

Drawn JULY 1959 by C.D.W.

Checked July 1959 by W.F.D.

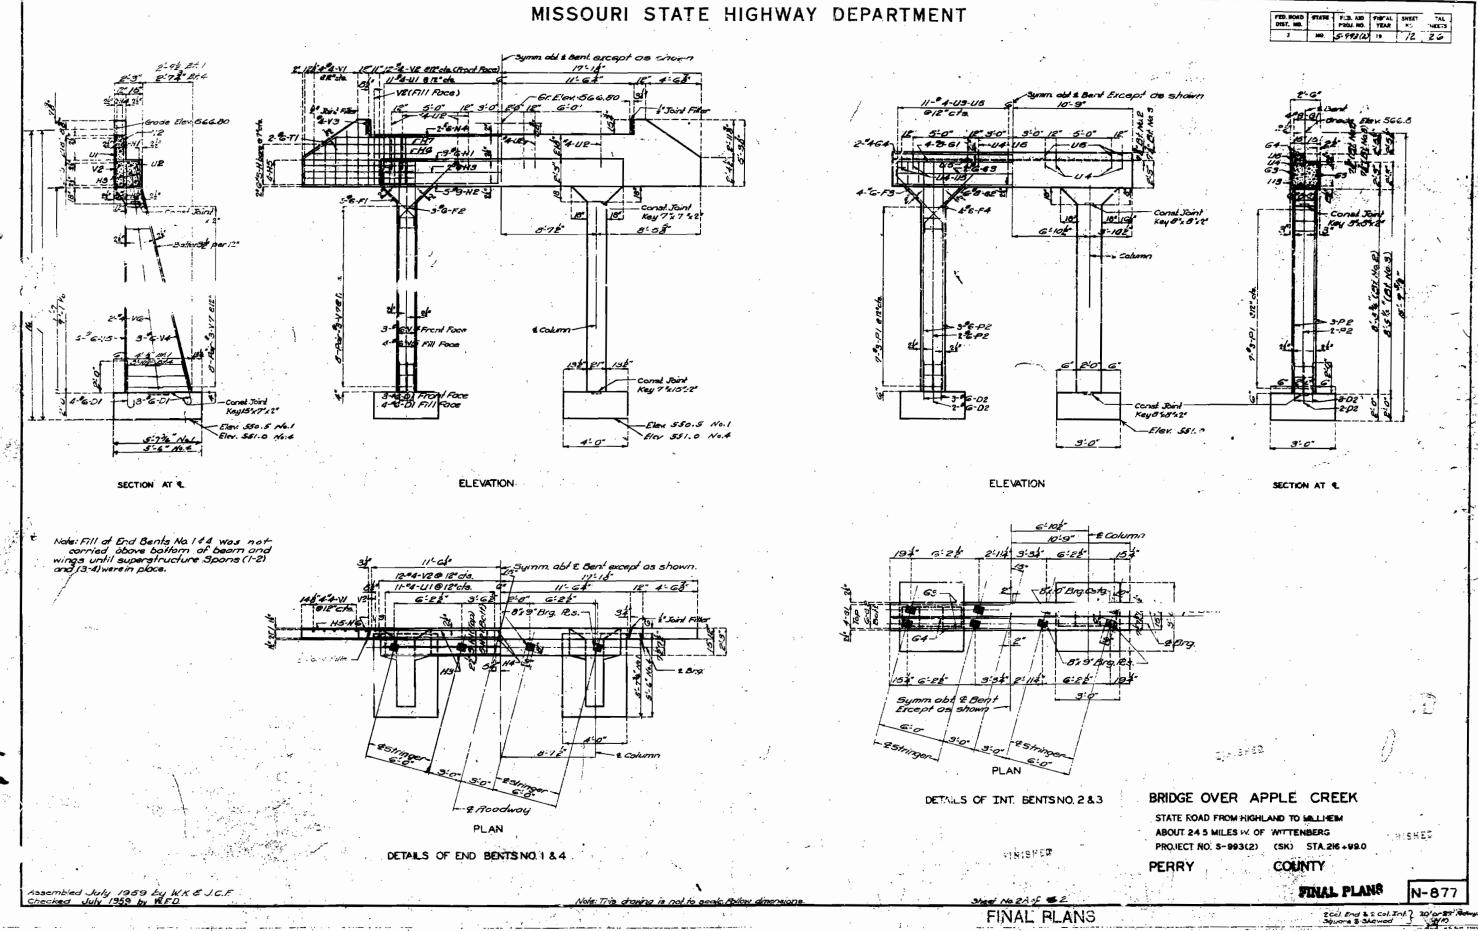

FINAL PLANS