
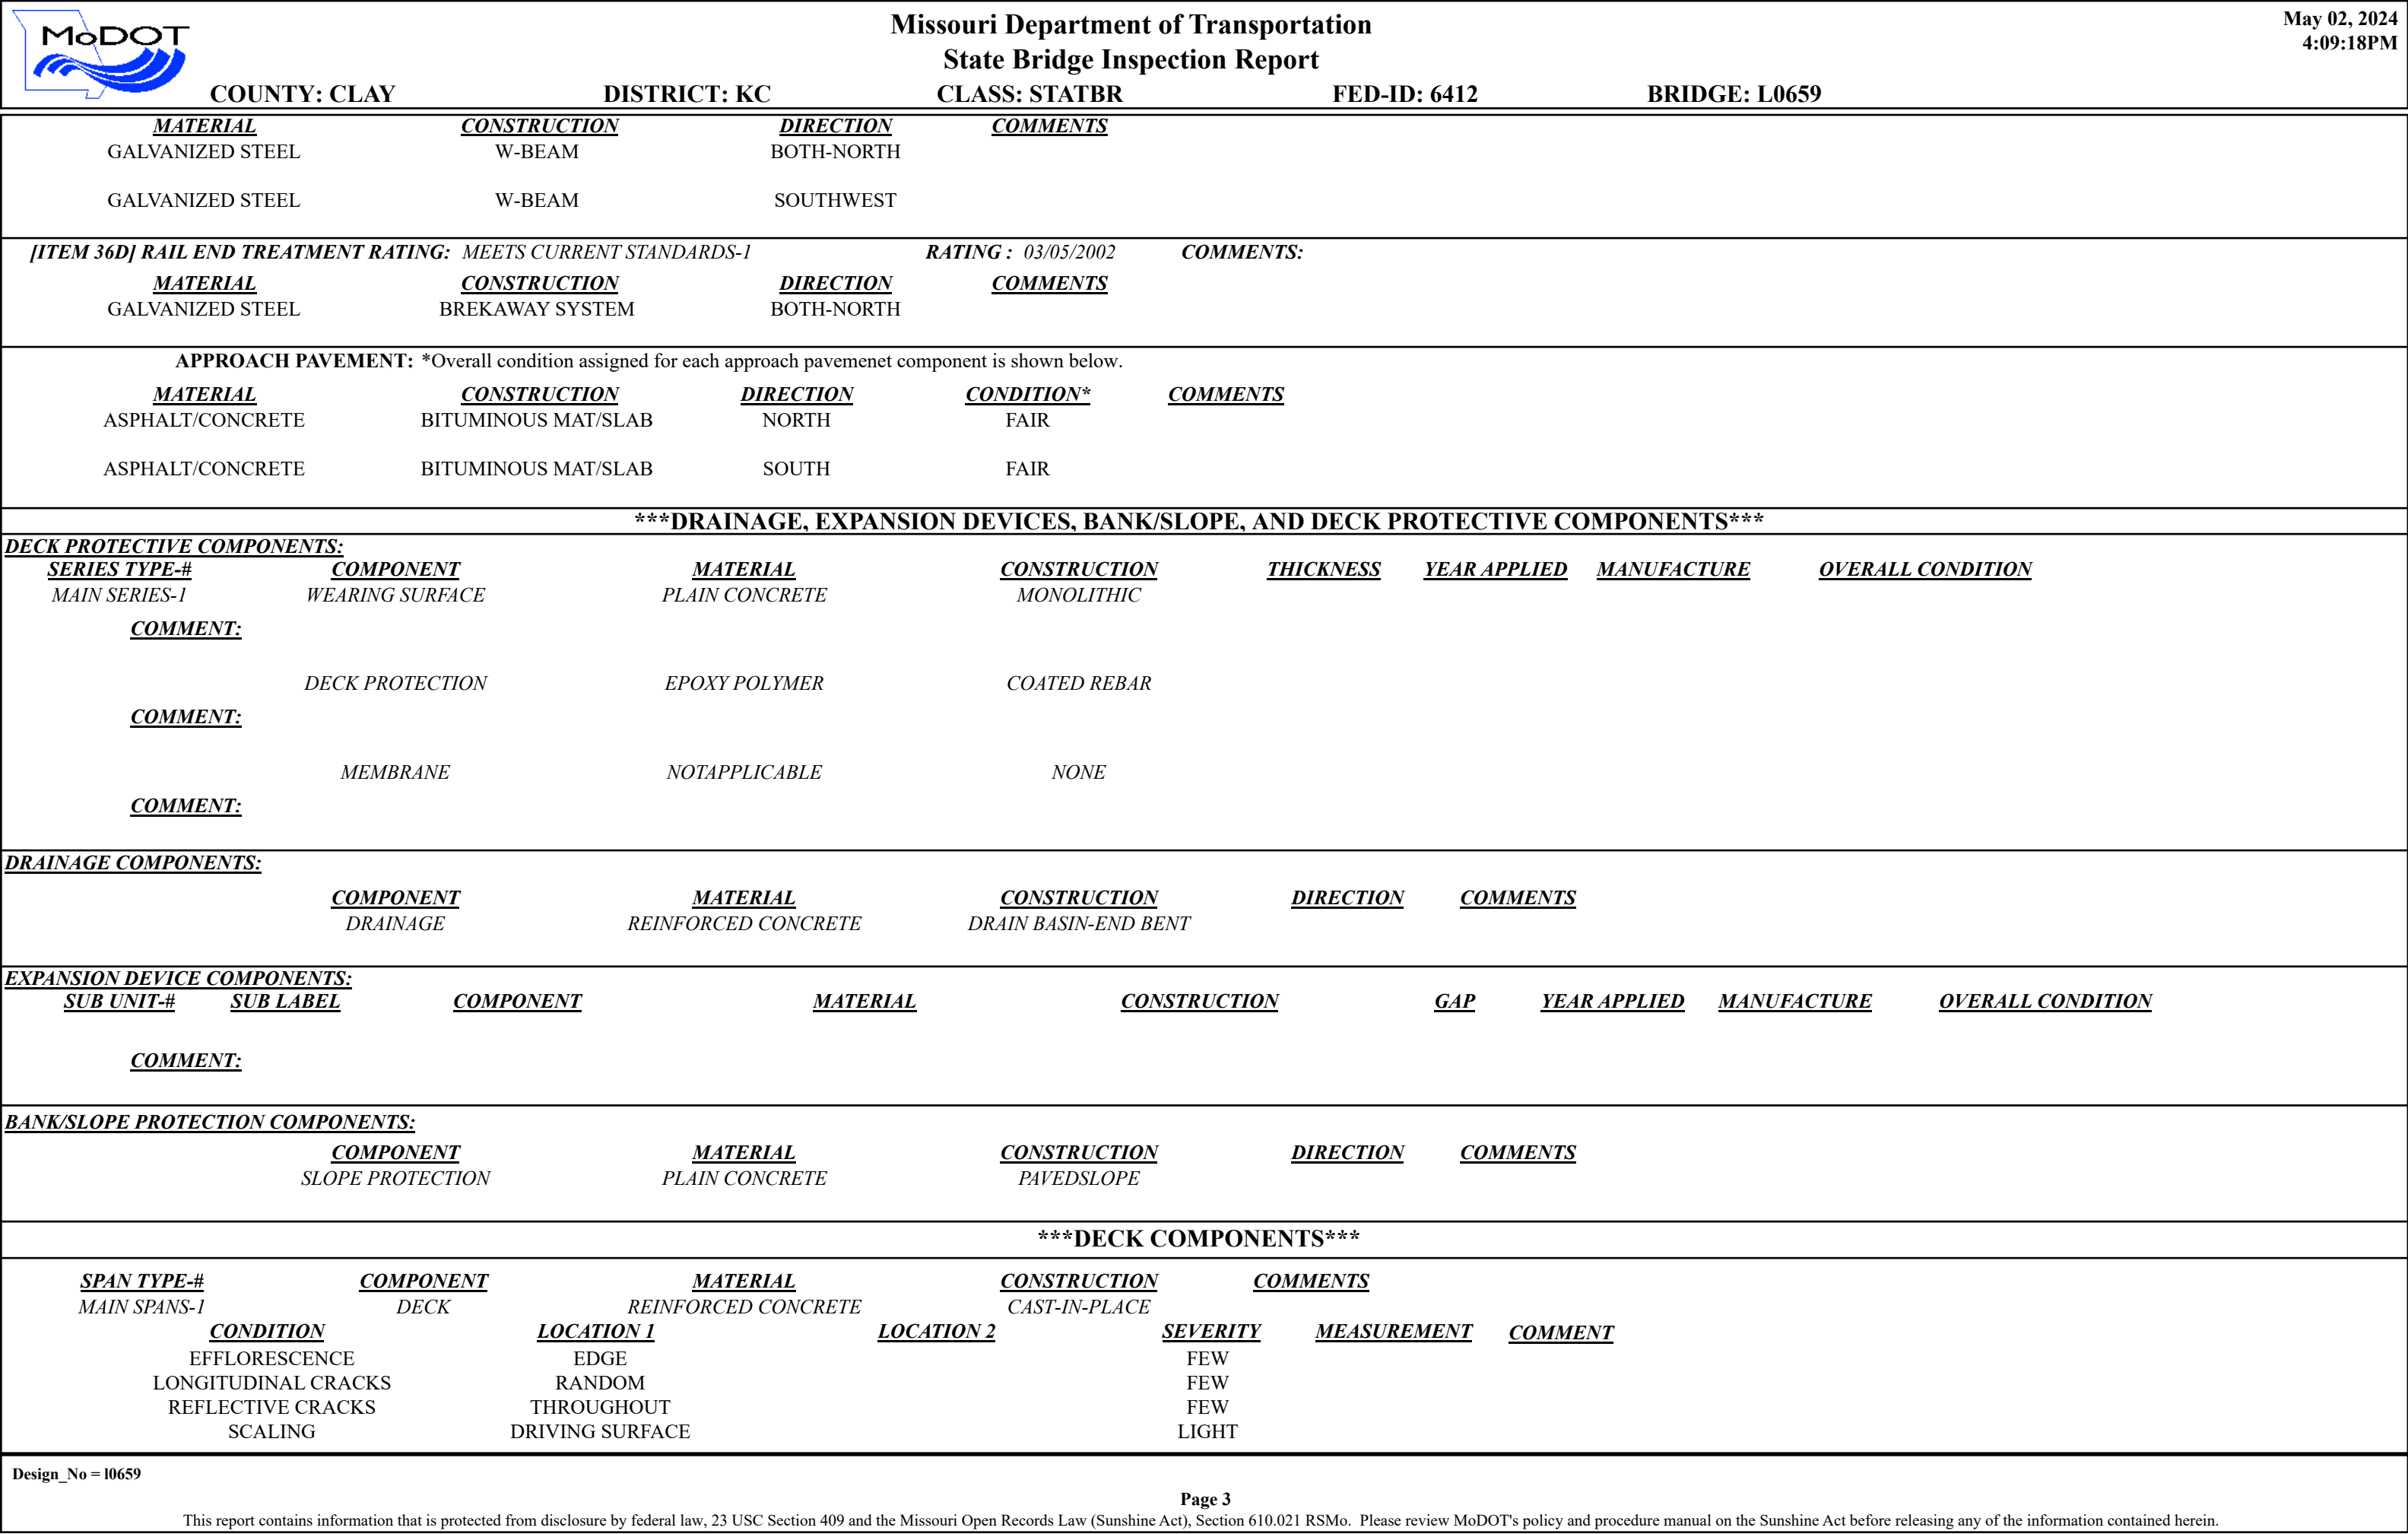
		<div>Missouri Department of Transportation</div> <div>State Bridge Inspection Report</div>				<div>May 02, 2024</div> <div>4:09:18PM</div>			
COUNTY: CLAY		DISTRICT: KC		CLASS: STATBR		FED-ID: 6412		BRIDGE: L0659	
GENERAL STRUCTURE INFORMATION							***BRIDGE INSPECTION INFORMATION***		
<div>ROUTE: IS29S</div> <div>FEATURE: CST NE PARVIN RD</div> <div>STATUS: A-OPEN</div> <div>LOG MILE: 124.169</div> <div>DETOUR: 1.00 MILES</div> <div>NHS: YES</div> <div>BUILT: 1954</div> <div>REHAB:</div> <div>LOCATION: S 1 T 50 R 33 W</div> <div>LATITUDE: 39 9 59.75 (DMS)</div> <div>LONGITUDE: 94 33 32.69 (DMS)</div>		<div># SPANS: 3</div> <div>LANES ON: 3</div> <div>LANES UNDER: 2</div> <div>COMPASS DIRECTION: SOUTH to NORTH</div> <div>DIRECTION OF TRAFFIC: 1-WAY TRAF</div> <div>FUNCTIONAL CLASS: UR-INTERSTATE</div> <div>NBI OWNER: MODOT</div> <div>NBI MAINTAINED: MODOT</div> <div>MAINTENANCE DISTRICT: KC</div> <div>MAINTENANCE COUNTY: CLAY</div> <div>SUB AREA: 7C25</div>		<div>PLACE CODE: 02800 AVONDALE CITY</div> <div>LENGTH: 123 FT 0 IN</div> <div>MAXIMUM SPAN: 62 FT 1 IN</div> <div>APPROACH ROADWAY: 52 FT 0 IN</div> <div>CURB TO CURB: 50 FT 10 IN</div> <div>OUT TO OUT: 53 FT 6 IN</div> <div>AADT: 43245</div> <div>AADT YEAR: 2023</div> <div>AADT TRUCK: 11.7%</div> <div>FUTURE AADT: 77841</div> <div>FUTURE AADT YEAR: 2043</div>		<div>DATE: 09/26/2022</div> <div>RESPONSIBILITY: DISTRICT</div> <div>FREQUENCY: 24</div> <div>CALCULATED INTERVAL**: 24</div> <div>TEAM LEADER: TIMOTHY HAZLETT</div> <div>ELEMENT: YES</div> <div>INSPECTOR 2:</div> <div>INSPECTOR 4:</div> <div>INSPECTOR 3:</div> <div>** When calculated interval exceeds the frequency, a justification comment per BIRM is required.</div>			
						GENERAL INSPECTION COMMENTS			
FRACTURE CRITICAL INSPECTION INFORMATION					***INDEPTH INSPECTION INFORMATION***				
<div>DATE:</div> <div>FREQUENCY:</div> <div>TEAM LEADER:</div> <div>INSPECTOR 2:</div> <div>** When calculated interval exceeds the frequency, a justification comment per BIRM is required.</div>					<div>RESPONSIBILITY:</div> <div>CALCULATED INTERVAL**:</div> <div>INSPECTOR 3:</div> <div>INSPECTOR 4:</div> <div>CATEGORY:</div> <div>NBI:</div> <div>METHOD:</div> <div>** When calculated interval exceeds the frequency, a justification comment per BIRM is required.</div>				
FRACTURE CRITICAL INSPECTION COMMENTS					INDEPTH INSPECTION COMMENTS				
SPECIAL INSPECTION INFORMATION					***UNDERWATER INSPECTION INFORMATION***				
<div>DATE:</div> <div>FREQUENCY:</div> <div>TEAM LEADER:</div> <div>INSPECTOR 2:</div> <div>** When calculated interval exceeds the frequency, a justification comment per BIRM is required.</div>					<div>RESPONSIBILITY:</div> <div>CALCULATED INTERVAL**:</div> <div>INSPECTOR 3:</div> <div>INSPECTOR 4:</div> <div>CATEGORY:</div> <div>NBI:</div> <div>METHOD:</div> <div>** When calculated interval exceeds the frequency, a justification comment per BIRM is required.</div>				
SPECIAL INSPECTION COMMENTS					UNDERWATER INSPECTION COMMENTS				
OTHER SPECIAL INSPECTIONS					OTHER UNDERWATER INSPECTIONS				
<div>DATE</div> <div>FREQUENCY</div> <div>CATEGORY</div> <div>NBI</div> <div>CALCULATED INTERVAL</div> <div>RESPONSIBILITY</div> <div>METHOD</div>					<div>DATE</div> <div>FREQUENCY</div> <div>CATEGORY</div> <div>NBI</div> <div>CALCULATED INTERVAL</div> <div>RESPONSIBILITY</div> <div>METHOD</div>				

Design_No = 10659

Page 1

This report contains information that is protected from disclosure by federal law, 23 USC Section 409 and the Missouri Open Records Law (Sunshine Act), Section 610.021 RSMo. Please review MoDOT's policy and procedure manual on the Sunshine Act before releasing any of the information contained herein.

		Missouri Department of Transportation			May 02, 2024	
		State Bridge Inspection Report			4:09:18PM	
COUNTY: CLAY		DISTRICT: KC		CLASS: STATBR	FED-ID: 6412	BRIDGE: L0659
STRUCTURE POSTING						
APPROVED CATEGORY: S-1		NO POSTING REQUIRED				
Ton 1:		Ton 2:		Ton 3:		
COMMENTS:						
FIELD CATEGORY: S-1		NO POSTING REQUIRED				
Ton 1:		Ton 2:		Ton 3:	PROBLEM:	PROBLEM DIRECTION:
COMMENTS:						
GENERAL COMMENTS/MAJOR RATED ITEMS						
GENERAL COMMENTS: (BOWDEJ1, 09/30/2008)--(32'-62'-27") CONT P/S CONC I-GDR SPANS (WIDENED)						
[ITEM 58] DECK: 7-GOOD CONDITION		COMMENTS: (BATUSJ1, 09/19/2012)--T-CRACKS				
RATING : 02/02/2007		(KIMM1, 10/02/2018)--WEAR				
[ITEM 59] SUPER: 6-SATISFACTORY CONDITION		COMMENTS: (OTISL1, 10/05/2020)--LEACHING @ GIDER ENDS/ENCASEMENTS				
RATING : 08/23/2023		(RAITHK, 08/23/2023)--MOD COLLISION DAMAGE MIDSPAN				
[ITEM 60] SUB: 6-SATISFACTORY CONDITION		COMMENTS: (OTISL1, 10/05/2020)--SPALLS BENT 2 COLUMNS & BOTH ABUTMENTS				
RATING : 02/02/2007						
[ITEM 61] BANK/CHANNEL: N-NOT APPLIC NO WATRWAY		COMMENTS:				
RATING : 05/18/2001						
[ITEM 113] SCOUR: N-NOT APPLIC NOT WATERW		COMMENTS:				
RATING : 05/18/2001						
EVALUATION TYPE :						
[ITEM 71] WATERWAY ADEQUACY: NOT APPLICABLE		COMMENTS:				
RATING : 05/18/2001						
[ITEM 72] APPRRDWY ALIGNMENT: 8-VERYGOOD		COMMENTS:				
RATING : 05/18/2001						
RAILING AND APPROACH PAVEMENT COMPONENTS AND RATINGS						
[ITEM 36A] BRIDGE RAILING RATING: MEETS CURRENT STANDARDS-1		RATING : 05/18/2001		COMMENTS:		
<u>MATERIAL</u>	<u>CONSTRUCTION</u>	<u>DIRECTION</u>	<u>COMMENTS</u>			
REINFORCED CONCRETE	SAFETY BARRIER CURB	BOTH	(OTISL1, 10/03/2016)--FEW SCRAPES THROUGHOUT			
<u>CONDITION</u>	<u>LOCATION 1</u>	<u>LOCATION 2</u>	<u>SEVERITY</u>	<u>COMMENT</u>		
PATCHES	RANDOM		MODERATE			
VERTICAL CRACKS	THROUGHOUT		FEW			
[ITEM 36B] TRANSITION RAILING RATING: MEETS CURRENT STANDARDS-1		RATING : 11/13/2008		COMMENTS:		
<u>MATERIAL</u>	<u>CONSTRUCTION</u>	<u>DIRECTION</u>	<u>COMMENTS</u>			
GALVANIZED STEEL	THRIE BEAM TO W-BEAM	BOTH-NORTH				
GALVANIZED STEEL	THRIE BEAM TO W-BEAM	SOUTHWEST				
[ITEM 36C] APPROACH RAILING RATING: MEETS CURRENT STANDARDS-1		RATING : 05/18/2001		COMMENTS:		
Design_No = 10659						
Page 2						
This report contains information that is protected from disclosure by federal law, 23 USC Section 409 and the Missouri Open Records Law (Sunshine Act), Section 610.021 RSMo. Please review MoDOT's policy and procedure manual on the Sunshine Act before releasing any of the information contained herein.						





Missouri Department of Transportation

State Bridge Inspection Report

May 02, 2024
4:09:18PM

COUNTY: CLAY

DISTRICT: KC

CLASS: STATBR

FED-ID: 6412

BRIDGE: L0659

TRANSVERSE CRACKS		EDGE		FEW		
MAIN SPANS-2	DECK	REINFORCED CONCRETE		CAST-IN-PLACE		
<u>CONDITION</u>		<u>LOCATION 1</u>	<u>LOCATION 2</u>	<u>SEVERITY</u>	<u>MEASUREMENT</u>	<u>COMMENT</u>
EFFLORESCENCE		EDGE		FEW		
LONGITUDINAL CRACKS		RANDOM		FEW		
REFLECTIVE CRACKS		THROUGHOUT		FEW		
SCALING		DRIVING SURFACE		LIGHT		
TRANSVERSE CRACKS		EDGE		FEW		
MAIN SPANS-3	DECK	REINFORCED CONCRETE		CAST-IN-PLACE		
<u>CONDITION</u>		<u>LOCATION 1</u>	<u>LOCATION 2</u>	<u>SEVERITY</u>	<u>MEASUREMENT</u>	<u>COMMENT</u>
EFFLORESCENCE		EDGE		FEW		
LONGITUDINAL CRACKS		RANDOM		FEW		
REFLECTIVE CRACKS		THROUGHOUT		FEW		
SCALING		DRIVING SURFACE		LIGHT		
TRANSVERSE CRACKS		EDGE		FEW		

SUPERSTRUCTURE COMPONENTS


<u>SERIES TYPE-#</u>	<u>SPAN TYPE</u>	<u>MATERIAL</u>	<u>CONSTRUCTION</u>	<u>LABEL</u>	<u>COMMENTS</u>	
MAIN SERIES-1	CONTINUOUS SPAN	PRESTRESSED CONCRETE	I-GIRDERS			
	<u>SPAN</u>	<u>COMPOSITE INDICATOR</u>	<u>LENGTH</u>	<u>WEATHERING STEEL</u>	<u>COMMENTS</u>	
MAIN SPANS-1	COMPOSITE	32 FT 8 IN	NO			
	<u>CONDITION</u>	<u>LOCATION 1</u>	<u>LOCATION 2</u>	<u>SEVERITY</u>	<u>MEASUREMENT</u>	<u>COMMENT</u>
	LEACHING	GIRDER ENCASEMENT		MINOR		
MAIN SPANS-2	COMPOSITE	62 FT 1 IN	NO			
	<u>CONDITION</u>	<u>LOCATION 1</u>	<u>LOCATION 2</u>	<u>SEVERITY</u>	<u>MEASUREMENT</u>	<u>COMMENT</u>
	COLLISION DAMAGE	EXTERIOR GIRDERS		MODERATE		
	LEACHING	GIRDER ENCASEMENT		MINOR		
MAIN SPANS-3	COMPOSITE	27 FT 8 IN	NO			
	<u>CONDITION</u>	<u>LOCATION 1</u>	<u>LOCATION 2</u>	<u>SEVERITY</u>	<u>MEASUREMENT</u>	<u>COMMENT</u>
	LEACHING	GIRDER ENCASEMENT		MINOR		


SUBSTRUCTURE COMPONENTS


<u>SUBSTRUCTURE</u>	<u>SKEW</u>	<u>LENGTH</u>	<u>MATERIAL</u>	<u>CONSTRUCTION</u>	<u>LABEL</u>	<u>COMMENTS</u>
ABUTMENT-1	RA-7 DEGREES	53 FT 11 IN	REINFORCED CONCRETE	INTEGRAL		
	<u>CONDITION</u>		<u>LOCATION 1</u>	<u>LOCATION 2</u>	<u>SEVERITY</u>	<u>MEASUREMENT</u> <u>COMMENT</u>
<u>ASSOCIATED COMPONENT</u>		<u>MATERIAL</u>		<u>CONSTRUCTION</u>		
BEAM CAP		REINFORCED CONCRETE		CAST-IN-PLACE		
	<u>CONDITION</u>		<u>LOCATION 1</u>	<u>LOCATION 2</u>	<u>SEVERITY</u>	<u>MEASUREMENT</u> <u>COMMENT</u>
	LEACHING		GIRDERS		MINOR	
	REBAR EXPOSED		THROUGHOUT		MINOR	
	SPALLS		THROUGHOUT		MINOR	
	VERTICAL CRACKS		THROUGHOUT		FEW	(OTISL1, 10/03/2016)--@ GIRDERS
PILING		STEEL		H-SHAPE		
	<u>CONDITION</u>		<u>LOCATION 1</u>	<u>LOCATION 2</u>	<u>SEVERITY</u>	<u>MEASUREMENT</u> <u>COMMENT</u>
TURNED BACK WINGS		REINFORCED CONCRETE		CAST-IN-PLACE		

Design_No = 10659

This report contains information that is protected from disclosure by federal law, 25 USC Section 409 and the Missouri Open Records Law (Sunshine Act), Section 610.021 RSMo. Please review MoDOT's policy and procedure manual on the Sunshine Act before releasing any of the information contained herein.


		Missouri Department of Transportation State Bridge Inspection Report				May 02, 2024 4:09:18PM	
COUNTY: CLAY		DISTRICT: KC		CLASS: STATBR		FED-ID: 6412	
						BRIDGE: L0659	
	<u>CONDITION</u>		<u>LOCATION 1</u>	<u>LOCATION 2</u>	<u>SEVERITY</u>	<u>MEASUREMENT</u>	<u>COMMENT</u>
FIXED BEARING			ELASTOMERIC	LAMIN NEOP/PTFE(ROTATI			
	<u>CONDITION</u>		<u>LOCATION 1</u>	<u>LOCATION 2</u>	<u>SEVERITY</u>	<u>MEASUREMENT</u>	<u>COMMENT</u>
DIAPHRAGM			REINFORCED CONCRETE	CAST-IN-PLACE			
	<u>CONDITION</u>		<u>LOCATION 1</u>	<u>LOCATION 2</u>	<u>SEVERITY</u>	<u>MEASUREMENT</u>	<u>COMMENT</u>
LEACHING			AT GIRDERS		MINOR		
VERTICAL CRACKS			AT GIRDERS		FEW		
BENT-2	RA-7 DEGREES	50 FT 3 IN	REINFORCED CONCRETE	MULTIPLE COLUMN			
	<u>CONDITION</u>		<u>LOCATION 1</u>	<u>LOCATION 2</u>	<u>SEVERITY</u>	<u>MEASUREMENT</u>	<u>COMMENT</u>
<u>ASSOCIATED COMPONENT</u>			<u>MATERIAL</u>	<u>CONSTRUCTION</u>			
BEAM CAP			REINFORCED CONCRETE	CAST-IN-PLACE			
	<u>CONDITION</u>		<u>LOCATION 1</u>	<u>LOCATION 2</u>	<u>SEVERITY</u>	<u>MEASUREMENT</u>	<u>COMMENT</u>
COLUMN			REINFORCED CONCRETE	CAST-IN-PLACE			
	<u>CONDITION</u>		<u>LOCATION 1</u>	<u>LOCATION 2</u>	<u>SEVERITY</u>	<u>MEASUREMENT</u>	<u>COMMENT</u>
DELAMINATION			THROUGHOUT		MINOR		
REBAR EXPOSED			THROUGHOUT		MODERATE		
SPALLS			THROUGHOUT		MODERATE		
VERTICAL CRACKS			THROUGHOUT		FEW		
FOOTING			REINFORCED CONCRETE	H-PILE			
	<u>CONDITION</u>		<u>LOCATION 1</u>	<u>LOCATION 2</u>	<u>SEVERITY</u>	<u>MEASUREMENT</u>	<u>COMMENT</u>
FIXED BEARING			ELASTOMERIC	LAMIN NEOP/PTFE(ROTATI			
	<u>CONDITION</u>		<u>LOCATION 1</u>	<u>LOCATION 2</u>	<u>SEVERITY</u>	<u>MEASUREMENT</u>	<u>COMMENT</u>
BENT-3	RA-7 DEGREES	50 FT 3 IN	REINFORCED CONCRETE	MULTIPLE COLUMN			
	<u>CONDITION</u>		<u>LOCATION 1</u>	<u>LOCATION 2</u>	<u>SEVERITY</u>	<u>MEASUREMENT</u>	<u>COMMENT</u>
<u>ASSOCIATED COMPONENT</u>			<u>MATERIAL</u>	<u>CONSTRUCTION</u>			
BEAM CAP			REINFORCED CONCRETE	CAST-IN-PLACE			
	<u>CONDITION</u>		<u>LOCATION 1</u>	<u>LOCATION 2</u>	<u>SEVERITY</u>	<u>MEASUREMENT</u>	<u>COMMENT</u>
VERTICAL CRACKS			THROUGHOUT		FEW		
COLUMN			REINFORCED CONCRETE	CAST-IN-PLACE			
	<u>CONDITION</u>		<u>LOCATION 1</u>	<u>LOCATION 2</u>	<u>SEVERITY</u>	<u>MEASUREMENT</u>	<u>COMMENT</u>
DELAMINATION			THROUGHOUT		MINOR		
VERTICAL CRACKS			THROUGHOUT		FEW		
FOOTING			REINFORCED CONCRETE	H-PILE			
	<u>CONDITION</u>		<u>LOCATION 1</u>	<u>LOCATION 2</u>	<u>SEVERITY</u>	<u>MEASUREMENT</u>	<u>COMMENT</u>
FIXED BEARING			ELASTOMERIC	LAMIN NEOP/PTFE(ROTATI			
	<u>CONDITION</u>		<u>LOCATION 1</u>	<u>LOCATION 2</u>	<u>SEVERITY</u>	<u>MEASUREMENT</u>	<u>COMMENT</u>
ABUTMENT-4	RA-7 DEGREES	53 FT 11 IN	REINFORCED CONCRETE	INTEGRAL			
	<u>CONDITION</u>		<u>LOCATION 1</u>	<u>LOCATION 2</u>	<u>SEVERITY</u>	<u>MEASUREMENT</u>	<u>COMMENT</u>
<u>ASSOCIATED COMPONENT</u>			<u>MATERIAL</u>	<u>CONSTRUCTION</u>			
BEAM CAP			REINFORCED CONCRETE	CAST-IN-PLACE			
	<u>CONDITION</u>		<u>LOCATION 1</u>	<u>LOCATION 2</u>	<u>SEVERITY</u>	<u>MEASUREMENT</u>	<u>COMMENT</u>
REBAR EXPOSED			THROUGHOUT		FEW		
RUST STAINS			THROUGHOUT		FEW		
SPALLS			THROUGHOUT		MINOR		
VERTICAL CRACKS			THROUGHOUT		FEW		
PILING			STEEL	H-SHAPE			
	<u>CONDITION</u>		<u>LOCATION 1</u>	<u>LOCATION 2</u>	<u>SEVERITY</u>	<u>MEASUREMENT</u>	<u>COMMENT</u>
TURNED BACK WINGS			REINFORCED CONCRETE	CAST-IN-PLACE			

		Missouri Department of Transportation				May 02, 2024	
		State Bridge Inspection Report				4:09:18PM	
COUNTY: CLAY		DISTRICT: KC		CLASS: STATBR		FED-ID: 6412	
						BRIDGE: L0659	
FIXED BEARING		ELASTOMERIC		LAMIN NEOP/PTFE(ROTATI			
DIAPHRAGM		REINFORCED CONCRETE		CAST-IN-PLACE			
LEACHING		AT GIRDERS		MINOR			
VERTICAL CRACKS		AT GIRDERS		FEW			
OVER/UNDER ROUTES CLEARANCE INFORMATION							
CLEARANCES OVER DECK **NOTE: Vertical clearances for permitting purposes are taken as 2 inches less than the actual field measured clearance.							
<u>VERTICAL CLEARANCE TYPE**</u>		<u>VALUE</u>	<u>DIRECTION</u>	<u>DATE</u>	<u>COMMENT</u>		
CLEARANCES UNDER BRIDGE **NOTE: Vertical clearances for permitting purposes are taken as 2 inches less than the actual field measured clearance.							
<u>RECORD #</u>	<u>ROUTE</u>	<u># LANES</u>	<u>DIRECTION OF TRAFFIC</u>	<u>RIGHT LATERAL CLEARANCE</u>	<u>LEFT LATERAL CLEARANCE</u>	<u>UR-ID</u>	
1	CST NE PARVIN RD E	2	2-WAY TRAF	7 FT 0 IN		14191	
<u>VERTICAL CLEARANCE TYPE**</u>		<u>VALUE</u>	<u>DIRECTION</u>	<u>DATE</u>	<u>COMMENT</u>		
ACTUAL		15 FT 6 IN					
STRUCTURE PAINT INFORMATION							
CONDITION:		RUST AMOUNT :		STEEL TONS :			
<u>ORIGINAL PAINT</u>		<u>CONTRACT REPAINT</u>		<u>DEPARTMENT REPAINT</u>			
PAINT TYPE :		PAINT TYPE :		PAINT TYPE :		MANUFACTURE :	
NAME :		NAME :		NAME :		SURFACE PREP :	
PAINT COLOR :		PAINT COLOR :		PAINT COLOR :			
PAINT YEAR :		PAINT YEAR :		PAINT YEAR :			
MILS :		MILS :		MILS :			
REQUESTED WORK ITEMS							
GENERAL WORK COMMENTS:							
Design_No = 10659							
Page 6							
This report contains information that is protected from disclosure by federal law, 23 USC Section 409 and the Missouri Open Records Law (Sunshine Act), Section 610.021 RSMo. Please review MoDOT's policy and procedure manual on the Sunshine Act before releasing any of the information contained herein.							

		Missouri Department of Transportation				May 02, 2024																																						
		State Bridge Inspection Report				4:09:18PM																																						
COUNTY: CLAY		DISTRICT: KC		CLASS: STATBR		FED-ID: 6412																																						
						BRIDGE: L0659																																						
RESPONSIBILITY DISTRICT SPECIAL		LOCATION ROADWAY SURFACE		ITEM SEAL WITH SILANE		CATEGORY DECK																																						
				PRIORITY 3		DATE 04/22/2024																																						
						WORK ITEM COMMENT																																						
UTILITY ATTACHMENTS																																												
UTILITY		OWNER		METHOD		MEASUREMENT TYPE																																						
						VALUE																																						
						NUMBER																																						
						UTILITY ATTACHMENT COMMENT																																						
PROGRAM NOTES INFORMATION																																												
YEAR		PROJECT #		MONTH LET		YEAR LET																																						
						ITEMS																																						
						COMMENT																																						
COMPUTER GENERATED RATINGS AND DEFICIENCY ITEMS						***ADVANCED SIGN INFORMATION***																																						
<p>NOTE: The items listed in this section are updated whenever computer edits are ran on a structure after the inspection updates have been entered in to TMS.</p> <table><tr><td><u>Rated Item</u></td><td><u>Rating</u></td><td><u>Rating Date</u></td></tr><tr><td>[Item 67] Structure Evaluation Rating:</td><td>6-EQ TO PRESENT MIN CRITR</td><td>10/6/2020</td></tr><tr><td>[Item 68] Deck Geometry Rating:</td><td>5-BETTER THAN MINIMUM</td><td>4/17/2002</td></tr><tr><td>[Item 69] Underclearance:</td><td>4-MEETS MINIMUM TOLERABLE</td><td>3/25/2003</td></tr><tr><td>Sufficiency Rating:</td><td>92.9%</td><td>3/7/2024</td></tr><tr><td>Deficiency:</td><td>NOT DEFICIENT</td><td>4/17/2002</td></tr><tr><td>Funding Eligibility:</td><td></td><td>----</td></tr><tr><td>Estimated New Structure Length:</td><td></td><td>----</td></tr><tr><td>Estimated Structure Cost:</td><td></td><td>----</td></tr><tr><td>Estimated Total Project Cost:</td><td></td><td>----</td></tr><tr><td>Year of Cost Estimate:</td><td></td><td>----</td></tr></table> <p>NOTE: The above structure length and cost estimates are computer generated using algorithms in the TMS system. These algorithms are generalized to use NBI items to come up with a new structure length and width to calculate a new area which is taken times a representative cost per square foot. The actual structure size and cost may vary significantly from these numbers once site specific engineering is done.</p>						<u>Rated Item</u>	<u>Rating</u>	<u>Rating Date</u>	[Item 67] Structure Evaluation Rating:	6-EQ TO PRESENT MIN CRITR	10/6/2020	[Item 68] Deck Geometry Rating:	5-BETTER THAN MINIMUM	4/17/2002	[Item 69] Underclearance:	4-MEETS MINIMUM TOLERABLE	3/25/2003	Sufficiency Rating:	92.9%	3/7/2024	Deficiency:	NOT DEFICIENT	4/17/2002	Funding Eligibility:		----	Estimated New Structure Length:		----	Estimated Structure Cost:		----	Estimated Total Project Cost:		----	Year of Cost Estimate:		----	SIGN # 1		SIGN TYPE		PROBLEM	
						<u>Rated Item</u>	<u>Rating</u>	<u>Rating Date</u>																																				
						[Item 67] Structure Evaluation Rating:	6-EQ TO PRESENT MIN CRITR	10/6/2020																																				
						[Item 68] Deck Geometry Rating:	5-BETTER THAN MINIMUM	4/17/2002																																				
						[Item 69] Underclearance:	4-MEETS MINIMUM TOLERABLE	3/25/2003																																				
Sufficiency Rating:	92.9%	3/7/2024																																										
Deficiency:	NOT DEFICIENT	4/17/2002																																										
Funding Eligibility:		----																																										
Estimated New Structure Length:		----																																										
Estimated Structure Cost:		----																																										
Estimated Total Project Cost:		----																																										
Year of Cost Estimate:		----																																										
						PROBLEM DIRECTION																																						
						OUTFALL INSPECTION INFORMATION																																						
						# OUTFALLS:																																						
						INSPECTOR:																																						
						STATUS:																																						
						DATE:																																						
						NOTES:																																						

MISSOURI STATE HIGHWAY DEPARTMENT

FED. ROAD DIST. NO.	STATE	FED. AID PROJ. NO.	FISCAL YEAR	SHEET NO.	TOTAL SHEETS
5	MO.	11-99(6)	19		

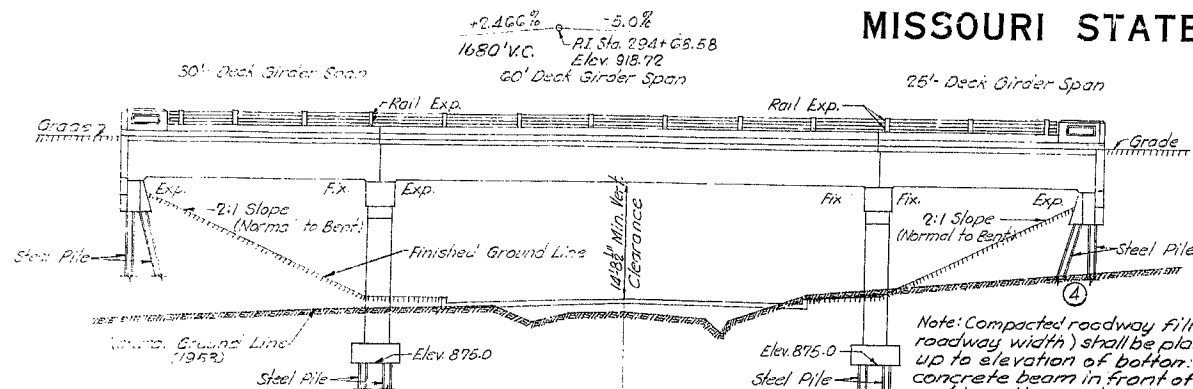


GENERAL ELEVATION

Note: All piling shall be 12" Bearing Pile at 53" and shall conform with details and notes on Sheet No. 2 of design plans. All Steel Pile required for this structure will be furnished by the State. See Special Provisions.

All piles shall be driven to or into solid rock, boulders, shale, or cemented gravel or to not less than full length authorized and to sustain a load of at least 46 ton per pile. All piles shall be driven with a steam hammer.

Note: Compacted roadway fill (Full roadway width) shall be placed up to elevation of bottom of concrete beam in front of and not less than 25' back of End Bents 1 and 4 before steel piles are driven.

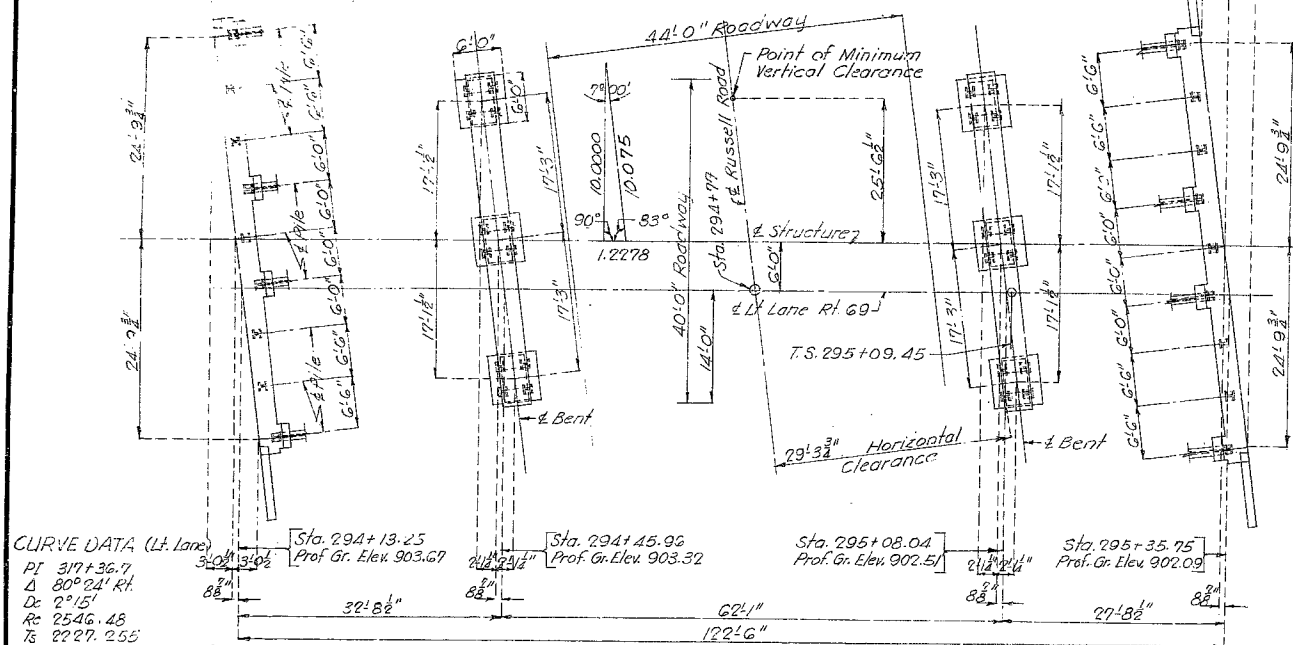


CURVE DATA (L.R. Lane)

PI 317+36.7
 Δ 80° 24' R/L
 DE 2° 15'
 RC 2546.48
 TS 2227.255
 LS 150.00
 K 15.0
 P .37
 SE .04 1/4"

GENERAL NOTES:

Design Specifications A.A.S.H.O. 1953
 Loading H20-S16-44
 Reinforcing Steel Stress 18,000 psi
 Class B Concrete Stress 1,000 psi
 All concrete shall be Class B (Air Entrained)
 Where joint filler is specified on plans it shall conform with the requirements for Gray Rubber Compound Joints as given in section 38-198(2) of the Standard Specifications.
 For requirements on welding electrodes see Special Provisions.
 Surfaces of piles at Bents No. 1 & 4 from bottom of concrete cap to 3'0" below bottom of concrete cap shall be painted with one coat of an approved brand of emulsified asphalt paint. Payment for excavating around piles to 3'0" below bottom of cap and backfilling same, furnishing emulsified asphalt paint and cleaning and painting steel surfaces specified will be included in the unit price bid for other items.
 A rubbed surface finish will be required on all exposed surfaces of concrete end posts above top of curbs.

LOCATION SKETCH

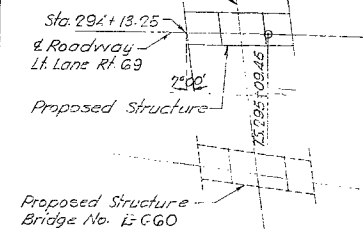

Drawn April 1954 by M.E.L.
 Checked May 1954 by J.E.L.

Note: This drawing is not to scale. Follow dimensions.

COMPLETE BILL OF REINFORCING STEEL



No.	Size	Length	Mark	Location
END BENTS NO. 1 & 4				
6	#4	12'0"	H1	Wing
20	#6	10'6"	H2	"
4	#6	7'0"	H3	"
32	#7	23'6"	H4	Beam
16	#6	28'0"	H5	"
8	#6	14'6"	T1	Wing
8	#6	12'6"	T2	"
184	#5	7'0"	U1	Beam
64	#7	8'9"	U2	"
16	#7	8'3"	U3	"
16	#7	8'0"	U4	"
28	#4	3'3"	U5	"
12	#2	11'3"	V1	Wing
20	#6	9'0"	V2	"
32	#4	8'9"	V3	Beam
INT. BENTS NO. 2 & 3				
48	#2	1'3"	D1	Footling
48	#6	7'6"	D2	"
32	#6	8'6"	F1	Col. Haunch
16	#6	8'6"	F2	"
28	#9	12'3"	G1	Beam
8	#6	21'9"	G2	"
26	#11	22'6"	G3	"
16	#10	22'3"	G4	"
93	#3	10'9"	P1	Col. 18" 2' 45" Bt. 3
72	#5	12'9"	U6	Beam
40	#5	10'9"	U7	"
24	#4	1'3"	U8	"
48	#3	19'3"	V4	Column
SUPERSTRUCTURE				
240	#4	10'9"	B1	Gir. Sp. (1-2) 8(3-4)
235	#4	11'9"	B2	" " (2-3)
15	#11	34'6"	B3	" " (1-2)
4	#9	36'9"	B4	" " "
6	#10	36'9"	B5	" " "
3	#10	29'9"	B6	" " "
30	#11	47'3"	B7	Gir. Sp. (2-3)
30	#11	72'0"	B8	" " "
30	#11	52'3"	B9	" " "
30	#11	19'0"	B10	" " "
15	#11	52'3"	B11	" " "
15	#11	45'8"	B12	" " "
10	#11	38'0"	B13	" " "
10	#11	31'0"	B14	" " "
15	#11	29'6"	B15	Gir. Sp. (3-4)
6	#8	31'9"	B16	" " "
50	#6	4'3"	B17	" (2-3)
40	#6	3'9"	B18	" (1-2) 8(3-4)
210	#4	3'9"	C1	Curb
244	#5	4'6"	C2	"
10	#5	27'6"	C3	Curb. Sp. (1-2)

No.	Size	Length	Mark	Location
Superstructure (Cont'd.)				
20	#5	32'8"	C4	Curb Sp. (2-3)
10	#5	22'6"	C5	Curb Sp. (3-4)
4	#5	7'3"	C6	Flare Curb
4	#5	8'6"	C7	" "
4	#5	6'0"	C8	" "
12	#4	6'0"	R1	End Post
12	#4	6'9"	R2	" "
56	#4	3'9"	R3	" "
432	#5	23'9"	S1	Slab
43	#5	27'0"	S2	Slab Sp. (1-2) 8(3-4)
53	#5	23'6"	S3	" " "
58	#5	24'6"	S4	Slab
8	#5	25'3"	S5	Slab Sp. (1-2) & (3-4)
10	#5	27'3"	S6	" " "
4	#5	33'9"	S7	Slab Sp. (1-2)
5	#5	33'3"	S8	" " "
720	#5	32'3"	S9	Slab Sp. (1-2) (2-3)
56	#5	5'0"	S10	Slab Flare
4	#5	31'0"	S11	Slab Sp. (3-4)
5	#5	32'6"	S12	" " "
84	#5	27'3"	S13	" " "
53	#5	27'6"	S14	Slab Sp. (2-3)
53	#6	23'3"	S15	" " "
10	#5	28'9"	S16	" " "
8	#5	25'6"	S17	" " "
16	#6	41'0"	W1	Wibs
8	#6	23'9"	W2	End Web Sp. (1-2) 8(3-4)
4	#8	41'0"	W3	" " " (2-3)
12	#8	22'3"	W4	" " "
48	#4	20'3"	W5	Wibs
72	#5	8'3"	W6	End Web Sp. (1-2) 8(3-4)
48	#5	12'0"	W7	" " " "
20	#5	12'0"	W8	" " " "
96	#4	13'3"	W9	Int. Web
128	#5	10'0"	W10	End Web

Bending Sketches & Cutting Diagrams


MISSOURI STATE HIGHWAY DEPARTMENT

FED. ROAD DIST. NO.	STATE	FED. AID PROJ. NO.	FISCAL YEAR	SHEET NO.	TOTAL SHEET
5	MO.	VI-9016 P. 62	19		

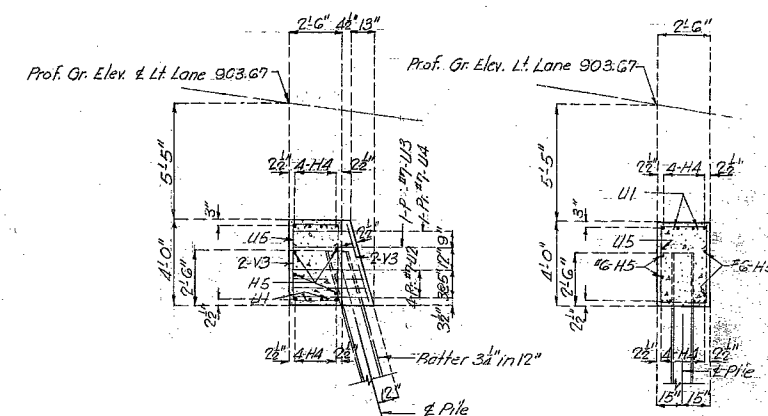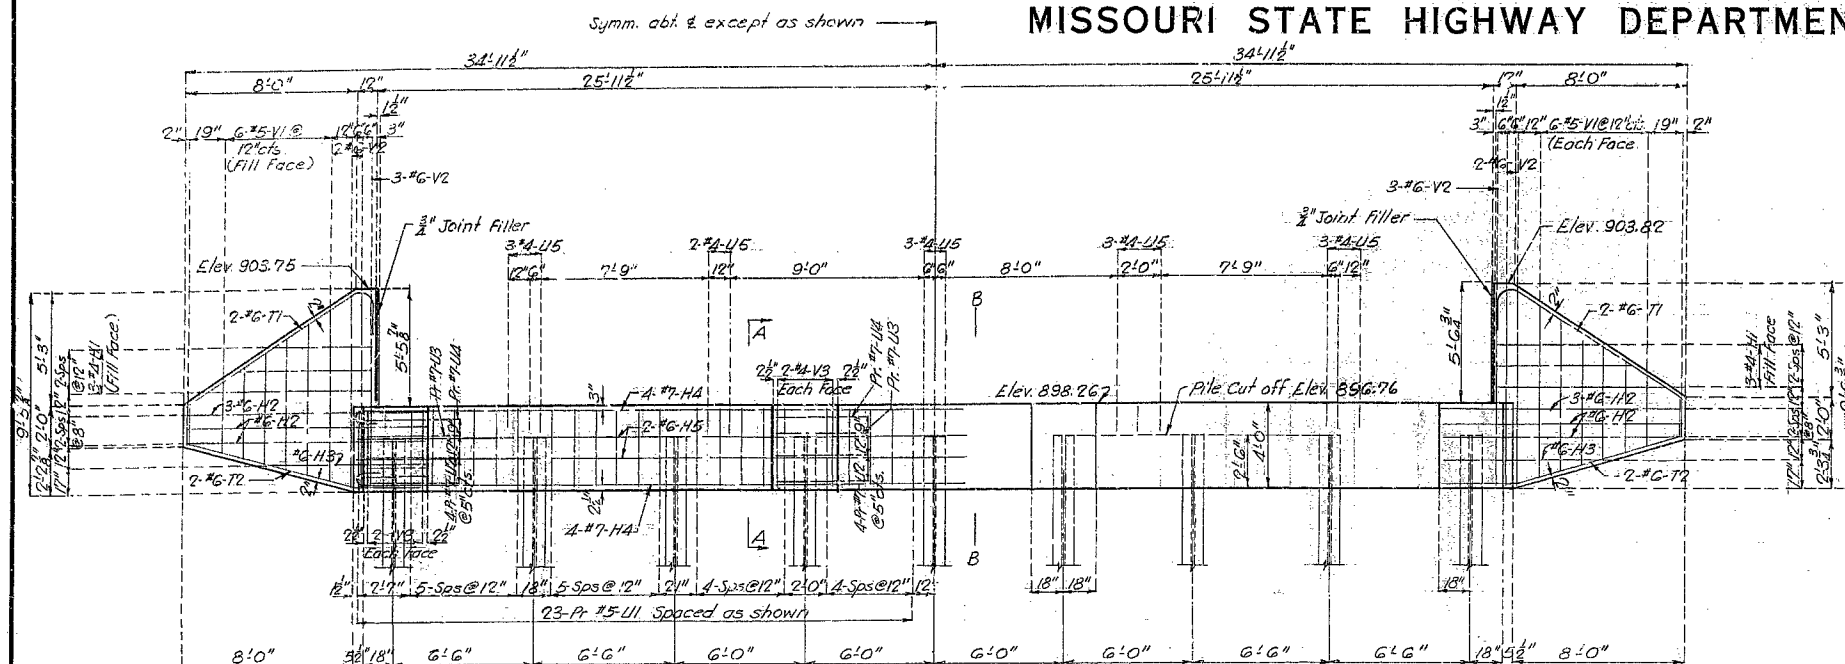


SECTION A-A

SECTION B-B

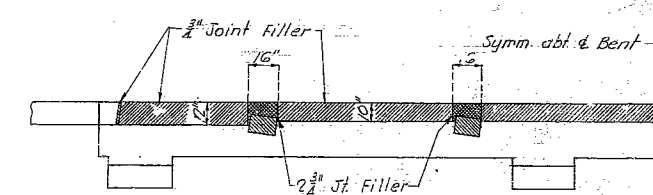


DETAILS OF JOINT FILLER


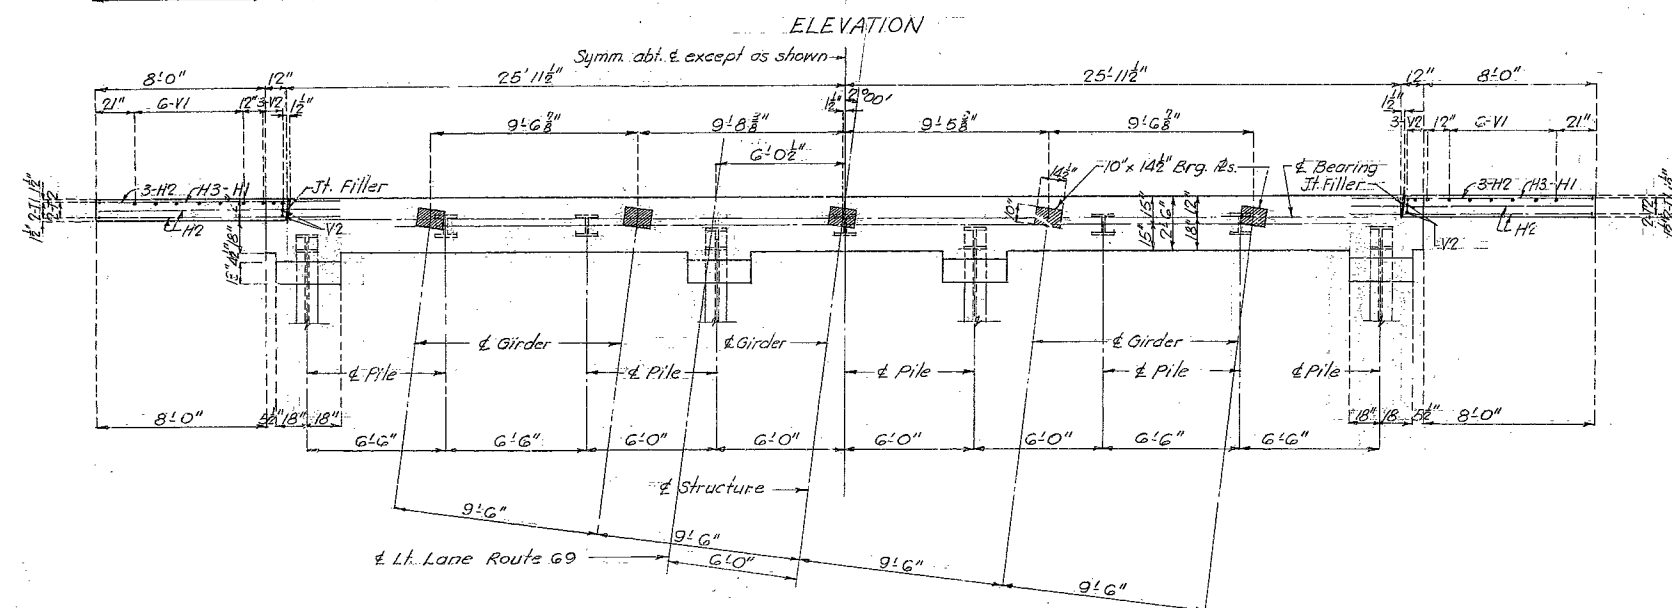


PLAN

DETAILS OF END BENT NO. 1.

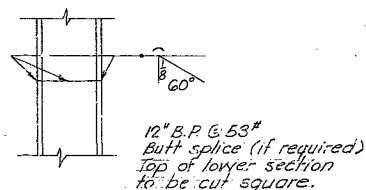

DETAILS OF STEEL PILE

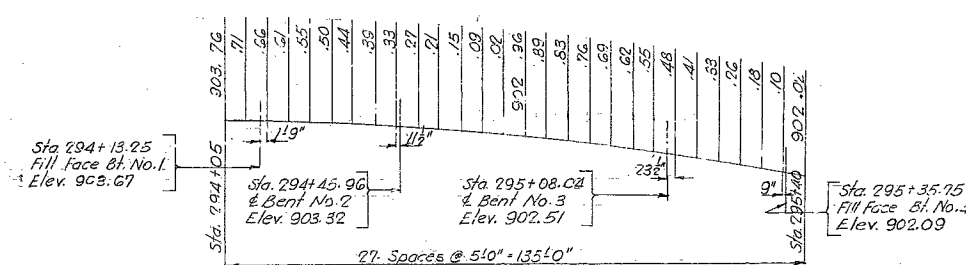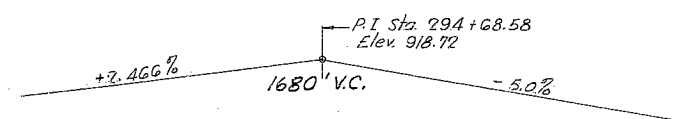

GRADE ELEVATIONS ALONG \pm SURVEY (LT. LANE)

BRIDGE OVER RUSSELL ROAD

STATE ROAD FROM ARMOUR ROAD IN NORTH KANSAS CITY N.E.

ABOUT 2 MILES NORTH OF NORTH KANSAS CITY

PROJECT NO. U-99(6) (RT. 69) STA. 294+13.25 (LEFT LANE)

COUNTY

FINISHED

FINISHE:

L-659

FINISHED CLAY

Drawn April 1954 by M.E.L.
Checked May 1954 by J.E.L.


Note: This drawing is not to scale. Follow dimensions.

Sheet No. 2 of 7.

NO CONSTRUCTION CHANGES

MISSOURI STATE HIGHWAY DEPARTMENT

FED. ROAD DIST. NO.	STATE	FED. AID PROJ. NO.	FISCAL YEAR	SHEET NO.	TOTAL SHEETS
5	MO	U7-89(6) (RT. 69)	19		

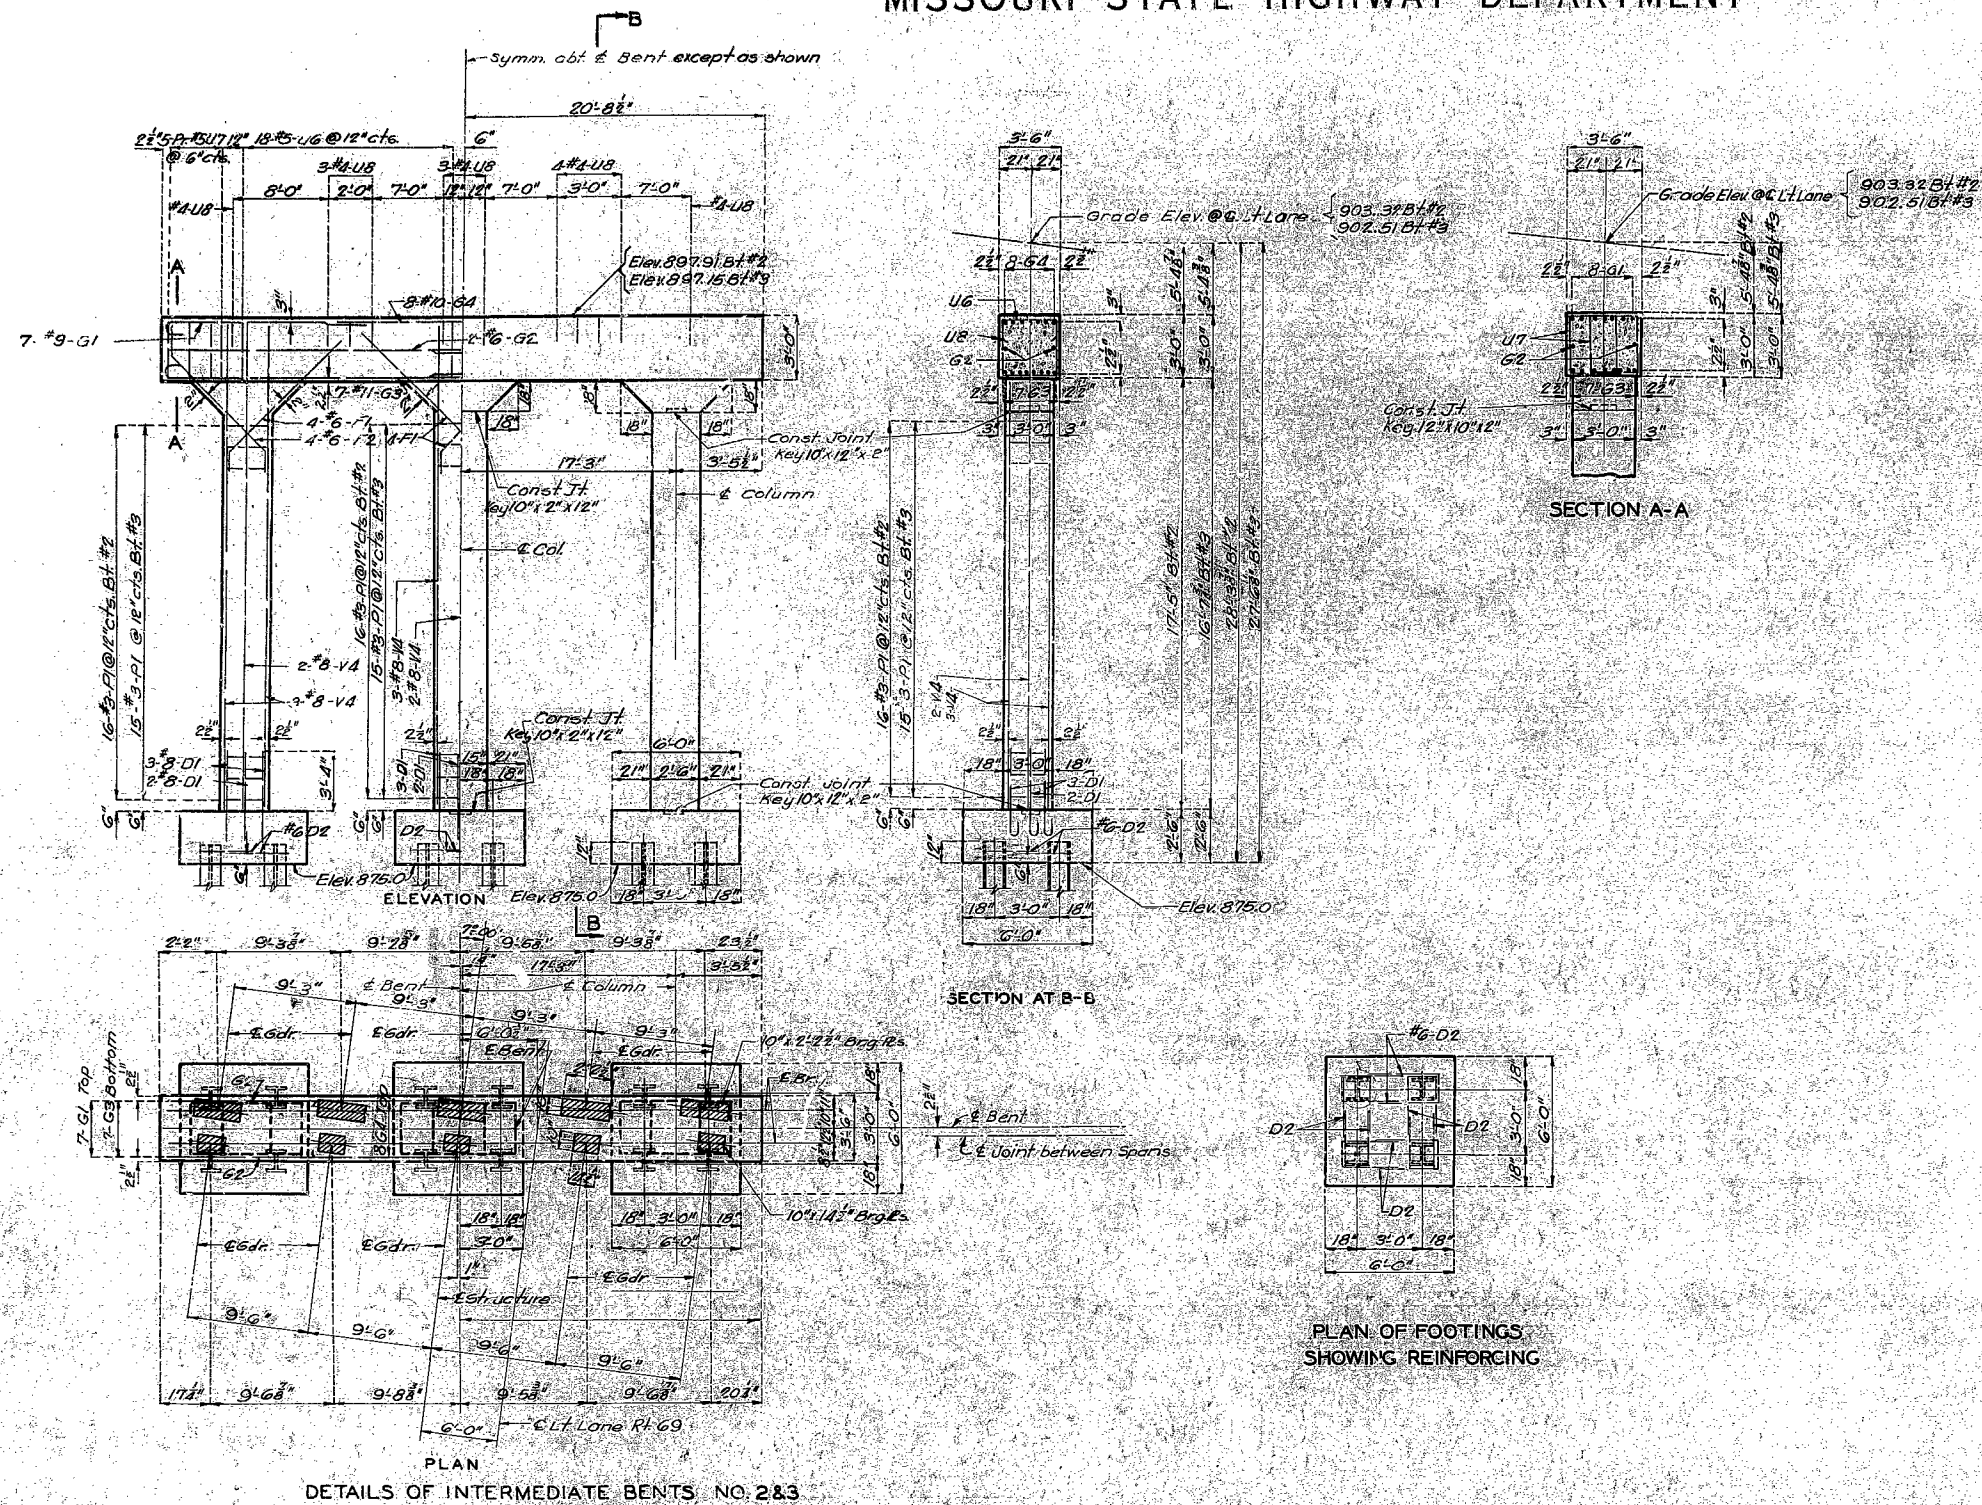

BRIDGE OVER RUSSELL ROAD
STATE ROAD FROM ARMOUR ROAD IN NORTH KANSAS CITY, N.E.
ABOUT 2 MILES NORTH OF NORTH KANSAS CITY
PROJECT NO. U7-99(6) (RT. 69) STA. 294+13.25 (LEFT LANE)

CLAY COUNTY FINISHED

Assembled April 1954 by M.E.L. & M.G.S.
Checked May 1954 by J.E.L.

Note: This drawing is not to scale. Follow dimensions.


Sheet No. 3 of 7

NO CONS. OR CHANGES


L-659

MISSOURI STATE HIGHWAY DEPARTMENT

FED. ROAD DIST. NO.	STATE	FED. AID PROJ. NO.	FISCAL YEAR	SHEET NO.	TOTAL SHEETS
5	MO.	07-99(6) (RT. 69)	19		

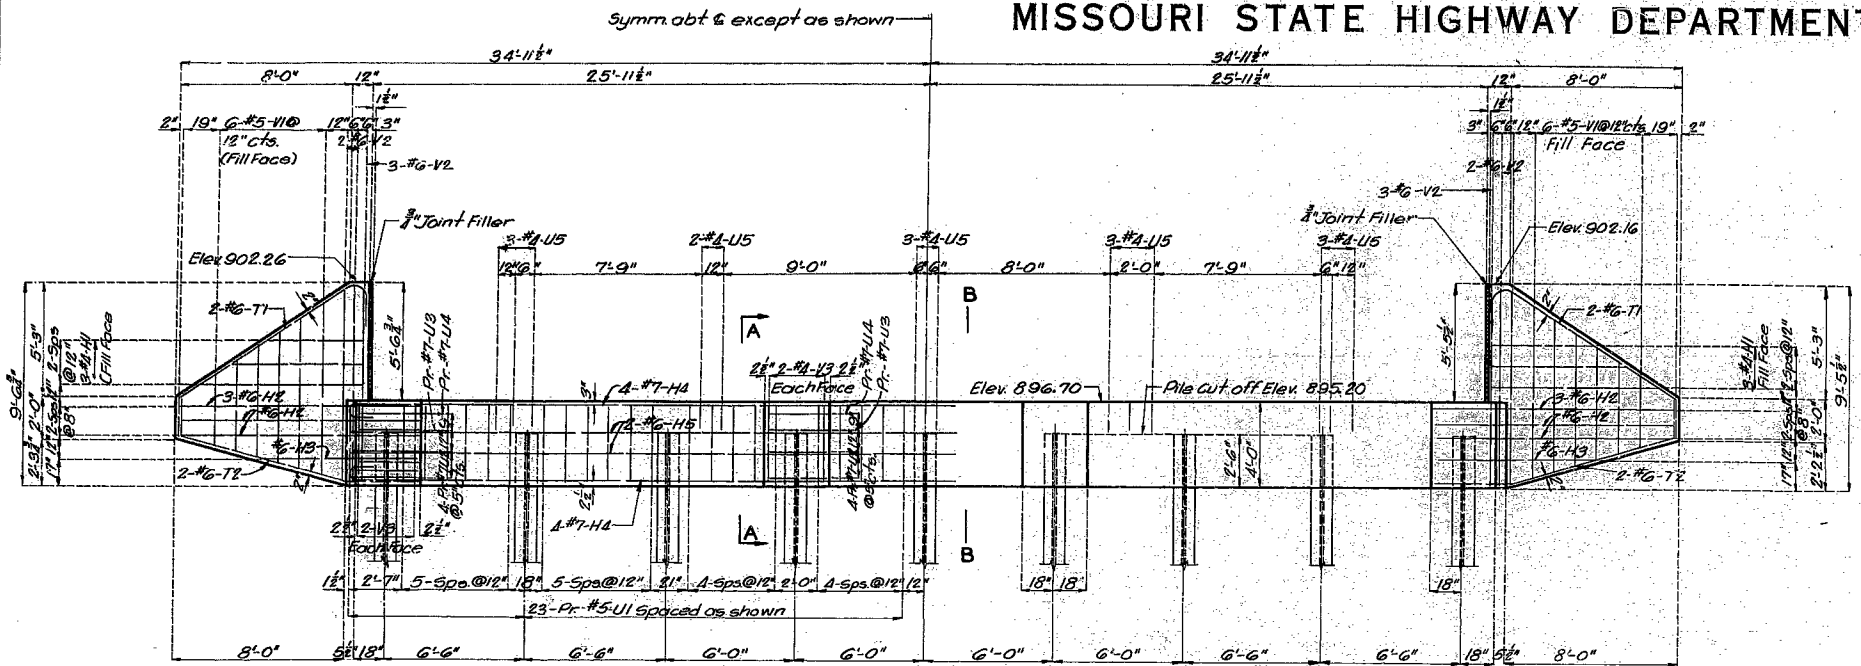


ELEVATION

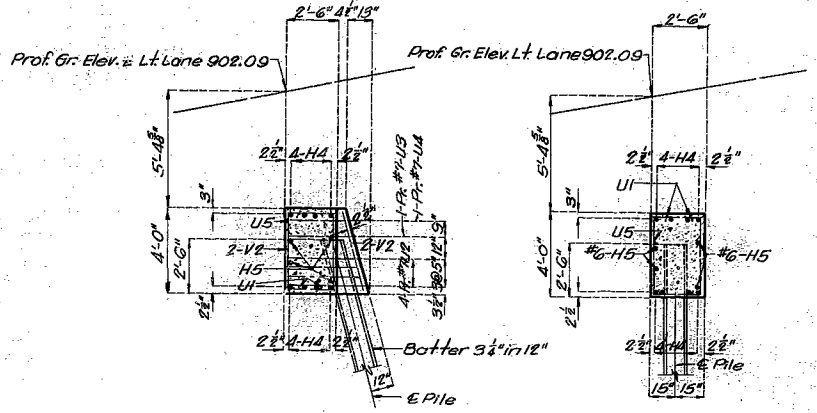


SECTION AA

SECTION BB

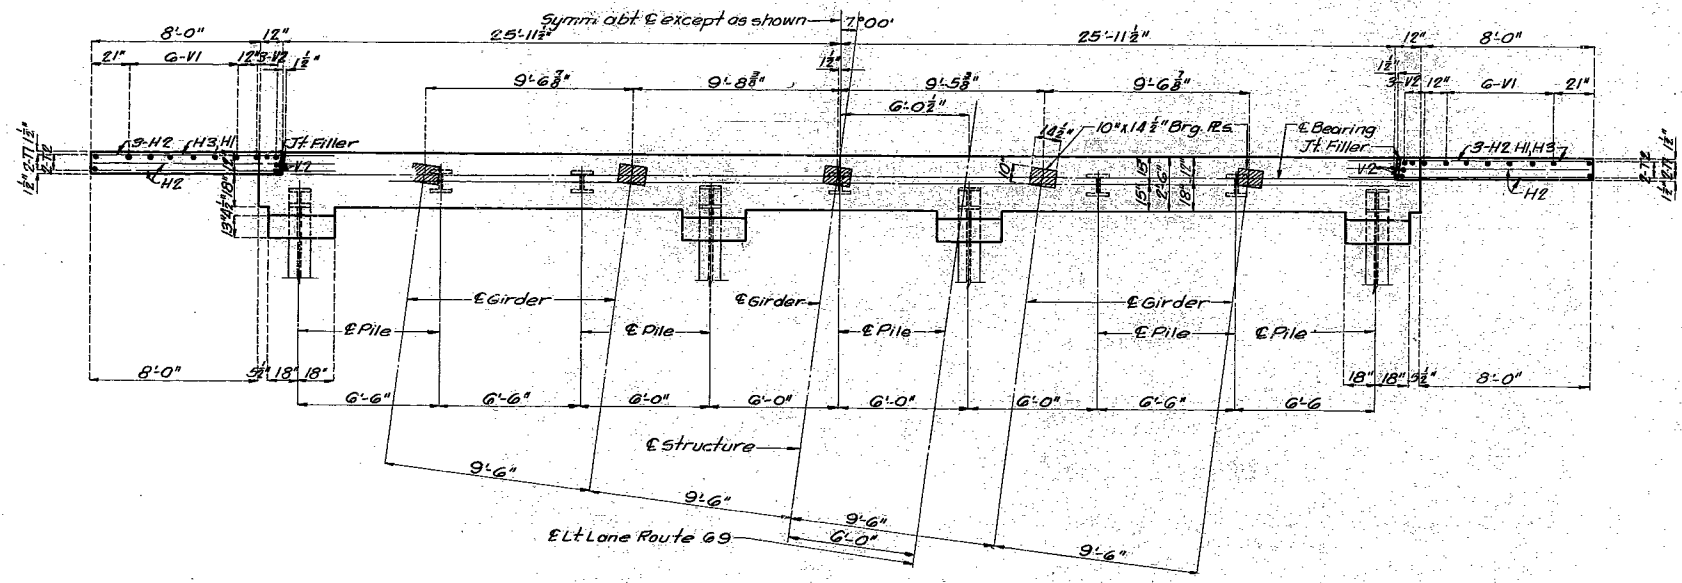

PLAN

DETAILS OF END BENT NO. 4

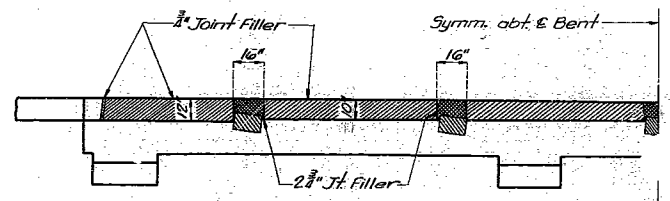

DETAILS OF JOINT FILLER

BRIDGE OVER RUSSELL ROAD
STATE ROAD FROM ARMOUR ROAD IN NORTH KANSAS CITY N.E.
ABOUT 2 MILES NORTH OF NORTH KANSAS CITY
PROJECT NO. UI-99(6) (RT. 69) STA. 294+13.25 (LEFT LANE)

CLAY COUNTY
FINISHED

Drawn April 1954 by M.E.L. & W.G.S.
Checked May 1954 by J.E.L.

Note: This drawing is not to scale. Follow Dimensions


Sheet No. 4 of 7

NO CONSTRUCTION CHANGES

L-659


MISSOURI STATE HIGHWAY DEPARTMENT

FED. ROAD DIST. NO.	STATE	FED. AID PROJ. NO.	FISCAL YEAR	SHEET NO.	TOTAL SHEETS
5	MO.	UI-99(6) (RT. 69)	19		


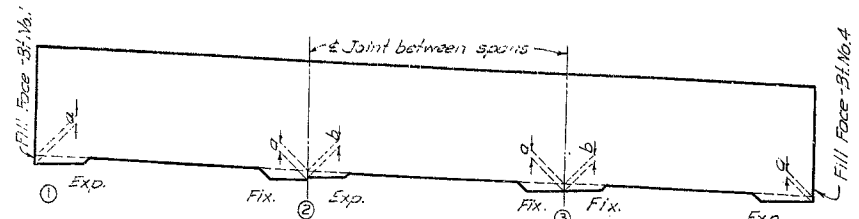


DETAILS OF GIRDER HAUNCHES


Girder	GIRDER HAUNCHES			
	Bl. No. 1	Bl. No. 2	Bl. No. 3	Bl. No. 4
1	1"	1"	1"	1"
2	2"	2"	2"	2"
3	3"	3"	3"	3"
4	4"	4"	4"	4"
5	5"	5"	5"	5"

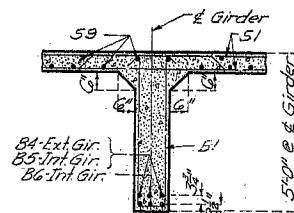


SECTION THRU GIRDER

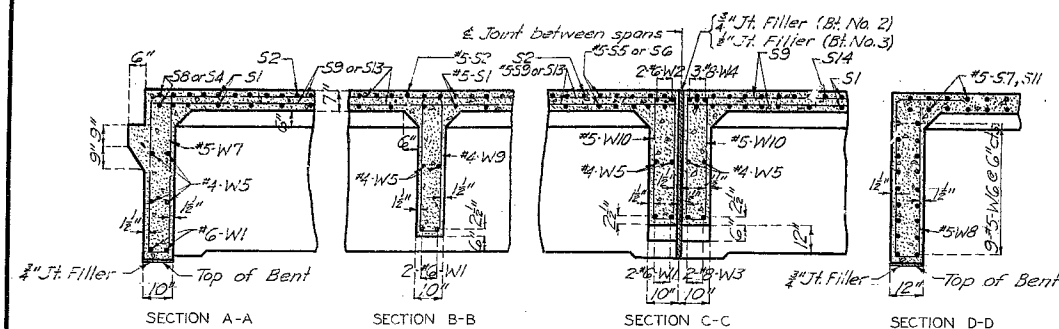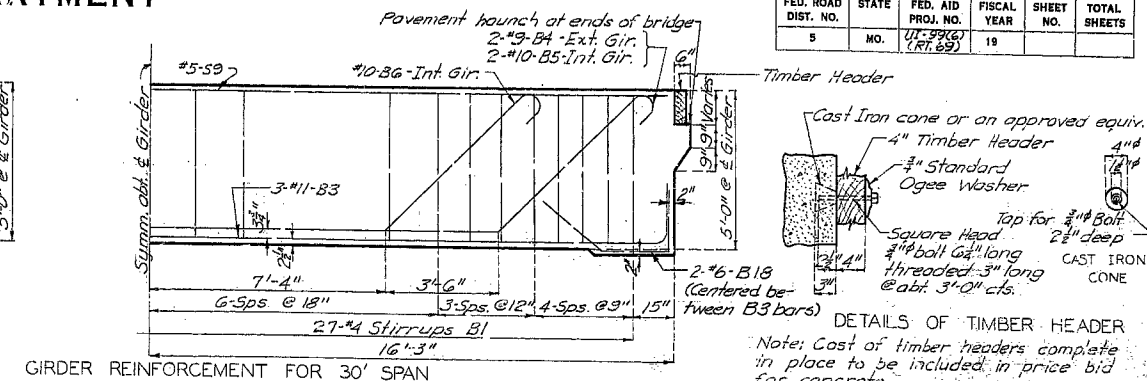


Part Longitudinal Section
Note: See sheet 6 of 7 for location of sections.

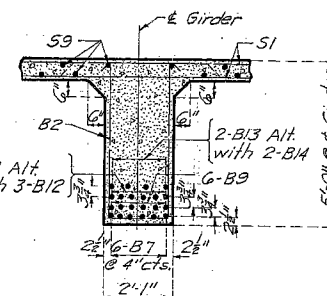

SECTION THRU GIRDER AT

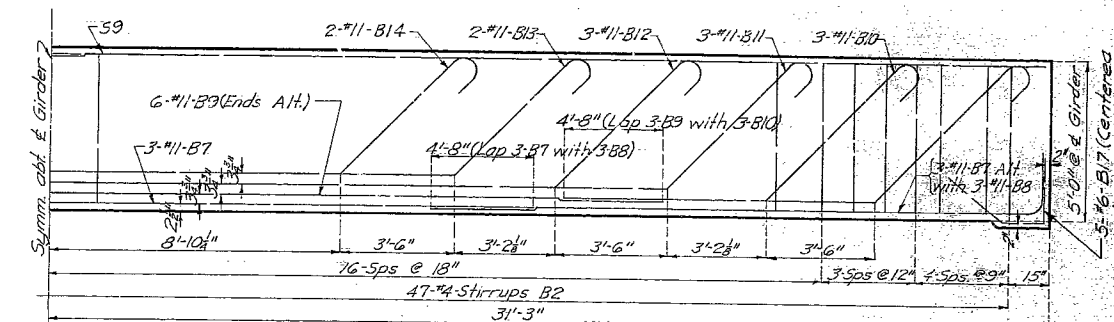


GIRDER REINFORCEMENT FOR 60' SPAN

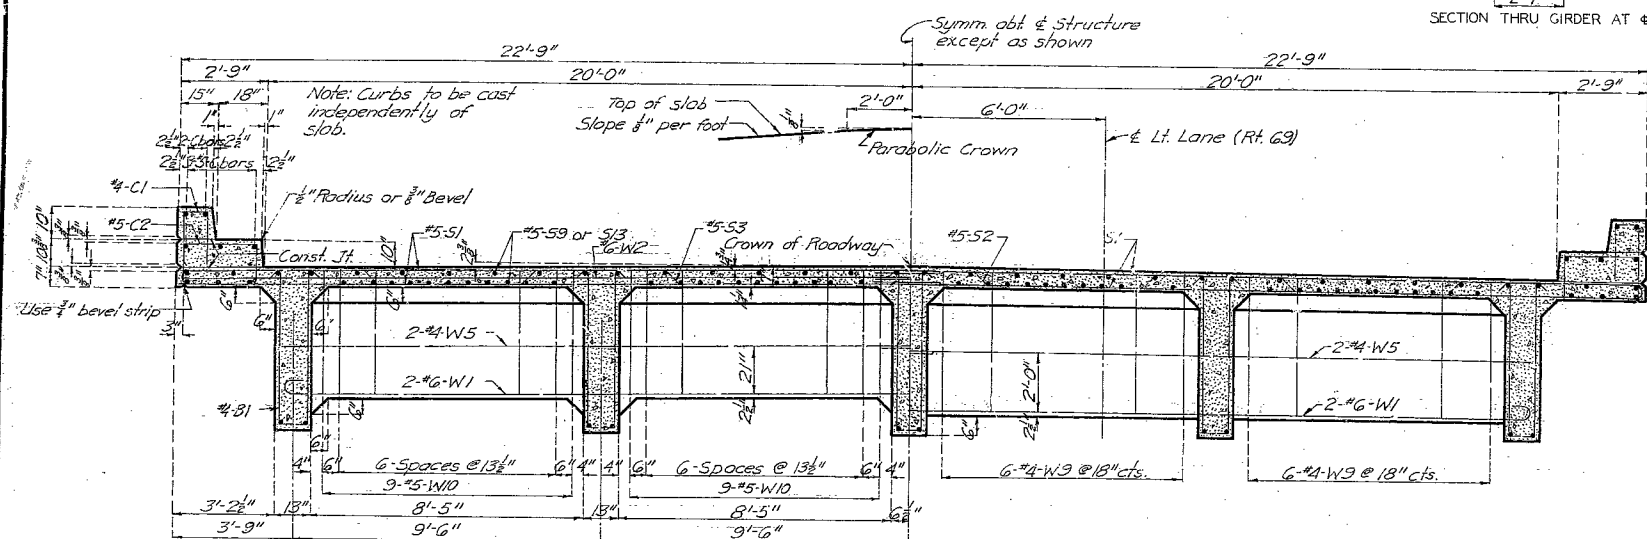

Note: Stirrups W10 to be placed parallel to roadway.

HALF SECTION THRU SPANS (1-2) & (3-4)
(Near Intermediate Bent)


HALF SECTION THRU SPANS (1-2) & (3-4)
(Near Intermediate Web)

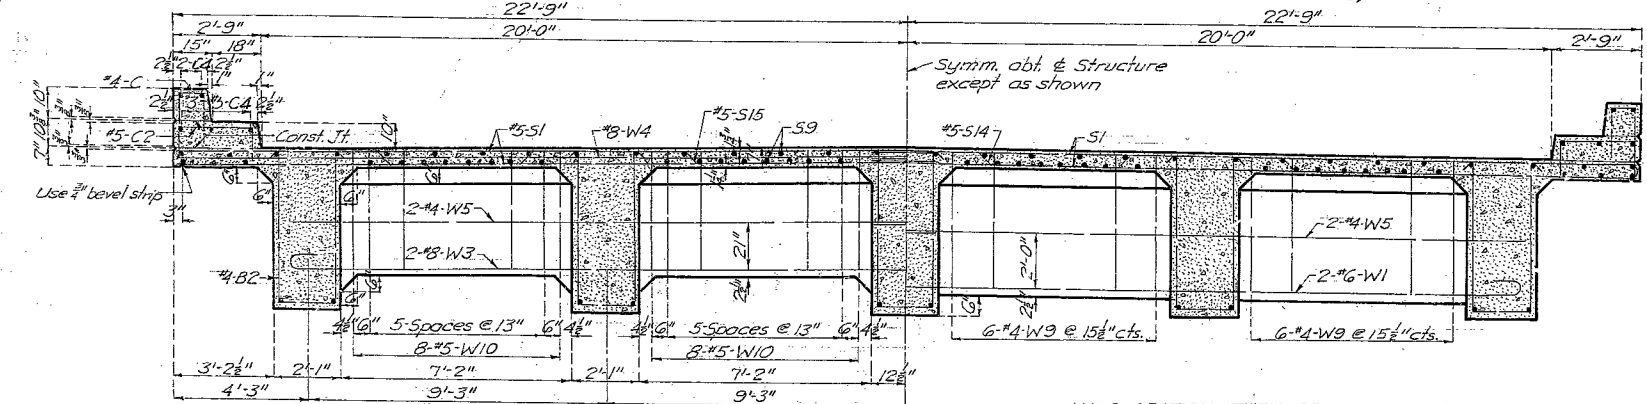


HALF SECTION THRU SPAN (2-3)
(Near Intermediate Bent)

HALF SECTION THRU SPAN (2-3)
(Near Intermediate Web)

Note: This drawing is not to scale. Follow dimensions.

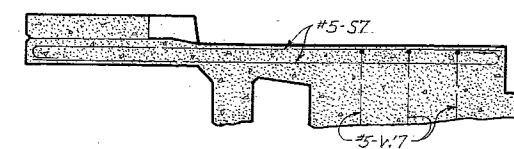


PART SECTION E-E
Note: See sheet 6 of 7 for location of section

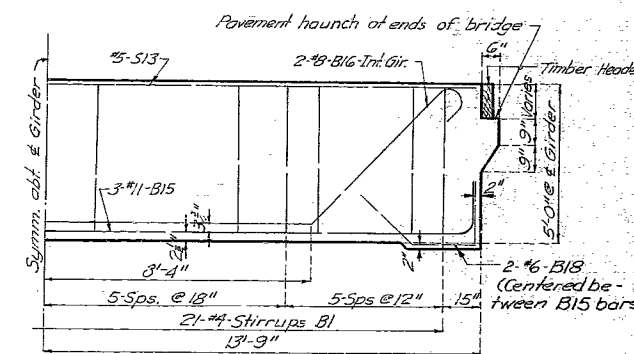


GIRDER REINFORCEMENT FOR 25' SPAN


BRIDGE OVER RUSSELL ROAD
STATE ROAD FROM ARMOUR ROAD IN NORTH KANSAS CITY N.E.
ABOUT 2 MILES NORTH OF NORTH KANSAS CITY
PROJECT NO. UI-99(6)(RT. 69) STA. 294+13.25 (LEFT LANE)
CLAY COUNTY FINISHED

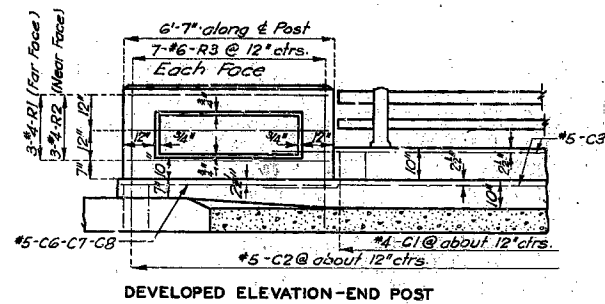

DEVELOPED ELEVATION-END POST

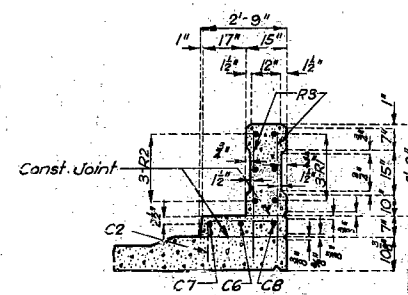

SECTION B-B

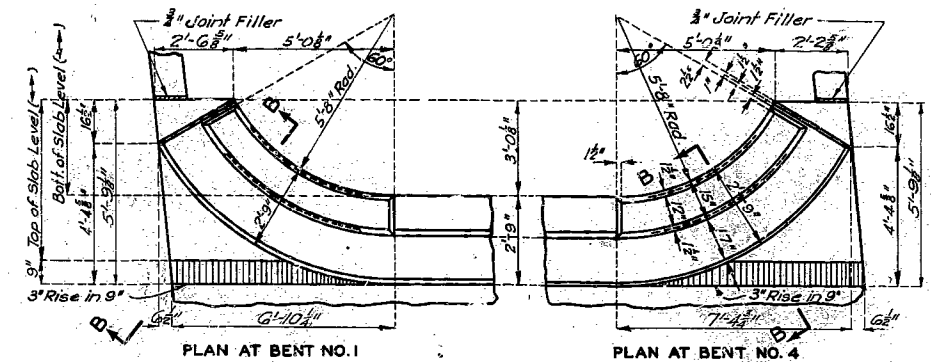


PLAN AT BENT NO. 1

PLAN AT BENT NO. 4

[illegible]


ELEVATION

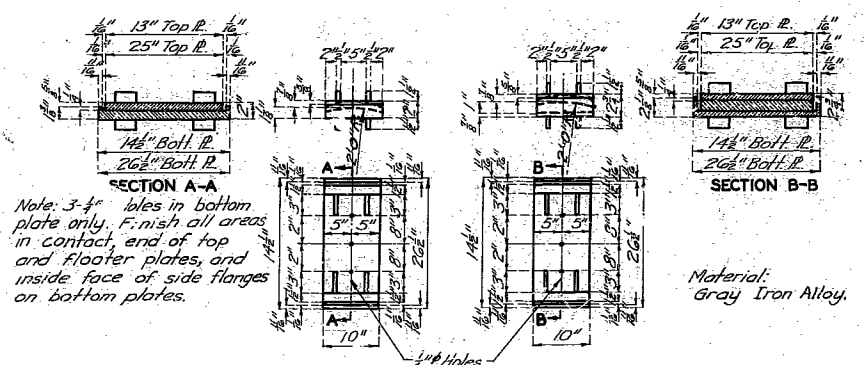


Material:
Gray Iron Alloy.

FIXED END	EXP. END
GRAY IRON ALLOY BEARING PLATES	

Note: Bearing plates to be furnished in sets. Each set consisting of 1 top and 1 bottom plate for fixed end and 1 top plate, 1 floatier plate and 1 bottom plate for expansion end.
Required: 10-Sets 10" x 13" plates.
5-Sets 10" x 25" plates.

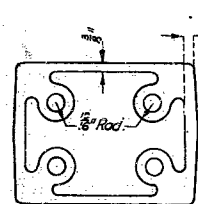

SECTION A-A

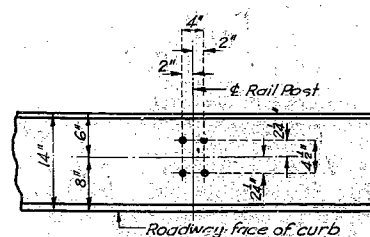

TYPICAL ANCHOR BOLT PLAN
DETAILS OF HANDRAIL

Note: All parts of hindrail except steel anchor bolts and their washers and nuts to be aluminum. Bolt holes in tubes to be 1/4" x 1/4" slotted holes centered on both ends. Ambient temperature of 55° except, at expansion posts where holes shall be 1/4" x 1/4" slots.

Aluminum washer slips between Fabreka pad and post base may be used for adjusting rail alignment. Maximum thickness of shim to be 3/8". Where more tilting of post is required for proper alignment, concrete bearing area shall be ground down.

Drawn Apr. 1954 By M.H.P.
Traced Apr. 1954 By M.H.P.
Checked May 1954 By J.E.L.

Note: This drawing is not to scale. Follow dimensions

Sheet No. 7 of 7

NO CONSTRUCTION CHANGES

BRIDGE OVER RUSSELL ROAD

STATE ROAD FROM ARMOUR ROAD IN NORTH KANSAS CITY N.E.
ABOUT 2 MILES NORTH OF NORTH KANSAS CITY
PROJECT NO. UI-99(6) (RT. 69) STA. 294+13.25(LEFT LANE)


FURNISHED CLAY

COUNTY

FINAL

L-659

FED. ROAD DIST. NO.	STATE	FED. AID PROJ. NO.	FISCAL YEAR	SHEET NO.	TOTAL SHEETS
5	NO.	41-9916 (RT. 69)	19		

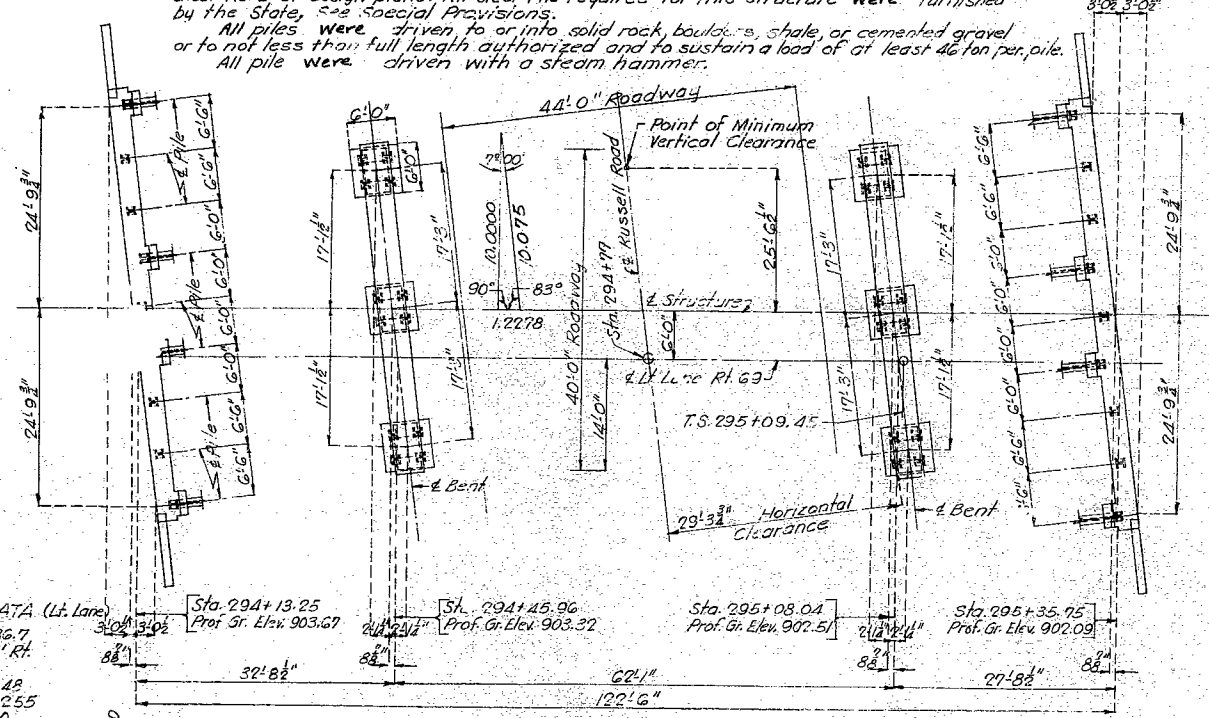

CURVE DATA (Lt. Lane)

PI 317+36.7
Δ 80° 24' RT.
DC 2° 5'
RC 2546.43
TS 2227.255
LS 150.00
K 75.0
P .37
SE .04 1/4 ft.

310M
881
ELL ROAD

Sta. 294+13.25
 & Roadway
 Lt. Lane Rt. 69

Structure

Structure
 Bridge No. 13-660

LOCATION SKETCH

COMPLETE BILL OF REINFORCING STEEL

END BENTS NO. 1 & 4

No.	Size	Length	Mark	Location
6	#4	12'0"	H1	Wing
20	#6	10'6"	H2	"
4	#6	7'0"	H3	"
32	#7	29'6"	H4	Beam
16	#6	28'0"	H5	"
8	#6	14'6"	F1	Wing
8	#6	12'6"	F2	"
184	#5	7'0"	U1	Beam
64	#7	8'9"	U2	"
16	#7	8'3"	U3	"
16	#7	8'0"	U4	"
28	#4	3'3"	U5	"
12	#5	11'3"	V1	Wing
20	#6	9'0"	V2	"
32	#4	3'9"	V3	Beam

INT. BENTS NO. 2 & 3

No.	Size	Length	Mark	Location
48	#3	6'3"	D1	Footings
48	#6	7'6"	D2	"
32	#6	8'0"	F1	Col. Haunch
16	#6	5'6"	F2	"
28	#9	12'3"	G1	Beam
8	#6	21'9"	G2	"
28	#11	24'6"	G3	"
16	#10	27'3"	G4	"
93	#3	10'9"	P1	Col. 48 B/2 45 B/3
72	#5	12'9"	U6	Beam
40	#5	10'9"	U7	"
24	#4	4'3"	U8	"
48	#8	19'3"	V4	Column

SUPERSTRUCTURE

No.	Size	Length	Mark	Location
240	#4	10'9"	B1	Gir. Sp. (1-2) (3-4)
235	#4	11'2"	B2	" " (2-3)
15	#11	34'6"	B3	" " (1-2)
4	#9	36'9"	B4	" " "
6	#10	36'9"	B5	" " "
3	#10	29'9"	B6	" " "
30	#11	47'3"	B7	Gir. Sp. (2-3)
30	#11	22'0"	B8	"
30	#11	52'3"	B9	"
30	#11	19'0"	B10	"
15	#11	52'3"	B11	"
15	#11	45'3"	B12	"
10	#11	38'0"	B13	"
10	#11	31'0"	B14	"
15	#11	29'6"	B15	Gir. Sp. (3-4)
6	#8	31'9"	B16	"
50	#6	4'3"	B17	" (2-3)
40	#6	3'9"	B18	" (1-2) (3-4)
216	#4	3'9"	C1	Curb
224	#5	4'6"	C2	"
10	#5	27'6"	C3	Curb Sp. (1-2)

Bending Sketches & Cutting Diagrams

FINAL QUANTITIES		FINAL PLANS	
Item	Substr.	Super str.	Total
Class I Excavation for Structures	Cu.Yds.	164.5	164.5
Class B Concrete	Cu.Yds.	132.9	498.3
Reinforcing Steel	Lbs.	20120	84870
Gray Iron Alloy Castings	Lbs.		8610
Aluminum Alloy Handrail	Lin. Ft.		215
Steel Piling in Place (Sole furnished)	Lin. Ft.	1201	1201

B.M. Elev. 902.15 on top of Right Wing Bent #4

BRIDGE OVER RUSSELL ROAD

STATE ROAD FROM ARMOUR ROAD IN NORTH KANSAS CITY N.E.
ABOUT 2 MILES NORTH OF NORTH KANSAS CITY
PROJECT NO. UI-99(6) (RT.69) STA. 294+13.25 (LEFT LANE)

CLAY COUNTY

SUBMITTED BY J. A. Williams DATE 6/2/1954
SENIOR ENGINEER
 APPROVED BY Rex M. Patton DATE 6/10/1954
CHIEF ENGINEER

FINISHED

FINISHED



STD. C-110 R3
L-659

FINAL PLANS

Sheet No. 1A of 1.

MISSOURI HIGHWAY AND TRANSPORTATION COMMISSION

FED. ROAD DIST. NO.	ST.ITE	FED. AID PROJ. NO.	FISCAL YEAR	SHEET NO.	TOTAL SHEETS
5	MO.		19	30	
SEC. 1 & 12 TWP. 50N					RGE. 33W

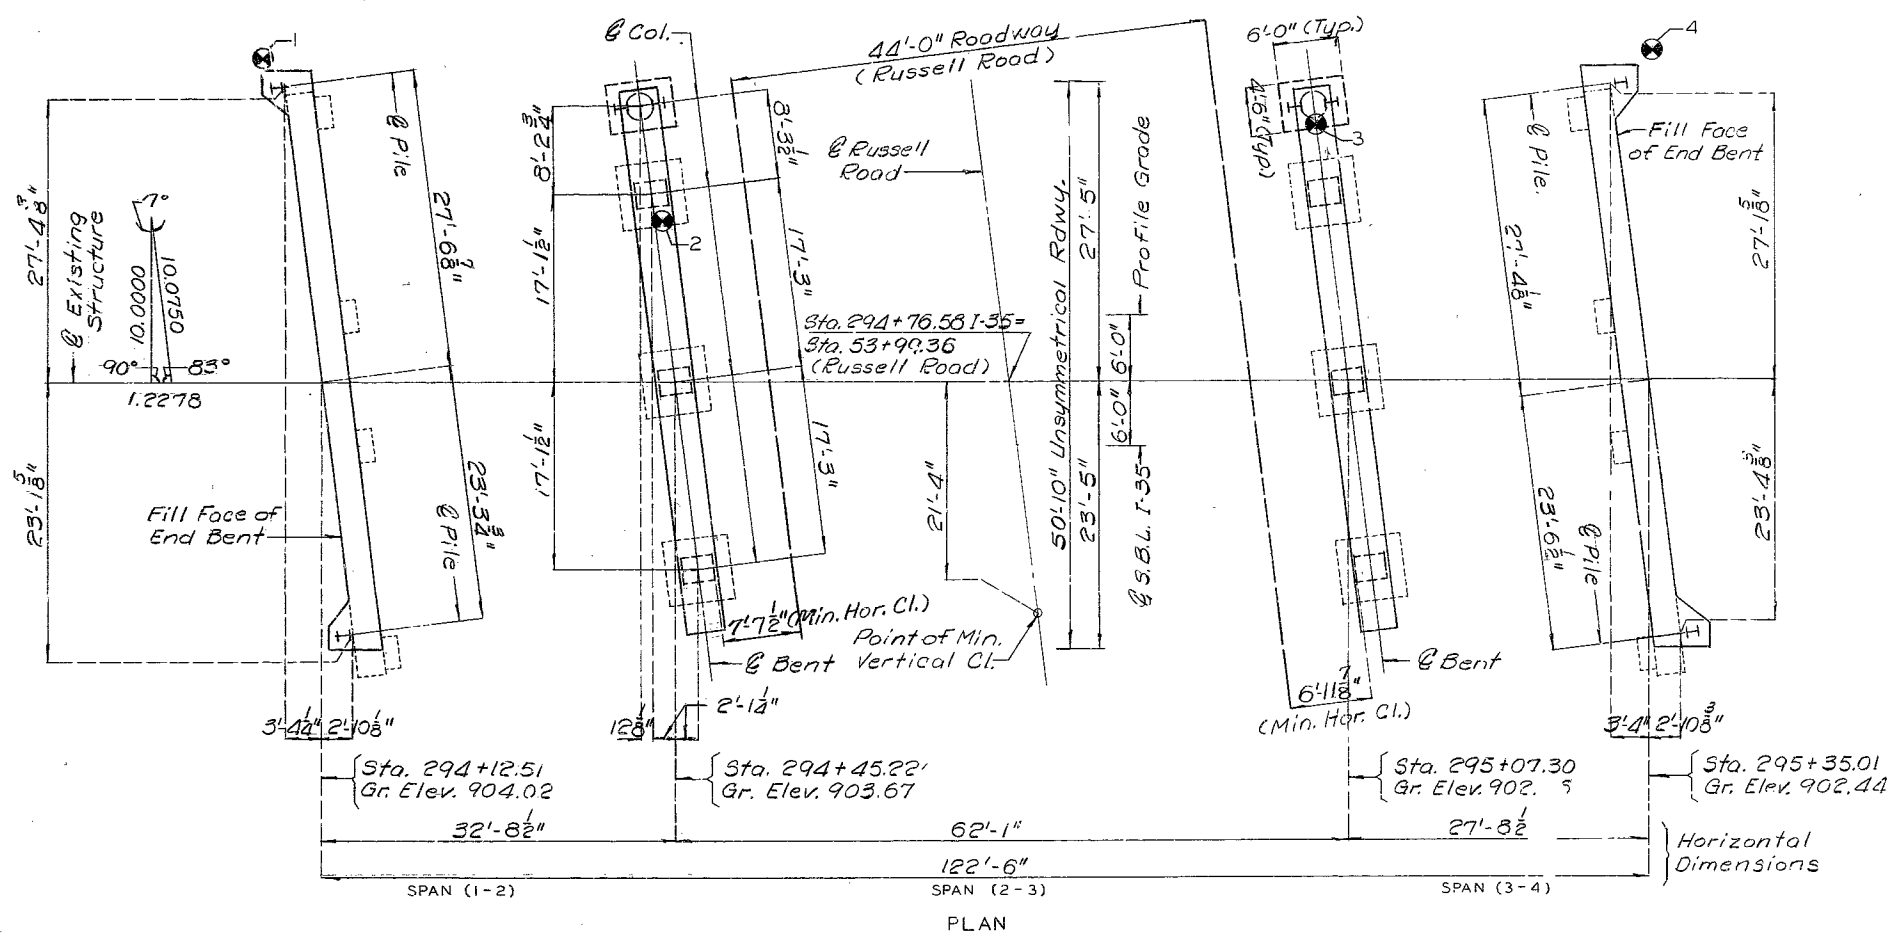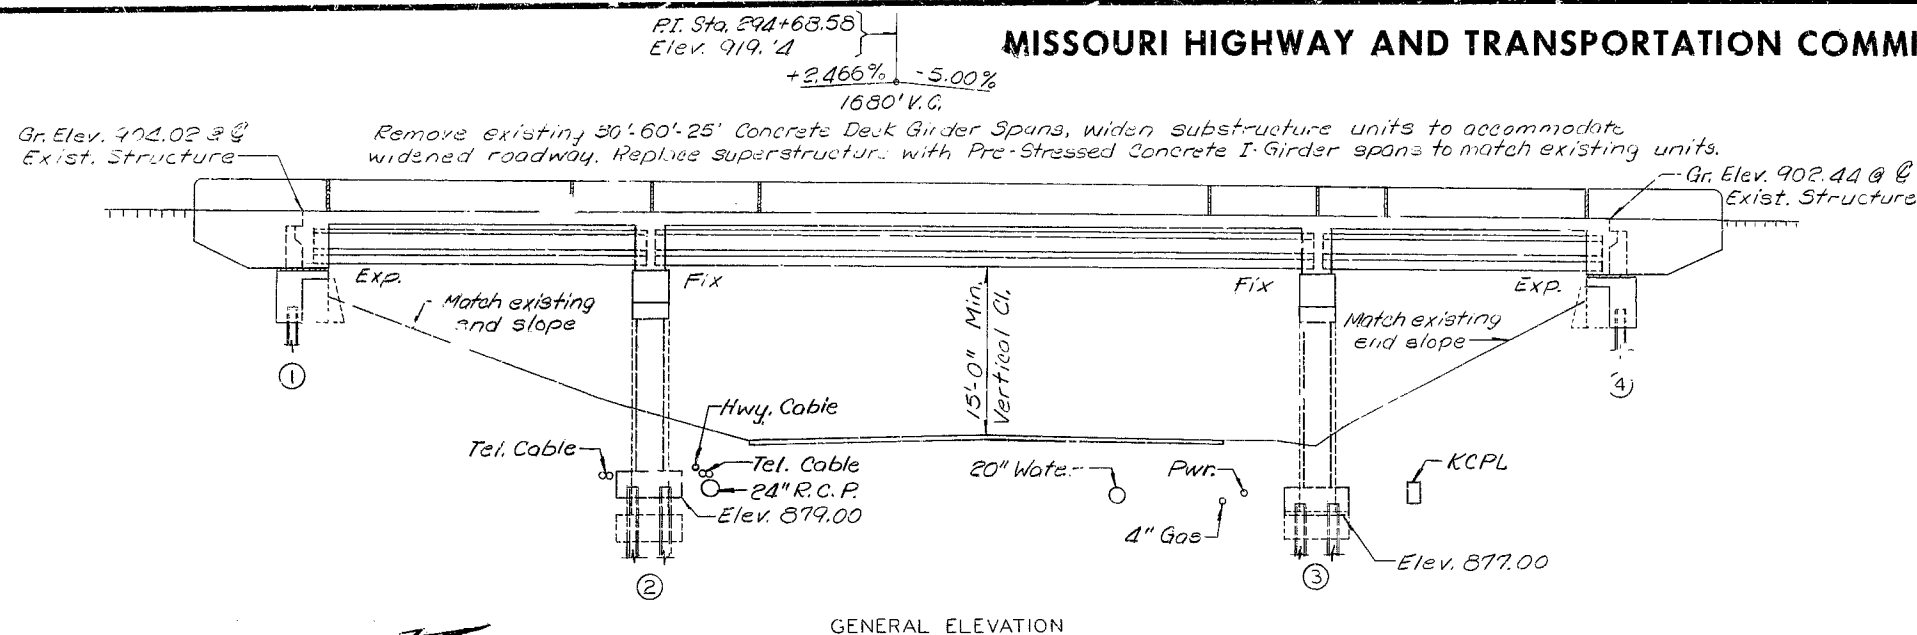

Note:
 "⊙" Indicates location of Borings.
 For Boring Data see Sht. No. 2.

Note:
 For Estimated Quantities and
 Pile & Footing Data see Sht. No. 2.

Note: This drawing is not to scale. Follow dimensions.

GENERAL NOTES:

Design Specifications: A.R.S.H.T.O. - 1977 Load Factor Design and Interim Specifications 1980

Design Loading:

H320-14
 15 # per sq. ft. Future Wearing Surface
 Modified 21,000 # Tandem Axle
 Earth 120 #, Equivalent Fluid Pressure 30 #
 Superstructure: Simply supported
 non-composite for Dead Load. Continuous
 composite for Live Load.

Design Unit Stresses:

Class B Concrete (Substructure) $f'_c = 3,000$ psi
 Class B1 Concrete (Safety Barrier Curb) $f'_c = 4,000$ psi
 Class B2 Concrete (Superstructure except
 Prestressed Girders and Safety Barrier
 Curb) $f'_c = 4,000$ psi
 Reinforcing Steel (Grade 60) $f_y = 60,000$ psi
 Steel Pile $f_b = 9,000$ psi

For Pre-stressed Girder Stresses see
 Sheet Nos. 6, 7 and 8.

Bearings shall be 60 durometer Neoprene
 Pads.

Joint Filler: All Joint Filler shall meet
 the requirement of Std. Spec. 1057.2.4.

Reinforcing Steel: Minimum clearance to
 reinforcing steel shall be $\frac{1}{2}$ " unless
 otherwise shown.

Construction Clearance: A minimum vertical
 clearance of 13'-6" from crown of
 existing lanes and a minimum lateral
 clearance of 33'-0" centered on
 existing lanes shall be maintained
 during construction.

Outline of old work is indicated by light
 dashed lines. Heavy lines indicate
 new work.

Cost of furnishing, fabricating and installing
 Neoprene Bearing Pads complete in place,
 shall be paid for at the contract unit
 price for Plain and Laminated Neoprene
 Bearing Pads per each.

B.M. Elev. 902.15 @ On Top of Rt Wing Bent
 No. 4 Sta. 295+35.75

BRIDGE OVER RUSSELL ROAD

STATE ROAD FROM RTE. 210 NORTH

IN KANSAS CITY

PROJECT NO. 1-1R-35-1(120)

STA. 294+12.51

JOB NO. 4-1-35-340

RTE. 1-35 S.B.L.

CLAY

COUNTY

DATE 1/13/83

STD.
STD. 706.35
L-659R

DESIGNED AUG. 1981
 DETAILED NOV. 1981
 CHECKED DEC. 1981

Sheet No. 1 of 121.

306

ESTIMATED QUANTITIES			
ITEM		SUBSTR	TOTAL
Special Work	Lump Sum	1	1
Removal Of Existing Bridge Deck	Sq. Ft.	5,574	5,574
Class 1 Excavation	Cu. Yd.	35	35
Structural Steel Piles (10 in.)	Lin. Ft.	244	244
Class B Concrete	Cu. Yd.	68.3	68.3
Reinforcing Steel	Pound	9,300	9,300
() Slab On Concrete I-Girder "*"	Sq. Yd.	728	728
Safety Barrier Curb	Lin. Ft.	285	285
Plain Neoprene Bearing Pads	Each	24	24
Laminated Neoprene Bearing Pads	Each	12	12
Prestressed Concrete T-Girder 30 Ft. Span Each		6	6
Prestressed Concrete T-Girder 60 Ft. Span Each		6	6
Prestressed Concrete T-Girder 25 Ft. Span Each		6	6


Note:
All concrete and reinforcement above lower construction joint in end bents are included with superstructure quantities.
Cost of $\frac{3}{4}$ " ϕ coil tie rods placed in diaphragms is included in contract unit price for P/S members.
"*" See Special Provisions.

ESTIMATED QUANTITIES FOR ALTERNATE SLABS			
TYPE OF SLABS	Slab on Conc. I-Girder		
	Reinf. (Lbs.)	Conc.	
	Epoxy	Plain	Cu. Yd.
Cast-In-Place Conventional Forms	28,680	26,580	256.7
Precast Panel Forms	28,680	7,590	219.2
Stay-In-Place Forms "*" "	28,680	26,580	256.7

The table of Estimated Quantities for Alternate Slabs represents the quantities used by the state in preparing the cost estimate for concrete slabs. Variations may be encountered in these estimated quantities but these variations cannot be used for an adjustment in the Contract Unit Price per square yard of Alternate Slab Used.
See Special Provisions for alternate methods of forming slabs.
Precast panel quantities based on skewed end panels.
"*" Does not include concrete required to fill corrugation of S.I.P. forms.


FED. ROAD DIST. NO.	STATE	FED. AID PROJ. NO.	FISCAL YEAR	SHEET NO.	TOTAL SHEETS
5	MO.		19	31	

Note: For location of Borings see sheet No. 1.

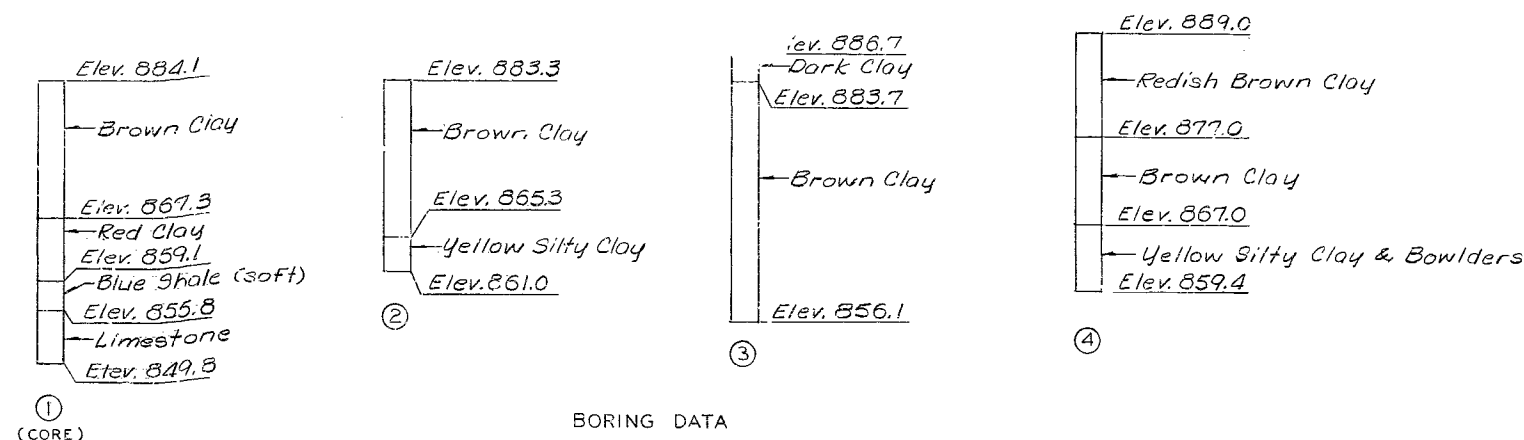

PILE DATA				
BENT NO.	1	2	3	4
Pile Type and size	HP10x42	HP10x42	HP10x42	HP10x42
Number	2	2	2	2
Approximate length Ft.	40	24	22	36
Design Bearing Tons	24	43	43	24
Hammer Energy required Ft. lbs	7,000	9,600	7,600	7,000

Minimum energy requirement of hammer based on plan length and design bearing value of piles.
All pile shall be driven to practical refusal.

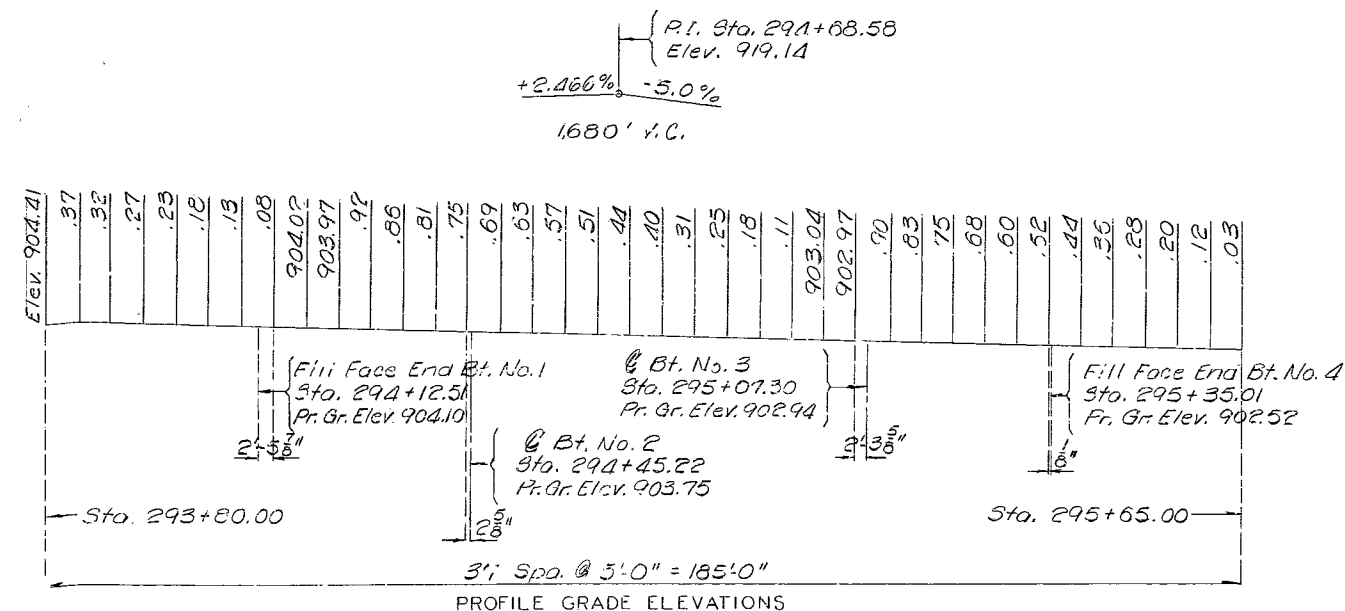


DETAILED Nov. 19 81
CHECKED Nov. 19 81

Note: This drawing is not to scale. Follow dimensions.

Sheet No. 2 of 14.


CLAY COUNTY

L-659R

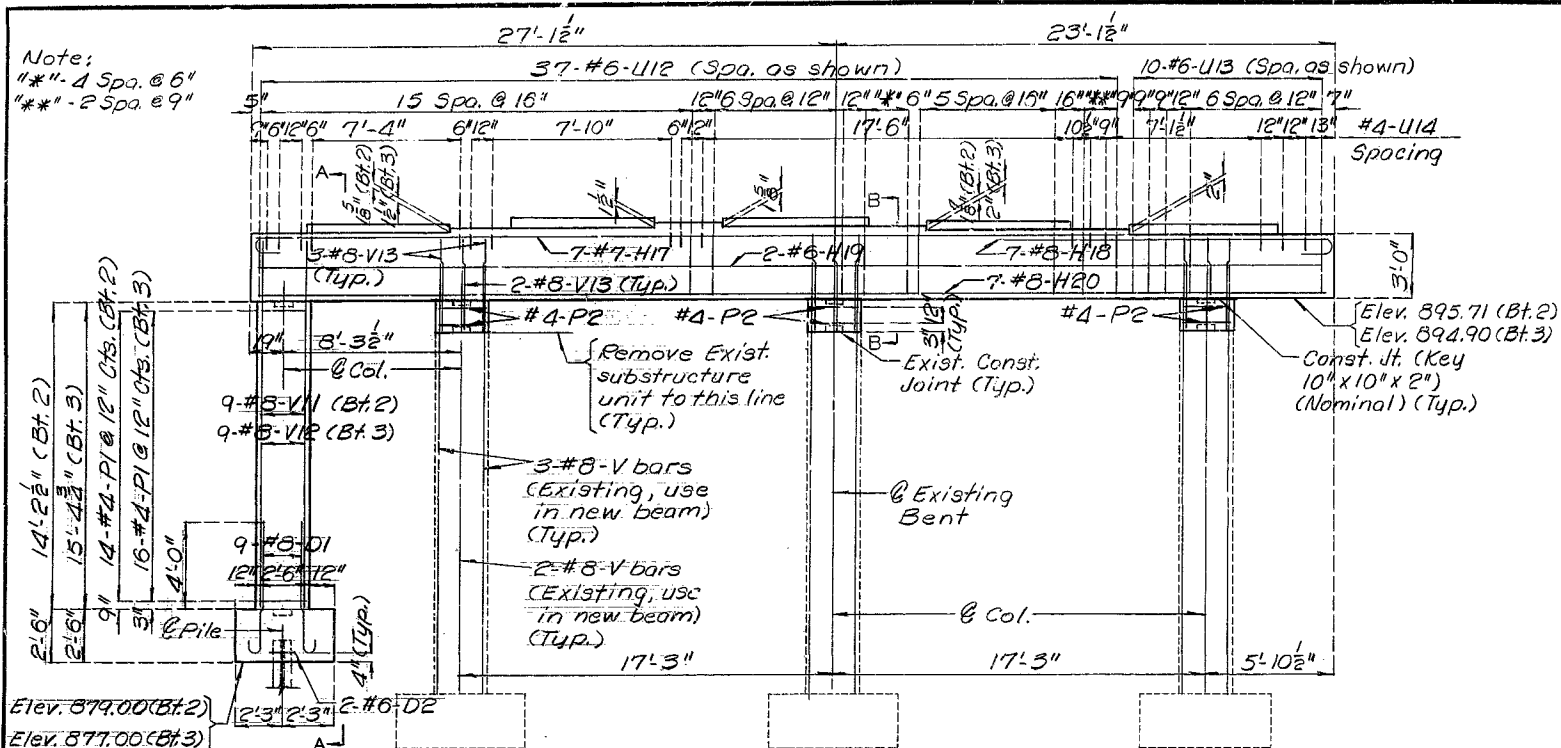


Note:
Light dashed lines indicate
existing structure.

ELEVATION

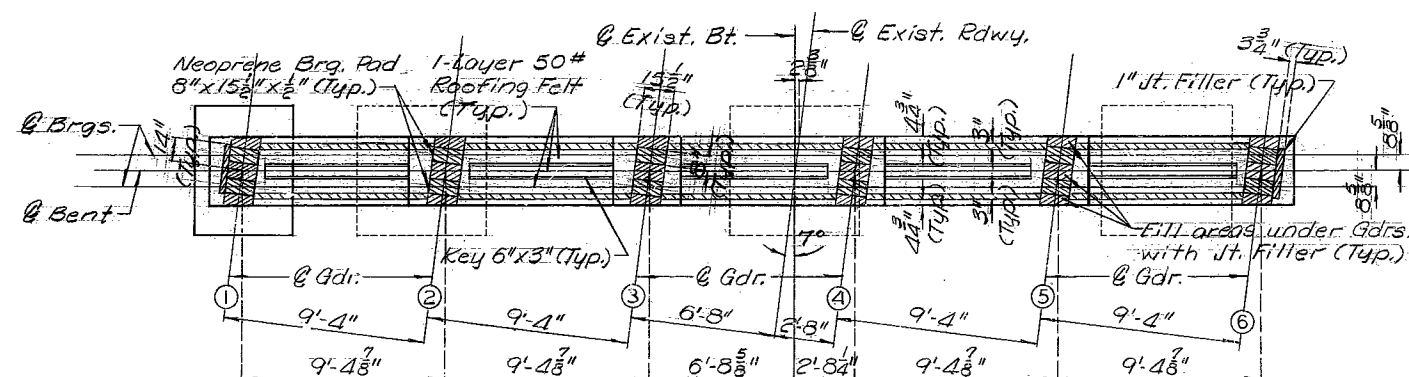

PLAN SHOWING BEARINGS

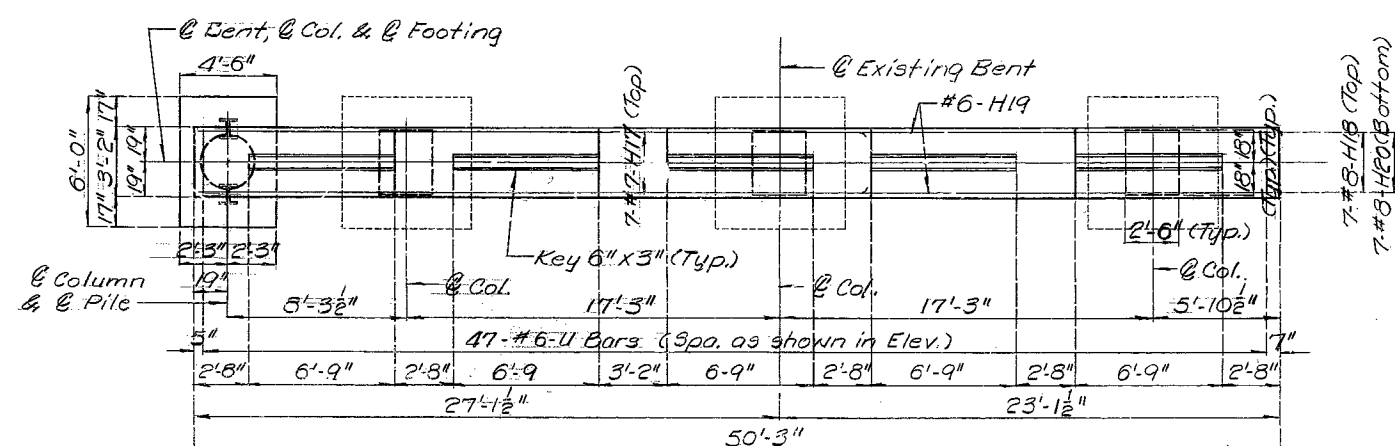


PLAN SHOWING REINF.


DETAILS OF INT. BT. NO. 2 & 3

Note: This drawing is not to scale. Follow dimensions.


FED. ROAD DIST. NO.	STATE	FED. AID PROJ. NO.	FISCAL YEAR	SHEET NO.	TOTAL SHEETS
5	MO.		19	33	

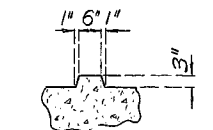

SECTION THRU KEY

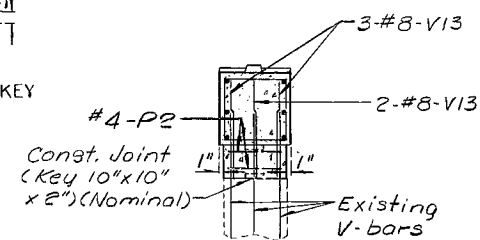


SECTION B-B

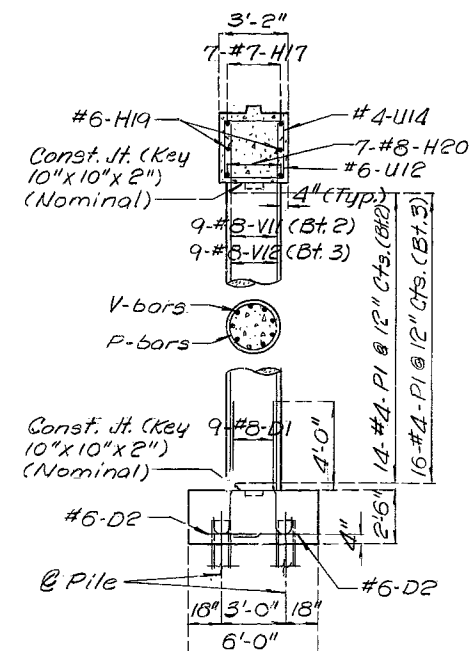


SECTION A-A

Notes:

Bars bonded in old concrete not removed shall be cleanly stripped and embedded into new concrete where possible. If length is available, old bars shall extend into new concrete at least 40 diameters for smooth bars and 30 diameters for deformed bars.

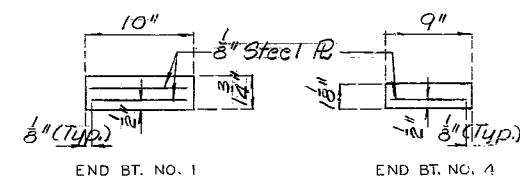


DETAILS OF LAMINATED NEOPRENE BRGS.

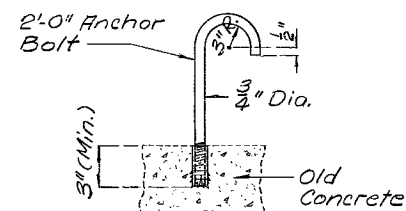

Note: Anchors shall be of the self drilling expansion type, made of casehardened and drawn carburized steel, with self-cutting angular broaching grooves.

Cost of furnishing and installing hook anchor bolt assemblies shall be included in contract unit price for concrete.

HOOK ANCHOR BOLT DETAILS

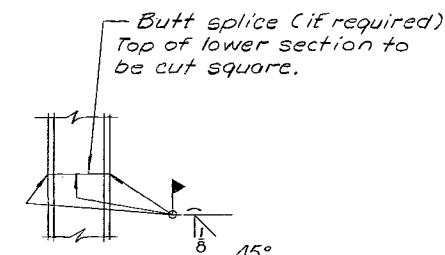

DETAIL OF STEEL PILE SPLICE

Note:






Note:
For location of Hook Anchor Bolts
see Sht. No. 3 and Sht. No. 5.

DETAILED *Oct. 1981*
CHECKED *Nov. 1981*

Sheet No. 4 of 14.

CLAY COUNTY




L-659R

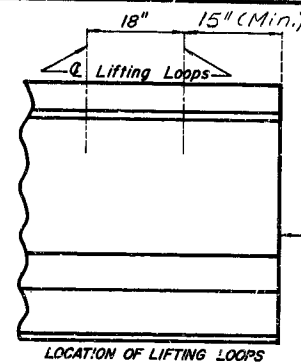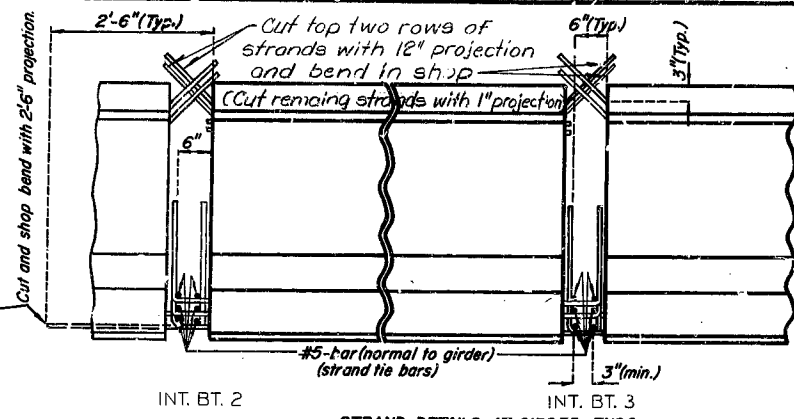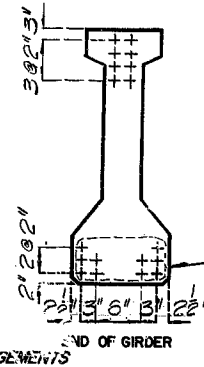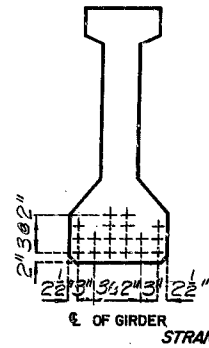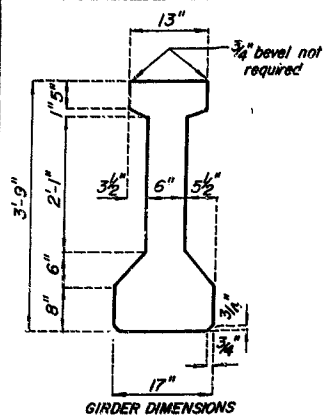

BILL OF REINFORCING STEEL - EACH GIRDER									
NO.	SIZE & MARK	ACTUAL LENGTH	SHAPE	BENDING DIAGRAMS					
4	5 A1	32'-4"	20						
104	5 B1	5'-3"	11						
5	5 B2	4'-3"	19						
52	4 C1	13"	10						
104	4 D1	3'-0"	9						

NOTE:
All dimensions are out to out.
Where deflecting strands interfere with placement, some in-place bending may be necessary.
Hooks and bends shall be in accordance with the CRSI Manual of Standard Practice for Detailing Reinforced Concrete Structures stirrup and tie dimensions.
Actual lengths are measured along centerline bar to the nearest inch. Minimum clearance to reinforcing shall be 1".
All reinforcement shall be Grade 60.

NOTE:
Concrete for prestressed girders shall be Class A1 with $f'_c = 5,000$ psi.
(+) indicates prestressed strand.
Use 13 strands with an initial prestress force of 520 kips.
Cost of 3/4" coil tie rods placed in diaphragms is included in contract unit price for prestress concrete members.
Coil ties shall be held in place in the forms by slotted wire-setting studs projecting thru forms. Studs are to be left in place or replaced with temporary plug until girders are erected and then replaced by coil tie rods.

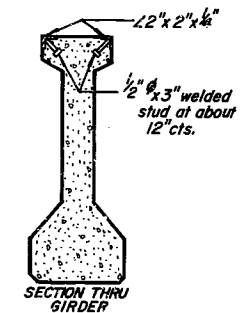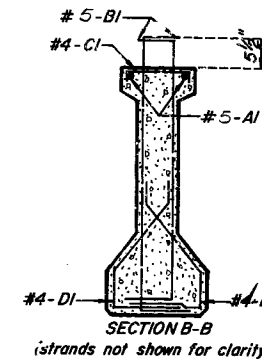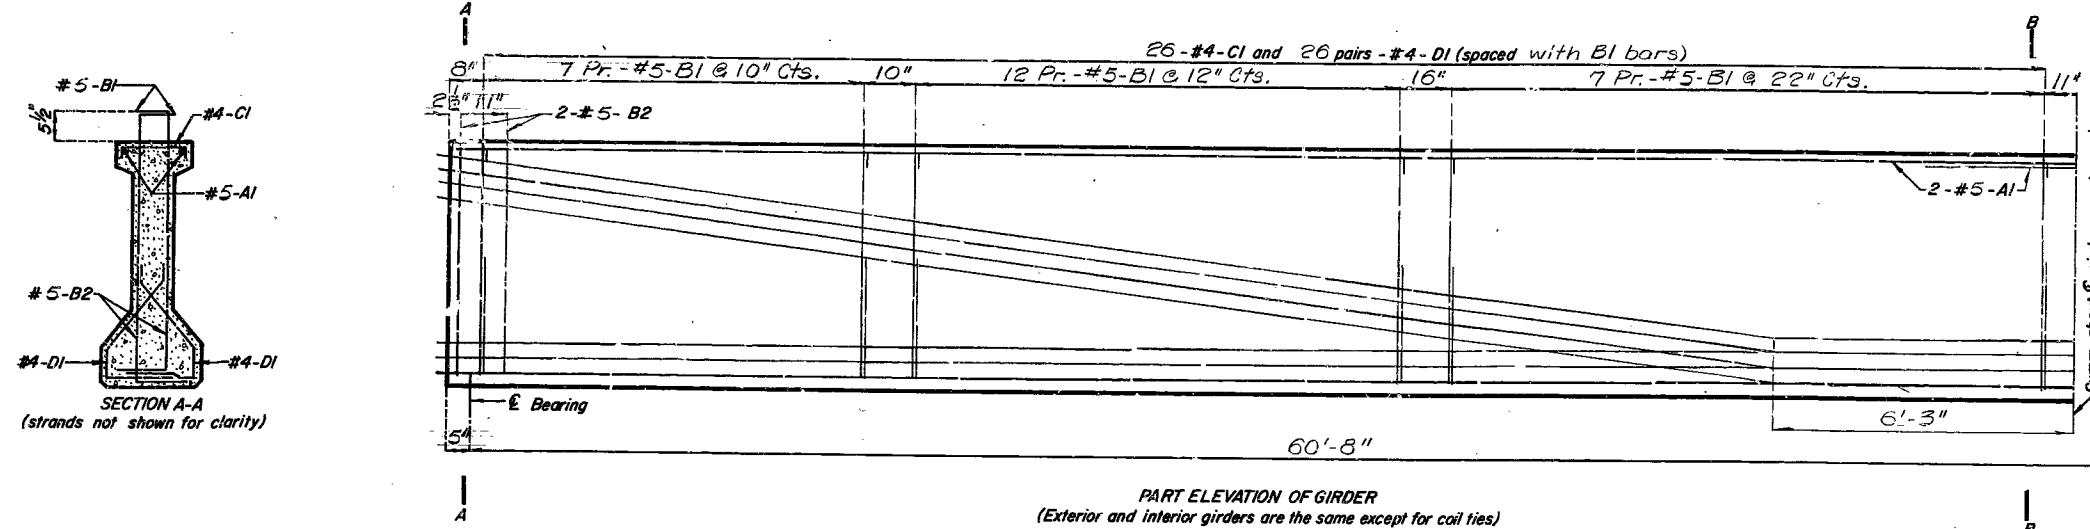

Note: Angles and welded studs to be cast-in-place on girders when alternate stay-in-place forms or slabs are used.
Angles to be placed no closer than 12" from end of girders.
Splices in the angles may be made at convenient lengths by a qualified welder.
Cost of angles and welded studs to be included in contract unit price for prestress concrete members.
Steel angles shall be galvanized in accordance with ASTM A123.

Note:
For Details of Coil Tie Rods see Sht. No. 6.

DETAILS OF PRESTRESSED GIRDERS (SPAN 2-3)

Note: This drawing is not to scale. Follow dimensions.

Sheet No. 7 of 12.

CLAY COUNTY

L-659R

SPS 53.4.6 Revised April 1973 MAY 1981

DETAILED Nov. 1981
CHECKED Nov. 1981

311

GIRDERS DIMENSIONS

- Total height: 3'-9"
- Top flange width: 13"
- Web thickness: 6"
- Bottom flange width: 17"
- Level not required

STRAND ARRANGEMENTS

- Strand layout diagram showing top and bottom reinforcement.

END OF GIRDER

- Diagram showing strand arrangement at the end of the girder.

STRAND DETAILS AT GIRDER ENDS

- Diagram showing strand details at the ends of the girder.
- Note: Cut all top strands with a 12" projection and bend in shop.
- Note: Cut and shop bend with 2'-6" projection.

PART ELEVATION OF GIRDER

- Overall length: 25'-9"
- Section A-A shows internal reinforcement: #5-B1, #4-C1, #7-A1, #5-B2, #4-D1.
- Reinforcement schedule: 8-#4-C1 and 8 pairs - #4-D1 (spaced with B1 bars), 4 Pr. - #5-B1 @ 16" Cts., 20", 4 Pr. - #5-B1 @ 2'-0" Cts., 12".
- Notes: Omit all draped strands; Symm. about centerline except as shown; Omit.

NOTE:

- Concrete for prestressed girders shall be Class AI with $f'_c = 5,000$ psi.
- (+) indicates prestressed strand.
- Use (C) strands with an initial prestress force of 231 kips.
- Cost of 3/4" coil tie rods placed in diaphragms is included in contract unit price for prestress concrete members.
- Cut ties shall be held in place in the forms by slotted wire-setting studs projecting thru forms. Studs are to be left in place or replaced with temporary plug until girders are erected and then replaced by coil tie rods.

BILL OF REINFORCING STEEL - EACH GIRDER				BENDING DIAGRAMS	
NO.	SIZE & MARK	ACTUAL LENGTH	SHAPE		
2	7 A1	26'-4"	20		
32	5 B1	5'-3"	11		
4	5 B2	4'-3"	19		
16	4 C1	13"	10		
32	4 D1	3'-0"	9		

A detailed cross-sectional diagram of a composite beam, labeled "SECTION B-B" with the note "(strands not shown for clarity)". The diagram shows a central vertical core filled with a stippled pattern, representing concrete or a similar material. This core is surrounded by a thick, solid outer layer. At the top of the beam, there is a triangular reinforcement element labeled "# 5-BI". Below this, a horizontal line with a dashed extension to the right is labeled "# 4-CI". The main body of the beam has a label "# 7-AI" pointing to the central core. At the bottom, there are two labels: "# 4-DI" on the left and "# 4-DI" on the right, pointing to the bottom corners of the outer layer. The entire diagram is enclosed in a rectangular frame.

GIRDER

Note: Angles and welded studs to be cast-in-place on girders when alternate stay-in-place forms for slabs are used.

Angles to be placed no closer than 12" from end of girders.


Splices in the angles may be made at convenient lengths by a qualified welder.

Cost of angles and welded studs to be included in contract unit price for prestress concrete members.

Steel angles shall be galvanized in accordance with ASTM A123.

Note:
For Details of Coil Tie Rods
see Sht. No. 6.


314

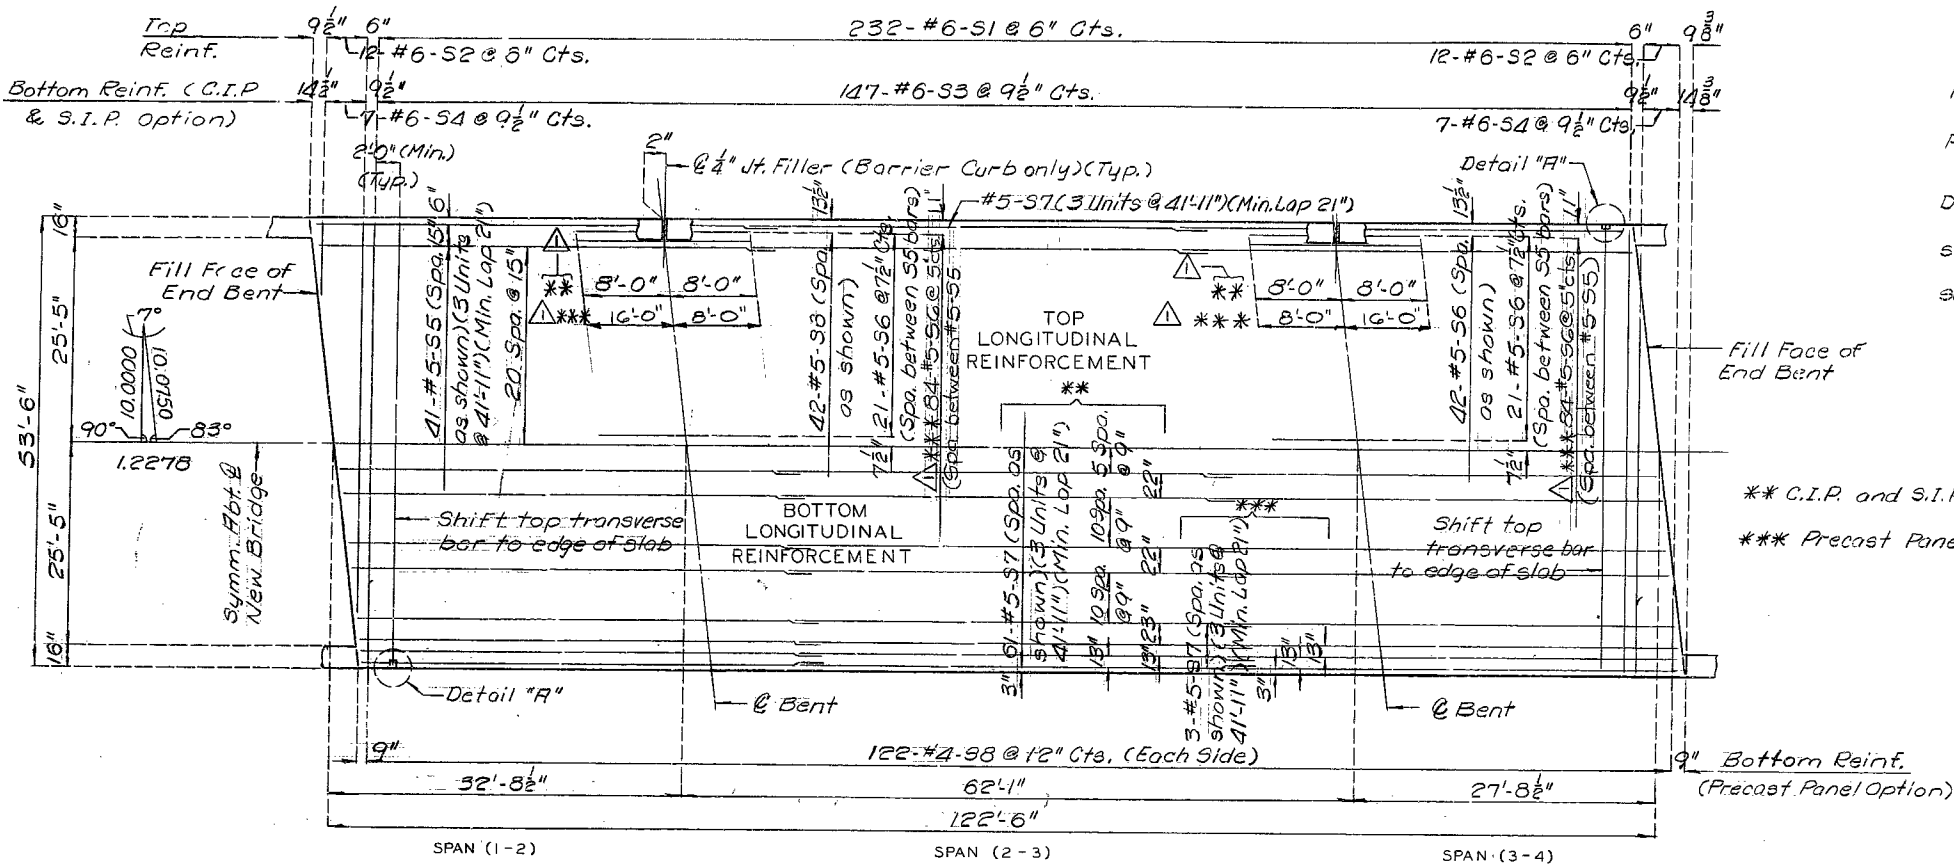

PLAN OF SLAB SHOWING REINFORCEMENT

Note:
Longitudinal dimensions shown are taken parallel to grade along @ new bridge @ top of slab.
For Detail "R" see Sht. No. 9.
For Girder Camber and Slab Haunching Diagram see Sht. No. 9.
For Details of Prestressed Panel Option, see Sht. No. 11.
For Details of Safety Barrier Curb not shown see Sht. No. 12.


** C.I.P. and S.I.P. Option
*** Precast Panel Option

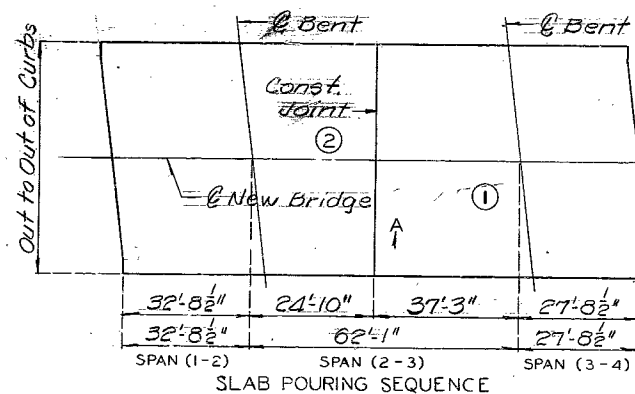


Note:
The contractor shall furnish an approved retarder to retard the set of the concrete to 2.5 hours and shall pour and satisfactorily finish the slab pours at the rate given.
The diaphragm at the intermediate bents and end bents shall be poured a minimum of 30 minutes and a maximum of 2 hours before the slab is poured.
Intermediate diaphragms within spans may be poured with the construction joint between the diaphragm and slab or monolithic with slab.

SEQUENCE OF POURS	DIRECTION		*
	1	2	
BASIC SEQUENCE	END TO 2	1 TO END	28
Alternate pours to the basic sequence are subject to the approval of the engineer in accordance with section 703.3.12.4 of Missouri Standard Specifications.			
ALTERNATE "A" POURS	1 + 2	END TO END	28

* Min. Rate of Pour (Cu. Yds./Hr.)


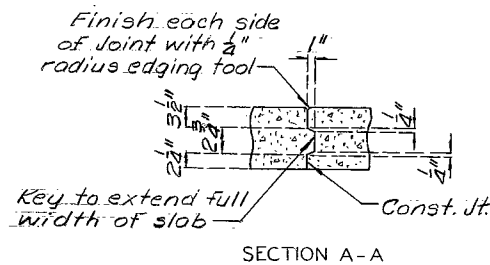


SECTION A-A

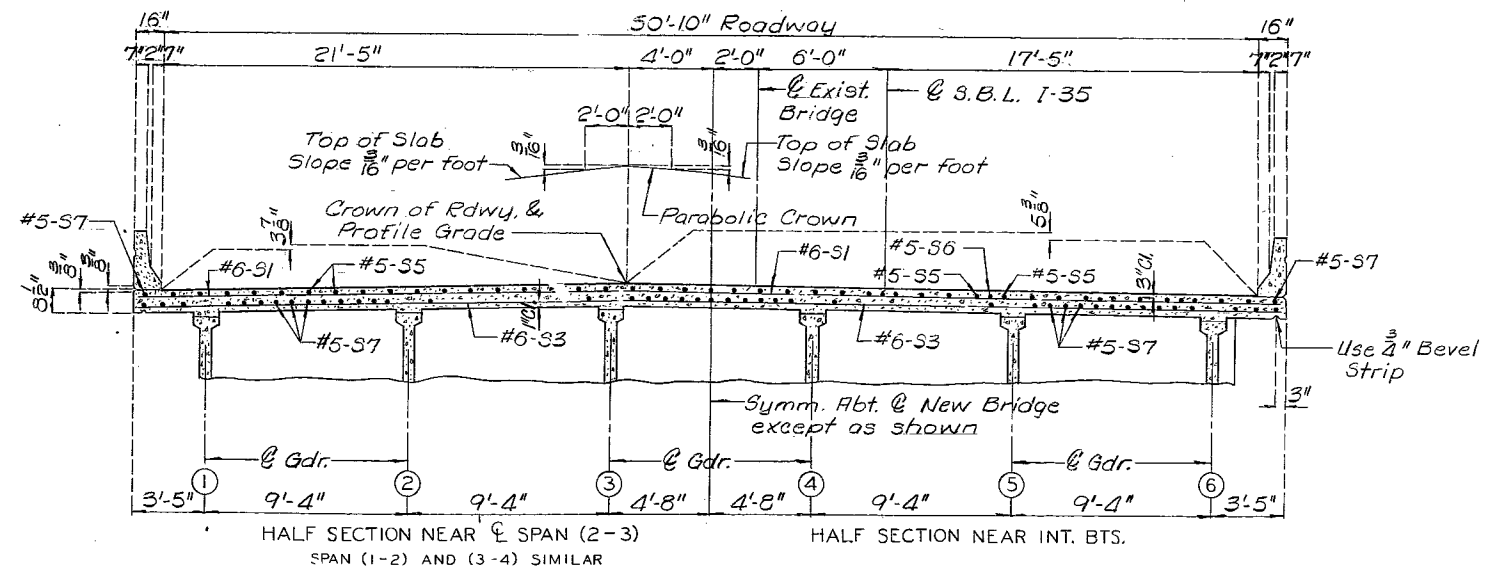


FED. ROAD DIST. NO.	STATE	FED. AID PROJ. NO.	FISCAL YEAR	SHEET NO.	TOTAL SHEETS
5	MO.		19	40	

Note: At the contractors option a 5 3/8" min. depth slab over the prestressed panel may be used by increasing and varying the girder top flange depth. Dimensions shall be shown on the shop drawings.



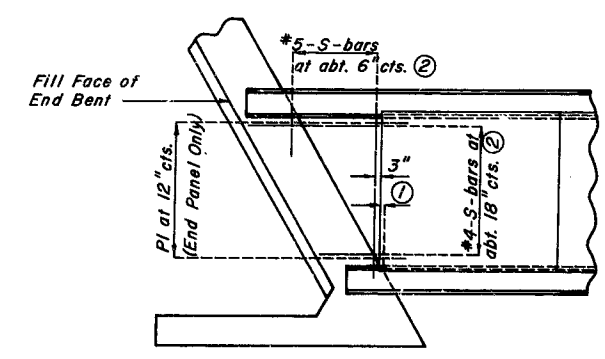
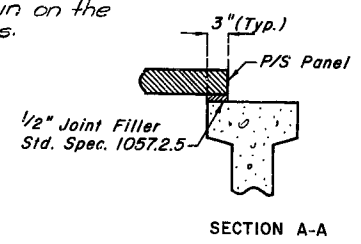


PANELS - SQUARED ENDS




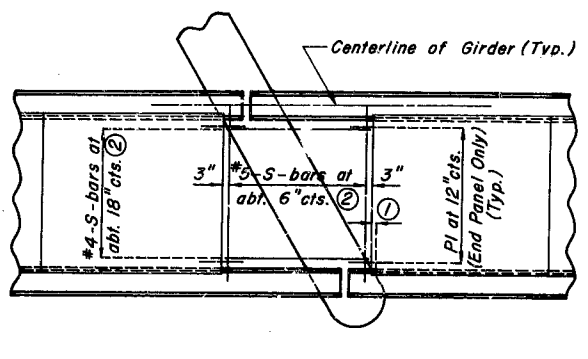


PANELS - SKEWED ENDS

PLAN OF PRESTRESSED PANEL PLACEMENT

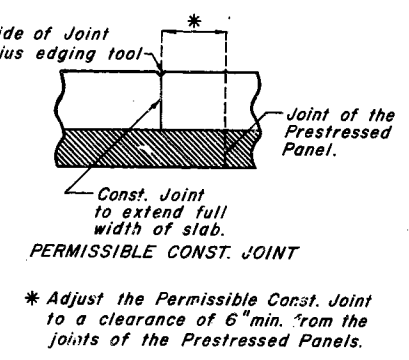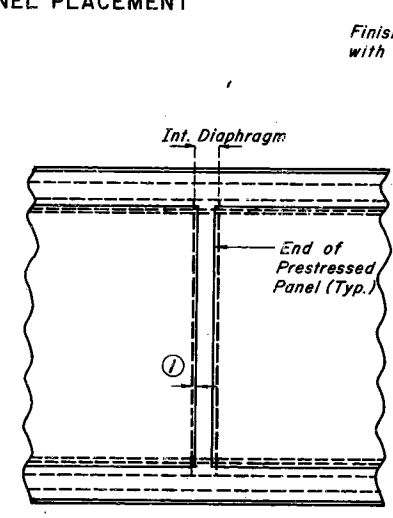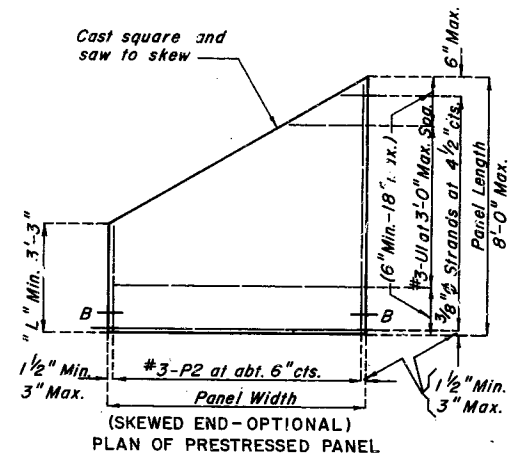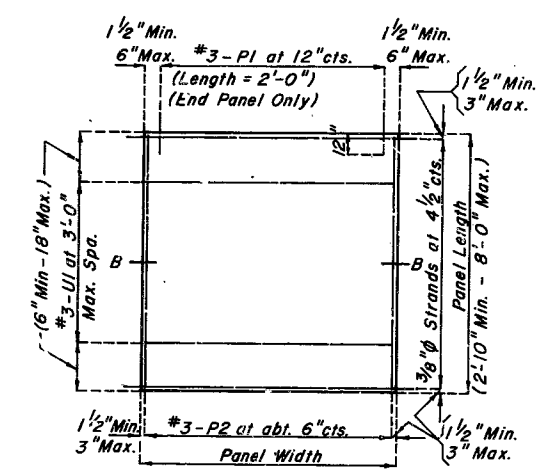


GENERAL NOTES:
PRESTRESSED PANELS:
 CONCRETE FOR PRESTRESSED PANELS SHALL BE CLASS A1 WITH $f'c = 5,000$ psi.
 THE TOP SURFACE OF ALL PLANKS SHALL RECEIVE A SCORED FINISH WITH A DEPTH OF SCORING OF 1/8" PERPENDICULAR TO THE PRESTRESSING STRANDS IN THE PLANK (SEE SPECIAL PROVISIONS).
 PRESTRESSING TENDON SHALL BE HIGH-TENSILE STRENGTH UNCOATED SEVEN-WIRE (7) STRESS RELIEVED STRANDS FOR PRESTRESSED CONCRETE CONFORMING TO A.S.T.M A-416 EXCEPT THAT NOMINAL DIAMETER OF STRAND = 3/8" AND NOMINAL AREA = 0.085 SQ. IN. AND MINIMUM ULTIMATE STRENGTH = 23,000 LBS. (270 KSI). LARGER STRANDS MAY BE USED WITH THE SAME SPACING AND INITIAL TENSION.
 INITIAL PRESTRESSING FORCE = 16.1 KIPS/STRAND.
 THE METHOD AND SEQUENCE OF RELEASING THE STRANDS SHALL BE SHOWN ON THE SHOP DRAWINGS.
 SUITABLE HOLES OR ANCHORAGE DEVICES FOR LIFTING PANELS MAY BE CAST IN PANELS PROVIDED THEY ARE SHOWN ON THE SHOP DRAWINGS AND APPROVED BY THE ENGINEER. PANEL LENGTHS SHALL BE DETERMINED BY THE CONTRACTOR AND SHOWN ON THE SHOP DRAWINGS.
 WHEN SQUARE END PANELS ARE USED AT SUPPORTS IT IS REQUIRED THAT THE SKEWED PORTION TO BE CAST-IN-PLACE. QUANTITIES ARE INCLUDED IN PAYMENT FOR SLAB ON CONCRETE I GIRDERS.
REINFORCING STEEL:
 ALL DIMENSIONS ARE OUT TO OUT.
 MINIMUM CLEARANCE TO REINFORCING STEEL SHALL BE 1-1/2" UNLESS OTHERWISE SHOWN.
 HOOKS AND BENDS SHALL BE IN ACCORDANCE WITH THE C.R.S.I. MANUAL OF STANDARD PRACTICE FOR DETAILING REINFORCED CONCRETE STRUCTURES, STIRRUP AND TIE DIMENSIONS.
 ACTUAL LENGTHS ARE MEASURED ALONG CENTERLINE BAR TO THE NEAREST INCH.
 THE PRESTRESSED PANEL QUANTITIES ARE NOT INCLUDED IN THE TABLE OF ESTIMATED QUANTITIES FOR ALTERNATE SLABS.

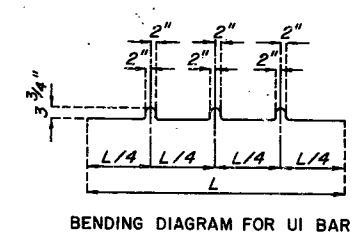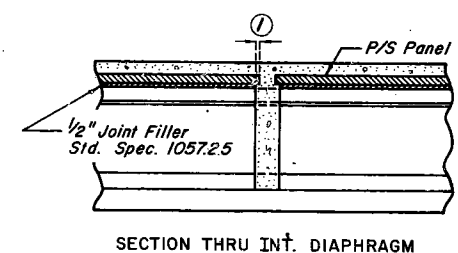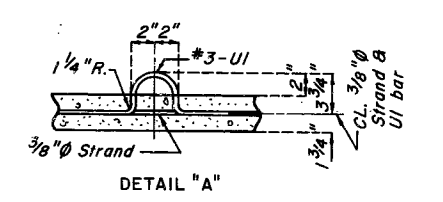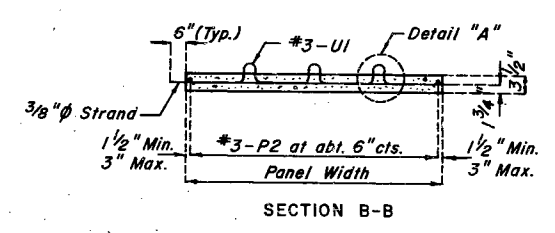

NOTE:
 ① End panel to be dimensioned 1" inside face of diaphragm.
 ② S-bars shown are bottom steel in slab between panels and used with squared end panels only.
 Cost of S-bars shall be included in price bid for Slab per sq. yd.

NOTES CON'T.
 Support from diaphragm forms required under optional skewed end until Cast-In-Place concrete has reached its minimum compressive strength.

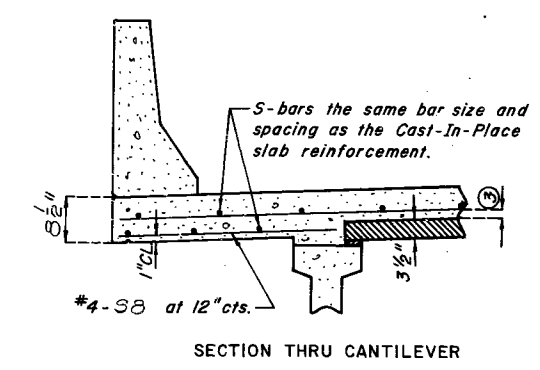

③ 1" CL. Min. #5 and #6 bars.
 NOTE: Slab exterior girder haunch to be the same as Cast-In-Place.
 Slab depth over Prestressed Panel varies due to girder number. Top of slab above Prestressed Panels to be built parallel to grade and to a min. thickness of 5 3/8"

DETAILS OF PRECAST PRESTRESSED PANELS

Note: This drawing is not to scale. Follow dimensions.

Sheet No. 11 of 14.

CLAY COUNTY


L-659R

315


P/S Panel Revised
 JAN. 1980
 CHECKED Nov. 1981

DETAILED Nov. 1981
 CHECKED Nov. 1981

FED. ROAD DIST. NO.	STATE	FED. AID PROJ. NO.	FISCAL YEAR	SHEET NO.	TOTAL SHEETS
3	NC		18	41	

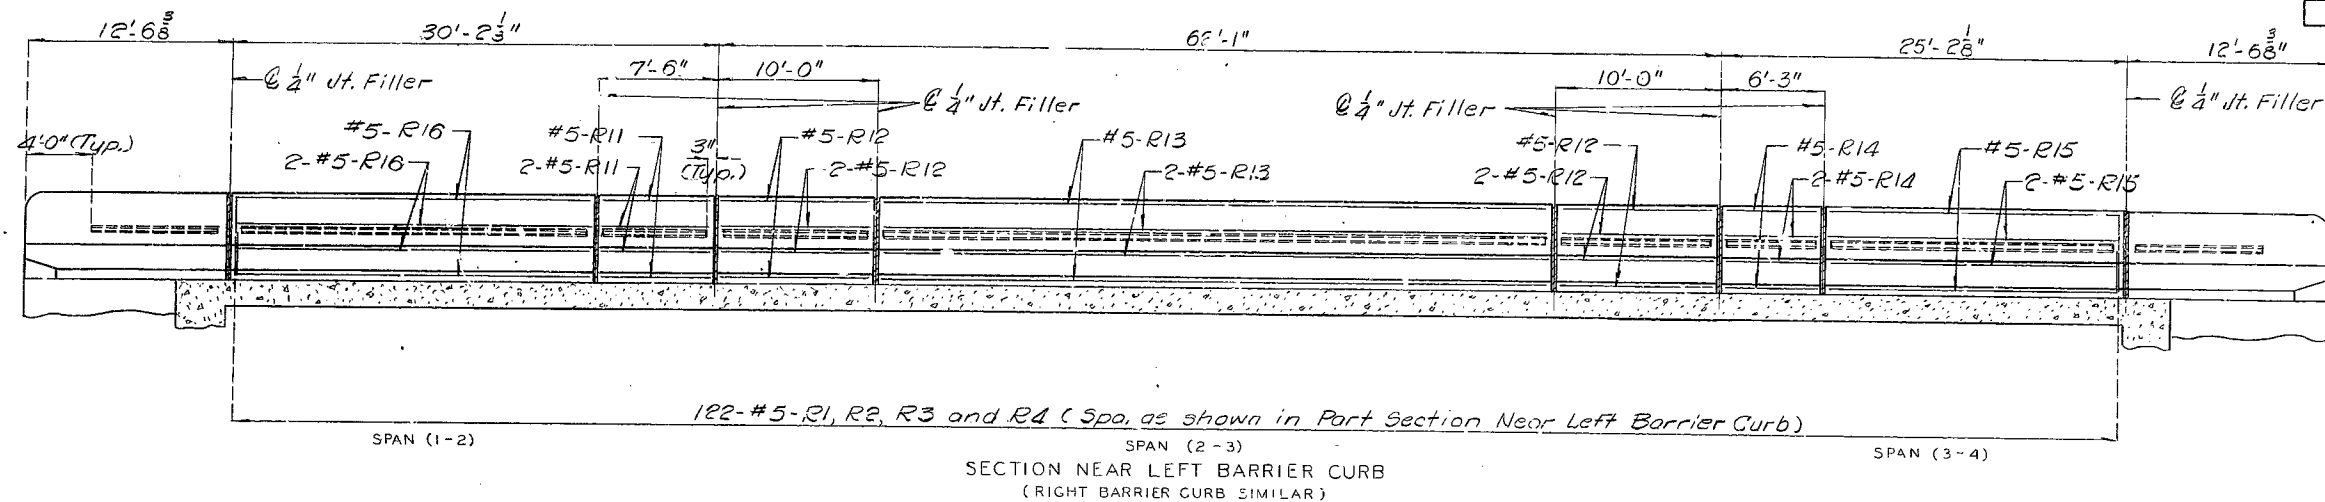


Note:
Longitudinal dimensions are along top edge of slab parallel to grade.
All reinforcing steel in barrier curbs shall be epoxy coated.

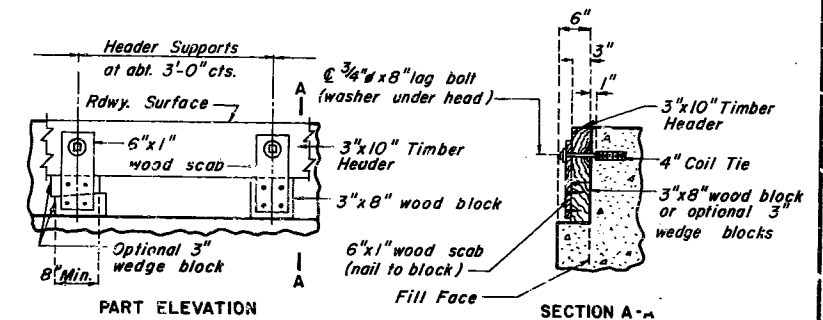


DETAILS OF TIMBER HEADER AT END BENTS

NOTES:
Top of barrier curb to be built parallel to grade with barrier curb joints (except at end bents) normal to grade.
All exposed edges of barrier curb shall have 1/2" radius or 3/8" bevel unless otherwise noted.
When the barrier curb is bid by linear feet, the contract unit price shall include the cost of all concrete and reinforcement.
Concrete in the safety barrier curb shall be Class B1.

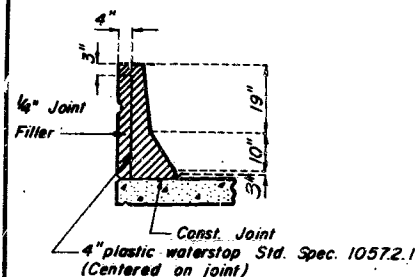


Note: Plastic waterstop shall be placed in all safety barrier curb filled joints.
Cost of plastic waterstop complete in place to be included in unit price bid for Safety Barrier Curb.


DETAILS OF PLASTIC WATERSTOP

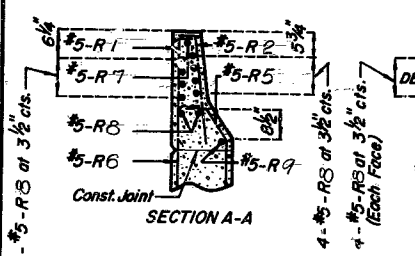


SECTION A-A

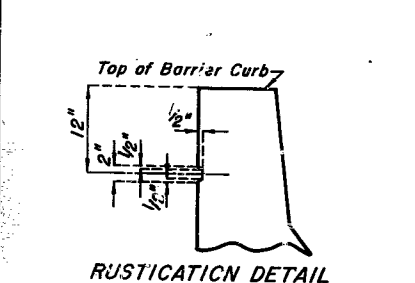


RUSTICATION DETAIL

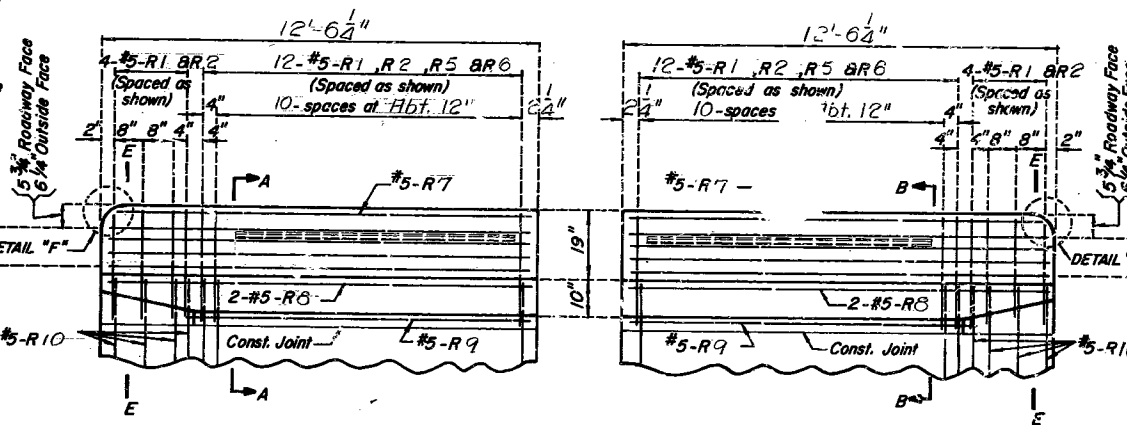


ELEVATION

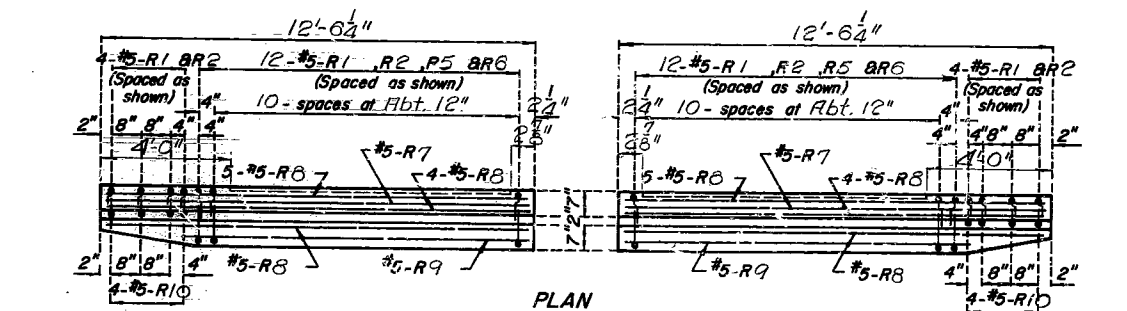


PLAN

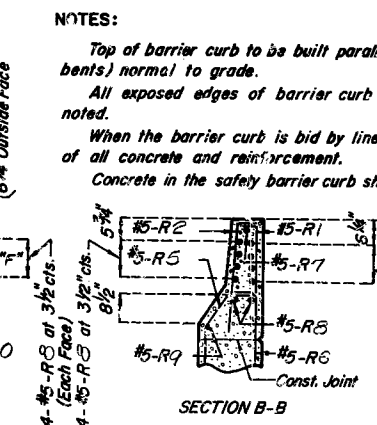


SECTION B-B

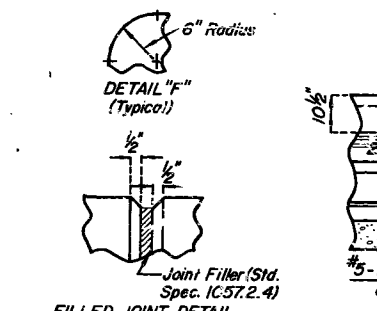


FILLED JOINT DETAIL

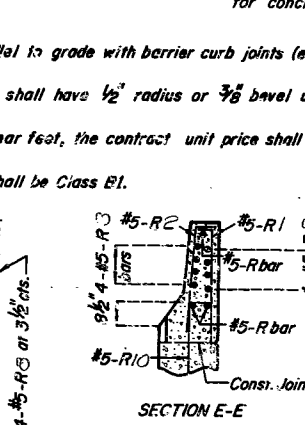


SECTION E-E

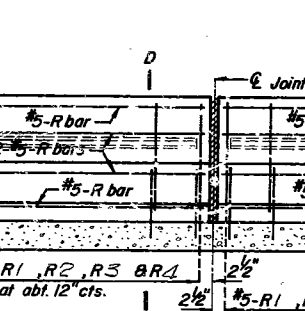

PART SECTION NEAR LEFT BARRIER CURB

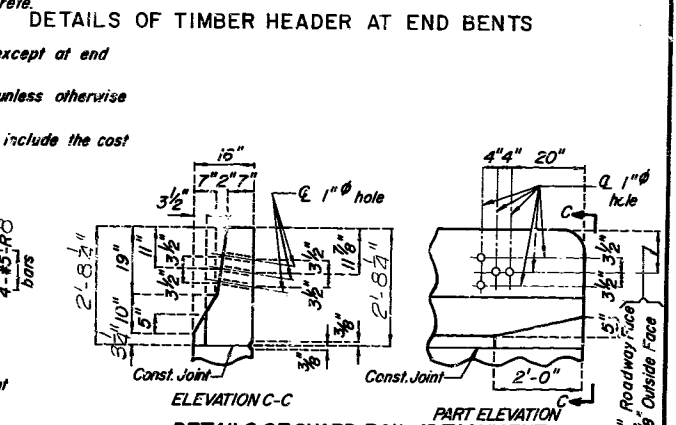

ELEVATION C-C

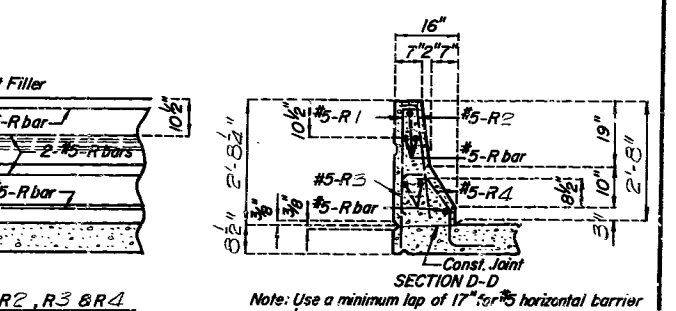

SECTION D-D

Note: Use a minimum lap of 17" for horizontal barrier bars.
The cross-sectional area above the slab = 2.27 sq. ft.

DETAILS OF BARRIER CURB AT END BENTS

Note: This drawing is not to scale. Follow dimensions.

Sheet No. 12 of 14.

CLAY COUNTY

L-659R

SPS 17.6(1) REVISED AUG. 1978 JUNE 1981

DETAILED Nov. 1981
CHECKED Nov. 1981


315

COMPLETE BILL OF REINFORCING STEEL																										
NO. REQD.	MARK NO.	MARK	LOCATION	EPOXY (E)	SHAPE NO.	STIRRUP (S)	SUBSTR. (X)	VARIES (V)	NO. EACH	DIMENSIONS												NOMINAL LENGTH	ACTUAL LENGTH	WEIGHT		
										B		C		D		E		F		H					K	
										FT.	IN.	FT.	IN.	FT.	IN.	FT.	IN.	FT.	IN.	FT.	IN.				FT.	IN.
			SUBSTRUCTURE																							
			ENC BENT NO. 1																							
4	6H1		BEAM		20	X			25	0.									25	0	150					
4	6H2		BEAM		20	X			32	8.000									32	8	194					
44	5U1		BEAM		10	S	X				12.000	22.000							3	10	168					
2	5U2		BEAM		13	S	X		2	3.000	4	7.750	2	3.000	4	7.750			14	9	30					
6	7U3		BEAM		14	X			2	2.000	23.000	2	7.625			20.500	2	0.000	6	9	80					
1	7U4		BEAM		14	X			4	1.000	23.000	4	9.250			2	10.750	3	9.500	10	9	23				
1	7U5		BEAM		14	X			3	8.500	2	0.500	4	11.000			3	10.000	3	1.000	10	8	21			
6	7U6		BEAM		14	X			22.000	2	0.500	2	11.625			2	4.000	22.000	6	10	6	7	81			
2	6V1		BEAM		20	X			4	5.000									4	5	4	5	13			
2	6V2		BEAM		20	X			4	7.000									4	7	4	7	14			
			INT. BENT NO. 2																							
9	6D1		FOOTING		17	X			6	2.000									7	1	7	1	170			
2	6D2		FOOTING		10	S	X				3	2.000	16.000						7	8	7	4	22			
7	7H17		BEAM		17	X			40	7.000									41	5	41	5	593			
7	8H18		BEAM		17	X			14	9.000									15	8	15	8	293			
2	6H19		BEAM		20	X			50	0.000									50	0	50	0	150			
7	8H20		BEAM		20	X			50	0.000									50	0	50	0	935			
14	4P1		COLUMN		16	X			2	3.000									7	11	7	11	74			
6	4P2		COLUMN		13	S	X		2	3.000	2	9.000	2	3.000	2	9.000			10	9	10	4	41			
37	6U12		BEAM		13	S	X		2	11.000	2	11.000	2	11.000	2	11.000			12	10	12	4	685			
10	6U13		BEAM		13	S	X		2	11.000	2	9.000	2	11.000	2	9.000			12	6	12	0	180			
16	4U14		BEAM		10	S	X				6.000	2	11.000						3	11	3	9	40			
9	8V11		COLUMN		20	X			16	6.000									16	6	16	6	396			
24	8V13		COLUMN		20	X			4	3.000									4	3	4	3	272			
			INT. BENT NO. 3																							
9	8D1		FOOTING		17	X			6	2.000									7	1	7	1	170			
2	6D2		FOOTING		10	S	X				3	2.000	16.000						7	8	7	4	22			
7	7H17		BEAM		17	X			40	7.000									41	5	41	5	593			
7	8H18		BEAM		17	X			14	9.000									15	8	15	8	293			
2	6H19		BEAM		20	X			50	0.000									50	0	50	0	150			
7	8H20		BEAM		20	X			50	0.000									50	0	50	0	935			
14	4P1		COLUMN		16	X			2	3.000									7	11	7	11	85			
6	4P2		COLUMN		13	S	X		2	3.000	2	9.000	2	3.000	2	9.000			10	9	10	4	41			
37	6U12		BEAM		13	S	X		2	11.000	2	11.000	2	11.000	2	11.000			12	10	12	4	685			
10	6U13		BEAM		13	S	X		2	11.000	2	9.000	2	11.000	2	9.000			12	6	12	0	180			
16	4U14		BEAM		10	S	X				6.000	2	11.000						3	11	3	9	40			
9	8V12		COLUMN		20	X			17	8.000									17	8	17	8	425			
24	8V13		COLUMN		20	X			4	3.000									4	3	4	3	272			


COMPLETE BILL OF REINFORCING STEEL																									
NO. REQD.	MARK NO.	LOCATION	EPOXY (E)	SHAPE NO.	STIRRUP (S)	SUBSTR. (X)	VARIES (V)	NO. EACH	DIMENSIONS										NOMINAL LENGTH	ACTUAL LENGTH	WEIGHT				
									B		C		D		E		F					H		K	
									FT.	IN.	FT.	IN.	FT.	IN.	FT.	IN.	FT.	IN.				FT.	IN.	FT.	IN.
		END BENT NO. 4																							
4	6H15	BEAM		20	X			32	8.000									32	8	196					
4	6H16	BEAM		20	X			25	0.000									25	0	150					
44	5U1	BEAM		10	S	X				12.000	22.000							3	10	3	168				
6	7U3	BEAM		14	X			2	2.000	23.000	2	7.625			20.500	2	0.000	6	9	6	80				
7	7U4	BEAM		14	X			4	1.000	23.000	4	9.250			2	10.750	3	9.500	10	9	10	22			
1	7U5	BEAM		14	X			3	8.500	2	0.500	4	11.000			3	10.000	3	1.000	10	8	10	5	21	
6	7U6	BEAM		14	X				22.000	2	0.500	2	11.625			2	4.000	22.000	6	10	6	7	81		
2	5U9	BEAM		13	S	X		2	3.000	4	8.000	2	3.000	4	8.000			14	9	14	5	30			
2	6V5	BEAM		20		Y		4	8.000									4	8	4	8	14			
2	6V6	BEAM		20		X		4	6.000									4	6	4	6	14			
		SUPERSTRUCTURE																							
		END BENT NO. 1																							
4	6F1	WING		23	S				14.125	4	5.000	14.125	9.500	10.500	9.500	10.500	6	9	6	8	40				
4	6F2	WING		23	S				14.125	5	0.500	14.125	10.500	9.500	10.500	9.500	7	5	7	4	44				
15	6H3	DIAPHRAGM		20				7	4.000								7	4	7	4	165				
6	6H4	DIAPHRAGM		20				2	6.000								2	6	2	6	23				
4	6H5	SLAB		20				53	8.000								53	8	53	8	322				
5	6H7	DIAPHRAGM		23	S			2	3.250	5	2.000			2	3.000	3.375	7	5	7	4	55				
5	6H8	DIAPHRAGM		21	S			2	3.250	5	2.000			2	3.000	3.375	7	5	7	3	54				
3	6H9	DIAPHRAGM		20				53	8.000								53	8	53	8	242				
6	6H10	WING		20				11	8.000								11	8	11	8	105				
6	6H11	WING		20		V	2	7	7.000								7	7	7	7					
		INCR = 18.500 IN						10	8.000								10	8	10	8	82				
6	6H12	WING		20				11	6.000								11	6	11	6	104				
6	6H13	WING		20		V	2	7	5.000								7	5	7	5					
		INCR = 18.500 IN						10	6.000								10	6	10	6	81				
6	5H14	DIAPHRAGM		20				3	11.000								3	11	3	11	25				
2	6T1	WING		25	S			2	1.500	5	5.250	7	0.000		2	4.000	4	11.000	14	7	14	6	44		
2	6T2	WING		25	S			2	1.500	5	5.250	6	7.000		2	4.000	4	11.000	14	2	14	1	42		
71	6U7	SLAB	E	19	S				12.000	4	2.000						5	2	5	0	533				
46	5U8	DIAPHRAGM		13	S			2	3.125	4	0.000	2	3.125	4	0.000		13	5	13	2	631				
20	6V3	WING		20		V	4	2	3.000								2			3					
		INCR = 6.000 IN						4	3.000								4	3		3	98				
20	6V4	WING		20				4	3.000								4	3		3	130				
		END BENT NO. 4																							
4	6F1	WING		23	S				14.125	4	5.000	14.125	9.500	10.500	9.500	10.500	6	9	6	8	40				
4	6F2	WING		23	S				14.125	5	0.500	14.125	10.500	9.500	10.500	9.500	7	5	7	4	44				
15	6H3	DIAPHRAGM		20				7	4.000								7	4	7	4	165				
6	6H4	DIAPHRAGM		20				2	6.000								2	6	2	6	23				
4	6H5	SLAB		20				53	8.000								53	8	53	8	322				
6	6H6	WING		20		V	2	7	11.000								7	11	7	11					
		INCR = 17.500 IN						10	10.000								10	10	10	10	84				
5	6H7	DIAPHRAGM		23	S			2	3.250	5	2.000			2	3.000	3.375	7	5	7	4	55				
5	6H8	DIAPHRAGM		21	S			2	3.250	5	2.000			2	3.000	3.375	7	5	7	3	54				
3	6H9	DIAPHRAGM		20				53	8.000								53	8	53	8	242				
6	6H10	WING		20				11	8.000								11	8	11	8	105				
6	6H12	WING		20				11	6.000								11	6	11	6	104				
6	5H14	DIAPHRAGM		20				3	11.000								3	11	3	11	25				

COMPLETE BILL OF REINFORCING STEEL																
NO.	REQD.	MARK NO.	LOCATION	EPOXY (E)	SHAPE NO.	STIRRUP (S)	SUBSTR. (X)	VARIES (V)	DIMENSIONS							
									B	C	D	E	F	H	K	NOMINAL
									FT.	IN.	FT.	IN.	FT.	IN.	FT.	IN.
4	6H23	WING	INCR = 18.500 IN		20				7	5.000						7 5 7 5
									10	6.000						10 6 10 6
2	6T3	WING			25	S			2	1.500	4	7.750	7	3.000		2 0.125 4 2.250 14 0 13 11
2	6T4	WING			25	S			2	1.500	4	7.500	6	5.000		2 0.000 4 2.000 13 2 13 1
71	6U11	SLAB			19	S			12	0.000	4	2.000				5 2 5 0
46	5U10	DIAPHRAGM			13	S			2	3.125	4	0.000	2	3.125	4	0.000
8	6V7		INCR = 7.375 IN		20				2	3.000						2 3 2 3
									4	1.000						4 1 4 1
10	6V8				20				4	3.000						4 3 4 3
10	6V9				20				4	3.000						4 3 4 3
10	6V10		INCR = 5.250 IN		20				2	3.000						2 3 2 3
			DIAPHRAGMS INT. AND END						4	0.000						4 0 4 0
72	5H14	END DIAPHS.			20				3	11.000						3 11 3 11
40	6H24	END DIAPHS.			20				7	10.000						7 10 7 10
40	4H25	END DIAPHS.			20				7	10.000						7 10 7 10
32	5H26	END DIAPHS.			19	S			11.000	2	3.000					3 2 3 1
16	5H27	END DIAPHS.			20				3	10.000						3 10 3 10
30	4H21	INT. DIAPH.			20				7	9.000						7 9 7 9
10	5H22	INT. DIAPH.			20				7	9.000						7 9 7 9
120	4U15	END DIAPHS.			28	S			20.000	3	10.000	12.000				6 6 6 4
40	6U16	END DIAPHS.			28	S			20.000	3	10.000	12.000				6 6 6 2
40	4U17	INT. DIAPH.			10	S			12.000	3	5.000	6.000	12.000			9 4 9 0
		CAST-IN-PLACE CONVENTIONAL FORMS OR STAY-IN-PLACE FORMS														
234	6S1	SLAB-TOP			20				53	3.000						53 3 53 3
24	6S2	SLAB-TOP			20				5	4.000						5 4 5 4
		INCR = 48.675 IN							50	1.000						50 1 50 1
147	6S3	SLAB-BOTTOM			20				53	3.000						53 3 53 3
14	6S4	SLAB-BOTTOM			20				8	9.000						8 9 8 9
		INCR = 77.125 IN							47	4.000						47 4 47 4
123	5S5	SLAB-TOP			20				41	11.000						41 11 41 11
84	5S6	SLAB-TOP			20				16	0.000						16 0 16 0
189	5S7	SLAB			20				41	11.000						41 11 41 11
		PRECAST PANEL FORMS														
234	6S1	SLAB-TOP			20				53	3.000						53 3 53 3
24	6S2	SLAB-TOP			20				5	4.000						5 4 5 4
		INCR = 48.675 IN							50	1.000						50 1 50 1
123	5S5	SLAB-TOP			20				41	11.000						41 11 41 11
84	5S6	SLAB-TOP			20				16	0.000						16 0 16 0
24	5S7	SLAB			20				41	11.000						41 11 41 11
244	4S8	SLAB-BOTTOM			20				3	6.000						3 6 3 6
		BARRIER CURB														
308	5R1	BARRIER CURB			19	S			2	6.000			3.500			2 10 2 8
308	5R2	BARRIER CURB			19	S			2	6.125			3.500			2 10 2 9
244	5R3	BARRIER CURB			19	S			17.000			6.000				23 22 467

COMPLETE BILL OF REINFORCING STEEL																
NO.	REQD.	MARK NO.	LOCATION	EPOXY (E)	SHAPE NO.	STIRRUP (S)	SUBSTR. (X)	VARIES (V)	DIMENSIONS							
									B	C	D	E	F	H	K	NOMINAL
									FT.	IN.	FT.	IN.	FT.	IN.	FT.	IN.
244	5R4	BARRIER CURB			27	S				6.000	11.125	7.000	12.000	9.125	6.375	3 0 2 10
48	5R5	BARRIER CURB			27	S				6.000	11.125	15.000		9.125	6.375	2 8 2 7
48	5R6	BARRIER CURB			19	S			2	0.000						2 6 2 5
4	5R7	BARRIER CURB			20				12	0.000						12 0 12 0
40	5R8	BARRIER CURB			20				12	3.000						12 3 12 3
4	5R9	BARRIER CURB			20				10	6.000						10 6 10 6
16	5R10	BARRIER CURB			10	S			2	0.000	4.000					4 4 6 2
12	5R11	BARRIER CURB			20				7	3.000						7 3 7 3
24	5R12	BARRIER CURB			20				9	9.000						9 9 9 9
12	5R13	BARRIER CURB			20				42	10.000						42 10 42 10
12	5R14	BARRIER CURB			20				6	0.000						6 0 6 0
12	5R15	BARRIER CURB			20				18	8.000						18 8 18 8
12	5R16	BARRIER CURB			20				22	5.000						22 5 22 5
		END OF BAR LIST														

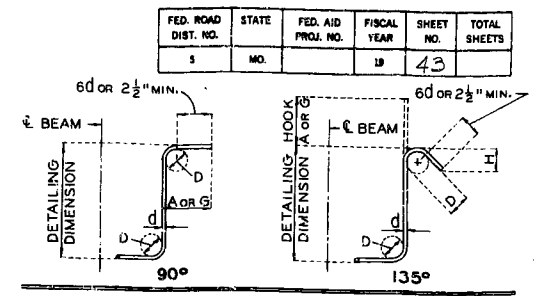

STIRRUP HOOK DIMENSIONS				
GRADES 40-50-60 KSI				
BAR SIZE	D (IN.)	90° HOOK A OR G	135° HOOK A OR G	APPROX. H
#3	1-1/2"	4"	4"	2-1/2"
#4	2"	4-1/2"	4-1/2"	3"
#5	2-1/2"	6"	5-1/2"	3-3/4"
#6	4-1/2"	8"	7"	4-1/2"

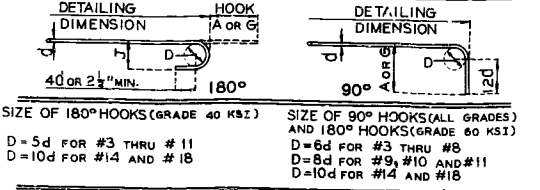

END HOOK DIMENSIONS				
180° HOOKS				
BAR SIZE	GRADE 40 A OR G	GRADE 60 J	GRADE 60 A OR G	90° HOOKS A OR G
#3	5"	2-3/4"	5"	3"
#4	6"	3-1/2"	6"	4"
#5	7"	4-1/2"	7"	5"
#6	8"	5-1/4"	8"	6"
#7	9"	6-1/4"	10"	7"
#8	10"	7"	11"	8"
#9	12"	8"	15"	11-1/4"
#10	13"	9"	17"	12-3/4"
#11	14"	10"	19"	14-1/4"
#14	21-2"	20-1/2"	21-2"	20-1/2"
#18	21-11"	21-3"	21-11"	21-3"

NOTES: ALL STANDARD HOOKS AND BENDS OTHER THAN 130 DEG. TO BE BENT WITH SAME PROCEDURE AS FOR 90 DEG. STD. HOOKS. HOOKS AND BENDS SHALL BE IN ACCORDANCE WITH THE PROCEDURES AS SHOWN ON THIS SHEET.

E - EPOXY COATED REINFORCEMENT.

S - STIRRUP.

X - BAR IS INCLUDED IN SUBSTRUCTURE QUANTITIES.

V - BAR DIMENSIONS VARY IN EQUAL INCREMENTS BETWEEN DIMENSIONS SHOWN ON THIS LINE AND THE FOLLOWING LINE.

NO. EA. - NUMBER OF BARS OF EACH LENGTH.



NOMINAL LENGTHS - ARE BASED ON OUT TO OUT DIMENSIONS SHOWN IN BENDING DIAGRAMS AND ARE LISTED FOR FABRICATORS USE. (NEAREST INCH)

ACTUAL LENGTHS - ARE MEASURED ALONG CENTERLINE BAR TO THE NEAREST INCH.

Note: Two additional #6-S1 and #5-S2 are included in bar bill for testing. See Special Provisions.

318

REVISED
MAY 1974
JAN. 1981

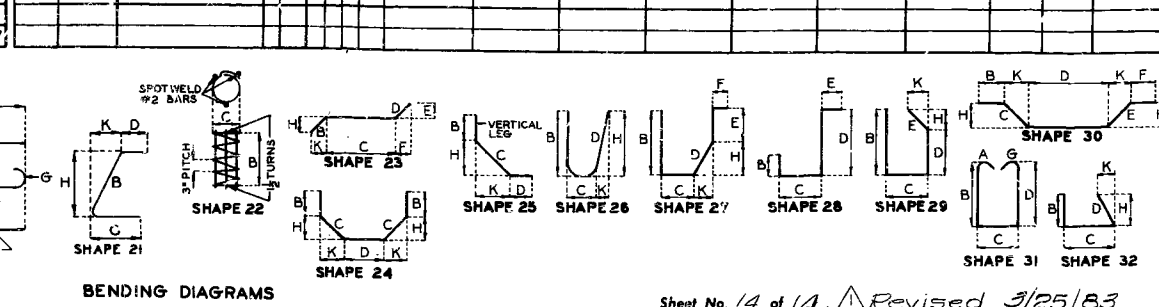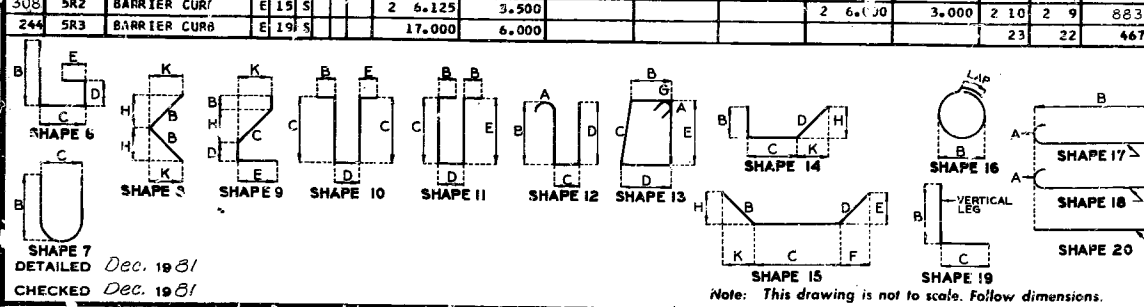

QUANTITIES			
ITEM		SUBSTR.	SUPERSTR.
Special Work	Lump Sum		1
Removal Of Existing Bridge Deck	Sq. Ft.		5,574
Class I Excavation	Cu. Yd.	35.5	35.5
Structural Steel Piles (10 In.)	Lin. Ft.	240	240
Class B Concrete	Cu. Yd.	68.3	68.3
Reinforcing Steel	Pound	9,300	9,300
Slab On Concrete I-Girder "X"	Sq. Yd.		728
Safety Barrier Curb	Lin. Ft.		285
Plain Neoprene Bearing Pads	Each		24
Laminated Neoprene Bearing Pads	Each		12
Prestressed Concrete I-Girder 30 Ft. Span Each			6
Prestressed Concrete I-Girder 60 Ft. Span Each			6
Prestressed Concrete I-Girder 25 Ft. Span Each			6
CONTINGENT			
504.01 Reinforcing Steel	Lb.		2800


Note:
 All concrete and reinforcement above lower construction joint in end bents are included with superstructure quantities.
 Cost of $\frac{3}{4}$ " ϕ coil tie rods placed in diaphragms is included in contract unit price for P/S members.
 "X" See Special Provisions.

PILE DATA					
BENT NO.		1	2	3	4
Pile Type and size		HP10x42	HP10x42	HP10x42	HP10x42
Number		2	2	2	2
Approximate length	Ft.	38	24	21	37
Design Bearing	Tons	24	43	43	24
Hammer Energy required	Ft. Lbs	7,000	9,600	9,600	7,000



Minimum energy requirement of hammer based on plan length and design bearing value of piles.
 All pile were driven to practical refusal.

QUANTITIES FOR SLAB			
TYPE OF SLAB	Slab on Conc. I-Gir.		
	Reinf. (Lbs.)		Conc.
	Epoxy	Plain	Cu. Yd.
Precast Panel Forms	31,480	7,590	219.2

Precast panel quantities based on skewed end panels.

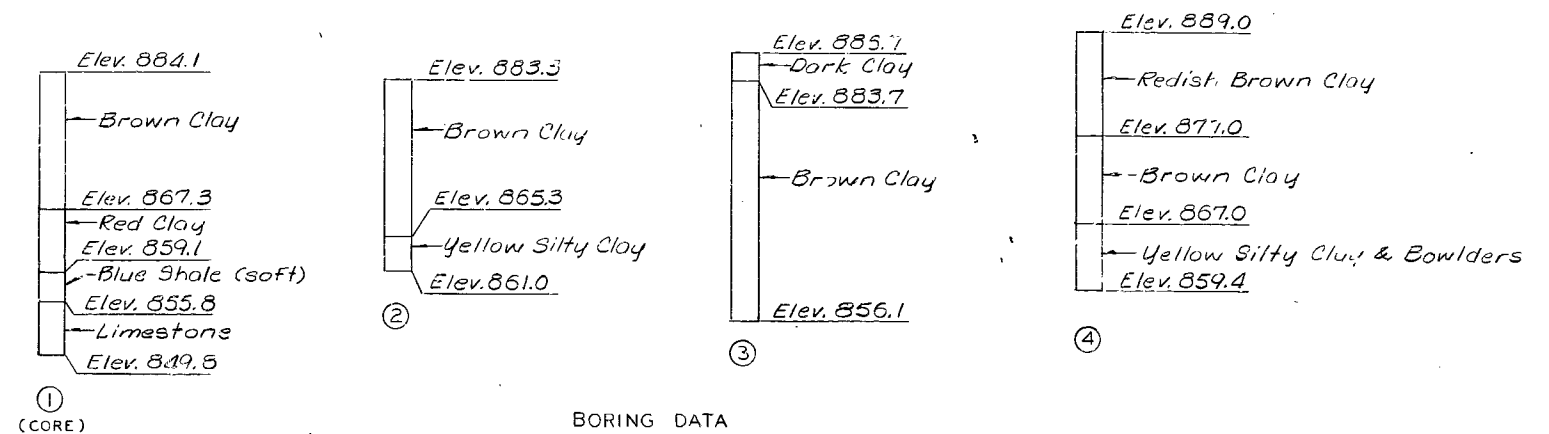

BORING DATA

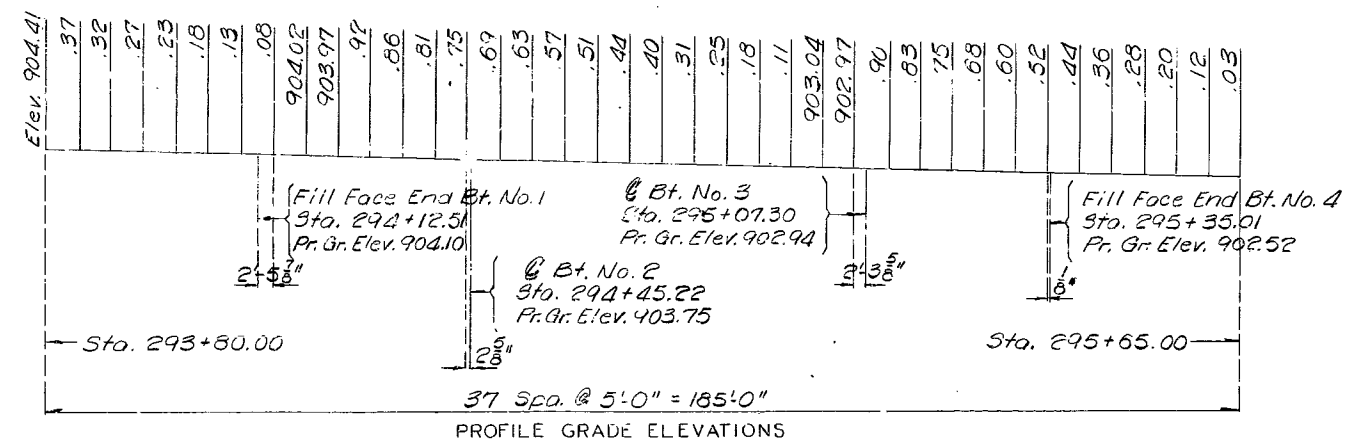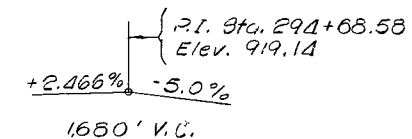

PROFILE GRADE ELEVATIONS


FED. ROAD DIST. NO.	STATE	FED. AID PROJ. NO.	FISCAL YEAR	SHEET NO.	TOTAL SHEETS
5	MO.		19	51	

FINAL PLANS

MISSOURI HIGHWAY AND TRANSPORTATION COMMISSION

(40'-40'-40') PREFABRICATED SEGMENTED WF BEAM SPANS

FED. ROAD DIST. NO.	STATE	FED. AID PROJ. NO.	FISCAL YEAR	SHEET NO.	TOTAL SHEETS
5	MO.		19	26	
SEC. 1 & 12			TWP. 50N RGE. 33W		

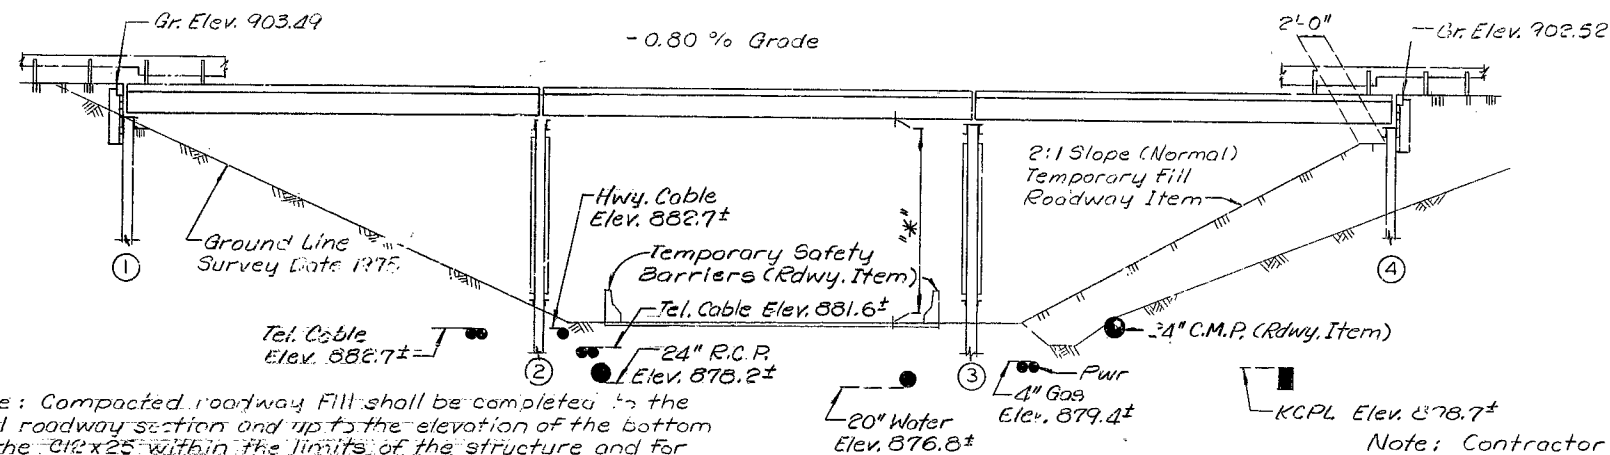

ELEVATION

Note: Contractor shall exercise caution during construction to prevent damage to existing underground utilities.

A minimum vertical clearance of 13'-6" from crown of existing lane to nearest temporary construction falsework shall be maintained during construction.

*" Final vertical clearance from top of roadway to bottom of superstructure to be at least 15'-0".

GENERAL NOTES:

Design Specifications: R.R.S.H.T.O. - 1977 Load Factor Design

Design Loading: H20-44

Design Unit Stresses:

Structural Steel (A.S.T.M. A588) $F_y = 50,000$ psi

Structural Carbon Steel (Piling & Sway Bracing) $F_s = 20,000$ psi

Steel Pile $F_b = 9,000$ psi

Timber:

All timber shall be standard rough sawn.

All timber shall be treated with creosote or pentachlorophenol solution.

All timber shall have a minimum strength of 1500 psi and shall be either douglas fir conforming to the requirements of paragraph 123 b (MC-19), 124 b (MC-19) and 130 b of the Standard Grading Rules for West Coast Lumber, No. 16, December 1, 1976 Revised Edition or southern pine conforming to the requirements of paragraphs 312 (MC-19), 342 (MC-19) and 405.1 of the Southern Pine Inspection Bureau Grading Rules, 1977 Edition or a satisfactory grade of sound native oak.

Note: All bolts shall be High Tensile Strength Bolts.

ESTIMATED QUANTITIES		
ITEM		TOTAL
Structural Steel Pile (10")	Lin. Ft.	991
Furnishing Superstructure	Lump Sum	1
Erecting Superstructure	Lump Sum	1
Removing & Storing Superstructure	Lump Sum	1

PILE DATA				
BENT NO.	1	2	3	4
Pile Type and Size	HP10x42	HP10x42	HP10x42	HP10x42
Number	7	5	5	7
Approximate Length Ft.	43	41	41	40
Design Bearing Tons	15	22	22	15
Hammer Energy Req'd. Ft. Lbs.	7000	7000	7000	7000

Note: Minimum energy requirement of hammer based on plan length and design bearing value of piles.

All pile shall be driven to practical refusal.

B.M. Elev. 902.15 on top of Rt. wing bent No. 4 Sta. 295+35.75

TEMPORARY BRIDGE OVER RUSSELL ROAD

STATE ROAD FROM ROUTE 210 NORTH

IN KANSAS CITY

PROJECT NO. I-1R-35-1(120)

STA. 9+30.52

JOB NO. 4-I-35-340

RTE. I-35

CLAY

COUNTY

DATE 1/13/83

STD.


STD.

L-659T

DESIGNED Sept. 1981
 DETAILED Nov. 1981
 CHECKED Dec. 1981





Note: This drawing is not to scale. Follow dimensions.

Sheet No. 1 of 4


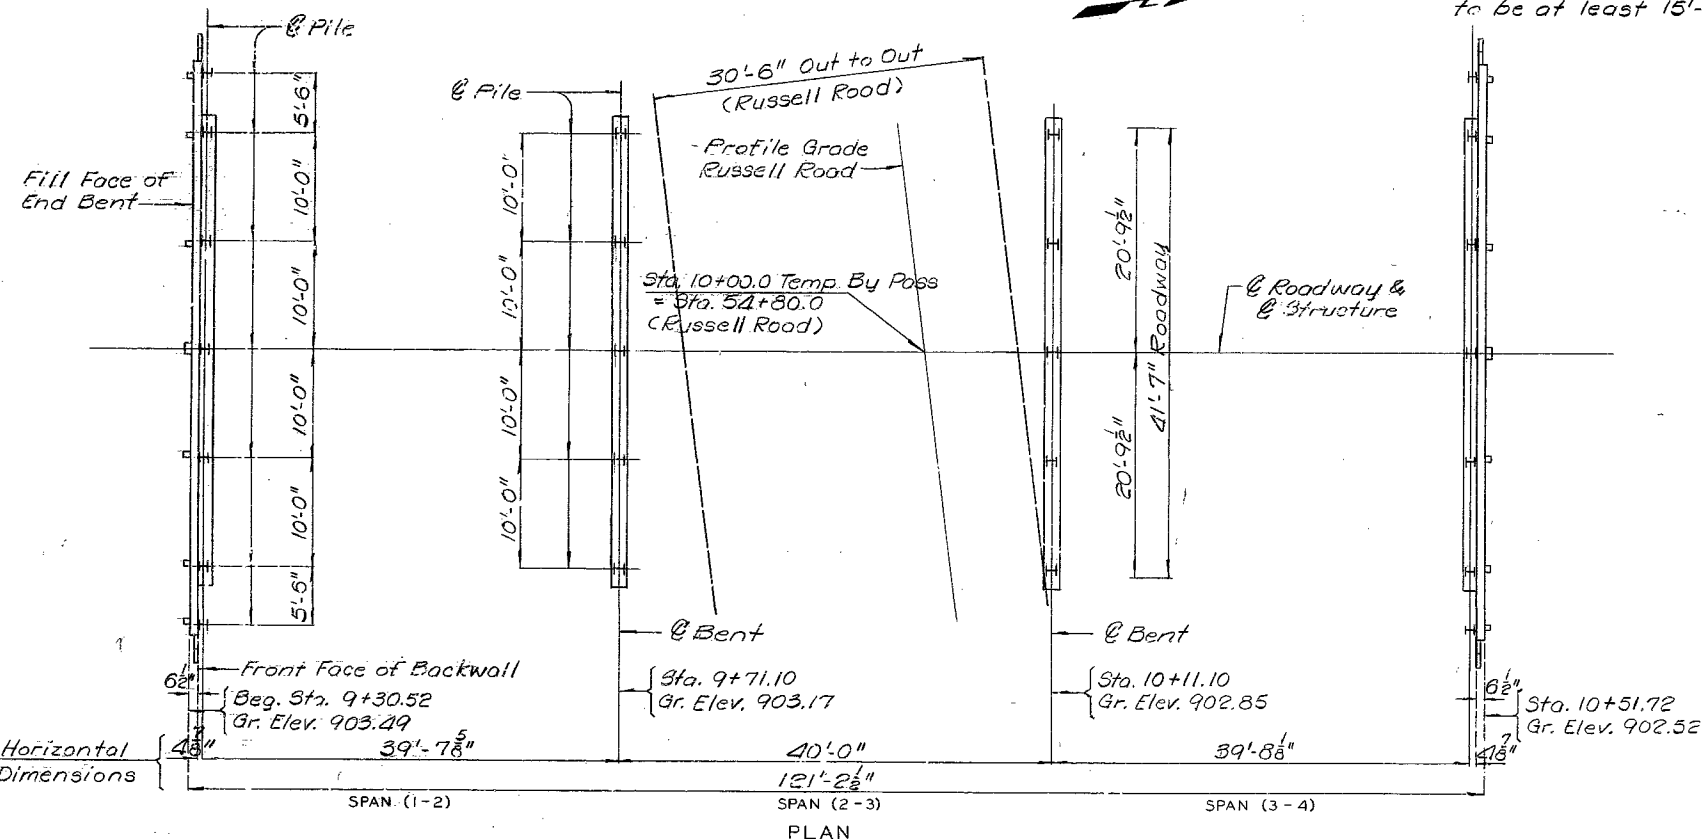


PLAN


FED. ROAD DIST. NO.	STATE	FED. AID PROJ. NO.	FISCAL YEAR	SHEET NO.	TOTAL SHEETS
5	MO.		19	27	

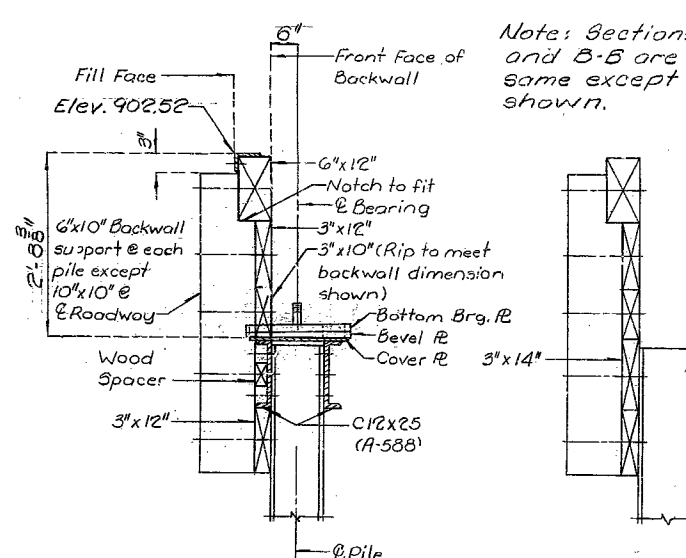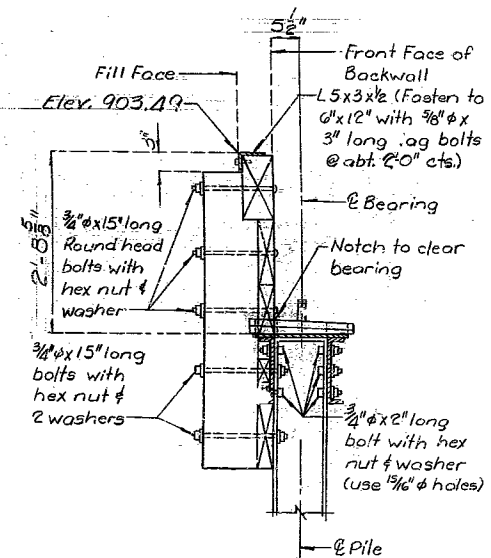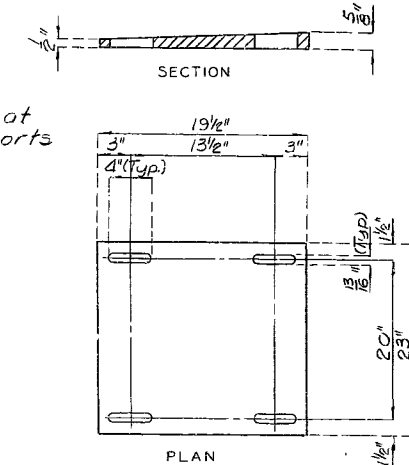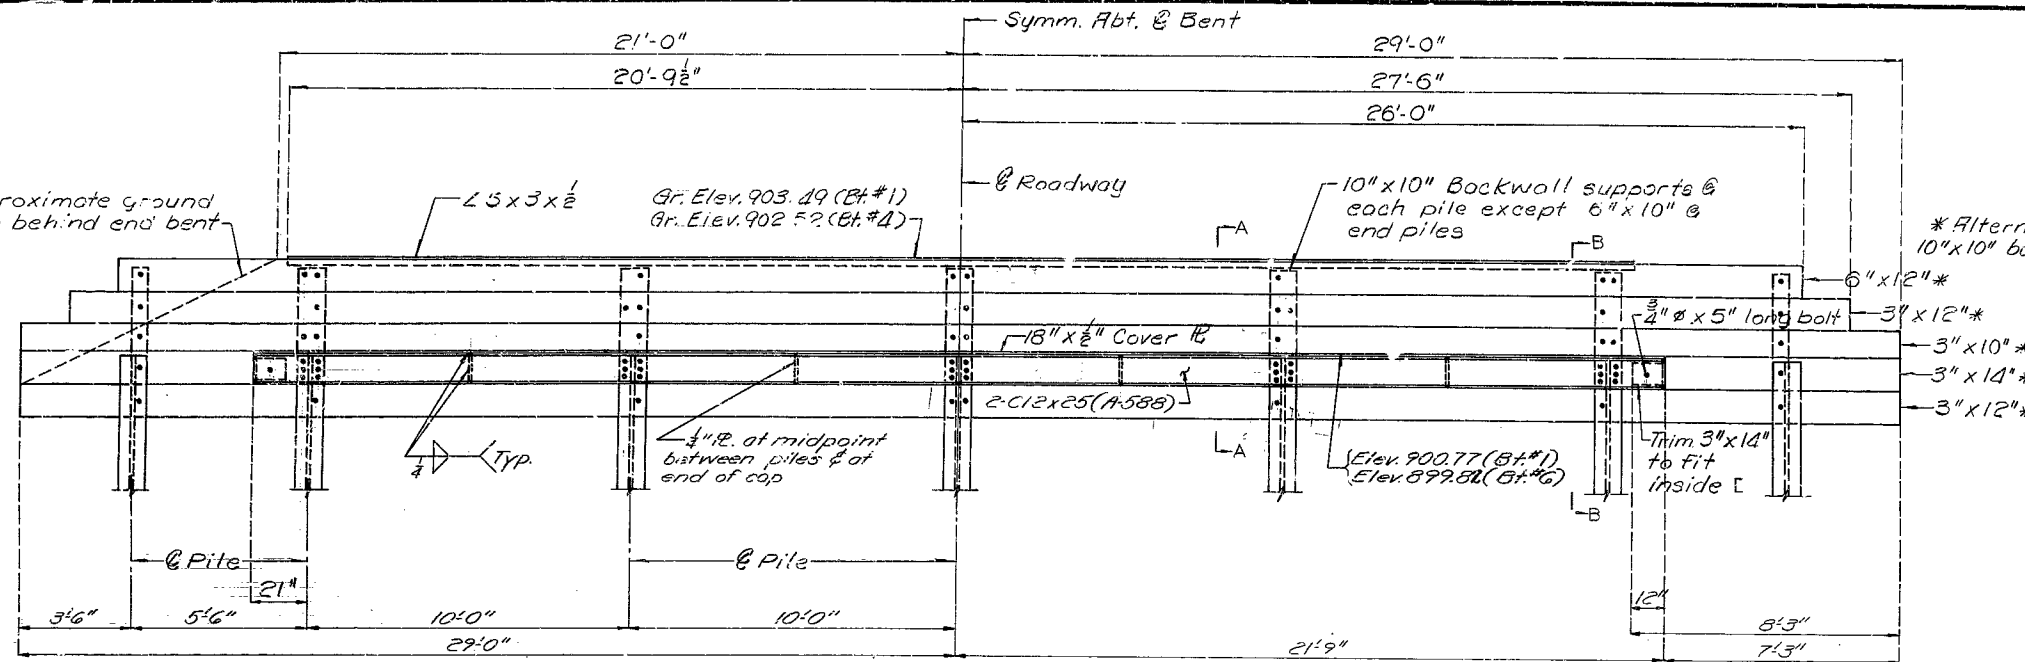

Note: Sections A-A and B-B are the same except as shown.

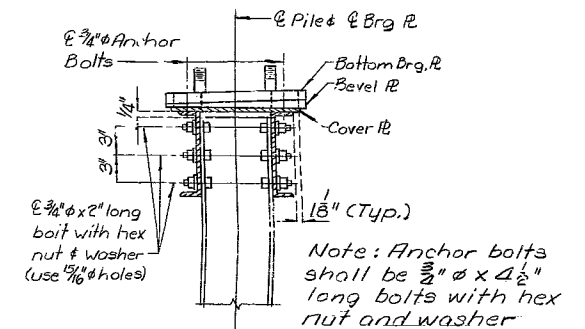
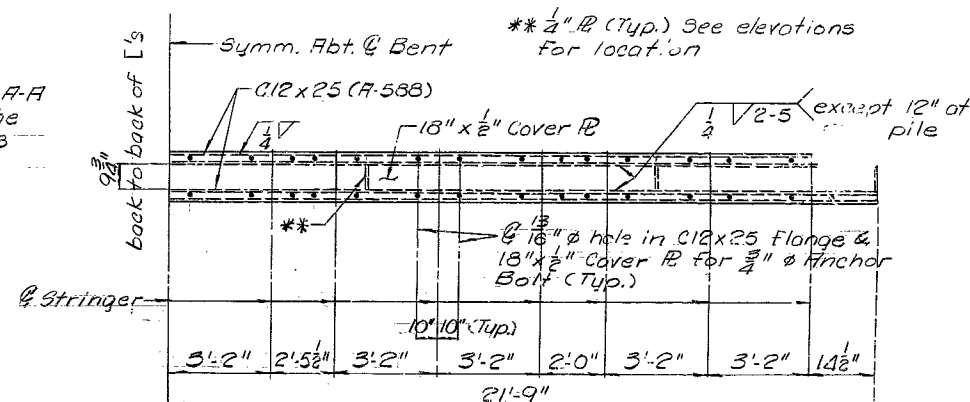


Note: Bolt spacing & pile clearance is same at End Bents & Int. Bents.

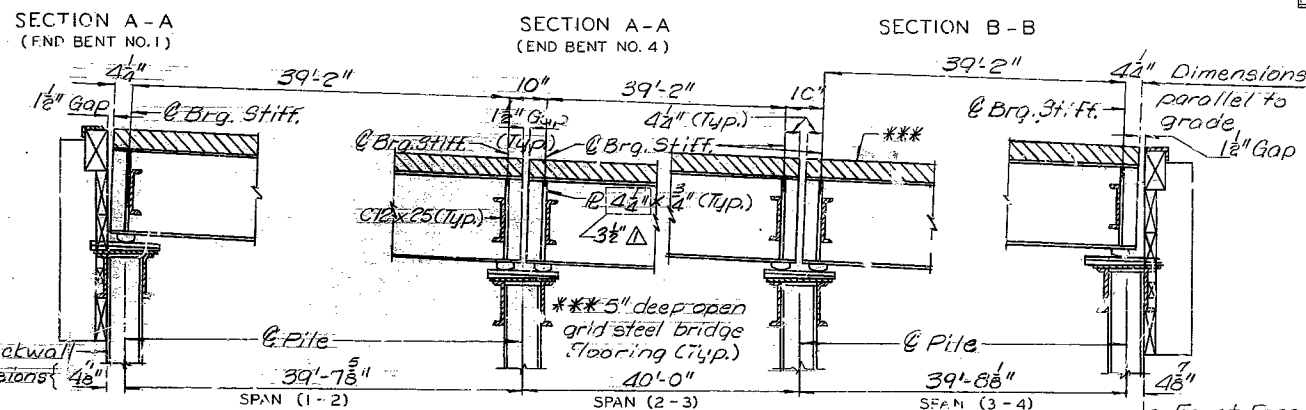

Note: This drawing is not to scale. Follow dimensions.

Revised March 7, 1983

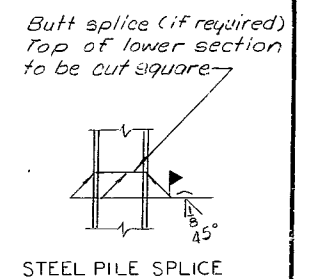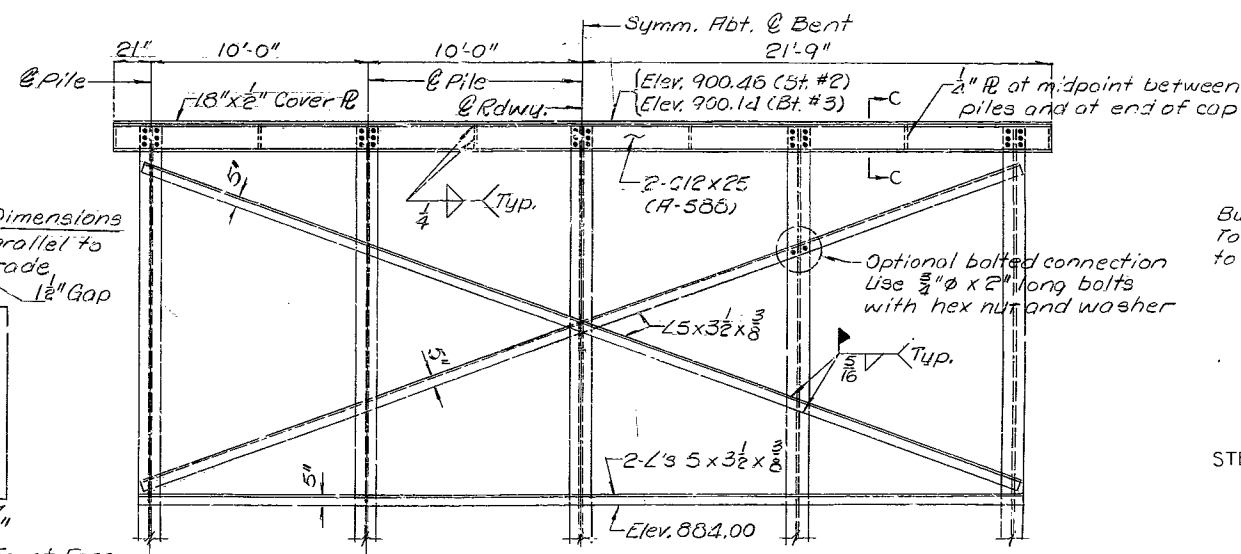

DETAILED Nov. 19 81
CHECKED Dec. 19 81

Sheet No. 2 of 4







CLAY COUNTY

L-659T


322

Note: Field Connections, High Strength
Bolts $\frac{7}{8}" \phi$, holes $1\frac{1}{8}" \phi$ except as shown

FED. ROAD DIST. NO.	STATE	FED. AID PROJ. NO.	FISCAL YEAR	SHEET NO.	TOTAL SHEETS
5	MO.		19	28	

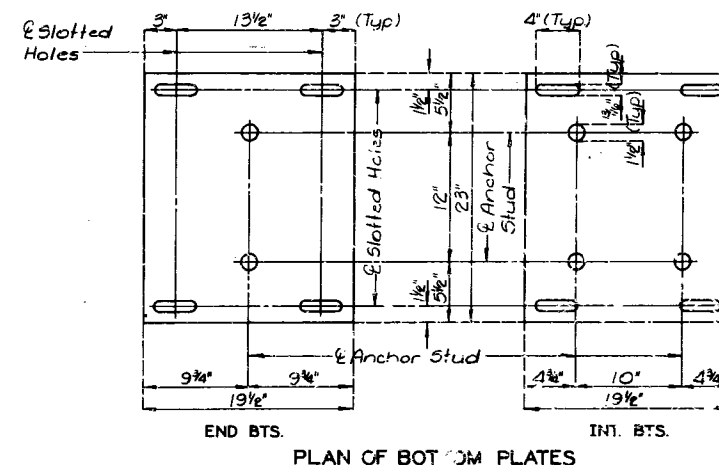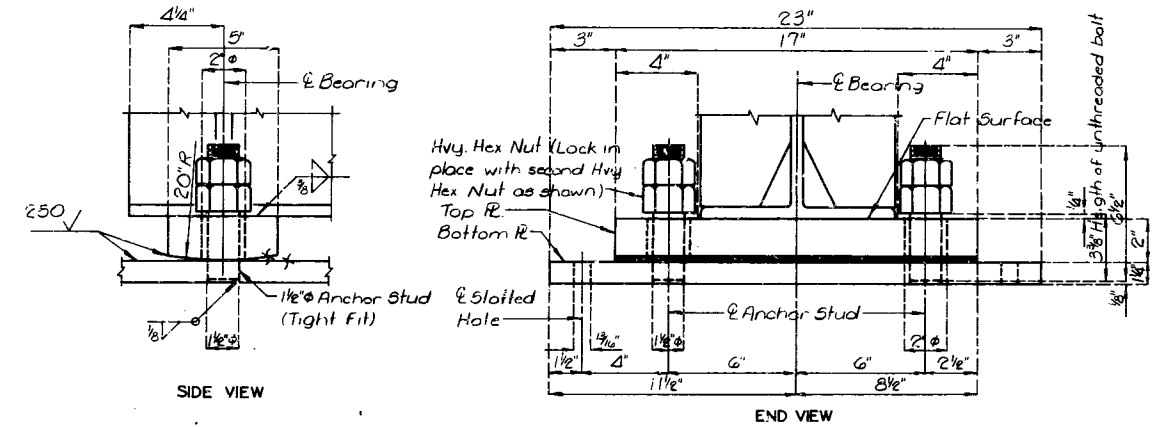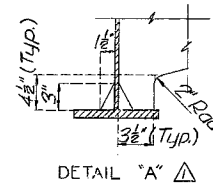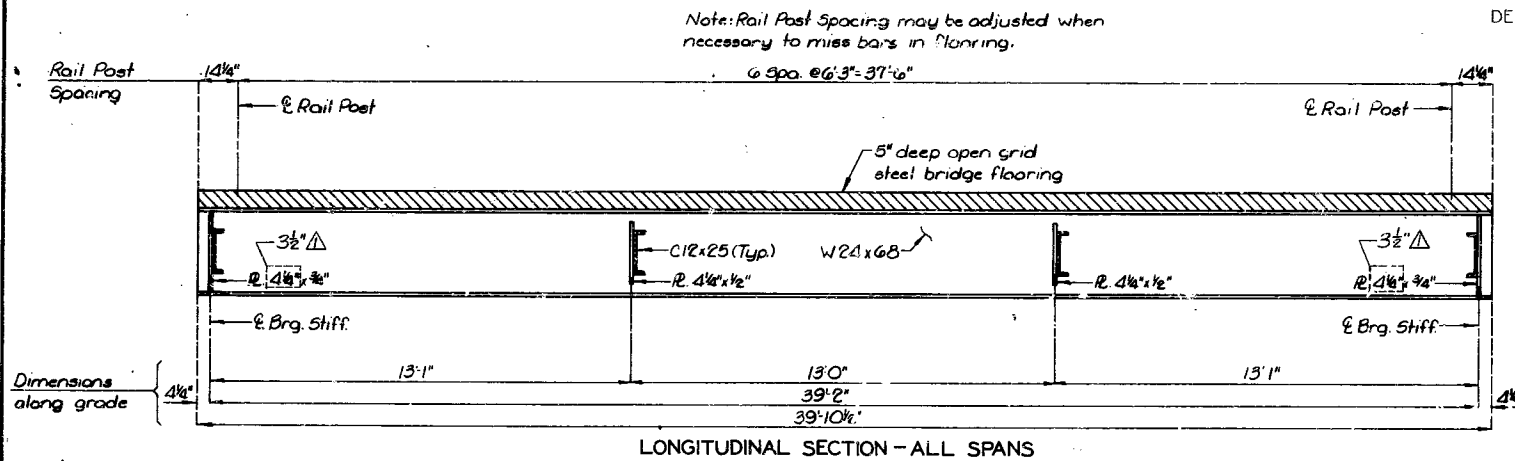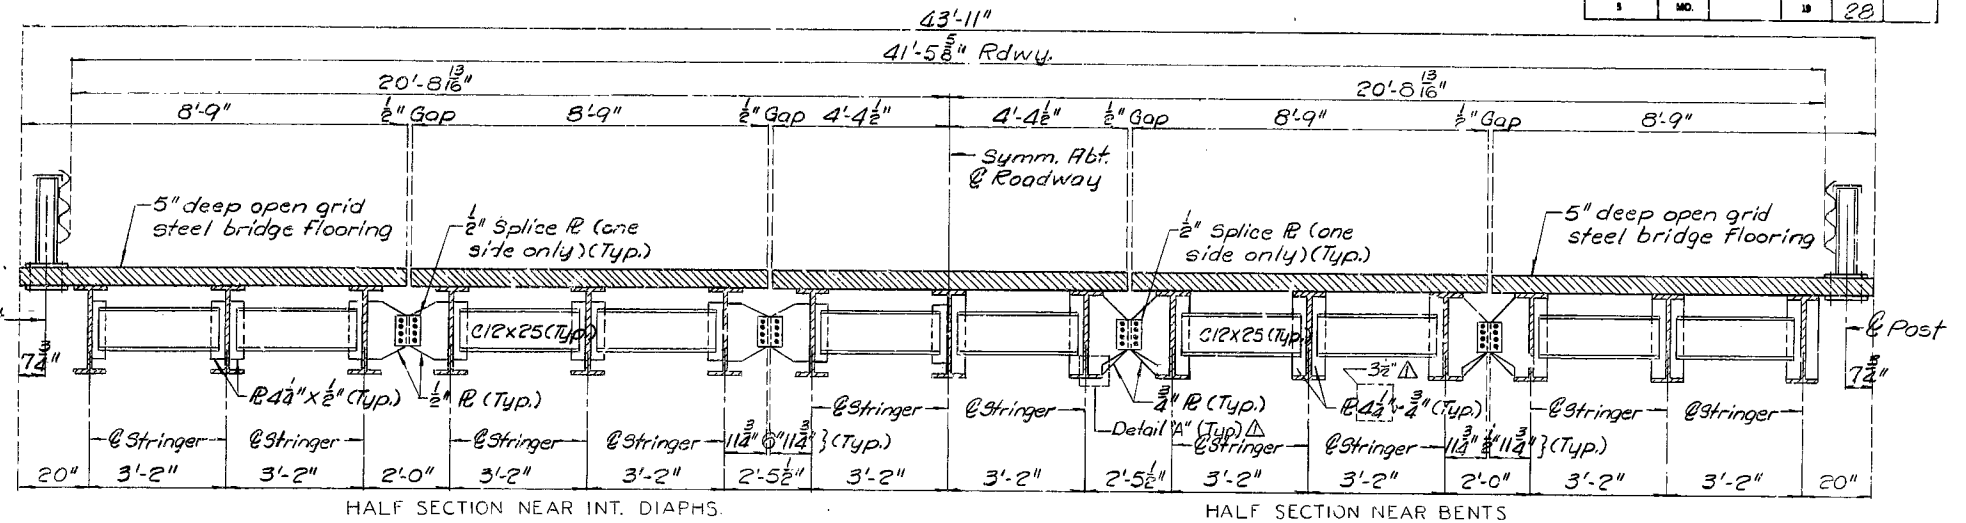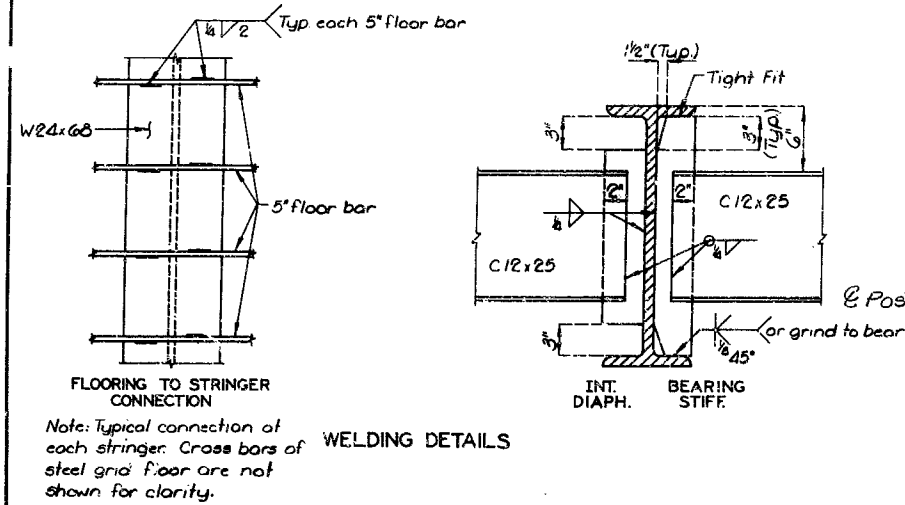

No. Required: 50 Top R's.
30 Bottom R's (Int. Bts)
30 Bottom R's (End Bts)

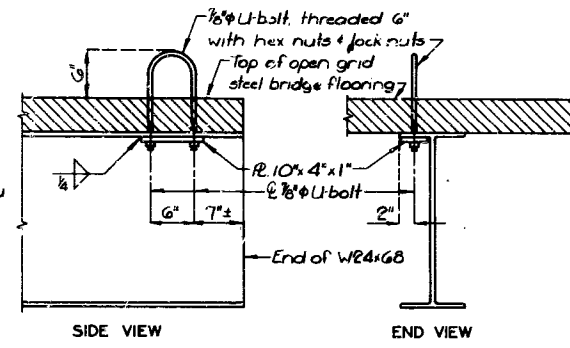

Note: Steel bridge flooring shall be Greulich 5-Inch RB/6.0M, Reliance 5" Weldlock Type "H", or Foster 5" Open Steel Bridge Flooring. Trim bars will be required at the sides and ends of each 39'10 1/2" unit.

Note: All Structural Steel shall be A-53B except piles and sway bracing which shall be A-36.

Note: U-bolt Lifting Device to be on the inside top flange at both ends of each exterior stringer of each unit. U-bolts to be removed during the time the bridge is open to traffic. Position of U-bolts may be shifted slightly to miss bars in flooring. 40 U-bolt Lifting Devices required.

DETAILED Nov. 1981
CHECKED Dec. 1981

Note: This drawing is not to scale. Follow dimensions.

Revised March 7, 1983


Sheet No. 3 of 4

DETAILS OF BEARINGS

CLAY COUNTY

L-659T

FABRICATION OF STRUCTURAL STEEL SHALL BE IN ACCORDANCE WITH SECTION 712 OF THE STANDARD SPECIFICATIONS.

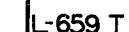

423


SPS W-BEAM	Revised
OCT. 1976	JUNE 1981

DETAILED SEPT. 1981
CHECKED Dec. 1981

MISSOURI HIGHWAY AND TRANSPORTATION COMMISSION

(40'-40'-40') PREFABRICATED SEGMENTED WF BEAM SPANS

FED. ROAD DIST. NO.	STATE	FED. AID PROJ. NO.	FISCAL YEA.	SHEET NO.	TOTAL SHEETS
5	MO.		19	26	
SEC. 1 & 12 TWP. 50N RGE. 33W					

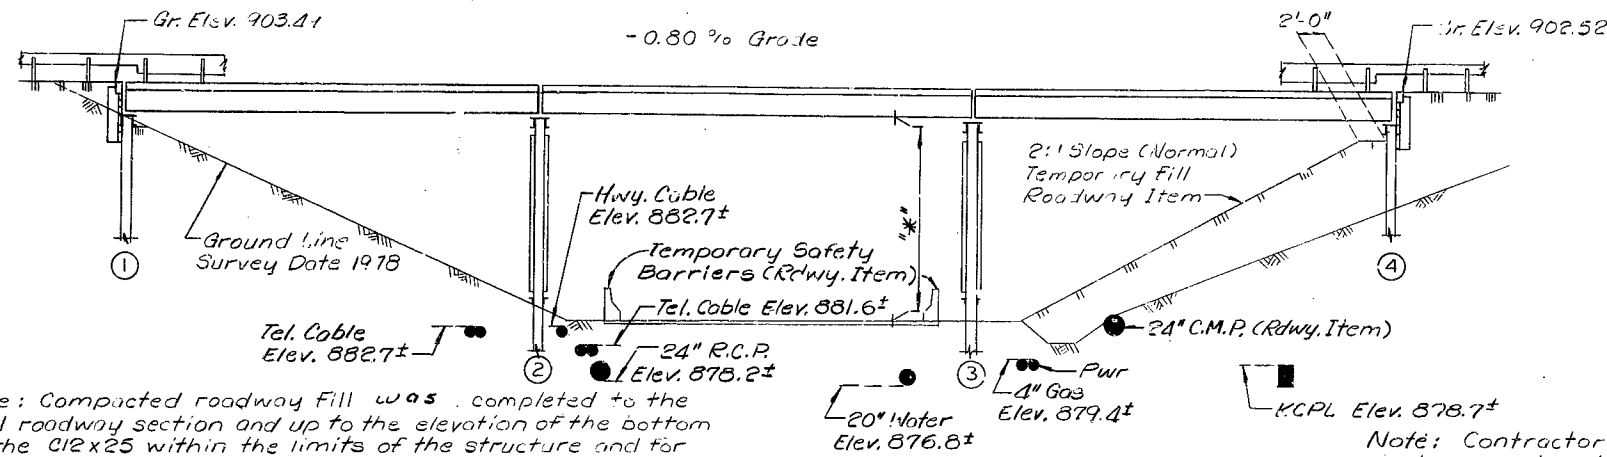

Note: Compacted roadway fill was completed to the final roadway section and up to the elevation of the bottom of the 42x25 within the limits of the structure and for not less than 25' in back of the fill face of the end bents before piles were driven for any bents falling within the embankment section.

ELEVATION

Note: Contractor did exercise caution during construction to prevent damage to existing underground utilities.
A minimum vertical clearance of 13'-6" from crown of existing lane to nearest temporary construction falsework was maintained during construction.
** Final vertical clearance from top of roadway to bottom of superstructure is at least 15'-0".

GENERAL NOTES:

FINAL PLANS



Design Specifications: A.R.S.H.T.O. - 1977 Load Factor Design

Design Loading: H20-44

Design Unit Stresses:
Structural Steel (A.S.T.M. A588) $f_y = 50,000$ psi
Structural Carbon Steel (Piling & Sway Bracing) $f_s = 20,000$ psi
Steel Pile $f_b = 9,000$ psi

Timber:
All timber was standard rough sawn.
All timber was treated with creosote or pentachlorophenol solution.
All timber did have a minimum strength of 1500 psi and was either Douglas fir conforming to the requirements of paragraph 123 b (MC-19), 124 b (MC-19) and 130 b b of the Standard Grading Rules for West Coast Lumber, No. 16, December 1, 1976 Revised Edition or southern pine conforming to the requirements of paragraphs 312 (MC-19), 342 (MC-19) and 405.1 of the Southern Pine Inspection Bureau Grading Rules, 1977 Edition or a satisfactory grade of sound native oak.

Note: All bolts were High Tensile Strength Bolts.

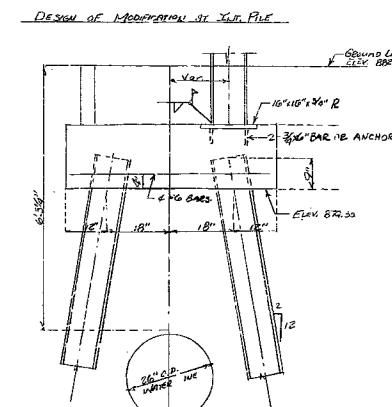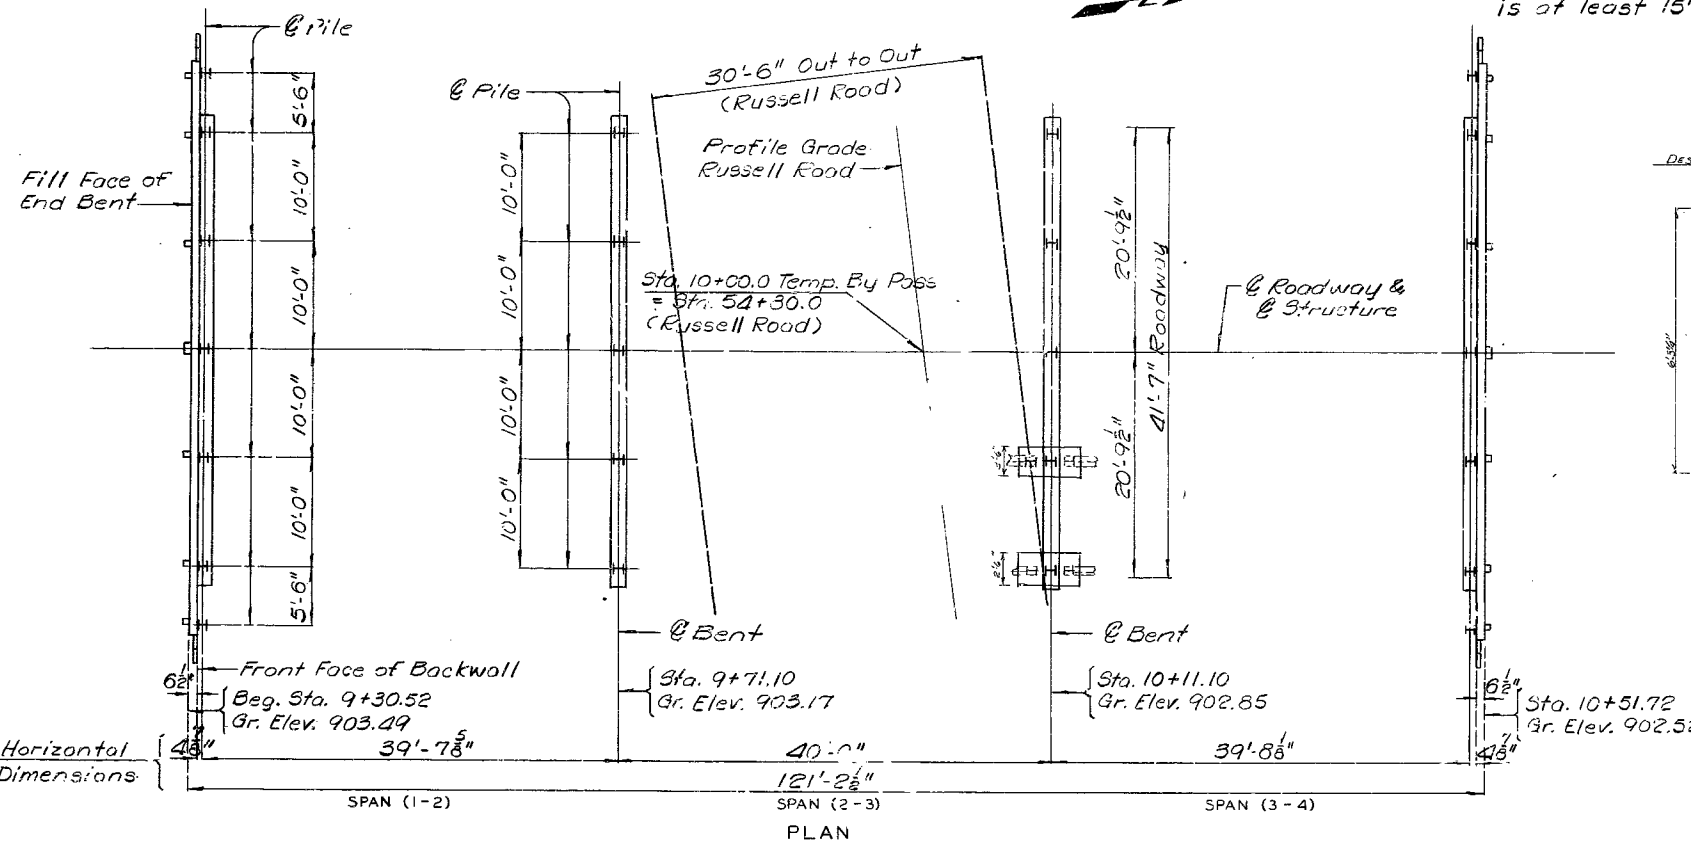

QUANTITIES		TOTAL
ITEM		
Structural Steel Pile (10")	Lin. Ft.	1050
Furnishing Superstructure	Lump Sum	1
Erecting Superstructure	Lump Sum	1
Removing & Storing Superstructure	Lump Sum	1
CONTINGENT ITEMS		
Class I Exc.	Cu. Yds.	2.7
Class B Concrete	Cu. Yds.	1.4
Furnish & install metal plates	Each	2
Remove & replace concrete Pavement	Lump Sum	1
Repair angle irons	F.A.	320.69
Repair angle irons	F.A.	337.16

PILE DATA				
BENT NO.	1	2	3	4
Pile Type and Size	HPI0x42	HPI0x42	HPI0x42	HPI0x42
Number	7	5	9	7
Approximate Length Ft.	43	42	28	41
Design Bearing Tons	15	22	22	15
Hammer Energy Req'd. Ft. Lbs.	7000	7000	7000	7000

Note: Minimum energy requirement of hammer based on pile length and design bearing value of piles.
All piles were driven to practical refusal.

B.M. Elev. 904.60 on top of Rt. barrier curb Abut. #4.
Sta. 295+47, L-659R S.B.L.

TEMPORARY BRIDGE OVER RUSSELL ROAD

STATE ROAD FROM ROUTE 210 NORTH
IN KANSAS CITY

PROJECT NO. I-1R-35-1(120) STA. 9+30.52

JOB NO. 4-I-35-340 RTE. I-35

CLAY COUNTY

DATE 1/15/83

DESIGNED Sept. 1981
DETAILED Nov. 1981
CHECKED Dec. 1981

Note: This drawing is not to scale. Follow dimensions.

Sheet No. 1A of 4

STD.
STD.
L-659T



Missouri Department of Transportation
Bridge Inventory and Inspection System
Structural Inventory & Appraisal Sheet

May 2, 2024
4:18:47pm

COUNTY : CLAY BRIDGE : L0659 R REVIEW STATUS : APPROVED NBI STATUS : P
RECORD TYPE : ROUTE CARRIED 'ON' STRUCT RUN DATE : 3/7/2024 SUBMITTAL YEAR : 2023

GENERAL STRUCTURE INFORMATION			ROUTE DESIGNATION INFORMATION		
1	State	MISSOURI	5A	Record Type	ROUTE CARRIED 'ON' STRUCT
2	District	KC	5B	Route Signing Prefix	IS
3	County	CLAY	5C	Designated Level of Service	MAINLINE
8	Federal ID No.	6412	5D	Route Number	00029
27	Year Built	1954	5E	Directional Suffix	NOT APPLICABLE
106	Year Reconstructed	0	7	Facility Carried	IS 29 S
42A	Type of Service On	HIGHWAY	12	Base Hwy. Network	YES
21	Structure Maintenance	STATE HIGHWAY AGENCY	13A	LRS Inventory Route No.	0000005878
22	Structure Owner	STATE HIGHWAY AGENCY	13B	Subroute No.	00
33	Br. Median Code	NO MEDIAN	20	Toll Status	ON FREE ROAD
37	Historical Significance	NOT ELIGIBLE FOR NR OF HP	26	Functional Classification	11-UR PRNCPL ARTERIAL-IS
101	Parallel Struc Desg	LEFT	28A	Lanes on Structure	03
103	Temporary Structure	NOT TEMPORARY	100	STRAHNET Designation	ON A DEFENSE HWY
112	NBIS Bridge Length	YES	104	National Highway System	ON NHS
			105	Federal Lands Highway	NOT APPLICABLE
			110	Designated Nat. Network	YES
STRUCTURE LOCATION INFORMATION			STRUCTURE TRAFFIC INFORMATION		
4	Place	AVONDALE CITY	29	AADT	43245
	Code	02800	30	AADT Year	2023
9	Location	S 1 T 50 N R 33 W	102	Direction of Traffic	1-WAY TRAFFIC
11	Milepoint	123.90 miles	109	AADT Truck Percent	12%
16	Latitude	39 D 9 M 60 S	114	Future AADT	77841
17	Longitude	94 D 33 M 33 S	115	Future AADT Year	2043
UNDERRECORD INFORMATION			STRUCTURE GEOMETRIC INFORMATION		
6	Features Intersected	CST NE PARVIN RD	10	Inventory Rte. Vert. Clear	99 Ft. 99 In.
42B	Type of Service Under	HIGHWAY	19	By pass Detour Length	0.62 miles
28B	Lanes Under Structure	02	32	Approach Roadway Width	51 Ft. 10 In.
54A	Vert. Clearance Ref.	HIGHWAY	34	Skew	7.00 Degrees
54B	Vert. Clearance	14 Ft. 12 In.	35	Struct. Flared	NO
55A	Rt. Lat Clear Ref.	HIGHWAY	47	Total Horiz. Clear	51 Ft. 10 In.
55B	Rt. Lat Clearance	6 Ft. 11 In.	48	Maximum Span Length	62 Ft. 0 In.
56	Left Lat Clearance	0 Ft. 0 In.	49	Structure Length	123 Ft. 0 In.
38	Navigation Control	N/A	50A	Left Curb/Sidewalk Width	0 Ft. 0 In.
39	Nav Vertical Clear	0 Ft. 0 In.	50B	Right Curb/Sidewalk Width	0 Ft. 0 In.
40	Nav Horizontal Clear	0 Ft. 0 In.	51	Curb to Curb Br. Width	50 Ft. 10 In.
111	Nav. Pier Protection		52	Deck Width (Out-Out)	53 Ft. 6 In.
116	Nav. Cl. Vert. Clear		53	Vert. Clearance Over Deck	99 Ft. 99 In.

Design_No = 10659



Missouri Department of Transportation
Bridge Inventory and Inspection System
Structural Inventory & Appraisal Sheet

May 2, 2024
4:18:47pm

COUNTY : CLAY BRIDGE : L0659 R REVIEW STATUS : APPROVED NBI STATUS : P
RECORD TYPE : ROUTE CARRIED 'ON' STRUCT RUN DATE : 3/7/2024 SUBMITTAL YEAR : 2023

LOAD RATING AND POSTING INFORMATION			MATERIAL/CONSTRUCTION INFORMATION		
31	Design Load	HS 20+MOD	43A	Main Struc. Mat type	PRESTRSED CONCRETE CONTIN
41	Structure Status	A - OPEN NO RESTRICTIONS	43B	Main struc Constr. Type	STRINGER/MULTIBEAM - GRD
63	Oper. Rating Meth.	LOAD FACTOR	45	# of Main Spans	3
64	Operating Rating	75 Tons.	44A	Appr Struc. Mat type	
65	Inventory Rating Meth	LOAD FACTOR	44B	Appr Struc. Cnstr. type	
66	Inventory Rating	41 Tons.	46	# of Approach Span	0
70	Bridge Posting Code	=>LEGAL LOADS	107	Deck Mat/Constr.	1 CONCRETE CIP
			108A	Wear Surf Mat/Constr.	1 MONO CONCRETE
			108B	Membrane Mat/Constr.	0 NONE
			108C	Deck Protect Mat/Constr.	1 EPOXY
PROPOSED IMPROVEMENT INFORMATION			CONDITION RATING INFORMATION		
Sufficiency Rating 92.9 Percent			58	Deck Cond. Rating	7
Deficiency Rating NOT DEFICIENT			59	Superstructure Cond. Rating	6
Funding Eligibility			60	Substructure Cond. Rating	6
75A	Proposed Work		61	Channel /Channel Protection Cond. Rating	N
75B	Work Done By		62	Culvert Cond. Rating	N
76	New Struc Length	0 Ft. 0 In.			
94	Struc Improve Cost	\$ 0,000	INSPECTION INFORMATION		
95	Roadway Improve Cost	\$ 0,000	90	Gen. Insp Date	9 / 22
96	Total Project Cost	\$ 0,000	91	Gen. Insp. Frequency	24 Months
97	Year of Cost Estimates	0	92A	Frac. Critical Inspection	N Months
			93A	Frac. Critical Insp. Date	
			92B	Underwater Inspection	N Months
			93B	Underwater Insp. Date	
			92C	Special Inspection	N Months
			93C	Special Inspection Date	
APPRAISAL RATING INFORMATION			BORDER BRIDGE INFORMATION		
36A	Br. Rail App. Rating	MEETS ACCEPTBLE STND	98	Neighboring State Code	
36B	Transition Rail App. Rating	MEETS ACCEPTBLE STND	98B	Neighboring State % Respon	
36C	Approach Rail App. Rating	MEETS ACCEPTBLE STND	99	Neighboring State Struc. No.	
36D	Rail End Treat. App. Rating	MEETS ACCEPTBLE STND			
67	Struc Eval App. Rating	6	APPROVED POSTING INFORMATION		
68	Deck Geometry App. Rating	5	FIELD POSTING INFORMATION		
69	Underclearance App. Rating	4	Approved Posting Category S-1		
71	Waterway Adeq. App. Rating	N	Field Posting Category S-1		
72	Approach Road App. Rating	8	Ton1 Ton2 Ton3		
113	Scour Assess App. Rating	N	Ton1 Ton2 Ton3		
			Tonnage Values for Posting Sign		
			General Text for Posting Sign		
			NO POSTING REQUIRED		

Design_No = 10659



Missouri Department of Transportation
Bridge Inventory and Inspection System
Structural Inventory & Appraisal Sheet

May 2, 2024
4:18:47pm

COUNTY : CLAY BRIDGE : L0659 R REVIEW STATUS : APPROVED NBI STATUS : P
RECORD TYPE : ROUTE 'UNDER' STRUCT RUN DATE : 3/7/2024 SUBMITTAL YEAR : 2023

GENERAL STRUCTURE INFORMATION			ROUTE DESIGNATION INFORMATION		
1	State	MISSOURI	5A	Record Type	ROUTE 'UNDER' STRUCT Code : 2
2	District	KC	5B	Route Signing Prefix	CST
3	County	CLAY	5C	Designated Level of Service	MAINLINE
8	Federal ID No.	6412	5D	Route Number	00000
27	Year Built	1954	5E	Directional Suffix	NOT APPLICABLE
106	Year Reconstructed	0	7	Facility Carried	IS 29 S
42A	Type of Service On	HIGHWAY	12	Base Hwy. Network	
21	Structure Maintenance		13A	LRS Inventory Route No.	
22	Structure Owner		13B	Subroute No.	
33	Br. Median Code		20	Toll Status	ON FREE ROAD
37	Historical Significance		26	Functional Classification	16-URBAN MINOR ARTERIAL
101	Parallel Struc Desg	LEFT	28A	Lanes on Structure	03
103	Temporary Structure	NOT TEMPORARY	100	STRAHNET Designation	RTE NOT A DEFENSE HWY
112	NBIS Bridge Length		104	National Highway System	NOT ON NHS
			105	Federal Lands Highway	
			110	Designated Nat. Network	NO
STRUCTURE LOCATION INFORMATION			STRUCTURE TRAFFIC INFORMATION		
4	Place	AVONDALE CITY	29	AADT	5728
	Code	02800	30	AADT Year	2023
9	Location	S 1 T 50 N R 33 W	102	Direction of Traffic	2-WAY TRAFFIC
11	Milepoint	0.79 miles	109	AADT Truck Percent	8%
16	Latitude	39 D 9 M 60 S	114	Future AADT	
17	Longitude	94 D 33 M 33 S	115	Future AADT Year	
UNDERRECORD INFORMATION			STRUCTURE GEOMETRIC INFORMATION		
6	Features Intersected	CST NE PARVIN RD	10	Inventory Rte. Vert. Clear	14 Ft. 12 In.
42B	Type of Service Under	HIGHWAY	19	By pass Detour Length	0.00 miles
28B	Lanes Under Structure	02	32	Approach Roadway Width	
54A	Vert. Clearance Ref.		34	Skew	
54B	Vert. Clearance		35	Struct. Flared	
55A	Rt. Lat Clear Ref.		47	Total Horiz. Clear	15 Ft. 5 In.
55B	Rt. Lat Clearance		48	Maximum Span Length	62 Ft. 0 In.
56	Left Lat Clearance		49	Structure Length	123 Ft. 0 In.
38	Navigation Control		50A	Left Curb/Sidewalk Width	
39	Nav Vertical Clear		50B	Right Curb/Sidewalk Width	
40	Nav Horizontal Clear		51	Curb to Curb Br. Width	
111	Nav. Pier Protection		52	Deck Width (Out-Out)	
116	Nav. Cl. Vert. Clear		53	Vert. Clearance Over Deck	

Design_No = 10659



Missouri Department of Transportation
Bridge Inventory and Inspection System
Structural Inventory & Appraisal Sheet

May 2, 2024
4:18:47pm

COUNTY : CLAY BRIDGE : L0659 R REVIEW STATUS : APPROVED NBI STATUS : P
RECORD TYPE : ROUTE 'UNDER' STRUCT RUN DATE : 3/7/2024 SUBMITTAL YEAR : 2023

LOAD RATING AND POSTING INFORMATION		MATERIAL/CONSTRUCTION INFORMATION	
<div>31</div> Design Load		<div>43A</div> Main Struc. Mat type	PRESTRSED CONCRETE CONTIN
<div>41</div> Structure Status		<div>43B</div> Main struc Constr. Type	STRINGER/MULTIBEAM - GRD
<div>63</div> Oper. Rating Meth.		<div>45</div> # of Main Spans	
<div>64</div> Operating Rating		<div>44A</div> Appr Struc. Mat type	
<div>65</div> Inventory Rating Meth		<div>44B</div> Appr Struc. Cnstr. type	
<div>66</div> Inventory Rating		<div>46</div> # of Approach Span	
<div>70</div> Bridge Posting Code		<div>107</div> Deck Mat/Constr.	
		<div>108A</div> Wear Surf Mat/Constr.	
		<div>108B</div> Membrane Mat/Constr.	
		<div>108C</div> Deck Protect Mat/Constr.	
PROPOSED IMPROVEMENT INFORMATION		CONDITION RATING INFORMATION	
Sufficiency Rating		<div>58</div> Deck Cond. Rating	
Deficiency Rating		<div>59</div> Superstructure Cond. Rating	
Funding Eligibility		<div>60</div> Substructure Cond. Rating	
<div>75A</div> Proposed Work		<div>61</div> Channel /Channel Protection Cond. Rating	
<div>75B</div> Work Done By		<div>62</div> Culvert Cond. Rating	
<div>76</div> New Struc Length			
<div>94</div> Struc Improve Cost		INSPECTION INFORMATION	
<div>95</div> Roadway Improve Cost		<div>90</div> Gen. Insp Date	
<div>96</div> Total Project Cost		<div>91</div> Gen. Insp. Frequency	
<div>97</div> Year of Cost Estimates		<div>92A</div> Frac. Critical Inspection	
		<div>93A</div> Frac. Critical Insp. Date	
		<div>92B</div> Underwater Inspection	
		<div>93B</div> Underwater Insp. Date	
		<div>92C</div> Special Inspection	
		<div>93C</div> Special Inspection Date	
APPRAISAL RATING INFORMATION		BORDER BRIDGE INFORMATION	
<div>36A</div> Br. Rail App. Rating		<div>98</div> Neighboring State Code	
<div>36B</div> Transition Rail App. Rating		<div>98B</div> Neighboring State % Respon	
<div>36C</div> Approach Rail App. Rating		<div>99</div> Neighboring State Struc. No.	
<div>36D</div> Rail End Treat. App. Rating			
<div>67</div> Struc Eval App. Rating			
<div>68</div> Deck Geometry App. Rating			
<div>69</div> Underclearance App. Rating			
<div>71</div> Waterway Adeq. App. Rating			
<div>72</div> Approach Road App. Rating			
<div>113</div> Scour Assess App. Rating			
APPROVED POSTING INFORMATION		FIELD POSTING INFORMATION	
Approved Posting Category		Field Posting Category	
Ton1 Ton2 Ton3		Ton1 Ton2 Ton3	
Tonnage Values for Posting Sign		Tonnage Values for Posting Sign	
General Text for Posting Sign		General Text for Posting Sign	

Design_No = 10659