



Missouri Department of Transportation
Bridge Inventory and Inspection System
Structural Inventory & Appraisal Sheet

December 9, 2024
7:16:05am

COUNTY : RIPLEY BRIDGE : S0889 1 REVIEW STATUS : APPROVED NBI STATUS : T
RECORD TYPE : ROUTE CARRIED 'ON' STRUCT RUN DATE : 3/15/2024 SUBMITTAL YEAR : 2024

GENERAL STRUCTURE INFORMATION			ROUTE DESIGNATION INFORMATION		
1	State	MISSOURI	5A	Record Type	ROUTE CARRIED 'ON' STRUCT
2	District	SE	5B	Route Signing Prefix	MO
3	County	RIPLEY	5C	Designated Level of Service	MAINLINE
8	Federal ID No.	8892	5D	Route Number	00142
27	Year Built	1933	5E	Directional Suffix	NOT APPLICABLE
106	Year Reconstructed	0	7	Facility Carried	MO 142 E
42A	Type of Service On	HIGHWAY	12	Base Hwy. Network	YES
21	Structure Maintenance	STATE HIGHWAY AGENCY	13A	LRS Inventory Route No.	0000001107
22	Structure Owner	STATE HIGHWAY AGENCY	13B	Subroute No.	00
33	Br. Median Code	NO MEDIAN	20	Toll Status	ON FREE ROAD
37	Historical Significance	HISTORICAL SIGNIF UNKNWN	26	Functional Classification	06-RURAL MINOR ARTERIAL
101	Parallel Struc Desg	NONE EXISTS	28A	Lanes on Structure	02
103	Temporary Structure	NOT TEMPORARY	100	STRAHNET Designation	RTE NOT A DEFENSE HWY
112	NBIS Bridge Length	YES	104	National Highway System	NOT ON NHS
			105	Federal Lands Highway	NOT APPLICABLE
			110	Designated Nat. Network	NO
STRUCTURE LOCATION INFORMATION			STRUCTURE TRAFFIC INFORMATION		
4	Place	VARNER	29	AADT	1181
	Code	75778	30	AADT Year	2023
9	Location	S 36 T 23 N R 3 E	102	Direction of Traffic	2-WAY TRAFFIC
11	Milepoint	91.87 miles	109	AADT Truck Percent	12%
16	Latitude	36 D 35 M 40 S	114	Future AADT	1772
17	Longitude	90 D 41 M 43 S	115	Future AADT Year	2043
UNDERRECORD INFORMATION			STRUCTURE GEOMETRIC INFORMATION		
6	Features Intersected	LOGAN CR	10	Inventory Rte. Vert. Clear	99 Ft. 99 In.
42B	Type of Service Under	WATERWAY	19	By pass Detour Length	19.38 miles
28B	Lanes Under Structure	00	32	Approach Roadway Width	20 Ft. 0 In.
54A	Vert. Clearance Ref.	N/A	34	Skew	15.00 Degrees
54B	Vert. Clearance	0 Ft. 0 In.	35	Struct. Flared	NO
55A	Rt. Lat Clear Ref.	N/A	47	Total Horiz. Clear	20 Ft. 0 In.
55B	Rt. Lat Clearance	0 Ft. 0 In.	48	Maximum Span Length	42 Ft. 12 In.
56	Left Lat Clearance	0 Ft. 0 In.	49	Structure Length	147 Ft. 12 In.
38	Navigation Control	PERMIT NOT REQ	50A	Left Curb/Sidewalk Width	0 Ft. 0 In.
39	Nav Vertical Clear	0 Ft. 0 In.	50B	Right Curb/Sidewalk Width	0 Ft. 0 In.
40	Nav Horizontal Clear	0 Ft. 0 In.	51	Curb to Curb Br. Width	20 Ft. 0 In.
111	Nav. Pier Protection		52	Deck Width (Out-Out)	20 Ft. 12 In.
116	Nav. Cl. Vert. Clear		53	Vert. Clearance Over Deck	99 Ft. 99 In.

Design_No = S0889 and Inventory_Appraisal_Submittal_Year = 2024




Missouri Department of Transportation
Bridge Inventory and Inspection System
Structural Inventory & Appraisal Sheet


December 9, 2024
7:16:05am


COUNTY : RIPLEY BRIDGE : S0889 1 REVIEW STATUS : APPROVED NBI STATUS : T
RECORD TYPE : ROUTE CARRIED 'ON' STRUCT RUN DATE : 3/15/2024 SUBMITTAL YEAR : 2024


LOAD RATING AND POSTING INFORMATION				MATERIAL/CONSTRUCTION INFORMATION			
31	Design Load	H 10		43A	Main Struc. Mat type	STEEL	
41	Structure Status	POSTED FOR LOAD		43B	Main struc Constr. Type	STRINGER/MULTIBEAM - GRD	
63	Oper. Rating Meth.	LOAD FACTOR		45	# of Main Spans	4	
64	Operating Rating	23 Tons.		44A	Appr Struc. Mat type	000	
65	Inventory Rating Meth	LOAD FACTOR		44B	Appr Struc. Cnstr. type	000	
66	Inventory Rating	14 Tons.		46	# of Approach Span	0	
70	Bridge Posting Code	30.0-39.9% BELOW		107	Deck Mat/Constr.	1 CONCRETE CIP	
PROPOSED IMPROVEMENT INFORMATION				108A	Wear Surf Mat/Constr.	6 BITUMINOUS	
Sufficiency Rating 28.2 Percent				108B	Membrane Mat/Constr.	0 NONE	
Deficiency Rating STRUCTURAL				108C	Deck Protect Mat/Constr.	0 NONE	
Funding Eligibility FULL				CONDITION RATING INFORMATION			
75A	Proposed Work	REPLACEMENT SUBSTND LOAD		58	Deck Cond. Rating	4	
75B	Work Done By	Contract		59	Superstructure Cond. Rating	5	
76	New Struc Length	180 Ft. 5 In.		60	Substructure Cond. Rating	5	
94	Struc Improve Cost	\$ 1,044,000		61	Channel /Channel Protection Cond. Rating	5	
95	Roadway Improve Cost	\$ 104,000		62	Culvert Cond. Rating	N	
96	Total Project Cost	\$ 1,566,000		INSPECTION INFORMATION			
97	Year of Cost Estimates	2024		90	Gen. Insp Date	1 / 24	
APPRAISAL RATING INFORMATION				91	Gen. Insp. Frequency	24 Months	
36A	Br. Rail App. Rating	MEETS ACCEPTBLE STND		92A	Frac. Critical Inspection	N Months	
36B	Transition Rail App. Rating	MEETS ACCEPTBLE STND		93A	Frac. Critical Insp. Date		
36C	Approach Rail App. Rating	MEETS ACCEPTBLE STND		92B	Underwater Inspection	N Months	
36D	Rail End Treat. App. Rating	MEETS ACCEPTBLE STND		93B	Underwater Insp. Date		
67	Struc Eval App. Rating	4		92C	Special Inspection	N Months	
68	Deck Geometry App. Rating	2		93C	Special Inspection Date		
69	Underclearance App. Rating	N		BORDER BRIDGE INFORMATION			
71	Waterway Adeq. App. Rating	4		98	Neighboring State Code		
72	Approach Road App. Rating	6		98B	Neighboring State % Respon		
113	Scour Assess App. Rating	8		99	Neighboring State Struc. No.		
APPROVED POSTING INFORMATION				FIELD POSTING INFORMATION			
Approved Posting Category S-16				Field Posting Category S-16			
Ton1 Ton2 Ton3				Ton1 Ton2 Ton3			
Tonnage Values for Posting Sign 16 22 39				Tonnage Values for Posting Sign 16 22 39			
General Text for Posting Sign				General Text for Posting Sign			
TRKS OVR 16 TNS 15MPH ON BR EXCPT SNGL UNIT TRKS WT LIMIT 22 TNS&ALL OTHR TRKS WT LIMIT 39 TNS.				TRKS OVR 16 TNS 15MPH ON BR EXCPT SNGL UNIT TRKS WT LIMIT 22 TNS&ALL OTHR TRKS WT LIMIT 39 TNS.			


Design_No = S0889 and Inventory_Appraisal_Submittal_Year = 2024


		Missouri Department of Transportation				December 09, 2024	
		State Bridge Inspection Report				7:13:20AM	
COUNTY: RIPLEY		DISTRICT: SE		CLASS: STATBR		FED-ID: 8892	
						BRIDGE: S0889	
GENERAL STRUCTURE INFORMATION						***BRIDGE INSPECTION INFORMATION***	
ROUTE: MO142E FEATURE: LOGAN CR STATUS: P-POSTLOAD LOG MILE: 91.338 DETOUR: 19.00 MILES NHS: NO BUILT: 1933 REHAB: LOCATION: S 36 T 23 R 3 E LATITUDE: 36 35 39.92 (DMS) LONGITUDE: 90 41 43.05 (DMS)		# SPANS: 4 LANES ON: 2 LANES UNDER: 0 COMPASS DIRECTION: WEST to EAST DIRECTION OF TRAFFIC: 2-WAY TRAF FUNCTIONAL CLASS: RL-MINOR ARTERIAL NBI OWNER: MODOT NBI MAINTAINED: MODOT MAINTENANCE DISTRICT: SE MAINTENANCE COUNTY: RIPLEY SUB AREA: 7H12		PLACE CODE: 75778 VARNER LENGTH: 148 FT 0 IN MAXIMUM SPAN: 43 FT 1 IN APPROACH ROADWAY: 20 FT 0 IN CURB TO CURB: 20 FT 0 IN OUT TO OUT: 21 FT 0 IN AADT: 1181 AADT YEAR: 2023 AADT TRUCK: 12.4% FUTURE AADT: 1772 FUTURE AADT YEAR: 2043		DATE: 01/11/2024 RESPONSIBILITY: DISTRICT	
						FREQUENCY: 24 CALCULATED INTERVAL**: 24	
						TEAM LEADER: JERROD JERNIGAN ELEMENT: NO	
				INSPECTOR 2: INSPECTOR 4:		INSPECTOR 3:	
						** When calculated interval exceeds the frequency, a justification comment per BIRM is required.	
GENERAL INSPECTION COMMENTS							
FRACTURE CRITICAL INSPECTION INFORMATION				***INDEPTH INSPECTION INFORMATION***			
DATE:		RESPONSIBILITY:		CATEGORY:		DATE:	
FREQUENCY:		CALCULATED INTERVAL**:		NBI:		FREQUENCY:	
TEAM LEADER:		INSPECTOR 3:		METHOD:		TEAM LEADER:	
INSPECTOR 2:		INSPECTOR 4:				INSPECTOR 3:	
						INSPECTOR 4:	
** When calculated interval exceeds the frequency, a justification comment per BIRM is required.				** When calculated interval exceeds the frequency, a justification comment per BIRM is required.			
FRACTURE CRITICAL INSPECTION COMMENTS				INDEPTH INSPECTION COMMENTS			
SPECIAL INSPECTION INFORMATION				***UNDERWATER INSPECTION INFORMATION***			
DATE: 07/23/2020		RESPONSIBILITY: DISTRICT		CATEGORY: CHANNEL CROSS SEC		DATE: 01/11/2024	
FREQUENCY: 72		CALCULATED INTERVAL**: 72		NBI: NO		RESPONSIBILITY: DISTRICT	
TEAM LEADER:		INSPECTOR 3:		METHOD: WT TAPE		CATEGORY: SHALLOW-WADE	
INSPECTOR 2: ED HESS		INSPECTOR 4:				NBI: NO	
** When calculated interval exceeds the frequency, a justification comment per BIRM is required.				** When calculated interval exceeds the frequency, a justification comment per BIRM is required.			
SPECIAL INSPECTION COMMENTS				UNDERWATER INSPECTION COMMENTS			
OTHER SPECIAL INSPECTIONS				OTHER UNDERWATER INSPECTIONS			
<u>DATE</u>	<u>FREQUENCY</u>	<u>CATEGORY</u>	<u>NBI</u>	<u>CALCULATED INTERVAL</u>	<u>RESPONSIBILITY</u>	<u>METHOD</u>	<u>DATE</u>
							<u>FREQUENCY</u>
							<u>CATEGORY</u>
							<u>NBI</u>
							<u>CALCULATED INTERVAL</u>
							<u>RESPONSIBILITY</u>
							<u>METHOD</u>
Design_No = S0889							
Page 1							
This report contains information that is protected from disclosure by federal law, 23 USC Section 409 and the Missouri Open Records Law (Sunshine Act), Section 610.021 RSMo. Please review MoDOT's policy and procedure manual on the Sunshine Act before releasing any of the information contained herein.							


		Missouri Department of Transportation		December 09, 2024	
		State Bridge Inspection Report		7:13:20AM	
COUNTY: RIPLEY		DISTRICT: SE		CLASS: STATBR	
		FED-ID: 8892		BRIDGE: S0889	
STRUCTURE POSTING					
APPROVED CATEGORY: S-16 TRKS OVR 16 TNS 15MPH ON BR EXCPT SNGL UNIT TRKS WT LIMIT 22 TNS&ALL OTHR TRKS WT LIMIT 39 TNS. Ton 1: 16 Ton 2: 22 Ton 3: 39 COMMENTS:					
FIELD CATEGORY: S-16 TRKS OVR 16 TNS 15MPH ON BR EXCPT SNGL UNIT TRKS WT LIMIT 22 TNS&ALL OTHR TRKS Ton 1: 16 Ton 2: 22 Ton 3: 39 PROBLEM: PROBLEM DIRECTION: COMMENTS:					
GENERAL COMMENTS/MAJOR RATED ITEMS					
GENERAL COMMENTS: (BOWDEJ1, 08/28/2008)--(30'-43'-43'-30') SMP WF GDR SPANS					
[ITEM 58] DECK: 4-POOR CONDITION COMMENTS: (DENNIB1, 01/14/2020)--EXPOSED REBAR RATING : 01/31/2022					
[ITEM 59] SUPER: 5-FAIR CONDITION COMMENTS: (SHRUBM1, 03/05/2012)--TOP FLANGE RUSTING RATING : 05/18/2001					
[ITEM 60] SUB: 5-FAIR CONDITION COMMENTS: (DENNIB1, 01/14/2020)--SPALLS & SCALING RATING : 01/14/2020					
[ITEM 61] BANK/CHANNEL: 5-MAJOR DAMAGE COMMENTS: (DENNIB1, 01/14/2020)--EROSION ON BOTH SLOPES RATING : 01/14/2020					
[ITEM 113] SCOUR: 8-STABLE FOR CALCULATED COMMENTS: RATING : 05/18/2001 EVALUATION TYPE :					
[ITEM 71] WATERWAY ADEQUACY: SIGNIFICANT DELAY APPRCH COMMENTS: RATING : 05/18/2001					
[ITEM 72] APPRRDWY ALIGNMENT: 6-SATISFACTORY COMMENTS: RATING : 05/18/2001					
RAILING AND APPROACH PAVEMENT COMPONENTS AND RATINGS					
[ITEM 36A] BRIDGE RAILING RATING: MEETS CURRENT STANDARDS-1 RATING : 01/22/2018 COMMENTS:					
<u>MATERIAL</u> GALVANIZED STEEL		<u>CONSTRUCTION</u> THRIE BEAM		<u>DIRECTION</u> BOTH	
				<u>COMMENTS</u>	
[ITEM 36B] TRANSITION RAILING RATING: MEETS CURRENT STANDARDS-1 RATING : 01/22/2018 COMMENTS:					
<u>MATERIAL</u> GALVANIZED STEEL		<u>CONSTRUCTION</u> THRIE BEAM TO W-BEAM		<u>DIRECTION</u> ALL	
				<u>COMMENTS</u>	
[ITEM 36C] APPROACH RAILING RATING: MEETS CURRENT STANDARDS-1 RATING : 01/22/2018 COMMENTS:					
<u>MATERIAL</u> GALVANIZED STEEL		<u>CONSTRUCTION</u> W-BEAM		<u>DIRECTION</u> ALL	
				<u>COMMENTS</u>	
[ITEM 36D] RAIL END TREATMENT RATING: MEETS CURRENT STANDARDS-1 RATING : 01/22/2018 COMMENTS:					
Design_No = S0889					
Page 2					
This report contains information that is protected from disclosure by federal law, 23 USC Section 409 and the Missouri Open Records Law (Sunshine Act), Section 610.021 RSMo. Please review MoDOT's policy and procedure manual on the Sunshine Act before releasing any of the information contained herein.					

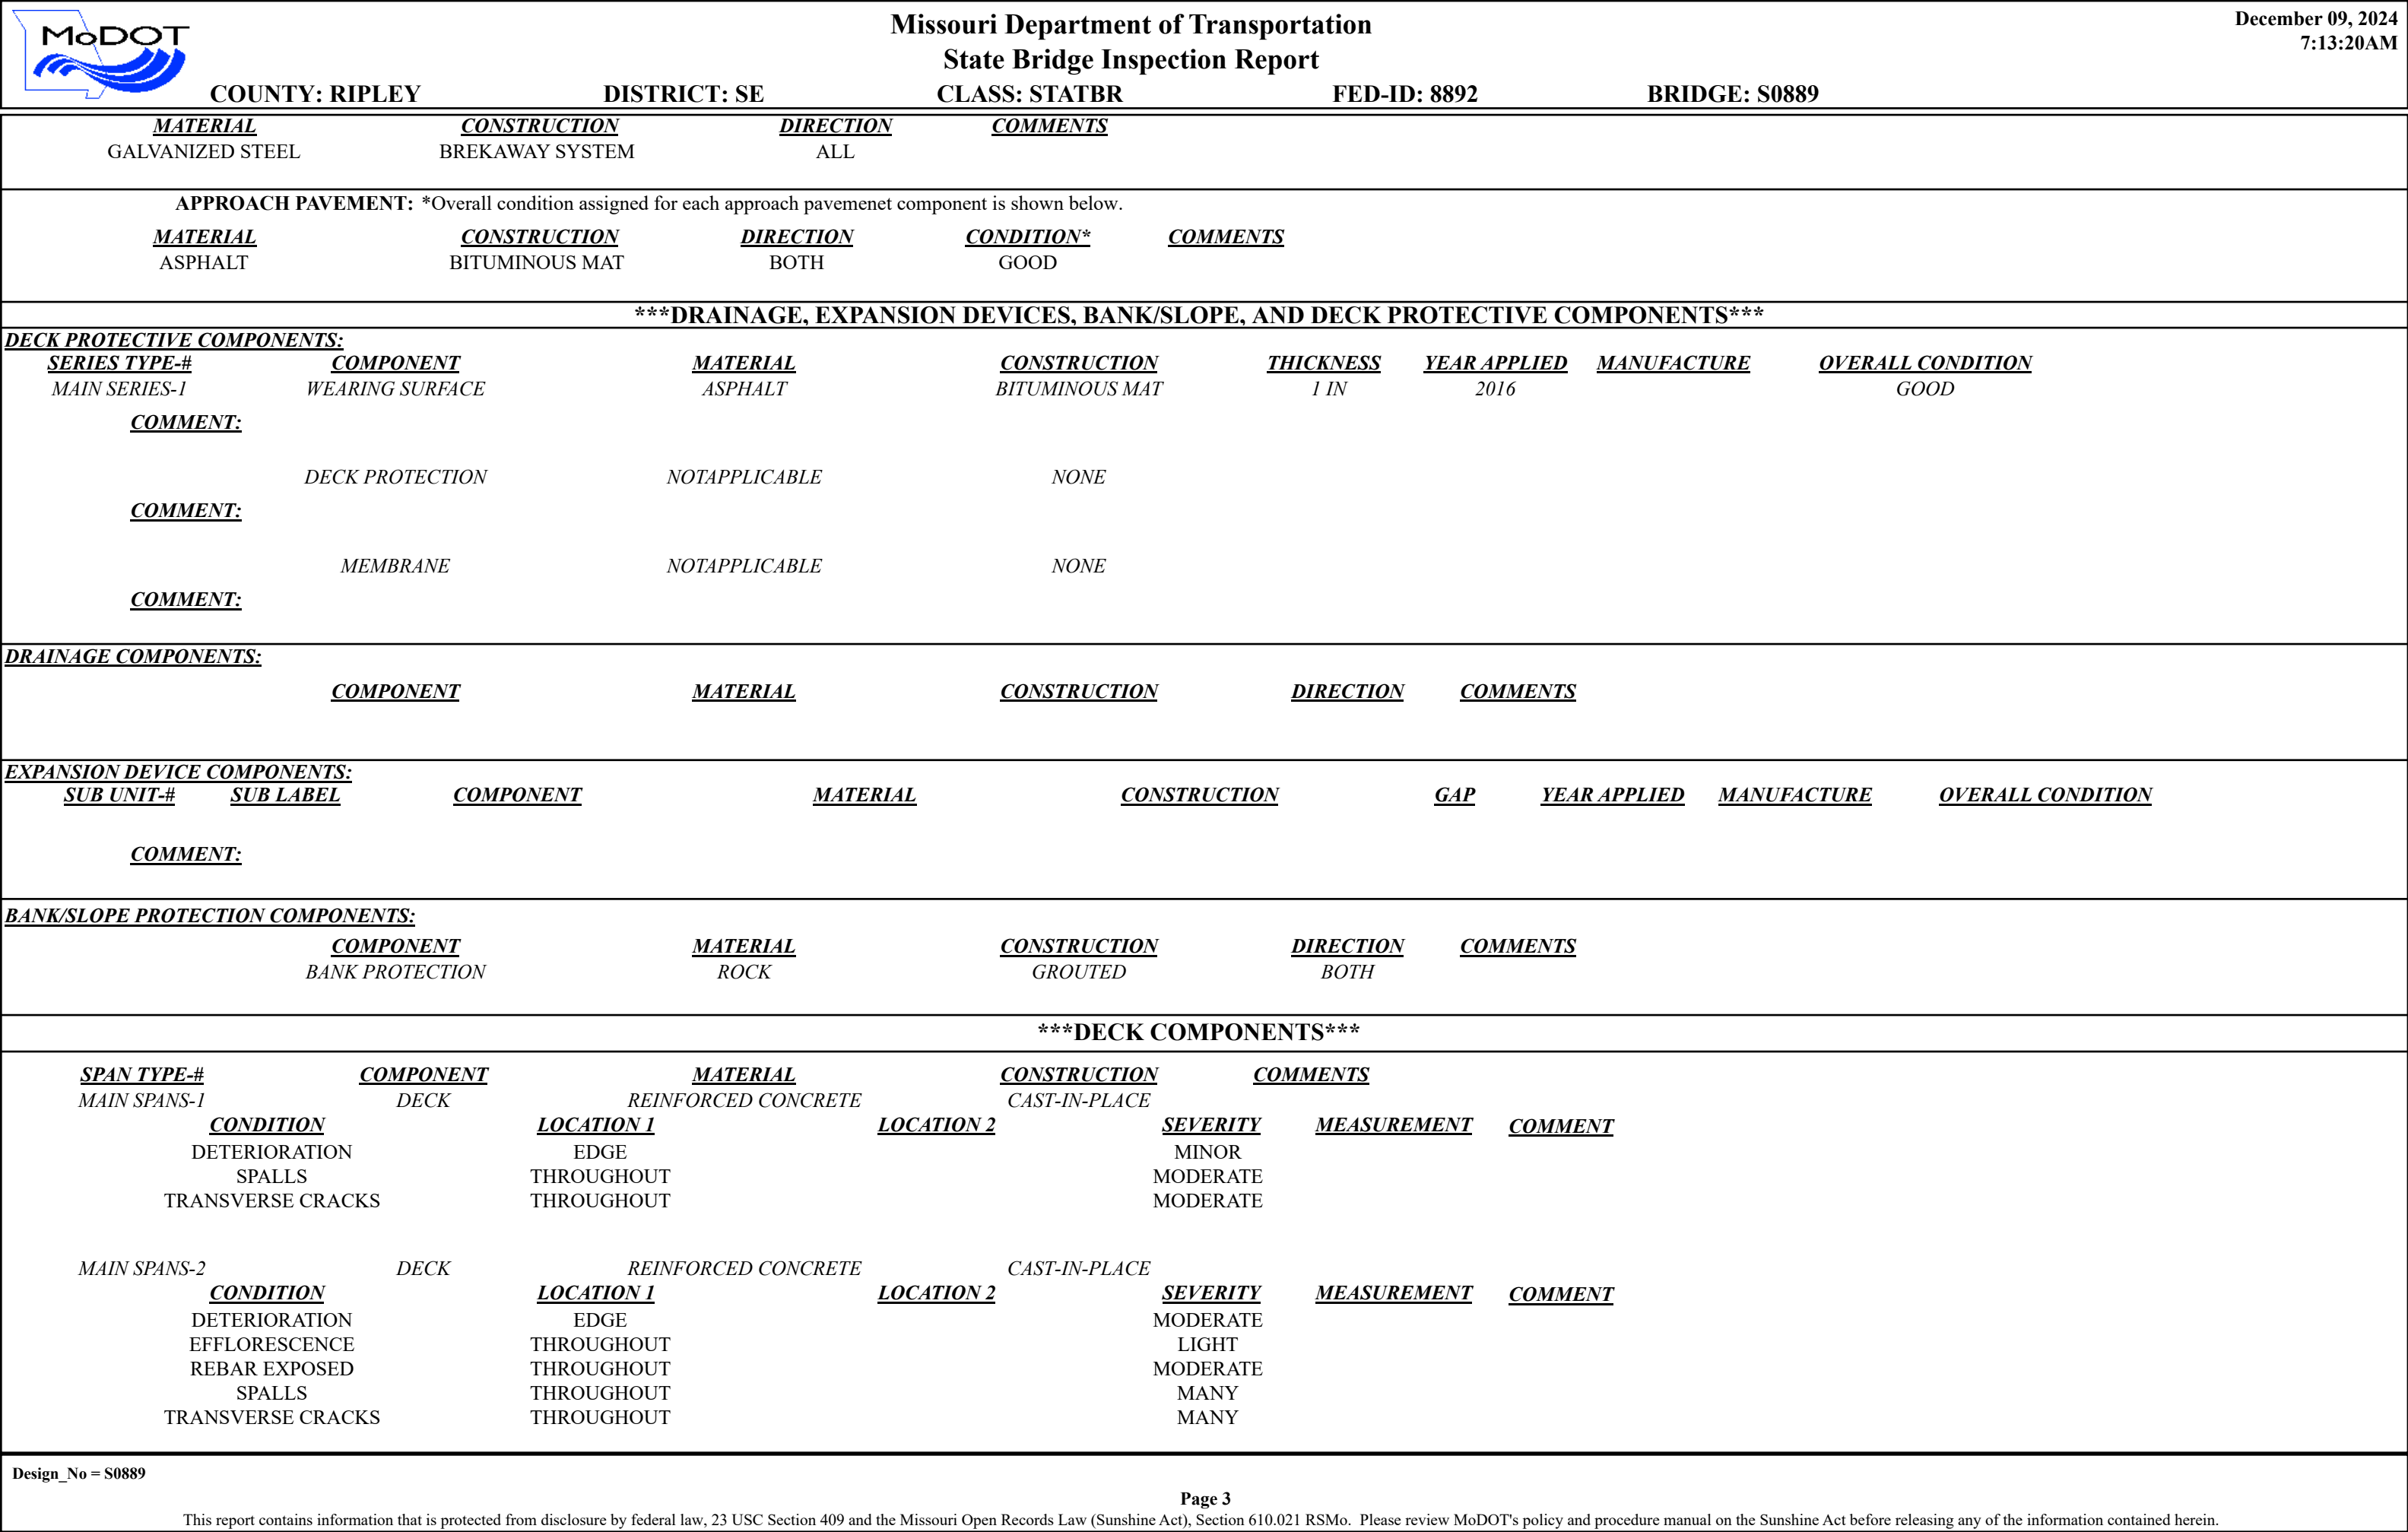

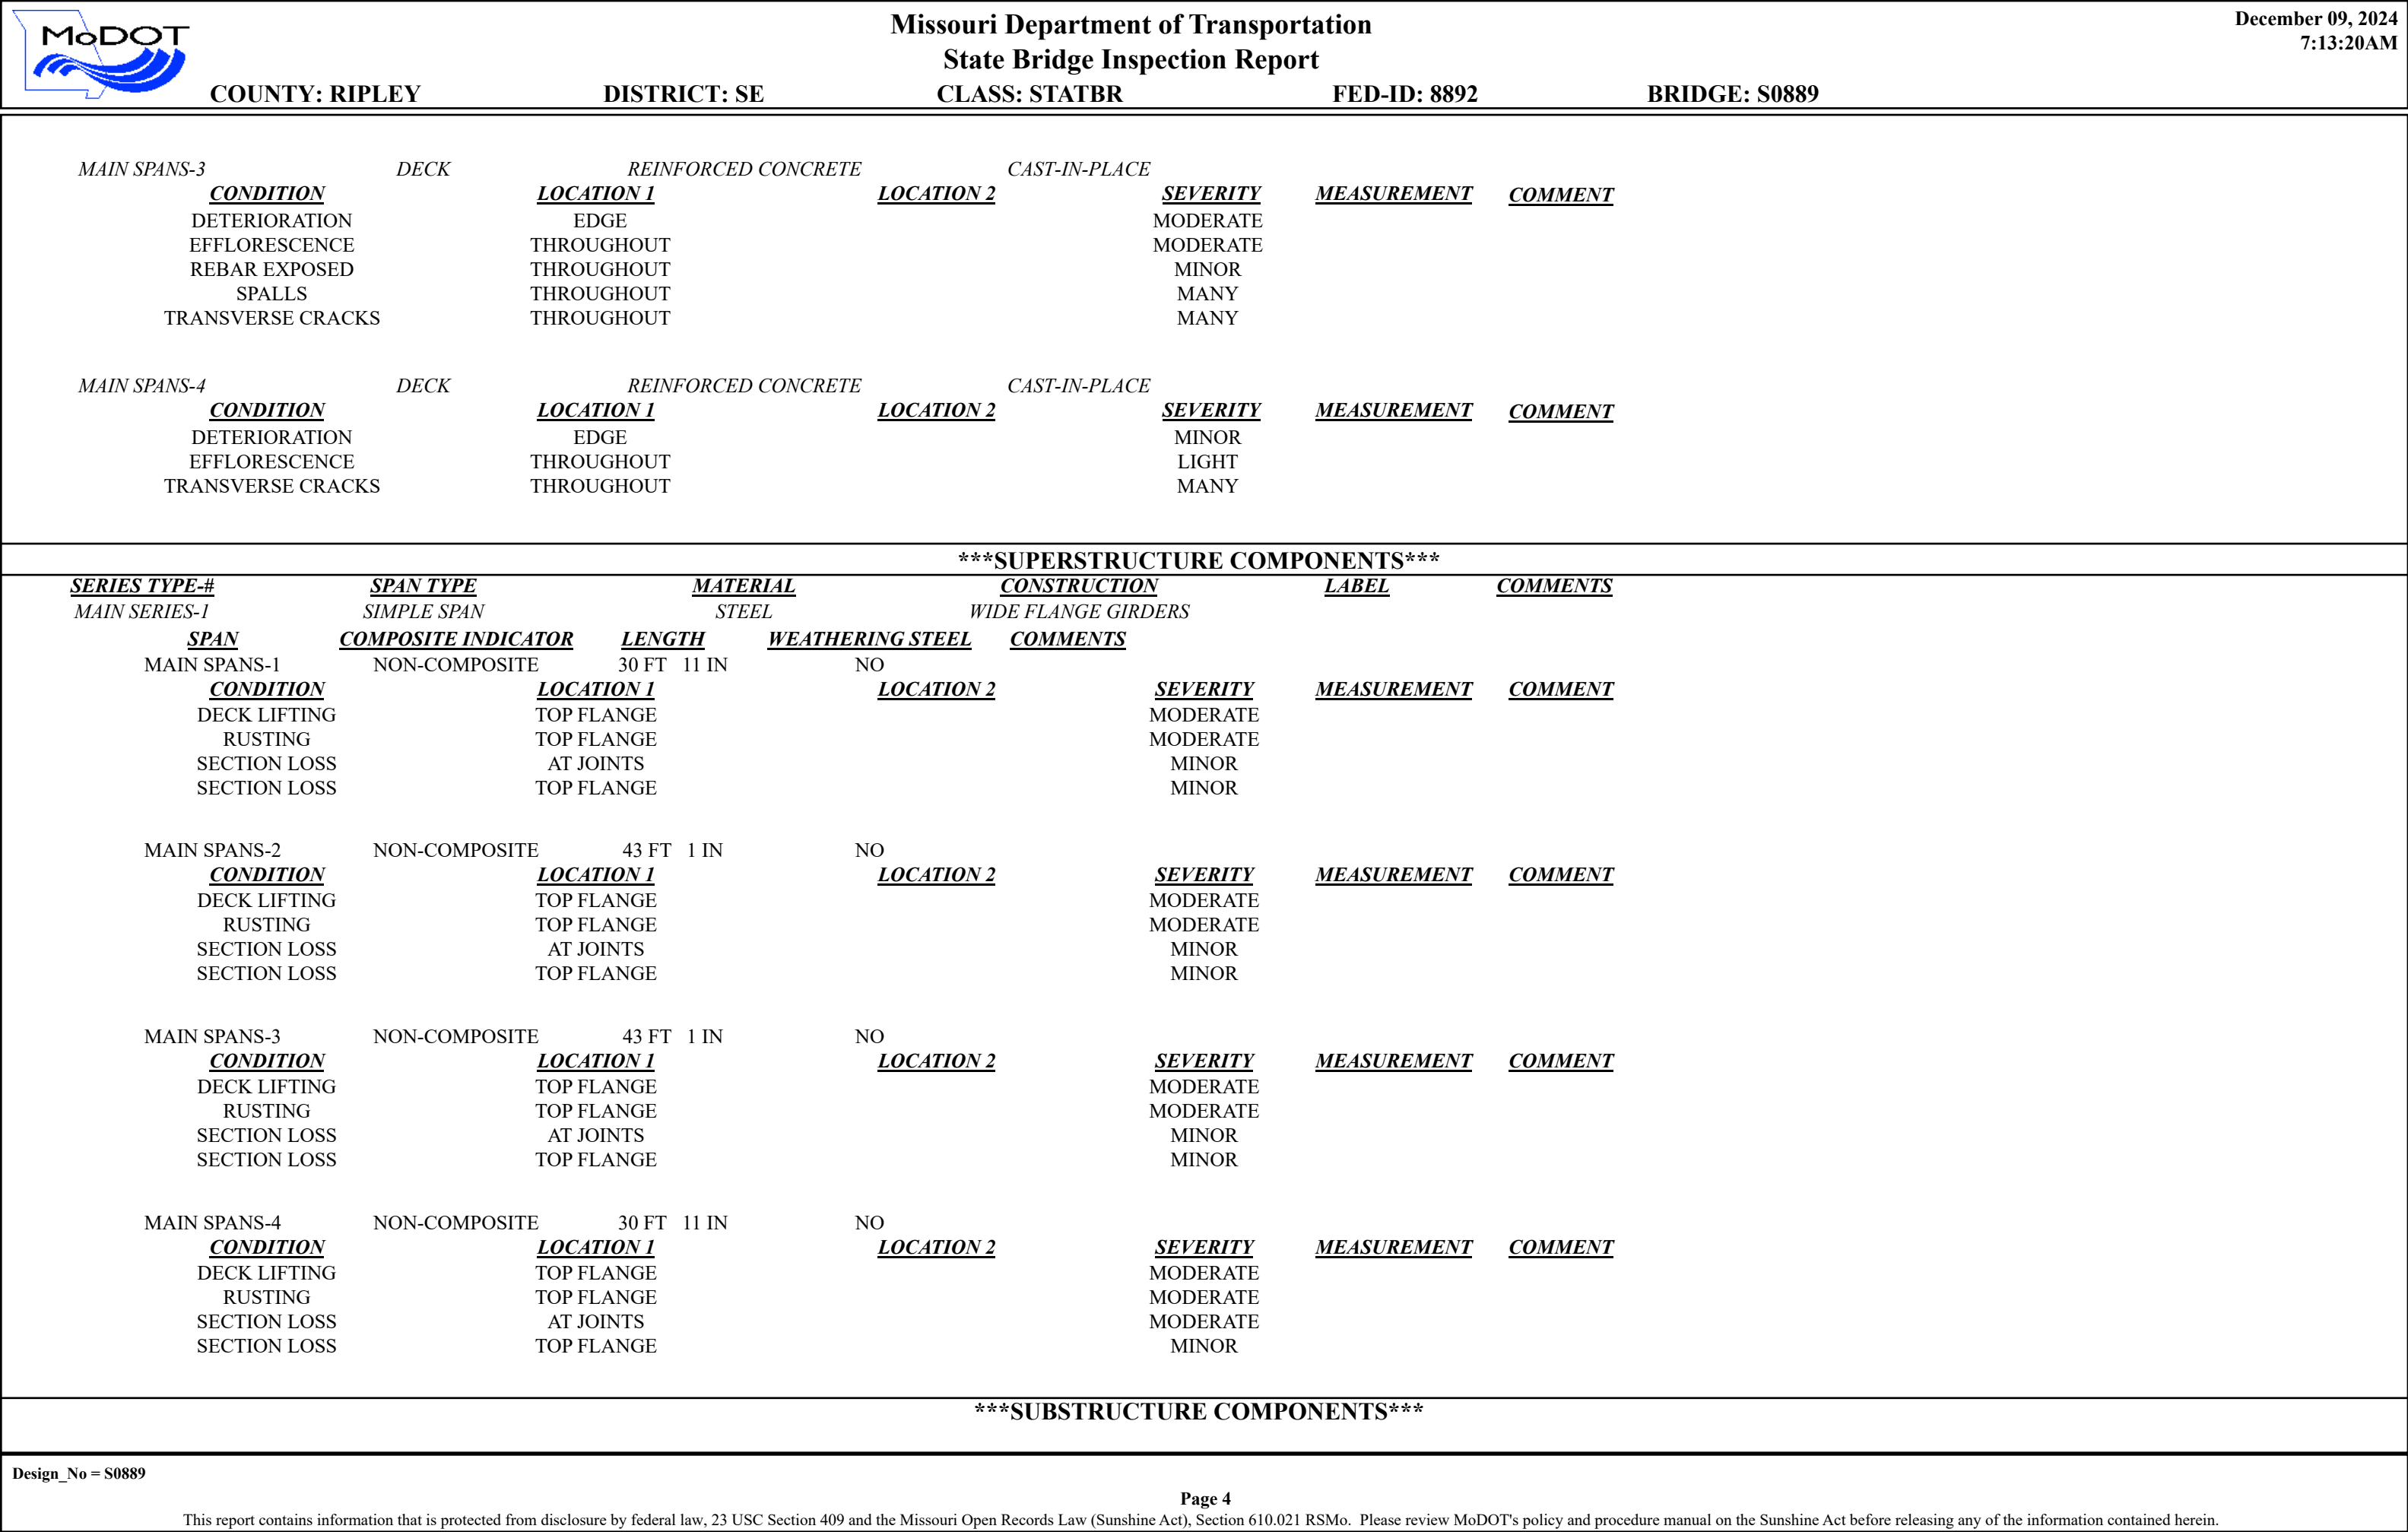


		<div>Missouri Department of Transportation</div> <div>State Bridge Inspection Report</div>					<div>December 09, 2024</div> <div>7:13:20AM</div>	
COUNTY: RIPLEY		DISTRICT: SE		CLASS: STATBR		FED-ID: 8892		BRIDGE: S0889
<u>SUBSTRUCTURE</u>	<u>SKEW</u>	<u>LENGTH</u>	<u>MATERIAL</u>	<u>CONSTRUCTION</u>	<u>LABEL</u>	<u>COMMENTS</u>		
ABUTMENT-1	LA-15 DEGREES	20 FT 2 IN	REINFORCED CONCRETE	NON-INTEGRAL		(STEGEC, 05/10/2005)--PROFILE GRADE ELEVATION = 321.0 (FLAT)		
	<u>CONDITION</u>		<u>LOCATION 1</u>	<u>LOCATION 2</u>		<u>SEVERITY</u>	<u>MEASUREMENT</u>	<u>COMMENT</u>
<u>ASSOCIATED COMPONENT</u>			<u>MATERIAL</u>	<u>CONSTRUCTION</u>				
BEAM CAP			REINFORCED CONCRETE	CAST-IN-PLACE				
	<u>CONDITION</u>		<u>LOCATION 1</u>	<u>LOCATION 2</u>		<u>SEVERITY</u>	<u>MEASUREMENT</u>	<u>COMMENT</u>
COLUMN			REINFORCED CONCRETE	CAST-IN-PLACE				
	<u>CONDITION</u>		<u>LOCATION 1</u>	<u>LOCATION 2</u>		<u>SEVERITY</u>	<u>MEASUREMENT</u>	<u>COMMENT</u>
FOOTING			REINFORCED CONCRETE	SPREAD				
	<u>CONDITION</u>		<u>LOCATION 1</u>	<u>LOCATION 2</u>		<u>SEVERITY</u>	<u>MEASUREMENT</u>	<u>COMMENT</u>
STRAIGHT WINGS			REINFORCED CONCRETE	CAST-IN-PLACE				
	<u>CONDITION</u>		<u>LOCATION 1</u>	<u>LOCATION 2</u>		<u>SEVERITY</u>	<u>MEASUREMENT</u>	<u>COMMENT</u>
BACKWALL			REINFORCED CONCRETE	CAST-IN-PLACE				
	<u>CONDITION</u>		<u>LOCATION 1</u>	<u>LOCATION 2</u>		<u>SEVERITY</u>	<u>MEASUREMENT</u>	<u>COMMENT</u>
EXPANSION BEARING			STEEL	SLIDING FLAT PLATE				
	<u>CONDITION</u>		<u>LOCATION 1</u>	<u>LOCATION 2</u>		<u>SEVERITY</u>	<u>MEASUREMENT</u>	<u>COMMENT</u>
	RUSTING		THROUGHOUT			MINOR		
BENT-2	LA-15 DEGREES	21 FT 6 IN	REINFORCED CONCRETE	MULTIPLE COLUMN		(STEGEC, 05/10/2005)--PROFILE GRADE ELEVATION = 321.0 (FLAT)		
	<u>CONDITION</u>		<u>LOCATION 1</u>	<u>LOCATION 2</u>		<u>SEVERITY</u>	<u>MEASUREMENT</u>	<u>COMMENT</u>
<u>ASSOCIATED COMPONENT</u>			<u>MATERIAL</u>	<u>CONSTRUCTION</u>				
BEAM CAP			REINFORCED CONCRETE	CAST-IN-PLACE				
	<u>CONDITION</u>		<u>LOCATION 1</u>	<u>LOCATION 2</u>		<u>SEVERITY</u>	<u>MEASUREMENT</u>	<u>COMMENT</u>
	DELAMINATION		RANDOM			MODERATE		
	REBAR EXPOSED		THROUGHOUT			MODERATE		
COLUMN			REINFORCED CONCRETE	CAST-IN-PLACE				
	<u>CONDITION</u>		<u>LOCATION 1</u>	<u>LOCATION 2</u>		<u>SEVERITY</u>	<u>MEASUREMENT</u>	<u>COMMENT</u>
	SCALING		WATERLINE			MODERATE		
FOOTING			REINFORCED CONCRETE	SPREAD				
	<u>CONDITION</u>		<u>LOCATION 1</u>	<u>LOCATION 2</u>		<u>SEVERITY</u>	<u>MEASUREMENT</u>	<u>COMMENT</u>
EXPANSION BEARING			STEEL	SLIDING FLAT PLATE				
	<u>CONDITION</u>		<u>LOCATION 1</u>	<u>LOCATION 2</u>		<u>SEVERITY</u>	<u>MEASUREMENT</u>	<u>COMMENT</u>
	RUSTING		THROUGHOUT			LIGHT		
BENT-3	LA-15 DEGREES	21 FT 6 IN	REINFORCED CONCRETE	MULTIPLE COLUMN		(STEGEC, 05/10/2005)--PROFILE GRADE ELEVATION = 321.0 (FLAT)		
	<u>CONDITION</u>		<u>LOCATION 1</u>	<u>LOCATION 2</u>		<u>SEVERITY</u>	<u>MEASUREMENT</u>	<u>COMMENT</u>
<u>ASSOCIATED COMPONENT</u>			<u>MATERIAL</u>	<u>CONSTRUCTION</u>				
BEAM CAP			REINFORCED CONCRETE	CAST-IN-PLACE				
	<u>CONDITION</u>		<u>LOCATION 1</u>	<u>LOCATION 2</u>		<u>SEVERITY</u>	<u>MEASUREMENT</u>	<u>COMMENT</u>
COLUMN			REINFORCED CONCRETE	CAST-IN-PLACE				
	<u>CONDITION</u>		<u>LOCATION 1</u>	<u>LOCATION 2</u>		<u>SEVERITY</u>	<u>MEASUREMENT</u>	<u>COMMENT</u>
	SCALING		WATERLINE			MODERATE		
FOOTING			REINFORCED CONCRETE	SPREAD				
	<u>CONDITION</u>		<u>LOCATION 1</u>	<u>LOCATION 2</u>		<u>SEVERITY</u>	<u>MEASUREMENT</u>	<u>COMMENT</u>
EXPANSION BEARING			STEEL	SLIDING FLAT PLATE				
	<u>CONDITION</u>		<u>LOCATION 1</u>	<u>LOCATION 2</u>		<u>SEVERITY</u>	<u>MEASUREMENT</u>	<u>COMMENT</u>
	RUSTING		THROUGHOUT			LIGHT		
BENT-4	LA-15 DEGREES	21 FT 6 IN	REINFORCED CONCRETE	MULTIPLE COLUMN		(STEGEC, 05/10/2005)--PROFILE GRADE ELEVATION = 321.0 (FLAT)		
	<u>CONDITION</u>		<u>LOCATION 1</u>	<u>LOCATION 2</u>		<u>SEVERITY</u>	<u>MEASUREMENT</u>	<u>COMMENT</u>
<u>ASSOCIATED COMPONENT</u>			<u>MATERIAL</u>	<u>CONSTRUCTION</u>				

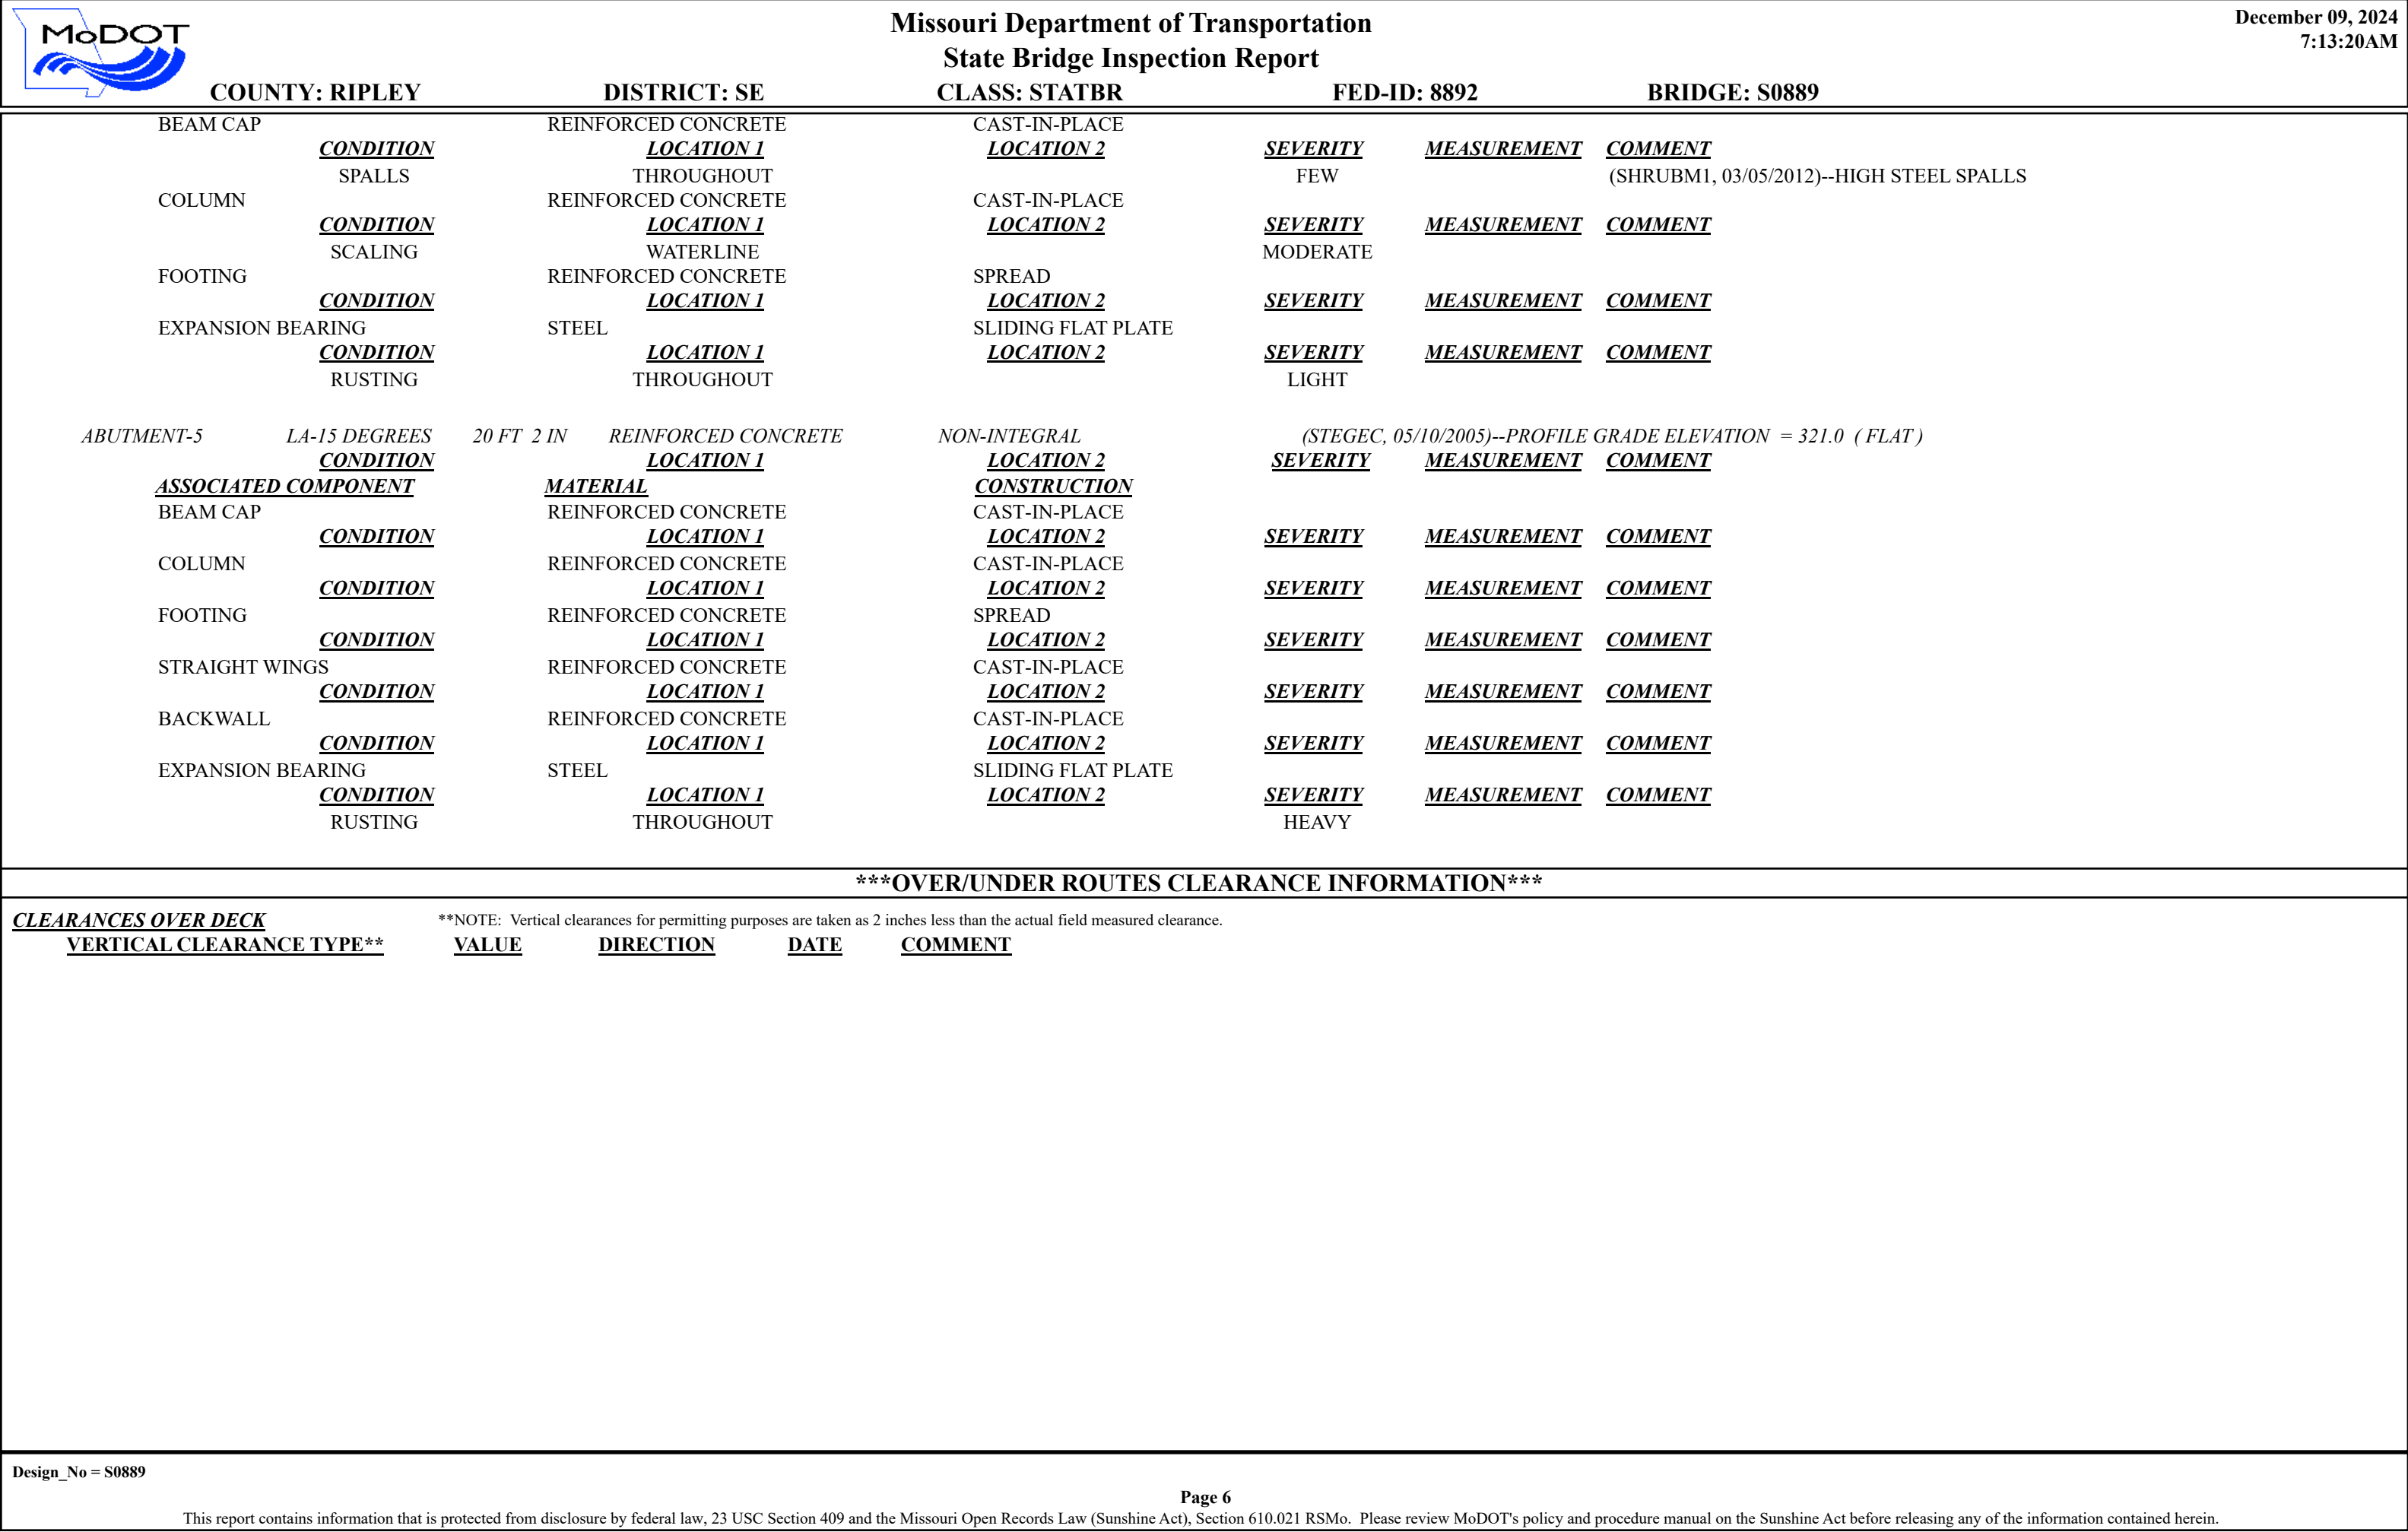

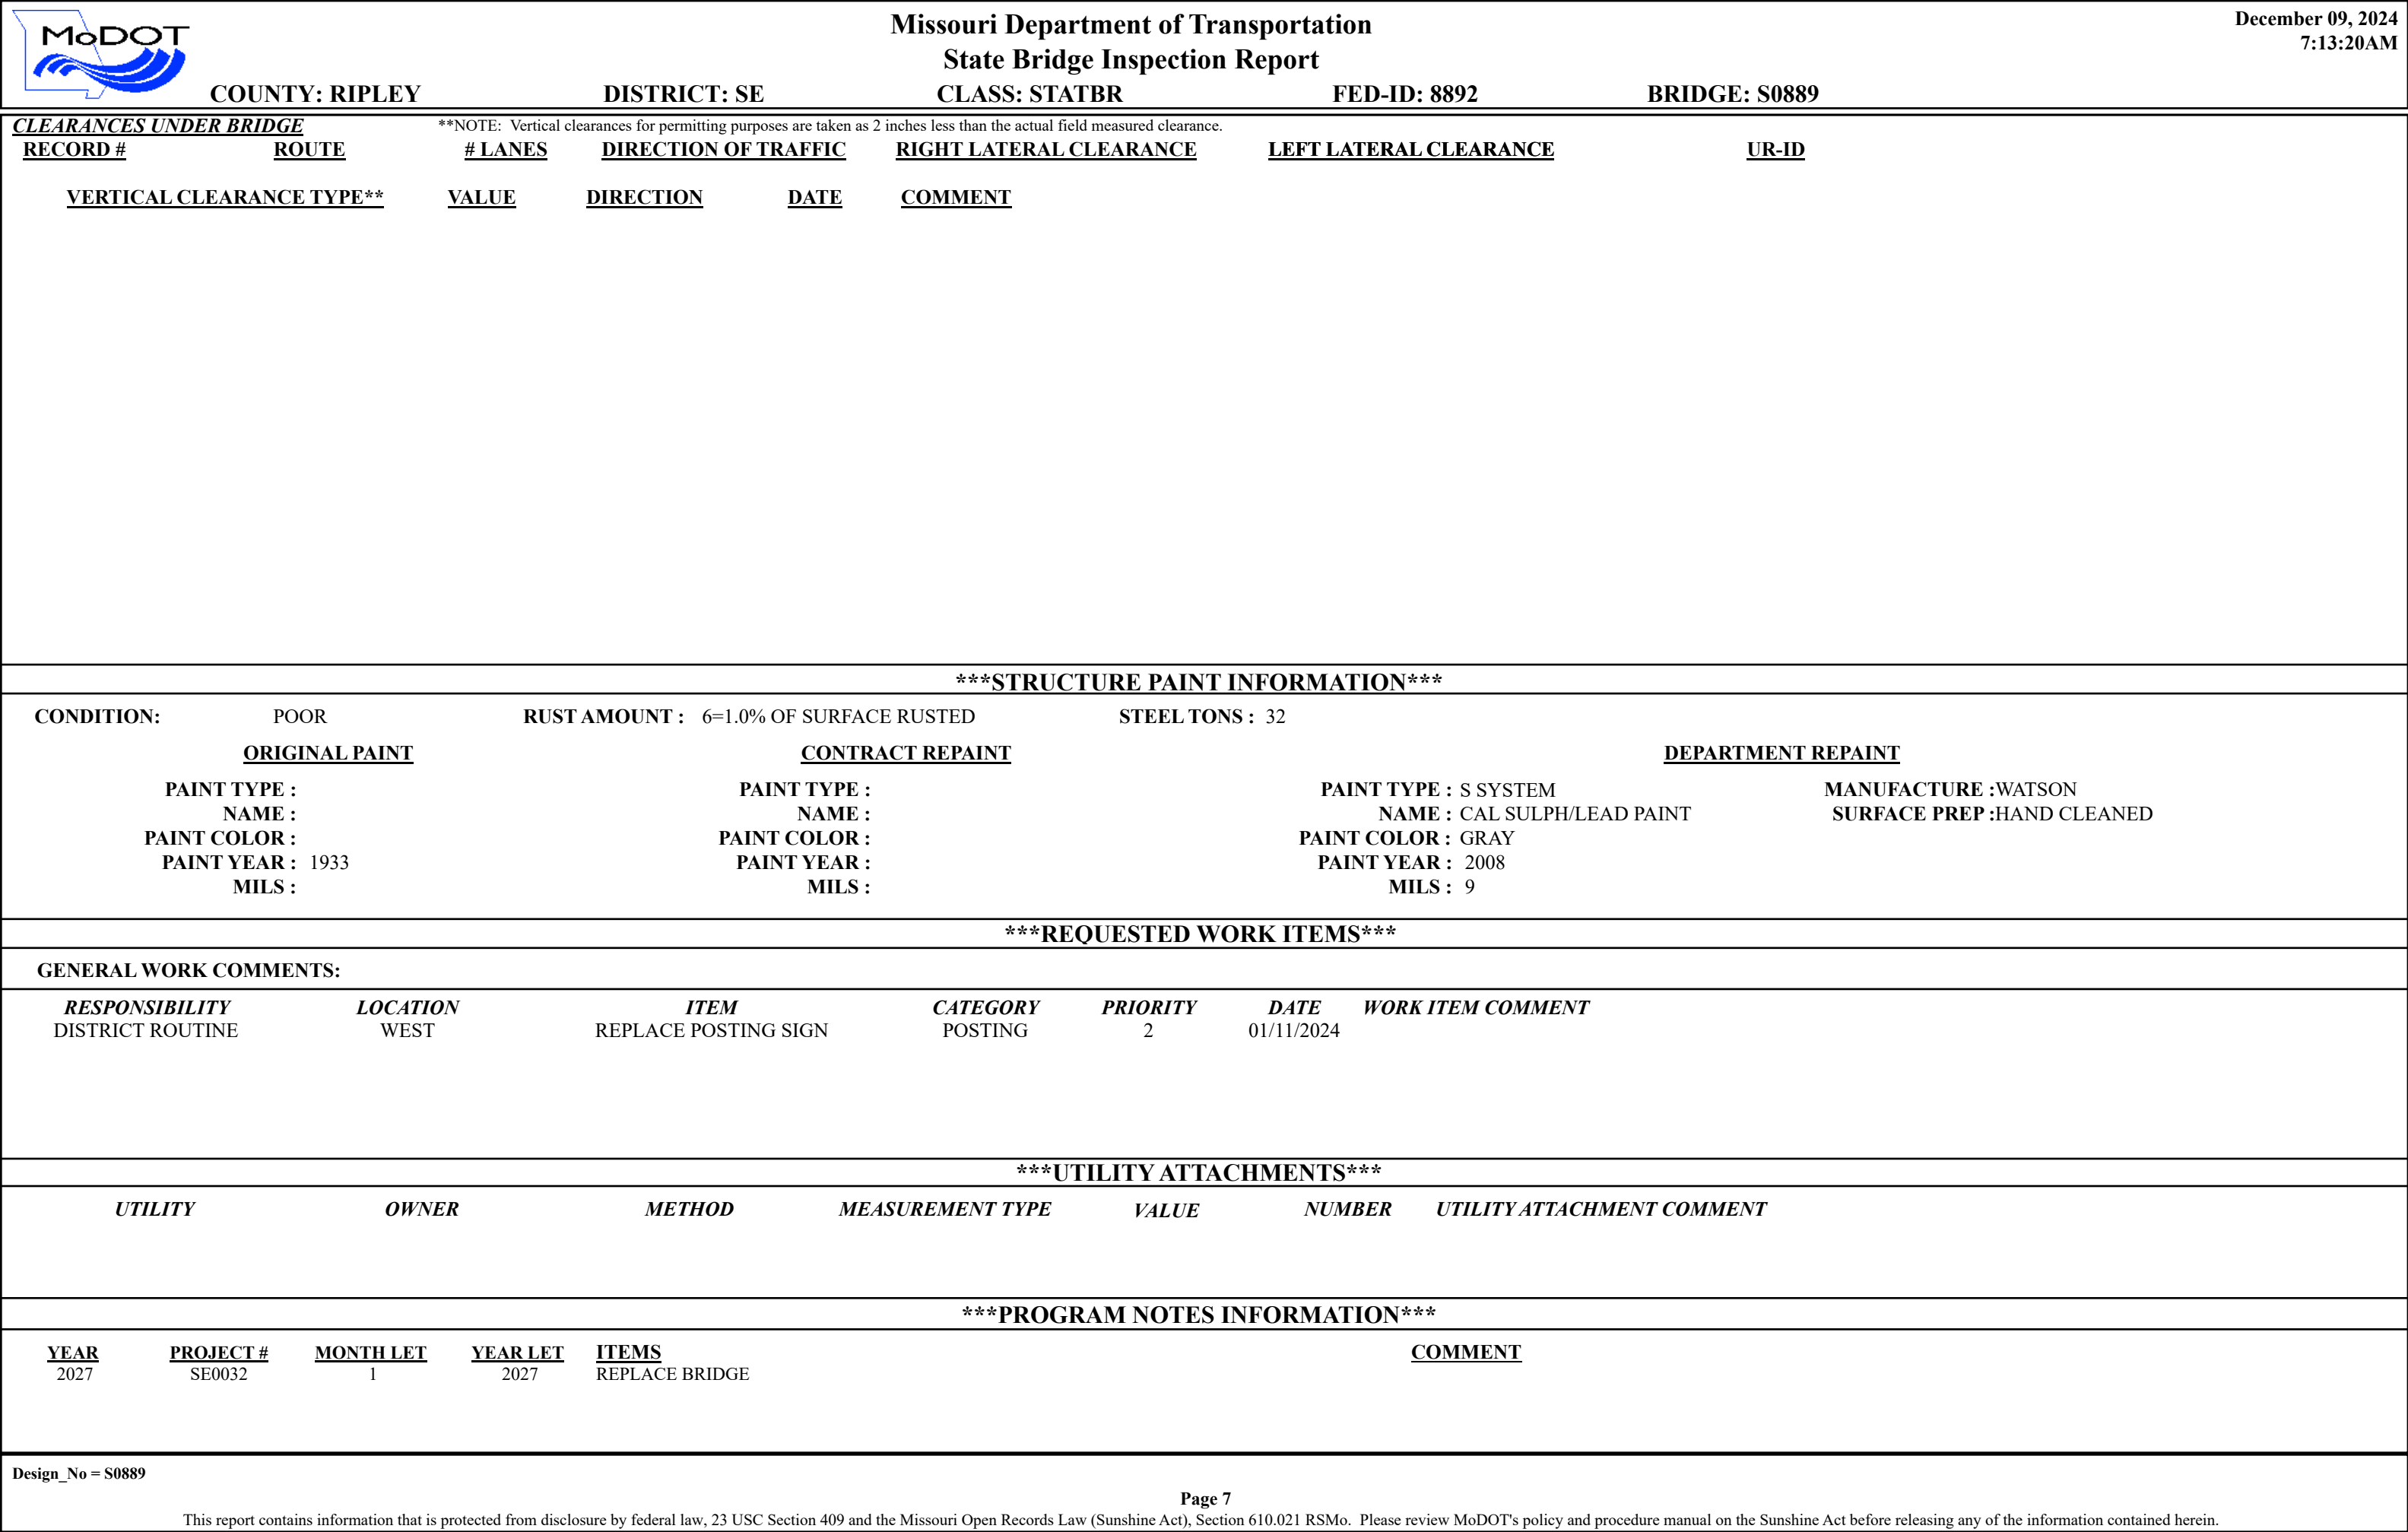


			Missouri Department of Transportation		December 09, 2024	
			State Bridge Inspection Report		7:13:20AM	
COUNTY: RIPLEY			DISTRICT: SE		CLASS: STATBR	
			FED-ID: 8892		BRIDGE: S0889	
COMPUTER GENERATED RATINGS AND DEFICIENCY ITEMS					***ADVANCED SIGN INFORMATION***	
NOTE: The items listed in this section are updated whenever computer edits are ran on a structure after the inspection updates have been entered in to TMS.					SIGN #	
					SIGN TYPE	
					PROBLEM	
					PROBLEM DIRECTION	
<u>Rated Item</u>						
<u>Rating</u>						
<u>Rating Date</u>						
[Item 67] Structure Evaluation Rating: 4-MEETS MINIMUM TOLERABLE 1/20/2017						
[Item 68] Deck Geometry Rating: 2-BASICALLY INTOLRBLE REQ 5/18/2001						
[Item 69] Underclearance: N-NOT APPLICABLE 5/18/2001						
Sufficiency Rating: 28.2% 3/6/2024						
Deficiency: STRUCTURAL 1/31/2022						
Funding Eligibility: ----						
Estimated New Structure Length: ----						
Estimated Structure Cost: ----						
Estimated Total Project Cost: ----						
Year of Cost Estimate: ----						
NOTE: The above structure length and cost estimates are computer generated using algorithms in the TMS system. These algorithms are generalized to use NBI items to come up with a new structure length and width to calculate a new area which is taken times a representative cost per square foot. The actual structure size and cost may vary significantly from these numbers once site specific engineering is done.						
					OUTFALL INSPECTION INFORMATION	
					# OUTFALLS:	
					INSPECTOR:	
					STATUS:	
					DATE:	
					NOTES:	

MISSOURI STATE HIGHWAY DEPARTMENT


Note: Outlets in curbs to be centered between rail posts.

FED. ROAD DIST. NO.	STATE	FED. AID PROJ. NO.	FISCAL YEAR	SHEET NO.	TOTAL SHEETS
5	MO.	400A(5B)	1933	10	10

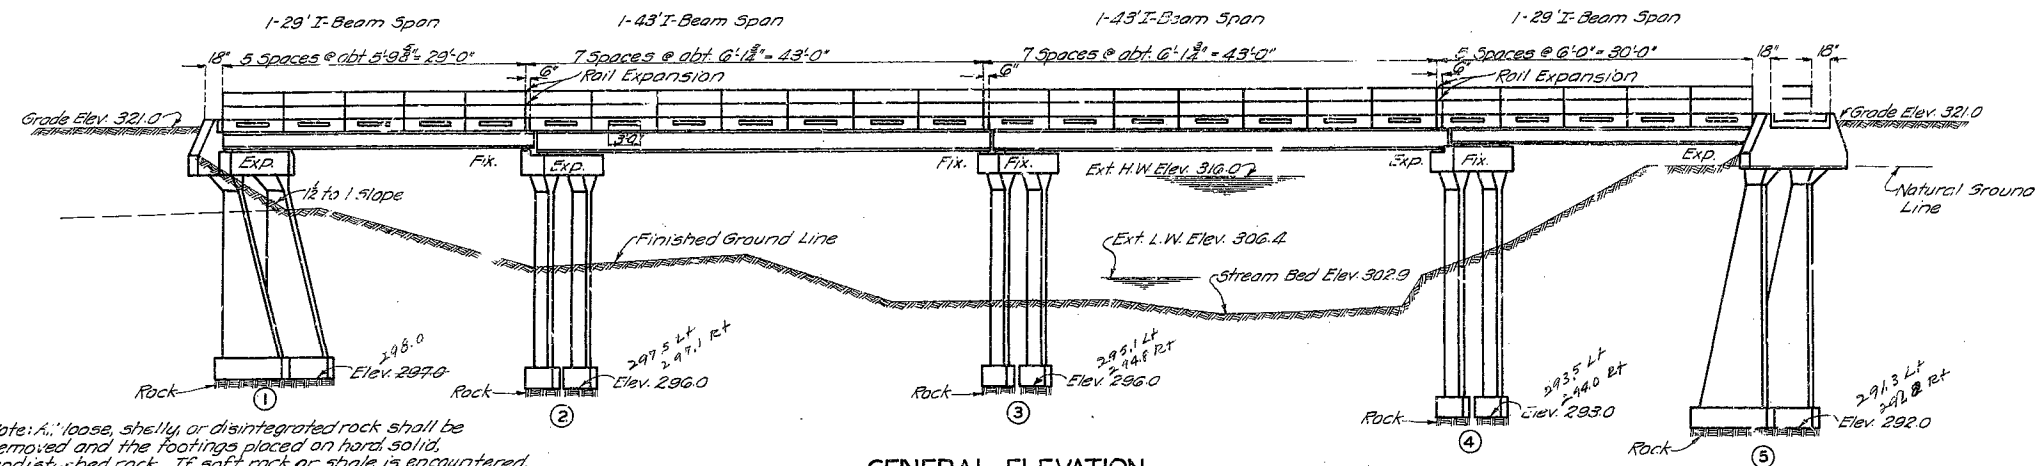

Note: A loose, shelly, or disintegrated rock shall be removed and the footings placed on hard, solid, undisturbed rock. If soft rock or shale is encountered, the footings shall be carried at least 18" into the same.

GENERAL ELEVATION

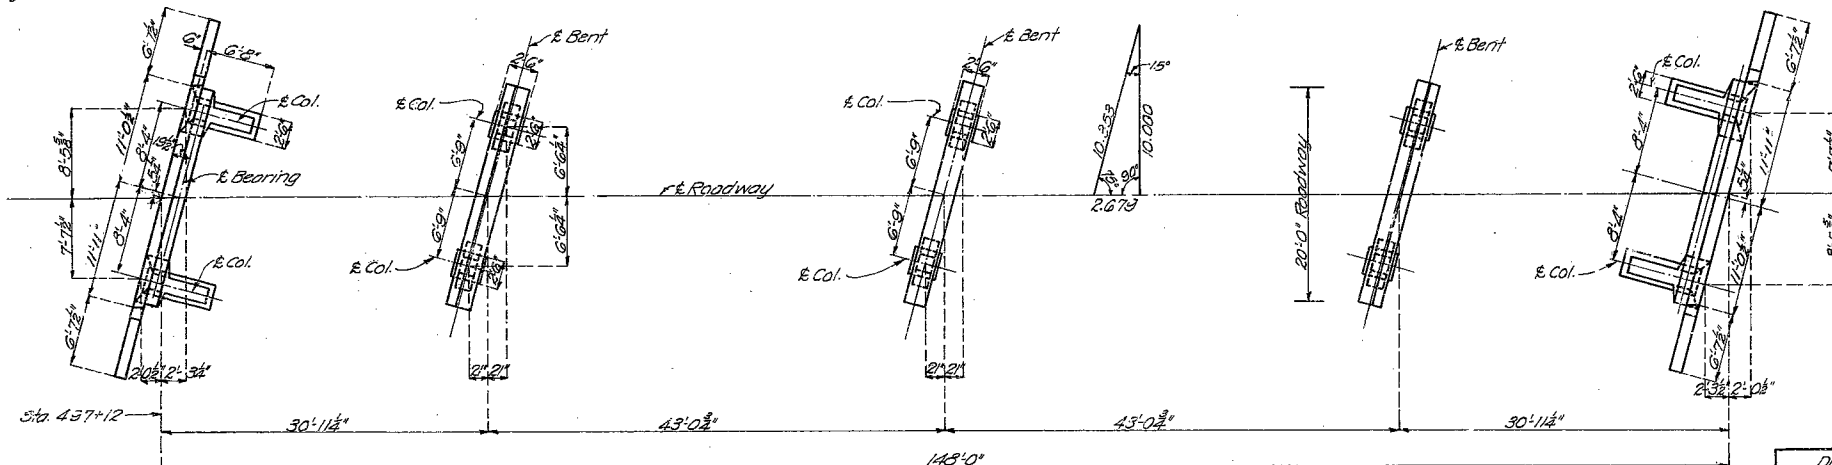

PLAN


REVISIONS REQUIRED

SEE SHEET NO. 5 OF 5 FOR THE FOLLOWING ITEMS:

- (1) Type of Handrail.
- (2) Width of Curb.
- (3) Type of Diaphragm.

Note: Details on any other sheet conflicting with those shown on Sheet No. 5 are VOID.

Note: This drawing is not to scale. Follow dimensions.

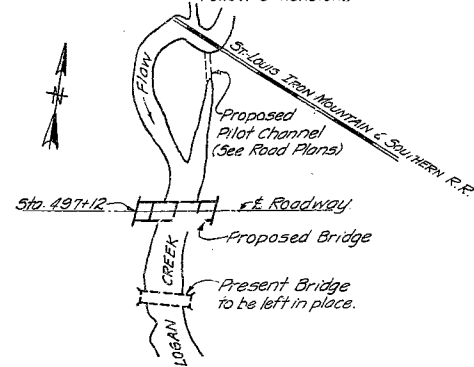

LOCATION SKETCH

Drawn Jan. 1931 By R.J.G.
Traced Jan. 1931 By R.J.G.
Checked Feb. 1931 By J.H.M.
Assembled April 1933 By H.C.M.-G.W.
Checked April 1933 By P.H.S.

BILL OF REINFORCING STEEL (SUBSTR)


No.	Size	Length	Mark	Location
20	3/8"	5'-9"	D1	Footings
12	3/8"	7'-3"	F1	Haunch
12	3/8"	7'-3"	F2	Haunch
12	3/8"	7'-3"	H1	Wing
6	3/8"	21'-9"	H2	Beam
6	3/8"	21'-9"	H3	Beam
4	3/8"	20'-9"	H4	Beam
14	3/8"	22'-9"	H5	Beam
10	3/8"	6'-6"	V1	Wing
12	3/8"	8'-0"	V2	Haunch
18	3/8"	3'-6"	V3	Backwall
10	3/8"	19'-3"	V4	Col. Bt #1
10	3/8"	24'-3"	V5	Col. Bt #5
8	3/8"	11'-9"	T1	Wing
4	3/8"	21'-0"	T2	Backwall
42	3/8"	8'-6"	U1	Beam
24	3/8"	5'-9"	D1	Footings
36	3/8"	7'-3"	F1	Haunch
16	3/8"	21'-0"	F2	Col. Bt #2,3
8	3/8"	21'-0"	F3	Col. Bt #4
36	3/8"	22'-9"	G1	Beam
6	3/8"	20'-9"	G2	Beam
44	3/8"	8'-6"	U2	Beam Bt #1,2
24	3/8"	8'-0"	U3	Beam Bt #3
82	3/8"	6'-0"	P2	Columns

Note: Dimensions given are along E of bars and are for computed lengths.
Reinforcing bars 3/8" or over in diameter, which are bent to an angle greater than 90° shall be of structural grade.

BILL OF REINFORCING STEEL (SUPER)

No.	Size	Length	Mark	Location
16	3/8"	30'-9"	C1	Curb
202	3/8"	2'-0"	C2	"
32	3/8"	22'-9"	C3	"
552	3/8"	20'-9"	S1	Slab
52	3/8"	30'-9"	S2	"
88	3/8"	21'-9"	S3	"
16	3/8"	21'-3"	S4	"
104	3/8"	22'-6"	S5	"

11-S3 CUT 88 BARS

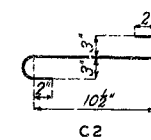

Note: Dimensions given are along center line of bars and are for computed lengths.

GENERAL NOTES:

Loading: One 10 Ton Truck, 80% of weight on rear axle, 30% impact, 14'-0" wheel base, 6'-0" gage, 10" tire.

Exposed edges to be beveled 3/8" where no other bevel is noted. Concrete in slab and curbs to be 1:2:3 1/2 mix, Class X. All other concrete to be 1:2:4 mix, Class B. Bridge excavation in accordance with Section I of Standard Specifications issued April 1, 1930, except that quantities paid for will be computed from Ext. L.W. Elev. 306.4 where existing ground line is below this elevation.

I-Beams with fastenings, spacers, handrail, handrail posts with fastenings will be paid for as structural steel. Cost of metallic edge moulding will be included in unit bid price for concrete. Rivets 3/8" holes 1/2", except in handrail where rivets shall be 3/8", holes 1/4". Field connections riveted except as noted.

Detail shop drawings shall be submitted to the State Highway Department in duplicate and shall be approved before steel is fabricated. Where rubber compound is specified on plans for use in partition and expansion joints, the pre-moulded joint shall be securely stitched to one face of concrete with copper wire. See Special Provisions in regard to permissible substitution of beams and basis of payment.

Paint: Shop, none; Field, contact surfaces of bolted field connections one coat of red lead and surfaces inaccessible after erection three coats of red lead. No other paint to be applied by contractor. All paint required will be furnished by the Missouri State Highway Department. See Special Provisions.

B.M. Elev. 313.31 Nail in roof 20" B. Oak 56' Lt. Sta. 497+25.

BRIDGE OVER LOGAN CREEK

STATE ROAD FROM DONIPHAN TO OXLY

ABOUT 0.5 MILE WEST OF OXLY

PROJECT NO. N.R.S. 400A (5B) STA. 497+12

RIPLEY COUNTY

SUBMITTED BY: *M.R. Lark* DATE: 5/4/33
APPROVED BY: *T.H. Carter* DATE: 5/4/33
BRIDGE ENGINEER
CHIEF ENGINEER

Sheet No. 10 of 5

S-889


DEAD LOAD DEFLECTION DIAGRAM

FINAL QUANT.	ITEM	SUPERSTR.	SUBSTR.	TOTAL
77.5	Excavation Class 1 Cu. Yds.		75	75
174.5	Excavation Class 2 Cu. Yds.		180	180
61.4	Concrete 1:2:4 mix, Class "B" Cu. Yds.		61.3	61.3
73.2	Concrete 1:2:3 1/2 mix, Class "X" Cu. Yds.	73.2		73.2
61400	Fabricated Structural Steel Lbs.	62900		62900
25520	Reinforcing Steel Lbs.	18400	7120	25520
4	Cl. Exc. below p.b. grade C.Y.			
34.6	Heating Concrete, Gr. A C.Y.			
6.7	" " " " Gr. B C.Y.			

Note: Bridge excavation above Elev. 307.0 will be paid for as Class 1 Bridge Excavation.
Bridge excavation below Elev. 307.0 will be paid for as Class 2 Bridge Excavation.

42

F.A.

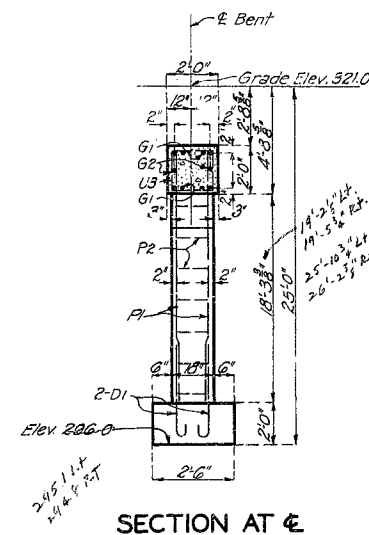

SECTION AT C

[illegible]

DETAILS OF BENT NO. 3


THE ROAD FROM DONIPHAN TO OXLEY
ABOUT 0.5 MILE WEST OF OXLEY
PROJECT NO. NRS400A(SB) STA. 497+12
RIPLEY COUNTY




Drawn Sept. 1930 by I.B.
Traced Sept. 1930 by G.W. & R.J.G.
Assembled April 1933 by H.C.M. - G.W.
Checked April 1933 by P.H.S.

MISSOURI STATE HIGHWAY DEPARTMENT


FED. ROAD DIST. NO.	STATE	FED. AID PROJ. NO.	FISCAL Y. 19	SHEET NO.	TOTAL SHEETS
5	MO.	NRS 400A (SB)	19		

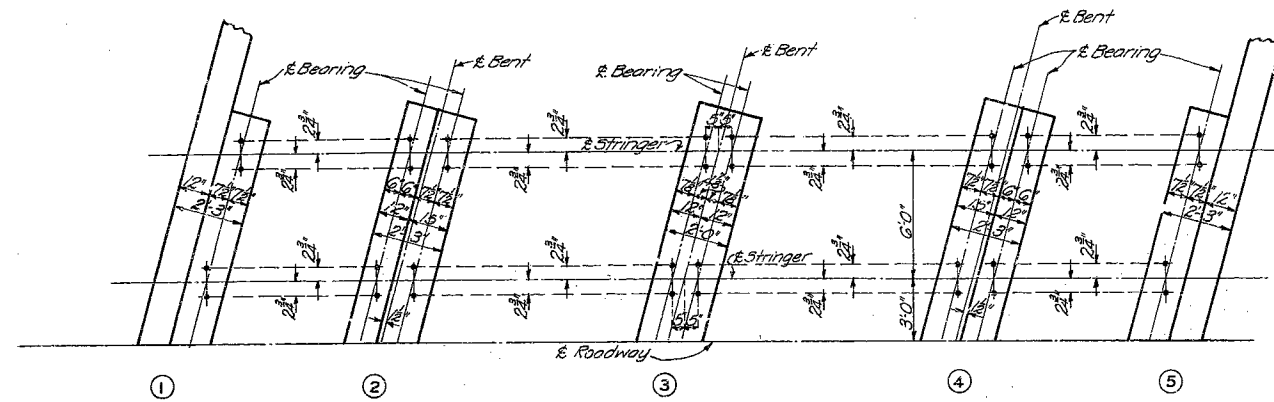

HALF ANCHOR BOLT PLAN

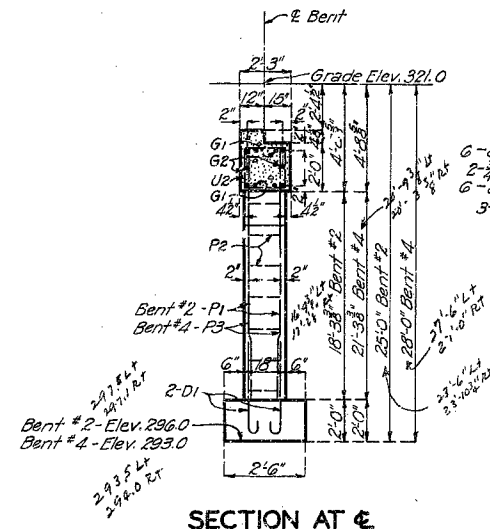


SECTION AT E

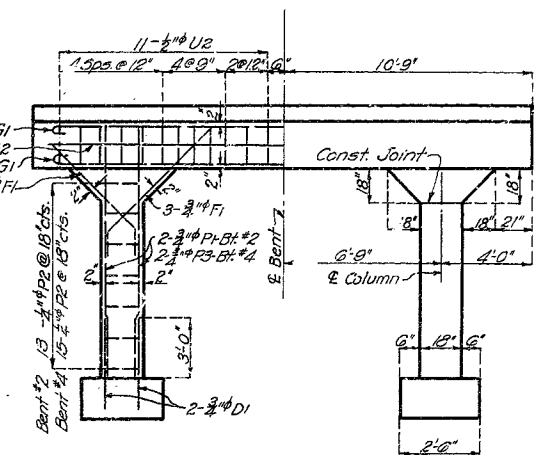

ELEVATION

Note: This drawing is not to scale. Follow dimensions.

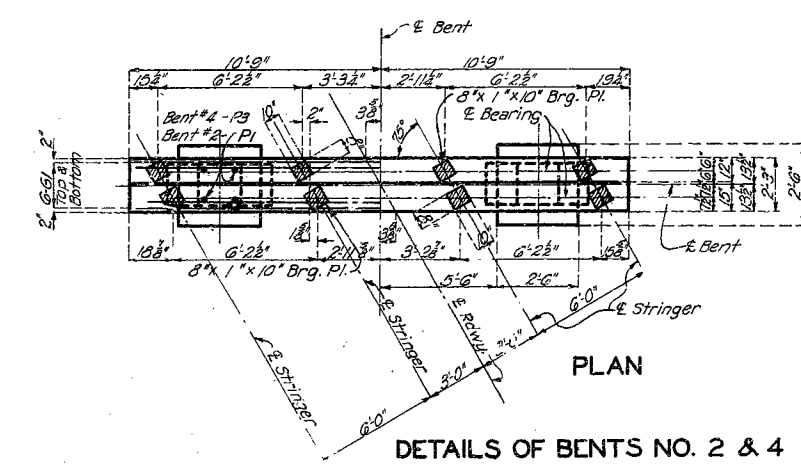

DETAILS OF BENTS NO. 2 & 4

BRIDGE OVER LOGAN REEK
STATE ROAD FROM DONIPHAN TO OXLY
ABOUT 0.5 MILE WEST OF OXLY
PROJECT NO. NRS 400A (SB) STA. 497+12
RIPLEY COUNTY





Drawn Sept. 1930 by I.B.
Traced Sept. 1930 by G.W. & R.J.G.
Assembled April 1933 by H.C.M.-G.W.
Checked April 1933 by R.H.S.

43


MISSOURI STATE HIGHWAY DEPARTMENT

FED. ROAD DIST. NO.	STATE	FED. AID PROJ. NO.	FISCAL YEAR	SHEET NO.	TOTAL SHEETS
5	MO	NRS 400A (SB)	19		

Note: Space dowel bars "C2" at approximately 12 cts. in curbs between outlets and at ends.

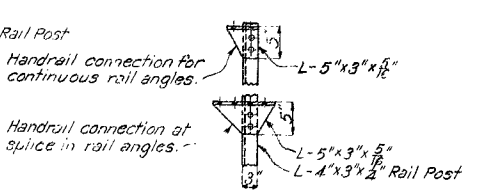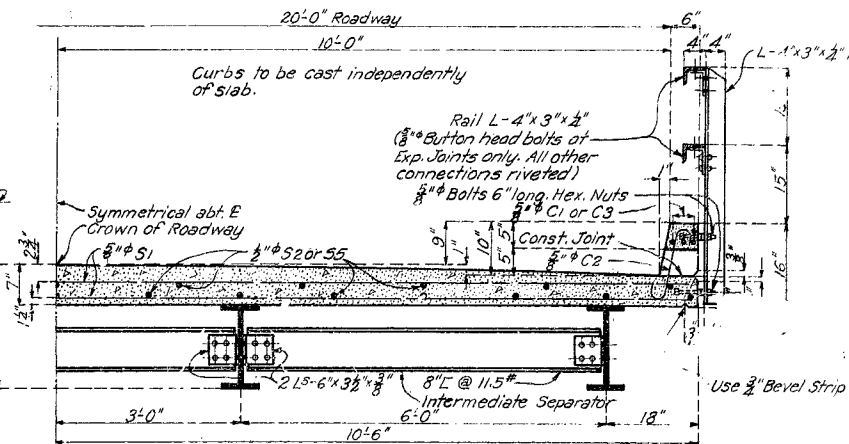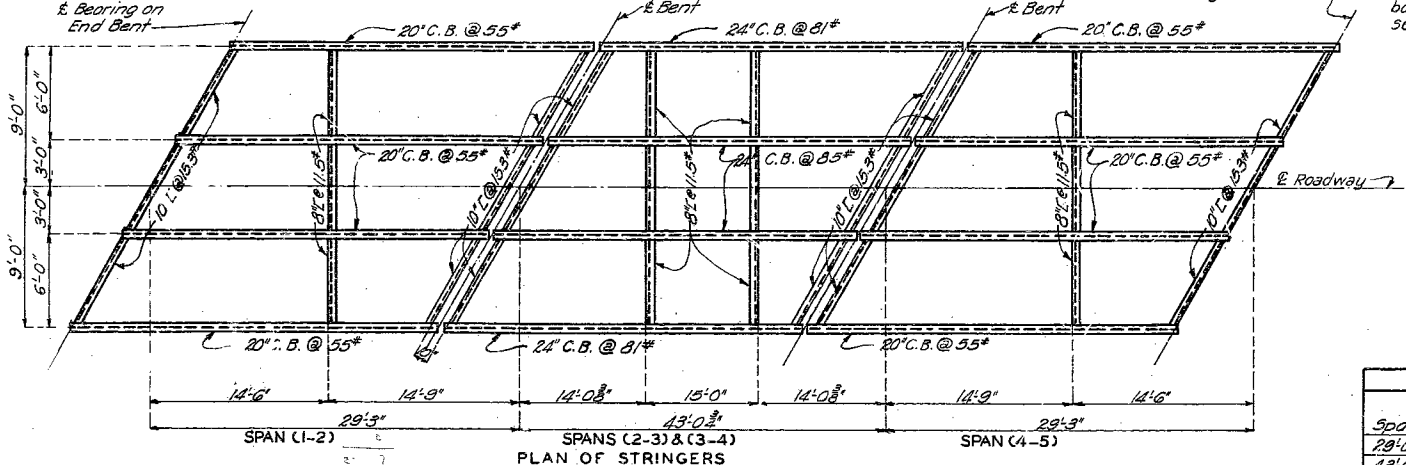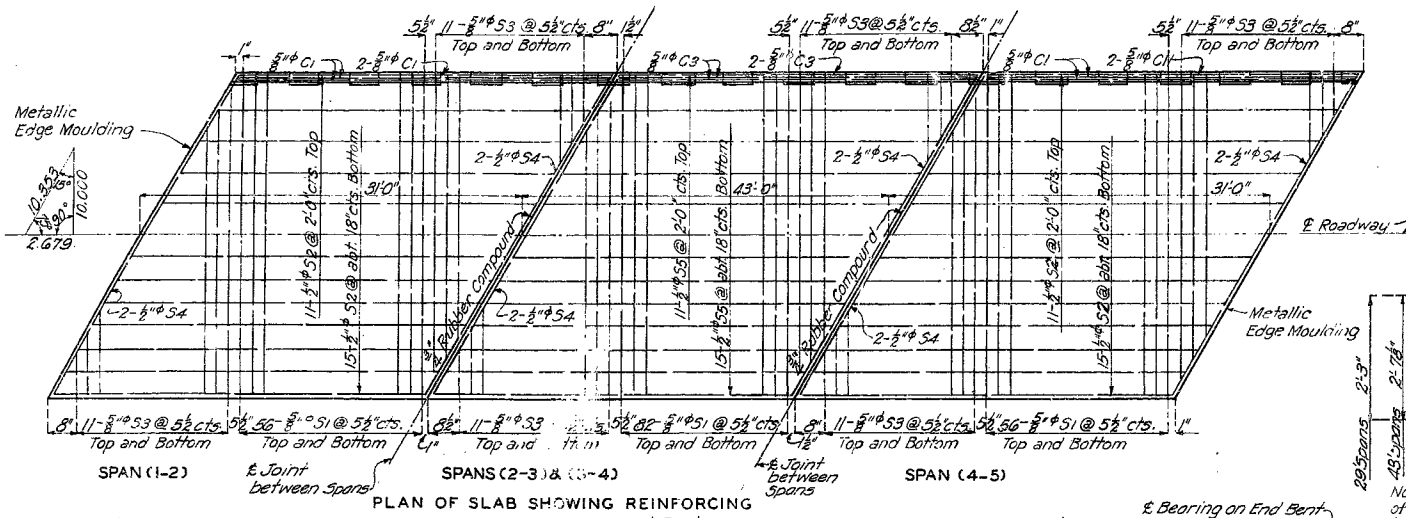

TYPICAL DETAILS FOR HANDRAIL POST (Railing not shown)

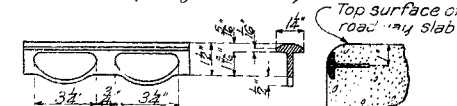

METALLIC EDGE Moulding

Note: Top of channel separators at ends of each I-Beam span to be flush with bottom of floor slab as shown in section thru end bent.


Note: Depth of outside stringers will in some cases be a fraction of an inch less than that of inside stringers and in order to keep bottom of slab horizontal it will be necessary to haunch slab down to top of outside stringers.

HALF SECTION THRU SPAN

PERMISSIBLE BEAM SUBSTITUTIONS


Span	Standard I-Beams		Bethlehem Beams	
	Inside	Outside	Inside	Outside
29'-0"	20" x 65.4"	20" x 65.4"	20" x 65.4"	20" x 65.4"
43'-0"	24" x 101"	24" x 90"	26" x 125"	26" x 81"

Note: See Special Provisions in regard to permissible substitution of beams and basis of payment.

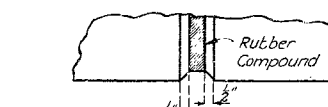


Note: Use bevel as shown for exposed faces of all joints consisting of rubber compound except at top surface of roadway slab. Use edging tool with 1/2" radius at top surface of roadway slab each side of rubber compound joint.

DETAIL OF BEVEL FOR RUBBER COMPOUND JOINTS

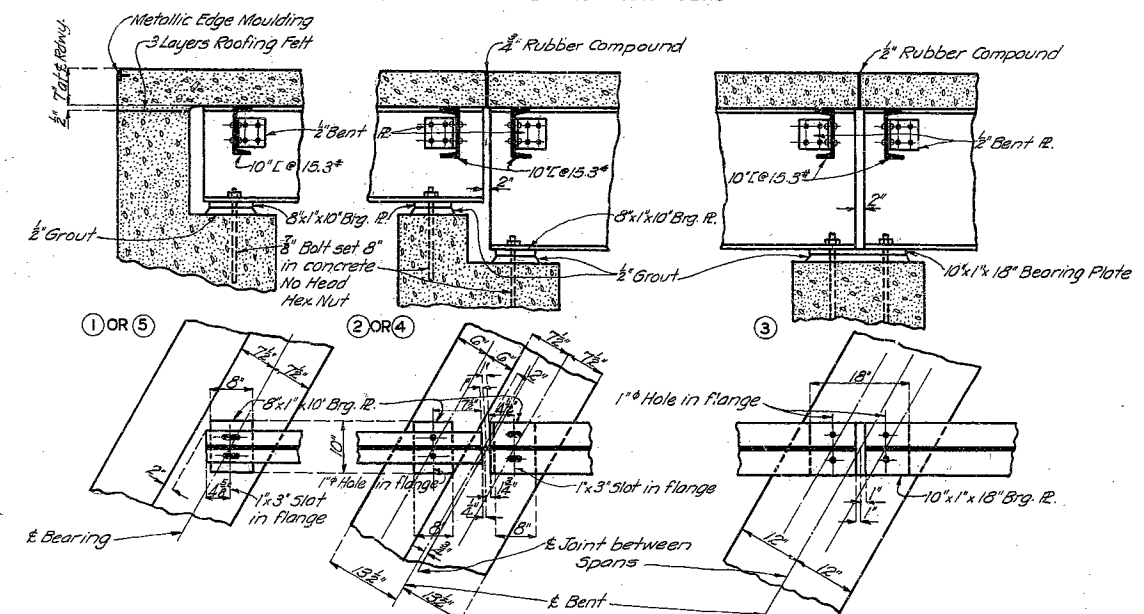

DETAILS OF BEARINGS

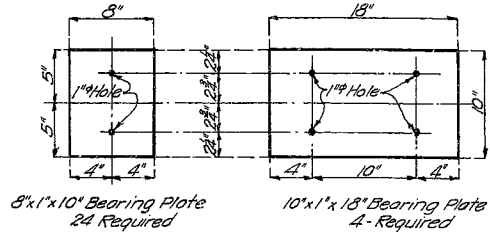



DETAILS OF BEARING PLATES

Note: This drawing is not to scale. Follow dimensions.


BRIDGE OVER LOGAN CREEK

STATE ROAD FROM DONIPHAN TO CKLY
ABOUT 0.5 MILE WEST OF CKLY
PROJECT NO. NRS 400A (SB) STA. 497+12
RIPLEY COUNTY

FED. ROAD DIST. NO.	STATE	FED. AID PROJ. NO.	FISCAL YEAR	SHEET NO.	TOTAL SHEETS
5	MO.	N.R.S. 400A (SB)	19		

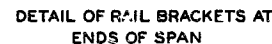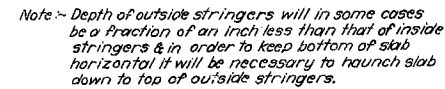

Note: Top of curbs under end posts shall be finished to a smooth finish parallel to grade. Not less than one nor more than four soft lead plates or flat washers shall be used under a rigid of each end rail cast to align the rail to correct elevation. Plates shall be 8" x 6" and shall be punched $\frac{1}{8}$ " on same gauge as angles. No grouting permitted. Cost of lead plates to be included in price bid for other items.

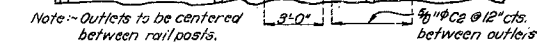

Sheet No. 5 of 5

F.A.

COUNTY


F.A.

S-889

Drawn July 1933 By H.E.C.
Traced July 1933 By H.E.C.
Checked July 1933 By N.W.R.

U.I.P. AND REHABILITATE EXISTING (29', 43', 43', 29') I-BEAM GIRDER SPANS


SEC/SUR 36 TWP 23N RGE 3E

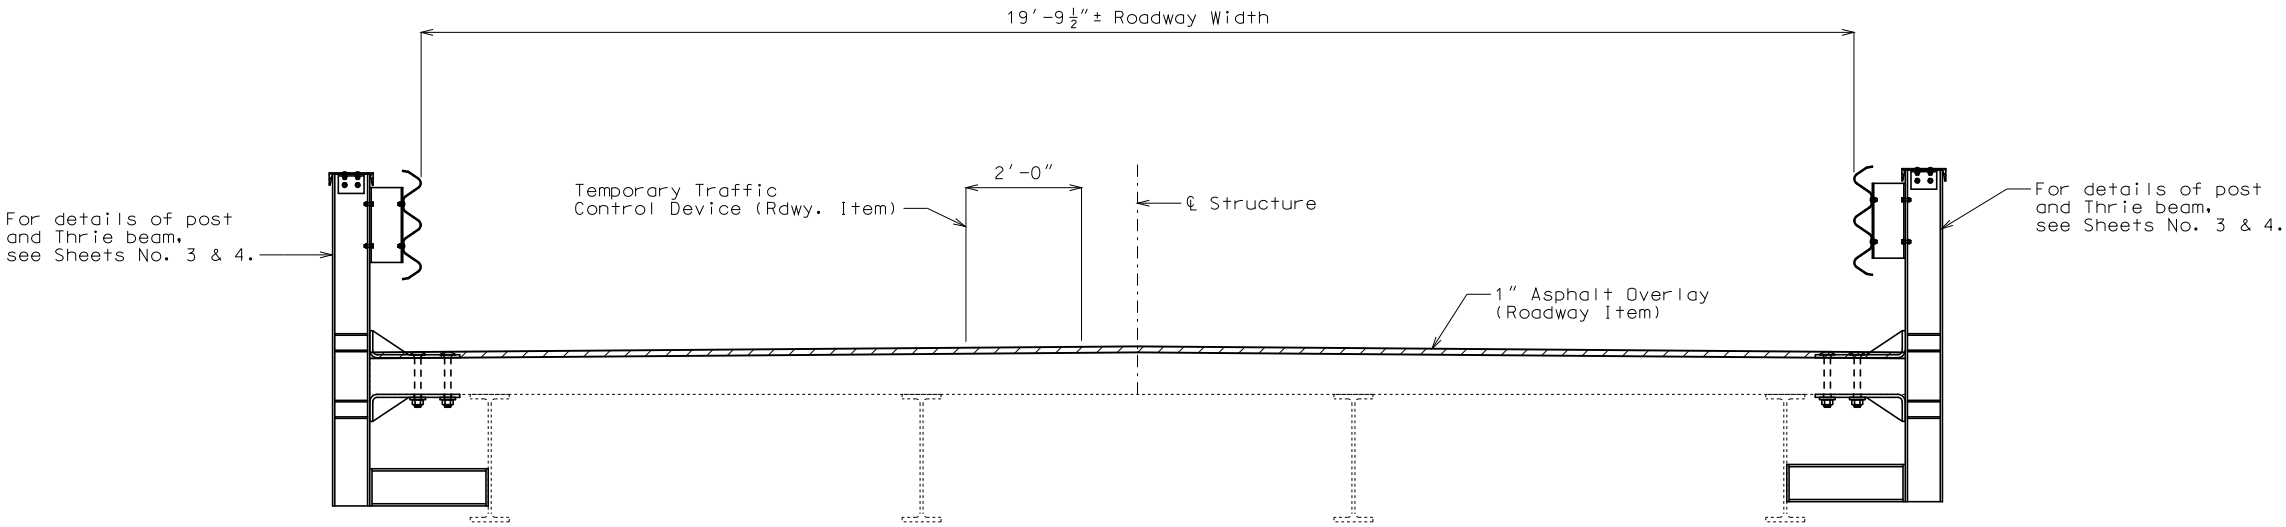


SECTION THUR SLAB

General Notes:

- Design Specifications:**
2002 - AASHTO (17th Edition) Standard Specifications
Load Factor Design
Bridge Deck Rating = 6
- Traffic Control:**
Traffic over structure to be maintained during construction (See Roadway Traffic Control Plans).
- Miscellaneous:**
Outline of old work is indicated by light dashed lines. Heavy lines indicate new work.
The area exposed by the removal of concrete and not covered with new concrete or asphalt shall be coated with an approved qualified special mortar in accordance with Sec 704.
Contractor shall verify all dimensions in field before ordering new material.
- (*) Payment for removal of existing brush curbs, steel rail and its components will be considered completely covered by the contract unit price for Removal of Existing Curb and Rail per linear foot.
- (**) After removal of steel rail components, H.S. Bolts shall be installed in existing holes. See Special Provisions for Rivet Removal and Replacement except that the cost of all work and materials to complete this item will be considered completely covered by the contract unit price for Removal of Existing Curb and Rail.
- The surface of existing I-Beam exposed by removal of existing steel rail components shall be coated with one coat of gray epoxy-mastic primer (non-aluminum) in accordance with Sec 1045. Payment for gray epoxy-mastic primer, material and labor, will be considered completely covered by the contract unit price for other items.
- Temporary Barrier shall not be attached to the bridge.

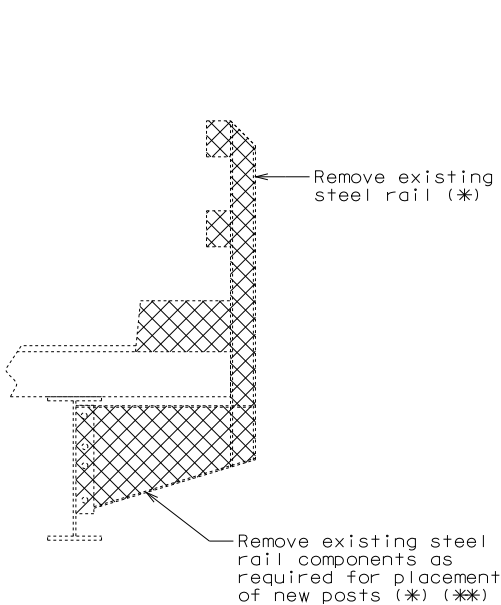

TYPICAL PART SECTION
SHOWING STEEL POST
AND RAIL COMPONENTS REMOVAL

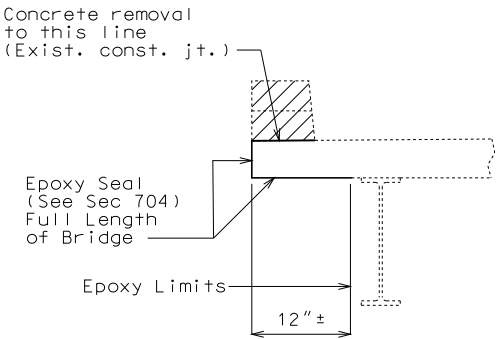

TYPICAL PART SECTION THRU
SLAB SHOWING AREA
OF CONCRETE CURB REMOVAL
AND EPOXY SEAL LIMITS

Estimated Quantities		Total
Removal of Existing Curb and Rail	linear foot	296
Clean and Epoxy Seal	sq. foot	444
Bridge Guardrail (Thrie Beam)	linear foot	288

REPAIRS TO BRIDGE OVER LOGAN CREEK


ROUTE 142 FROM RTE. N TO RTE. T
ABOUT 1 MILE EAST OF RTE. N
STA. 497+12.00± (MATCH EXISTING)

STD. 606.23
STD. 617.10

Detailed July 2016
Checked Aug. 2016

Note: This drawing is not to scale. Follow dimensions.

Sheet No. 1 of 4

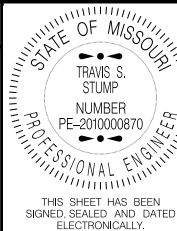

DATE PREPARED
8/9/2016

ROUTE 142 STATE MO
DISTRICT BR SHEET NO. 1

COUNTY RIPLEY
JOB NO. J9S3171
CONTRACT ID.



PROJECT NO.

BRIDGE NO.
S08891

DESCRIPTION	DATE

MISSOURI HIGHWAYS AND TRANSPORTATION
COMMISSION
105 WEST CAPITOL
JEFFERSON CITY, MO 65102
1-888-ASK-MODOT (1-888-275-6636)

IF A SEAL IS PRESENT ON THIS SHEET IT HAS BEEN ELECTRONICALLY SEALED AND DATED.

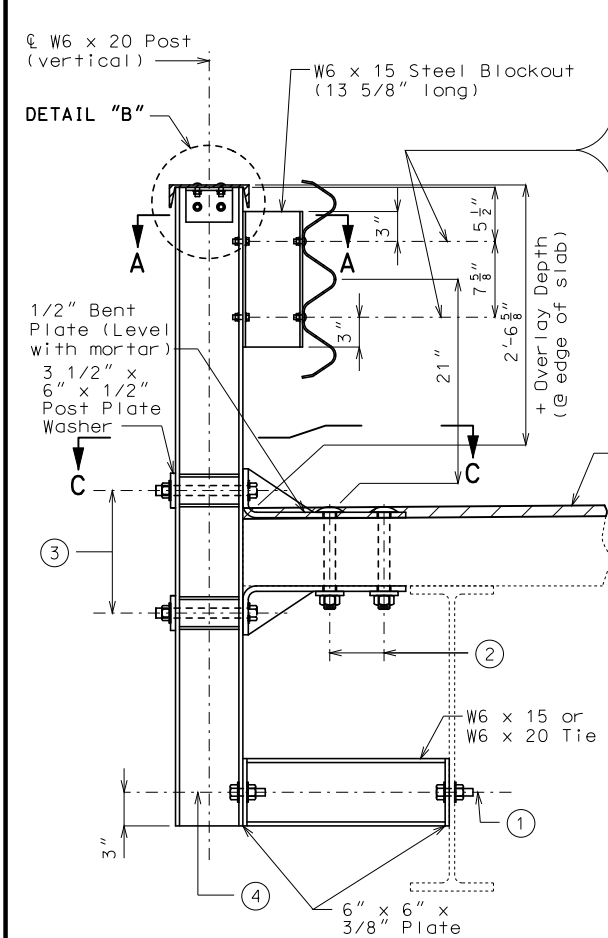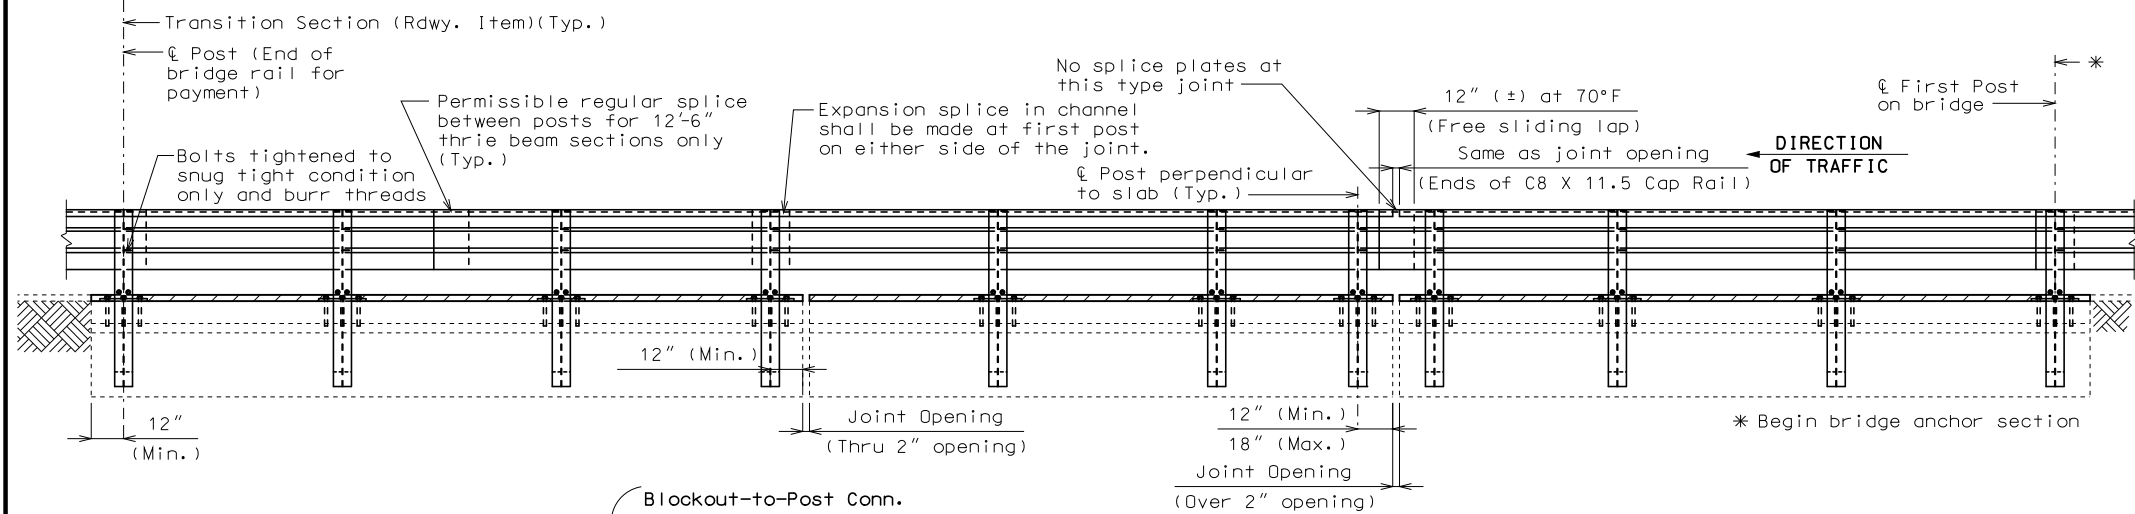

Blockout-to-Post Conn.

2 Holes 13/16"Ø in W6 x 20 Post flange and W6 x 15 Blockout flange

2 Hex head bolt 5/8"Ø with two washers and hex nut in W6 x 20 Post flange

Thrie Beam-to-Blockout Conn.

13/16" x 2 1/2" Vertical slotted hole in W6 x 15 Blockout flange (**)

5/8"Ø Carriage bolt with one flat washer and hex nut

Post-to-Bent Plate Conn.

2 Bolts 1"Ø A325 H.S. with hardened washers
2 Vertical slotted holes 1 1/16" x 1 1/2" in post flanges
2 Holes 1 1/16"Ø in bent plate and post plate washer

Post-to-Tie Conn.

2 Bolts 3/4"Ø A325 H.S. with hardened washers
2 Holes 15/16"Ø in post flange and 6" x 6" x 3/8" plate

Bent Plate-to-Deck Conn.

3 Drilled holes 1 1/8"Ø (min.) in old concrete or as recommended by manufacturer
3 Holes 1 1/4"Ø in bent plates
3 Bolt 1"Ø A325 H.S. Round head bolts, snug tight, with hardened washers


Post-to-Tie Conn.

2 Bolts 3/4"Ø A325 H.S. with hardened washers
2 Holes 15/16"Ø in girder web and 6" x 6" x 3/8" plate


PART ELEVATION SHOWING THRIE BEAM RAIL

Note:
At bridge ends for head to head traffic, guardrail shall be used at all four corners and for single directional traffic, guardrail shall be used at entrance ends only unless required at the exit.

** Required on one side of web only, but may be provided on both sides of web at the contractor's option.

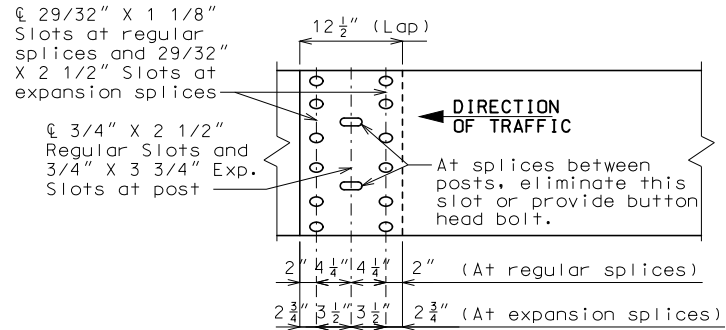

THRIE BEAM RAIL SPLICE DETAILS

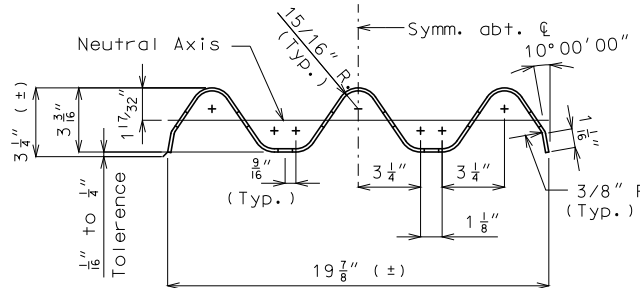

SECTION THRU THRIE BEAM RAIL

GENERAL NOTES:
Design Specifications: 2002 - AASHTO 17th Edition

Guardrail delineators shall be attached to the top of the guardrail and shall similarly use the delineator details of Missouri Standard Plan 617.10, except that the delineator body shall be attached to the top of the cap rail using galvanized anchorage as shown on Missouri Standard Plan 606.00. Delineators on bridges with two-lane, two-way traffic shall have retroreflective sheeting on both sides. Guardrail delineators will be considered completely covered by the contract unit price for Bridge Guardrail (Thrie Beam).

Panel lengths of channel members shall be attached continuously to a minimum of four posts and a maximum of six posts (except at end bents).

All bolts, nuts, washers, and plates will be considered completely covered by the contract unit price for Bridge Guardrail (Thrie Beam).

All steel connecting bolts and fasteners for posts and railing, and all anchor bolts, nuts, washers and plates shall be galvanized after fabrication. Protective coating and material requirement of steel railing shall be in accordance with Sec 1040.

Rail posts shall be set perpendicular to roadway profile grade, vertically in cross section and aligned in accordance with Sec 713 except that the rail posts shall be aligned by the use of shims such that the post deviates not more than 1/2 inch from true horizontal alignment after final adjustment. The shims shall be 3" x 1 3/4" and placed between the blockout and the thrie beam rail. The thickness of the shims shall be determined by the contractor and verified by the engineer before ordering material for this work.

At the expansion slots in the thrie beam rails and channels, the bolts shall be tightened and backed off one-half turn and the threads shall be burred.

At the thrie beam connection to blockout on wings, the bolts shall be tightened and backed off one-half turn and the threads shall be burred.

Minimum length of thrie beam sections is equal to one post space.

5/8"Ø button-head, oval shoulder bolts with 3/8" min. thickness hex nuts shall be used at all slots.

Thrie beam guardrail on the bridge shall be 12 gage steel.

Posts, cap rail angles, bent plates, channels and channel splice plates shall be fabricated from ASTM A709 Grade 36 steel and galvanized.

Washers shall be used at all post bolts between the bolt head and beam. The flat washers shall be rectangular in shape 3" x 1 3/4" x 3/16" minimum and with a 11/16" x 1" slot, or when necessary of such design as to fit the contour of the beam. A 3" x 1 3/4" x 5/8" rectangular washer shall be used between the blockout and the thrie beam rail.

Special drilling of the thrie beam may be required at the splices. All drilling details shall be shown on the shop drawings.

Fabrication of structural steel shall be in accordance with Sec 1080.

Expansion splices in the thrie beam rail shall be made at either the first or second post on either side of the joint and on structure at bridge ends. When the splice is made at the second post, an expansion slot shall be provided in the thrie beam rail for connection to the first post to allow for movement.

In addition to the expansion provisions at the expansion joints, expansion splices in the thrie beam rail and the channel shall be provided at other locations so that the maximum length without expansion provisions does not exceed 200 ft.

Contractor shall verify all dimensions before ordering materials.


Shim plates 6" x 6" x 1/16" may be used between the top of the post and the channel member as required for vertical alignment.

See slab sheet for rail post spacing.


See Missouri Standard Plans 606.00 for details not shown.

PART SECTION AT RAIL POST


Note: For Section C-C see sheet No. 4.

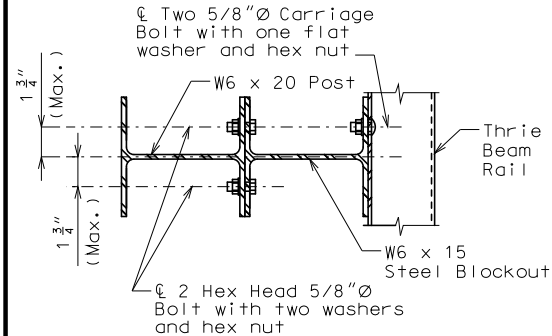

SECTION A-A

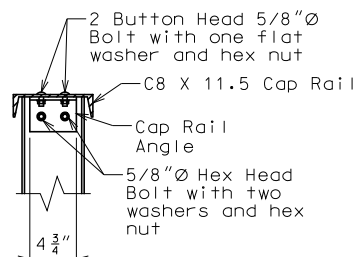

DETAIL B

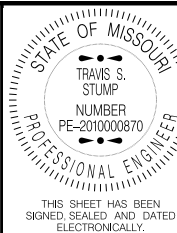

DATE PREPARED
8/9/2016

ROUTE
142

STATE
MO

DISTRICT
BR

SHEET NO.
3

COUNTY
RIPLEY

J9S3171

CONTRACT ID.

PROJECT NO.

BRIDGE NO.
S08891

DESCRIPTION

DATE


MISSOURI HIGHWAYS AND TRANSPORTATION COMMISSION

105 WEST CAPITOL
JEFFERSON CITY, MO 65102
1-888-ASK-MODOT (1-888-275-6636)

IF A SEAL IS PRESENT ON THIS SHEET IT HAS BEEN ELECTRONICALLY SEALED AND DATED.

SEC/SUR	36	TWP	23N	RGE	3E
---------	----	-----	-----	-----	----




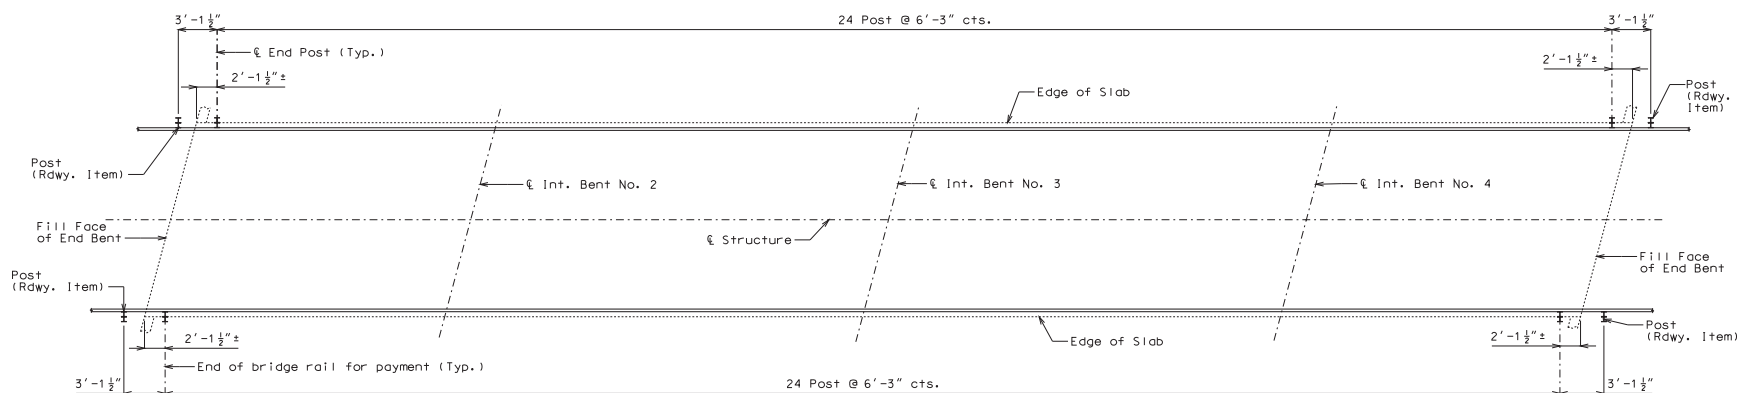

Note:
Work this sheet with Sheets No. 1, 3 & 4.

Note: This drawing is not to scale. Follow dimensions.

Sheet No. 2 of 4

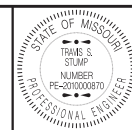

[illegible]

13" (Max.)
 1 3/4" (Max.)
 Two 5/8"Ø Carriage Bolt with one flat washer and hex nut
 W6 x 20 Post
 Thrie Beam Rail
 W6 x 15 Steel Blackout
 Two Hex Head 5/8"Ø Bolt with two washers and hex nut
 SECTION A-A

① { Post-to-Tie Conn.
 2 Bolts 3/4" Ø A325 H.S.
 with hardened washers
 2 Holes 15/16" Ø in girder
 web and 6" x 6" x 3/8"
 plate

Diagram illustrating a three-post expansion splice. The diagram shows a cross-section of a concrete slab with three vertical reinforcement posts. The traffic direction is indicated by an arrow pointing to the right, labeled "DIRECTION OF TRAFFIC".

Dimensions and labels:



- Top reinforcement: $\frac{1}{2}$ 29/32" X 1 1/8" Slots at regular splices and 29/32" X 2 1/2" Slots at expansion splices.
- Post reinforcement: $\frac{3}{4}$ " X 2 1/2" Regular Slots and $\frac{3}{4}$ " X 3 3/4" Exp. Slots at post.
- Top lap dimension: 12 1/2" (Lap).
- Bottom dimensions:
 - 2 1/4" (At regular splices)
 - 2 3/4" (At expansion splices)
- Note: At splices between posts, eliminate this slot or provide button head bolt.

The diagram shows a cross-section of a symmetrical part. Key dimensions include:

- Total width: $19 \frac{7}{8}$ inches
- Height from base to top: $3 \frac{1}{4}$ inches
- Distance from centerline to first peak: $3 \frac{1}{4}$ inches
- Distance between peaks: $3 \frac{1}{4}$ inches
- Distance from last peak to right edge: $3 \frac{1}{4}$ inches
- Radius at bottom right: $\frac{3}{8}$ inch R
- Angle at top right: $10^{\circ}00'00''$
- Tolerance: $\pm .001$ inch

AS-BUILT PLANS

  Note: This drawing is not to scale. Follow dimensions.



Notes:

Shim plates 6" x 6" x 1/16" may be used between post W6 x 20 and 6" x 6" x 3/8" plate and shim plates 6" x 3 1/2" x 1/16" may be used between post W6 x 20 and 1/2" bent plate connection as required for horizontal alignment.

Shim plates may vary in thickness from 1/16" to the thickness required, and may be used in multiples.


Shim plates shall be galvanized after fabrication.



Expansion slots same side of post as exp. joint



SIDE VIEW
EXPANSION CAP RAIL ANGLE
45 x 3 1/2 x 5/16

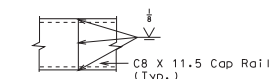

OPTIONAL SPLICE

Shop or field splice
at any location
(Max. one per panel)



COUNTY

RIPLEY

JOB NO.
1953171

9933171

CONTRACT ID

161118-H07

PROJECT NO.

J9S3171

BRIDGE NO.
600001

S08891

DATE	DESCRIPTION
------	-------------

MISSOURI HIGHWAYS AND TRANSPORTATION [



AS-BUILT PLANS