



Ŋ

5

			FED. ROAD	STATE	FEP. AID	FISCAL	SHEE?	TOTAL	
			DIST. NO. 5	NO.	PROJ. NO. シイ527(77 くろシャノ)	YEAR 19	HO,	SHERTS	
	d Bent #1	لكام				~			
/ē fo; 3'-0" Rock	Slope-		H.W. 8 ול לסו גו		6.27	and the second	Š		
Blanket-	P.	3:0" Roc.	t Bionke		de 1	5			
	of end be	er ond in fr nt to b =	ont D	ood					
A CONTRACTOR	Firmly tan Ground L								
a826834		10C- 685			<b>F</b> # 1				
FRONT OF END E	BENTS P. Rock Slonke	t shall be	SIDE SLOF		FULL				
fills at	Enc' Bent N d Plunt for	10.1 as sho	in in sk	erch	25.				
	OCK BLANKE								
<i>h</i> .									
GENERAL N	NOTES								
Design	Specification	s A.A.S.H.C	(1953.).						
Struct	g no-a. Steel Steel Ste	Stress 180	000 #/=						i
Concre	ete Class"3".	Stress 1.0	00 #/ =".						
Rivets	erete sholl "4"; holes la istion of we	"except in h	andrail,m ators w	here Ni be	rivets	ensis ed.	e 8 % %	0/05/2".	
OKE COUT	stion of we Shop, none; stred jead o	つつつ ちょうつつ	CE ICCIC	· · · ·	5/ D/G O	. سرمد بهد تن	eres	1200	ns
Contract	ors of red l or except c	eoo. No     or No <i>noted</i> +	or stee	n. Loil	) 5 8 9 8 . R	pplie	ර හැ ග්		
required	shall be t	urnished	by Can	ŕrac	tor,	Payn	nent	for	
in unit pr See S	ection 22-9	Fabricate C of Star	ed str	uctu Deci	ficatio	eel. Ins re	~		
required Where	nd painting rise biol for ection 22-9 painting of joint filler requirement requirement s must be ab	'steel pile is specific	s. d on the	e plo	ns, ita	ing//	cont	brm	
with the given in s	requirements	2D of Sto	nnoulde ndar,d	:5' /v/ SPE	cifical	for I	Filler 5.	' <b>0</b> 5	
Ttemento	and in interior	- concot be	tonos	000-	and hu	4-1-1-		74	5.
overail le: specified	''gth less th ' Shipping po	9019 75-0" Wat	must be	: Sh:	יבש אבייייטיי י	rail	<del>1</del> 0 f	he	
details or	ionnections it the Conti chia nonio	ortor des	ine to	alin	to all	field	1		
the Sat r	n this projective the neod wet neod hachine balts	bolts spe	ecified a	for h	e sorra ondrail ndord	erce Heo	de a	nd	
55	0,000 julion - 200,000 julion - 200,000,			, _, _, _,		. 90			
	8.M.#3A·E/e (U.S.G.S.Dat		ike in tru	rt 30	0" Em 3	8' R+. S	570.20	0+60	
	BRIDGE		UTH F	ORH			JF C	REEN	$\langle  $
		FROM RIE S							- 1
1.		VILES 5. OF S							
naition	PROJECT NO	).S-1521(1)	(SW)	<b>5ta</b> . 2	0+40				
,	PERRY		COUN	ITY					Ì
Y	$\mathcal{O}$	7. 100.		12.1	CIRC	-	,		
	APPROVED BY	minor entities	ton DATE					Dallas	
		CHEF ENGINEER							3
								1-62	
FINAL PLANS	SROWN-LINE					_			

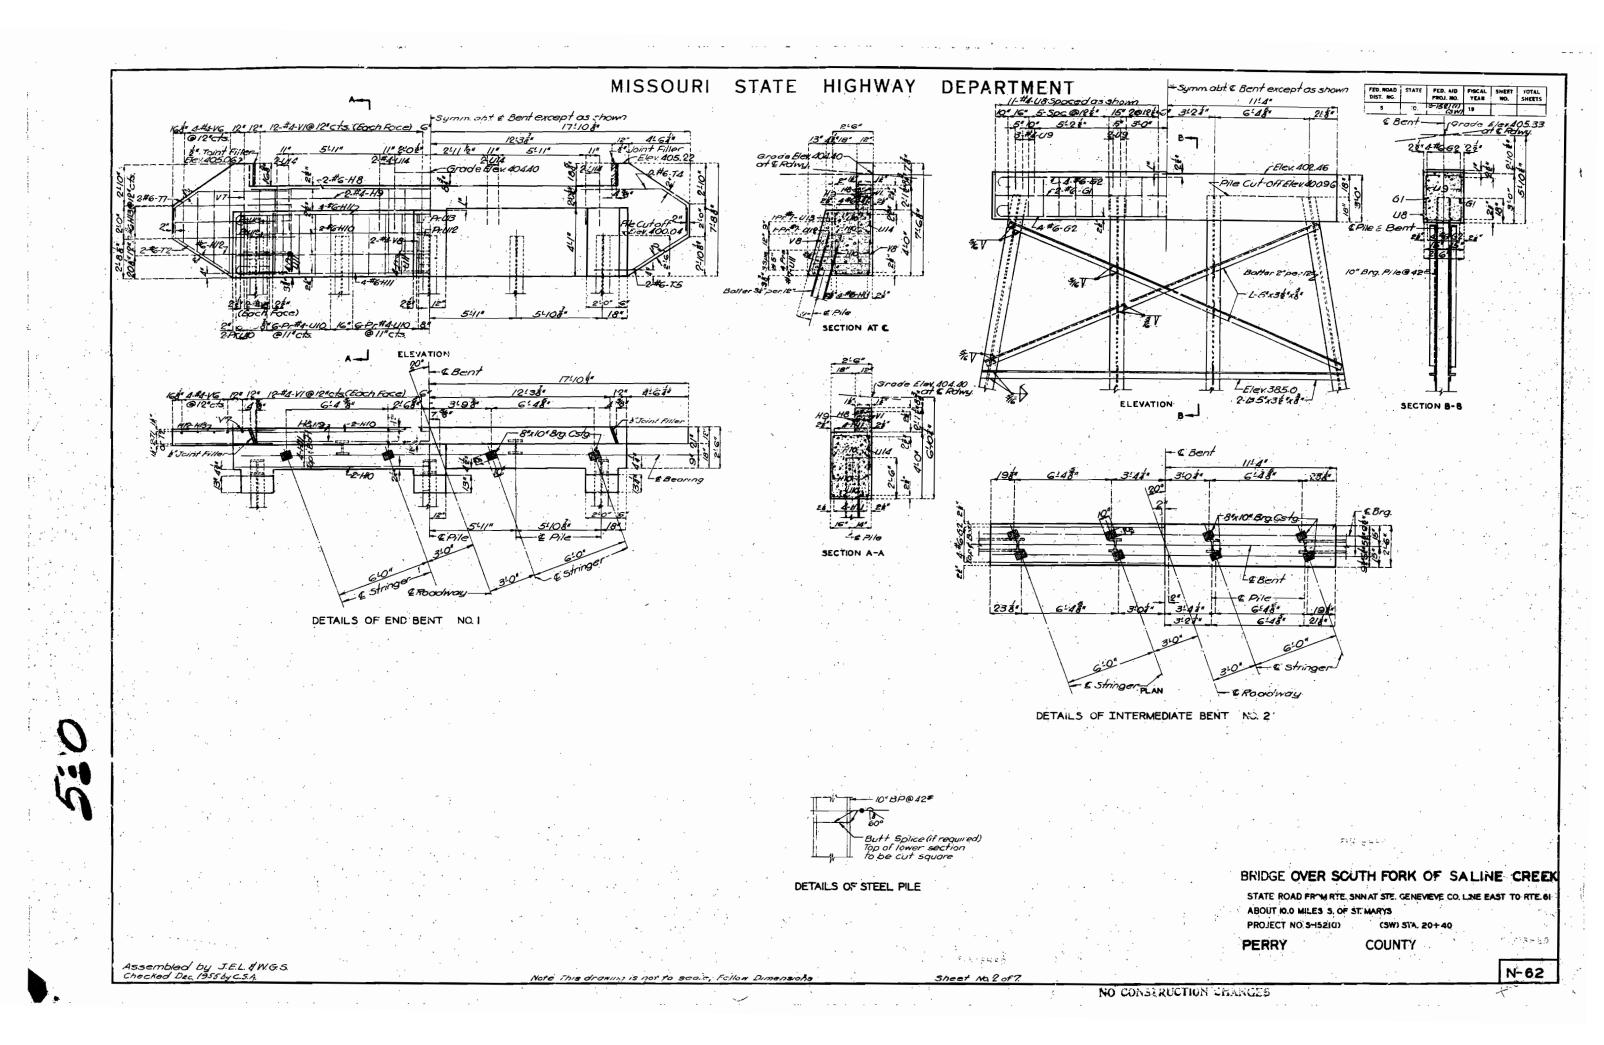

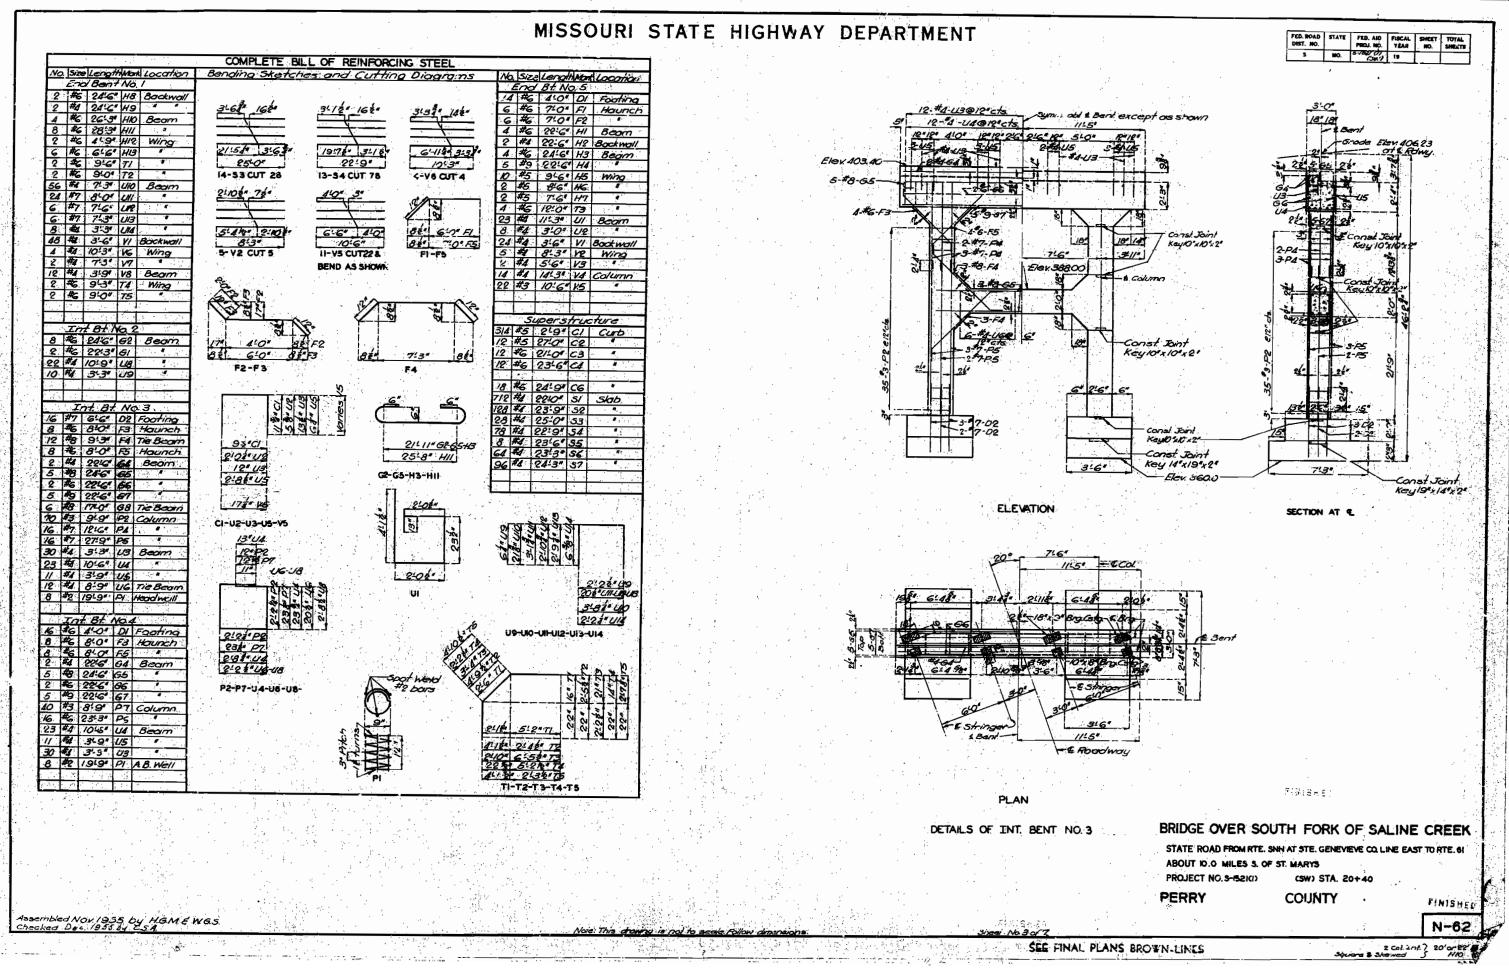

and a second second


12.7


L &


蹇.

6

100

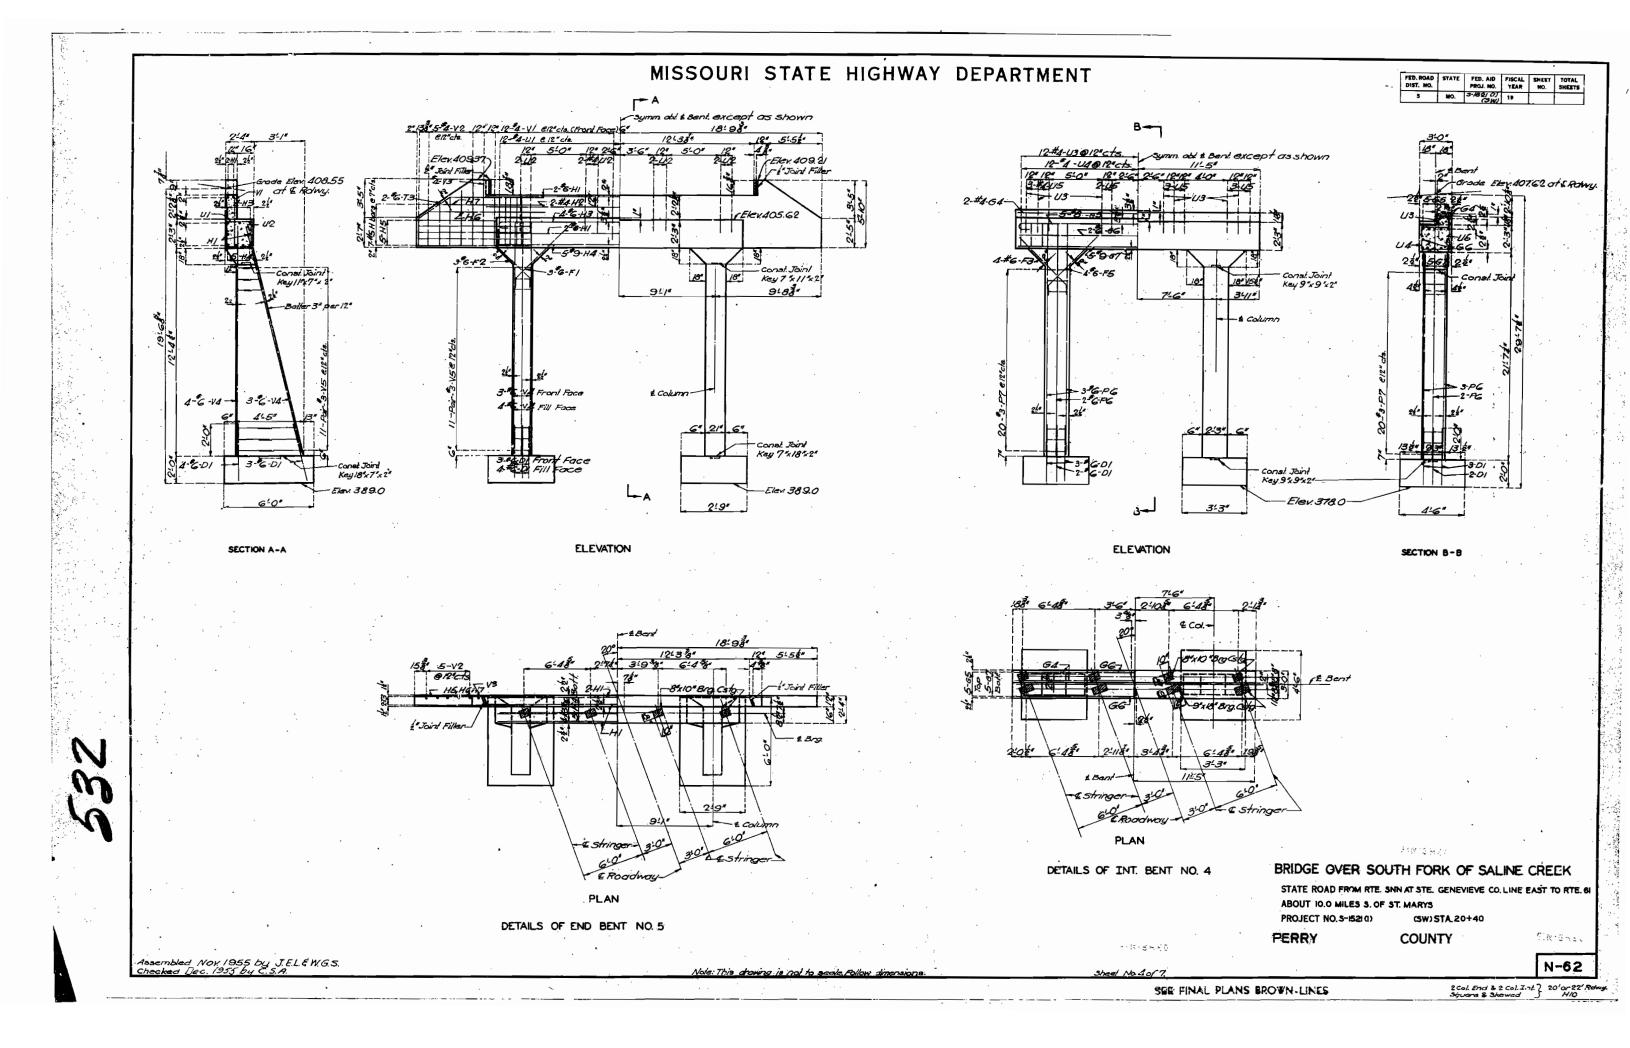


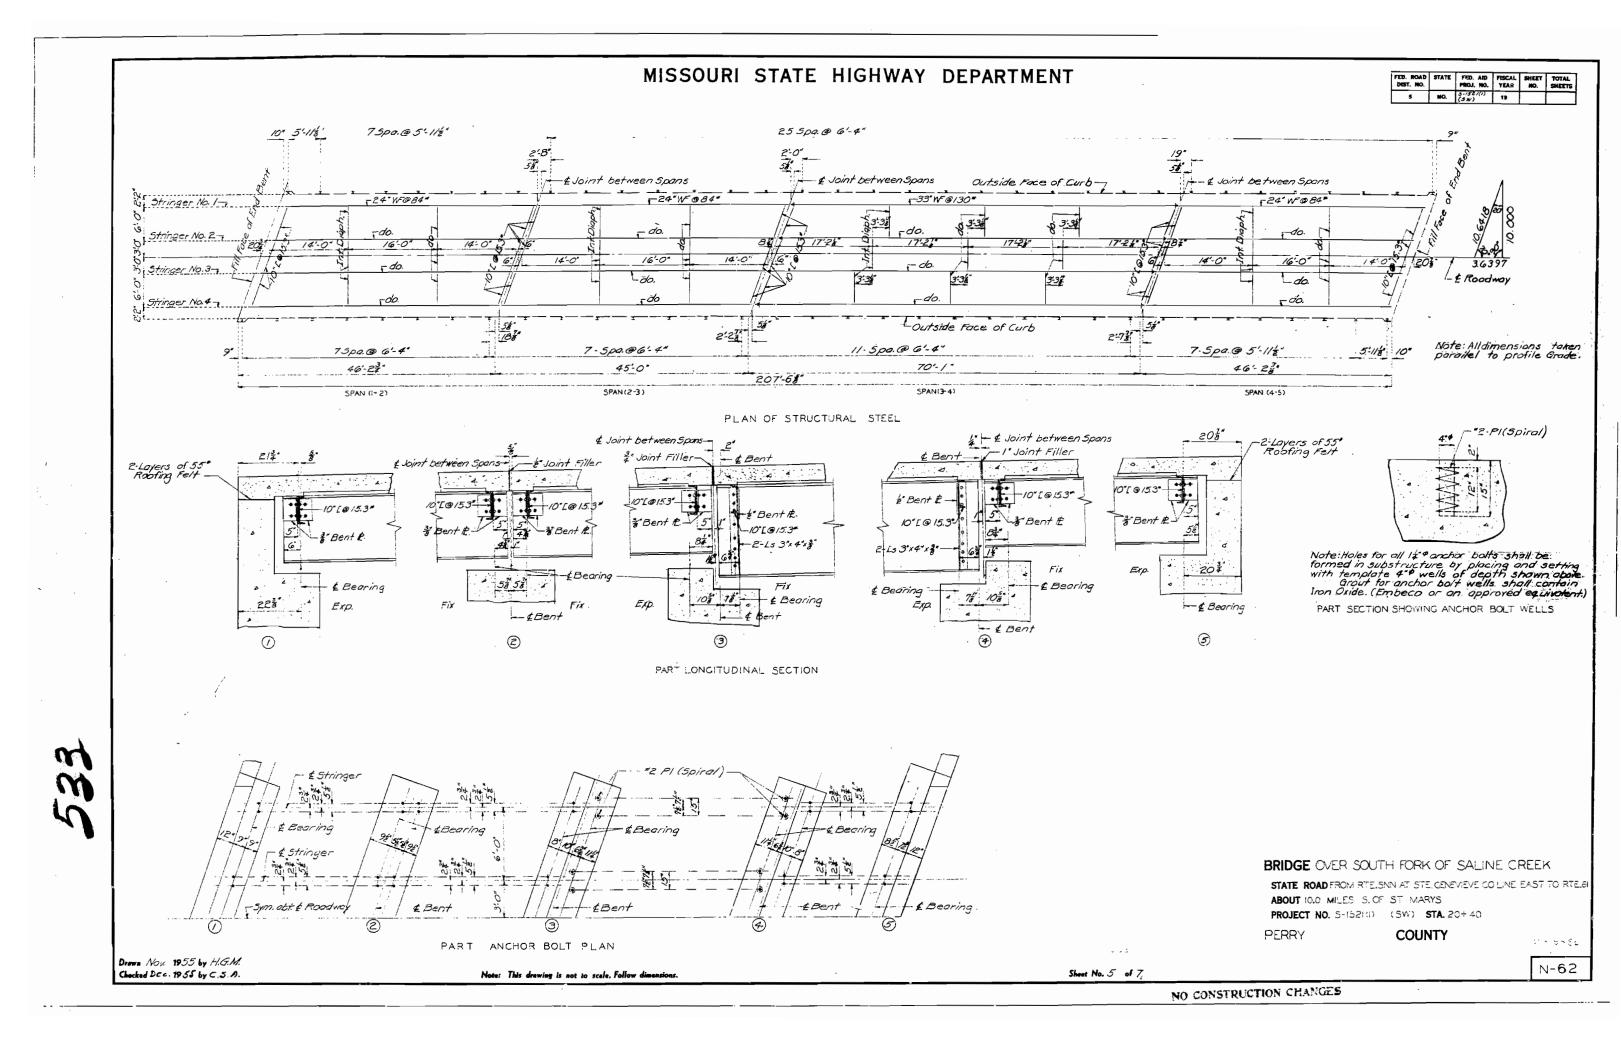

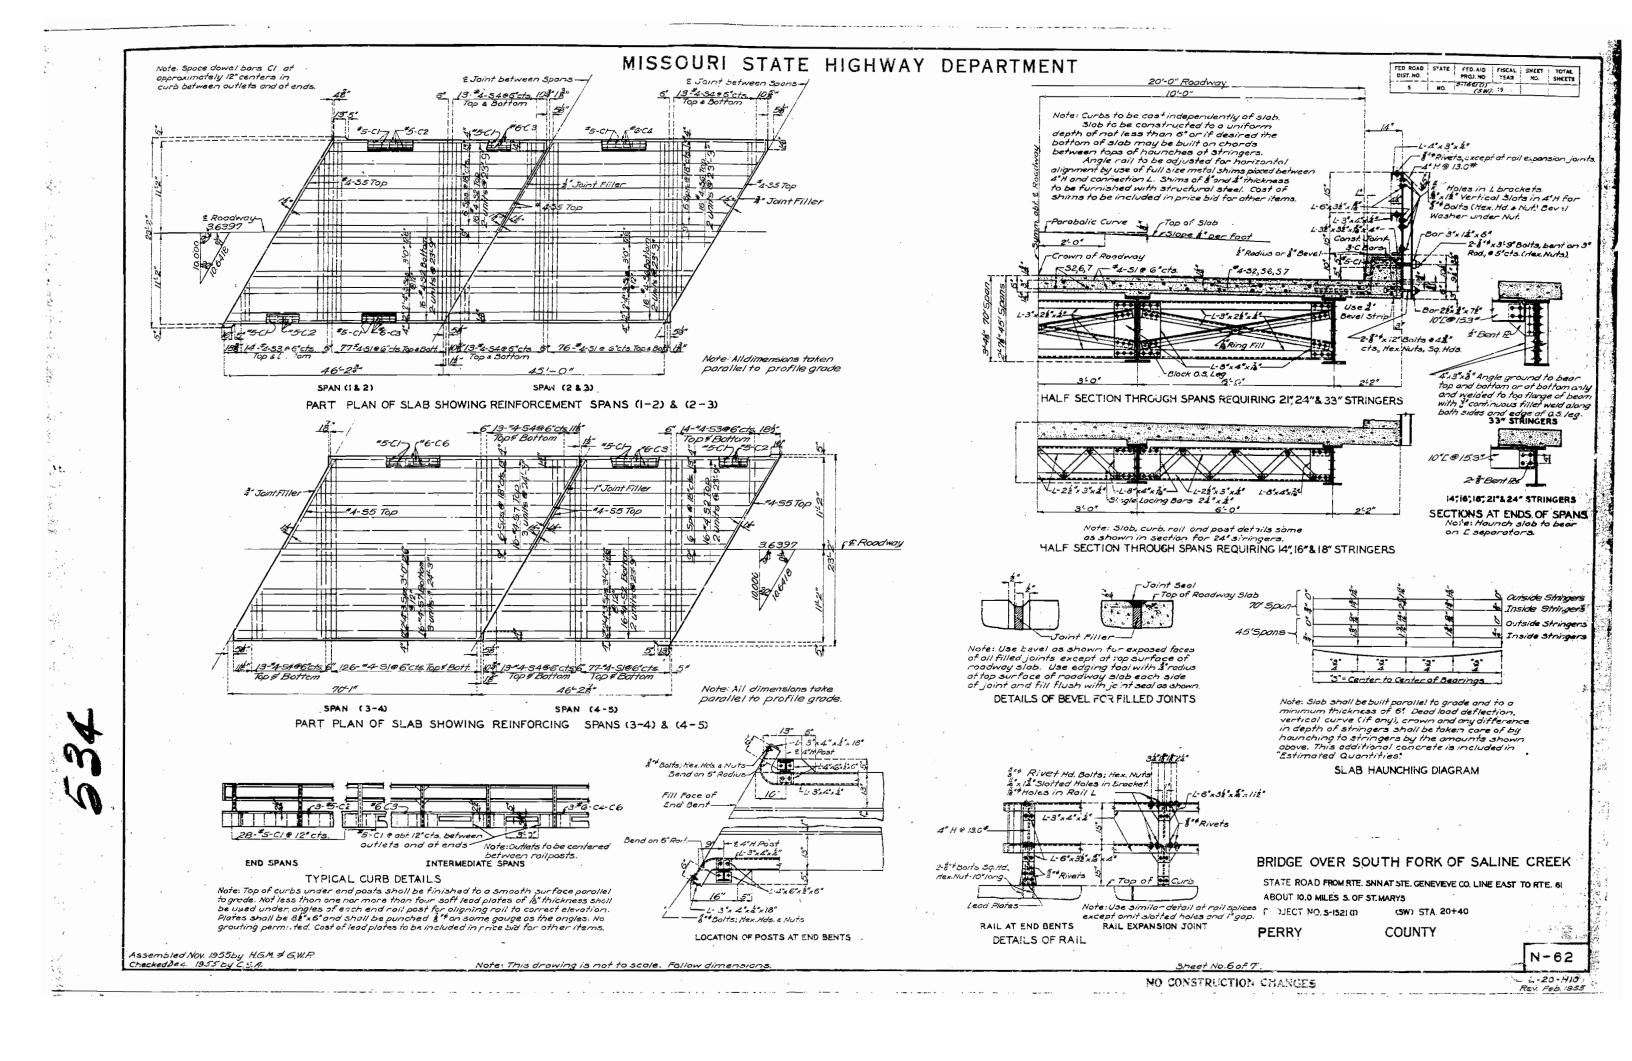



# MISSOURI STATE HIGHWAY DEPARTMENT

is" Diameter

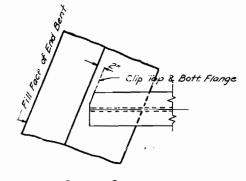

0 6 \*

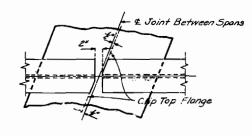


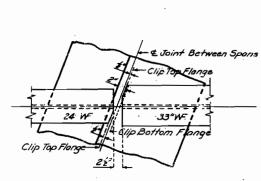


DETAILS OF STRINGEP FLANGES NEAR BENTS

⊘

3 1

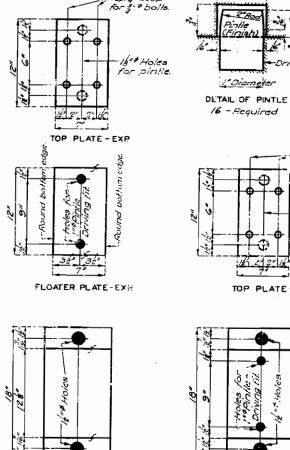

Top 📲 deep

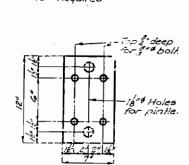

TOP PLATE -FIX.

BOTTOM PLATE - FIX.


Driving fit




BOTTOM PLATE - EXP.

42

Note: Plan of fill plates same as for top castings. - Fill R : "\*\* 7" (Stringers #18-3 only)-2-3" Stud bolis

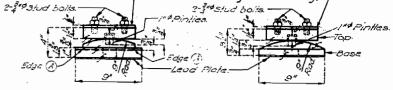

END ELEVATION - EXP END ELEVATION - FIX. Required 4 Sets for 70' Span, Each set consists of 5 Plates each. TYPE "B"

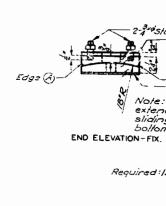

GENERAL NOTES:

\*16/6/201


Assembled Nov. 1955 by H.G.M. & W.J.K. Checked Dec. 1955 by C.S.A.

m

#### DETAILS OF BEARING CASTINGS

Note: This drawing is not to scale. Follow dimensions.


Sheet No. 7 of 7. NO CONSTRUCTION CHANGES

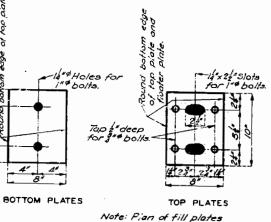

ote:	Pial	n of	fill p	lates	
ame	<b>a</b> 5	for	top	olates castings.	

FED, ROAD DIST. NO.	STATE	FED, AID PROJ. NO.	FISCAL	TOTAL
5	MO	5-/52/(/) (3W)	19	

Fill Plats Thickness"a"								
Stringer	*/	*2	#3	•4				
Bt. No.1	1	1.1	2"	1.				
Bt: No2(Spanl-2)			1					
Bt. No.2 (Span.2-3)	*	\$ª.	#	÷.				
Bt.No.3	t"		1:					
Bt.No.3	ť.	1	<u>‡</u> "	•				
Bt. No.5	ź.		21					

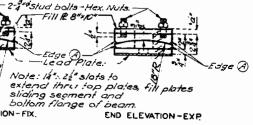

Required 123ets for 45'SpangEach set consists of 5 plates each.

TYPE C

54

Finish all surfaces marked J.

Material for Type "B" and Type"c" castings shall be either gray iron alloy or cast steel but payment will be made as Gray Iron Alloy. All bots and nuts and topered pins shall be paid for as structural steel Anchor, bolls for Type "B" Castings. shall be 13" swedged bolts with Hex. nuts and shall extend 12" into concrete. Anchor bolls for Type"c" castings shall be 1" " swedged bols, no heads or nuts and shall extend 10" into concrete. Top ends of anchor bolts shall be above the top of castings but not higher than \$" below the top of castings shall be induced in price bid for other items. Edge (A) to be rounded. (\$" \$" Radius) Fill plates may be made as part of top casting it desired but payment for additional cast metal will be made as Fabricated Structural Steel.

5:2°8430

#### BRIDGE OVER SOUTH FORK OF SALINE CR.

STATE ROAD FROM RTE. SNN AT STE. GENEVIEVE CO. LINE EAST TO RTE. 61 ABOUT IO.O MILES S. OF ST MARYS PROJECT NO.S-IS2ICI)


(SW) STA. 20+40

PERRY


COUNTY

N-62

. S. 504.

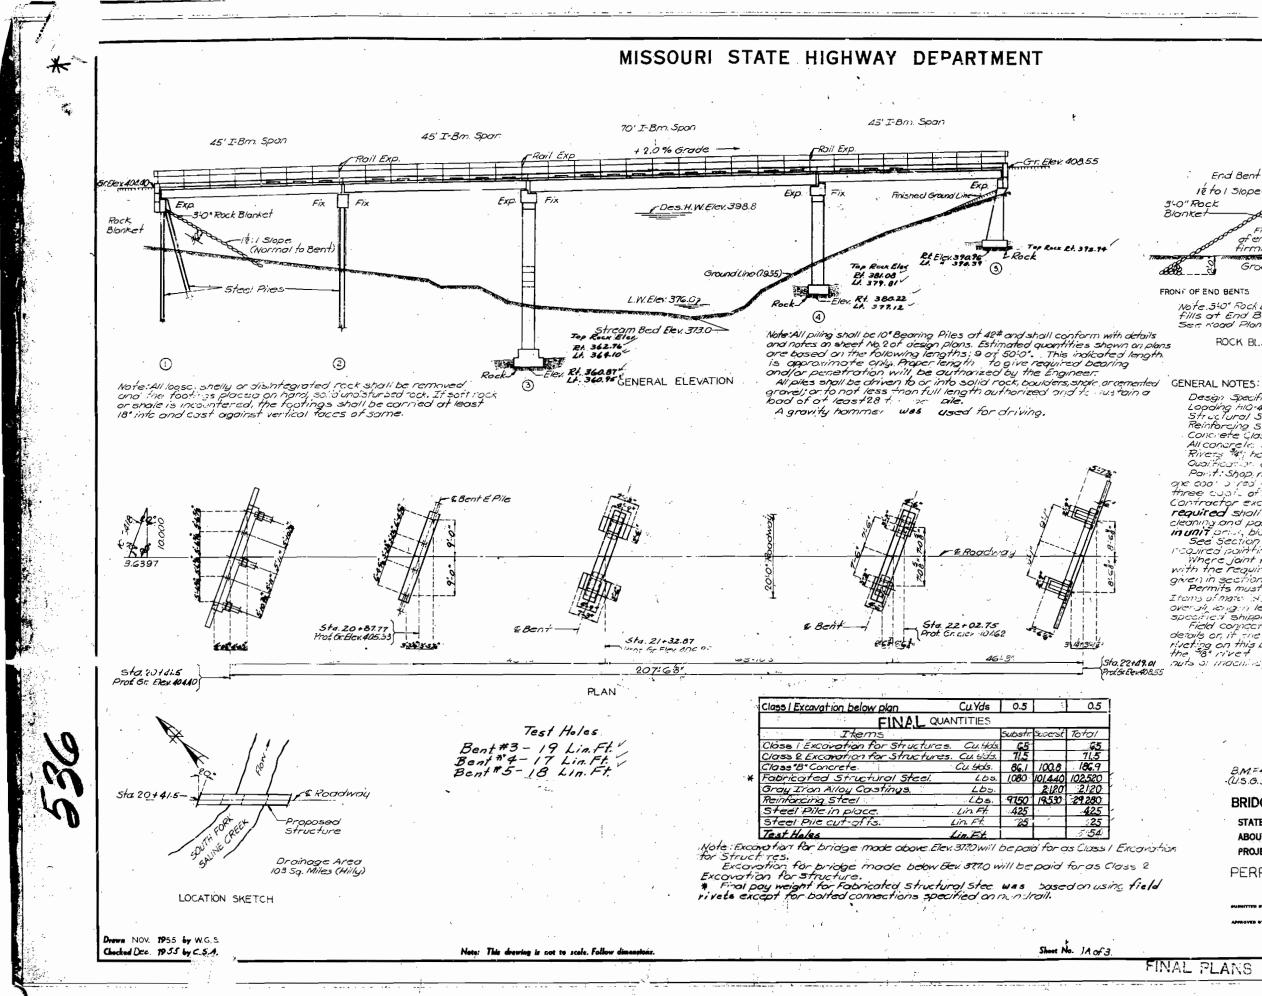



STATE FED. AN TOSCAL SHEET TOTAL PROL NO. YEAR NO. SHEETS FED, ROAD DIST. NO. NO. 5-15E1(1) 19 11 26 5 FINAL PLANS End Bent #1-12 to 1 Slope. H.W. Elev. **396.8**7 3'-0" Rock 12 tol Siope Blanket A 3'0' Rock Blanket Fili under and in front of end bent to be firmly tomped. Ground Line-Æ. 1 FRONT OF END BENTS SIDE SLOPE OF FILL Wolfe.540" Rock Blockert shall be placed on fills at End Bent No.1 as shown in sketches. See road Plans for Quantities. ROCK BLANKET SKETCHES Design Specifications A.A.S.H.O. (1953.). Looding 110-44. Structurol Steel Stress 18,000 #/2". Reinforcing Steel Stress 18,000 #/" Concrete Class" B" Stress 18,000 #/" All concrete: shall be Claus 8." Rivers "4", holes "error: into stallwhere rivets shalls "holes" Ousification of w suing operators will be required. Parit : Shop, none; Fielo, comoct surfaces of Latig/field american one cool 3 (25) into and suits, cs inaccessible after erection three costs of red investigates paint to be applied by Contractor except as noted for steel piles. Red kad required shall be furnished by Contractor. Payment for cleaning and pain in such surfaces will be incuded in unit price, bid for Fabric stress Structural steel See Section 22-9. Cof Standard Specific drins for required paint filler is specified on the plans it shall conform with the requirements for Premoulded Materia for Filler as given in section 59-22.D of Standard Specifications, Permits must be obtained for all truck loads over legal lengths. Items of mater is which connot be transported by truck with oversitieng in less than, 75-0" must be snaped by rock with one coo sires was and suit and inaccessibil offer erection specifical shipping point. Field connections shall be riveted except as noted in handral details on it the Contents of the Marco desires to eliniate all field rivering on this project, he may use machine boths except for the "8" rivet head boths specified for handroil Heads and nuts of machine Latis shall as American Standard Regular. B.M. # 4A. Elev. 405.14 Spike in root 30" W. Car 52 # Sty. 22+52 -(4.5.G.S. Daturn) BRIDGE OVER SOUTH FORK OF SALINE CREEK STATE ROAD FROM RTE, SNN AT STE, GENEVIEVE CO LINE EAST TO RTER ABOUT 10.0 MILES S. OF ST. MARYS (SW)STA. 20+41.5 PROJECT NO.S-1521(D) COUNTY PERRY 4 3 May a Tirllia DATE 12-16-1955 Justitton DATE 12-16-1955 TH. STDC: 10 R3 N-62 FINAL PLANS

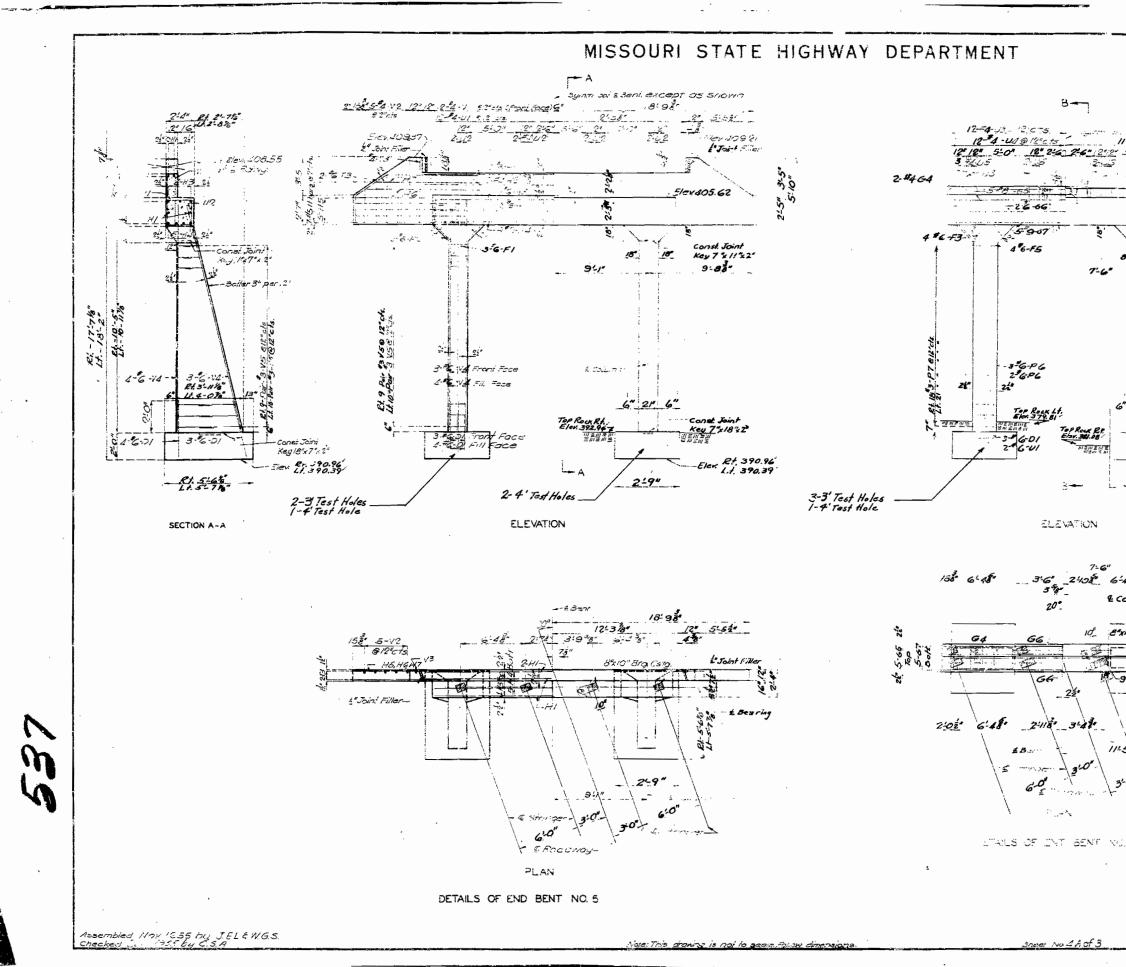

		FED. ROAD     STATE     FED. RID     FISLAL     SHEET     TOTAL       CIST. VO.     PROJ. NO.     YEAR     NO.     SHEET     SHEET       5     400     SHEET     SHEET     SHEET     SHEET	
		FINAL PLAN	S
	- 03 3. Cm.	<u>3=01</u> ig# /8#	
5" C" 5		Grade Elsy do 7.62 of ER	try
·	a der	21 566 21 · Q 22 66 · · · · · · · · · · · · · · · · ·	
	, E,Z	U1	
	Const Joint	211 567 224	
3-1/1	Key 9 × 9 × 2*	15	
É Colo	inta.		,
		3-26 42 - 13	
		26	1. 7
2-'3" 6"		23	
	: :onst joint : <ey9%28< td=""><td>301</td><td>•</td></ey9%28<>	301	•
	Elav, Rt. 380	.22	:
-3"			
		Test Hole ECTION 5-8	
		Test Hole	
5. 2 <sup>2</sup> /3	1-4	Test Hole	· · · · · · · · · · · · · · · · · · ·
- -	1-4	Test Hole	· · · · · · · · · · · · · · · · · · ·
	-4	Tast Hole SECTION 5-B	· · · · · · · · · · · · · · · · · · ·
"Brg Caty	1-4	Test Hole ECTION 5-8 TEST HOLES BENT No. 4	· · · · · · · · · · · · · · · · · · ·
	-4	Test Hole ECTION 5-8 TEST HOLES BENT No.4 Pr. FTG J.L.F. LT. FTG J.L.F.	
153 Gla	-4	Test Hole SECTION 5-8 TEST HOLES BENT No. 4 R.F.F.G J.L.F. ENT No. 5 BENT No. 5 R.F.F.G. J.L.F. L.T.F.G. J.L.F. L.T.F.G. J.L.F.	
18 g G 19	-4	Test Hole SECTION 5-8 TEST HOLES BENT NO. 4 RX FTG 7. L.F. LX.FTG 13. L.F. BENT NO. 5 RT.FTG 3. L.F.	
10 3 3 4 1 1 1 1 1 1 1 1 1 1 1 1 1 1 1 1 1	-4	Test Hole SECTION 5-8 TEST HOLES BENT No. 4 R.F.F.G J.L.F. ENT No. 5 BENT No. 5 R.F.F.G. J.L.F. L.T.F.G. J.L.F. L.T.F.G. J.L.F.	
15 3 G Cata	-4	Test Hole SECTION 5-8 TEST HOLES BENT No. 4 R.F.F.G J.L.F. ENT No. 5 BENT No. 5 R.F.F.G. S L.F. L.F.F.G. J.L.F. L.F.F.G. J.L.F.	· · · · · · · · · · · · · · · · · · ·
	J-4	Test Hole SECTION 5-8 Test Holes Bent No. 4 R.F. F.G J.L.F. BENT No. 5 R.F.F.G. J.L.F. LT.F.T.G. J.L.F. J.S.L.F. BENTS 4.4.	· · · · · · · · · · · · · · · · · · ·
10 3 3 4 1 1 1 1 1 1 1 1 1 1 1 1 1 1 1 1 1	I-4	TEST HOLES ECTION 5-B TEST HOLES BENT No.4 RT.FTG 7.L.F. BENT NO.5 RT.FTG, J.L.F. J.T.FTG, J.L.F. 352.F. BENTS 4.4 R. SOUTH FORK OF SALINE UREEK	the same
	IRIDGE UYE	TEST HOLES SECTION 5-B TEST HOLES BENT NO.4 RY. FTG ALF LT. FTG /3 L.F. BENT NO.5 RY. FTG, 3 L.F. BENT NO.5 RY. FTG, 3 L.F. BENT NO.5 RY. FTG, 3 L.F. BENTS 4.4 ST.F. BENTS 4.4 ST.	the same
	IRIDGE - YE	TEST HOLES SECTION 5-B TEST HOLES BENT NO.4 RY. FTG ALF LT. FTG /3 L.F. BENT NO.5 RY. FTG, 3 L.F. BENT NO.5 RY. FTG, 3 L.F. BENT NO.5 RY. FTG, 3 L.F. BENTS 4.4 ST.F. BENTS 4.4 ST.	the same
	IRIDGE UYE SIE KORD PRO JUDI J.O. 4-13 KOLEUT NO SHA	TEST HOLES SECTION 5-8 TEST HOLES BENT No. 4 RY, FTG ALF LT. FTG /3-L.F. BENT NO. 5 RT. FTG, J.L.F. BENT NO. 5 RT. FTG, J.L.F. BENTS & d.F. LT. FTG, J.L.F. BENTS & d.F. STL.F. BENTS & D	E. 61

الهيم ويعجب فالانتزار فكمالته والمطورة ومسمسه فالماعا الباري المحمد محمد

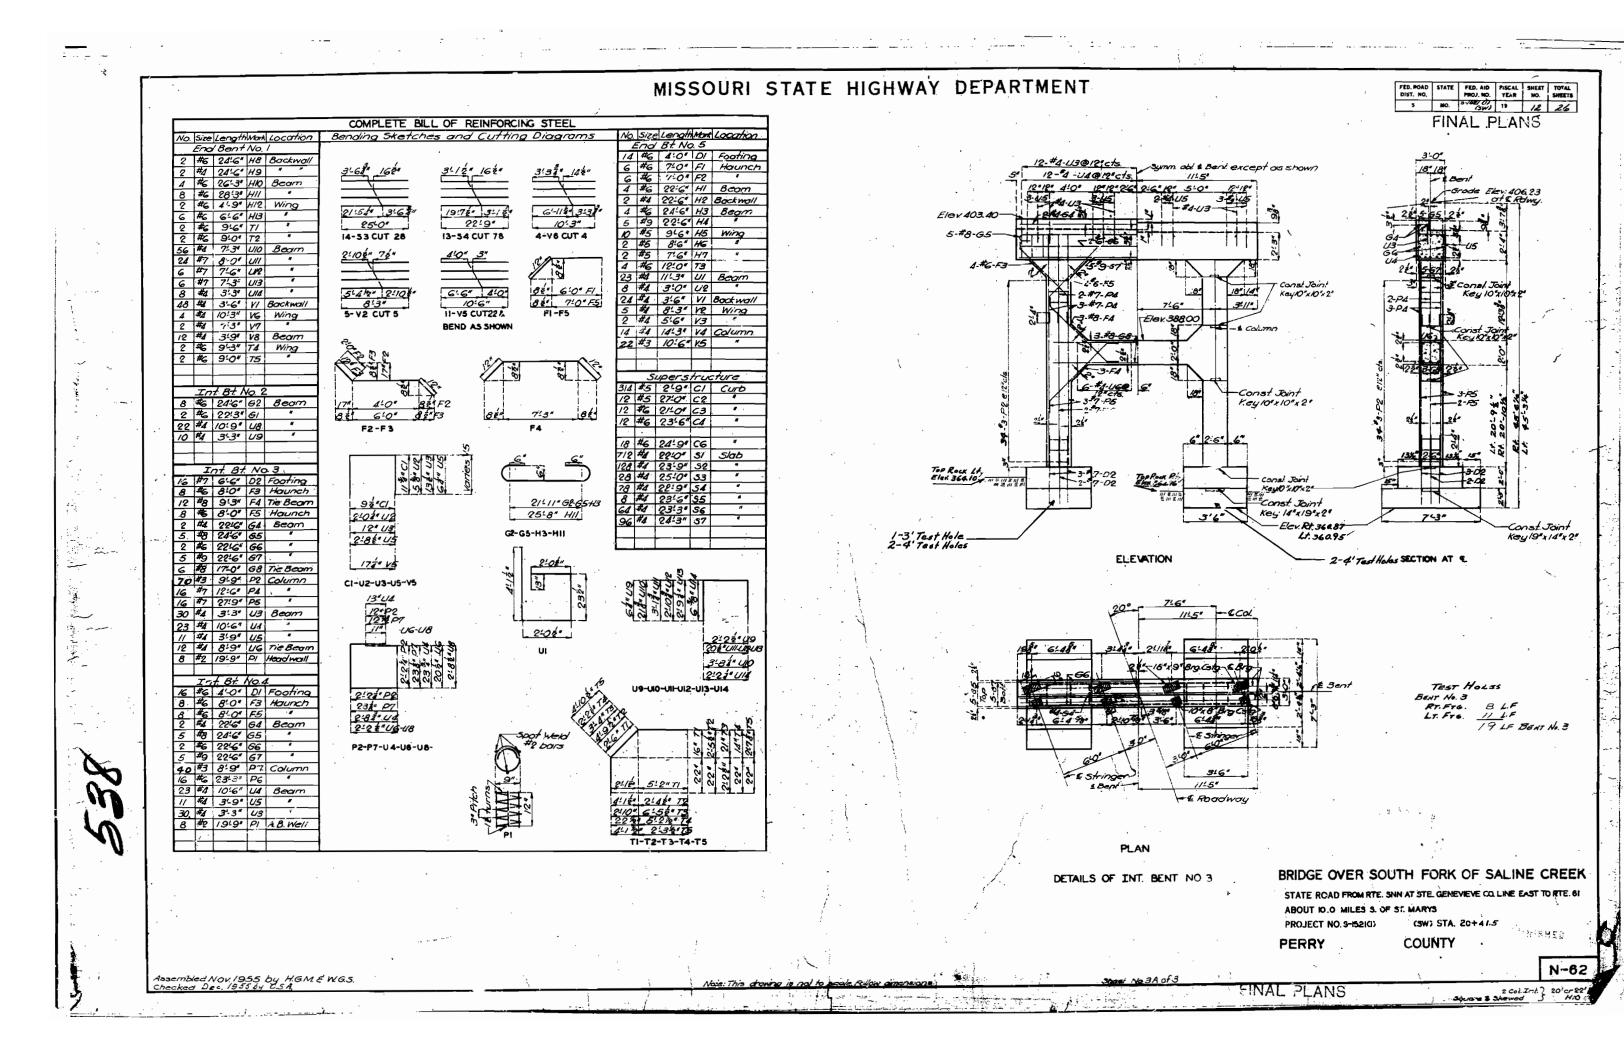

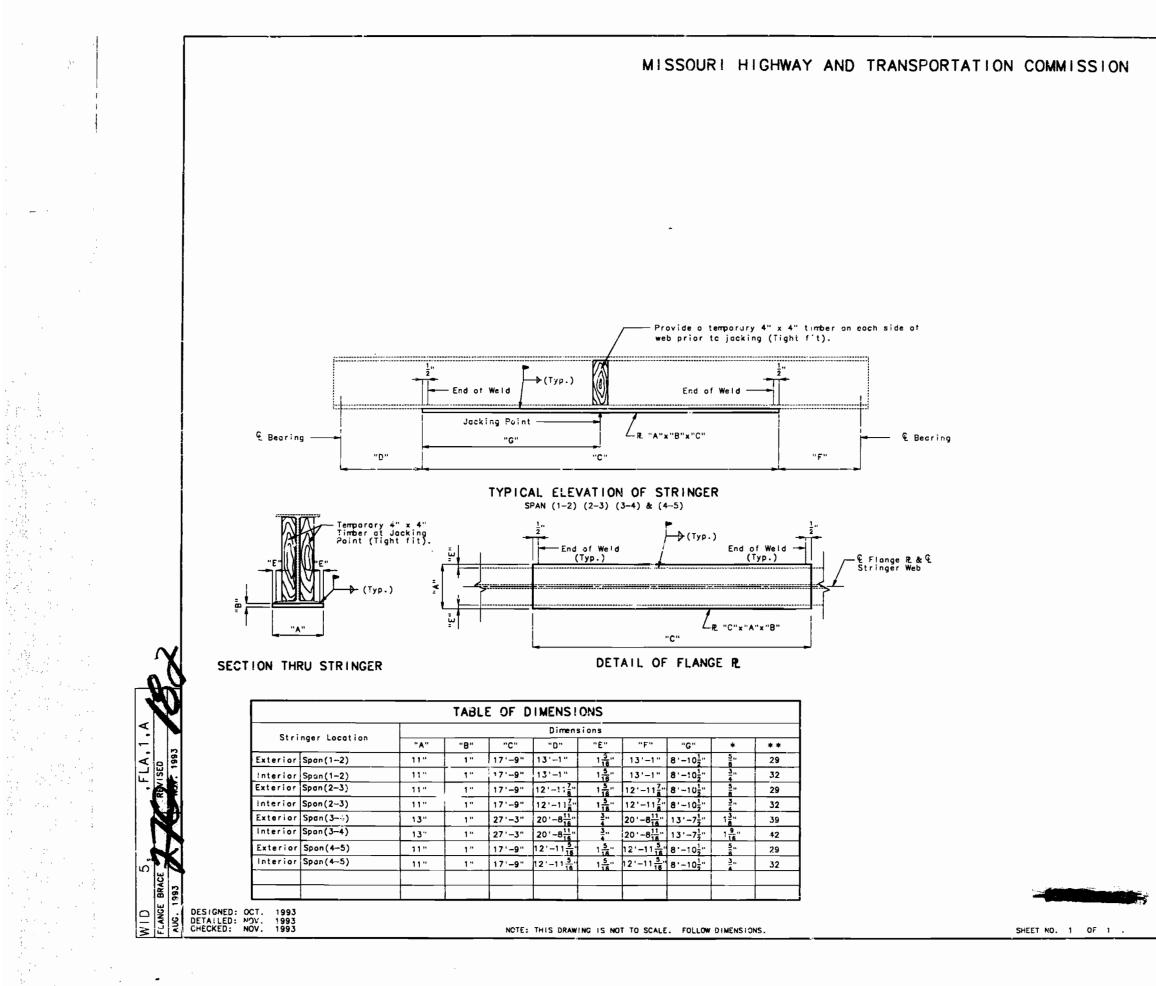

. .

STATE	PROJ. NO.		SHEET
MO. JC	50 <b>52</b> 7		4
SEC/SUR 3015	TWP 36N	RGE	10E

General Notes: Design Specifications: A.A.S.H.T.O. 1992 Design Looding. 1993 Missauri Posting Laads. (H20 & ™S2) No Future Wearing Surfoce Design Unit Stresses: Structural Carbon Steel fy=36,000 psi. (New Steel) Existing Steel fy=33,000 psi. Working stress Design based on 68% fy. (Exis\*.) Point: Calcium Su fonate (2 coats)(See Special Provisions). Oid and New Work: Cutline of old work is indicated by light dashed lines. Heavy lines indicate new work. Dimensions: Longitudinol dimensions are based on the arijinol design plans. Troffic: Maintoin one lane of traffic during construction, (See Roadway Traffic Control Plans). Stringer Support:

All existing stringers in the span being strengthened shall be roised simultaneously + at jacking point and supported during welding of new steel plates. The temporory supports must be capable of safely supporting a service load of approximately \*\* tons per stringer. (Factor of safety not included) (See Special Provisions).

ESTIMATED QUANTITIES							
I TEM		TOTAL					
Strengthaning Existing Stringers	Lump Sum	1					
· · · · · · · · · · · · · · · · · · ·							
-							

CREEK (SO.		
CO. LINE	RTE. 61 WEST TO ST	. GENEVIEVE
PROJECT NO. JOS	0527 STA. 20+40	
JOB NO. J050527	RTE. NN	STD.
PERRY	COUNTY	STD.
DATE	1/11/94	N00621

MoDOT	Γ			Department of T	-	
	COUNTY, DEDDY	DISTRICT: SE		Bridge Inspections STATBR	-	DDIDCE, NAA
	COUNTY: PERRY				FED-ID: 7415	BRIDGE: N000
ROUTE	RTNNE	***GENERAL STRUCTURE # SPANS: 4	<u>E INFORMATION</u>		CODE: 65360 SALINE	<b>DATE:</b> 10/01/
	SALINE CR	LANES ON: 2			<b>NGTH:</b> 208 FT 0 IN	FREQUENCY: 12
STATUS:	P-POSTLOAD	LANES UNDER: 0		MAXIMUM	<b>SPAN:</b> 69 FT 11 IN	TEAM LEADER: MELA
LOG MILE:		COMPASS DIRECTION: WES		APPROACH ROAI		<b>INSPECTOR 2:</b>
	16.00 MILES	<b>DIRECTION OF TRAFFIC:</b> 2-WA			CURB: 20 FT 0 IN	<b>INSPECTOR 3:</b>
NHS:		FUNCTIONAL CLASS: RL-N			<b>OUT:</b> 22 FT 4 IN	** When calculated interv
BUILT: REHAB:		NBI OWNER: MOI NBI MAINTAINED: MOI			AADT: 364 YEAR: 2023	G
	S 3015 T 36 R 10 E	MAINTENANCE DISTRICT: SE	DOT		RUCK: 14.6%	
	37 48 17.38 (DMS)	MAINTENANCE COUNTY: PER	RY		AADT: 510	
	90 0 13.51 (DMS)	SUBAREA: 7H30		FUTURE AADT		
		DITICAL INSDECTION INFORM	[ATION:***			***INIDEDTH INCOECT
DATE:		RITICAL INSPECTION INFORM nsibility:	LATION*** CATEGORY:		DATE:	***INDEPTH INSPECT RESPONSIBILITY:
DATE: FREQUENCY:			NBI:		FREQUENCY:	CALCULATED INTERVAL**:
TEAM LEADER:		SPECTOR 3:	METHOD:		TEAM LEADER:	INSPECTOR 3:
<b>INSPECTOR 2:</b>		SPECTOR 4:			<b>INSPECTOR 2:</b>	<b>INSPECTOR 4:</b>
** When calculated	interval exceeds the frequency, a just	stification comment per BIRM is required.			** When calculated interval exc	eeds the frequency, a justification comr
	FRACTURE	CRITICAL INSPECTION COMME	ENTS			INDEPTH INSPEC
	***SPECIAI	L INSPECTION INFORMATION	***			***UNDERWATER INSPE
DATE:			*** CATEGORY: QUALI	TY ASSURANCE	<b>DATE:</b> 10/01/202	
DATE: FREQUENCY:	01/24/2022 <b>RESPON</b>	NSIBILITY: BRIDGEDIV		TY ASSURANCE	DATE: 10/01/202 FREQUENCY: 60	
FREQUENCY: TEAM LEADER:	01/24/2022 RESPON 999 CALCULATED IN CHAD DANIEL INS	NSIBILITY: BRIDGEDIV	CATEGORY: QUALI		FREQUENCY: 60	24 <b>RESPONSIBILITY:</b>
FREQUENCY: TEAM LEADER: INSPECTOR 2:	01/24/2022 RESPON 999 CALCULATED IN CHAD DANIEL INS JESSE ELSEMAN INS	NSIBILITY: BRIDGEDIV TERVAL**: SPECTOR 3:	CATEGORY: QUALI NBI: NO		FREQUENCY: 60 TEAM LEADER: MELAN INSPECTOR 2:	24 <b>RESPONSIBILITY:</b> CALCULATED INTERVAL**: IE RICKARD-ELMOINSPECTOR 3:
FREQUENCY: TEAM LEADER: INSPECTOR 2:	01/24/2022RESPON999CALCULATED INCHAD DANIELINSJESSE ELSEMANINSinterval exceeds the frequency, a just	NSIBILITY: BRIDGEDIV TERVAL**: SPECTOR 3: SPECTOR 4:	CATEGORY: QUALI NBI: NO		FREQUENCY: 60 TEAM LEADER: MELAN INSPECTOR 2:	24 RESPONSIBILITY: CALCULATED INTERVAL**: IE RICKARD-ELMOINSPECTOR 3: INSPECTOR 4:
FREQUENCY: TEAM LEADER: INSPECTOR 2:	01/24/2022RESPON999CALCULATED INCHAD DANIELINSJESSE ELSEMANINSinterval exceeds the frequency, a just	NSIBILITY: BRIDGEDIV TERVAL**: SPECTOR 3: SPECTOR 4: stification comment per BIRM is required.	CATEGORY: QUALI NBI: NO		FREQUENCY: 60 TEAM LEADER: MELAN INSPECTOR 2:	24 <b>RESPONSIBILITY:</b> CALCULATED INTERVAL**: IE RICKARD-ELMOINSPECTOR 3: INSPECTOR 4: xceeds the frequency, a justification com
FREQUENCY: TEAM LEADER: INSPECTOR 2:	01/24/2022 RESPON 999 CALCULATED IN CHAD DANIEL INS JESSE ELSEMAN INS interval exceeds the frequency, a jus SPECI	NSIBILITY: BRIDGEDIV TERVAL**: SPECTOR 3: SPECTOR 4: stification comment per BIRM is required.	CATEGORY: QUALI NBI: NO		FREQUENCY: 60 TEAM LEADER: MELAN INSPECTOR 2:	24 <b>RESPONSIBILITY:</b> CALCULATED INTERVAL**: IE RICKARD-ELMOINSPECTOR 3: INSPECTOR 4: xceeds the frequency, a justification com
FREQUENCY: TEAM LEADER: INSPECTOR 2: ** When calculated i	01/24/2022 RESPON 999 CALCULATED IN CHAD DANIEL INS JESSE ELSEMAN INS Interval exceeds the frequency, a jus SPECI	NSIBILITY: BRIDGEDIV TERVAL**: SPECTOR 3: SPECTOR 4: stification comment per BIRM is required. <i>AL INSPECTION COMMENTS</i>	CATEGORY: QUALI NBI: NO METHOD: VISUA		FREQUENCY: 60 TEAM LEADER: MELAN INSPECTOR 2: ** When calculated interval ex	24 RESPONSIBILITY: CALCULATED INTERVAL**: IE RICKARD-ELMOINSPECTOR 3: INSPECTOR 4: a justification com UNDERWATER INSP OTHER UNDERWA
FREQUENCY: TEAM LEADER: INSPECTOR 2: ** When calculated i DATE FREQ	01/24/2022 RESPON 999 CALCULATED IN CHAD DANIEL INS JESSE ELSEMAN INS Interval exceeds the frequency, a jus SPECI UENCY CATEGORY 120 CHANNEL CROSS	NSIBILITY: BRIDGEDIV TERVAL**: SPECTOR 3: SPECTOR 4: stification comment per BIRM is required. MAL INSPECTION COMMENTS	CATEGORY: QUALI NBI: NO METHOD: VISUA	L	FREQUENCY: 60 TEAM LEADER: MELAN INSPECTOR 2: ** When calculated interval ex	24 RESPONSIBILITY: CALCULATED INTERVAL**: IE RICKARD-ELMOINSPECTOR 3: INSPECTOR 4: a justification com UNDERWATER INSP OTHER UNDERWA
FREQUENCY: TEAM LEADER: INSPECTOR 2: ** When calculated in bare frequency 06/18/2019	01/24/2022 RESPON 999 CALCULATED IN CHAD DANIEL INS JESSE ELSEMAN INS interval exceeds the frequency, a jus SPECI UENCY CATEGORY 120 CHANNEL CROSS SECTIONS	NSIBILITY: BRIDGEDIV     TERVAL**:     SPECTOR 3:     SPECTOR 4:     stification comment per BIRM is required.     VAL INSPECTION COMMENTS     ER SPECIAL INSPECTIONS     NBI   CALCULATED INTERVAL F     NO   70	CATEGORY: QUALI NBI: NO METHOD: VISUA	L 	FREQUENCY: 60 TEAM LEADER: MELAN INSPECTOR 2: ** When calculated interval ex	24 RESPONSIBILITY: CALCULATED INTERVAL**: IE RICKARD-ELMOINSPECTOR 3: INSPECTOR 4: a justification com UNDERWATER INSP OTHER UNDERWA
FREQUENCY: TEAM LEADER: INSPECTOR 2: ** When calculated in bare frequency 06/18/2019	01/24/2022 RESPON 999 CALCULATED IN CHAD DANIEL INS JESSE ELSEMAN INS Interval exceeds the frequency, a jus SPECI UENCY CATEGORY 120 CHANNEL CROSS	NSIBILITY: BRIDGEDIV     TERVAL**:     SPECTOR 3:     SPECTOR 4:     stification comment per BIRM is required.     VAL INSPECTION COMMENTS     ER SPECIAL INSPECTIONS     NBL   CALCULATED INTERVAL	CATEGORY: QUALI NBI: NO METHOD: VISUA	L 	FREQUENCY: 60 TEAM LEADER: MELAN INSPECTOR 2: ** When calculated interval ex	24 RESPONSIBILITY: CALCULATED INTERVAL**: IE RICKARD-ELMOINSPECTOR 3: INSPECTOR 4: a justification com UNDERWATER INSP OTHER UNDERWA

Page 1

November 22, 2024 9:43:14AM

)062

#### BRIDGE INSPECTION INFORMATION\*\*\* /01/2024 **RESPONSIBILITY:** DISTRICT CALCULATED INTERVAL\*\*: 12 ELANIE RICKARD-ELMO] ELEMENT: NO **INSPECTOR 4:**

erval exceeds the frequency, a justification comment per BIRM is required. GENERAL INSPECTION COMMENTS

# TION INFORMATION\*\*\*

#### CATEGORY: NBI: **METHOD:**

mment per BIRM is required.

ECTION COMMENTS

## PECTION INFORMATION\*\*\*

Y: DISTRICT \*\*: 12 3: 4:

CATEGORY: DRY NBI: NO METHOD: VISUAL

comment per BIRM is required.

**SPECTION COMMENTS** 

VATER INSPECTIONS ALCULATED INTERVAL RESPONSIBILITY

**METHOD** 

MODOT		Ν	/lissouri Departmen	t of Transportation		November 22, 2024 9:43:14AM
			State Bridge Ins	pection Report		2.13.11.111
COUNTY: PERRY	DISTRICT: SE		CLASS: STATBR	FED-ID: 741	5 BRIDGE: N0062	
			***STRU	CTURE POSTING***		
APPROVED CATEGORY: S-7	TRUCKS OVER 21 TONS 15 MF	PH ON BRIDGE.				
<b>Ton 1:</b> 21	<b>Ton 2:</b>		Ton 3:			
COMMENTS:						
FIELD CATEGORY: S-7	TRUCKS OVER 21 TONS 15 MF	H ON BRIDGE.				
Ton 1: 21 COMMENTS:	<b>Ton 2:</b>		Ton 3:	PROBLEM:	<b>PROBLEM DIRECTION:</b>	
COMMENTS:			***CENEDAL COMM	ENTEMA IOD DATED ITEM	1444	
GENERAL COMMENTS: (BOWDEJ1, 04/0	9/2008) (46' 45' 69' 46') SMP WE GDP 9			ENTS/MAJOR RATED ITEMS	<b>.</b>	
GENERAL COMMENTS. (BOWDEST, 04/0	5/2008)(+0 -+5 -07 -+0 ) SMI WI ODK S		THEN ALL OKDRS ON BR	(די		
[ITEM 58] DECK: 4 RATING : 1		COMMEN	FS: (DENNIB1, 10/17/2013)- (WILSOT2 10/18/2017)-	PATCHES & T-CRACKS MOD DELAMN THROUT		
KATING: 1	0/09/2019			MEDIUM SATURATION THROUGH	IOUT	
[ITEM 59] SUPER: 5		COMMEN		GIRDERS STRENGTHENED		
RATING: 0	)2/01/2022		(STEGEC, 02/01/2022)	RUSTING THRU OUT WITH MED SE	CT LOSS TO TOP FLANGES OF EXT GIRDERS	
[ITEM 60] SUB: 4	-POOR CONDITION	COMMEN	<b>FS:</b> (WILSOT2, 10/18/2017)-	INT SEC LOSS TOP FLANGE		
RATING: 1	0/27/2022			LARGE SPALL ON BENT 4 SOUTH		
		COMMENT		ADVANCED SECT LOSS ON CENTER		
RATING : 0	-WIDESPREAD MINOR DAMAGE	COMMEN	18: (STEGEC, 02/01/2022)	CHANNEL DEEPENING WITH MINC	R LOCAL SCOUR AT BENT 3	
	-STABLE FOR CALCULATED	COMMEN	<b>FS:</b> (WILSOT2, 10/18/2017)-	STABLE		
RATING : 0 EVALUATION TYPE :	15/18/2001					
ITEM 71] WATERWAY ADEQUACY: I		COMMEN	FQ.			
RATING: 0		COMMEN	15:			
[ITEM 72] APPRRDWY ALIGNMENT: 5		COMMEN	<b>FS:</b> (ELSEMJ, 01/23/2012)	UNEVEN @ ABUT 5		
RATING: 0	01/23/2012					
		***RAILING	G AND APPROACH PA	WEMENT COMPONENTS AN	D RATINGS***	
[ITEM 36A] BRIDGE RAILING RATI!	NG: DOESNT MEET CURRNT STND-0		<b>RATING:</b> 02/23/2004	COMMENTS:		
MATERIAL	CONSTRUCTION	<b>DIRECTION</b>	<u>COMMENTS</u>			
REINFORCED CONCRETE	CURB	BOTH				
STEEL	ANGLE-DOUBLE	BOTH				
[ITEM 36B] TRANSITION RAILING RATI	NG: NOT PROVIDED-0		<b>RATING:</b> 05/18/2001	COMMENTS:		
[ITEM 36C] APPROACH RAILING RATI	NG: NOT PROVIDED-0		<b>RATING:</b> 05/18/2001	COMMENTS:		
[ITEM 36D] RAIL END TREATMENT RATI!	NG: NOT PROVIDED-0		<b>RATING:</b> 05/18/2001	COMMENTS:		
Design_No = N0062						
This report contains information that	is protected from disclosure by federal law 22 USC	Section 400 and the	Missouri Open Records Law (Sunchi	Page 2 ne Act) Section 610.021 RSMo. Please review M	DOT's policy and procedure manual on the Sunshine Act before re-	easing any of the information contained herein

MODOT			Missouri Departmer State Bridge Ins	-	-			
COUN	NTY: PERRY	<b>DISTRICT: SE</b>	CLASS: STATBR	1	FED-ID	): 7415	BRII	)GE: N006
APPROAC	CH PAVEMENT: *Overall c	ondition assigned for each approach pavo	emenet component is shown below.					
<u>MATERIAL</u> ASPHALT		STRUCTIONDIRECTIOMINOUS MATBOTH	<u>CONDITION*</u> POOR	<u>COMMENT</u>	<u>TS</u>			
		***DRAINAGE, EX	XPANSION DEVICES, BAN	K/SLOPE, A	ND DECK PH	ROTECTIVE	COMPONEN	TS***
<u>DECK PROTECTIVE COMPO</u> SERIES TYPE-#	<u>NENTS:</u> <u>COMPONENT</u>	<u>MATERIAL</u>	<u>CONSTRUCTION CONSTRUCTION CONSTRUCTURE CONS</u>	ON	<u>THICKNESS</u>	<u>YEAR APPLIE</u>	<u>D</u> <u>MANUFAC</u>	TIIRE
<u>SERIES I II E-#</u> MAIN SERIES-1	WEARING SURFACE	ASPHALT	BITUMINOUS SEAL		.4 IN	<u>2012</u>	<u>D</u> <u>MANUTAC</u>	IUNL
<u>COMMENT:</u>								
	DECK PROTECTION	NOTAPPLICABLE	NONE					
<u>COMMENT:</u>								
			NONE					
	MEMBRANE	NOTAPPLICABLE	NONE					
<u>COMMENT:</u>								
DRAINAGE COMPONENTS:								
	<u>COMPONENT</u>	<u>MATERIAL</u>	<u>CONSTRUCTION CONSTRUCTION CONSTRUCTUON CONS</u>	ON	<b>DIRECTION</b>	<u>COMMEN</u>	TS	
	DRAINAGE	REINFORCED CONCRE						
EXPANSION DEVICE COMPO SUB UNIT-# SUB		PONENT MA	<u>ATERIAL</u>	CONSTRUCTIO	N	<u>GAP</u> Y	EAR APPLIED	<u>MANUFA</u>
		<u></u>	<u></u>		<u></u>	<u> </u>		
<u>COMMENT:</u>								
BANK/SLOPE PROTECTION	<u>COMPONENTS:</u>							
	<u>COMPONENT</u>	<u>MATERIAL</u>	<u>CONSTRUCTIO</u>	<u>ON</u>	DIRECTION	<u>COMMEN</u>	<u>TS</u>	
	BANK PROTECTION	ROCK	BLANKET		ВОТН			
			***DECI	K COMPON	ENTS***			
SPAN TYPE-#	<u>COMPONENT</u>	<u>MATERIAL</u>	<u>CONSTRUCTION CONSTRUCTION CONSTRUCTUON CONS</u>	ON C	COMMENTS			
MAIN SPANS-1	DECK	REINFORCED CONCRE						
<u>COND</u>		<u>LOCATION 1</u>	LOCATION 2	<u>SEVERITY</u>	<u>MEASURE</u>	E <u>MENT</u> <u>COM</u>	<u>MENT</u>	
	DRATION	EDGE		HEAVY				
	ESCENCE TH PATCHES	THROUGHOUT THROUGHOUT		MODERATE FEW				
	NAL CRACKS	THROUGHOUT		MINOR				
	RACKS	THROUGHOUT		FINE				
REBAR E	EXPOSED	THROUGHOUT		MODERATE				
	RATION	THROUGHOUT		MODERATE	30 %	, D		
	LLS SE CRACKS	RANDOM THROUGHOUT		MEDIUM MANY				
I KANG V LK				1417 71 41 4				
MAIN SPANS-2	DECK	REINFORCED CONCRE	TE CAST-IN-PLAC	$\gamma_F$				
MAIN SFANS-2 COND		LOCATION 1	LOCATION 2	SEVERITY	MEASURE	EMENT COM	MENT	
	INATION	THROUGHOUT		MINOR	<u></u>			
Design_No = N0062								
8				Page 3				

Page 3 This report contains information that is protected from disclosure by federal law, 23 USC Section 409 and the Missouri Open Records Law (Sunshine Act), Section 610.021 RSMo. Please review MoDOT's policy and procedure manual on the Sunshine Act before releasing any of the information contained herein.

0062

### OVERALL CONDITION POOR

FAIR

FACTURE

**OVERALL CONDITION** 

10DOT				i Department of Trans e Bridge Inspection R	-	
COUNTY: Pl	ERRY	<b>DISTRICT: SI</b>		SS: STATBR	FED-ID: 7415	BRIDGE: N000
DETERIORATION EFFLORESCENCE MAP CRACKS REBAR EXPOSEE SATURATION SPALLS TRANSVERSE CRAC	Е ТН ТН О ТН	EDGE ROUGHOUT ROUGHOUT ROUGHOUT RANDOM RANDOM ROUGHOUT		SEVERE MINOR MANY MINOR MINOR MEDIUM MEDIUM	50 %	
MAIN SPANS-3 <u>CONDITION</u>	DECK <u>L</u> (	REINFORCED <u>CATION 1</u>	CONCRETE <u>LOCATION 2</u>	CAST-IN-PLACE <u>SEVERITY</u>	<u>MEASUREMENT</u>	<u>COMMENT</u>
DELAMINATION DETERIORATION EFFLORESCENCH REBAR EXPOSED SATURATION SPALLS TRANSVERSE CRAC	NETH DTH TH	RANDOM EDGE ROUGHOUT ROUGHOUT ROUGHOUT RANDOM ROUGHOUT		MINOR HEAVY MINOR MANY MINOR MEDIUM MANY	20 %	
MAIN SPANS-4	DECK	REINFORCED		CAST-IN-PLACE		
<u>CONDITION</u> DELAMINATION DETERIORATION EFFLORESCENCH REBAR EXPOSED SATURATION SPALLS TRANSVERSE CRAC	TH	ANDOM EDGE ANDOM EDGE ROUGHOUT ANDOM ROUGHOUT	<u>LOCATION 2</u>	2 <u>SEVERITY</u> MINOR MODERATE MINOR MANY MINOR MEDIUM MEDIUM		<u>COMMENT</u> (BLALOR1, 03/13/2014)& SPALLS ((
			***	SUPERSTRUCTURE CO	OMPONENTS***	
<u>SERIES TYPE-#</u> MAIN SERIES-1	<u>SPAN TYPE</u> SIMPLE SPAN	<u>MATEI</u> STEI	RIAL	CONSTRUCTION DE FLANGE GIRDERS	LABEL	<u>COMMENTS</u> (STEGEC, 05/03/2004)DECK BOLT (BLALOR1, 03/13/2014)MED DLD
MAIN SPANS-1		<u>R</u> <u>LENGTH</u> 46 FT 3 IN <u>CATION 1</u> ROUGHOUT	<u>WEATHERING STEEL</u> NO <u>LOCATION 2</u>	<u>Comments</u> 2 <u>Severity</u> Moderate	<u>MEASUREMENT</u>	(BLALOR1, 03/13/2014)& HEAV
<u>CONDITION</u> DECK LIFTING PACK RUST RUSTING SECTION LOSS	THI BOT	ROUGHOUT 'OM FLANGE P FLANGE		MINOR MINOR INITIAL		
DECK LIFTING PACK RUST RUSTING SECTION LOSS MAIN SPANS-2 <u>CONDITION</u> DECK LIFTING	THI BOT TC NON-COMPOSITE <u>L(</u> THI	ROUGHOUT OM FLANGE P FLANGE 45 FT 1 IN <u>PCATION 1</u> ROUGHOUT	NO <u>LOCATION 2</u>	MINOR MINOR INITIAL (BLALOR1, 03/13/2014)ME <u>SEVERITY</u> MODERATE	<u>MEASUREMENT</u>	<u>COMMENT</u>
DECK LIFTING PACK RUST RUSTING SECTION LOSS MAIN SPANS-2 <u>CONDITION</u> DECK LIFTING OTHER OTHER PACK RUST	THI BOT TC NON-COMPOSITE <u>LC</u> THI A C A	ROUGHOUT OM FLANGE P FLANGE 45 FT 1 IN CATION 1 ROUGHOUT T JOINTS GIRDERS T JOINTS		MINOR MINOR INITIAL (BLALOR1, 03/13/2014)ME SEVERITY MODERATE NOT APPLICAE NOT APPLICAE MODERATE	MEASUREMENT BLE BLE	<u>COMMENT</u> (BLALOR1, 03/13/2014)GDRS 2
DECK LIFTING PACK RUST RUSTING SECTION LOSS MAIN SPANS-2 <u>CONDITION</u> DECK LIFTING OTHER OTHER	THI BOT TC NON-COMPOSITE <u>LC</u> THI A BOT	ROUGHOUT OM FLANGE P FLANGE 45 FT 1 IN <u>OCATION 1</u> ROUGHOUT T JOINTS GIRDERS		MINOR MINOR INITIAL (BLALOR1, 03/13/2014)ME <u>SEVERITY</u> MODERATE NOT APPLICAE NOT APPLICAE	<u>MEASUREMENT</u> BLE BLE	

Page 4 This report contains information that is protected from disclosure by federal law, 23 USC Section 409 and the Missouri Open Records Law (Sunshine Act), Section 610.021 RSMo. Please review MoDOT's policy and procedure manual on the Sunshine Act before releasing any of the information contained herein.

#### November 22, 2024 9:43:14AM

# 0062

(@ JOINT AREA @ ABUT 4)

OLTED DOWN IN 4-2004 LD

AVY @ JNTS @ BT 2

S 2 & 3: MED SMOKE DAMAGE @ ABUT 1

AREAS

MODOT				Missouri Dej	L	-				
				State Br	idge Inspe	ction Repor	·t			
	NTY: PERRY	DIS	TRICT: SE	CLASS: S	TATBR		FED-II	<b>):</b> 7415		BRIDGE: N00
<u>COND</u> DECK L		<u>LOCATION</u> THROUGHO		LOCATION 2		<i>EVERITY</i> ODERATE	<u>MEASURI</u>	E <u>MENT</u>	COMMEN (BLALOR	N <u>T</u> 1, 03/13/2014)@ JNT A
OTH PACK		AT JOINTS AT JOINTS				APPLICABLE MEDIUM			(BLALOR	1, 03/13/2014)ALL GII
RUST RUST	TING	BOTTOM FLAT TOP FLANG	Έ			MINOR MINOR				3, 10/27/2015)EXTERI
SECTIO	N LOSS	TOP FLANG	ΈE		ľ	MEDIUM			(BLALOR	1, 03/13/2014)OUTSIE
MAIN SPANS- <u>COND</u> DECK L OTH	I <u>TION</u> IFTING	APOSITE 46 <u>LOCATION</u> AT JOINTS AT JOINTS	5	NO (BL LOCATION 2	<u>S</u> M	'2014)MED DL <u>EVERITY</u> ODERATE APPLICABLE	.D <u>MEASURI</u>	E <u>MENT</u>	<u>COMMEN</u>	<u>NT</u>
PACK PACK PACK SECTIO	RUST RUST RUST	AT JOINTS AT JOINTS DIAPHRAGM GIRDERS TOP FLANG	AS		ת ת	MEDIUM MINOR MEDIUM INITIAL			·	.1, 03/13/2014)& SECT .1, 03/13/2014)@ JOIN
				*** <b>S</b> U	RSTRUCTI	RE COMPO	NENTS**	:*		
SUBSTRUCTURE	<u>SKEW</u>	<u>LENGTH</u>	MATERIAL	CONSTRUC			COMMENT			
ABUTMENT-1	LA-20 DEGREES		NFORCED CONCRETE					_		
	<u>CONDITION</u>		LOCATION 1		<u>TION 2</u>	<u>SEV</u>	<u>ERITY</u>	<u>MEASU</u>	<u>REMENT</u>	<u>COMMENT</u>
	<u>D COMPONENT</u>	<u>MATERIAI</u>			<u>RUCTION</u>					
BACKWALL			CED CONCRETE		N-PLACE	6.51				
	<u>CONDITION</u>		LOCATION 1	LOCA	<u>TION 2</u>		<u>ERITY</u>	<u>MEASU</u>	<u>REMENT</u>	<u>COMMENT</u>
	DELAMINATION HORIZONTAL CRACI		HROUGHOUT				NOR EW			
	SHOVING		'HROUGHOUT 'HROUGHOUT				EW DERATE			
BEAM CAP	5110 ¥ 1100		CED CONCRETE	CAST-II	N-PLACE	MOL	LIKAL			
DEALM OF H	CONDITION		LOCATION 1		TION 2	SEV	ERITY	MEASU	REMENT	COMMENT
	DELAMINATION		HROUGHOUT				NOR			
	EROSION		GROUND LINE				XPOSED			
	REBAR EXPOSED	Т	HROUGHOUT			MI	NOR			
	SEALED		BEAM CAP			ASPHA	LTICBASE			
	SPALLS		HROUGHOUT			MI	NOR			
PILING		STEEL		H-SHAP						
	<u>CONDITION</u>		LOCATION 1	<u>LOCA</u>	<u>TION 2</u>		<u>ERITY</u>	<u>MEASU</u>	<u>REMENT</u>	<u>COMMENT</u>
	EXPOSED		TERIOR PILING			PAI	RTIAL			(STEGEC, 02/01/2022)
STRAIGHT	CONDITION		CED CONCRETE		N-PLACE	CEIZ	EDITV	MEACH	DEMENT	COMMENT
	<u>UNDERMINING</u>		<u>LOCATION 1</u> THROUGHOUT	LUCA	<u>TION 2</u>		<u>ERITY</u>	MEASU	<u>REMENT</u>	
FIXED BEAI		STEEL	ΠΚΟυθΠΟυΙ	CURVE	D PLATE(ROT		NOR			(ROBINC3, 11/30/2018
	CONDITION		LOCATION 1		TION 2	*	<u>ERITY</u>	MEASU	REMENT	COMMENT
	RUSTING		HROUGHOUT				INOR			
BENT-2	LA-20 DEGREES	22 FT 8 IN REL	NFORCED CONCRETE			651				
100001 100	<u>CONDITION</u>	<b>አ<i>ለ አጣ</i>ርም እንደ 41</b>	<u>LOCATION 1</u>		<u>TION 2</u> Buction	<u>SEV</u>	<u>ERITY</u>	<u>MEASU</u>	<u>REMENT</u>	<u>COMMENT</u>
<u>ASSOCIATE</u> BEAM CAP	<u>D COMPONENT</u>	<u>MATERIAI</u> DEINEODO			<u>RUCTION</u>					
DEAM CAP	<u>CONDITION</u>		CED CONCRETE <u>LOCATION 1</u>		N-PLACE <i>TION 2</i>	<b>CF</b> I/	<u>ERITY</u>	MFACU	<u>REMENT</u>	<u>COMMENT</u>
	DELAMINATION		<u>THROUGHOUT</u>	LUCA	11011 4		DERATE	MLASU		<u>COMMENT</u>
	HORIZONTAL CRACI		RANDOM				INE			
						Г	11 N L/			

Page 5

This report contains information that is protected from disclosure by federal law, 23 USC Section 409 and the Missouri Open Records Law (Sunshine Act), Section 610.021 RSMo. Please review MoDOT's policy and procedure manual on the Sunshine Act before releasing any of the information contained herein.

#### November 22, 2024 9:43:14AM

# 0062

Γ AREAS

GIRDERS

RIOR GIRDERS SIDE GIRDERS

CTION LOSS @ BT 4 INT AREA BT 4

#### 22)--CENTER PILE EXPOSED BEHIND STACKED LOOSE ROCK

018)--SW WING

DOT			Missouri Department of Tra State Bridge Inspection	-		
	JNTY: PERRY	DISTRICT: SE	CLASS: STATBR	FED-ID	): 7415	BRIDGE: N00
	SEALED	BEAM CAP		ASPHALTICBASE		
	SPALLS	THROUGHOUT		MINOR		
PILING		STEEL	H-SHAPE			
	<u>CONDITION</u>	LOCATION 1	LOCATION 2	<u>SEVERITY</u>	<u>MEASUREMENT</u>	<u>COMMENT</u>
	RUSTING	RANDOM		SEVERE		(BLALOR1, 03/13/2014
	SECTION LOSS	AT BEAM CAP		ADVANCED		(STEGEC, 02/01/2022)
CROSS BR		STEEL	ANGLE	CEVEDITY	MEACUDEMENT	COMMENT
EIVED DE	<u>CONDITION</u>	<u>LOCATION 1</u>	LOCATION 2	<u>SEVERITY</u>	<u>MEASUREMENT</u>	<u>COMMENT</u>
FIXED BEA	AKING <u>CONDITION</u>	STEEL <u>LOCATION 1</u>	CURVED PLATE(ROTATING) LOCATION 2	<i><b>SEI/EDITV</b></i>	MEACUDEMENT	<u>COMMENT</u>
			LOCATION 2	<u>SEVERITY</u>	<u>MEASUREMENT</u>	COMMENT
	PACK RUST	RANDOM		MINOR		
BENT-3	LA-20 DEGREES 22 I	FT 10 IN REINFORCED CONCRETE	MULTIPLE COLUMN			
	<u>CONDITION</u>	LOCATION 1	LOCATION 2	<u>SEVERITY</u>	<u>MEASUREMENT</u>	<u>COMMENT</u>
	<u>ED COMPONENT</u>	<u>MATERIAL</u>	<u>CONSTRUCTION</u>			
BEAM CA		REINFORCED CONCRETE	CAST-IN-PLACE			
	<u>CONDITION</u>	LOCATION 1	LOCATION 2	<u>SEVERITY</u>	<u>MEASUREMENT</u>	<u>COMMENT</u>
	DELAMINATION	THROUGHOUT		MODERATE		
	EFFLORESCENCE	THROUGHOUT		MINOR		
	HORIZONTAL CRACKS	RANDOM		MANY		
	REBAR EXPOSED	THROUGHOUT		MINOR		
	SCALING SEALED	THROUGHOUT BEAM CAP		HEAVY ASPHALTICBASE		
	SPALLS	THROUGHOUT		MINOR		
COLUMN	STALLS	REINFORCED CONCRETE	CAST-IN-PLACE	MINOK		
COLONIA	<b>CONDITION</b>	LOCATION 1	LOCATION 2	<u>SEVERITY</u>	MEASUREMENT	COMMENT
	DELAMINATION	THROUGHOUT	<u></u>	MODERATE		
	REBAR EXPOSED	THROUGHOUT		MINOR		
	SCALING	RANDOM		MINOR		
	VERTICAL CRACKS	RANDOM		MINOR		
FOOTING		REINFORCED CONCRETE	SPREAD			
	<u>CONDITION</u>	LOCATION 1	LOCATION 2	<u>SEVERITY</u>	<u>MEASUREMENT</u>	<u>COMMENT</u>
TIE BEAM		REINFORCED CONCRETE	CAST-IN-PLACE			
	<u>CONDITION</u>	LOCATION 1	LOCATION 2	<u>SEVERITY</u>	<u>MEASUREMENT</u>	<u>COMMENT</u>
FIXED BEA		STEEL	CURVED PLATE(ROTATING)			
	<u>CONDITION</u>	<u>LOCATION 1</u>	<u>LOCATION 2</u>	<u>SEVERITY</u>	<u>MEASUREMENT</u>	<u>COMMENT</u>
	PACK RUST	RANDOM		MINOR		
BENT-4	LA-20 DEGREES 22 I	FT 10 IN REINFORCED CONCRETE	MULTIPLE COLUMN			
	CONDITION	LOCATION 1	LOCATION 2	<u>SEVERITY</u>	MEASUREMENT	COMMENT
	HORIZONTAL CRACKS	RANDOM		MINOR		
	VERTICAL CRACKS	RANDOM		MINOR		
<u>ASSOCIAT</u>	<u>ED COMPONENT</u>	<u>MATERIAL</u>	<u>CONSTRUCTION</u>			
BEAM CA		REINFORCED CONCRETE	CAST-IN-PLACE			
	<u>CONDITION</u>	LOCATION 1	LOCATION 2	<u>SEVERITY</u>	<u>MEASUREMENT</u>	<u>COMMENT</u>
	DELAMINATION	THROUGHOUT		MEDIUM		
	HAIR LINE CRACKING	AT BEAM CAP		FEW		(BLALOR1, 03/13/2014
	OTHER	BEAM CAP		NOT APPLICABLE		(ROBINC3, 11/17/2015
	SEALED	BEAM CAP		ASPHALTICBASE		
00113.01	SPALLS	RANDOM		MINOR		
COLUMN	CONDITION	REINFORCED CONCRETE LOCATION 1	CAST-IN-PLACE <i>LOCATION 2</i>	<u>SEVERITY</u>	MEASUREMENT	COMMENT
					ылы л SI (КН М/Н /\/Н'/\/'Г'	

Design\_No = N0062

Page 6 This report contains information that is protected from disclosure by federal law, 23 USC Section 409 and the Missouri Open Records Law (Sunshine Act), Section 610.021 RSMo. Please review MoDOT's policy and procedure manual on the Sunshine Act before releasing any of the information contained herein.

November 22, 2024 9:43:14AM

0062

#### 2014)--ON H PILE & CROSS BRACING 22)--WITH SMALL HOLES RUSTED THRU

2014)--TOP & BOTTOM OF FACE CAP 015)--MINOR LONG CRACKS ON BOTTOM OF BEAM CAPS

			Missouri Department of Tra	-				
			State Bridge Inspection Report					
COUN	TY: PERRY	DISTRICT: SE	CLASS: STATBR	FED-II	<b>D:</b> 7415	BRIDGE: N00		
	DELAMINATION	THROUGHOUT		LARGE		(BLALOR1, 03/13/2014		
	REBAR EXPOSED	COLUMN		MODERATE		(ROBINC3, 11/30/2018		
	SPALLS	THROUGHOUT		SEVERE				
	VERTICAL CRACKS			LARGE		(BLALOR1, 03/13/2014		
FOOTING	<u>CONDITION</u>	REINFORCED CONCRETE <u>LOCATION 1</u>	SPREAD <u>LOCATION 2</u>	<u>SEVERITY</u>	<u>MEASUREMENT</u>	<u>COMMENT</u>		
FIXED BEARI		STEEL	CURVED PLATE(ROTATING	<u>SLV LKITT</u>	MLASUKLMLNI	COMMENT		
FIAED DEARI	<u>CONDITION</u>	LOCATION 1	LOCATION 2	<u>SEVERITY</u>	<u>MEASUREMENT</u>	<u>COMMENT</u>		
	PACK RUST	RANDOM		MEDIUM		(BLALOR1, 03/13/2014		
ADITMENT 5	I A DA DECDEES	A ET 9 IN DEINEODCED CONCRETE	OPEN CONCRETE					
ABUTMENT-5	LA-20 DEGREES CONDITION	24 FT 8 IN REINFORCED CONCRETE LOCATION 1	LOCATION 2	SEVERITY	MEASUREMENT	COMMENT		
ASSOCIATED	<u>COMPONENT</u>	MATERIAL	CONSTRUCTION	<u>SLV LKITT</u>	MLASUKEMENT	COMMENT		
BACKWALL	COMICIVEIVI	REINFORCED CONCRETE	CAST-IN-PLACE					
Diferentee	<u>CONDITION</u>	LOCATION 1	LOCATION 2	<u>SEVERITY</u>	MEASUREMENT	COMMENT		
	SHOVING	THROUGHOUT	<u></u>	MINOR		<u></u>		
BEAM CAP	SHOTHO	REINFORCED CONCRETE	CAST-IN-PLACE					
	<u>CONDITION</u>	LOCATION 1	LOCATION 2	SEVERITY	MEASUREMENT	COMMENT		
	DELAMINATION	RANDOM		MODERATE				
Н	ORIZONTAL CRACK	KS RANDOM		FINE				
	SEALED	BEAM CAP		ASPHALTICBASE				
	SPALLS	RANDOM		MINOR		(ROBINC3, 10/27/2015		
STRAIGHT W		REINFORCED CONCRETE	CAST-IN-PLACE					
	<u>CONDITION</u>	<u>LOCATION 1</u>	LOCATION 2	<u>SEVERITY</u>	<u>MEASUREMENT</u>	<u>COMMENT</u>		
COLUMN	<i></i>	REINFORCED CONCRETE	CAST-IN-PLACE	~~··~~				
	<u>CONDITION</u>	LOCATION 1	LOCATION 2	<u>SEVERITY</u>	<u>MEASUREMENT</u>	<u>COMMENT</u>		
FOOTING	CONDITION	REINFORCED CONCRETE	SPREAD	<u>CEL/EDI/EV</u>		COMMENT		
	<u>CONDITION</u>	LOCATION 1	LOCATION 2	<u>SEVERITY</u>	<u>MEASUREMENT</u>	<u>COMMENT</u>		
FIXED BEARI		STEEL <i>LOCATION 1</i>	CURVED PLATE(ROTATING) LOCATION 2	<u>CEVEDITV</u>	MEASUDEMENT	COMMENT		
	CONDITION	THROUGHOUT	LOCATION 2	<u>SEVERITY</u>	<u>MEASUREMENT</u>	<u>COMMENT</u>		
	RUSTING	THROUGHOUT		LIGHT				
		*:	**OVER/UNDER ROUTES CLEA	RANCE INFOR	MATION***			
RANCES OVER DECK	**N	IOTE: Vertical clearances for permitting purposes are taken as			- ·			
VERTICAL CLEARAN		ALUE <u>DIRECTION</u> DATE	<u>COMMENT</u>					
<u>No = N0062</u>								
	Anton in Res. of the Atlant	tected from disclosure by federal law 23 USC Section 409 and	Page 7					
Lhis report con	rains information that is nro	recreation disclosure by federal law 73 USC Section 409 and	ine Mussouri Upen Records Law (Sunshine Act) Section	on n I U U / I R SM n Please i	review MoDUL's policy and	i procedure manual on the Sunsh		

#### November 22, 2024 9:43:14AM

### 0062

2014)--ON SOUTH COLUMN 018)--S. COLUMN 3' X 3' AREA

2014)--OPEN V CRK ON WEST SIDE OF SOUTH COLUMN

2014)--OF BRGS @ SP 3 & 4

015)--W/ EXPOSED REBAR

MODOT					Missouri Depa State Bridg	rtment of Trai ge Inspection 1	-		
COUNT	ΓY: PERRY		DISTRICT: S	E	CLASS: STA	TBR	<b>FED-ID: 7</b> 4	15	BRIDGE: NO
<u>CLEARANCES UNDER BRIDG</u> <u>RECORD #</u> <u>R</u>	<u>'E</u> **1 OUTE	NOTE: Vertical c <u># LANES</u>	learances for permitting pur DIRECTION OF		s 2 inches less than the actual fie <b><u>RIGHT LATERAL</u></b>		<u>LEFT LATERAL CI</u>	JEARANCE	<u>UR-I</u>
VERTICAL CLEARANC	<u>EE TYPE**</u> <u>V</u>	ALUE	<b>DIRECTION</b>	<u>DATE</u>	<u>COMMENT</u>				
					***STRUC	TURE PAINT I	NFORMATION***		
<b>CONDITION:</b> FA	AIR	RUST	<b>CAMOUNT :</b> $7 = .29$	% OF SURFA	CE RUSTED	STEEL TONS	<b>S:</b> 51		
	<u>GINAL PAINT</u>				RACT REPAINT				<b>DEPARTMEN</b>
PAINT TYPE NAME			P.	AINT TYPE NAME			PAINT TYPE : NAME :	C SYSTEM INORGANIC ZIN	C/VINYL
PAINT COLOR	:			NT COLOR	:		PAINT COLOR :	ALUMINUM	
PAINT YEAR MILS			P/	AINT YEAR MILS			PAINT YEAR : MILS :		
					*** <b>R</b> F	QUESTED WO	RK ITEMS***		
GENERAL WORK COMME	ENTS:								
RESPONSIBILITY	LOCATION	Ţ	ITEM		CATEGORY	PRIORITY	DATE WORK IT.	EM COMMENT	
					***U	TILITY ATTAC	CHMENTS***		
UTILITY	OWNER		METHOD	M	EASUREMENT TYPE	VALUE	NUMBER U	TILITY ATTACHM	ENT COMMENT
					***PROG	RAM NOTES II	NFORMATION***		
YEAR     PROJECT #       2026     9S3771	MONTH LET 0	<u>YEAR LET</u> 2026	<u>ITEMS</u> REPLACE BRIDGE				<u>CO</u> M	<u>1MENT</u>	
Design_No = N0062						Page 8	n 610.021 RSMo. Please review		

This report contains information that is protected from disclosure by federal law, 23 USC Section 409 and the Missouri Open Records Law (Sunshine Act), Section 610.021 RSMo. Please review MoDOT's policy and procedure manual on the Sunshine Act before releasing any of the information contained herein.

#### November 22, 2024 9:43:14AM

# 0062

# -ID

<u>NT REPAINT</u> MANUFACTURE : SURFACE PREP :

MODOT			Missouri Department of Transpor State Bridge Inspection Repo		
COUNTY	: PERRY	DISTRICT: SE	CLASS: STATBR	FED-ID: 7415	BRIDGE: N000
***	<b>COMPUTER GEN</b>	ERATED RATINGS AND I	DEFICIENCY ITEMS***		***ADVANCE
NOTE: The items listed in this sec	ction are updated whenev	er computer edits are ran on a struct	ture after the inspection updates have been entered in to TMS.	SIGN #	SIGN TYPE
Rated Item		<u>Rating</u>	<b>Rating Date</b>	1	
[Item 67] Structure Evaluation Ra	ating: 4-MEETS	MINIMUM TOLERABLE	12/17/2018		
[Item 68] Deck Geometry Rating:	4-MEETS	MINIMUM TOLERABLE	3/6/2024		
[Item 69] Underclearance:	N-1	NOT APPLICABLE	5/18/2001		
Sufficiency Rating:		16.6%	3/6/2024		
Deficiency:		STRUCTURAL	10/16/2019		
Funding Eligibility:		FULL			<b>***OUTFALL INS</b>
Estimated New Structure Length:	:	243 FT.			
<b>Estimated Structure Cost:</b>		\$1,263,357		# OUTFALLS:	1
<b>Estimated Total Project Cost:</b>		\$1,895,036		STATUS:	
Year of Cost Estimate:		2024		NOTES:	
-	ne up with a new structur	e length and width to calculate a new	in the TMS system. These algorthims are w area which is taken times a representative cost per site specific engineering is done.		

Page 9 This report contains information that is protected from disclosure by federal law, 23 USC Section 409 and the Missouri Open Records Law (Sunshine Act), Section 610.021 RSMo. Please review MoDOT's policy and procedure manual on the Sunshine Act before releasing any of the information contained herein.

November 22, 2024 9:43:14AM

### 062

ED SIGN INFORMATION\*\*\* PROBLEM

**PROBLEM DIRECTION** 

## **NSPECTION INFORMATION\*\*\***

## **INSPECTOR:** DATE:

MODOT				Missouri Department of T	<b>Transportation</b>	
		State Bridge Inspection	on Report			
		COUNTY: PERRY	DISTRICT: SE	CLASS: STATBR	FED-ID: 7415	BRIDGE: N00

Page 10 This report contains information that is protected from disclosure by federal law, 23 USC Section 409 and the Missouri Open Records Law (Sunshine Act), Section 610.021 RSMo. Please review MoDOT's policy and procedure manual on the Sunshine Act before releasing any of the information contained herein.

### November 22, 2024 9:43:14AM

## 0062



#### Missouri Department of Transportation Bridge Inventory and Inspection System Structural Inventory & Appraisal Sheet

COUNTY : PERRY BRIDGE : NO RECORD TYPE : ROUTE CARRIED 'ON' STRUCT	62 1 REVIEW STATUS : APPROVED NBI STATUS : T RUN DATE : 10/4/2024 SUBMITTAL YEAR : 2024
GENERAL STRUCTURE INFORMATIO	N ROUTE DESIGNATION INFORMATION
1StateMISSOURI2DistrictSE3CountyPERRY8Federal ID No.741527Year Built1956106Year Reconstructed199442AType of Service OnHIGHWAY21Structure MaintenanceSTATE HIGHWAY AGENCY22Structure OwnerSTATE HIGHWAY AGENCY33Br. Median CodeNO MEDIAN37Historical SignificanceNOT ELIGIBLE FOR NR OF H101Parallel Struc DesgNONE EXISTS103Temporary StructureNOT TEMPORARY112NBIS Bridge LengthYES	5ARecord TypeROUTE CARRIED 'ON' STRUCT5BRoute Signing PrefixMO5CDesignated Level of ServiceMAINLINE5DRoute Number000NN5EDirectional SuffixNOT APPLICABLE7Facility CarriedRT NN E12Base Hwy. NetworkNO13ALRS Inventory Route No.13BSubroute No.20Toll StatusON FREE ROAD
	Image: Index
STRUCTURE LOCATION INFORMATI	ON STRUCTURE TRAFFIC INFORMATION
4     Place     SALINE       Code     65360       9     Location     S 3015 T 36 N R 10 E       11     Milepoint     1.50 miles       16     Latitude     37 D 48 M 17 S       17     Longitude     90 D 0 M 14 S	29AADT36430AADT Year2023102Direction of Traffic2-WAY TRAFFIC109AADT Truck Percent15%114Future AADT510115Future AADT Year2043
UNDERRECORD INFORMATION	STRUCTURE GEOMETRIC INFORMATION
6Features IntersectedSALINE CR42BType of Service UnderWATERWAY28BLanes Under Structure0054AVert. Clearance Ref.N/A54BVert. Clearance0 Ft. 0 In.55ARt. Lat Clear Ref.N/A55BRt. Lat Clearance0 Ft. 0 In.56Left Lat Clearance0 Ft. 0 In.38Navigation ControlPERMIT NOT REQ39Nav Vertical Clear0 Ft. 0 In.40Nav Horizontal Clear0 Ft. 0 In.111Nav. Pier Protection116116Nav. Cl. Vert. Clear	10Inventory Rte. Vert. Clear99 Ft. 99 In.19By pass Detour Length16.25 miles32Approach Roadway Width21 Ft. 12 In.34Skew20.00 Degrees35Struct. FlaredNO47Total Horiz. Clear20 Ft. 0 In.48Maximum Span Length69 Ft. 11 In.49Structure Length208 Ft. 0 In.50ALeft Curb/Sidewalk Width0 Ft. 0 In.50BRight Curb/Sidewalk Width0 Ft. 0 In.51Curb to Curb Br. Width20 Ft. 0 In.52Deck Width (Out-Out)22 Ft. 4 In.53Vert.Clearance Over Deck99 Ft. 99 In.

Design\_No = N0062 and Inventory\_Appraisal\_Submittal\_Year = 2024

Page: 1

This report contains information that is protected from disclosure by federal law, 23 USC Section 409 and the Missouri Open Records Law (Sunshine Act), Section 610.021 RSMo. Please review MoDOT's policy and procedure manual on the Sunshine Act before releasing any of the information contained herein.



#### Missouri Department of Transportation Bridge Inventory and Inspection System Structural Inventory & Appraisal Sheet

COUNTY: PERRY BRIDGE: N0062 1	REVIEW STATUS : APPROVED NBI STATUS : T
RECORD TYPE : ROUTE CARRIED 'ON' STRUCT	RUN DATE : 10/4/2024 SUBMITTAL YEAR : 2024
LOAD RATING AND POSTING INFORMATION	MATERIAL/CONSTRUCTION INFORMATION
31 Design Load H 10	43A Main Struc. Mat type STEEL
41 Structure Status POSTED FOR LOAD	43B Main struc Constr. Type STRINGER/MULTIBEAM - GRD
63 Oper. Rating Meth. ALLOWABLE STRESS	45 # of Main Spans 4
64 Operating Rating 26 Tons.	44A Appr Strue. Mat type 000
65 Inventory Rating Meth ALLOWABLE STRESS	44B Appr Struc. Cnstr. type 000
66 Inventory Rating 13 Tons.	$\begin{array}{c} 46 \\ \hline \ \ \ \ \ \ \ \ \ \ \ \ \ \ \ \ \ \$
70 Bridge Posting Code 0.1-9.9% BELOW	107     Deck Mat/Constr.     1 CONCRETE CIP
PROPOSED IMPROVEMENT INFORMATION	108A Wear Surf Mat/Constr. 6 BITUMINOUS
Sufficiency Rating 16.6 Percent	108B Membrane Mat/Constr. 0 NONE
Deficiency Rating STRUCTURAL	108C Deck Protect Mat/Constr. 0 NONE
Funding Eligibility FULL	CONDITION RATING INFORMATION
75A Proposed Work REPLACEMENT SUBSTND LOAD	58 Deck Cond. Rating 4
75B Work Done By Contract	59 Superstructure Cond. Rating 5
76 New Struc Length 242 Ft. 9 In.	60 Substructure Cond. Rating 4
94 Struc Improve Cost \$ 1,263,000	61 Channel /Channel Protection Cond. Rating 6
95 Roadway Improve Cost \$126,000	62 Culvert Cond. Rating N
96 Total Project Cost \$1,895,000	INSPECTION INFORMATION
97 Year of Cost Estimates 2024	
APPRAISAL RATING INFORMATION	90 Gen. Insp Date 10 / 24
36A Br. Rail App. Rating DOES NOT MEET ACCEPT STND	91 Gen. Insp. Frequency 12 Months   92A Frac. Critical Inspection N Months
36B     Transition Rail App. Rating     DOES NOT MEET ACCEPT STND	92A Frac. Critical Inspection N Months   93A Frac. Critical Insp. Date
36C     Approach Rail App. Rating     DOES NOT MEET ACCEPT STND	92B Underwater Inspection N Months
36D     Rail End Treat. App. Rating     DOES NOT MEET ACCEPT STND	93B Underwater Insp. Date
67 Struc Eval App. Rating 4	92C Special Inspection N Months
68 Deck Geometry App. Rating 4	93C Special Inspection Date
69 Underclearance App. Rating N	
71 Waterway Adeq. App. Rating 8	BORDER BRIDGE INFORMATION
72 Approach Road App. Rating 5	98 Neighboring State Code
113     Scour Assess App. Rating     8	98B Neighboring State % Respon
	99 Neighboring State Struc. No.
APPROVED POSTING INFORMATION	FIELD POSTING INFORMATION
Approved Posting Category S-7	Field Posting Category S-7
Ton1 Ton2 Ton3	Ton1 Ton2 Ton3
Tonnage Values for Posting Sign 21	Tonnage Values for Posting Sign 21
	General Text for Posting Sign
General Text for Posting Sign	
TRUCKS OVER 21 TONS 15 MPH ON BRIDGE.	TRUCKS OVER 21 TONS 15 MPH ON BRIDGE.
Design_No = N0062 and Inventory_Appraisal_Submittal_Year = 2024	
Page:	2

This report contains information that is protected from disclosure by federal law, 23 USC Section 409 and the Missouri Open Records Law (Sunshine Act), Section 610.021 RSMo. Please review MoDOT's policy and procedure manual on the Sunshine Act before releasing any of the information contained herein.