

April 28, 2025

BIDDING ADDENDUM 2

For work titled: Roadway Extension - Pemiscot County Port Authority

TO ALL BIDDERS

GENERAL NOTES

This addendum is issued for the purpose of clarifying the intent of the contract documents or for making necessary corrections, deletions, and/or additions to the documents on all items of discrepancy raised up to the time of the issuance of this addendum.

Each bidder is hereby instructed and authorized to incorporate into his proposal the instructions contained in this addendum. This addendum forms a part of the bidding and contract documents and modifies the original bidding documents, dated April 2025. Acknowledge receipt of this addendum in space provided on Bid Form. FAILURE TO DO SO MAY SUBJECT BIDDER TO DISQUALIFICATION.

This addendum consists of three (3) – 8 1/2" x 11" pages including this cover sheet and one (1) - 22" x 34" sheet.

GENERAL

1	Questions	<p>Question: Will there be any profilographing needed?</p> <p>Response: Profilographing is not specified.</p>
2	Questions	<p>Question: I see a several notes on Sheet C003 that I am assuming do not apply to this project. i.e. Geo-grid required, etc. Can you please clarify?</p> <p>Response: Geogrid is not required. Pavement should be constructed per detail 3/C501.</p>
3	Questions	<p>Question: Sheets c101,c102 show transverse joints running all the way across roadway.</p> <p>Response: Transverse joints should extend the full width of the pavement.</p>
4	Questions	<p>Question: Sheet c501 show joints going all the way across, but only baskets on transverse joints in the travel lane sections. Is this correct? No baskets in transverse joints of shoulder area.</p> <p>Response: Transverse joints shall be per detail 7/C501, except for the first and last panels of the roadway, which should include baskets per detail 6/C501. Revise detail 1/C501 to show baskets the full width of the pavement at these joint locations.</p>
5	Questions	<p>Question: Sheets C101,C102 it looks as if all lanes ,travel and shoulder are the same width 10'.</p> <p>Response: Correct</p>


6	Questions	<p>Question: Sheet c501 it looks as if travel lanes are wider (12') than the shoulder area lanes (8').Is this correct , what are the actual widths of the lanes.</p> <p>Response: All panels shall be an equal width per detail 1/C102.</p>
7	Clarification	<p>Pemiscot County Port Authority is inviting you to a scheduled Zoom meeting.</p> <p>Topic: ROADWAY EXTENSION BID OPENING Pemiscot County Port Authority Time: May 1, 2025 10:00 AM Central Time (US and Canada) Join Zoom Meeting https://us06web.zoom.us/j/85345200326?pwd=c0ZyihBtTL3BByQS7OPaledHc7qQdl.1</p> <p>Meeting ID: 853 4520 0326 Passcode: 198933</p> <p>---</p> <p>One tap mobile +16465588656,,85345200326#,,,,*198933# US (New York) +16469313860,,85345200326#,,,,*198933# US</p> <p>---</p> <p>Dial by your location</p> <ul style="list-style-type: none"> • +1 646 558 8656 US (New York) • +1 646 931 3860 US • +1 301 715 8592 US (Washington DC) • +1 305 224 1968 US • +1 309 205 3325 US • +1 312 626 6799 US (Chicago) • +1 720 707 2699 US (Denver) • +1 253 205 0468 US • +1 253 215 8782 US (Tacoma) • +1 346 248 7799 US (Houston) • +1 360 209 5623 US • +1 386 347 5053 US • +1 507 473 4847 US • +1 564 217 2000 US • +1 669 444 9171 US • +1 689 278 1000 US • +1 719 359 4580 US <p>Meeting ID: 853 4520 0326 Passcode: 198933</p> <p>Find your local number: https://us06web.zoom.us/j/85345200326?pwd=c0ZyihBtTL3BByQS7OPaledHc7qQdl.1</p>
DRAWINGS		
1	Plan Sheet C002, Site Specifications	<p>Specifications, Part 2 Materials, ADD paragraph 2.3 as follows:</p> <p>A.Pavement joints shall be sealed with hot-poured joint sealer</p> <ol style="list-style-type: none"> 1.The hot poured sealer shall be placed utilizing a “V” shaped wand tip, to allow penetration of the materials into the joints while providing neat completely filled joints. 2.Joints shall be completely filled or over banded not to exceed 1½”. Excessive over banding shall be removed as directed by the A/E.
2	Plan Sheet C501, Pavement Details	<p>REPLACE Plan Sheet C501 with the attached revised plan sheet C501.</p>

ATTACHMENTS

(Example) C501 Site Specifications - (22x34)

All other terms and conditions of the Project Manual and Drawings shall remain unchanged.


END OF ADDENDUM 2

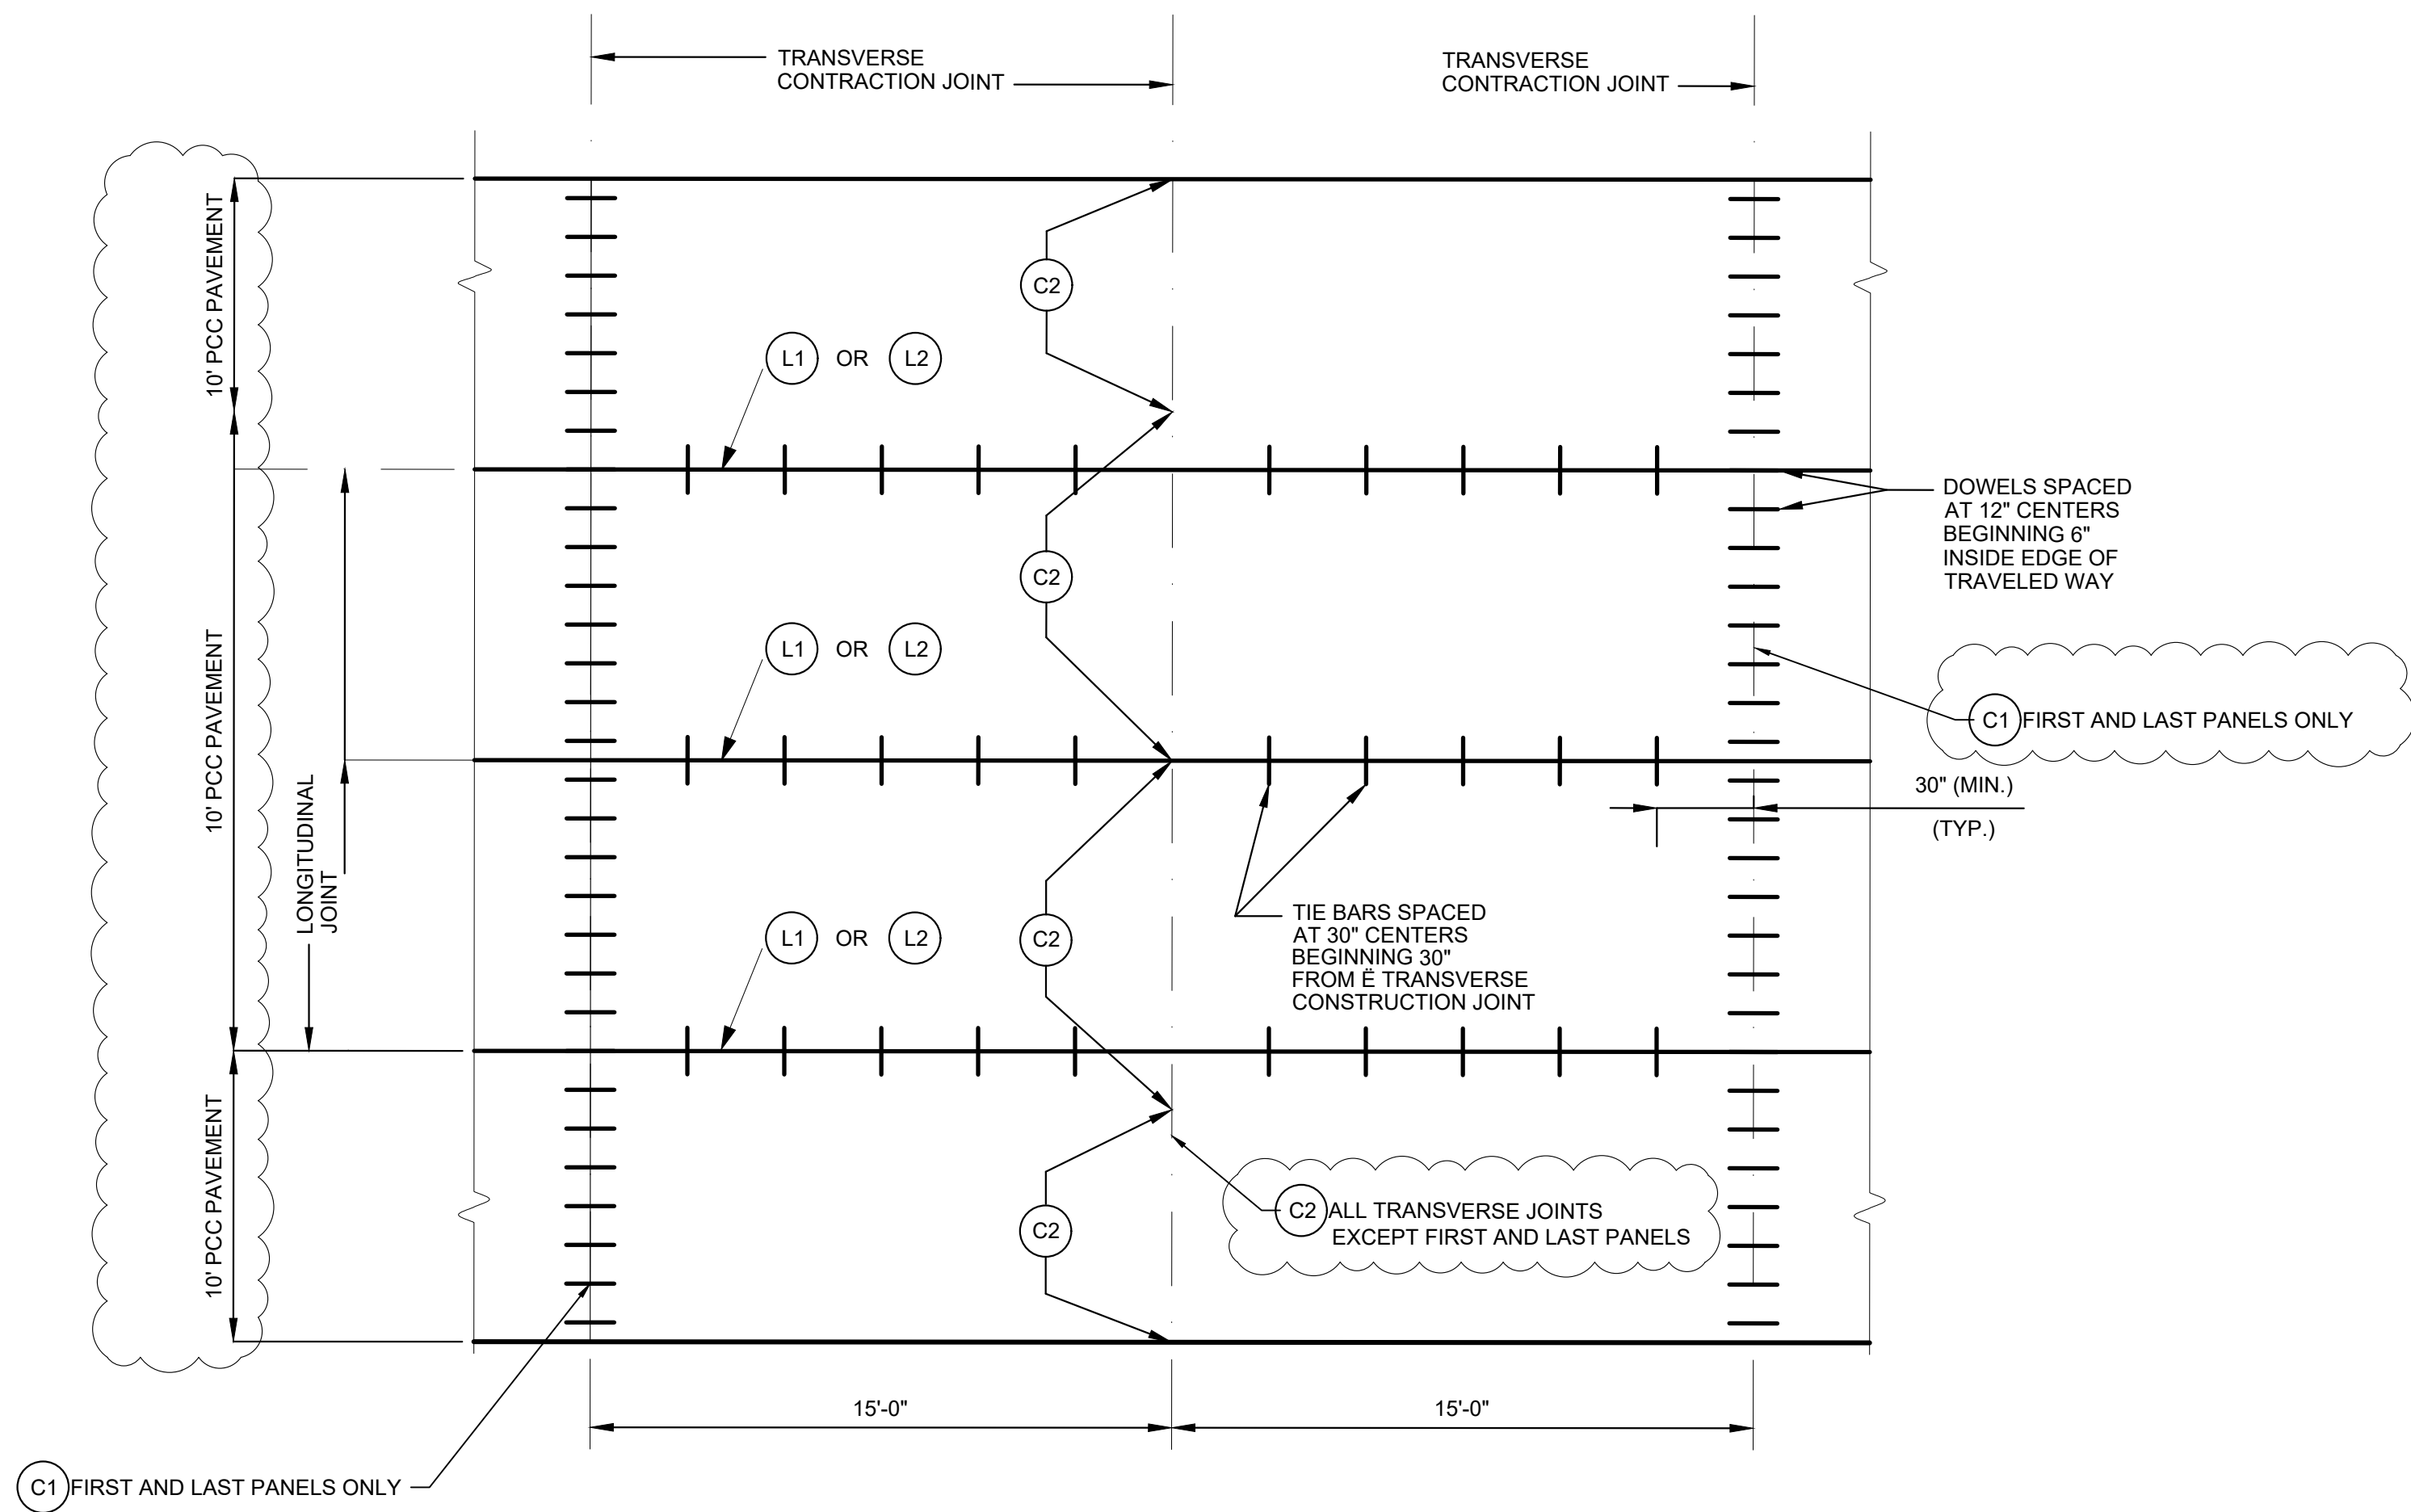


1 JOINT PLAN AND SPACING FOR CONTRACTION JOINTS
NTS

PCCP THICKNESS (P)	DOWEL		TIE BAR	
	SIZE	SPACING	SIZE	SPACING
LESS THAN 7"	NONE	NONE	#5X30"	30" CTRS.
7" TO 10"	1 1/2"X18"	12" CTRS.	#5X30"	30" CTRS.
GREATER THAN 10"	1 1/2"X18"	12" CTRS.	#6X40"	30" CTRS.


GENERAL NOTES:
THE FINAL POSITION OF ALL DOWELS AND TIE BARS SHALL BE PERPENDICULAR TO THE PLANE OF THE JOINT AND PARALLEL TO THE SURFACE OF THE PAVEMENT AND PARALLEL TO EACH OTHER.

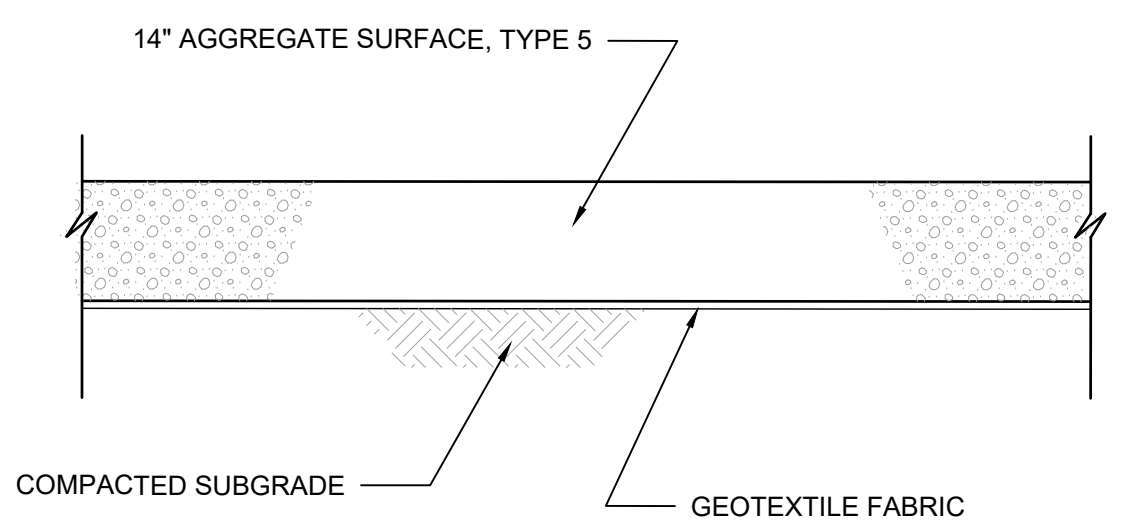


2 AGGREGATE PAVING DETAIL
NTS

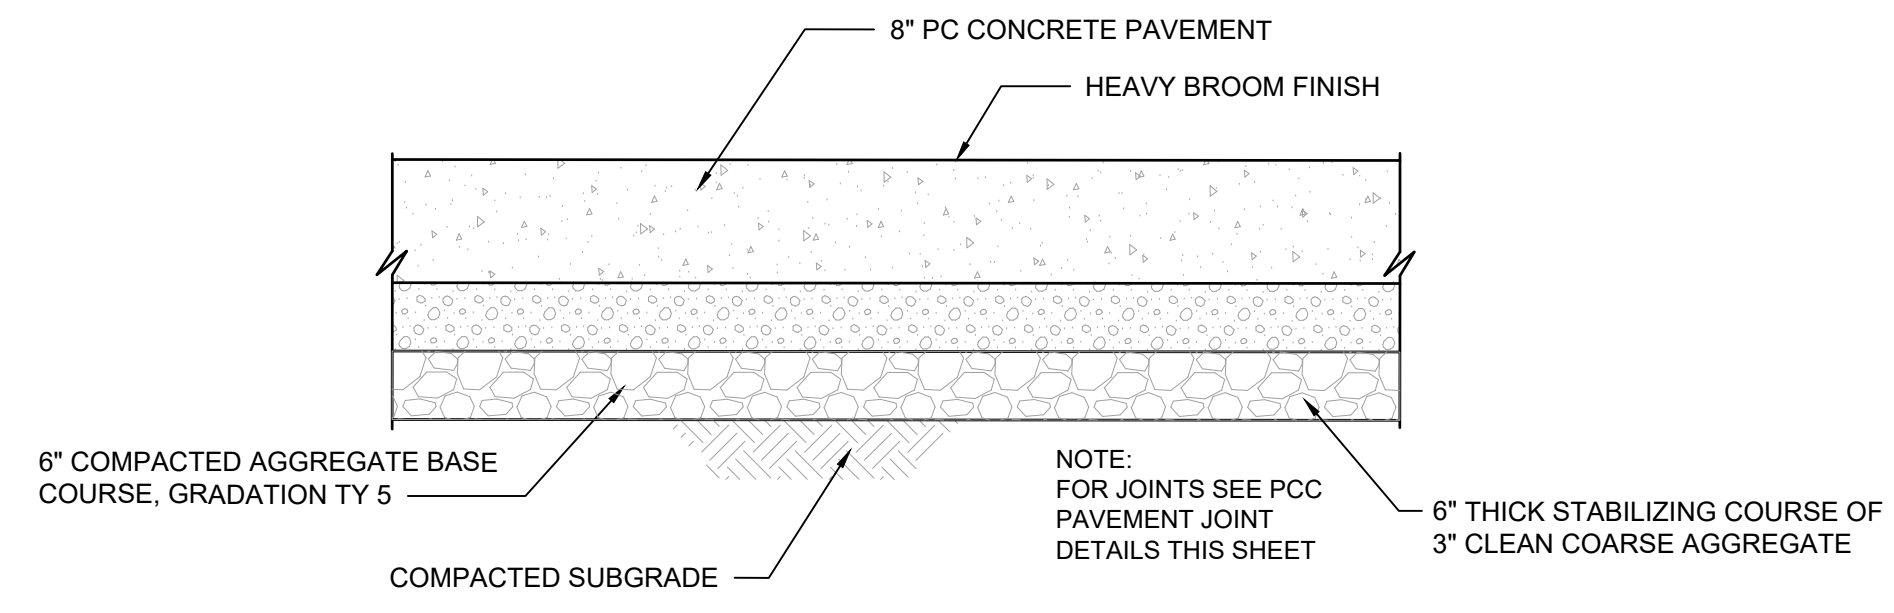


3 PCC PAVING DETAIL
NTS

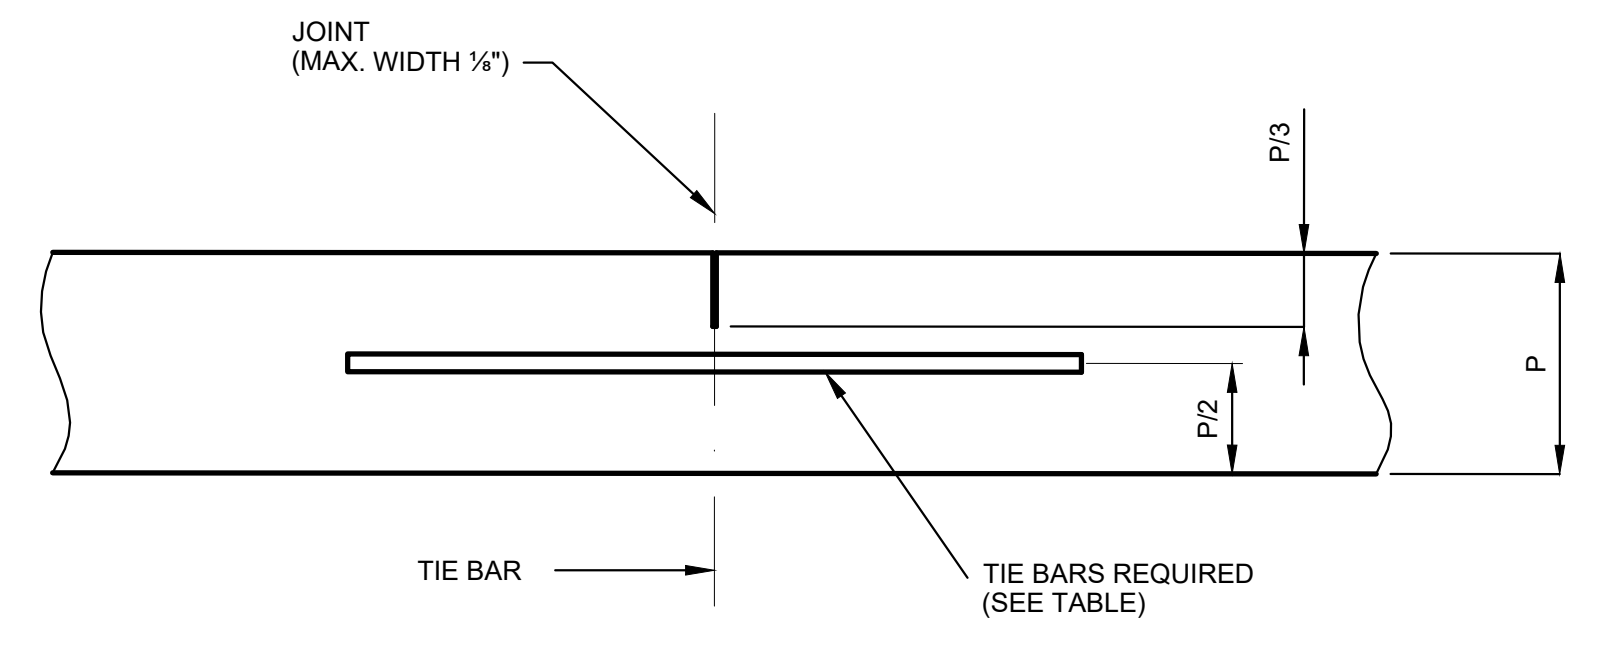


4 LONGITUDINAL JOINT L1
NTS

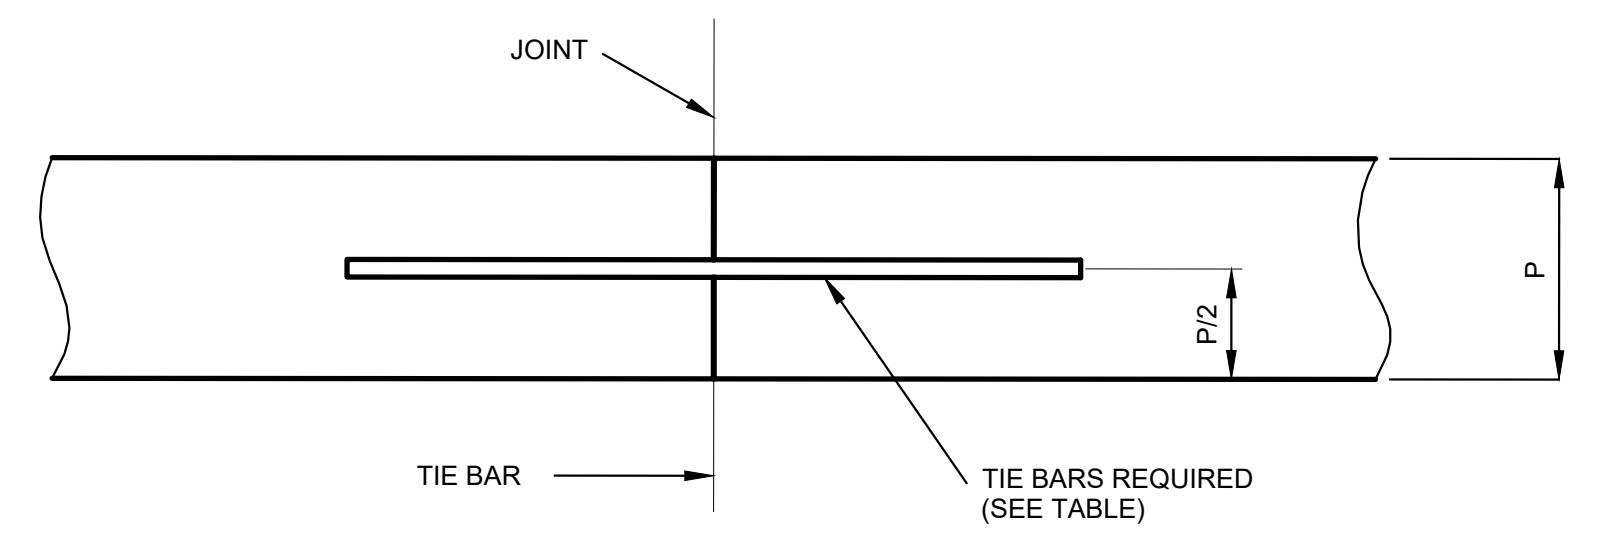

5 LONGITUDINAL CONSTRUCTION JOINT L2
NTS

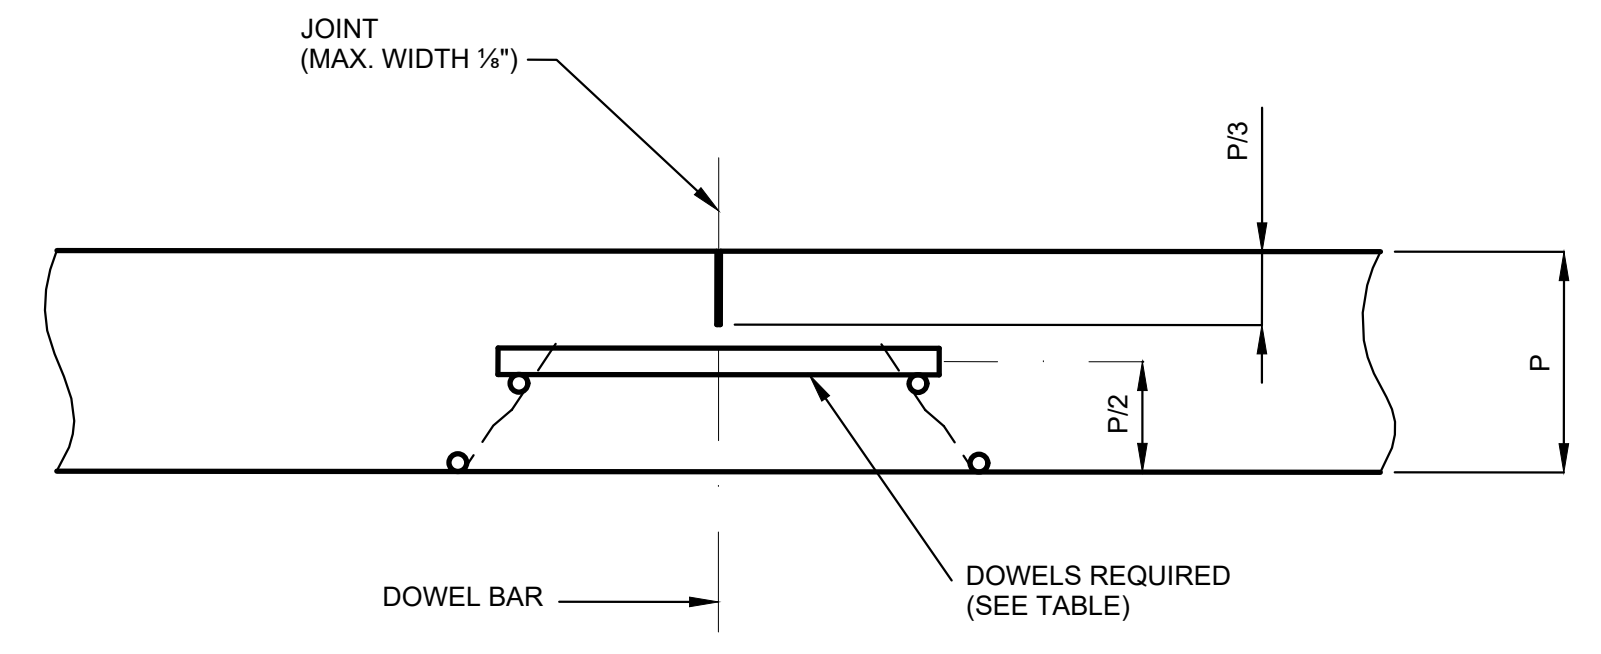

6 TRANSVERSE CONTRACTION JOINT C1
NTS

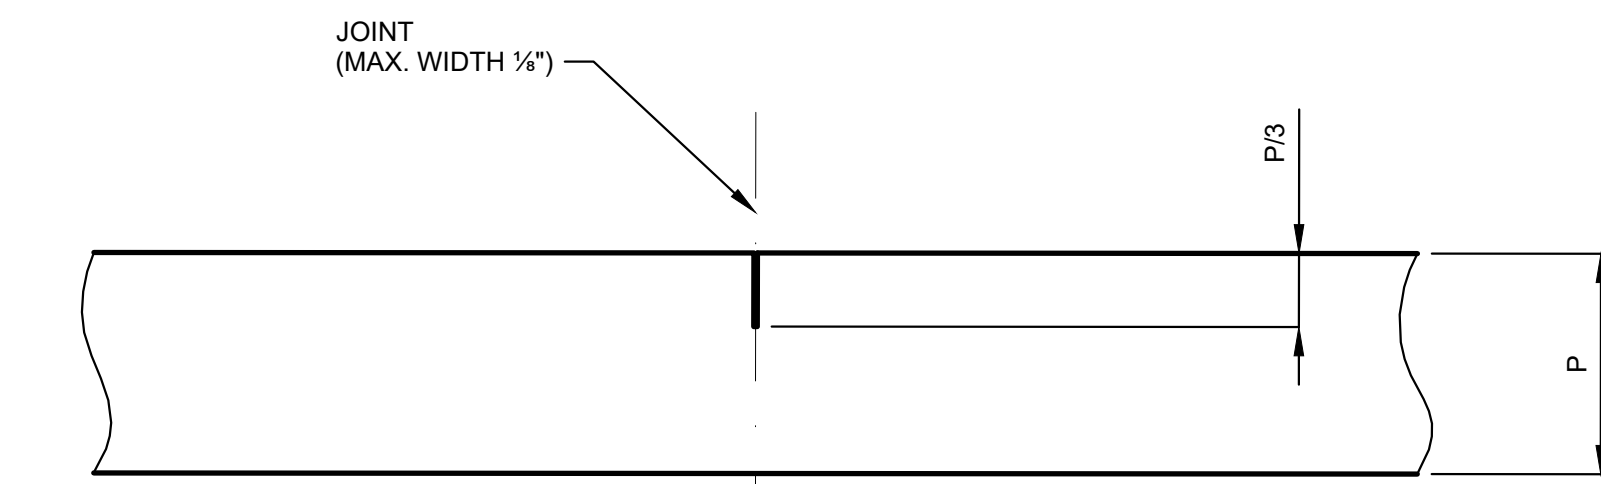


7 TRANSVERSE CONTRACTION JOINT C2
NTS

© 2025 KLINGNER & ASSOCIATES P.C.
This document shall not be used for any purpose or project for which it is not intended. Klingner & Associates P.C. and their Divisions shall be indemnified by the client and held harmless from all claims, damages, liabilities, losses and expenses, including attorneys fees and costs arising out of such misuse or reuse of this document. In addition, unauthorized reproduction of this document, in part or as a whole, is prohibited.

REVISION HISTORY			
MARK	DESCRIPTION	DATE	APPR
Δ	REVISED PAVT DETAILS	4/28/2025	DCD

ISSUED FOR: 04/14/2025
BIDDING

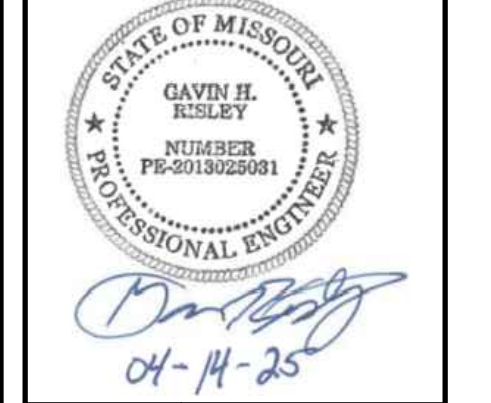

ROADWAY EXTENSION
PEMISCOT CO PORT AUTHORITY
2353 N STATE HIGHWAY D
HAYTI, MO 63851

Non-Reduced Sheet Size: 22" x 34"
Full sized plans have been prepared using standard scales.
Reduced size plans may not conform to standard scales.

DESIGNED	DRAWN
DCD	DCD
FIELD	FIELD BOOK
DRONE	NA
CHECKED	CHECK DATE
GHR	4/14/25

SHEET TITLE
PAVEMENT DETAILS

PROJECT NO.
24-0298
DRAWING ISSUED DATE:
04/14/2025
SHEET

C501