



Issued: September 1, 2026

Receipt acknowledged by

This Addendum is hereby made a part of the Contract Documents to the same extent as if they were originally included herein. This Addendum shall be inserted in the Contract Documents and shall be executed and submitted with the Bid. This Addendum includes the following:

1. A CAD model is available to all bidders upon request. Bidders who want the model must fill out the attached Digital Data License agreement and send it to alec.mcdonald@amce.com.
2. The bid schedule has been revised as follows. (A revised Bid Schedule is attached)
 - a. Item 8 has been removed and replaced with item 10, 608-40.23 Sidewalk Handrail. The corresponding MODOT standard details for this item are attached.
 - b. Item 27, 732-299.24 24" Dia. RCP Flared End section has been added.
3. The following Drawings have been changed to correspond to the changes listed above in the bid schedule.
 - a. Drawing 2: Updated Quantity Table.
 - b. Drawing 5: Replaced "75 LF OF BLACK VINYL COATED CHAINLINK FENCE" with "75 LF OF SIDEWALK HANDRAIL"
 - c. Drawing 6: Replaced "40 LF OF BLACK VINYL COATED CHAINLINK FENCE" with "40 LF OF SIDEWALK HANDRAIL"
 - d. Drawing 10: Adjusted the downstream end location of 18" RCP pipe.
4. The City of Aurora has already cleared the tree's and branches required for construction.

ALLGEIER, MARTIN and ASSOCIATES, INC.

Alec McDonald, P.E.

DIGITAL DATA LICENSE AGREEMENT

This Digital Data License Agreement (“Agreement”), regarding the transmittal of certain digital data (“Digital Data”), is entered into on this ____ day of ____, 2026, by and between Allgeier, Martin and Associates, Inc. (“Transmitting Party”) and ____ (“Receiving Party”). The Transmitting Party and the Receiving Party are collectively referred to herein as the “Parties.”

This Agreement pertains to the following project (“Project”): Crosby Park to Robinson Elementary, Federal Project No. TAP-9900(791).

The Receiving Party is considering entering into an agreement with the Owner to construct all or part of the Project (“Construction Contract”). Terms in this Agreement, not otherwise defined, shall have the same meaning as those in the Construction Contract.

In consideration of the mutual promises herein, the Parties agree as follows:

1. The Transmitting Party hereby agrees to transmit the Digital Data and grant a nonexclusive limited license to the Receiving Party on the terms set forth herein. The nonexclusive license will terminate upon Substantial Completion of the Project.
2. “Digital Data” is information, communications, drawings, or designs created or stored for the Project in digital form.
3. Except as specifically set forth herein, this Agreement does not create any other contractual relationship between the Parties. The Transmitting Party is not a party to the Construction Contract (however, the Transmitting Party has the right to be indemnified as provided in the General Conditions of the Construction Contract).
4. The Transmitting Party retains its rights in the Digital Data, including any rights of ownership and/or copyright as established by law and/or contract. By transmitting the Digital Data, the Transmitting Party does not grant to the Receiving Party an assignment of those rights or convey to the Receiving Party any right in the software used to generate the Digital Data.
5. The Digital Data was created for this Project only and may not be used for the purpose of any other project. To the fullest extent permitted by law, the Receiving Party shall indemnify and defend the Transmitting Party from and against all claims arising from or related to the Receiving Party’s modification to, or unlicensed use of, the Digital Data.
6. The Transmitting Party makes no representation as to the compatibility of the Digital Data with any hardware or software.
7. The transfer of the Digital Data shall not be deemed to be a sale. The Transmitting Party makes no representation regarding the accuracy, completeness, or permanence of the Digital Data, and makes no warranty of merchantability or fitness for a particular purpose.
8. The Digital Data shall not be considered to be a Contract Document. In the event of a conflict between the Digital Data and the sealed Contract Documents, the latter shall govern. It is the Receiving Party’s responsibility to determine if any conflicts exist. Addenda information or revisions made after the date indicated on the Digital Data may not have been incorporated therein.

9. The use of the Digital Data shall not obviate the Receiving Party's obligations under the Contract Documents, including, and without limitation, the need to check, confirm and coordinate all dimensions and details, take field measurements, verify field conditions and coordinate the Work.
10. The Transmitting Party will not be responsible for any deterioration, degradation, or inadvertent modification of the Digital Data.
11. This Agreement shall be governed by the laws of the state where the Project is located.

This Agreement contains the entire agreement between the Parties, and there are no other oral, written, express or implied promises, agreements, representations, or inducements not specified in this Agreement.

This Agreement is entered into as of the day and year first written above.

TRANSMITTING PARTY:

By: *Alec McDonald*
Alec McDonald, P.E.

Allgeier Martin and Associates, Inc.
Company

Title: Civil Engineer

RECEIVING PARTY:

By: _____
Name

Company

Title: _____

(21) **INSURANCE:** It is understood by the undersigned that insurance policies are in compliance with Section 107 of the latest edition of the Missouri Standard Specification for Highway Construction. Additional insured shall be as follows:


1. Aurora, Missouri

ITEMIZED BID: The bidder should complete the following section in accordance with Sec 102.7. The bidder proposes to furnish all labor, materials, equipment, services, etc. required for the performance and completion of the work, as follows:

BASE BID						
Item #	Item Code	No. of Units			Unit Price	Extended Total
1	202-20.10	1	LS	Removal of Improvements		
2	201-99.01	1	LS	Clearing & Grubbing		
3	202-99.02	1	EA	Cap Existing Storm Sewer		
4	203-50.00	776	CY	Earthwork (Unclassified Excavation & Embankment)		
5	207-10.00	33.5	STA.	Linear Grading, Class 1		
6	304-01.63	3,608	SY	Type 1 Aggregate Base, 4" Thick		
7	502-11.06	183	SY	Full Depth Concrete Replacement (6 In.)		
8	608-10.10	7	EA	Concrete Curb Ramps (ADA)		
9	608-10.12	141	SF	Truncated Domes		
10	608-40.23	115	LF	Sidewalk Handrail		
11	608-50.08	99	SY	Concrete Driveway, Grading, Compaction, and Base Rock		
12	608-60.04	3,608	SY	Concrete Sidewalk, 4 In.		
13	609-10.51	119	LF	Rollback Curb & Gutter		
14	611-30.20	20	CY	Furnishing Type 2 Rock Blanket		
15	611-30.40	20	CY	Placing Type 2 Rock Blanket		
16	616-10.05	85	SQFT	Construction Signs		
17	616-10.22	100	EA	Channelizer (Cones)		
18	616-10.30	2	EA	Type III Moveable Barricade		
29	618-10.00	1	LS	Mobilization		
20	627-40.00	1	LS	Contractor Furnished Surveying & Staking		
21	726-99.18	143	LF	18" Dia. RCP Storm Sewer Pipe		
22	726-99.24	112	LF	24" Dia. RCP Storm Sewer Pipe		
23	731-10.32	1	EA	Precast Drop Inlet W/ Existing Junction Box Frame		
24	731-10.53	3	EA	Type S2 Inlet (3'x5)		
25	731-99.02	1	EA	Adjust Existing Storm Sewer Junction Box		
26	732-299.18	2	EA	18" Dia. RCP Flared End Section		
27	732-299.24	1	EA	24" Dia. RCP Flared End Section		
28	805-99.19	1.7	AC	Seeding & Mulching		


29	806-99.28	1	LS	Maintain SWPPP Including Reporting Requirements		
30	808-99.03	400	LF	Erosion Control Log/Sock		
TOTAL CONSTRUCTION AMOUNT						

Bid Alternate 1						
Item #	Item Code	No. of Units			Unit Price	Extended Total
31	608-99.05	3608	SY	Asphalt Sidewalk, 4 In. In lieu of Concrete Sidewalk, 4 In.		
TOTAL CONSTRUCTION AMOUNT WITH ALTERNATE BID						

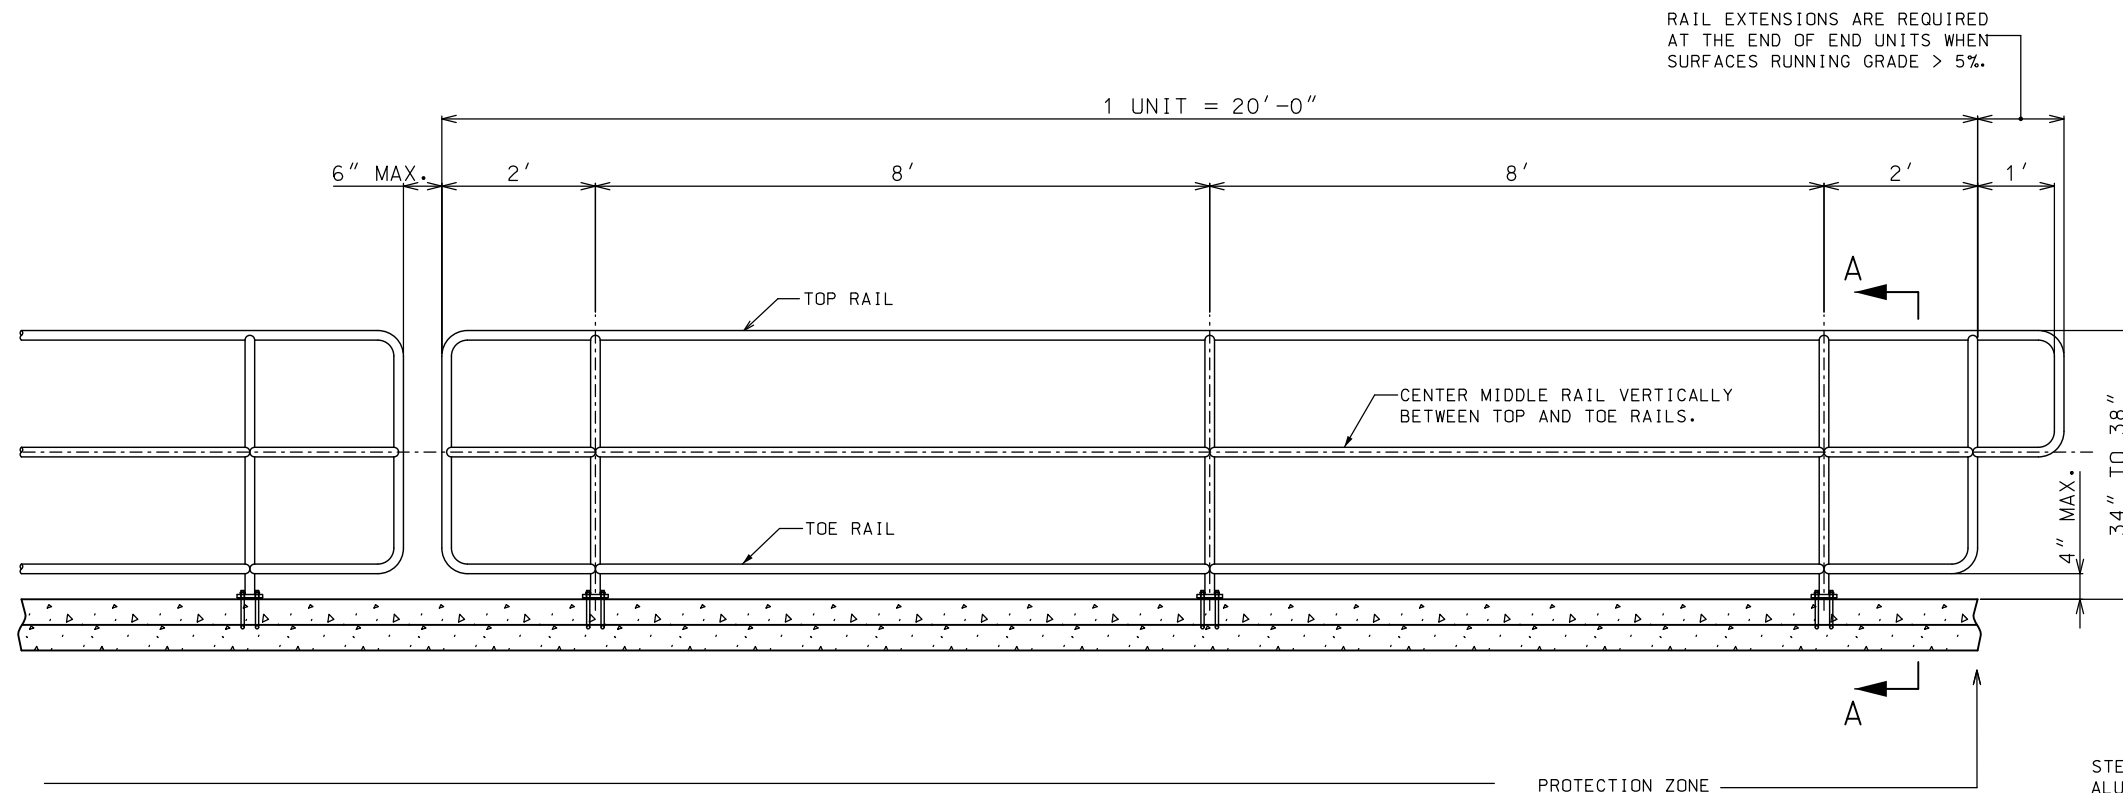


SIDEWALK HANDRAILING WITHOUT BALUSTERS


* CROSS SLOPE: 1.0 % MIN. - 2.0 % MAX.

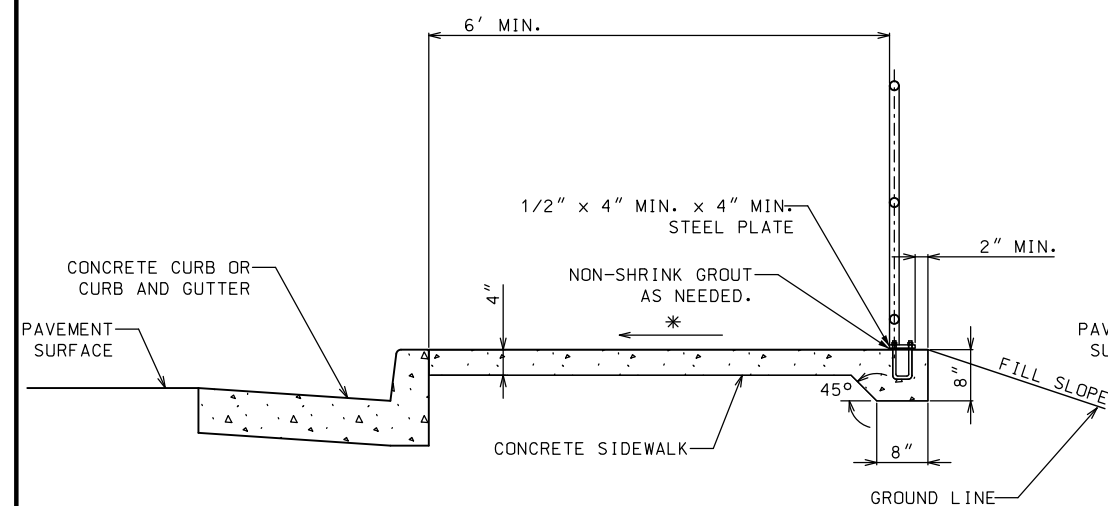

SIDEWALK WITHOUT BUFFER STRIP
(SECTION A-A)

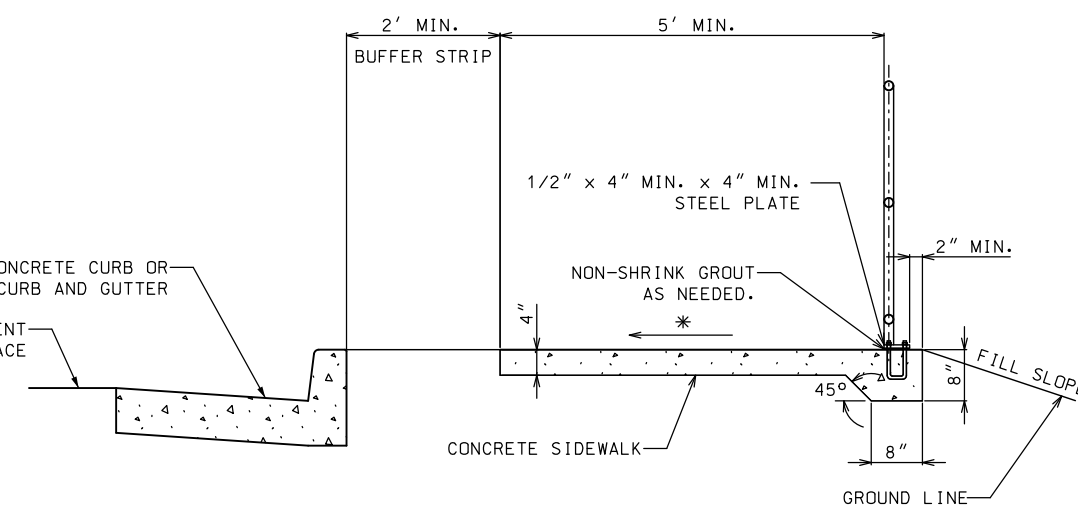


SIDEWALK WITH BUFFER STRIP
(SECTION A-A)

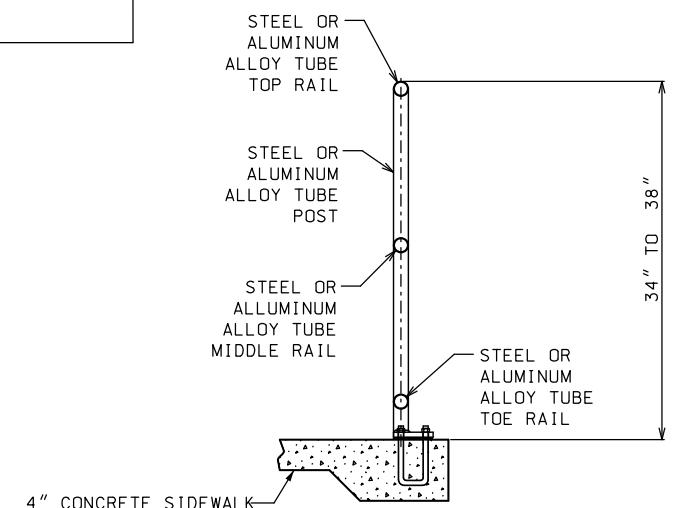


HANDRAILING


FOR GENERAL NOTES AND HANDRAILING REQUIREMENTS ON FILL SLOPES SEE SHEET 3 OF 4

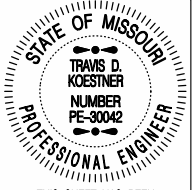 MISSOURI HIGHWAYS AND TRANSPORTATION COMMISSION 105 WEST CAPITOL JEFFERSON CITY, MO 65102 1-888-ASK-MODOT (1-888-275-6636)	
	HANDRAILING
DATE EFFECTIVE: 01/01/2021 DATE PREPARED: 10/14/2020	608.40A
SHEET NO. 1 OF 4	

IF A SEAL IS PRESENT ON THIS SHEET IT HAS BEEN ELECTRONICALLY SEALED AND DATED.

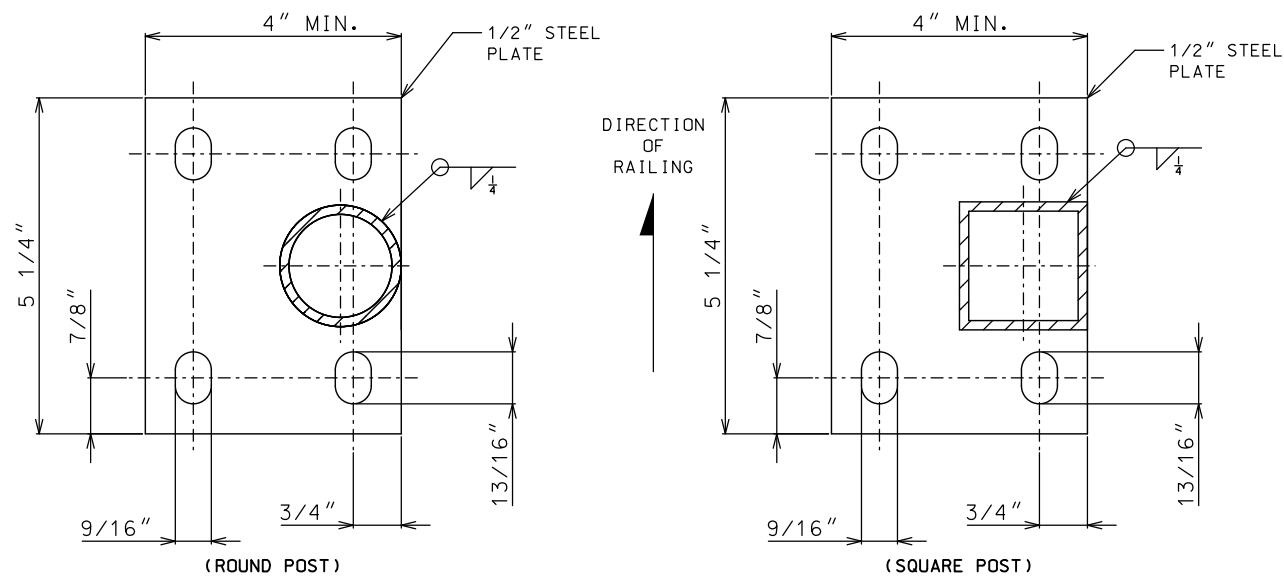

MOUNTING PLATE DETAIL
(PLAN VIEW)

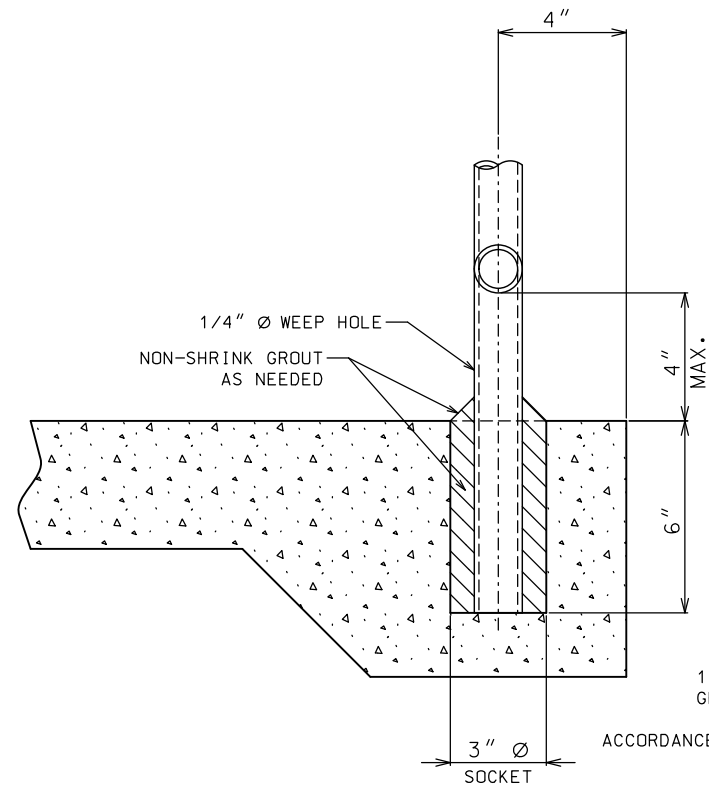

SOCKET MOUNTING DETAIL

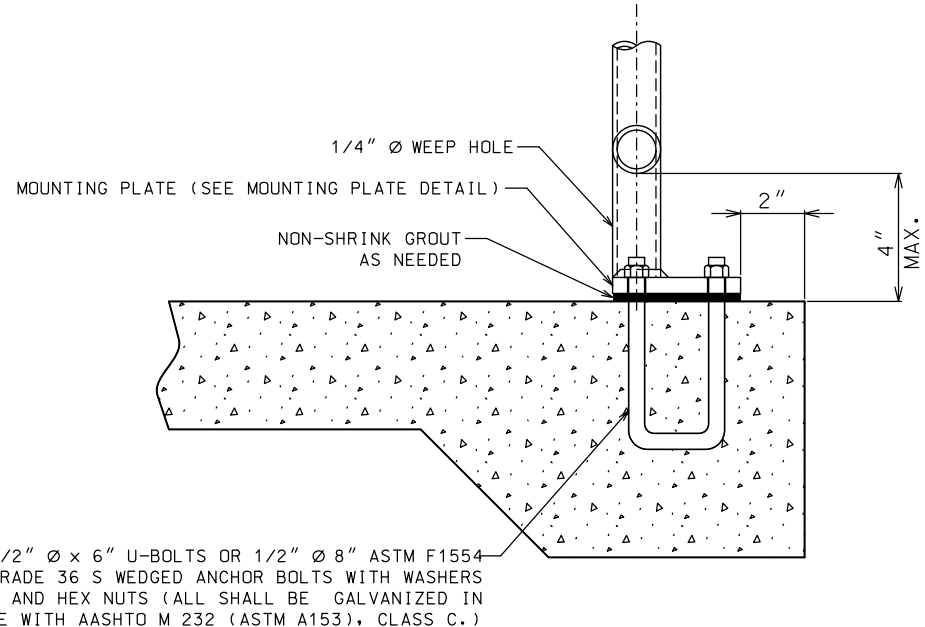


PLATE MOUNTING DETAIL

GENERAL NOTES:

RAILINGS AND POSTS MAY BE EITHER ROUND OR SQUARE STEEL OF GOOD COMMERCIAL WELDABLE QUALITY OR ALUMINUM ALLOY 6061-T6 OR 6063-T6.

STEEL RAILINGS AND POSTS SHALL BE GALVANIZED AFTER FABRICATION IN ACCORDANCE WITH AASHTO M111.

ALL JOINTS SHALL BE CONTINUOUS WELDED AND GROUND SMOOTH.

METAL SAFETY RAIL MUST BE COMPLIANT WITH THE "AMERICAN'S WITH DISABILITIES ACT ACCESSIBILITY GUIDELINES (ADAAG)". EXCEPTIONS MUST BE APPROVED BY THE ENGINEER. ALL OTHER AREAS OF NON-COMPLIANCE SHALL BE REMOVED AND CORRECTED AT THE CONTRACTOR'S EXPENSE.

ALL POSTS SHALL HAVE A 1/4" WEEP HOLE IMMEDIATELY ABOVE THE MOUNTING PLATE.

WHEN INSTALLED THE POSTS SHALL BE PLUMB AND RAILINGS SHALL MATCH THE SLOPE OF THE SIDEWALK.

HANDRAIL REQUIREMENTS		
FILL SLOPE	FILL HEIGHT	HANDRAIL
(1V:3H) OR FLATTER	_____	NOT REQUIRED
(1V:3H) OR STEEPER	≥ 6 FT.	REQUIRED
(1V:2H) OR STEEPER	≥ 4 FT.	REQUIRED
(1V:1H) OR STEEPER	≥ 1 FT.	REQUIRED

RAILING AND POST SPECIFICATION				
DESCRIPTION	TYPE	SIZE (DIA.)	WEIGHT (LBS. / FT.)	
			ALUM.	STEEL
RAILING & POST	ROUND	1 1/2"	0.940	2.720
	SQUARE	2" X 2"	1.3094	4.310
BALUSTER	ROUND	1/2"	0.2312	0.668
	RECT.	3/8" X 1/2" STL.	_____	0.6375
	SQUARE	1/2" X 1/2" ALUM.	0.2944	_____

MISSOURI HIGHWAYS AND TRANSPORTATION COMMISSION

105 WEST CAPITOL
JEFFERSON CITY, MO 65102
1-888-ASK-MODOT (1-888-275-6636)

STATE OF MISSOURI
TRAVIS D. KOESTNER
NUMBER PE-30042
PROFESSIONAL ENGINEER

THIS SHEET HAS BEEN
SIGNED, SEALED AND DATED
ELECTRONICALLY.

HANDRAILING

DATE EFFECTIVE: 01/01/2021
DATE PREPARED: 10/14/2020

608.40A

SHEET NO.
3 OF 4

Z:\AURORA MO\CITY OF AURORA\TRANSPORTATION\WHITE PARK TO CROSBY PARK TAP-9900(791)\DRAWINGS\2. QUANTITIES.DWG

BASE BID

Item #	Item Code	No. of Units		
1	202-20.10	1	LS	Removal of Improvements
2	201-99.01	1	LS	Clearing & Grubbing
3	202-99.02	1	EA	Cap Existing Storm Sewer
4	203-50.00	776	CY	Earthowrk (Unclassified Excavation & Embankment)
5	207-10.00	33.5	STA.	Linear Grading, Class 1
6	304-01.63	3,608	SY	Type 1 Aggregate Base, 4" Thick
7	502-11.06	183	SY	Full Depth Concrete Replacement (6 In.)
8	608-10.10	7	EA	Concrete Curb Ramps (ADA)
9	608-10.12	141	SF	Truncated Domes
10	608-40.23	115	LF	Sidewalk Handrail
11	608-50.08	99	SY	Concrete Driveway, Grading, Compaction, and Base Rock
12	608-60.04	3,608	SY	Concrete Sidewalk, 4 In.
13	609-10.51	119	LF	Rollback Curb & Gutter
14	611-30.20	20	CY	Furnishing Type 2 Rock Blanket
15	611-30.40	20	CY	Placing Type 2 Rock Blanket
16	616-10.05	85	SQFT	Construction Signs
17	616-10.22	100	EA	Channelizer (Cones)
18	616-10.30	2	EA	Type III Moveable Barricade
19	618-10.00	1	LS	Mobilization
20	627-40.00	1	LS	Contractor Furnished Surveying & Staking
21	726-99.18	143	LF	18" Dia. RCP Storm Sewer Pipe
22	726-99.24	112	LF	24" Dia. RCP Storm Sewer Pipe
23	731-10.32	1	EA	Precast Drop Inlet W/ Existing Junction Box Frame
24	731-10.53	3	EA	Type S2 Inlet (3'x5)
25	731-99.02	1	EA	Adjust Existing Storm Sewer Junction Box
26	732-299.18	2	EA	18" Dia. RCP Flared End Section
27	732-299.24	1	EA	24" Dia. RCP Flared End Section
28	805-99.19	1.7	AC	Seeding & Mulching
29	806-99.28	1	LS	Maintain SWPPP Including Reporting Requirements
30	808-99.03	400	LF	Erosion Control Log/Sock

Bid Alternate 1

Item #	Item Code	No. of Units		
31	608-99.05	3,608	SY	Asphalt Sidewalk, 4 In. In Lieu of Concrete Sidewalk, 4 In.

GENERAL NOTES:

LOCATIONS OF EXISTING UTILITIES AS SHOWN ON PLANS ARE APPROXIMATE, LOCATED WITH INFORMATION PROVIDED BY OTHERS. CONTRACTOR SHALL CONTACT ALL UTILITIES PRIOR TO EXCAVATION, AND SHALL BE RESPONSIBLE FOR THE EXACT LOCATION (HORIZONTAL AND DEPTH) AND PRESERVATION OF ALL BURIED UTILITY LINES. UTILITY LOCATING SERVICE, SUCH AS (MISSOURI DIG-RITE), SHALL BE CONTACTED BY THE CONTRACTOR 48 HOURS PRIOR TO THE BEGINNING OF CONSTRUCTION. IT MAY BE NECESSARY FOR THE CONTRACTOR TO EXPOSE UTILITIES TO DETERMINE EXACT LOCATION FOR THE PURPOSE OF COMPLETING THE PROJECT.

B.M. (BENCHMARK) ELEVATIONS & LOCATIONS SHALL BE AS SHOWN ON PLAN SHEETS.

CP-* (CONTROL POINT) – SEE PLAN SHEETS FOR ELEVATIONS, LOCATIONS & DESCRIPTION.

NORTHING & EASTING INFORMATION CAN BE MADE AVAILABLE UPON CONTRACTORS REQUEST.

CONTRACTOR SHALL BE RESPONSIBLE FOR ALL LINE AND GRADE STAKING REQUIRED TO COMPLETE THE PROJECT.

ALL CONSTRUCTION & EXCAVATION ACTIVITIES SHALL BE CONFINED TO EASEMENTS, RIGHT-OF-WAY AND/OR WORK AREA LIMITS AS SHOWN ON DRAWING.

ALL TRAFFICWAYS INCLUDING DRIVEWAYS, ALLEYWAYS AND SIDEWALKS SHALL REMAIN ACCESSIBLE TO RESIDENTIAL AND EMERGENCY VEHICLES DURING PROJECT DURATION UNLESS OTHER ARRANGEMENTS WITH THE PROPERTY OWNER ARE MADE.

TRAFFIC CONTROL SHALL BE THE SOLE RESPONSIBILITY OF THE CONTRACTOR. THE CONTRACTOR SHALL PROVIDE, PLACE, AND MAINTAIN ALL BARRIERS (CONES, BARRELS, ETC.) AND SAFETY PERSONNEL (FLAGMEN) AS NECESSARY FOR A SAFE WORKING ENVIRONMENT.

CONTRACTOR SHALL REMOVE, PRESERVE, AND REPLACE ALL SIGNS, MAILBOXES, FENCES AND THE LIKE WITHIN THE LIMITS OF THE PROPOSED IMPROVEMENTS.

CONTRACTOR SHALL PRESERVE ALL TREES & SHRUBBERY LOCATED WITHIN THE CONSTRUCTION EASEMENT AND RIGHT-OF-WAY UNLESS OTHERWISE NOTED.

ALL SURFACES (CONCRETE, ASPHALT, GRAVEL OR DIRT) AND THEIR APPURTENANCES (CURBS, CULVERTS, ETC.) DISTURBED DURING CONSTRUCTION SHALL BE REPLACED WITH LIKE MATERIALS PER PLANS & SPECIFICATIONS.

DURING ALL CONSTRUCTION ACTIVITIES, CARE SHALL BE TAKEN TO PREVENT DAMAGE TO ADJACENT STRUCTURES, BURIED PIPING & UTILITIES. REPAIR OF ALL STRUCTURES, PIPING &/OR UTILITIES DAMAGED DURING CONSTRUCTION SHALL BE AT THE CONTRACTORS EXPENSE & TO THEIR ORIGINAL CONDITION.

CONTRACTOR SHALL BE RESPONSIBLE FOR COORDINATION OF ALL CONSTRUCTION WITH ALL UTILITIES AND APPROPRIATE GOVERNING BOARDS.

CONTRACTOR SHALL EXERCISE CAUTION TO GUARD AGAINST THE DEGRADATION OF THE WATERS OF THE STATE DUE TO CONSTRUCTION RELATED POLLUTANTS (SILT, DEBRIS, AND PETROLEUM PRODUCTS).

FOR THE PURPOSES OF CONTROLLING EROSION AND DISCHARGE OF SEDIMENT FROM THE PROJECT SITE, THE CONTRACTOR SHALL PLACE NECESSARY EROSION CONTROL DEVICES PRIOR TO BEGINNING CONSTRUCTION ACTIVITIES. EROSION CONTROL MEASURES SHALL BE REMOVED ONCE CONSTRUCTION IS COMPLETE AND ALL AREAS HAVE BEEN STABILIZED IN ACCORDANCE WITH THE SITE SPECIFIC LAND DISTURBANCE PERMIT.

OPEN BURNING SHALL NOT BE ALLOWED ON SITE.

ALL WORK SHALL BE COMPLETED IN ACCORDANCE WITH ALL FEDERAL, STATE, AND LOCAL REGULATIONS.



ALLGEIER, MARTIN and ASSOCIATES, INC.
CONSULTING ENGINEERS and SURVEYORS
7231 EAST 24th STREET JOPLIN, MISSOURI 64804 (417) 680 - 7200

THIS DRAWING IS A DOCUMENT OF SERVICE
AND IS THE PROPERTY OF ALLGEIER, MARTIN
and ASSOCIATES, INC. THIS DOCUMENT SHALL
NOT BE USED ON THIS OR OTHER PROJECTS
WITHOUT THE WRITTEN CONSENT OF
ALLGEIER, MARTIN and ASSOCIATES, INC.
CERTIFICATE OF AUTHORITY
MISSOURI NO. 000427




DATE	REVISION
ADDENDUM 2-HANDRAIL & 24" FES	

DWN. BY:	AJM
CKD. BY:	MRA/TGG
APPD. BY:	AJM
DATE:	02/16/2026


QUANTITIES
CROSBY PARK TO ROBINSON ELEMENTARY TAP-9900 (791)
CITY OF AURORA

DWG. NO.

2

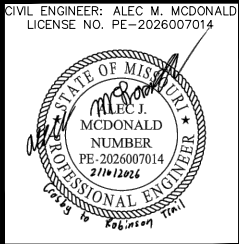


Z:\AURORA MO\CITY OF AURORA\TRANSPORTATION\WHITE PARK TO CROSBY PARK TAP-9901(791)\DRAWINGS\5 TRAIL PLAN.DWG

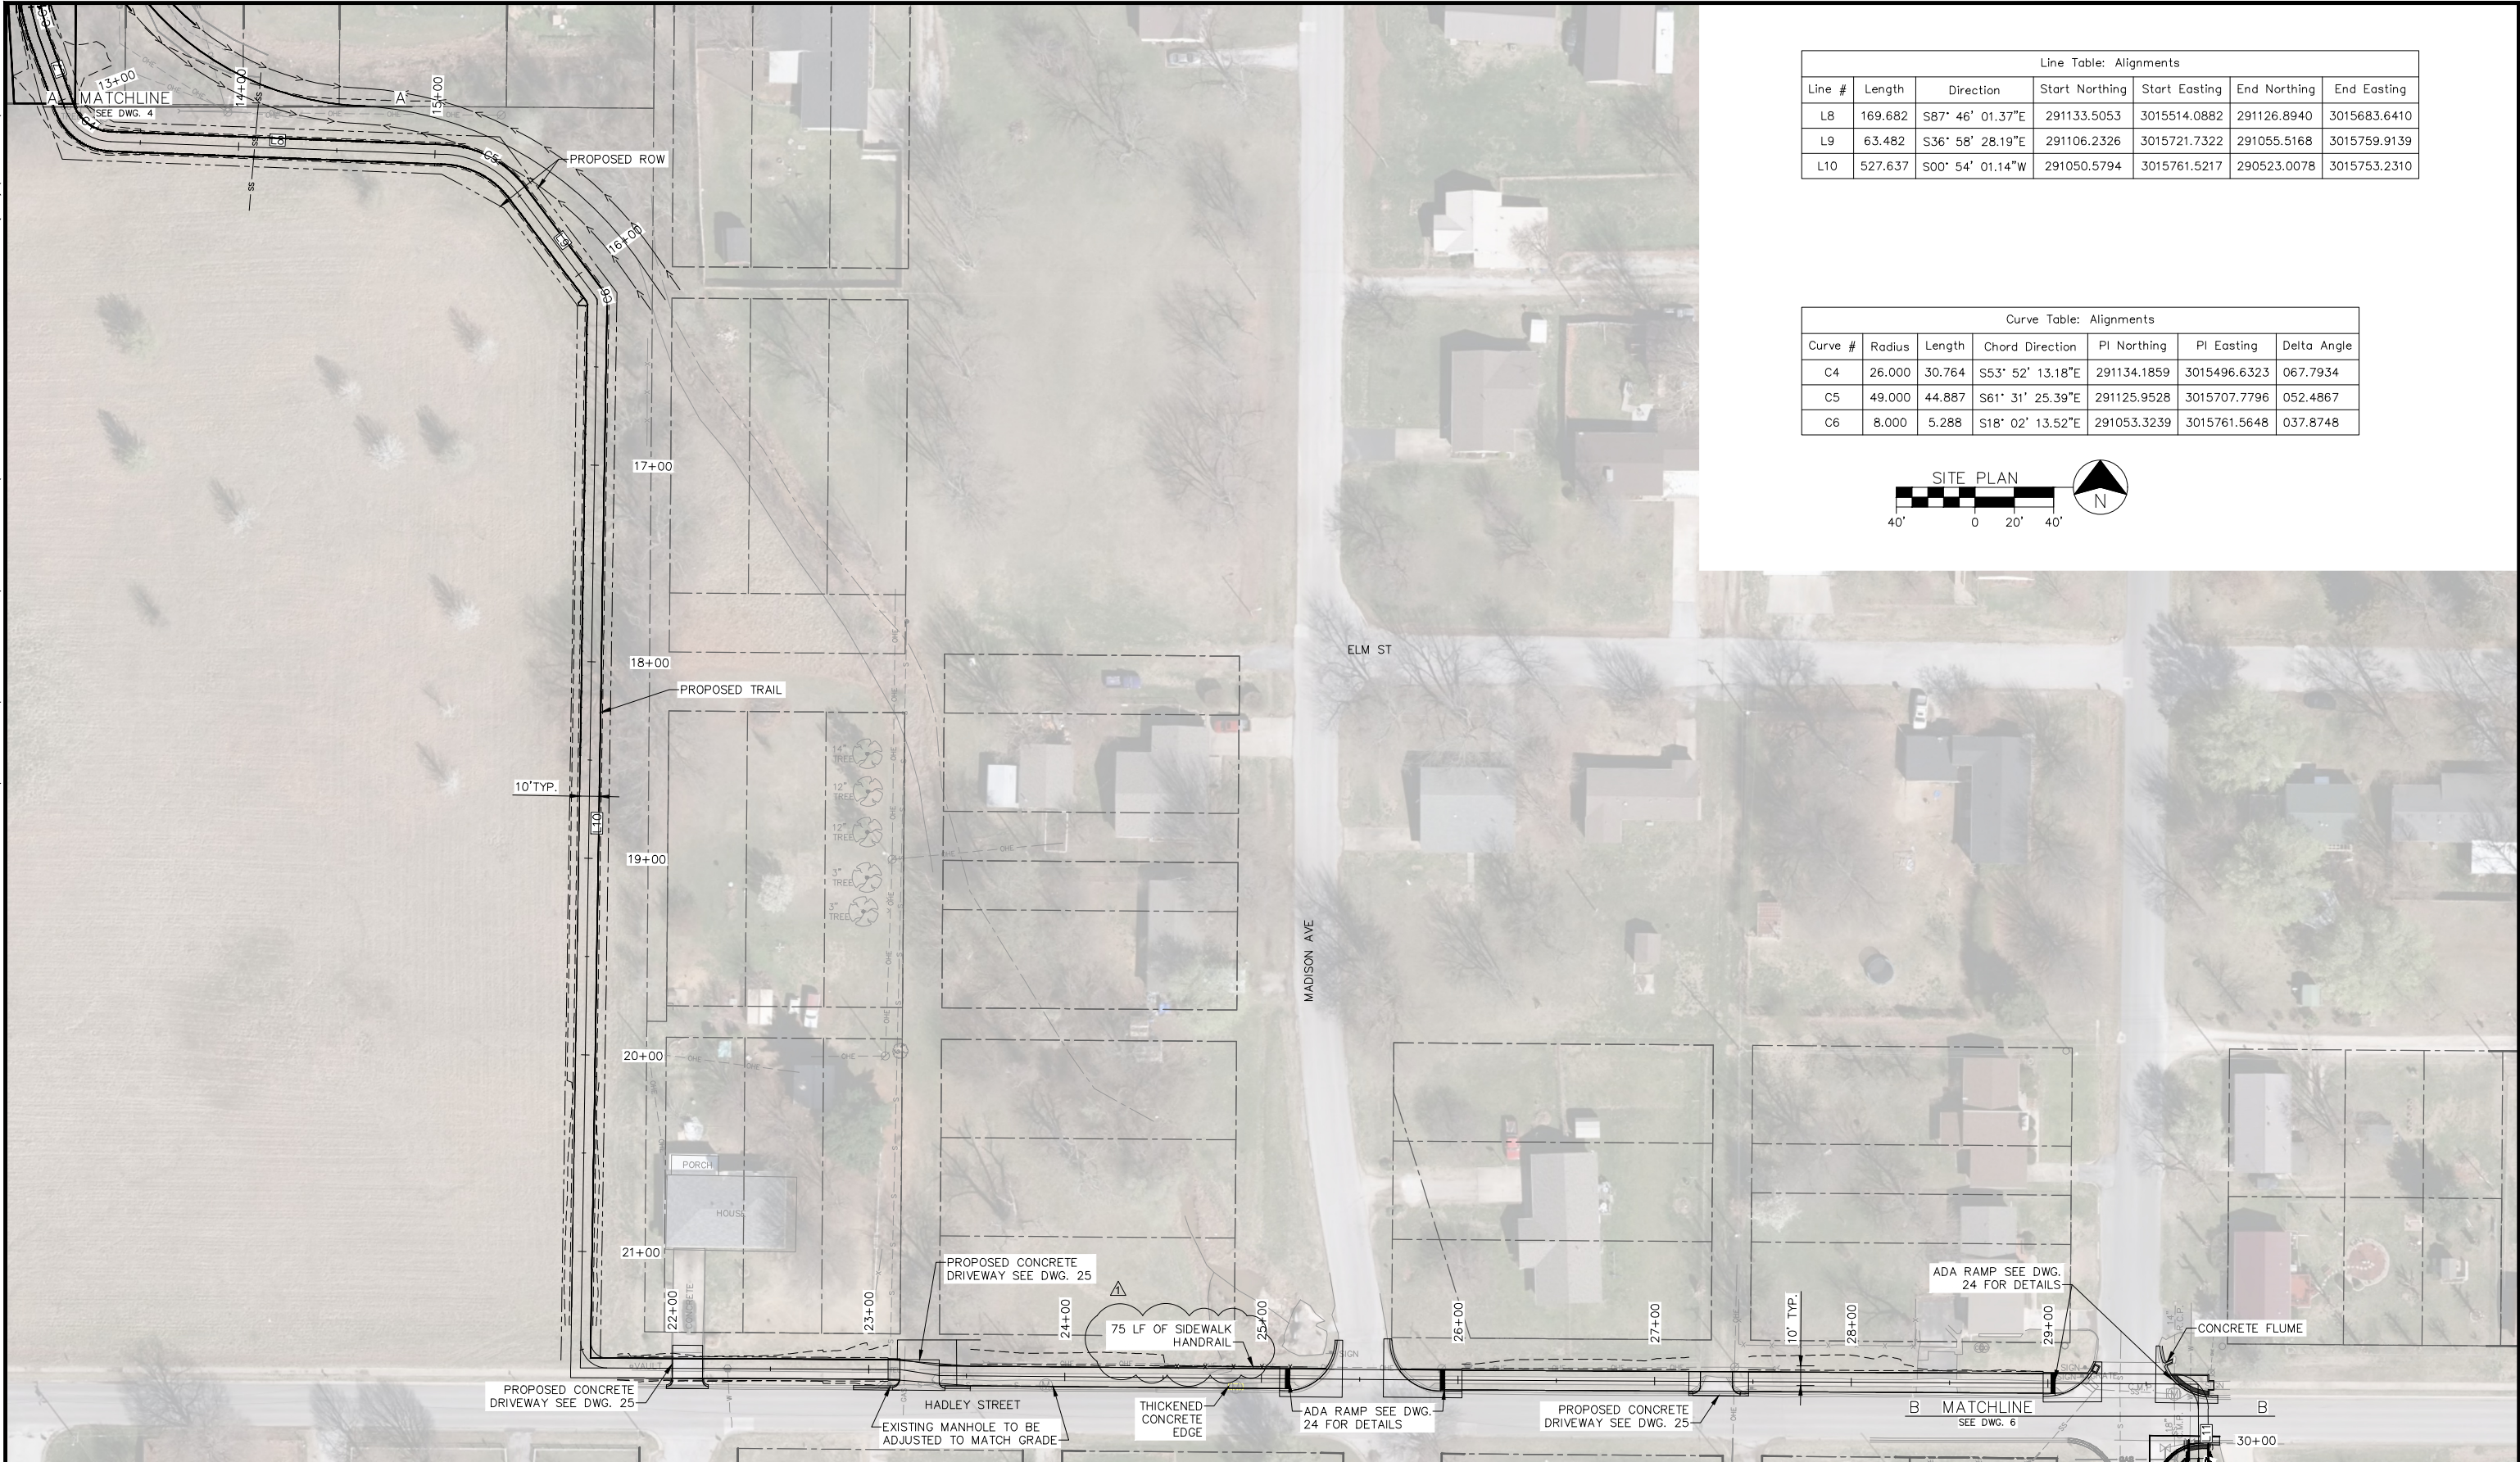

Line Table: Alignments						
Line #	Length	Direction	Start Northing	Start Easting	End Northing	End Easting
L8	169.682	S87° 46' 01.37"E	291133.5053	3015514.0882	291126.8940	3015683.6410
L9	63.482	S36° 58' 28.19"E	291106.2326	3015721.7322	291055.5168	3015759.9139
L10	527.637	S00° 54' 01.14"W	291050.5794	3015761.5217	290523.0078	3015753.2310

Curve Table: Alignments						
Curve #	Radius	Length	Chord Direction	PI Northing	PI Easting	Delta Angle
C4	26.000	30.764	S53° 52' 13.18"E	291134.1859	3015496.6323	067.7934
C5	49.000	44.887	S61° 31' 25.39"E	291125.9528	3015707.7796	052.4867
C6	8.000	5.288	S18° 02' 13.52"E	291053.3239	3015761.5648	037.8748

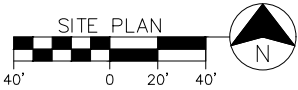

ALLGEIER, MARTIN and ASSOCIATES, INC.
CONSULTING ENGINEERS and SURVEYORS
7231 EAST 24th STREET JOPLIN, MISSOURI 64804 (417) 680 - 7200

THIS DRAWING IS A DOCUMENT OF SERVICE
AND IS THE PROPERTY OF ALLGEIER, MARTIN
AND ASSOCIATES, INC. THIS DOCUMENT SHALL
NOT BE USED ON THIS OR OTHER PROJECTS
WITHOUT THE WRITTEN CONSENT OF
ALLGEIER, MARTIN AND ASSOCIATES, INC.
CERTIFICATE OF AUTHORITY
MISSOURI NO. 000427


DATE	REVISION
Δ	ADDENDUM 2-HANDRAIL

DWN. BY: AJM
CKD. BY: MRA/TGG
APPD. BY: AJM
DATE: 02/16/2026


TRAIL PLAN
CROSBY PARK TO ROBINSON ELEMENTARY TAP-9900 (791)
CITY OF AURORA

DWG. NO.

5

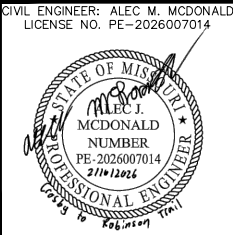


Z:\AURORA MO\CITY OF AURORA\TRANSPORTATION\WHITE PARK TO CROSBY PARK TAP-9901(791)\DRAWINGS\6 TRAIL PLAN.DWG

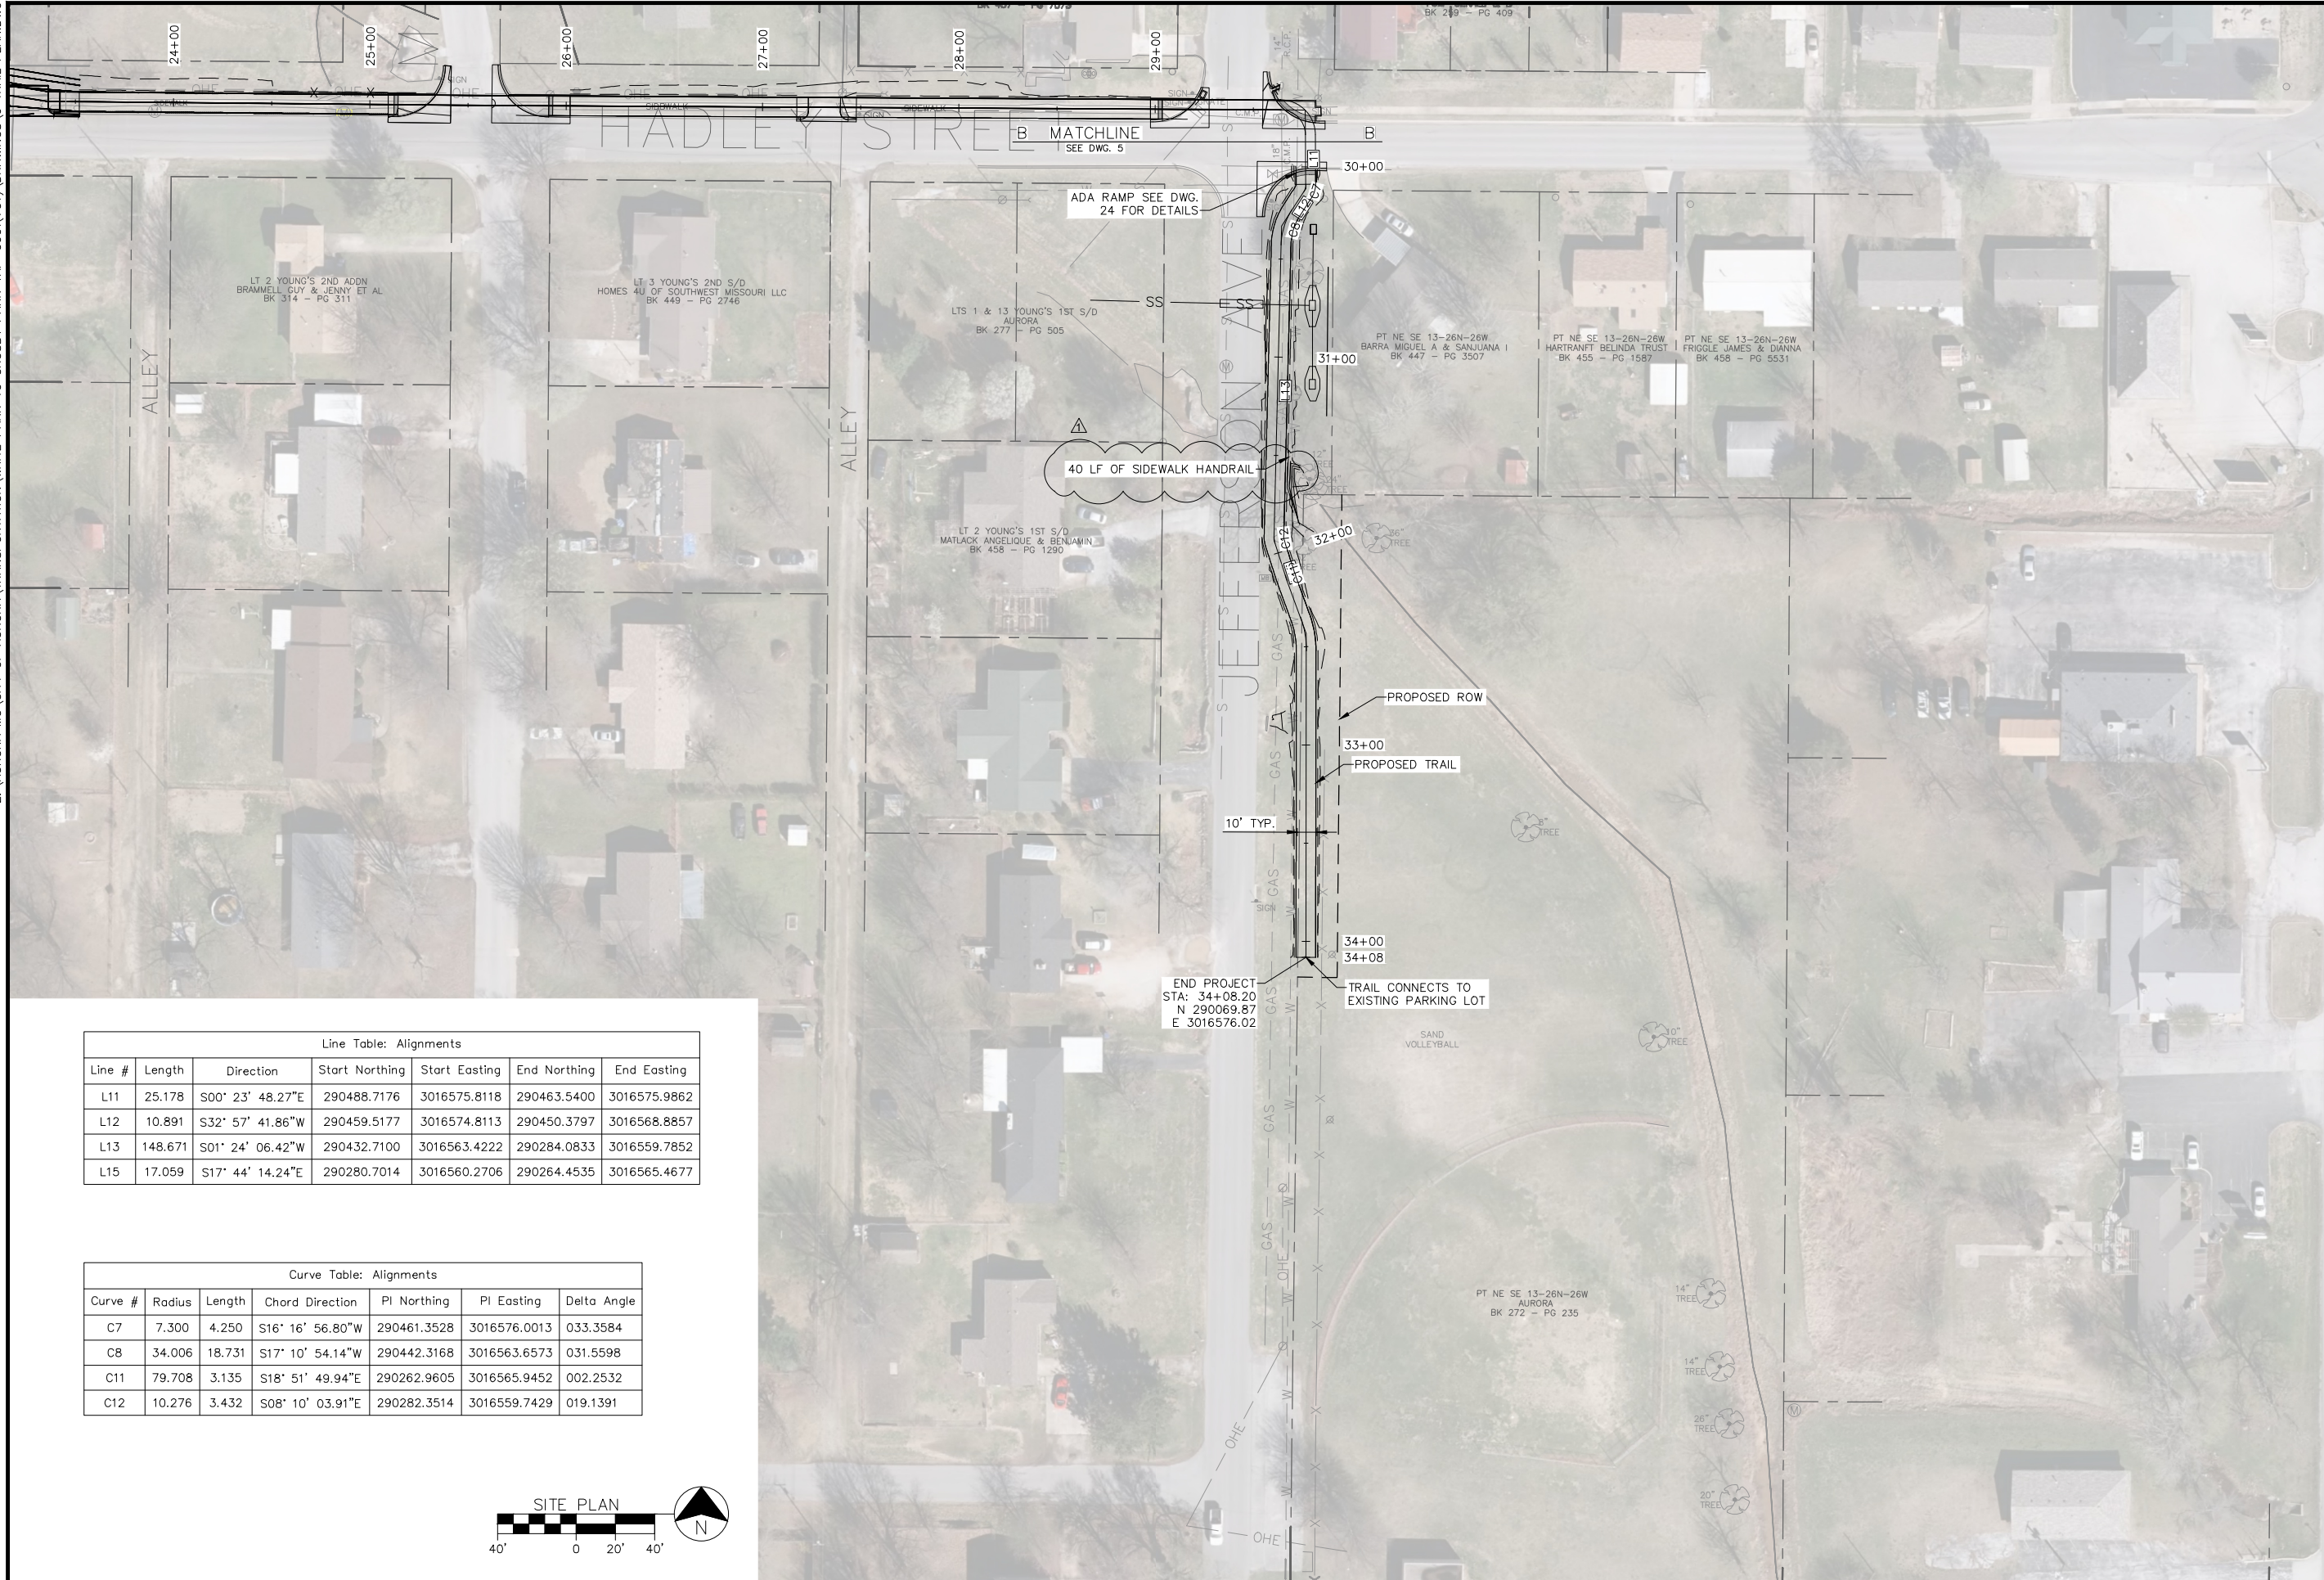

Line Table: Alignments						
Line #	Length	Direction	Start Northing	Start Easting	End Northing	End Easting
L11	25.178	S00° 23' 48.27"E	290488.7176	3016575.8118	290463.5400	3016575.9862
L12	10.891	S32° 57' 41.86"W	290459.5177	3016574.8113	290450.3797	3016568.8857
L13	148.671	S01° 24' 06.42"W	290432.7100	3016563.4222	290284.0833	3016559.7852
L15	17.059	S17° 44' 14.24"E	290280.7014	3016560.2706	290264.4535	3016565.4677

Curve Table: Alignments						
Curve #	Radius	Length	Chord Direction	PI Northing	PI Easting	Delta Angle
C7	7.300	4.250	S16° 16' 56.80"W	290461.3528	3016576.0013	033.3584
C8	34.006	18.731	S17° 10' 54.14"W	290442.3168	3016563.6573	031.5598
C11	79.708	3.135	S18° 51' 49.94"E	290262.9605	3016565.9452	002.2532
C12	10.276	3.432	S08° 10' 03.91"E	290282.3514	3016559.7429	019.1391

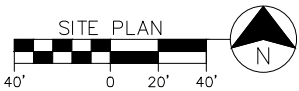

ALLGEIER, MARTIN and ASSOCIATES, INC.
CONSULTING ENGINEERS and SURVEYORS
7231 EAST 24th STREET JOPLIN, MISSOURI 64804 (417) 680 - 7200

THIS DRAWING IS A DOCUMENT OF SERVICE
AND IS THE PROPERTY OF ALLGEIER, MARTIN
AND ASSOCIATES, INC. THIS DOCUMENT SHALL
NOT BE USED ON THIS OR OTHER PROJECTS
WITHOUT THE WRITTEN CONSENT OF
ALLGEIER, MARTIN AND ASSOCIATES, INC.
CERTIFICATE OF AUTHORITY
MISSOURI NO. 000427

DATE	REVISION
02/16/2026	ADDENDUM 2-HANDRAIL

DWN. BY: **AJM**
CKD. BY: **MRA/TGG**
APPD. BY: **AJM**
DATE: **02/16/2026**

TRAIL PLAN
CROSBY PARK TO ROBINSON ELEMENTARY TAP-9900 (791)
CITY OF AURORA

DWG. NO.

6

CIVIL ENGINEER: ALEC M. McDONALD
LICENSE NO. PE-2026007014

Alec M. McDonald
Professional Engineer
State of Missouri
License No. PE-2026007014
2/16/2026

THIS DRAWING IS A DOCUMENT OF SERVICE
AND IS THE PROPERTY OF ALLGEIER, MARTIN
and ASSOCIATES, INC. THIS DOCUMENT SHALL
NOT BE USED ON THIS OR OTHER PROJECTS
WITHOUT THE WRITTEN CONSENT OF
ALLGEIER, MARTIN and ASSOCIATES, INC.

CERTIFICATE OF AUTHORITY
MISSOURI NO. 000427

DWN. BY:	AJM
CKD. BY:	MRA/TGG
APPD. BY:	AJM
DATE :	02/16/2026

DWG. NO.

CIVIL ENGINEER: ALEC M. MCDONALD
LICENSE NO. PE-2026007014

