

October 23, 2026

ADDENDUM NO. #2
City of Arnold, MO
Pomme Road Reconstruction

This addendum forms a part of the bidding and contract documents and modifies the bidding documents. Acknowledge receipt of this addendum in space provided on Bid Form. **FAILURE TO DO SO MAY SUBJECT BIDDER TO DISQUALIFICATION.**

Clarifications:

1. Dowel supporting units as shown on MoDOT Standard Plan 502.10L are not required for Pay Item 5021107 – Concrete Pavement (7 IN. Non-Reinf).
2. Ameren work to relocate existing utility poles is anticipated to begin the week of October 26th and be completed by November 15th.
3. Rock excavation encountered as part of the construction of storm pipe or structures shall be included in the unit cost of the respective pay item as indicated in JSP LL – Storm Sewer Construction Requirements.
4. A bid item has been established for any rock excavation, Pay Item 2032000 – Class C Excavation, required as part of roadway work. The bid item has been added to the Itemized Bid Sheets.
5. The anticipated schedule is for the project to be awarded in December 2026 with tree clearing in Winter 2027. Road closures and construction is anticipated to begin in early Spring 2027.

Drawings:

1. Summary of Quantities (Sheet 4 of 89) – Revised quantities
2. Schedules (Sheet 8 of 89) – Revised Entrance Schedule
3. Plan Sheets (Sheet 18 of 89) – Revised easternmost entrance at 1835 Pomme Road, widened entrance

Specifications:

1. Table of Contents – Deleted reference to General Provisions (other than MoDOT)
2. Itemized Bid Sheets – Revised Bid Form to reflect revised quantities.

Addendum #2 consists of 2 page of text and the following attachments:

Sheets 3, 8, and 18 of STP-XXX(XXX) – Pomme Road Reconstruction – Final Plans

Table of Contents
Itemized Bid Sheets

RETURN ONE SIGNED COPY TOGETHER WITH YOUR PROPOSAL

Addendum No. 2 is hereby acknowledged.

Name of Bidder: _____


By: _____ Title: _____

Address: _____

Telephone: _____ Date: _____

SUMMARY OF QUANTITIES				
JSP	ITEM NO.	DESCRIPTION	UNIT	TOTAL QUANTITY
	2013000	CLEARING AND GRUBBING	LS	1
*	2022010	REMOVAL OF IMPROVEMENTS	LS	1
	2031000	CLASS A EXCAVATION	CUYD	9,622
	2036000	COMPACTING EMBANKMENT	CUYD	1,558
	3040504	TYPE 5 AGGREGATE FOR BASE (4 IN. THICK)	SQYD	16,335
	3101002	GRAVEL (A)	TONS	100
	3101003	GRAVEL (A)	SQYD	230
	4011209	BITUMINOUS PAVEMENT MIXTURE PG64-22, (BP-1)	TONS	392.2
	4013000	BITUMINOUS PAVEMENT MIXTURE PG64-22 (BASE)	TONS	984.9
	4071005	TACK COAT	GAL	183
	5021107	CONCRETE PAVEMENT (7 IN. NON-REINF)	SQYD	8,158.5
*	6039902{1}	ADJUST WATER SERVICE METER AND VALVE BOX TO GRADE	EA	38
*	6039902{2}	REMOVE AND RELOCATE FIRE HYDRANT ASSEMBLY	EA	1
	6042010	ADJUSTING MANHOLE	EA	5
	6046012A	12 IN. SLOTTED DRAIN	LF	112
	6071102	MODIFIED CONCRETE GUTTER TYPE B	LF	321
	6072010	WOVEN WIRE FENCE	LF	113
*	6079903	ALUMINUM HANDRAIL FOR RETAINING WALLS	LF	579
	6081012	TRUNCATED DOMES	SQFT	194
	6085007	PAVED APPROACH, 7 IN.	SQYD	1,051.3
	6086007	CONCRETE SIDEWALK, 7 IN.	SQYD	99.8
*	6089905	CONCRETE SIDEWALK, 5 IN	SQYD	1,535.8
	6091051	CURB AND GUTTER TYPE A	LF	708
	6091052	CURB AND GUTTER TYPE B	LF	5,616
*	6099903	30 IN MAX REINFORCED CURB AS RETAINING WALL	LF	31
*	6099907	CONCRETE ENCASEMENT	CUYD	1
	6113020	FURNISHING TYPE 2 ROCK BLANKET	CUYD	145
	6113040	PLACING TYPE 2 ROCK BLANKET	CUYD	145

SUMMARY OF QUANTITIES				
JSP	ITEM NO.	DESCRIPTION	UNIT	TOTAL QUANTITY
*	6149902{1}	PRECAST CONCRETE SINGLE CURB INLET	EA	25
*	6149902{2}	PRECAST CONCRETE DOUBLE CURB INLET	EA	11
*	6149902{3}	PRECAST CONCRETE AREA INLET	EA	5
*	6149902{4}	PRECAST CONCRETE RETAINING WALL INLET	EA	2
	6161005	CONSTRUCTION SIGNS	SQFT	714
	6161030	TYPE 3 MOVEABLE BARRICADE	EA	12
	6161099	CHANGEABLE MESSAGE SIGN WITH COMMUNICATION INTERFACE, CONTRACTOR FURNISHED / RETAINED	EA	3
	6181000	MOBILIZATION	LS	1
	6200015	PREFORMED THERMOPLASTIC PAVEMENT MARKING, 24 IN. WHITE	LF	421
	6205303B	TEMPORARY REMOVABLE MARKING TAPE 4 IN., YELLOW	LF	6,161
	6205309	TEMPORARY REMOVABLE MARKING TAPE, 24 IN., WHITE	LF	109
	6206001D	4 IN. YELLOW CLASS 1 PAVEMENT MARKING PAINT (18-MIL, TYPE P BEADS)	LF	6,161
	6274000	CONTRACTOR FURNISHED SURVEYING AND STAKING	LS	1
*	6279901	AS BUILT PLANS	LS	1
*	7209904	LARGE-BLOCK RETAINING WALL	SQFT	3,955
	7250312A	12 IN. PIPE GROUP B	LF	33
	7250315A	15 IN. PIPE GROUP B	LF	1,438
	7250318A	18 IN. PIPE GROUP B	LF	550
	7250324A	24 IN. PIPE GROUP B	LF	390
	7250348A	48 IN. PIPE GROUP B	LF	158
	7250360A	60 IN. PIPE GROUP B	LF	20
*	7259903	24 IN. X 36 IN. ELLIPTICAL PIPE GROUP B	LF	34
	7269923	8 IN. PVC SANITARY SEWER PIPE	LF	423
*	7319902{1}	PRECAST CONCRETE MANHOLE - 48 IN.	EA	4
*	7319902{2}	PRECAST CONCRETE MANHOLE - 72 IN.	EA	4
	7320615A	15 IN. OR ALLOWED SUBSTITUTE GROUP A FLARED END SECTION	EA	2
	7320648A	48 IN. OR ALLOWED SUBSTITUTE GROUP A FLARED END SECTION	EA	3
	7320660A	60 IN. OR ALLOWED SUBSTITUTE GROUP A FLARED END SECTION	EA	1

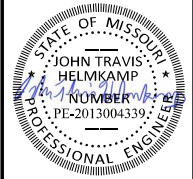

JOHN TRAVIS HELMKAMP
PROFESSIONAL ENGINEER
LICENSE NO. 2013004339

DATE PREPARED
10/23/2026

DISTRICT SL STATE MO

SHEET NO.
4

COUNTY
JEFFERSON

ROUTE
POMME RD

OA JOB NO.
223021

PROJECT NO.
STP-5445(608)

BRIDGE NO.
N/A

DATE	DESCRIPTION
10/23	ADDENDUM #2

ST. LOUIS
720 Olive, Suite 700
St. Louis, MO 63101
Tel: 314.586.8381

MISSOURI DESIGN FIRM
LICENSE NO. 001166

MISSOURI LAND SURVEY CORP
LICENSE NO. 000275

CITY OF ARNOLD
DEPARTMENT OF PUBLIC WORKS
2900 ARNOLD • MO 63010
Tel: 636.282.2386

SUMMARY OF QUANTITIES
SHEET 1 OF 3

STATE OF MISSOURI
JOHN TRAVIS
HELMKAMP
NUMBER
PE-2013004339
PROFESSIONAL ENGINEER

DATE PREPARED
10/23/2026

SHEET NO.
8

ROUTE
POMME ROAD

PROJECT NO.	STP-5445(608)
-------------	---------------

11/11							

 **OATES**
ASSOCIATES

ST. LOUIS
720 Olive, Suite 700
St. Louis, MO 63101
tel. 314.598.8381

MISSOURI DESIGN FIRM
LICENSE NO. 001166

MISSOURI LAND SURVEY CORP
LICENSE NO. 000275



CITY OF ARNOLD
DEPARTMENT OF PUBLIC WORKS
2900 ARNOLD TENBROOK ROAD
ARNOLD, MD 63010
tel 636-282-2386

SCHEDULES
SHEET 2 OF 7

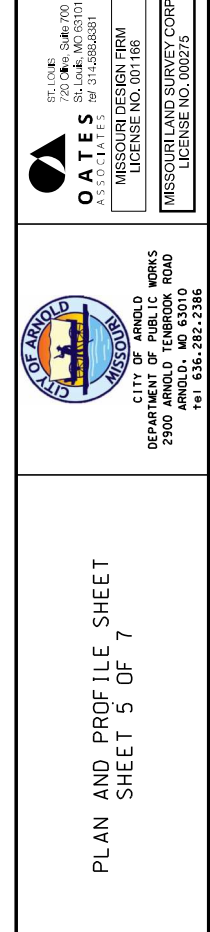
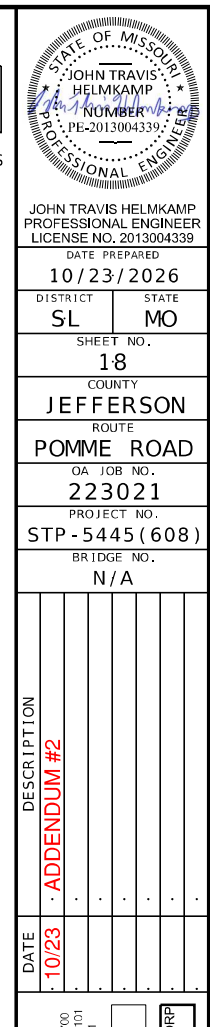


TABLE OF CONTENTS

Notice to Contractors

Proposed Work.....	(1)
Compliance With Contract Provisions.....	(2)
Period of Performance	(3)
Liquidated Damages	(4)
Bid Guaranty	(5)
Certifications for Federal Jobs	(6)
Antidiscrimination	(7)
Federal and State Inspection	(8)
Prevailing Wage.....	(9)
Worker Eligibility Requirements	(10)
OSHA Training Requirements.....	(11)
Buy America Requirements	(12)
Addendum Acknowledgement.....	(13)
Signature and Identity of Bidder	(14)
Trainees.....	(15)
Subcontractor Disclosure	(16)
Project Award	(17)
Materials Inspections.....	(18)
Prime Contractor Requirements.....	(19)
Tax Exempt Status	(20)
Retainage.....	(21)
Instructions to Bidders	(22)

Itemized Bid Sheets

Bid Bond

Bidder's List Quote Summary Form ([Fig. 136.9.12](#))

DBE Identification Submittal ([Fig. 136.9.9](#))

DBE Provisions ([Fig. 136.9.8](#))

~~General Provisions (Other Than MoDOT)~~

~~Job Special Provisions (Sample JSP's on MoDOT's Website)~~

Form FHWA 1273 ([Fig. 136.9.7](#))

Federal Aid Provisions

Applicable State Wage Rates

Applicable Federal Wage Rates

Applicable Environmental and Cultural Permits and Clearances

ADA Checklist ([Fig. 136.9.4](#))

Geotechnical Report

Contract Forms

Owner-Contractor Agreement

Contractor's Acknowledgement

Form of Contract Performance-Payment Bond

Subcontractor Approval Form

 **REVISED**

ITEMIZED BID FORM

Contractor's Name

Contractor's Address

City

State

Zip Code

Local Public Agency

County

Federal Project Number

Route(s) (Street/Road Name)

Each bidder shall specify a unit price for each of the separate items listed. The bidder shall show the products of the respective unit prices and quantities in the column provided. In cases of errors or discrepancies in extensions, the unit prices shall govern.

(For complete information covering these items, see plans and specifications)

Item Number	Items	Unit	Quantity	Unit Price	Total
ROADWAY ITEMS					
2013000	CLEARING AND GRUBBING	LS	1		
2022010	REMOVAL OF IMPROVEMENTS	LS	1		
2031000	CLASS A EXCAVATION	CUYD	9,622		
2032000	CLASS C EXCAVATION	CUYD	100		
2036000	COMPACTING EMBANKMENT	CUYD	1,558		
3040504	TYPE 5 AGGREGATE FOR BASE (4 IN. THICK)	SQYD	14,837		
3101002	GRAVEL (A)	TONS	100		
3101003	GRAVEL (A)	SQYD	230		
4011209	BITUMINOUS PAVEMENT MIXTURE PG64-22, (BP-1)	TONS	392.2		
4013000	BITUMINOUS PAVEMENT MIXTURE PG64-22 (BASE)	TONS	984.9		
4071005	TACK COAT	GAL	183		
5021107	CONCRETE PAVEMENT (7 IN. NON-REINF)	SQYD	8,158.5		
6039902{1}	ADJUST WATER SERVICE METER AND VALVE BOX TO GRADE	EA	38		
6039902{2}	REMOVE AND RELOCATE FIRE HYDRANT ASSEMBLY	EA	1		
6042010	ADJUSTING MANHOLE	EA	5		
6046012A	12 IN. SLOTTED DRAIN	LF	112		
6071102	MODIFIED CONCRETE GUTTER TYPE B	LF	321		
6072010	WOVEN WIRE FENCE	LF	113		
6079903	ALUMINUM HANDRAIL FOR RETAINING WALLS	LF	579		
6085007	PAVED APPROACH, 7 IN.	SQYD	1,051.3		
6091051	CURB AND GUTTER TYPE A	LF	708		
6091052	CURB AND GUTTER TYPE B	LF	5,616		
6099907	CONCRETE ENCASEMENT	CUYD	1		
6113020	FURNISHING TYPE 2 ROCK BLANKET	CUYD	145		
6113040	PLACING TYPE 2 ROCK BLANKET	CUYD	145		
6149902{1}	PRECAST CONCRETE SINGLE CURB INLET	EA	25		
6149902{2}	PRECAST CONCRETE DOUBLE CURB INLET	EA	11		
6149902{3}	PRECAST CONCRETE AREA INLET	EA	5		
6149902{4}	PRECAST CONCRETE RETAINING WALL INLET	EA	2		
6161005	CONSTRUCTION SIGNS	SQFT	714		
6161030	TYPE 3 MOVEABLE BARRICADE	EA	12		
6161099	CHANGEABLE MESSAGE SIGN WITH COMMUNICATION INTERFACE, CONTRACTOR FURNISHED / RETAINED	EA	3		

6181000	MOBILIZATION	LS	1		
6274000	CONTRACTOR FURNISHED SURVEYING AND STAKING	LS	1		
6279901	AS BUILT PLANS	LS	1		
7209904	LARGE-BLOCK RETAINING WALL	SQFT	3,955		
7250312A	12 IN. PIPE GROUP B	LF	33		
7250315A	15 IN. PIPE GROUP B	LF	1,438		
7250318A	18 IN. PIPE GROUP B	LF	550		
7250324A	24 IN. PIPE GROUP B	LF	390		
7250348A	48 IN. PIPE GROUP B	LF	158		
7250360A	60 IN. PIPE GROUP B	LF	20		
7259903	24 IN. X 36 IN. ELLIPTICAL PIPE GROUP B	LF	34		
7269923	8 IN. PVC SANITARY SEWER PIPE	LF	423		
7319902{1}	PRECAST CONCRETE MANHOLE - 48 IN.	EA	4		
7319902{2}	PRECAST CONCRETE MANHOLE - 72 IN.	EA	4		
7320615A	15 IN. OR ALLOWED SUBSTITUTE GROUP A FLARED END SECTION	EA	2		
7320648A	48 IN. OR ALLOWED SUBSTITUTE GROUP A FLARED END SECTION	EA	3		
7320660A	60 IN. OR ALLOWED SUBSTITUTE GROUP A FLARED END SECTION	EA	1		
8052000A	SEEDING - WARM SEASON GRASSES	ACRE	1.9		
8061003	SEDIMENT TRAP EXCAVATION	CUYD	12.4		
8061004	SEDIMENT TRAP ROCK	CUYD	12.4		
8061005	ROCK DITCH CHECK	LF	126		
8061007A	CURB INLET CHECK	EA	48		
8061016	SEDIMENT REMOVAL	CUYD	96		
8061017	TEMPORARY SEEDING	ACRE	1.9		
8061019	SILT FENCE	LF	3,387		
ROADWAY ITEMS SUBTOTAL					
BICYCLE / PEDESTRIAN ITEMS					
3040504	TYPE 5 AGGREGATE FOR BASE (4 IN. THICK)	SQYD	1,498		
6081012	TRUNCATED DOMES	SQFT	194		
6086007	CONCRETE SIDEWALK, 7 IN.	SQYD	100		
6089905	CONCRETE SIDEWALK, 5 IN	SQYD	1,536		
6099903	30 IN MAX REINFORCED CURB AS RETAINING WALL	LF	31		
BICYCLE / PEDESTRIAN ITEMS SUBTOTAL					
SIGNING / STRIPING / SIGNAL ITEMS					
6200015	PREFORMED THERMOPLASTIC PAVEMENT MARKING, 24 IN. WHITE	LF	421		
6205303B	TEMPORARY REMOVABLE MARKING TAPE 4 IN., YELLOW	LF	6,161		
6205309	TEMPORARY REMOVABLE MARKING TAPE, 24 IN., WHITE	LF	109		
6206001D	4 IN. YELLOW CLASS 1 PAVEMENT MARKING PAINT (18-MIL, TYPE P BEADS)	LF	6,161		
9031250A	U-CHANNEL POST, 3 LB	LF	183		
9035004A	SH-FLAT SHEET	SQFT	103		
9039902	RELOCATING EXISTING SIGN TO NEW POST	EA	11		
SIGNING / STRIPING / SIGNAL ITEMS SUBTOTAL					

Bidder's Total Proposal