

# ADDENDUM NO. 2

March 10, 2025

Notice to All Persons and Firms Proposing to Submit a Bid or Furnish Materials for:

St. Vincent Greenway-187 Phase 1: Ferguson Ave, Great Rivers Greenway Project No. - 220044 Federal Project No. STP-9901(666)

The construction contract for this project has been revised as follows:

### No. 1

# Clarification and additional information regarding Sod:

- Job Special Provision 800.10.1 Sodding states that Zoysia sod shall be paid for by Bid Item 803-10.10 Sodding (Zoysia) or at twice the contract unit price for Bid Item No. 803-10.00 Sodding when no bid item is included in the contract for Zoysia sod.
- No bid item for 803-10.10 Sodding (Zoysia) was included in the contract.
- If needed, Zoysia Sod would be paid at twice the contract unit price for Bid Item No. 803-10.10 Sodding.
- This provision for Zoysia sod is used as a contingency when areas disturbed with zoysia grass have not been identified and the existing yard is not Fescue (as specified on plan sheet no. 90 of 106).
- The use of Fescue sod has been clarified by deleting reference on sheet 90 of 106.
- Added note 3 on Sheet 90 of 106 indicating that sodding shall be in accordance with Saint Louis County Standard Specification for Roadway and Bridge Construction Section 803 and Job Special Provision 800.10.1.
- Remove and replace Plan Sheet No. 90 of 106 with the attached Plan Sheet No. 90 of 106.



Addendum No. 2 St. Vincent Greenway Page 2

### No. 2

# Clarification and additional information regarding Topsoil and Amended Soils:

- Sheet 14 of 106 Clarified "Soil Mix "A"" and "Transition Layer" by revising nomenclature to "Topsoil" and "Till Subgrade". Notes detailing associated work and clarifying work incidental to other items have been added to Sheet 14 of 106.
- Revised quantities and locations for Pay Items Nos. 804-10.00 and 804-20.01 on Construction Plan Sheets Nos. 22 and 24 of 106.
- Clarify the nomenclature of Soil Mix "A" versus Topsoil. In this case the terms are being used interchangeably.
- Remove and replace Plan Sheet Nos. 14, 22 and 24 with the attached Plan Sheet Nos. 14, 22, and 24.

# No. 3

• Remove and replace the Table of Contents with the attached Table of Contents.

## No. 4

• Remove Job Special Provision 100.10.22, Prevailing Hourly Wage Rates Non-Discrimination from the Contract Book.

### No. 5

• Remove Federal Wage Determination, MO20230001 (January 3, 2025) from the Contract Book.

ATTENTION BIDDERS: THE ADDENDUM ACKNOWLEDGEMENT IN THE BID DOCUMENTS MUST BE COMPLETED AND SUBMITTED WITH ALL BID PROPOSALS.

Regards,

Contracts Manager

ilealler

Department of Transportation and Public Works

1050 North Lindbergh Boulevard

Creve Coeur, MO 63132

Attachments: Updated Table of Contents

Revised Plan Sheets Nos. 14, 22, 24 and 90

# **TABLE OF CONTENTS**

St. Vincent Greenway-187B Phase 1: Ferguson Avenue

# SECTION A: SPECIAL PROVISIONS TO THE GENERAL SPECIFICATIONS

100 10 1	0, 1, 10, 7, 7, 10, 1, 10, 1
100.10.1	Standard Specifications and Standard Drawings
100.10.2	Completion of Project
100.10.3	Working Restrictions
100.10.4	Addendums
100.10.5	Construction Documents Provided to Contractors
100.10.6	Bid Validity, Bid Award and Execution of Contract
100.10.8	Compliance with Air and Water Acts
100.10.10	Control of Material (Certified Test Results)
100.10.11	Proof of Minority/Women Owned Business Enterprise (M/WBE) Subcontract Goal Attainment Pursuant to Section 107.071 SLCRO
100.10.12	Subcontractor Mobilization Payment Requirements
100.10.14	Instructions for Compliance with Section 285-530(2)
100.10.15	Interest of Members, Officers or Employees, and Former Members, Officers or
	Employees
100.10.16	Revised Insurance Specification
100.10.20	OSHA Ten Hour Training Requirements
100.10.23	Prevailing Hourly Wage Rates Special Labor Provisions – State of Missouri
100.10.24	Contract Subletting Requirements
100.20.1	Buy America Requirements
100.20.2	Differing Site Conditions, Suspensions of Work and Significant Changes in the
	Character of Work (Title 23, CFR 635.109 - May, 2019)
100.20.3	Inspection by State and Federal Officials
100.20.5	Non-Discrimination in Employment (July, 1990)
100.20.6	Wage Rates
100.20.10	Americans with Disabilities Act (ADA) Compliance and Final Acceptance of Constructed Facilities
100.30.5	Supplementary Reporting Requirements (Revised December 2023)
100.40.6	Local Programs Permit for Work on MoDOT Right-of-Way
100.60.1	MSD Acceptance for Maintenance
100.60.2	MSD Permit and Inspection
100.60.3	MSD Standards
100.70.5	Railroad Permits, Agreements, and Licenses
100.80.3	Time Limit on Driveway Closures
100.80.4	Project Assurances
100.80.6	Prohibition on Certain Telecommunication and Video Surveillance Services and
	Equipment
200.30.1	Land Disturbance Permit
200.60.1	Tree Removal
300.10.1	Aggregate Base

# Addendum No. 2 / St. Vincent Greenway-187 Phase 1: Ferguson Avenue / Great Rivers Greenway Project No. 220044 / STP-9901(666)

400.10.2	Estimation Factors for Asphalt Items
500.10.1	Dowels and Bent Bars
600.10.2	Existing Sprinkler Systems
600.50.1	Concrete Sidewalk (Saw Cutting Existing Asphalt Pavement)
600.80.1	Advance Project Signing
600.80.2	Traffic Control Devices
600.80.6	Lump Sum Traffic Control (All Inclusive)
600.80.13	Edge Drop-Off Treatment and Type "5" Aggregate
600.80.15	Work Zone Traffic Management Plan (Revised October 2023)
600.80.16	Mobilization
800.10.1	Sodding
800.30.1	Contractor Duty to Comply
800.30.2	Public Notification Sign for Land Disturbance Site
800.30.3	Storm Water Pollution Prevention Plan (SWPPP) & Land Disturbance Permit
800.30.4	Contractor Employee SWPPP Training
800.30.6	Concrete Waste Management
800.30.8	Restriction on Particulate Matter
900.10.1	Final Striping
1100.60.2	Temporary Project Water Pollution Control (Maintenance Projects)

# SECTION B: SPECIAL PROVISIONS TO THE GENERAL SPECIFICATIONS

Α	Maintenance of Traffic
B.	Utilities Coordination
C.	Pavement Markings
D.	Linear Grading
E.	Drainage Structures
F.	Metro (Bi-State Development Agency) Coordination
G.	Emergency Blue Call Light
H.	Bicycle Railing, 54"
I.	Tree Protection
J.	Existing Tree Pruning
K.	Green Way and Regulatory Signage
L.	Protection of Private Property
M.	Required Permits
N.	Polyethylene Pedestrian Barrier
Ο.	Precast Drainage Structures
P.	Concrete Steps
Q.	Soil Amendment

R.

**Plants** 

# PLANTING SCHEDULE

SYM	QTY	BOTANICAL NAME	CULTIVAR	COMMON NAME	CONTAINER TYPE	PLANT SIZE	SPACING	DETAIL	COMMENTS
_I TU	1	Liriodendron tulipifera		Tulip Tree	B&B	2.5" Cal.	See Plan		
			EVER	GREEN SHI	RUBS - FERG	SUSON			
SYM	QTY	BOTANICAL NAME	CULTIVAR	COMMON NAME	CONTAINER TYPE	PLANT SIZE	SPACING	DETAIL	COMMENTS
ou gr	14	Buxus x	Green Velvet	Green Velvet Boxwood	Container	5 Gal.	3' O.C.		
			HERBAC	EOUS PERI	ENNIALS - FE	RGUSON			
SYM	QTY	BOTANICAL NAME	CULTIVAR	COMMON NAME	CONTAINER TYPE	PLANT SIZE	SPACING	DETAIL	COMMENTS
hp	10	Hosta plantaginea		Hosta	Container	1 Gal.	18" O.C.		

- LAWN SOD - Festuca spp. - 3 IMPROVED CULTIVARS - TURF-TYPE TALL FESCUE

# **GENERAL NOTES:**

WHERE PROVIDED, AREA TAKEOFFS AND PLANT QUANTITY ESTIMATES IN PLANTING SCHEDULE ARE FOR INFORMATION ONLY. CONTRACTOR IS RESPONSIBLE TO DO THEIR OWN QUANTITY TAKEOFFS FOR ALL PLANT MATERIAL AND SIZES SHOWN ON THE DRAWINGS. IN CASE OF DISCREPANCIES,

- BRING TO THE ATTENTION OF THE LANDSCAPE ARCHITECT FOR CLARIFICATION. 2. ALL PLANT LAYOUT WILL BE CONDUCTED IN THE FIELD BY LANDSCAPE ARCHITECT.
- 3. SODDING PER SAINT LOUIS COUNTY STANDARD SPECIFICATION FOR ROADWAY AND BRIDGE CONSTRUCTION SECTION 803 SODDING AND JOB SPECIAL PROVISION 800.10.1.

3/7/25 BY JMD (STL) APPROVED BY BRR (STL): CLARIFICATION AND ADDITIONAL INFORMATION REGARDING SOD






720 Olive, Suite 700 St. Louis, MO 63101 314.588.8381 www.oatesassociates.com

Collinsville St. Louis Belleville St. Charles MISSOURI DESIGN FIRM LICENSE NO.: 001166 www.oatesassociates.com

Lamar Johnson Collaborative 7 2199 INNERBELT BUSINESS CENTER DRIVE ST. LOUIS, MISSOURI 63114 Ph 314.429.1010

ı		
	SUBMITTALS	
	ISSUE:	DATE:
	DESIGN 100%	02/29/2024

187B **FERGUSON AVE** GREENWAY

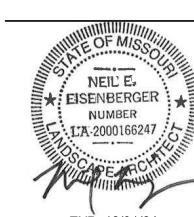

EXP. 12/31/24

STP PROJECT NO.: STP-9901(666)

> PROJECT NO.: 220044

02/29/2024

DRAWING TITLE: FERGUSON PLANTING


SCHEDULE

FERG-L2.03

SHEET <u>90</u> OF <u>106</u>

COPYRIGHT 2024 BY OATES ASSOCIATES
COPYRIGHT C 2024 LJC



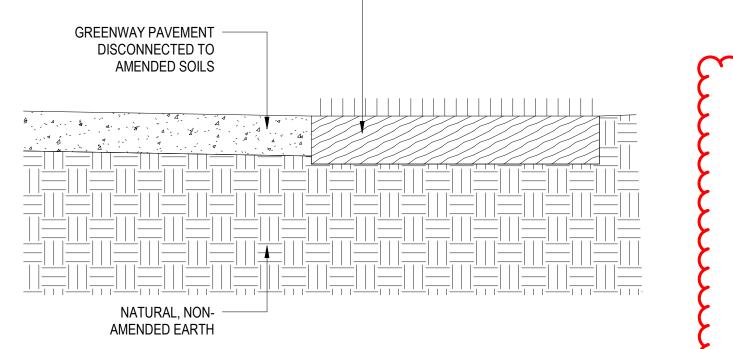


AMENDED SOIL - TILL 2" THICK LAYER OF COMPOST INTO EXISTING SOIL. TILL

6" MIN. DEEP FOR TURF COVER

- 1. TILL SOIL SUBGRADE PRIOR TO COMPOST ADDITION, AND TILL AFTER COMPOST ADDITION
- 2. CLEAN ALL OBJECTS LARGER THAN 2" FROM AMENDED SOIL AREA
- 3. FOR TURF COVER, COMPLETE WITH FINE GRADING AND SODDING IN ACCORDANCE WITH MSD STANDARD SPECIFICATIONS
- 4. SEE COMPOST SPECIFICATION FOR COMPOST MATERIAL PROPERTIES AND TESTING REQUIREMENTS

# 2 AMENDED SOILS

DTL-L1.02 1" = 1'-0"

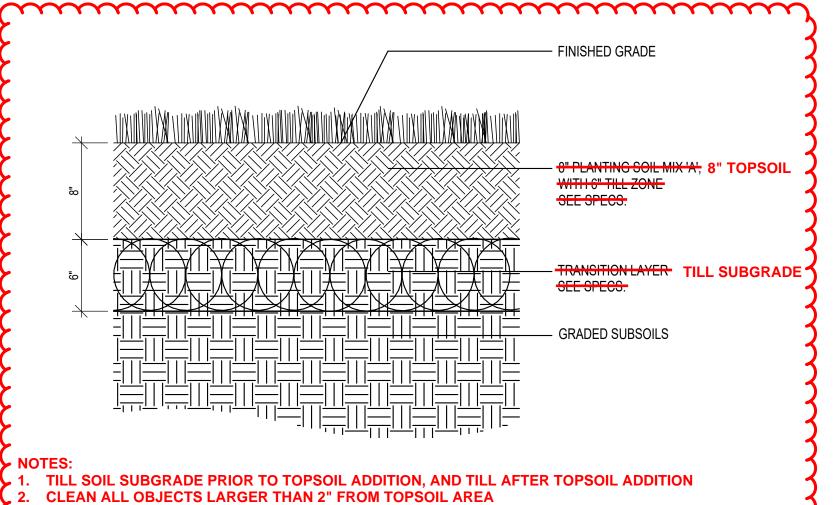

3. SEE SAINT LOUIS COUNTY STANDARD SPECIFICATIONS FOR ROADWAY AND BRIDGE

4. 6" TILL SUBGRADE ZONE TO BE INCIDENTAL TO COST OF TOPSOIL

SOILS - LAWN

DTL-L1.02 1 1/2" = 1'-0"

CONSTRUCTION, SECTION 804 TOPSOIL SPECIFICATION FOR TOPSOIL REQUIREMENTS





OATES ASSOCIATES


720 Olive, Suite 700 St. Louis, MO 63101 314.588.8381 www.oatesassociates.com

Collinsville St. Louis Belleville St. Charles MISSOURI DESIGN FIRM LICENSE NO.: 001166 www.oatesassociates.com

Lamar Johnson Collaborative 7 2199 INNERBELT BUSINESS CENTER DRIVE ST. LOUIS, MISSOURI 63114 Ph 314.429.1010

SUBMITTALS	
ISSUE:	DATE:
DESIGN 30%	12/30/2020
DESIGN 70%	02/18/2022
DESIGN 95%	11/07/2023
DESIGN 100%	02/29/2024

87B **FERGUSON AVI** GREENWAY VINCEN-

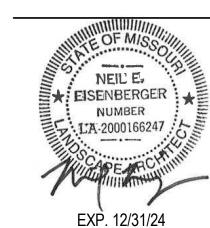

STP PROJECT NO.:

STP-9901(666) PROJECT NO.:

> 220044 DATE:

02/29/2024

DRAWING TITLE: SOIL DETAILS

DTL-L1.02

SHEET <u>14</u> OF <u>106</u>

COPYRIGHT 2024 BY OATES ASSOCIATES
COPYRIGHT C 2024 LJC

3/7/25 BY JMD (STL) APPROVED BY BRR (STL): CLARIFICATION AND ADDITIONAL INFORMATION REGARDING TOPSOIL AND AMENDED SOIL

MISSOURI DESIGN FIRM LICENSE NO.: 001166

SUBMITTALS	
ISSUE:	DATE:
DESIGN - 30%	12/30/2020
DESIGN - 70%	02/18/2022
DESIGN - 95%	11/07/2024
DESIGN - 100%	02/29/2024

187B GREENWAY VINCENT



EXP. 12/31/24

STP PROJECT NO.: STP-9901(666)

> PROJECT NO.: 220044

DATE:

02/29/2024

DRAWING TITLE:
SCHEDULES FERGUSON AVE (1 OF 3)

DRAWING NO.:

SHEET **22** OF **106** 

SUMM		FERGUSON ROAD ST. LOUIS COUNTY PROJECT NO. AR-1795			
QUANT	TITIES		FEDERAL PROJECT NO. STP-5515 (603)		
SUB- TOTALS	TOTAL	UNIT	ITEM NO.	DESCRIPTION	REMARKS
1	1	EACH	107.02.00	RAILROAD PERMITS, AGREEMENTS, AND LICENSES	NOT ON B SHEETS
4	4	EACH	201-20.22	TREE REMOVAL, 6"-15"	INOT ON B SHEETS
5 744	5 744	EACH L.F.		TREE REMOVAL, OVER 15" TREE PROTECTION FENCE	
1	1	L.S.	201-99.02	TREE PROTECTION EXECUTION	INCLUDES PLANNING, EXECUTION, AND MONITORING OF TREE HEALTH; NOT ON B SHEETS; SEE SHT. DTL-L1.01
1	1 1	L.S. L.S.		TREE PRUNING REMOVAL OF IMPROVEMENTS	NOT ON B SHEETS INCLUDES SAWCUTTING
1	1	EACH	203-10.30	LAND DISTURBANCE PERMITS	NOT ON B SHEETS
459.2	459.2	STA. S.Y.		LINEAR GRADING, CLASS 1 TYPE 5 AGGREGATE BASE (4" THICK)	USED UNDER SIDEWALKS AND PAVEMENT PATCHES
4,267.7 38.6	4,267.7 40.5	S.Y. TON		TYPE 5 AGGREGATE BASE (6" THICK) TYPE "C" BITUMINOUS CONCRETE (PAVEMENT)	USED UNDER GREENWAY, BUS STOPS, AND CURB ESTIMATED AT 2.0" THICK, 2.16 TONS/CY, INCLUDES 5% CONTINGENCY
163.4	171.6	_		TYPE "X" BITUMINOUS CONCRETE (PAVEIMENT)	ESTIMATED AT 8.5" THICK, 2.16 TONS/CY, INCLUDES 5% CONTINGENCY
190	200	GAL.		TACK-EMULSIFIED ASPHALT (SS-1H) CONCRETE PAVEMENT (6" NON-REINFORCED)	ESTIMATED AT 0.6 GAL/SQYD, INCLUDES 5% CONTINGENCY
224	224	S.Y.	502-11.07	CONCRETE PAVEMENT (7" NON-REINFORCED)	
1	1	EACH EACH		SINGLE CURB INLET, UNTRAPPED ADJUSTING BASIN OR INLET	
2	2	EACH	604-20.30	ADJUSTING MANHOLE TO GRADE	INCLUDES COST OF UTILITY COLLAR ONLY
4	4	EACH EACH	604-99.01 604-99.02	INLET SPECIAL 3' DIAMETER INLET SPECIAL 4' DIAMETER	CASTING IS INCLUDED IN STRUCTURE COST CASTING IS INCLUDED IN STRUCTURE COST
1	1	EACH	604-99.03	DRAINAGE FLUME	CASTING IS INCLUDED IN STRUCTURE COST
299.8 594.6	299.8 594.6			PAVED DRIVEWAY APPROACH (6" THICK) PAVED DRIVEWAY APPROACH (7" THICK)	
18	18	EACH	608-70.40	CONCRETE WHEEL STOP	
247 114	247 114	<b>+</b>		CONCRETE CURB, TYPE "S" CURB AND GUTTER, VERTICAL	
2,370			609-10.55	CURB AND GUTTER, MOUNTABLE (3")	
55	55	L.F.		INTEGRAL CURB (6" HEIGHT AND UNDER) GROUT FOR ABANDONED SEWERS	
1	1	L.S.	612-30.15	TRAFFIC CONTROL (ALL INCLUSIVE)	NOT ON B SHEETS
20	20	L.F. EACH		CONCRETE MEDIAN BARRIER, TYPE "B" POLYETHYLENE PEDESTRIAN BARRIER	
1	1	L.S.	619-00.00	MOBILIZATION	NOT ON B SHEETS
720 1.180	720 1,180			REMOVAL OF PAVEMENT STRIPING, PAINT TEMPORARY PAVEMENT STRIPING, TAPE (INCLUDES REMOVAL)	
2,134	2,134	S.F.	621-99.01	WHITE METHYL METHACRYLATE (MMA) PAVEMENT MARKING	
1,795	1,795	S.F.		GREEN METHYL METHACRYLATE (MMA) PAVEMENT MARKING REGULATORY SIGNAGE	NOT ON B SHEETS; SEE SHT. FERG-L4.01 FOR SIGNAGE SCHEDULE
1	1	L.S.	628-99.02	GREENWAYSIGNAGE	NOT ON B SHEETS; SEE SHT. FERG-L4.01 FOR SIGNAGE SCHEDULE
588 295		L.F.		12" CLASS V REINFORCED CONCRETE PIPE CULVERT (GASKET TYPE)  18" CLASS V REINFORCED CONCRETE PIPE CULVERT (GASKET TYPE)	
6	6	C.Y.	726-90.40	FLOWABLE FILL	
1,636	1,636 <b>279</b>	S.Y. 3 C.Y.	803-10.00 804-10.00		
(384.8	384.8	S.Y.	804-20.01	AMENDED SOIL (WATER QUALITY BMP)	
3	3	EACH EACH		INLET PROTECTION DEVICE, SINGLE UNIT - FILTER SOCK/ROLL INLET PROTECTION DEVICE, SINGLE UNIT - FABRIC DROP	
1	1	L.S.		STORM WATER POLLUTION PREVENTION PLAN (SWPPP)	NOT ON B SHEETS
1	1	EACH EACH	808-99.02	CERCIS CANADENSIS (REDBUD) TULIP TREE	NOT ON B SHEETS; SEE JSP 100.80.4 "PROJECT ASSURANCES"  NOT ON B SHEETS; SEE SHT. FERG-L2.03 FOR PLANTING SCHEDULE
14	14	EACH EACH	820-99.02	GREEN VELVET BOXWOOD HOSTA SP "BIG MAMA"	NOT ON B SHEETS; SEE SHT. FERG-L2.03 FOR PLANTING SCHEDULE NOT ON B SHEETS; SEE SHT. FERG-L2.03 FOR PLANTING SCHEDULE
10	10	LAUII	070-30.14		INOTON DOLLETO, OLE OITI. I ENO-LZ.00 I OIXI EMNINO OCILEDOLE
11	11	l F	202-10.29	STRUCTURAL ITEMS  DISASSEMBLY AND STORAGE OF BRICK RETAINING WALL	
16.6	16.6	C.Y.	703-20.02	CLASS "B" CONCRETE (MISCELLANEOUS)	
43 1.410	43 1,410	S.F. LBS.		BRICK RETAINING WALL REINFORCING STEEL (GRADE 60)	NOT ON B SHEETS; SEE SHT. FERG-C5.05 FOR MEDIAN BARRIER DETAIL
1,710	1,710		7.00-10.00		TO STATE TO, OLD STATE DATE OF THE DESTRICT OF
36	36	l F	607-30.00	PEDESTRIAN ITEMS HANDRAIL (GALVANIZED PIPE)	
84	84	L.F.	607-99.03	BICYCLE RAILING, 54"	
7 120.0	7 120.0	EACH S.F.		CONCRETE SIDEWALK, CURB RAMP CONCRETE STEPS	INCLUDES SAWCUTTING, TRUNCATED DOMES, CURB AND GUTTER MOUNTABLE (DEPRESSED), CONCRETE CURB TYPE 5, AND TYPE 5 AGGREGATE BASE
2,467	2,467		<b>.</b>	CONCRETE SIDEWALK (5" THICK, REINFORCED)	
	-	-		COUNTY TRAFFIC SIGNAL ITEMS	
2	2	EACH	904-91.73	BASE, TYPE C-3, CONCRETE	
	1	1		STATE TRAFFIC SIGNAL ITEMS	
2	2	EACH	902-99.50	EMERGENCY BLUE CALL LIGHT	
	1				
		-			

COPYRIGHT 2024 BY OATES ASSOCIATES

608-60.08 - CONCRETE SIDEWALK, CURB RAMP

<u>-OCATION</u> FERGUSON AVE						803-10.00 - SODDING			T						T		
ERGUSON AVE	<u>STA</u>	<u>STA</u>	<u>OFFSET</u>	<u>L.F.</u>	REMARKS	LOCATION	<u>STA</u>	<u>STA</u>	<u>OFFSET</u>	S.Y. REMARKS		<u>ATION</u>	<u>STA</u>	<u>STA</u>	<u>OFFSET</u>		REMARKS
	610+00	LT	614+50	195		FERGUSON AVE	610+00	614+50	LT/RT	131	FERG	GUSON AVE	612+20		CL	1 7	YPE B
FERGUSON AVE	614+50	LT	619+00	450		FERGUSON AVE	614+50	619+00	LT/RT	186		GUSON AVE	612+57		CL	1 7	YPE B
FERGUSON AVE	619+00	LT	623+00	423		FERGUSON AVE	619+00	623+00	LT/RT	221		GUSON AVE	620+81		CL		YPE B
		LT							LT/RT	119							
FERGUSON AVE	623+00		627+00	106		FERGUSON AVE	623+00	627+00				GUSON AVE	621+28		CL		YPE B
FERGUSON AVE	627+00	LT	631+00	400		FERGUSON AVE	627+00	631+00	LT/RT	294	FERG	GUSON AVE	637+17		LT	1 1	YPE B
FERGUSON AVE	631+00	LT	635+00	400		FERGUSON AVE	631+00	635+00	LT/RT	236					TOTAL:	7	
FERGUSON AVE	635+00	LT	638+83	396		FERGUSON AVE	635+00	638+83	LT/RT	449							
			TOTAL:	2370					TOTAL:	1636	1						
			1017(21	20.0					1017(2)	1000	608-7	70.00 - CONCRETE	- CTEDS				
														СТА	OFFOFT	0.5	
												<u>ATION</u>	<u>STA</u>	<u>STA</u>	<u>OFFSET</u>		REMARKS
609-20.11 - INTEGRAL	. CURB (6" HEIGH	IT AND UNDER				804-10.00 - TOPSOIL					FERG	GUSON AVE	613+65		RT	10.0	
LOCATION	STA	STA	OFFSET	L.F.	REMARKS	LOCATION	STA	STA	OFFSET	C.Y. REMARKS	FERG	GUSON AVE	614+58		RT	15.0	
ERGUSON AVE	610+00	614+50	LT	55		FERGUSON AVE	610+00	614+50	RT	13		GUSON AVE	615+53		RT	10.0	
	010100	011100	TOTAL:	55		FERGUSON AVE	614+50	619+00	RT	17		GUSON AVE	616+04		RT	5.0	
			TOTAL.	33						17					1 (1		
						FERGUSON AVE	619+00	623+00	RT	31		GUSON AVE	619+64		RT	20.0	
						FERGUSON AVE	623+00	627+00	RT	19	FERG	GUSON AVE	620+13		RT	15.0	
611-20.95 - GROUT FOI	OR ABANDONED	SEWERS				FERGUSON AVE	627+00	631+00	RT	47 )	FERG	GUSON AVE	620+69		RT	10.0	
OCATION	STA	STA	OFFSET	C.Y.	REMARKS	FERGUSON AVE	631+00	635+00	RT	52		GUSON AVE	631+16		RT	15.0	
FERGUSON AVE	635+00	638+83	RT	1		FERGUSON AVE	635+00	638+83	RT	100		GUSON AVE	634+94		RT	15.0	
LINGUSUNAVL	033+00	030+03		<u> </u>		I LNG030N AVL	033+00	030+03							DT		
			TOTAL:	1					TOTAL:	279	/ FERG	GUSON AVE	637+16		KI	5.0	
										unil ,	/ \				TOTAL:	120.0	
											2						
617-20.00 - CONCRETE	E MEDIAN BARR	ER. TYPE "B"				804-20.01 - AMENDED S	OIL (WATER Q	DUALITY BMP)	<u> </u>								
LOCATION		<del>, '</del>	OFFRET	L.F.	REMARKS	LOCATION	STA	STA	OFFSET	S.Y. REMARKS	600 6	60.55 - CONCRETE	E SIDEMALK (F" 7	LUICK DEINEC	DPCED)		
	STA	STA	<u>OFFSET</u>										<u>`</u>	· · · · · · · · · · · · · · · · · · ·			NELLA DI (0
FERGUSON AVE	625+94	626+14	RT	20		FERGUSON AVE	610+00	614+50	LT	73.7		ATION	STA	STA	OFFSET		REMARKS
			TOTAL:	20		FERGUSON AVE	614+50	619+00	LT	108.6	FERG	GUSON AVE	610+00	614+50	CL	2452	
						FERGUSON AVE	619+00	623+00	LT	83.1	FERG	GUSON AVE	614+50	619+00	CL	3737	
						FERGUSON AVE	623+00	627+00	LT	35.0		GUSON AVE	619+00	623+00	CL	2954	
617-99.03 - POLYETHY	VI ENE DEDESTO	IAN BADDIED			I	FERGUSON AVE	627+00	631+00	1 T	84.4		GUSON AVE	623+00	627+00	CL	3180	
			OFFERT	EACH	REMARKS				I T						01		
<u>OCATION</u>	STA	STA	<u>OFFSET</u>	<u>EACH</u>	IVEINIALVAS	FERGUSON AVE	631+00	635+00	LI	0.0		GUSON AVE	627+00	631+00	UL C:	3457	
FERGUSON AVE	623+00	627+00	RT	2	<u> </u>	FERGUSON AVE	635+00	638+83	LT	0.0		GUSON AVE	631+00	635+00	CL	3758	
			TOTAL:	2					TOTAL:	384.8	/ IFERG	GUSON AVE	635+00	638+83	CL	2665	
										(,,,,,), ()					TOTAL:	22203	
											2						
620-99.75 - REMOVAL (	OF PAVEMENT S	TRIPING PAIN	<u>.                                    </u>			806-45.08 - INLET PROT	ECTION DEVIC	CE. SINGI F IINI	T - FILTER SOCK	/ROLL	\						
OCATION	STA	STA	OFFSET	L.F.	REMARKS	LOCATION	STA	STA	OFFSET	EACH REMARKS		NTY TRAFFIC SIG	NAI ITEMS.				
			LT/RT			FERGUSON AVE		SIA		LACII NEWARKS	<u> COOI</u>	MIT INAFFIC SIG	PIANE II EIVIO.		+		
FERGUSON AVE	623+00	627+00		720			611+28		LT	I				_			
			TOTAL:	720		FERGUSON AVE	627+97		LT	1		91.73 - BASE, TYP			T		
						FERGUSON AVE	630+46		LT	1	<u>LOC</u> A	<u>ATION</u>	STA STA	<u>STA</u>	<u>OFFSET</u>	EACH F	REMARKS
						FERGUSON AVE	633+43		LT	1	FERG	GUSON AVE	612+02		LT	1	
321-11.00 - TEMPORAF	RY PAVEMENT S	TRIPING, TAPE	(INCLUDES REM	/IOVAL)		FERGUSON AVE	636+38		LT	1	FERG	GUSON AVE	626+70		LT	1	
OCATION	STA	STA	OFFSET		REMARKS	FERGUSON AVE	637+31		IT	1					TOTAL:	2	
ERGUSON AVE	623+00	627+00	LT/RT	1180		FERGUSON AVE	638+64		I T	1					TOTAL	-	
LNGOSONAVL	023+00	027+00				I LNG030N AVL	030+04		<b>-</b> 1					Ι	T		
			TOTAL:	1180					TOTAL:			TE TD 4 EE 10 01011	AL ITEMS				
											SIAI	TE TRAFFIC SIGN	AL II EMS:				
621-99.01 - WHITE MET	THYL METHACRY	(LATE (MMA) P	VEMENT MARK	ING		806-45.12 - INLET PROT	ECTION DEVIC	CE, SINGLE UNI	T - FABRIC DROI		902-9	99.50 - EMERGEN	CY BLUE CALL LI	IGHT			
_OCATION	STA	STA	OFFSET	S.F.	REMARKS	LOCATION	STA	STA	OFFSET	EACH REMARKS	LOCA	ATION	STA	STA	OFFSET	EACH F	REMARKS
FERGUSON AVE	610+00	614+50	LT/RT	375		FERGUSON AVE	611+82		RT	1		GUSON AVE	612+02		LT	1	
FERGUSON AVE							637+32		RT	1		GUSON AVE	626+70		LT	1	
	I 610±00	1 673±1111							1 1 1	I	I LING	GUSUNAVL	020170			1	
	619+00	623+00	LT/RT	125		FERGUSON AVE	<del></del>			4					TOTAL.	0	
ERGUSON AVE	623+00	627+00	LT/RT	359		FERGUSON AVE	638+96		RT	1					TOTAL:	2	
FERGUSON AVE FERGUSON AVE	623+00 627+00	627+00 631+00	LT/RT LT/RT	359 625			<del></del>			1 3					TOTAL:	2	
FERGUSON AVE FERGUSON AVE	623+00	627+00	LT/RT LT/RT LT/RT	359 625 275			<del></del>		RT	3					TOTAL:	2	
FERGUSON AVE FERGUSON AVE FERGUSON AVE	623+00 627+00	627+00 631+00	LT/RT LT/RT	359 625			<del></del>		RT	1 3					TOTAL:	2	
FERGUSON AVE FERGUSON AVE FERGUSON AVE	623+00 627+00 631+00	627+00 631+00 635+00	LT/RT LT/RT LT/RT	359 625 275			<del></del>		RT	1 3					TOTAL:	2	
ERGUSON AVE ERGUSON AVE ERGUSON AVE	623+00 627+00 631+00	627+00 631+00 635+00	LT/RT LT/RT LT/RT LT/RT	359 625 275 375		FERGUSON AVE	<del></del>		RT	1 3					TOTAL:	2	
ERGUSON AVE	623+00 627+00 631+00	627+00 631+00 635+00	LT/RT LT/RT LT/RT LT/RT	359 625 275 375		FERGUSON AVE  STRUCTURAL ITEMS:	638+96	AGE OF BBICK	RT TOTAL:	1 3					TOTAL:	2	
FERGUSON AVE FERGUSON AVE FERGUSON AVE FERGUSON AVE	623+00 627+00 631+00 635+00	627+00 631+00 635+00 638+83	LT/RT LT/RT LT/RT LT/RT TOTAL:	359 625 275 375 <b>2134</b>		STRUCTURAL ITEMS:  202-10.28 - DISASSEMB	638+96 BLY AND STORA	1	RT TOTAL:  RETAINING WAL						TOTAL:	2	
ERGUSON AVE ERGUSON AVE ERGUSON AVE ERGUSON AVE ERGUSON AVE	623+00 627+00 631+00 635+00	627+00 631+00 635+00 638+83 YLATE (MMA) P	LT/RT LT/RT LT/RT LT/RT TOTAL:	359 625 275 375 <b>2134</b> KING		STRUCTURAL ITEMS:  202-10.28 - DISASSEMB LOCATION	638+96  BLY AND STORA  STA	STA	RT TOTAL:  RETAINING WAL OFFSET	1 3 L L.F. REMARKS					TOTAL:	2	
FERGUSON AVE FERGUSON AVE FERGUSON AVE FERGUSON AVE FERGUSON AVE  621-99.02 - GREEN ME LOCATION	623+00 627+00 631+00 635+00 ETHYL METHACR STA	627+00 631+00 635+00 638+83 YLATE (MMA) P	LT/RT LT/RT LT/RT LT/RT TOTAL:  AVEMENT MARI	359 625 275 375 <b>2134</b> KING <u>S.F.</u>	REMARKS	STRUCTURAL ITEMS:  202-10.28 - DISASSEMB	638+96 BLY AND STORA	1	RT TOTAL:  RETAINING WAL OFFSET CL	L.F. REMARKS 41					TOTAL:	2	
ERGUSON AVE ERGUSON AVE ERGUSON AVE ERGUSON AVE ERGUSON AVE	623+00 627+00 631+00 635+00	627+00 631+00 635+00 638+83 YLATE (MMA) P	LT/RT LT/RT LT/RT LT/RT TOTAL:  AVEMENT MARI OFFSET LT/RT	359 625 275 375 <b>2134</b> KING S.F.	REMARKS	STRUCTURAL ITEMS:  202-10.28 - DISASSEMB LOCATION	638+96  BLY AND STORA  STA	STA	RT TOTAL:  RETAINING WAL OFFSET						TOTAL:	2	
FERGUSON AVE FERGUSON AVE FERGUSON AVE FERGUSON AVE FERGUSON AVE  621-99.02 - GREEN ME LOCATION	623+00 627+00 631+00 635+00 ETHYL METHACR STA	627+00 631+00 635+00 638+83 YLATE (MMA) P	LT/RT LT/RT LT/RT LT/RT TOTAL:  AVEMENT MARI	359 625 275 375 <b>2134</b> KING <u>S.F.</u>	REMARKS	STRUCTURAL ITEMS:  202-10.28 - DISASSEMB LOCATION	638+96  BLY AND STORA  STA	STA	RT TOTAL:  RETAINING WAL OFFSET CL	L.F. REMARKS 41					TOTAL:		
FERGUSON AVE FERGUSON AVE FERGUSON AVE FERGUSON AVE FERGUSON AVE  621-99.02 - GREEN ME LOCATION	623+00 627+00 631+00 635+00 ETHYL METHACR STA	627+00 631+00 635+00 638+83 YLATE (MMA) P	LT/RT LT/RT LT/RT LT/RT TOTAL:  AVEMENT MARI OFFSET LT/RT	359 625 275 375 <b>2134</b> KING S.F.	REMARKS	STRUCTURAL ITEMS:  202-10.28 - DISASSEMB LOCATION FERGUSON AVE	638+96  BLY AND STORA  STA  619+45	STA 619+89	RT TOTAL:  RETAINING WAL OFFSET CL TOTAL:	L.F. REMARKS 41					TOTAL:		
ERGUSON AVE ERGUSON AVE ERGUSON AVE ERGUSON AVE  21-99.02 - GREEN ME OCATION ERGUSON AVE	623+00 627+00 631+00 635+00 ETHYL METHACR STA 623+00	627+00 631+00 635+00 638+83 YLATE (MMA) P STA 627+00	LT/RT LT/RT LT/RT LT/RT TOTAL:  AVEMENT MARI OFFSET LT/RT TOTAL:	359 625 275 375 <b>2134</b> KING S.F. 1795 1795	REMARKS	STRUCTURAL ITEMS:  202-10.28 - DISASSEMB LOCATION FERGUSON AVE  703-20.02 - CLASS "B"	638+96  BLY AND STORA  STA  619+45  CONCRETE (M	STA 619+89 IISCELLANEOU	RT TOTAL:  RETAINING WAL OFFSET CL TOTAL:	L.F. REMARKS 41 41					TOTAL:		
ERGUSON AVE ERGUSON AVE ERGUSON AVE ERGUSON AVE  21-99.02 - GREEN ME OCATION ERGUSON AVE	623+00 627+00 631+00 635+00 ETHYL METHACR STA 623+00	627+00 631+00 635+00 638+83 YLATE (MMA) P STA 627+00	LT/RT LT/RT LT/RT LT/RT TOTAL:  AVEMENT MARI OFFSET LT/RT TOTAL:  PE CULVERT (G	359 625 275 375 <b>2134</b> KING S.F. 1795 1795	REMARKS	STRUCTURAL ITEMS:  202-10.28 - DISASSEMB LOCATION FERGUSON AVE  703-20.02 - CLASS "B" ( LOCATION	638+96  BLY AND STORA  STA  619+45  CONCRETE (M  STA	STA 619+89 IISCELLANEOU	RT TOTAL:  RETAINING WAL OFFSET CL TOTAL: S) OFFSET	L.F. REMARKS 41 41  C.Y. REMARKS					TOTAL:		
ERGUSON AVE ERGUSON AVE ERGUSON AVE ERGUSON AVE  21-99.02 - GREEN ME OCATION ERGUSON AVE	623+00 627+00 631+00 635+00 ETHYL METHACR STA 623+00	627+00 631+00 635+00 638+83 YLATE (MMA) P STA 627+00	LT/RT LT/RT LT/RT LT/RT TOTAL:  AVEMENT MARI OFFSET LT/RT TOTAL:	359 625 275 375 <b>2134</b> KING S.F. 1795 1795	REMARKS	STRUCTURAL ITEMS:  202-10.28 - DISASSEMB LOCATION FERGUSON AVE  703-20.02 - CLASS "B"	638+96  BLY AND STORA  STA  619+45  CONCRETE (M	STA 619+89 IISCELLANEOU	RT TOTAL:  RETAINING WAL OFFSET CL TOTAL:	L.F. REMARKS 41 41	EDIAN BARRIER				TOTAL:		
ERGUSON AVE ERGUSON AVE ERGUSON AVE ERGUSON AVE  21-99.02 - GREEN ME OCATION ERGUSON AVE	623+00 627+00 631+00 635+00 ETHYL METHACR STA 623+00 S V REINFORCED STA	627+00 631+00 635+00 638+83 YLATE (MMA) P STA 627+00 CONCRETE PI STA	LT/RT LT/RT LT/RT LT/RT TOTAL:  AVEMENT MARI OFFSET LT/RT TOTAL:  PE CULVERT (G OFFSET	359 625 275 375 <b>2134</b> KING S.F. 1795 1795 ASKET TYPE) L.F.	REMARKS REMARKS	STRUCTURAL ITEMS:  202-10.28 - DISASSEMB LOCATION FERGUSON AVE  703-20.02 - CLASS "B" ( LOCATION	638+96  BLY AND STORA  STA  619+45  CONCRETE (M  STA	STA 619+89 IISCELLANEOU	RT TOTAL:  RETAINING WAL OFFSET CL TOTAL: S) OFFSET	L.F. REMARKS 41 41  C.Y. REMARKS	EDIAN BARRIER				TOTAL:		
ERGUSON AVE ERGUSON AVE ERGUSON AVE ERGUSON AVE  21-99.02 - GREEN ME  OCATION ERGUSON AVE  26-25.12 - 12" CLASS OCATION ERGUSON AVE	623+00 627+00 631+00 635+00 ETHYL METHACR STA 623+00 S V REINFORCED STA 627+00	627+00 631+00 635+00 638+83 YLATE (MMA) P STA 627+00 CONCRETE PI STA 631+00	LT/RT LT/RT LT/RT LT/RT TOTAL:  AVEMENT MARI OFFSET LT/RT TOTAL:  PE CULVERT (G OFFSET LT	359 625 275 375 <b>2134</b> KING S.F. 1795 1795 1795	REMARKS REMARKS	STRUCTURAL ITEMS:  202-10.28 - DISASSEMB LOCATION FERGUSON AVE  703-20.02 - CLASS "B" ( LOCATION	638+96  BLY AND STORA  STA  619+45  CONCRETE (M  STA	STA 619+89 IISCELLANEOU	RT TOTAL:  RETAINING WAL OFFSET CL TOTAL: S) OFFSET LT	L.F. REMARKS 41 41  C.Y. REMARKS 16.6 CONCRETE M	EDIAN BARRIER				TOTAL:		
ERGUSON AVE ERGUSON AVE ERGUSON AVE ERGUSON AVE  21-99.02 - GREEN ME OCATION ERGUSON AVE  26-25.12 - 12" CLASS OCATION ERGUSON AVE ERGUSON AVE	623+00 627+00 631+00 635+00 ETHYL METHACR STA 623+00 S V REINFORCED STA 627+00 631+00	627+00 631+00 635+00 638+83 YLATE (MMA) P STA 627+00 CONCRETE PI STA 631+00 635+00	LT/RT LT/RT LT/RT LT/RT TOTAL:  AVEMENT MARI OFFSET LT/RT TOTAL:  PE CULVERT (G OFFSET LT LT LT LT	359 625 275 375 <b>2134</b> KING S.F. 1795 1795 L.F. 303 243	REMARKS REMARKS	STRUCTURAL ITEMS:  202-10.28 - DISASSEMB LOCATION FERGUSON AVE  703-20.02 - CLASS "B" ( LOCATION	638+96  BLY AND STORA  STA  619+45  CONCRETE (M  STA	STA 619+89 IISCELLANEOU	RT TOTAL:  RETAINING WAL OFFSET CL TOTAL: S) OFFSET LT	L.F. REMARKS 41 41  C.Y. REMARKS 16.6 CONCRETE M	EDIAN BARRIER				TOTAL:		
ERGUSON AVE ERGUSON AVE ERGUSON AVE ERGUSON AVE  21-99.02 - GREEN ME OCATION ERGUSON AVE  26-25.12 - 12" CLASS OCATION ERGUSON AVE ERGUSON AVE	623+00 627+00 631+00 635+00 ETHYL METHACR STA 623+00 S V REINFORCED STA 627+00	627+00 631+00 635+00 638+83 YLATE (MMA) P STA 627+00 CONCRETE PI STA 631+00	LT/RT LT/RT LT/RT LT/RT TOTAL:  AVEMENT MARI OFFSET LT/RT TOTAL:  PE CULVERT (G OFFSET LT LT LT LT LT LT	359 625 275 375 <b>2134</b> KING S.F. 1795 1795 1795 L.F. 303 243 42	REMARKS  REMARKS	STRUCTURAL ITEMS:  202-10.28 - DISASSEMB LOCATION FERGUSON AVE  703-20.02 - CLASS "B" ( LOCATION FERGUSON AVE	638+96  BLY AND STORA  STA  619+45  CONCRETE (M  STA  623+00	STA 619+89 IISCELLANEOU	RT TOTAL:  RETAINING WAL OFFSET CL TOTAL: S) OFFSET LT	L.F. REMARKS 41 41  C.Y. REMARKS 16.6 CONCRETE M	EDIAN BARRIER				TOTAL:		
ERGUSON AVE ERGUSON AVE ERGUSON AVE ERGUSON AVE ERGUSON AVE  21-99.02 - GREEN ME OCATION ERGUSON AVE  26-25.12 - 12" CLASS OCATION ERGUSON AVE ERGUSON AVE	623+00 627+00 631+00 635+00  ETHYL METHACR STA 623+00  S V REINFORCED STA 627+00 631+00	627+00 631+00 635+00 638+83 YLATE (MMA) P STA 627+00 CONCRETE PI STA 631+00 635+00	LT/RT LT/RT LT/RT LT/RT TOTAL:  AVEMENT MARI OFFSET LT/RT TOTAL:  PE CULVERT (G OFFSET LT LT LT LT	359 625 275 375 <b>2134</b> KING S.F. 1795 1795 L.F. 303 243	REMARKS  REMARKS	STRUCTURAL ITEMS:  202-10.28 - DISASSEMB LOCATION FERGUSON AVE  703-20.02 - CLASS "B" ( LOCATION FERGUSON AVE	638+96  BLY AND STORA  STA  619+45  CONCRETE (M  STA  623+00  AINING WALL	STA 619+89 IISCELLANEOUS STA 627+00	RT TOTAL:  RETAINING WAL OFFSET CL TOTAL:  S) OFFSET LT TOTAL:	L.F. REMARKS  41  41  C.Y. REMARKS  16.6 CONCRETE M  16.6	EDIAN BARRIER				TOTAL:		
ERGUSON AVE ERGUSON AVE ERGUSON AVE ERGUSON AVE ERGUSON AVE  621-99.02 - GREEN ME OCATION ERGUSON AVE  726-25.12 - 12" CLASS OCATION ERGUSON AVE ERGUSON AVE	623+00 627+00 631+00 635+00  ETHYL METHACR STA 623+00  S V REINFORCED STA 627+00 631+00	627+00 631+00 635+00 638+83 YLATE (MMA) P STA 627+00 CONCRETE PI STA 631+00 635+00	LT/RT LT/RT LT/RT LT/RT TOTAL:  AVEMENT MARI OFFSET LT/RT TOTAL:  PE CULVERT (G OFFSET LT LT LT LT LT LT	359 625 275 375 <b>2134</b> KING S.F. 1795 1795 1795 L.F. 303 243 42	REMARKS  REMARKS	STRUCTURAL ITEMS:  202-10.28 - DISASSEMB LOCATION FERGUSON AVE  703-20.02 - CLASS "B" ( LOCATION FERGUSON AVE  703-90.26 - BRICK RETAL LOCATION	638+96  BLY AND STORA  STA  619+45  CONCRETE (M  STA  623+00  AINING WALL  STA	STA 619+89 IISCELLANEOU STA 627+00	RT TOTAL:  RETAINING WAL OFFSET CL TOTAL: S) OFFSET LT TOTAL:	L.F. REMARKS 41 41  C.Y. REMARKS 16.6 CONCRETE M	EDIAN BARRIER				TOTAL:		
FERGUSON AVE FERGUSON AVE FERGUSON AVE FERGUSON AVE FERGUSON AVE  621-99.02 - GREEN ME LOCATION	623+00 627+00 631+00 635+00  ETHYL METHACR STA 623+00  S V REINFORCED STA 627+00 631+00	627+00 631+00 635+00 638+83 YLATE (MMA) P STA 627+00 CONCRETE PI STA 631+00 635+00	LT/RT LT/RT LT/RT LT/RT TOTAL:  AVEMENT MARI OFFSET LT/RT TOTAL:  PE CULVERT (G OFFSET LT LT LT LT LT LT	359 625 275 375 <b>2134</b> KING S.F. 1795 1795 1795 L.F. 303 243 42	REMARKS  REMARKS	STRUCTURAL ITEMS:  202-10.28 - DISASSEMB LOCATION FERGUSON AVE  703-20.02 - CLASS "B" ( LOCATION FERGUSON AVE	638+96  BLY AND STORA  STA  619+45  CONCRETE (M  STA  623+00  AINING WALL	STA 619+89 IISCELLANEOUS STA 627+00	RT TOTAL:  RETAINING WAL OFFSET CL TOTAL:  S) OFFSET LT TOTAL:	L.F. REMARKS  41  41  C.Y. REMARKS  16.6 CONCRETE M  16.6	EDIAN BARRIER				TOTAL:		
ERGUSON AVE ERGUSON AVE ERGUSON AVE ERGUSON AVE  621-99.02 - GREEN ME OCATION ERGUSON AVE  726-25.12 - 12" CLASS OCATION ERGUSON AVE ERGUSON AVE	623+00 627+00 631+00 635+00  ETHYL METHACR STA 623+00  S V REINFORCED STA 627+00 631+00 635+00	627+00 631+00 635+00 638+83 YLATE (MMA) P STA 627+00 CONCRETE PI STA 631+00 635+00 638+83	LT/RT LT/RT LT/RT TOTAL:  AVEMENT MARI OFFSET LT/RT TOTAL:  PE CULVERT (G OFFSET LT LT LT LT LT LT LT TOTAL:	359 625 275 375 2134 KING S.F. 1795 1795 1795 L.F. 303 243 42 588	REMARKS  REMARKS	STRUCTURAL ITEMS:  202-10.28 - DISASSEMB LOCATION FERGUSON AVE  703-20.02 - CLASS "B" ( LOCATION FERGUSON AVE  703-90.26 - BRICK RETAL LOCATION	638+96  BLY AND STORA  STA  619+45  CONCRETE (M  STA  623+00  AINING WALL  STA	STA 619+89 IISCELLANEOU STA 627+00	RT TOTAL:  RETAINING WAL OFFSET CL TOTAL: S) OFFSET LT TOTAL:	L.F. REMARKS  41  41  C.Y. REMARKS  16.6 CONCRETE M  16.6	EDIAN BARRIER				TOTAL:		
ERGUSON AVE ERGUSON AVE ERGUSON AVE ERGUSON AVE  621-99.02 - GREEN ME OCATION ERGUSON AVE  726-25.12 - 12" CLASS OCATION ERGUSON AVE ERGUSON AVE ERGUSON AVE ERGUSON AVE	623+00 627+00 631+00 635+00  ETHYL METHACR STA 623+00  S V REINFORCED  STA 627+00 631+00 635+00	627+00 631+00 635+00 638+83  YLATE (MMA) P STA 627+00  CONCRETE PI STA 631+00 635+00 638+83  CONCRETE PI	LT/RT LT/RT LT/RT TOTAL:  AVEMENT MARI OFFSET LT/RT TOTAL:  PE CULVERT (G OFFSET LT LT LT LT LT TOTAL:  PE CULVERT (G	359 625 275 375 2134 KING S.F. 1795 1795 1795 L.F. 303 243 42 588	REMARKS  REMARKS	STRUCTURAL ITEMS:  202-10.28 - DISASSEMB LOCATION FERGUSON AVE  703-20.02 - CLASS "B" ( LOCATION FERGUSON AVE  703-90.26 - BRICK RETAL LOCATION	638+96  BLY AND STORA  STA  619+45  CONCRETE (M  STA  623+00  AINING WALL  STA	STA 619+89 IISCELLANEOU STA 627+00	RT TOTAL:  RETAINING WAL OFFSET CL TOTAL:  S) OFFSET LT TOTAL:  OFFSET RT	L.F. REMARKS  41  41  C.Y. REMARKS  16.6 CONCRETE M  16.6  S.F. REMARKS  43	EDIAN BARRIER				TOTAL:		
ERGUSON AVE ERGUSON AVE ERGUSON AVE ERGUSON AVE  621-99.02 - GREEN ME OCATION ERGUSON AVE  726-25.12 - 12" CLASS OCATION ERGUSON AVE ERGUSON AVE ERGUSON AVE ERGUSON AVE ERGUSON AVE	623+00 627+00 631+00 635+00  ETHYL METHACR STA 623+00  S V REINFORCED STA 627+00 631+00 635+00  S V REINFORCED STA	627+00 631+00 635+00 638+83  YLATE (MMA) P STA 627+00  CONCRETE PI STA 631+00 635+00 638+83  CONCRETE PI STA	LT/RT LT/RT LT/RT TOTAL:  AVEMENT MARI OFFSET LT/RT TOTAL:  PE CULVERT (G OFFSET LT LT LT LT LT TOTAL:  PE CULVERT (G OFFSET	359 625 275 375 2134 KING S.F. 1795 1795 1795 ASKET TYPE) L.F. 303 243 42 588 ASKET TYPE)	REMARKS  REMARKS	STRUCTURAL ITEMS:  202-10.28 - DISASSEMB LOCATION FERGUSON AVE  703-20.02 - CLASS "B" ( LOCATION FERGUSON AVE  703-90.26 - BRICK RETAL LOCATION	638+96  BLY AND STORA  STA  619+45  CONCRETE (M  STA  623+00  AINING WALL  STA	STA 619+89 IISCELLANEOU STA 627+00	RT TOTAL:  RETAINING WAL OFFSET CL TOTAL:  S) OFFSET LT TOTAL:  OFFSET RT	L.F. REMARKS  41  41  C.Y. REMARKS  16.6 CONCRETE M  16.6  S.F. REMARKS  43	EDIAN BARRIER				TOTAL:		
ERGUSON AVE ERGUSON AVE ERGUSON AVE ERGUSON AVE  621-99.02 - GREEN ME OCATION ERGUSON AVE  726-25.12 - 12" CLASS OCATION ERGUSON AVE ERGUSON AVE ERGUSON AVE ERGUSON AVE ERGUSON AVE ERGUSON AVE	623+00 627+00 631+00 635+00  ETHYL METHACR STA 623+00  S V REINFORCED STA 627+00 631+00 635+00  S V REINFORCED STA 631+00 635+00	627+00 631+00 635+00 638+83  YLATE (MMA) P STA 627+00  CONCRETE PI STA 631+00 635+00 638+83  CONCRETE PI STA 635+00	LT/RT LT/RT LT/RT LT/RT TOTAL:  AVEMENT MARI OFFSET LT/RT TOTAL:  PE CULVERT (G OFFSET LT LT LT LT LT TOTAL:  PE CULVERT (G OFFSET LT LT LT LT LT LT LT TOTAL:	359 625 275 375 2134 KING S.F. 1795 1795 ASKET TYPE) L.F. 303 243 42 588 ASKET TYPE) L.F.	REMARKS  REMARKS	STRUCTURAL ITEMS:  202-10.28 - DISASSEMB LOCATION FERGUSON AVE  703-20.02 - CLASS "B" ( LOCATION FERGUSON AVE  703-90.26 - BRICK RETA LOCATION FERGUSON AVE	638+96  BLY AND STORA  STA  619+45  CONCRETE (M  STA  623+00  AINING WALL  STA	STA 619+89 IISCELLANEOU STA 627+00	RT TOTAL:  RETAINING WAL OFFSET CL TOTAL:  S) OFFSET LT TOTAL:  OFFSET RT	L.F. REMARKS  41  41  C.Y. REMARKS  16.6 CONCRETE M  16.6  S.F. REMARKS  43	EDIAN BARRIER				TOTAL:		
ERGUSON AVE ERGUSON AVE ERGUSON AVE ERGUSON AVE  621-99.02 - GREEN ME OCATION ERGUSON AVE  726-25.12 - 12" CLASS OCATION ERGUSON AVE ERGUSON AVE ERGUSON AVE ERGUSON AVE ERGUSON AVE	623+00 627+00 631+00 635+00  ETHYL METHACR STA 623+00  S V REINFORCED STA 627+00 631+00 635+00  S V REINFORCED STA	627+00 631+00 635+00 638+83  YLATE (MMA) P STA 627+00  CONCRETE PI STA 631+00 635+00 638+83  CONCRETE PI STA	LT/RT LT/RT LT/RT LT/RT TOTAL:  AVEMENT MARI OFFSET LT/RT TOTAL:  PE CULVERT (G OFFSET LT LT LT LT LT TOTAL:  PE CULVERT (G OFFSET LT	359 625 275 375 2134 KING S.F. 1795 1795 ASKET TYPE) L.F. 303 243 42 588 ASKET TYPE) L.F. 157 138	REMARKS  REMARKS	STRUCTURAL ITEMS:  202-10.28 - DISASSEMB LOCATION FERGUSON AVE  703-20.02 - CLASS "B" ( LOCATION FERGUSON AVE  703-90.26 - BRICK RETAL LOCATION	638+96  BLY AND STORA  STA  619+45  CONCRETE (M  STA  623+00  AINING WALL  STA	STA 619+89 IISCELLANEOU STA 627+00	RT TOTAL:  RETAINING WAL OFFSET CL TOTAL:  S) OFFSET LT TOTAL:  OFFSET RT	L.F. REMARKS  41  41  C.Y. REMARKS  16.6 CONCRETE M  16.6  S.F. REMARKS  43	EDIAN BARRIER				TOTAL:		
ERGUSON AVE ERGUSON AVE ERGUSON AVE ERGUSON AVE ERGUSON AVE  621-99.02 - GREEN ME OCATION ERGUSON AVE	623+00 627+00 631+00 635+00  ETHYL METHACR STA 623+00  S V REINFORCED STA 627+00 631+00 635+00  S V REINFORCED STA 631+00 635+00	627+00 631+00 635+00 638+83  YLATE (MMA) P STA 627+00  CONCRETE PI STA 631+00 635+00 638+83  CONCRETE PI STA 635+00	LT/RT LT/RT LT/RT LT/RT TOTAL:  AVEMENT MARI OFFSET LT/RT TOTAL:  PE CULVERT (G OFFSET LT LT LT LT LT TOTAL:  PE CULVERT (G OFFSET LT LT LT LT LT LT LT TOTAL:	359 625 275 375 2134 KING S.F. 1795 1795 ASKET TYPE) L.F. 303 243 42 588 ASKET TYPE) L.F.	REMARKS  REMARKS	STRUCTURAL ITEMS:  202-10.28 - DISASSEMB LOCATION FERGUSON AVE  703-20.02 - CLASS "B" ( LOCATION FERGUSON AVE  703-90.26 - BRICK RETA LOCATION FERGUSON AVE  PEDESTRIAN ITEMS:	638+96  BLY AND STORA  STA  619+45  CONCRETE (M  STA  623+00  AINING WALL  STA  619+45	STA 619+89 IISCELLANEOUS STA 627+00 STA 619+89	RT TOTAL:  RETAINING WAL OFFSET CL TOTAL:  S) OFFSET LT TOTAL:  OFFSET RT	L.F. REMARKS  41  41  C.Y. REMARKS  16.6 CONCRETE M  16.6  S.F. REMARKS  43	EDIAN BARRIER				TOTAL:		
ERGUSON AVE ERGUSON AVE ERGUSON AVE ERGUSON AVE ERGUSON AVE  621-99.02 - GREEN ME OCATION ERGUSON AVE	623+00 627+00 631+00 635+00  ETHYL METHACR STA 623+00  S V REINFORCED STA 627+00 631+00 635+00  S V REINFORCED STA 631+00 635+00	627+00 631+00 635+00 638+83  YLATE (MMA) P STA 627+00  CONCRETE PI STA 631+00 635+00 638+83  CONCRETE PI STA 635+00	LT/RT LT/RT LT/RT LT/RT TOTAL:  AVEMENT MARI OFFSET LT/RT TOTAL:  PE CULVERT (G OFFSET LT LT LT LT LT TOTAL:  PE CULVERT (G OFFSET LT	359 625 275 375 2134 KING S.F. 1795 1795 ASKET TYPE) L.F. 303 243 42 588 ASKET TYPE) L.F. 157 138	REMARKS  REMARKS	STRUCTURAL ITEMS:  202-10.28 - DISASSEMB LOCATION FERGUSON AVE  703-20.02 - CLASS "B" ( LOCATION FERGUSON AVE  703-90.26 - BRICK RETA LOCATION FERGUSON AVE  PEDESTRIAN ITEMS: 607-30.00 HANDRAIL (G	638+96  BLY AND STORA  STA  619+45  CONCRETE (M  STA  623+00  AINING WALL  STA  619+45	STA 619+89 IISCELLANEOUS STA 627+00 STA 619+89	RT TOTAL:  RETAINING WAL OFFSET CL TOTAL: S) OFFSET LT TOTAL:  OFFSET RT TOTAL:	L.F. REMARKS  41  41  C.Y. REMARKS  16.6 CONCRETE M  16.6  S.F. REMARKS  43  43	EDIAN BARRIER				TOTAL:		
ERGUSON AVE ERGUSON AVE ERGUSON AVE ERGUSON AVE  621-99.02 - GREEN ME OCATION ERGUSON AVE	623+00 627+00 631+00 635+00  ETHYL METHACR STA 623+00  S V REINFORCED STA 627+00 631+00 635+00  S V REINFORCED STA 631+00 635+00	627+00 631+00 635+00 638+83  YLATE (MMA) P STA 627+00  CONCRETE PI STA 631+00 635+00 638+83  CONCRETE PI STA 635+00	LT/RT LT/RT LT/RT LT/RT TOTAL:  AVEMENT MARI OFFSET LT/RT TOTAL:  PE CULVERT (G OFFSET LT LT LT LT LT TOTAL:  PE CULVERT (G OFFSET LT	359 625 275 375 2134 KING S.F. 1795 1795 ASKET TYPE) L.F. 303 243 42 588 ASKET TYPE) L.F. 157 138	REMARKS  REMARKS	STRUCTURAL ITEMS:  202-10.28 - DISASSEMB LOCATION FERGUSON AVE  703-20.02 - CLASS "B" ( LOCATION FERGUSON AVE  703-90.26 - BRICK RETA LOCATION FERGUSON AVE  PEDESTRIAN ITEMS: 607-30.00 HANDRAIL (GLOCATION	638+96  BLY AND STORA  STA  619+45  CONCRETE (M  STA  623+00  AINING WALL  STA  619+45  GALVANIZED PI  STA	STA 619+89 IISCELLANEOUS STA 627+00 STA 619+89	RT TOTAL:  RETAINING WAL OFFSET CL TOTAL: S) OFFSET LT TOTAL:  OFFSET RT TOTAL:  OFFSET RT TOTAL:	L.F. REMARKS  41  41  C.Y. REMARKS  16.6 CONCRETE M  16.6  S.F. REMARKS  43	EDIAN BARRIER				TOTAL:		
ERGUSON AVE ERGUSON AVE ERGUSON AVE ERGUSON AVE  621-99.02 - GREEN ME OCATION ERGUSON AVE  CATION ERGUSON AVE	623+00 627+00 631+00 635+00  ETHYL METHACR STA 623+00  S V REINFORCED STA 627+00 631+00 635+00  S V REINFORCED STA 631+00 635+00	627+00 631+00 635+00 638+83  YLATE (MMA) P STA 627+00  CONCRETE PI STA 631+00 635+00 638+83  CONCRETE PI STA 635+00 638+83	LT/RT LT/RT LT/RT TOTAL:  AVEMENT MARI OFFSET LT/RT TOTAL:  PE CULVERT (G OFFSET LT LT LT LT LT TOTAL:  PE CULVERT (G OFFSET LT LT LT LT TOTAL:	359 625 275 375 2134 KING S.F. 1795 1795 ASKET TYPE) L.F. 303 243 42 588 ASKET TYPE) L.F. 157 138 295	REMARKS  REMARKS	STRUCTURAL ITEMS:  202-10.28 - DISASSEMB LOCATION FERGUSON AVE  703-20.02 - CLASS "B" ( LOCATION FERGUSON AVE  703-90.26 - BRICK RETA LOCATION FERGUSON AVE  PEDESTRIAN ITEMS:  607-30.00 HANDRAIL (G LOCATION FERGUSON AVE	638+96  BLY AND STORA  STA  619+45  CONCRETE (MI  STA  623+00  AINING WALL  STA  619+45  GALVANIZED PI  STA  619+64	STA 619+89 IISCELLANEOUS STA 627+00 STA 619+89	RT TOTAL:  RETAINING WAL OFFSET CL TOTAL: S) OFFSET LT TOTAL:  OFFSET RT TOTAL:  OFFSET RT TOTAL:	L.F. REMARKS  41  41  C.Y. REMARKS  16.6 CONCRETE M  16.6  S.F. REMARKS  43  43	EDIAN BARRIER				TOTAL:		
ERGUSON AVE ERGUSON AVE ERGUSON AVE ERGUSON AVE  621-99.02 - GREEN ME OCATION ERGUSON AVE	623+00 627+00 631+00 635+00  ETHYL METHACR STA 623+00  S V REINFORCED STA 627+00 631+00 635+00  S V REINFORCED STA 631+00 635+00	627+00 631+00 635+00 638+83  YLATE (MMA) P STA 627+00  CONCRETE PI STA 631+00 635+00 638+83  CONCRETE PI STA 635+00	LT/RT LT/RT LT/RT LT/RT TOTAL:  AVEMENT MARI OFFSET LT/RT TOTAL:  PE CULVERT (G OFFSET LT LT LT LT LT TOTAL:  PE CULVERT (G OFFSET LT	359 625 275 375 2134 KING S.F. 1795 1795 ASKET TYPE) L.F. 303 243 42 588 ASKET TYPE) L.F. 157 138 295	REMARKS  REMARKS	STRUCTURAL ITEMS:  202-10.28 - DISASSEMB LOCATION FERGUSON AVE  703-20.02 - CLASS "B" ( LOCATION FERGUSON AVE  703-90.26 - BRICK RETA LOCATION FERGUSON AVE  PEDESTRIAN ITEMS: 607-30.00 HANDRAIL (GLOCATION	638+96  BLY AND STORA  STA  619+45  CONCRETE (M  STA  623+00  AINING WALL  STA  619+45  GALVANIZED PI  STA	STA 619+89 IISCELLANEOUS STA 627+00 STA 619+89	RT TOTAL:  RETAINING WAL OFFSET CL TOTAL: S) OFFSET LT TOTAL:  OFFSET RT TOTAL:  OFFSET RT TOTAL:	L.F. REMARKS  41  41  C.Y. REMARKS  16.6 CONCRETE M  16.6  S.F. REMARKS  43  43	EDIAN BARRIER				TOTAL:		
ERGUSON AVE ERGUSON AVE ERGUSON AVE ERGUSON AVE  621-99.02 - GREEN ME OCATION ERGUSON AVE  726-25.12 - 12" CLASS OCATION ERGUSON AVE ERGUSON AVE ERGUSON AVE ERGUSON AVE ERGUSON AVE ERGUSON AVE	623+00 627+00 631+00 635+00  ETHYL METHACR STA 623+00  S V REINFORCED STA 627+00 631+00 635+00  S V REINFORCED STA 631+00 635+00	627+00 631+00 635+00 638+83  YLATE (MMA) P STA 627+00  CONCRETE PI STA 631+00 635+00 638+83  CONCRETE PI STA 635+00 638+83	LT/RT LT/RT LT/RT TOTAL:  AVEMENT MARI OFFSET LT/RT TOTAL:  PE CULVERT (G OFFSET LT LT LT LT LT TOTAL:  PE CULVERT (G OFFSET LT LT LT LT TOTAL:	359 625 275 375 2134 KING S.F. 1795 1795 ASKET TYPE) L.F. 303 243 42 588 ASKET TYPE) L.F. 157 138 295	REMARKS  REMARKS  REMARKS	STRUCTURAL ITEMS:  202-10.28 - DISASSEMB LOCATION FERGUSON AVE  703-20.02 - CLASS "B" ( LOCATION FERGUSON AVE  703-90.26 - BRICK RETA LOCATION FERGUSON AVE  PEDESTRIAN ITEMS:  607-30.00 HANDRAIL (G LOCATION FERGUSON AVE	638+96  BLY AND STORA  STA  619+45  CONCRETE (MI  STA  623+00  AINING WALL  STA  619+45  GALVANIZED PI  STA  619+64	STA 619+89 IISCELLANEOUS STA 627+00 STA 619+89	RT TOTAL:  RETAINING WAL OFFSET CL TOTAL: S) OFFSET LT TOTAL:  OFFSET RT TOTAL:  OFFSET RT TOTAL:	L.F. REMARKS  41  41  C.Y. REMARKS  16.6 CONCRETE M  16.6  S.F. REMARKS  43  43	EDIAN BARRIER				TOTAL:		
ERGUSON AVE ERGUSON AVE ERGUSON AVE ERGUSON AVE  621-99.02 - GREEN ME OCATION ERGUSON AVE  726-25.12 - 12" CLASS OCATION ERGUSON AVE	623+00 627+00 631+00 635+00  ETHYL METHACR STA 623+00  S V REINFORCED STA 627+00 631+00 635+00  S V REINFORCED STA 624+24	627+00 631+00 635+00 638+83  YLATE (MMA) P STA 627+00  CONCRETE PI STA 631+00 635+00 638+83  CONCRETE PI STA 635+00 638+83	LT/RT LT/RT LT/RT LT/RT TOTAL:  AVEMENT MARI OFFSET LT/RT TOTAL:  PE CULVERT (G OFFSET LT LT LT LT LT TOTAL:  PE CULVERT (G OFFSET LT LT LT TOTAL:  OFFSET LT LT LT TOTAL:  OFFSET LT	359 625 275 375 2134  KING S.F. 1795 1795  ASKET TYPE) L.F. 303 243 42 588  ASKET TYPE) L.F. 157 138 295	REMARKS  REMARKS  REMARKS	STRUCTURAL ITEMS:  202-10.28 - DISASSEMB LOCATION FERGUSON AVE  703-20.02 - CLASS "B" ( LOCATION FERGUSON AVE  703-90.26 - BRICK RETA LOCATION FERGUSON AVE  PEDESTRIAN ITEMS:  607-30.00 HANDRAIL (GLOCATION FERGUSON AVE FERGUSON AVE FERGUSON AVE FERGUSON AVE FERGUSON AVE	638+96  BLY AND STORA  STA  619+45  CONCRETE (M  STA  623+00  AINING WALL  STA  619+45  619+45  631+16 634+94	STA 619+89 IISCELLANEOUS STA 627+00 STA 619+89	RT TOTAL:  RETAINING WAL OFFSET CL TOTAL:  S) OFFSET LT TOTAL:  OFFSET RT TOTAL:  OFFSET RT TOTAL:  RT TOTAL:	L.F. REMARKS  41  41  C.Y. REMARKS  16.6 CONCRETE M  16.6  S.F. REMARKS  43  43	EDIAN BARRIER				TOTAL:		
ERGUSON AVE ERGUSON AVE ERGUSON AVE ERGUSON AVE  621-99.02 - GREEN ME OCATION ERGUSON AVE  726-25.12 - 12" CLASS OCATION ERGUSON AVE	623+00 627+00 631+00 635+00  ETHYL METHACR STA 623+00  S V REINFORCED STA 627+00 631+00 635+00  S V REINFORCED STA 624+00 635+00	627+00 631+00 635+00 638+83  YLATE (MMA) P STA 627+00  CONCRETE PI STA 631+00 635+00 638+83  CONCRETE PI STA 635+00 638+83	LT/RT LT/RT LT/RT LT/RT TOTAL:  AVEMENT MARI OFFSET LT/RT TOTAL:  PE CULVERT (G OFFSET LT LT LT LT TOTAL:  PE CULVERT (G OFFSET LT LT LT TOTAL:  OFFSET LT	359 625 275 375 2134 KING S.F. 1795 1795 ASKET TYPE) L.F. 303 243 42 588 ASKET TYPE) L.F. 157 138 295	REMARKS  REMARKS  REMARKS	STRUCTURAL ITEMS:  202-10.28 - DISASSEMB LOCATION FERGUSON AVE  703-20.02 - CLASS "B" ( LOCATION FERGUSON AVE  703-90.26 - BRICK RETA LOCATION FERGUSON AVE  PEDESTRIAN ITEMS:  607-30.00 HANDRAIL (G LOCATION FERGUSON AVE FERGUSON AVE	638+96  BLY AND STORA  STA  619+45  CONCRETE (M  STA  623+00  AINING WALL  STA  619+45  GALVANIZED PI  STA  619+64  631+16	STA 619+89 IISCELLANEOUS STA 627+00 STA 619+89	RT TOTAL:  RETAINING WAL OFFSET CL TOTAL: S) OFFSET LT TOTAL:  OFFSET RT TOTAL:  RT RT RT RT RT RT RT RT	L.F. REMARKS  41  41  C.Y. REMARKS  16.6 CONCRETE M  16.6  S.F. REMARKS  43  43  43  L.F. REMARKS  7  11  11  11  7	EDIAN BARRIER				TOTAL:		
ERGUSON AVE ERGUSON AVE ERGUSON AVE ERGUSON AVE ERGUSON AVE  621-99.02 - GREEN ME OCATION ERGUSON AVE	623+00 627+00 631+00 635+00  ETHYL METHACR STA 623+00  S V REINFORCED STA 627+00 631+00 635+00  S V REINFORCED STA 624+24	627+00 631+00 635+00 638+83  YLATE (MMA) P STA 627+00  CONCRETE PI STA 631+00 635+00 638+83  CONCRETE PI STA 635+00 638+83	LT/RT LT/RT LT/RT LT/RT TOTAL:  AVEMENT MAR  OFFSET LT/RT TOTAL:  PE CULVERT (G OFFSET LT LT LT LT TOTAL:  PE CULVERT (G OFFSET LT LT LT TOTAL:  OFFSET LT LT LT TOTAL:  PE CULVERT (G OFFSET LT LT LT TOTAL:  PE CULVERT (G OFFSET LT LT LT LT TOTAL:  RT	359 625 275 375 2134  KING S.F. 1795 1795  ASKET TYPE) L.F. 303 243 42 588  ASKET TYPE) L.F. 157 138 295	REMARKS  REMARKS  REMARKS	STRUCTURAL ITEMS:  202-10.28 - DISASSEMB LOCATION FERGUSON AVE  703-20.02 - CLASS "B" ( LOCATION FERGUSON AVE  703-90.26 - BRICK RETA LOCATION FERGUSON AVE  PEDESTRIAN ITEMS:  607-30.00 HANDRAIL (GLOCATION FERGUSON AVE FERGUSON AVE FERGUSON AVE FERGUSON AVE FERGUSON AVE	638+96  BLY AND STORA  STA  619+45  CONCRETE (M  STA  623+00  AINING WALL  STA  619+45  619+45  631+16  634+94	STA 619+89 IISCELLANEOUS STA 627+00 STA 619+89	RT TOTAL:  RETAINING WAL OFFSET CL TOTAL: S) OFFSET LT TOTAL:  OFFSET RT TOTAL:  RT TOTAL:  RT RT RT RT RT RT	L.F. REMARKS  41  41  C.Y. REMARKS  16.6 CONCRETE M  16.6  S.F. REMARKS  43  43	EDIAN BARRIER				TOTAL:		
ERGUSON AVE ERGUSON AVE ERGUSON AVE ERGUSON AVE ERGUSON AVE  621-99.02 - GREEN ME OCATION ERGUSON AVE	623+00 627+00 631+00 635+00  ETHYL METHACR STA 623+00  S V REINFORCED STA 627+00 631+00 635+00  S V REINFORCED STA 624+00 635+00	627+00 631+00 635+00 638+83  YLATE (MMA) P STA 627+00  CONCRETE PI STA 631+00 635+00 638+83  CONCRETE PI STA 635+00 638+83	LT/RT LT/RT LT/RT LT/RT TOTAL:  AVEMENT MARI OFFSET LT/RT TOTAL:  PE CULVERT (G OFFSET LT LT LT LT TOTAL:  PE CULVERT (G OFFSET LT LT LT TOTAL:  OFFSET LT	359 625 275 375 2134 KING S.F. 1795 1795 ASKET TYPE) L.F. 303 243 42 588 ASKET TYPE) L.F. 157 138 295	REMARKS  REMARKS  REMARKS	STRUCTURAL ITEMS:  202-10.28 - DISASSEMB LOCATION FERGUSON AVE  703-20.02 - CLASS "B" ( LOCATION FERGUSON AVE  703-90.26 - BRICK RETA LOCATION FERGUSON AVE  PEDESTRIAN ITEMS:  607-30.00 HANDRAIL (GLOCATION FERGUSON AVE FERGUSON AVE FERGUSON AVE FERGUSON AVE FERGUSON AVE	638+96  BLY AND STORA  STA  619+45  CONCRETE (M  STA  623+00  AINING WALL  STA  619+45  619+45  631+16  634+94	STA 619+89 IISCELLANEOUS STA 627+00 STA 619+89	RT TOTAL:  RETAINING WAL OFFSET CL TOTAL: S) OFFSET LT TOTAL:  OFFSET RT TOTAL:  RT TOTAL:  RT RT RT RT RT RT RT RT	L.F. REMARKS  41  41  C.Y. REMARKS  16.6 CONCRETE M  16.6  S.F. REMARKS  43  43  43  L.F. REMARKS  7  11  11  11  7	EDIAN BARRIER				TOTAL:		
ERGUSON AVE ERGUSON AVE ERGUSON AVE ERGUSON AVE ERGUSON AVE  621-99.02 - GREEN ME OCATION ERGUSON AVE	623+00 627+00 631+00 635+00  ETHYL METHACR STA 623+00  S V REINFORCED STA 627+00 631+00 635+00  S V REINFORCED STA 624+00 635+00	627+00 631+00 635+00 638+83  YLATE (MMA) P STA 627+00  CONCRETE PI STA 631+00 635+00 638+83  CONCRETE PI STA 635+00 638+83	LT/RT LT/RT LT/RT LT/RT TOTAL:  AVEMENT MAR  OFFSET LT/RT TOTAL:  PE CULVERT (G OFFSET LT LT LT LT TOTAL:  PE CULVERT (G OFFSET LT LT LT TOTAL:  OFFSET LT LT LT TOTAL:  PE CULVERT (G OFFSET LT LT LT TOTAL:  PE CULVERT (G OFFSET LT LT LT LT TOTAL:  RT	359 625 275 375 2134  KING S.F. 1795 1795  ASKET TYPE) L.F. 303 243 42 588  ASKET TYPE) L.F. 157 138 295	REMARKS  REMARKS  REMARKS	STRUCTURAL ITEMS:  202-10.28 - DISASSEMB LOCATION FERGUSON AVE  703-20.02 - CLASS "B" ( LOCATION FERGUSON AVE  703-90.26 - BRICK RETA LOCATION FERGUSON AVE  PEDESTRIAN ITEMS:  607-30.00 HANDRAIL (G LOCATION FERGUSON AVE FERGUSON AVE FERGUSON AVE FERGUSON AVE FERGUSON AVE FERGUSON AVE	638+96  BLY AND STORA  STA  619+45  CONCRETE (M  STA  623+00  AINING WALL  STA  619+45  619+45  631+16  634+94  637+16	STA 619+89 IISCELLANEOUS STA 627+00 STA 619+89	RT TOTAL:  RETAINING WAL OFFSET CL TOTAL: S) OFFSET LT TOTAL:  OFFSET RT TOTAL:  RT TOTAL:  RT RT RT RT RT RT RT RT	L.F. REMARKS  41  41  C.Y. REMARKS  16.6 CONCRETE M  16.6  S.F. REMARKS  43  43  43  L.F. REMARKS  7  11  11  11  7	EDIAN BARRIER				TOTAL:		
ERGUSON AVE ERGUSON AVE ERGUSON AVE ERGUSON AVE  621-99.02 - GREEN ME OCATION ERGUSON AVE  726-25.12 - 12" CLASS OCATION ERGUSON AVE	623+00 627+00 631+00 635+00  ETHYL METHACR STA 623+00  S V REINFORCED STA 627+00 631+00 635+00  S V REINFORCED STA 624+00 635+00	627+00 631+00 635+00 638+83  YLATE (MMA) P STA 627+00  CONCRETE PI STA 631+00 635+00 638+83  CONCRETE PI STA 635+00 638+83	LT/RT LT/RT LT/RT LT/RT TOTAL:  AVEMENT MAR  OFFSET LT/RT TOTAL:  PE CULVERT (G OFFSET LT LT LT LT TOTAL:  PE CULVERT (G OFFSET LT LT LT TOTAL:  OFFSET LT LT LT TOTAL:  PE CULVERT (G OFFSET LT LT LT TOTAL:  PE CULVERT (G OFFSET LT LT LT LT TOTAL:  RT	359 625 275 375 2134  KING S.F. 1795 1795  ASKET TYPE) L.F. 303 243 42 588  ASKET TYPE) L.F. 157 138 295	REMARKS  REMARKS  REMARKS	STRUCTURAL ITEMS:  202-10.28 - DISASSEMB LOCATION FERGUSON AVE  703-20.02 - CLASS "B" ( LOCATION FERGUSON AVE  703-90.26 - BRICK RETA LOCATION FERGUSON AVE  PEDESTRIAN ITEMS:  607-30.00 HANDRAIL (GLOCATION FERGUSON AVE FERGUSON AVE FERGUSON AVE FERGUSON AVE FERGUSON AVE	638+96  BLY AND STORA  STA  619+45  CONCRETE (M  STA  623+00  AINING WALL  STA  619+45  619+45  631+16  634+94  637+16	STA 619+89 IISCELLANEOUS STA 627+00 STA 619+89	RT TOTAL:  RETAINING WAL OFFSET CL TOTAL: S) OFFSET LT TOTAL:  OFFSET RT TOTAL:  RT TOTAL:  RT RT RT RT RT RT RT RT	L.F. REMARKS  41  41  C.Y. REMARKS  16.6 CONCRETE M  16.6  S.F. REMARKS  43  43  43  L.F. REMARKS  7  11  11  11  7	EDIAN BARRIER				TOTAL:		
ERGUSON AVE ERGUSON AVE ERGUSON AVE ERGUSON AVE ERGUSON AVE  621-99.02 - GREEN ME OCATION ERGUSON AVE	623+00 627+00 631+00 635+00  ETHYL METHACR STA 623+00  S V REINFORCED STA 627+00 631+00 635+00  S V REINFORCED STA 624+00 635+00	627+00 631+00 635+00 638+83  YLATE (MMA) P STA 627+00  CONCRETE PI STA 631+00 635+00 638+83  CONCRETE PI STA 635+00 638+83	LT/RT LT/RT LT/RT LT/RT TOTAL:  AVEMENT MAR  OFFSET LT/RT TOTAL:  PE CULVERT (G OFFSET LT LT LT LT TOTAL:  PE CULVERT (G OFFSET LT LT LT TOTAL:  OFFSET LT LT LT TOTAL:  PE CULVERT (G OFFSET LT LT LT TOTAL:  PE CULVERT (G OFFSET LT LT LT LT TOTAL:  RT	359 625 275 375 2134  KING S.F. 1795 1795  ASKET TYPE) L.F. 303 243 42 588  ASKET TYPE) L.F. 157 138 295	REMARKS  REMARKS  REMARKS	STRUCTURAL ITEMS:  202-10.28 - DISASSEMB LOCATION FERGUSON AVE  703-20.02 - CLASS "B" ( LOCATION FERGUSON AVE  703-90.26 - BRICK RETA LOCATION FERGUSON AVE  PEDESTRIAN ITEMS:  607-30.00 HANDRAIL (G LOCATION FERGUSON AVE FERGUSON AVE FERGUSON AVE FERGUSON AVE FERGUSON AVE FERGUSON AVE	638+96  BLY AND STORA  STA  619+45  CONCRETE (M  STA  623+00  AINING WALL  STA  619+45  631+16  634+94  637+16  LING, 54"	STA 619+89 IISCELLANEOUS STA 627+00 STA 619+89	RT TOTAL:  RETAINING WAL OFFSET CL TOTAL: S) OFFSET LT TOTAL:  OFFSET RT TOTAL:  RT TOTAL:  TOTAL:  TOTAL:  OFFSET RT TOTAL:  TOTAL:  TOTAL:  OFFSET RT TOTAL:  TOTAL:	L.F. REMARKS  41  41  C.Y. REMARKS  16.6 CONCRETE M  16.6  S.F. REMARKS  43  43  41  L.F. REMARKS  7  11  11  7  36	EDIAN BARRIER				TOTAL:		
ERGUSON AVE ERGUSON AVE ERGUSON AVE ERGUSON AVE  621-99.02 - GREEN ME OCATION ERGUSON AVE  726-25.12 - 12" CLASS OCATION ERGUSON AVE	623+00 627+00 631+00 635+00  ETHYL METHACR STA 623+00  S V REINFORCED STA 627+00 631+00 635+00  S V REINFORCED STA 624+00 635+00	627+00 631+00 635+00 638+83  YLATE (MMA) P STA 627+00  CONCRETE PI STA 631+00 635+00 638+83  CONCRETE PI STA 635+00 638+83	LT/RT LT/RT LT/RT LT/RT TOTAL:  AVEMENT MAR  OFFSET LT/RT TOTAL:  PE CULVERT (G OFFSET LT LT LT LT TOTAL:  PE CULVERT (G OFFSET LT LT LT TOTAL:  OFFSET LT LT LT TOTAL:  PE CULVERT (G OFFSET LT LT LT TOTAL:  PE CULVERT (G OFFSET LT LT LT LT TOTAL:  RT	359 625 275 375 2134  KING S.F. 1795 1795  ASKET TYPE) L.F. 303 243 42 588  ASKET TYPE) L.F. 157 138 295	REMARKS  REMARKS  REMARKS	STRUCTURAL ITEMS:  202-10.28 - DISASSEMB LOCATION FERGUSON AVE  703-20.02 - CLASS "B" ( LOCATION FERGUSON AVE  703-90.26 - BRICK RETA LOCATION FERGUSON AVE  PEDESTRIAN ITEMS:  607-30.00 HANDRAIL (G LOCATION FERGUSON AVE	638+96  BLY AND STORA  STA 619+45  CONCRETE (M  STA 623+00  AINING WALL  STA 619+45  CALVANIZED PI  STA 631+16 634+94 637+16  LING, 54"  STA	STA   619+89	RT TOTAL:  RETAINING WAL OFFSET CL TOTAL:  S) OFFSET LT TOTAL:  OFFSET RT	L.F. REMARKS  41  41  41  C.Y. REMARKS  16.6 CONCRETE M  16.6  S.F. REMARKS  43  43  43  41  L.F. REMARKS  7  11  11  7  36	EDIAN BARRIER				TOTAL:		
ERGUSON AVE ERGUSON AVE ERGUSON AVE ERGUSON AVE  621-99.02 - GREEN ME OCATION ERGUSON AVE  726-25.12 - 12" CLASS OCATION ERGUSON AVE	623+00 627+00 631+00 635+00  ETHYL METHACR STA 623+00  S V REINFORCED STA 627+00 631+00 635+00  S V REINFORCED STA 624+00 635+00	627+00 631+00 635+00 638+83  YLATE (MMA) P STA 627+00  CONCRETE PI STA 631+00 635+00 638+83  CONCRETE PI STA 635+00 638+83	LT/RT LT/RT LT/RT LT/RT TOTAL:  AVEMENT MAR  OFFSET LT/RT TOTAL:  PE CULVERT (G OFFSET LT LT LT LT TOTAL:  PE CULVERT (G OFFSET LT LT LT TOTAL:  OFFSET LT LT LT TOTAL:  PE CULVERT (G OFFSET LT LT LT TOTAL:  PE CULVERT (G OFFSET LT LT LT LT TOTAL:  RT	359 625 275 375 2134  KING S.F. 1795 1795  ASKET TYPE) L.F. 303 243 42 588  ASKET TYPE) L.F. 157 138 295	REMARKS  REMARKS  REMARKS	STRUCTURAL ITEMS:  202-10.28 - DISASSEMB LOCATION FERGUSON AVE  703-20.02 - CLASS "B" ( LOCATION FERGUSON AVE  703-90.26 - BRICK RETA LOCATION FERGUSON AVE  PEDESTRIAN ITEMS:  607-30.00 HANDRAIL (G LOCATION FERGUSON AVE	638+96  BLY AND STORA  STA  619+45  CONCRETE (M  STA  623+00  AINING WALL  STA  619+45  631+16  634+94  637+16  LING, 54"	STA   619+89	RT TOTAL:  RETAINING WAL OFFSET CL TOTAL: S) OFFSET LT TOTAL:  OFFSET RT TOTAL:  RT TOTAL:  OFFSET RT	L.F. REMARKS  41  41  41  C.Y. REMARKS  16.6 CONCRETE M  16.6  S.F. REMARKS  43  43  43  L.F. REMARKS  7  11  11  7  36  L.F. REMARKS		/25 RY IMP (	STIDAPPRON	/FD RY RRI			MENDED SOIL
ERGUSON AVE ERGUSON AVE ERGUSON AVE ERGUSON AVE ERGUSON AVE  621-99.02 - GREEN ME OCATION ERGUSON AVE	623+00 627+00 631+00 635+00  ETHYL METHACR STA 623+00  S V REINFORCED STA 627+00 631+00 635+00  S V REINFORCED STA 624+00 635+00	627+00 631+00 635+00 638+83  YLATE (MMA) P STA 627+00  CONCRETE PI STA 631+00 635+00 638+83  CONCRETE PI STA 635+00 638+83	LT/RT LT/RT LT/RT LT/RT TOTAL:  AVEMENT MAR  OFFSET LT/RT TOTAL:  PE CULVERT (G OFFSET LT LT LT LT TOTAL:  PE CULVERT (G OFFSET LT LT LT TOTAL:  OFFSET LT LT LT TOTAL:  PE CULVERT (G OFFSET LT LT LT TOTAL:  PE CULVERT (G OFFSET LT LT LT LT TOTAL:  RT	359 625 275 375 2134  KING S.F. 1795 1795  ASKET TYPE) L.F. 303 243 42 588  ASKET TYPE) L.F. 157 138 295	REMARKS  REMARKS  REMARKS	STRUCTURAL ITEMS:  202-10.28 - DISASSEMB LOCATION FERGUSON AVE  703-20.02 - CLASS "B" ( LOCATION FERGUSON AVE  703-90.26 - BRICK RETA LOCATION FERGUSON AVE  PEDESTRIAN ITEMS:  607-30.00 HANDRAIL (G LOCATION FERGUSON AVE	638+96  BLY AND STORA  STA 619+45  CONCRETE (M  STA 623+00  AINING WALL  STA 619+45  CALVANIZED PI  STA 631+16 634+94 637+16  LING, 54"  STA	STA   619+89	RT TOTAL:  RETAINING WAL OFFSET CL TOTAL:  S) OFFSET LT TOTAL:  OFFSET RT	L.F. REMARKS  41  41  41  C.Y. REMARKS  16.6 CONCRETE M  16.6  S.F. REMARKS  43  43  43  41  L.F. REMARKS  7  11  11  7  36	3/7/	/25 BY JMD (	STL) APPROV	/ED BY BRI	R (STL): TO	PSOIL AND A	MENDED SOIL
ERGUSON AVE ERGUSON AVE ERGUSON AVE ERGUSON AVE ERGUSON AVE  21-99.02 - GREEN ME OCATION ERGUSON AVE	623+00 627+00 631+00 635+00  ETHYL METHACR STA 623+00  S V REINFORCED STA 627+00 631+00 635+00  S V REINFORCED STA 624+00 635+00	627+00 631+00 635+00 638+83  YLATE (MMA) P STA 627+00  CONCRETE PI STA 631+00 635+00 638+83  CONCRETE PI STA 635+00 638+83	LT/RT LT/RT LT/RT LT/RT TOTAL:  AVEMENT MAR  OFFSET LT/RT TOTAL:  PE CULVERT (G OFFSET LT LT LT LT TOTAL:  PE CULVERT (G OFFSET LT LT LT TOTAL:  OFFSET LT LT LT TOTAL:  PE CULVERT (G OFFSET LT LT LT TOTAL:  PE CULVERT (G OFFSET LT LT LT LT TOTAL:  RT	359 625 275 375 2134  KING S.F. 1795 1795  ASKET TYPE) L.F. 303 243 42 588  ASKET TYPE) L.F. 157 138 295	REMARKS  REMARKS  REMARKS	STRUCTURAL ITEMS:  202-10.28 - DISASSEMB LOCATION FERGUSON AVE  703-20.02 - CLASS "B" ( LOCATION FERGUSON AVE  703-90.26 - BRICK RETA LOCATION FERGUSON AVE  PEDESTRIAN ITEMS:  607-30.00 HANDRAIL (G LOCATION FERGUSON AVE	638+96  BLY AND STORA  STA 619+45  CONCRETE (M  STA 623+00  AINING WALL  STA 619+45  CALVANIZED PI  STA 631+16 634+94 637+16  LING, 54"  STA	STA   619+89	RT TOTAL:  RETAINING WAL OFFSET CL TOTAL: S) OFFSET LT TOTAL:  OFFSET RT TOTAL:  RT TOTAL:  OFFSET RT	L.F. REMARKS  41  41  41  C.Y. REMARKS  16.6 CONCRETE M  16.6  S.F. REMARKS  43  43  43  L.F. REMARKS  7  11  11  7  36  L.F. REMARKS	3/7/	/25 BY JMD (S	STL) APPROV	/ED BY BRID PREPAR/	R (STL): TO	PSOIL AND A	MENDED SOIL FICATION
ERGUSON AVE ERGUSON AVE ERGUSON AVE ERGUSON AVE  621-99.02 - GREEN ME OCATION ERGUSON AVE  726-25.12 - 12" CLASS OCATION ERGUSON AVE	623+00 627+00 631+00 635+00  ETHYL METHACR STA 623+00  S V REINFORCED STA 627+00 631+00 635+00  S V REINFORCED STA 624+00 635+00	627+00 631+00 635+00 638+83  YLATE (MMA) P STA 627+00  CONCRETE PI STA 631+00 635+00 638+83  CONCRETE PI STA 635+00 638+83	LT/RT LT/RT LT/RT LT/RT TOTAL:  AVEMENT MAR  OFFSET LT/RT TOTAL:  PE CULVERT (G OFFSET LT LT LT LT TOTAL:  PE CULVERT (G OFFSET LT LT LT TOTAL:  OFFSET LT LT LT TOTAL:  PE CULVERT (G OFFSET LT LT LT TOTAL:  PE CULVERT (G OFFSET LT LT LT LT TOTAL:  RT	359 625 275 375 2134  KING S.F. 1795 1795  ASKET TYPE) L.F. 303 243 42 588  ASKET TYPE) L.F. 157 138 295	REMARKS  REMARKS  REMARKS	STRUCTURAL ITEMS:  202-10.28 - DISASSEMB LOCATION FERGUSON AVE  703-20.02 - CLASS "B" ( LOCATION FERGUSON AVE  703-90.26 - BRICK RETA LOCATION FERGUSON AVE  PEDESTRIAN ITEMS:  607-30.00 HANDRAIL (G LOCATION FERGUSON AVE	638+96  BLY AND STORA  STA 619+45  CONCRETE (M  STA 623+00  AINING WALL  STA 619+45  CALVANIZED PI  STA 631+16 634+94 637+16  LING, 54"  STA	STA   619+89	RT TOTAL:  RETAINING WAL OFFSET CL TOTAL: S) OFFSET LT TOTAL:  OFFSET RT TOTAL:  RT TOTAL:  OFFSET RT	L.F. REMARKS  41  41  41  C.Y. REMARKS  16.6 CONCRETE M  16.6  S.F. REMARKS  43  43  43  L.F. REMARKS  7  11  11  7  36  L.F. REMARKS	3/7/	/25 BY JMD (SANTITY CORE	STL) APPROV	/ED BY BRID PREPARA	R (STL): TO	PSOIL AND A	MENDED SOIL FICATION

803-10.00 - SODDING

609-10.55 - CURB AND GUTTER, MOUNTABLE (3")





720 Olive, Suite 700 St. Louis, MO 63101 314.588.8381 www.oatesassociates.com

Collinsville St. Louis Belleville St. Charles MISSOURI DESIGN FIRM LICENSE NO.: 001166

SUBMITTALS	
ISSUE:	DATE:
DESIGN - 30%	12/30/2020
DESIGN - 70%	02/18/2022
DESIGN - 95%	11/07/2023
DESIGN - 100%	02/29/2024

**FERGUSON AVE** 



EXP. 12/31/24

STP PROJECT NO.: STP-9901(666)

> PROJECT NO.: 220044

DATE:

02/29/2024 DRAWING TITLE:
SCHEDULES

FERGUSON AVE (3 OF 3)

DRAWING NO.:

FERG-C2.03
SHEET 24 OF106
COPYRIGHT 2024 BY OATES ASSOCIATES