




502

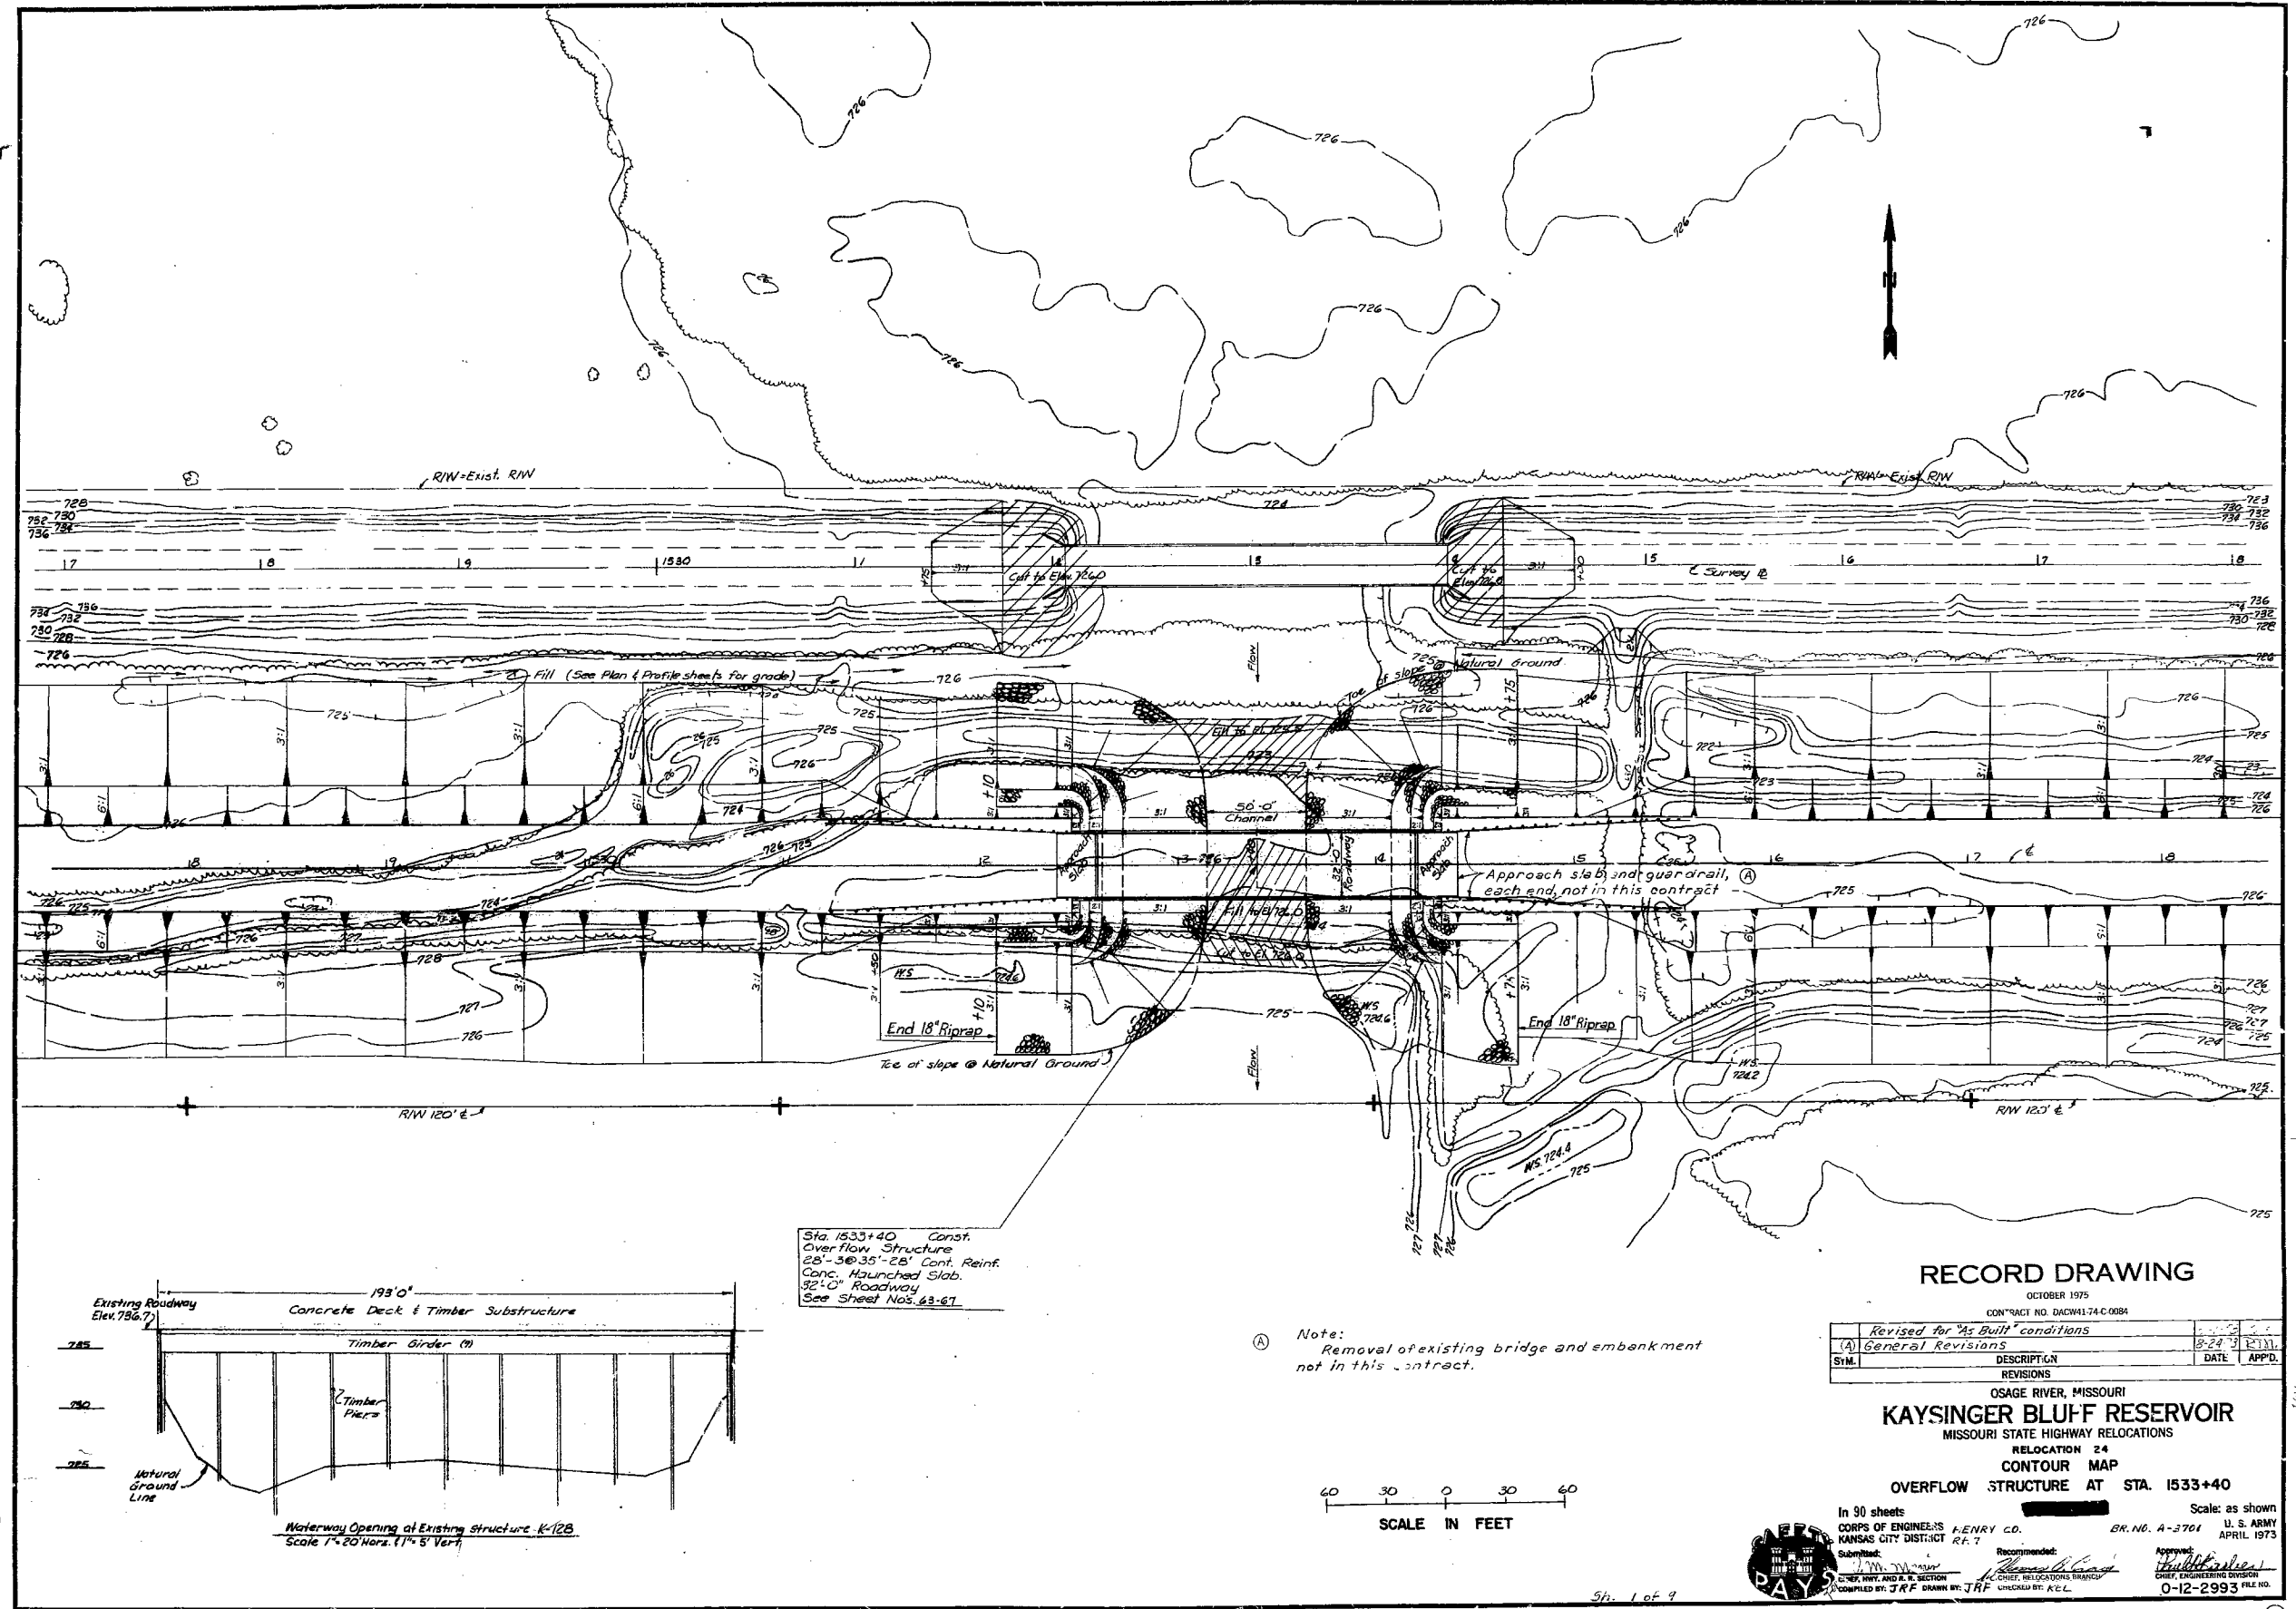


862 29 TO 1

503

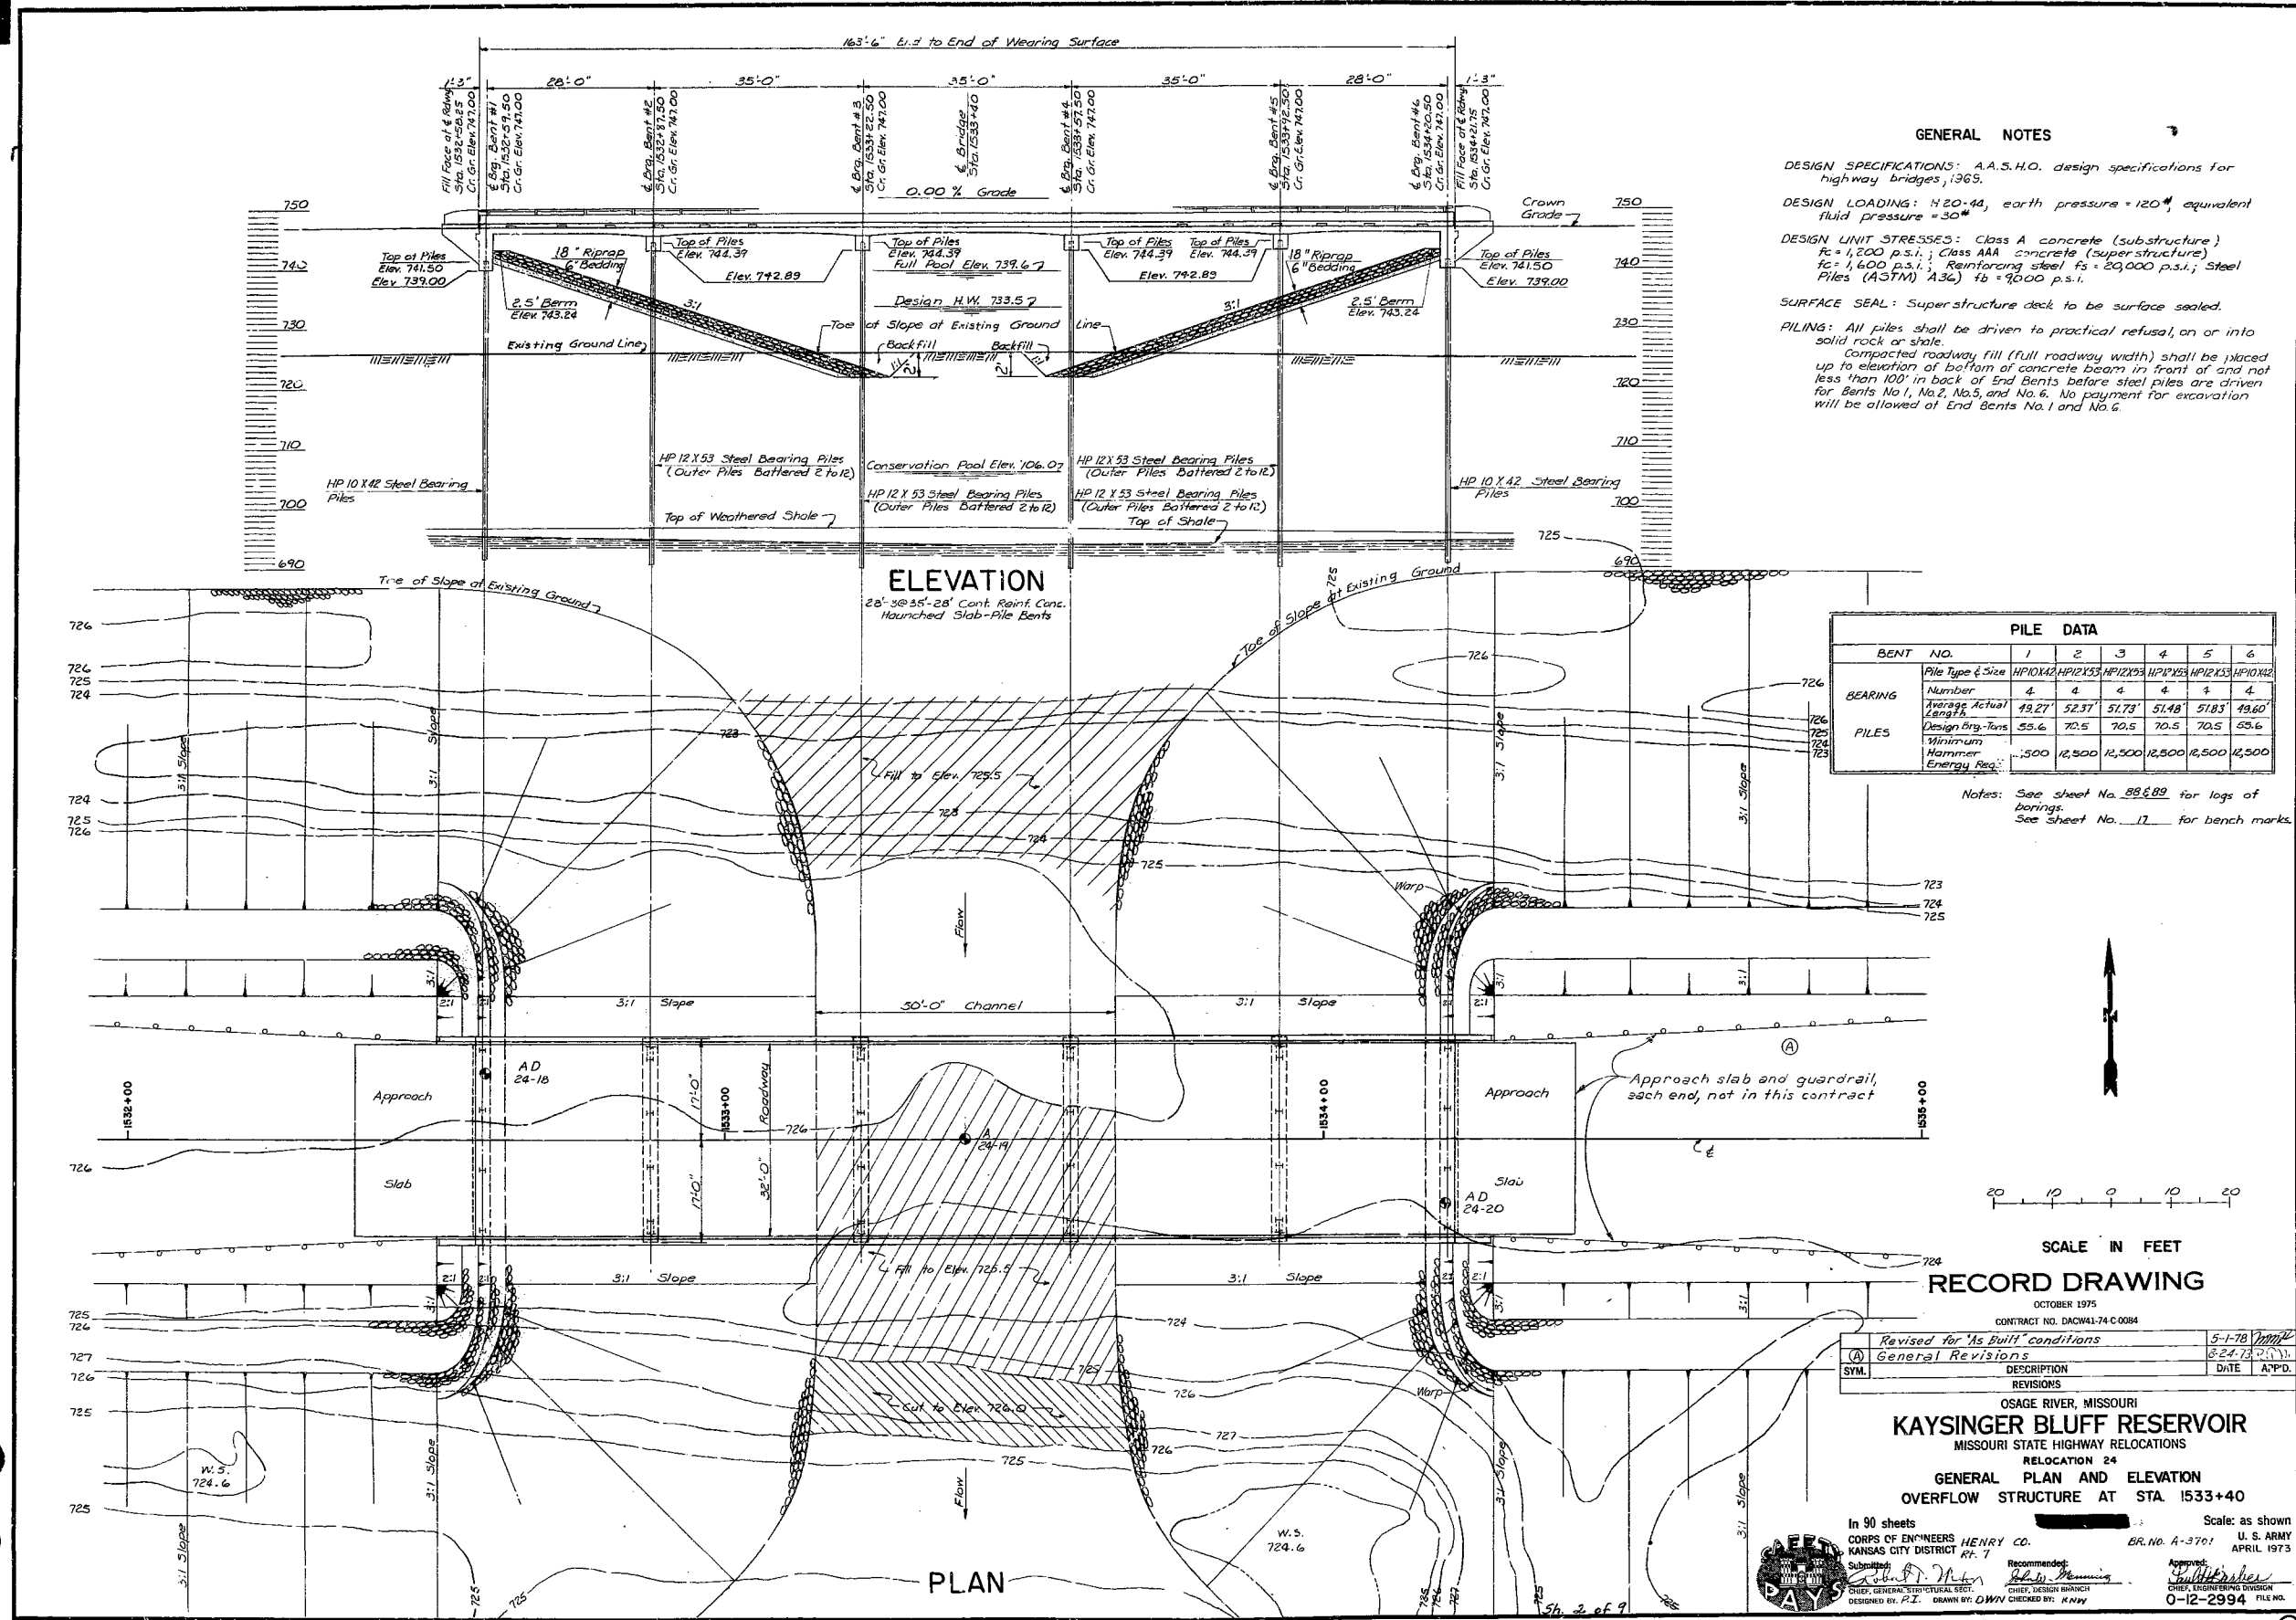


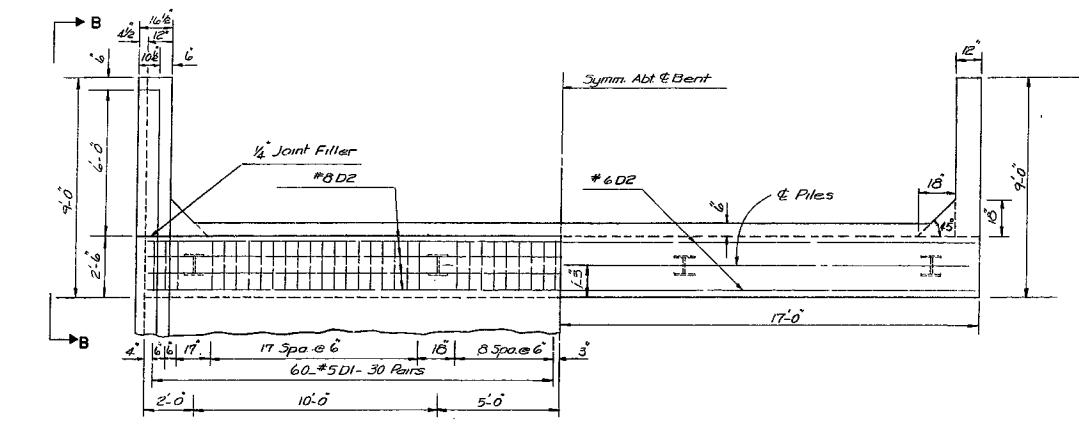


SECTION A-A

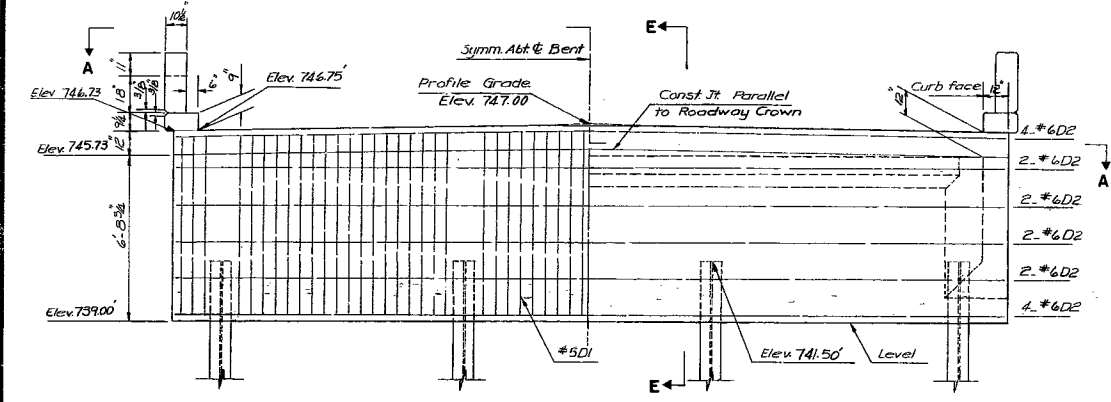


ELEVATION

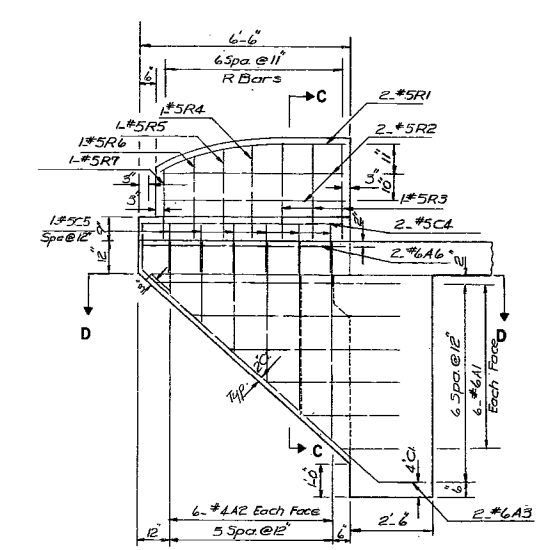


SECTION B-B

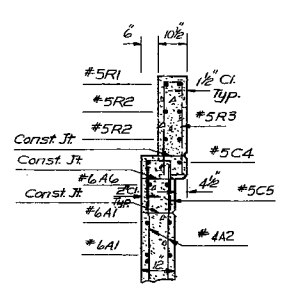

SECTION C-C

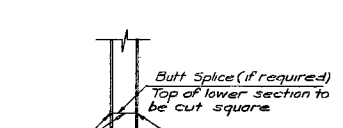


PILE SPlice DETAIL

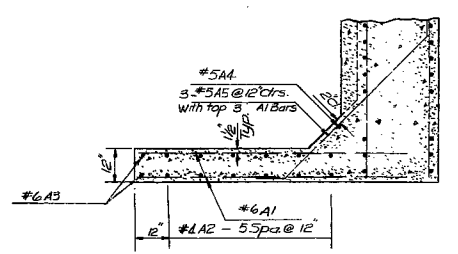


SECTION D-D

END BENTS 1 & 6

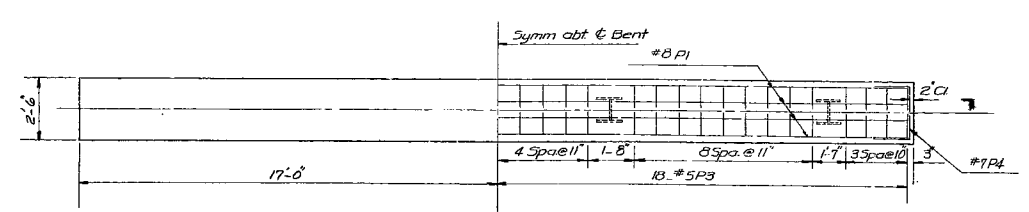


PLAN

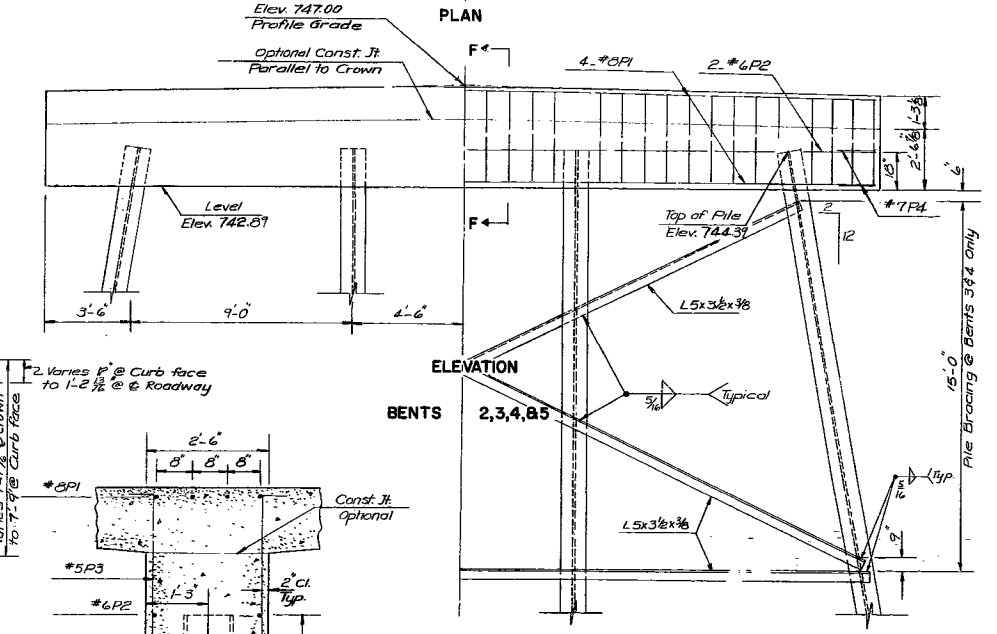


ELEVATION BENTS 2, 3, 4, & 5

SECTION F-F

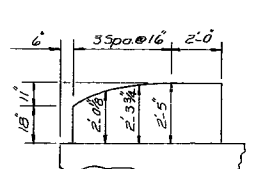

END POST

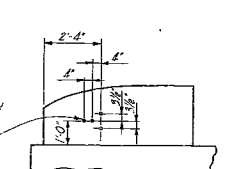

GUARDRAIL CONNECTION

GENERAL NOTES

For notes and details of railing see sheet No. 67
Piles are to be HP 10 X 42 at end bents, and HP 12 X 53 at intermediate bents.
Fill at end bents No. 1 & 6 shall not be carried above bottom of beam and wings until adjacent superstructure span is in place.

RECORD DRAWING

OCTOBER 1975
CONTRACT NO. DACW41-74-C-0084

SYM.	DESCRIPTION	DATE	APP'D.
	Revised for "As Built" conditions	5-1-78	PHM
	REVISIONS		

OSAGE RIVER, MISSOURI
KAYSINGER BLUFF RESERVOIR
MISSOURI STATE HIGHWAY RELOCATIONS

RELOCATION 24
BENTS 1, 2, 3, 4, 5 & 6
OVERFLOW STRUCTURE AT STA. 1533+40

In 90 sheets
CORPS OF ENGINEERS HENRY C. KANSAS CITY DISTRICT RE-1
Submitted: *Robert D. Miller*
Recommended: *Robert D. Miller*
Checked: *Robert D. Miller*
Designed: *Robert D. Miller*
Drawn: *Robert D. Miller*
Scale: as shown
U. S. ARMY
APRIL 1975
0-12-2996
FILE NO.



BUCHER & WILLIS, Consulting Engineers, Planners & Architects





(65)

505

862 29 TO 1

Note: This drawing is not to scale. Follow dimensions.

Sh. 4 of 9

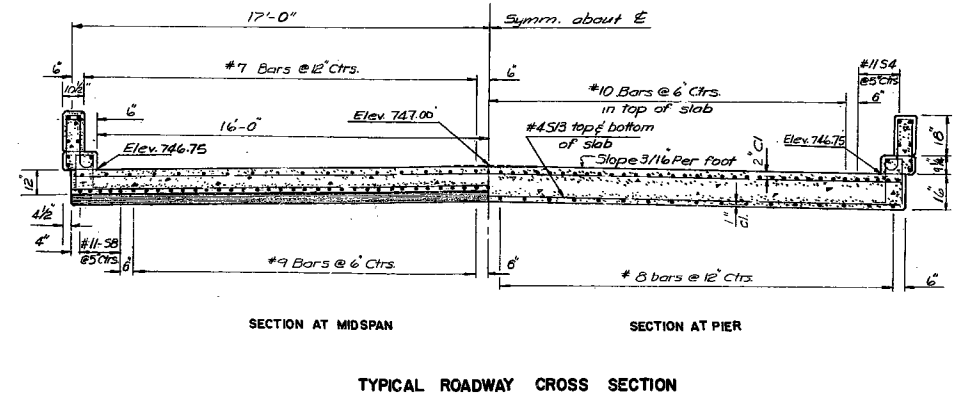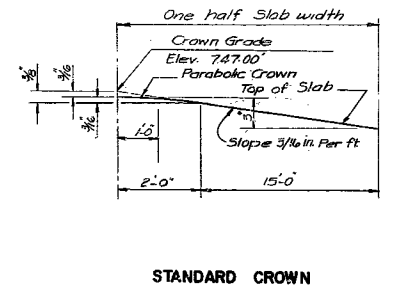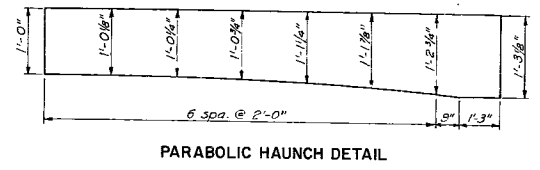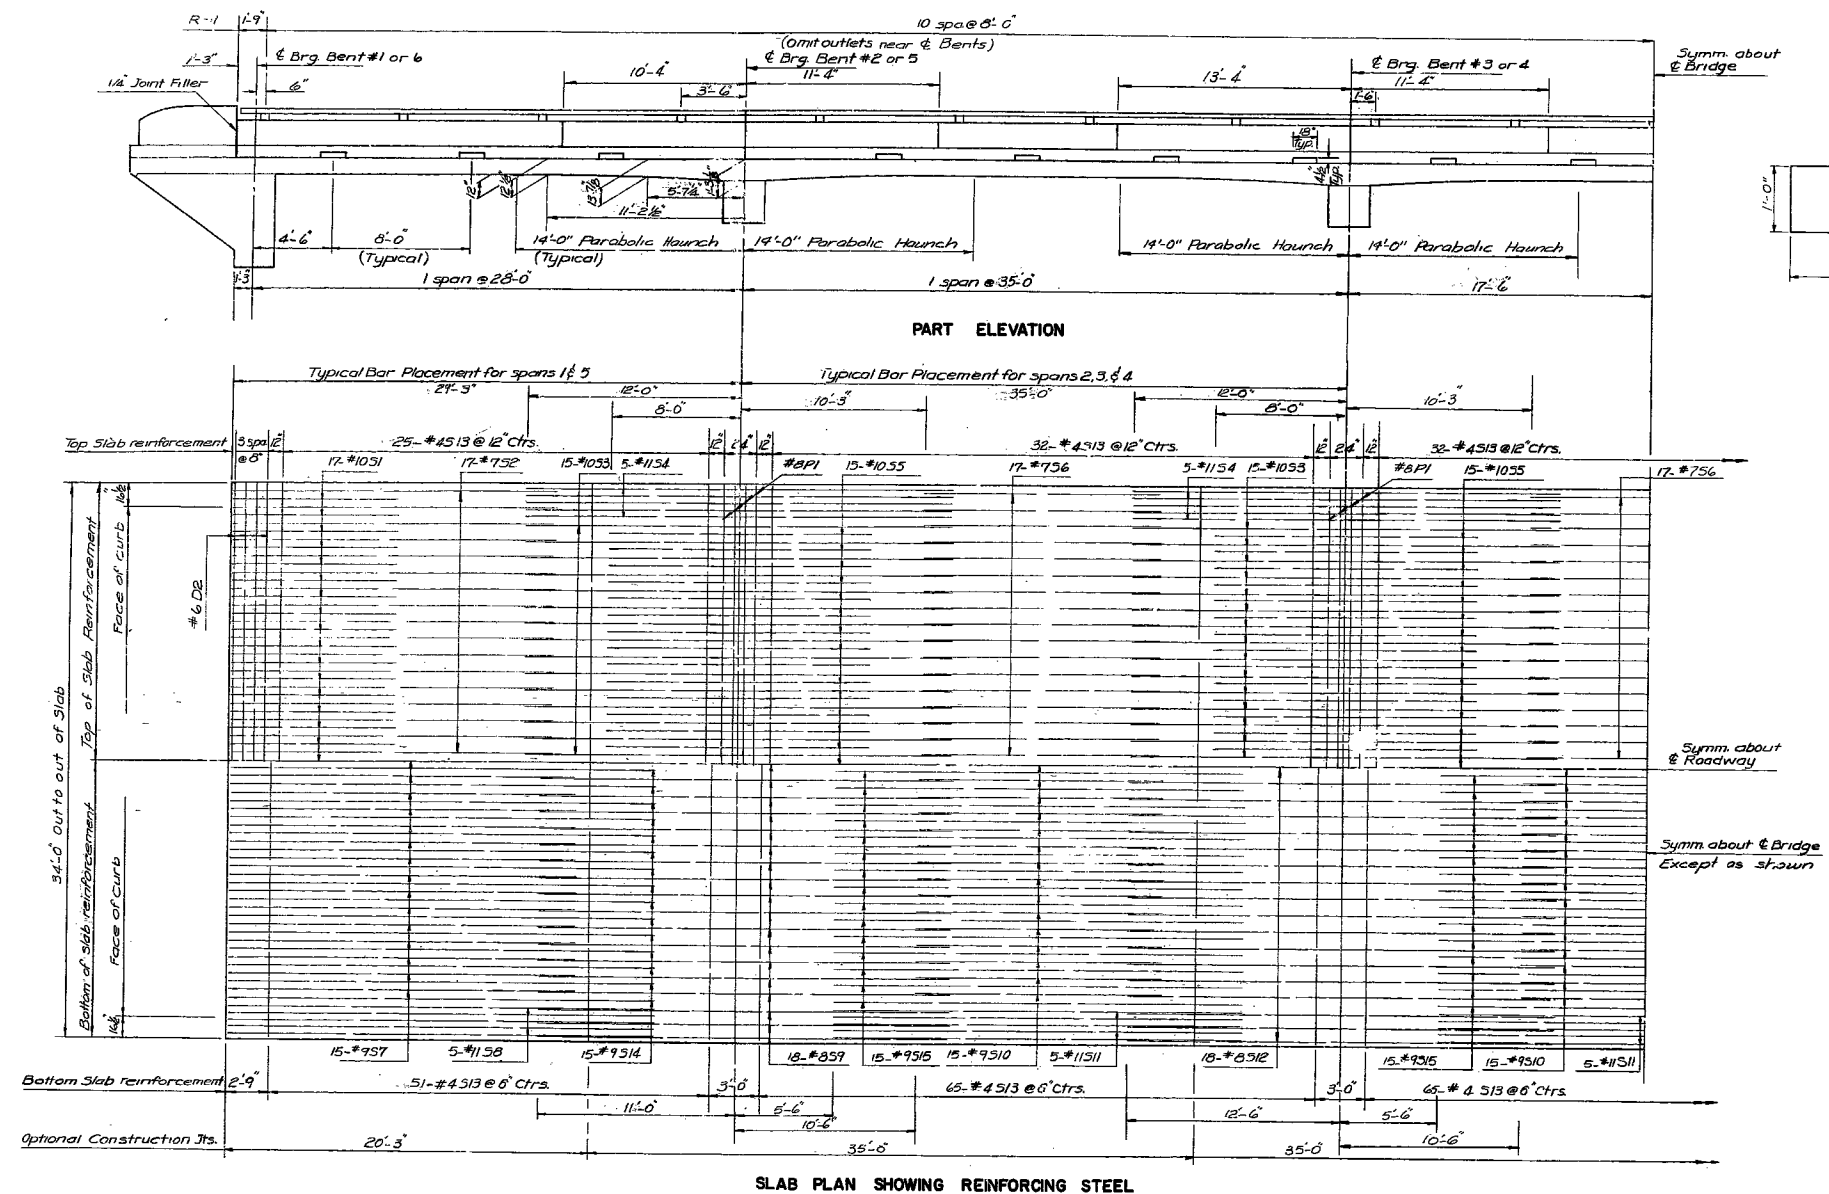

GENERAL NOTES

For Handrail, Parapet, and Curb Details and notes see sheet 15.62.

For Slab Pouring Sequence and optional Construction Joints see Sheet 15.62.

RECORD DRAWING

OCTOBER 1975
CONTRACT NO. DACW41-74-C-0084

SYMBOL	Revised for "As Built" conditions	DATE	5-1-78
DESCRIPTION	REVISIONS	DATE	APPROVED

OSAGE RIVER, MISSOURI
KAYSINGER BLUFF RESERVOIR
MISSOURI STATE HIGHWAY RELOCATIONS
RELOCATION 24
SLAB PLAN AND CROSS SECTION
OVERFLOW STRUCTURE AT STA. 1533+40

In 90 sheets
CORPS OF ENGINEERS HENRY CO.
KANSAS CITY DISTRICT RT. 7

Scale: as shown
BR. NO. 4-3761
U. S. ARMY
APRIL 1973

Submitted: [Signature]
Recommended: [Signature]
Approved: [Signature]

DESIGNED BY: E.H. BUNN BY: R.L. [Signature]
CHECKED BY: K.W.V. [Signature]


CHIEF, GENERAL STRUCTURAL SECT.
CHIEF, DESIGN BRANCH
CHIEF, ENGINEERING DIVISION

0-12-2997 FILE NO.


BUCHER & WILLIS, Consulting Engineers, Planners & Architects

506


862 29 TO 1

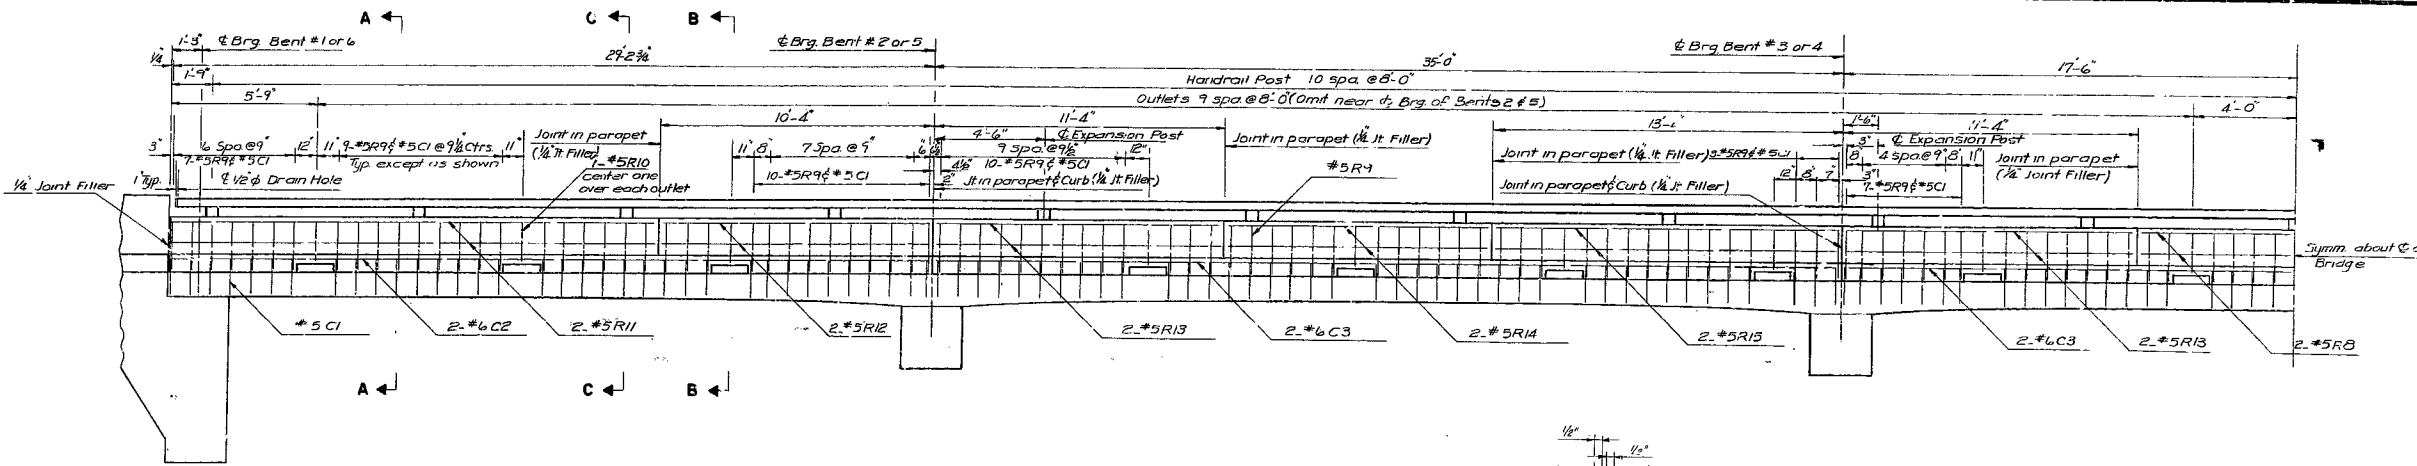

PARAPET DETAIL

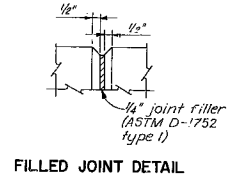


FILLED JOINT DETAIL

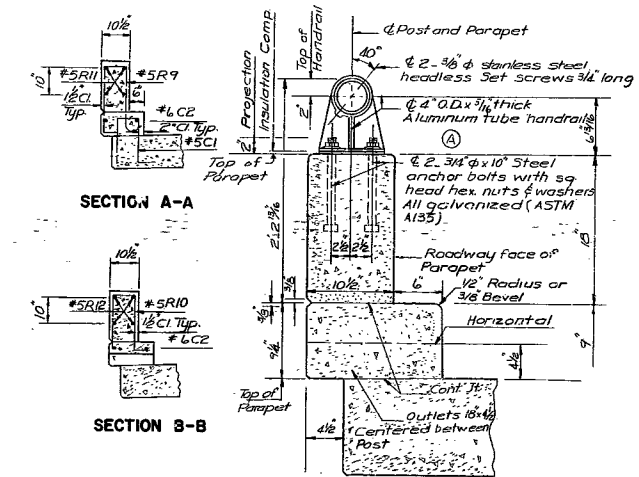


SECTION A-A

SECTION B-B


SECTION C-C

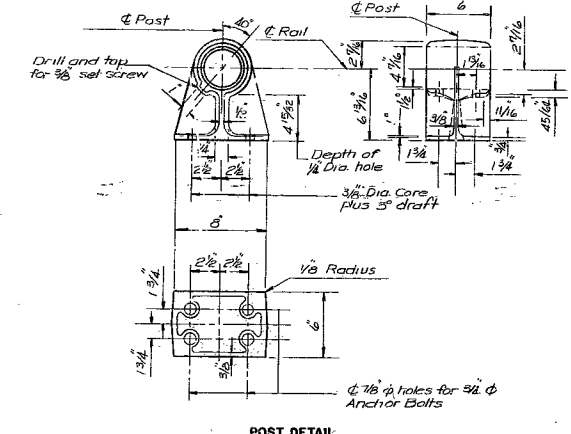

POST DETAIL

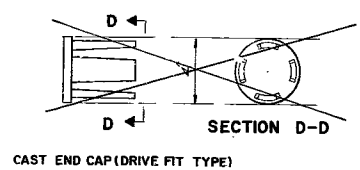

CAST END CAP (DRIVE FIT TYPE)

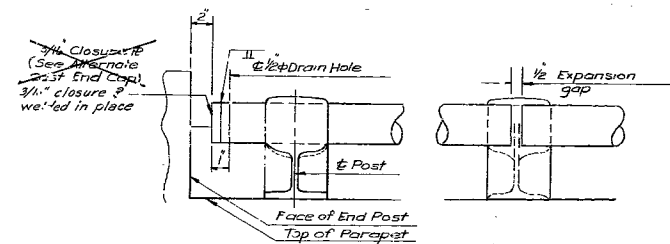

RAIL SPLICE OR EXPANSION POST DETAIL

GENERAL NOTES

All handrail posts shall be set normal to grade. Aluminum washer shims between top of parapet and post base may be used for adjusting handrail alignment. Maximum thickness of shims to be 1/8 inch. Where more fitting of post is required for proper alignment concrete bearing areas shall be ground down.

All parts of handrail, except anchor bolts, nuts, washers, and set screws are to be of aluminum material.

All fillets 1/4 inch except as noted.

All drafts 3 degrees except as noted.

Pipe rail to be fabricated in two or three panel lengths unless otherwise approved.

Omit set screw on side near filled joint in parapet at all expansion posts.

Top of curbs and parapets to be built parallel to grade.


Vertical faces of endposts to be vertical.

All exposed edges of endposts, parapets, and curbs shall have 1/8 inch radius or 1/8 inch bevel.


Curbs shall be placed independently of slab, and not sooner than five days after slab has been placed. Curb placement shall follow the same pouring sequence as the slab unless otherwise approved.

SEQUENCE OF POURS				
Direction				
Basic Sequence	Either Dir	3 to 1	4 to 2	5 to 3
Alternate "A" Pour		1+2+3+4+5		End to 4
		End to End		

The contractor shall use an approved oscillating screed type, self propelled mechanical finishing machine and shall pour and satisfactorily finish the roadway slab at a rate of not less than 30 cubic yards per hour. He shall observe the transverse construction joints shown on plans unless he can demonstrate to the satisfaction of engineer that he is equipped to pour and satisfactorily finish the roadway slab at a rate which will permit a continuous pouring through some or all of these joints. Finishing machine work will not be permitted on concrete less than 48 hours old.

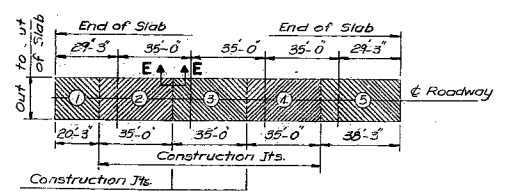


SLAB POURING SEQUENCE

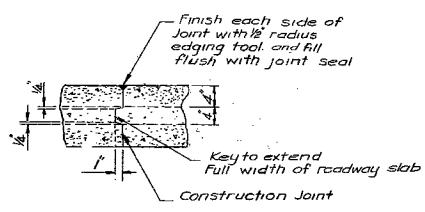

SECTION E-E

Note:
This drawing is not to scale. Follow dimensions.

HANDRAIL DETAILS

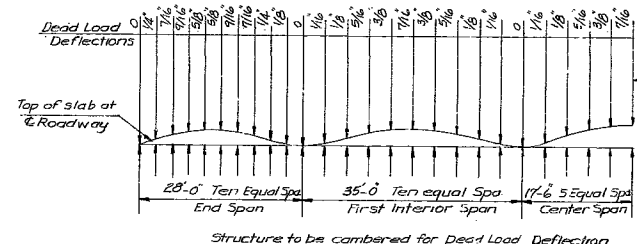

CAMBER DIAGRAM

SYMBOL	DESCRIPTION	DATE	APP'D.
Revised for "As built" conditions		5-1-78	
General Revisions		8-24-78	


OSAGE RIVER, MISSOURI
KAYSINGER BLUFF RESERVOIR
MISSOURI STATE HIGHWAY RELOCATIONS
RELOCATION: 24
PARAPET, HANDRAIL & MISCELLANEOUS DETAILS
OVERFLOW STRUCTURE AT STA. 1533+40

In 90 sheets
CORPS OF ENGINEERS
KANSAS CITY DISTRICT
Submitted: *[Signature]*
Checked by: *[Signature]*
Recommended: *[Signature]*
Approved: *[Signature]*
Scale: as shown
U. S. ARMY
APRIL 1973
0-12-2998
BUCHER & WILLIS, Consulting Engineers, Planners & Architects

RECORD DRAWING

OCTOBER 1975
CONTRACT NO. DACW41-74-C-0084

5h. 6 of 9

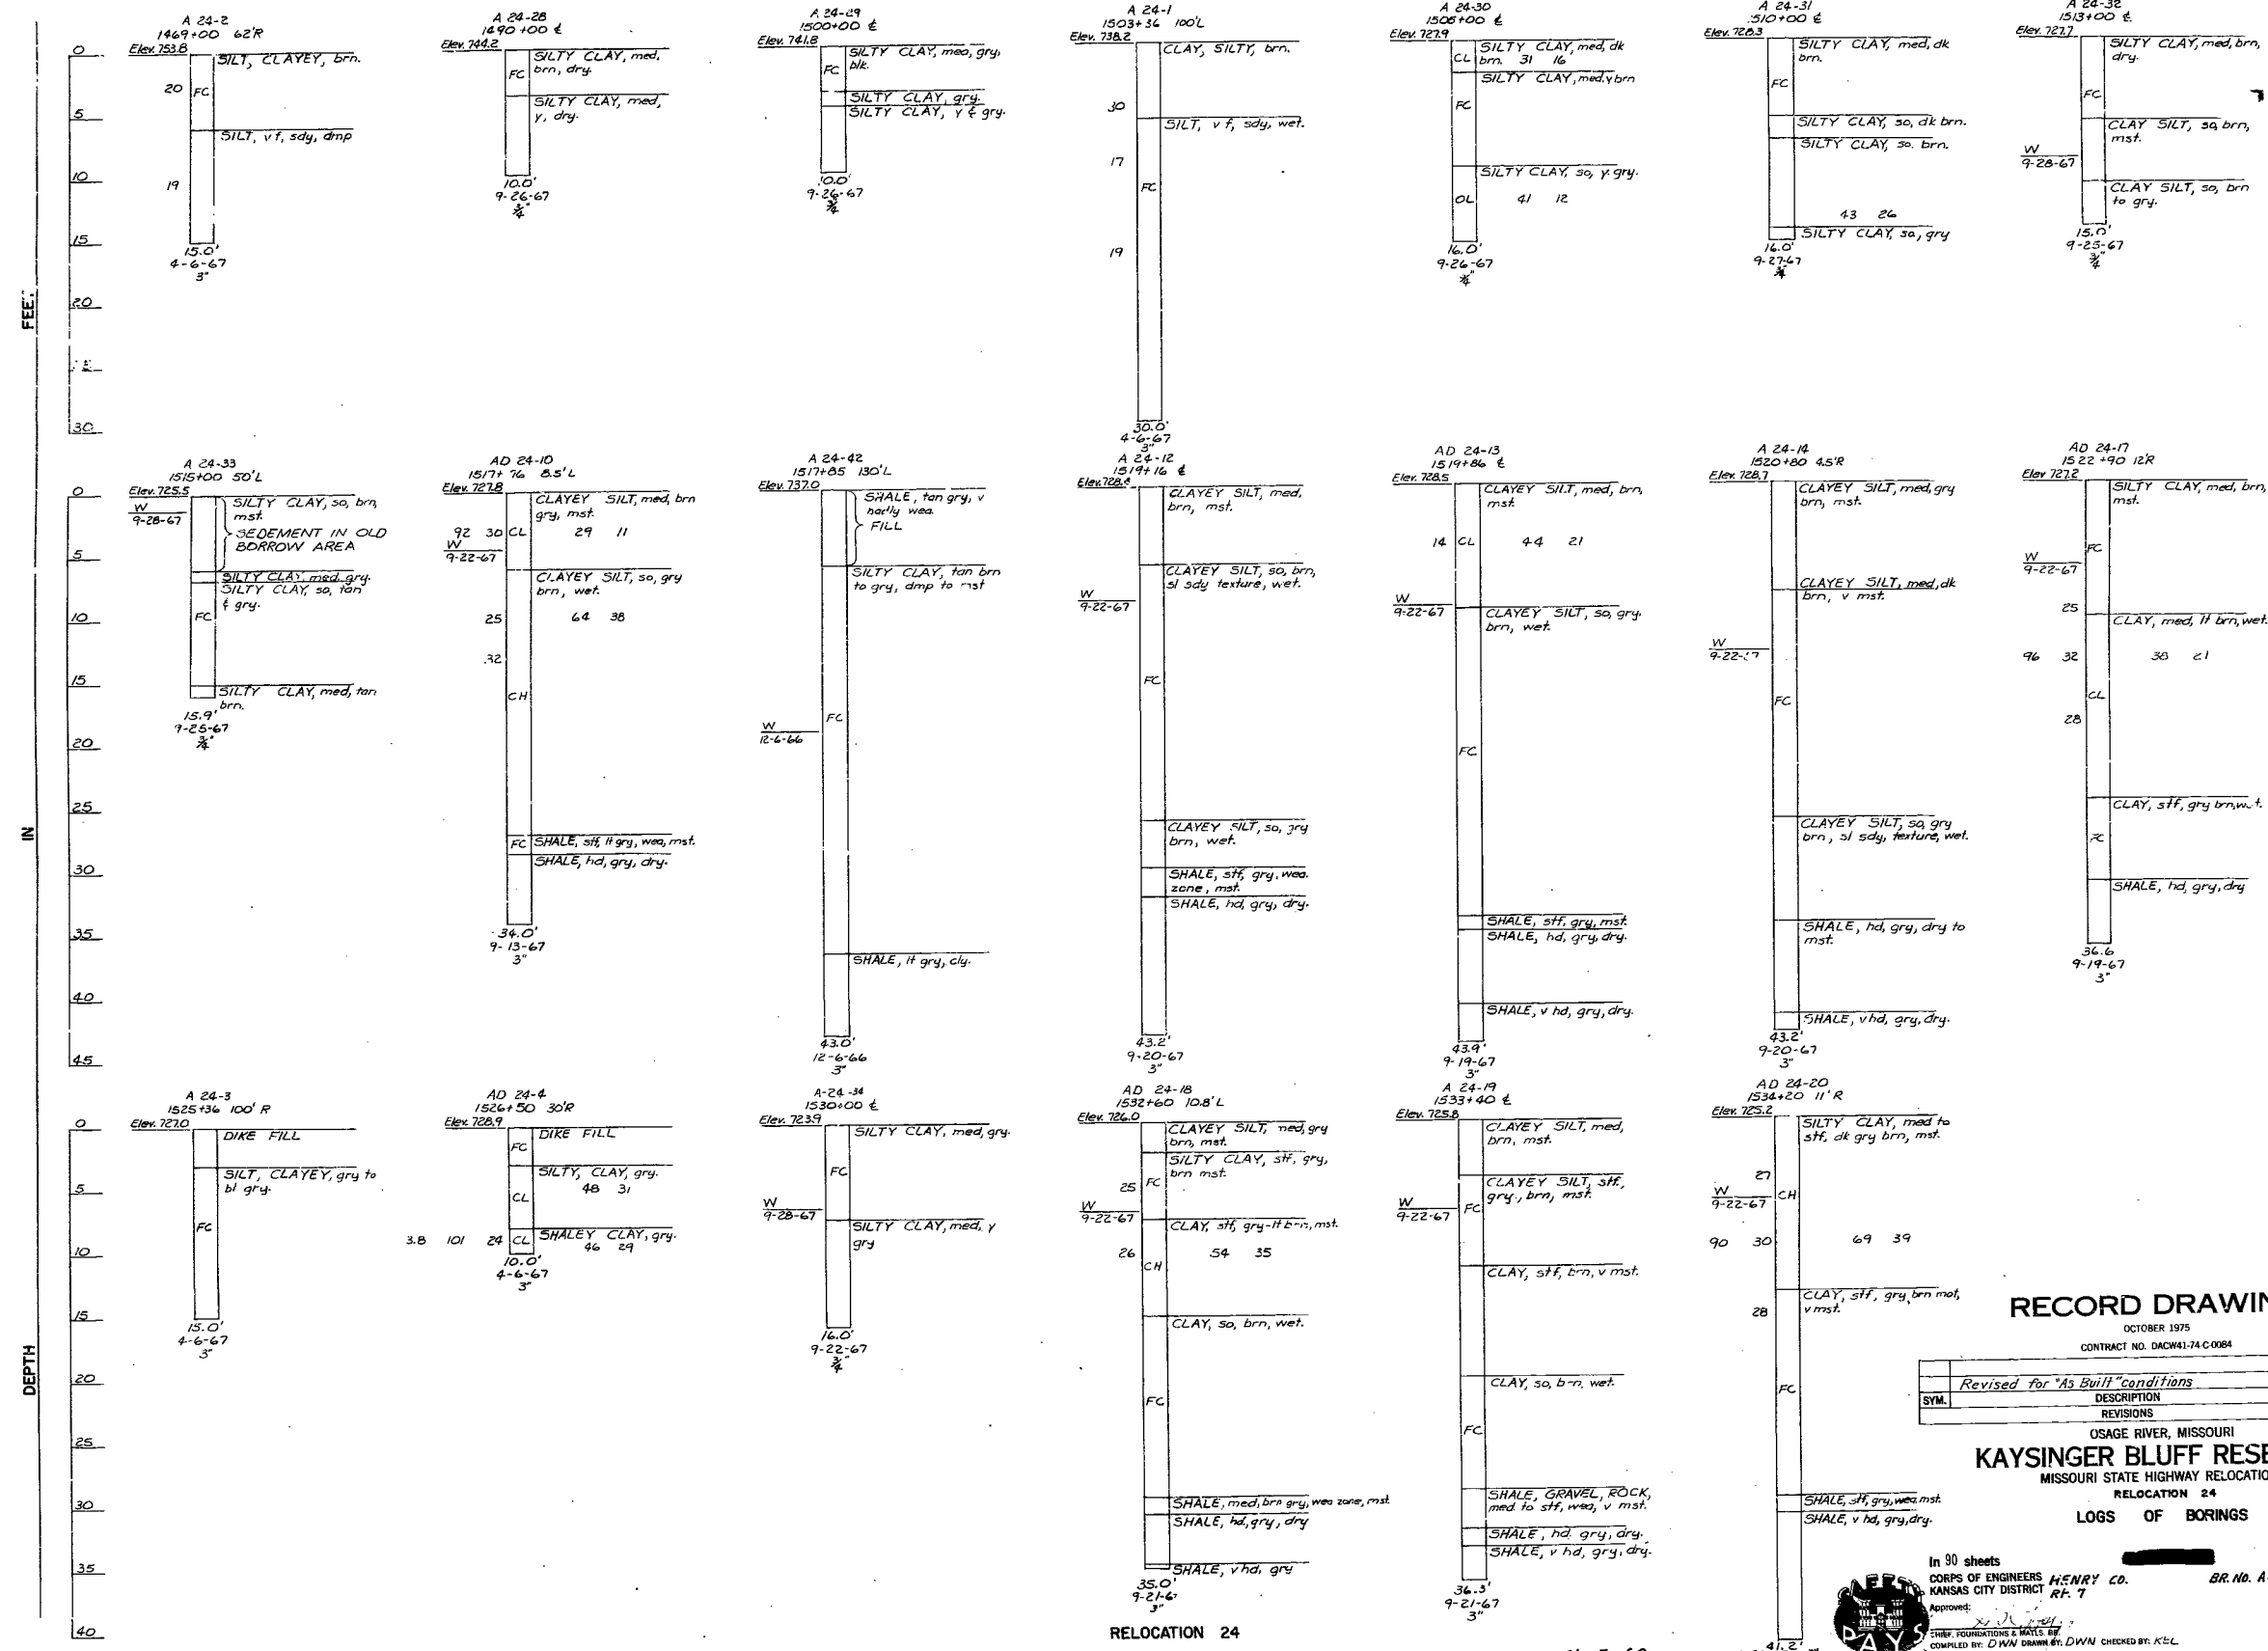

RECORD DRAWING

OCTOBER 1975				
CONTRACT NO. DACW41-74 C-0084				
	Revised for "As Built" conditions		5-1-78	
SYM.	DESCRIPTION		DATE	APPD
	REVISIONS			

OSAGE RIVER, MISSOURI
KAYSINGER BLUFF RESERVOIR
MISSOURI STATE HIGHWAY RELOCATIONS
RELOCATION 24
LOGS OF BORINGS



In 90 sheets
CORPS OF ENGINEERS HENRY CO.
KANSAS CITY DISTRICT
APPROVED: [Signature]
COMPILED BY: D.W.N. DRAWN BY: K.E.L.
Scale: as shown
BR. NO. A-3701
U. S. ARMY
APRIL 1973
80-12-3019 FILE NO.


508

862 29 TO 1

RELOCATION 24

Sh. 7 of 7

BUCHER & WILLIS, Consulting Engineers, Planners & Architects

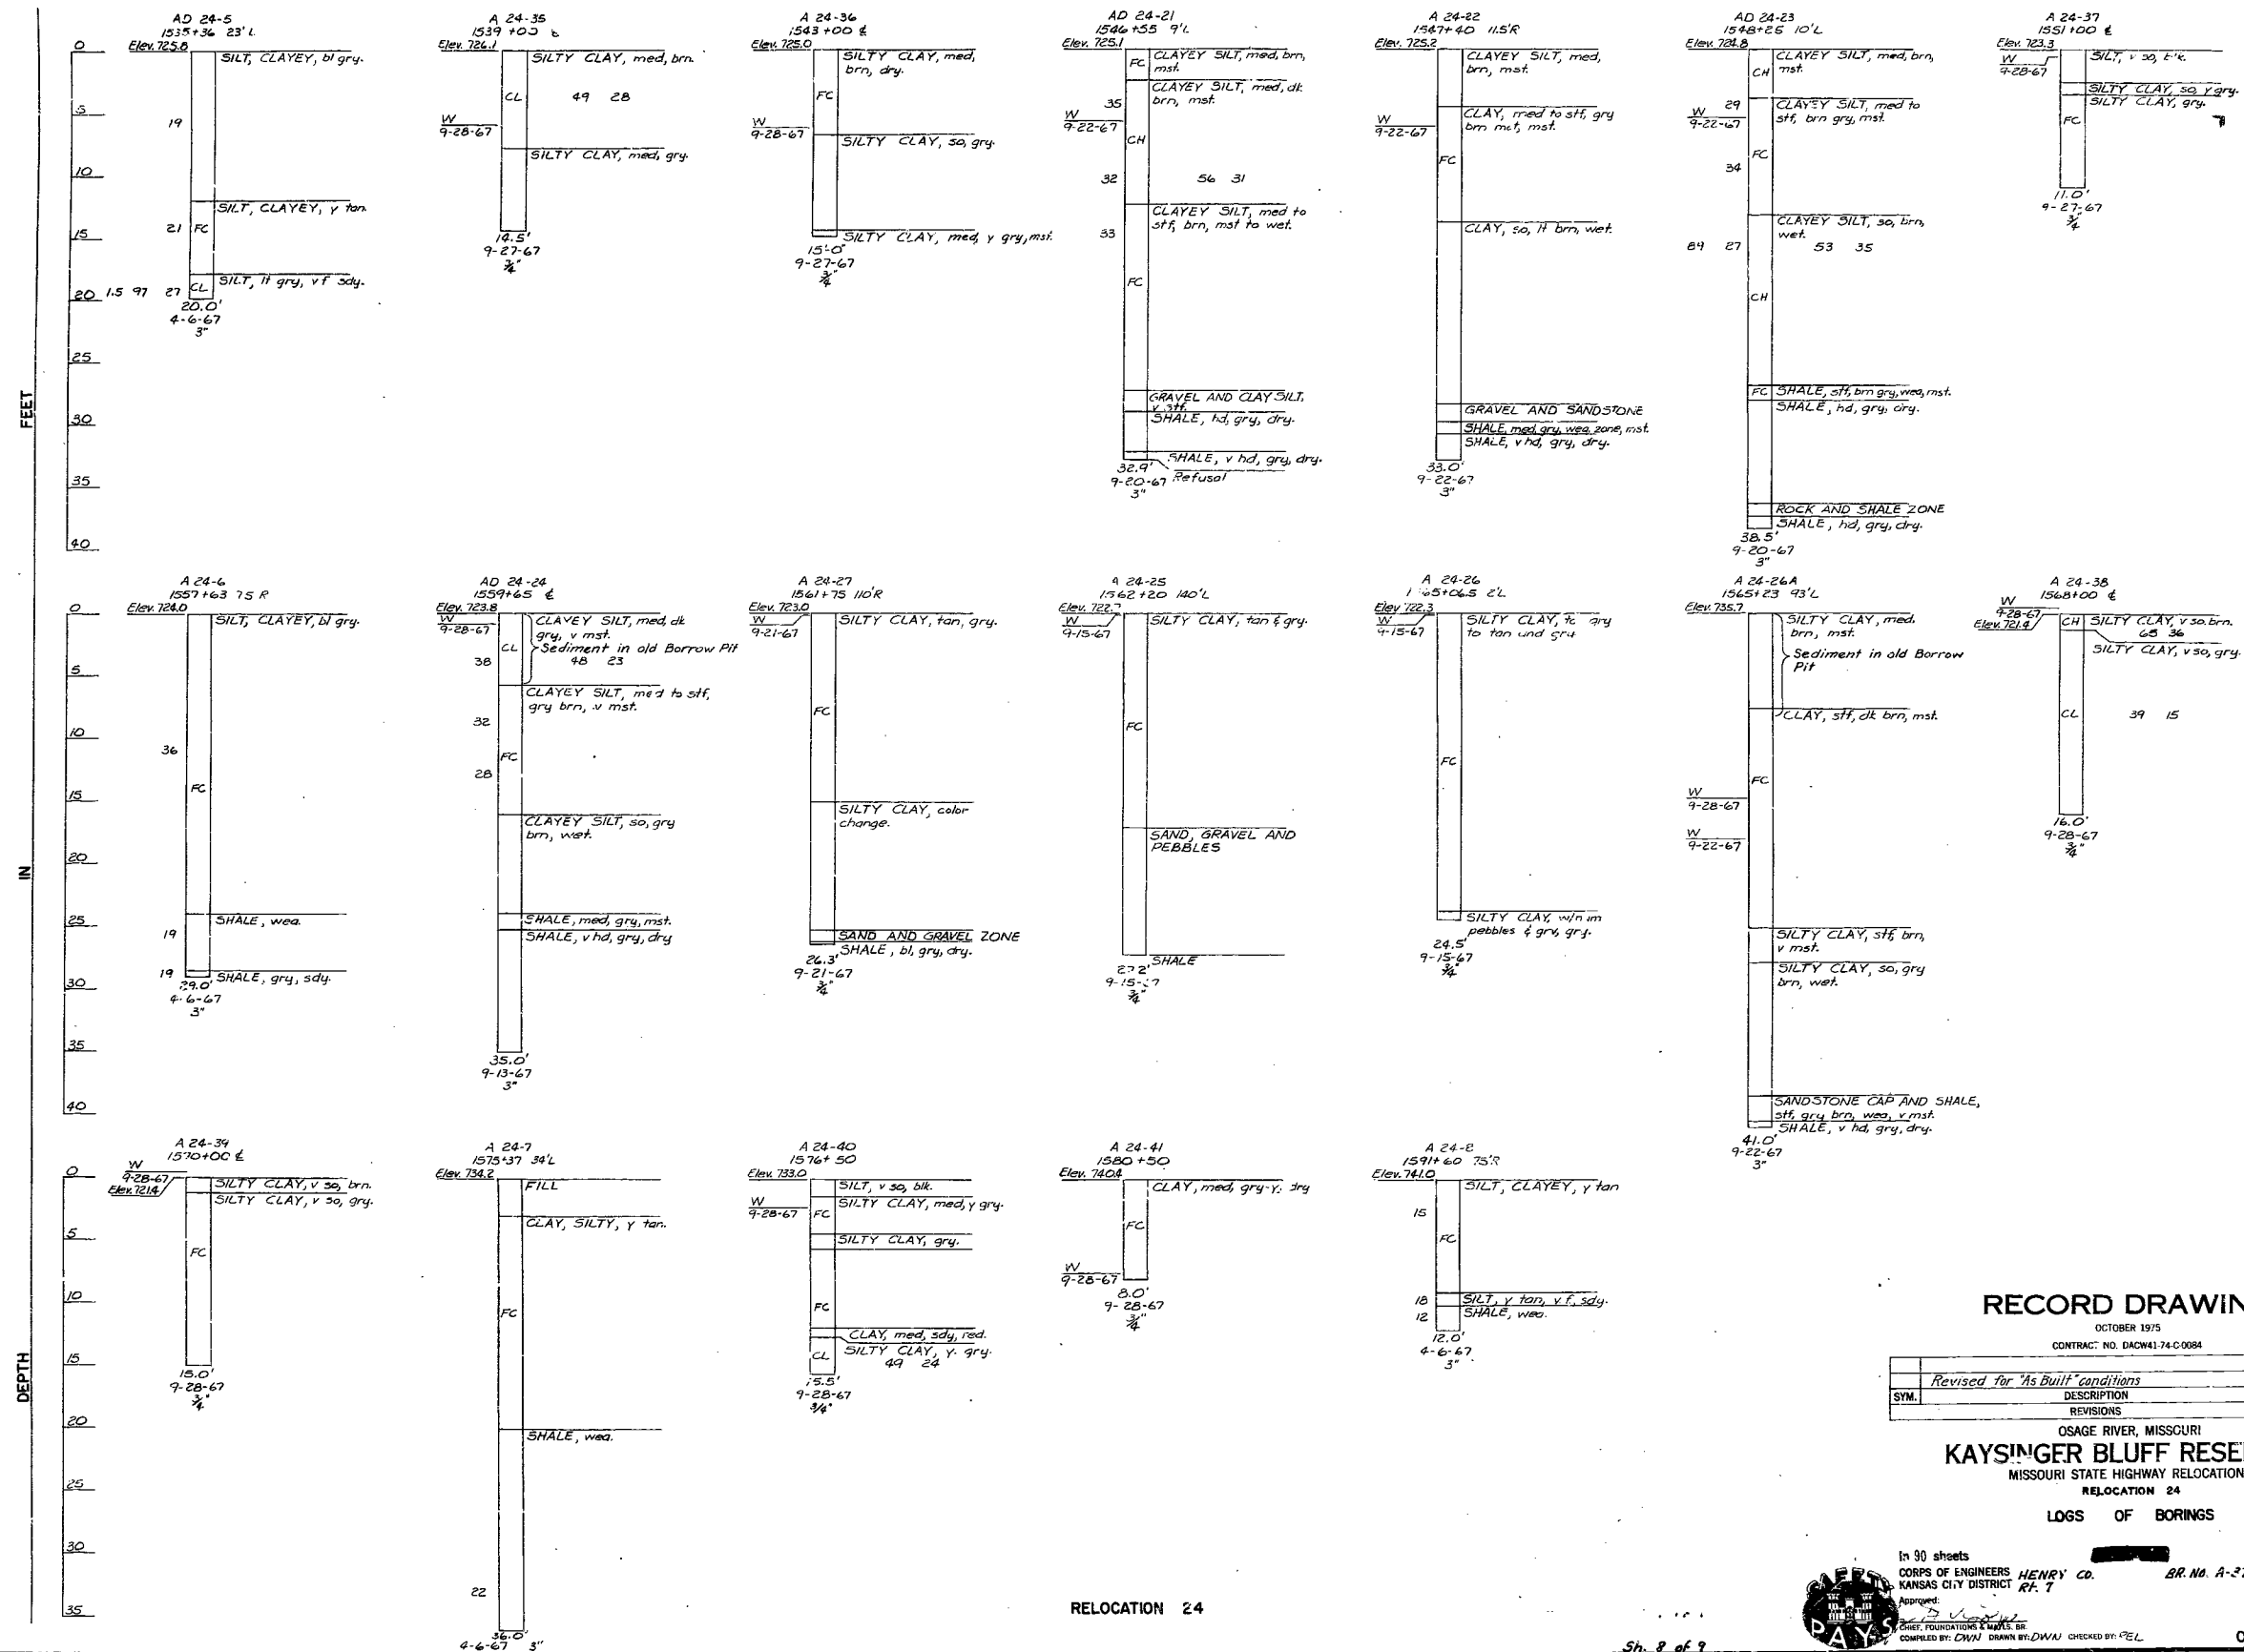

RELOCATION 24

RECORD DRAWING

OCTOBER 1975
CONTRACT NO. DACW4174-C-0084



SYM.	DESCRIPTION	DATE	APP'D.
	Revised for "As Built" conditions	5-1-78	
	REVISIONS		

OSAGE RIVER, MISSOURI
KAYSINGER BLUFF RESERVOIR
MISSOURI STATE HIGHWAY RELOCATIONS
RELOCATION 24
LOGS OF BORINGS




In 90 sheets
CORPS OF ENGINEERS
KANSAS CITY DISTRICT
APPROVED: [Signature]
COMPILED BY: DAWN DRAHN BY: DWAJ CHECKED BY: CEL
Scale: as shown
BR. NO. A-2701
U. S. ARMY
APRIL 1973
0-12-3020 FILE NO.

BUCHER & WILLIS, Consulting Engineers, Planners & Architects

89

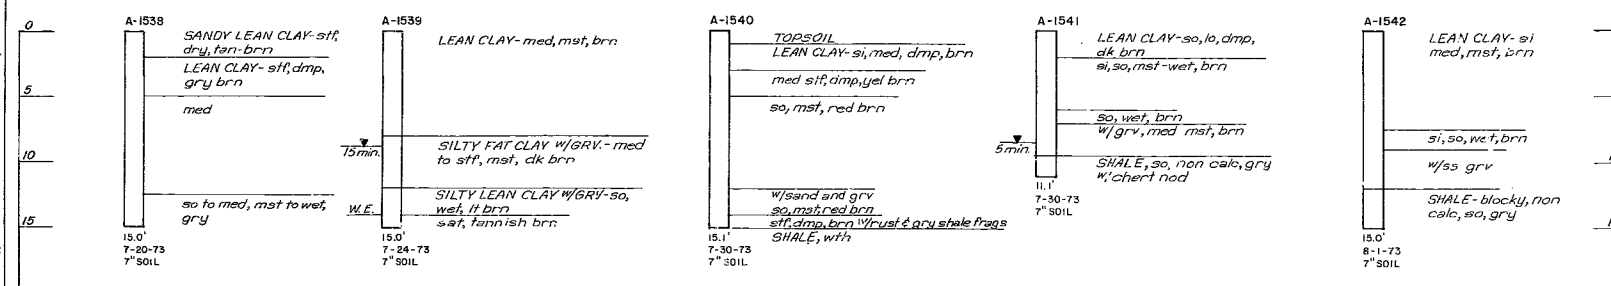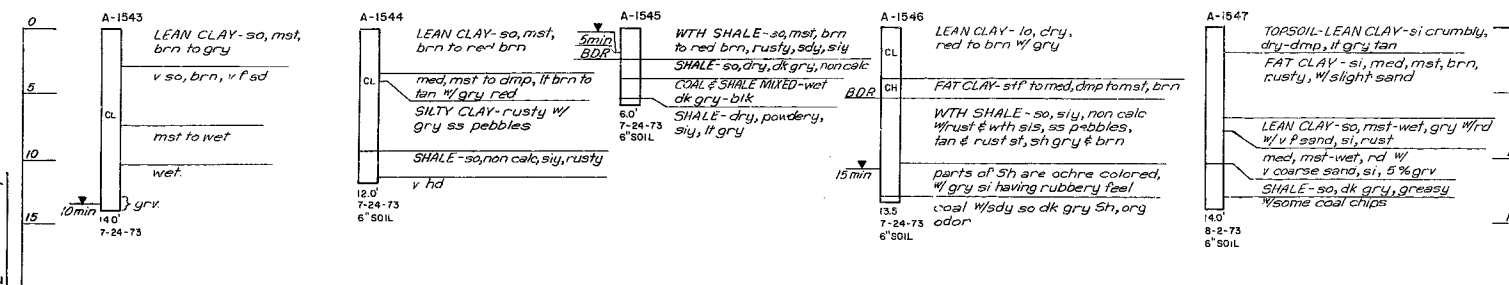

NOTES:
1. For location of borings for Relocation 23 & 24, see Sheet No. 1A
2. For location of borings for Relocation 12, see Sheet Nos. 23 & 24

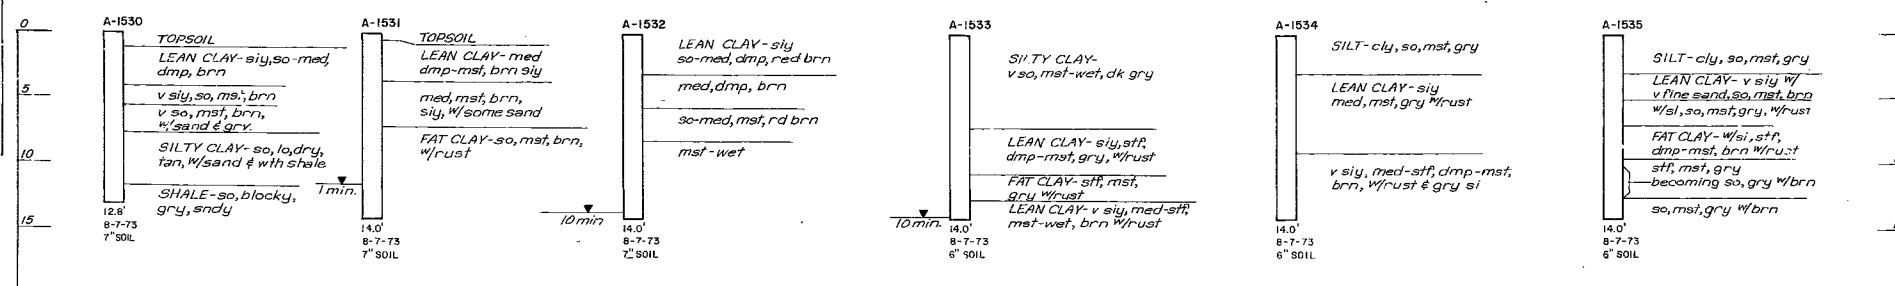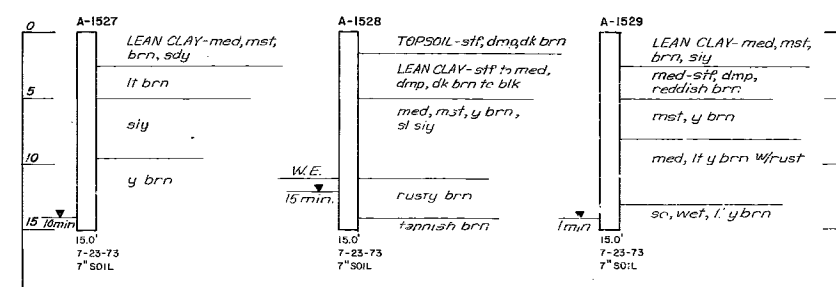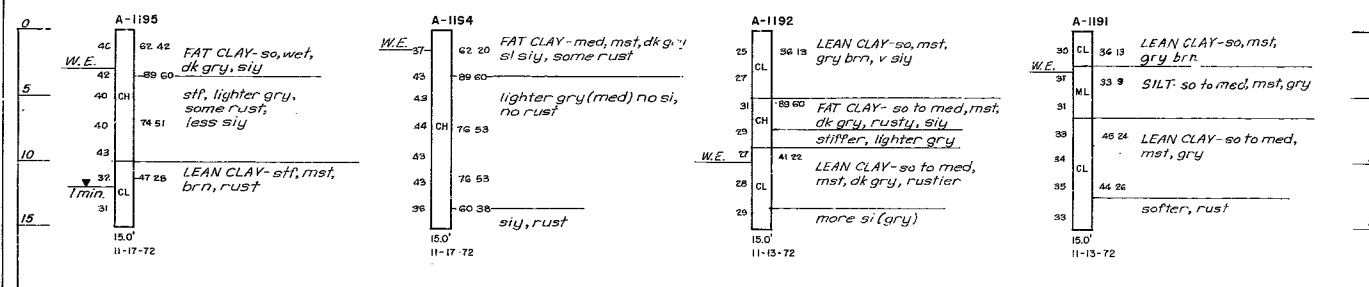

RECORD DRAWING

CONTRACT NO. DACW41-74-C-0084

Revised for "As Built" conditions

General Revisions

DESCRIPTION

REVISIONS

OSAGE RIVER, MISSOURI

KAYSINGER BLUFF RESERVOIR

MISSOURI STATE HIGHWAY RELOCATIONS

RELOCATION 12, 23 & 24

LOGS OF BORINGS

BORROW AREAS

In 90 sheets

CORPS OF ENGINEERS HENRY CO. BR. NO. A-3701

KANSAS CITY DISTRICT

Submitted: [Signature]

Checked by: [Signature]

FILE NO. 0-12-3021

Scale: as shown




U. S. ARMY APRIL 1973



Bars bonded in old concrete not removed shall be cleanly stripped and embedded into new concrete where possible. If length is available, old bars shall extend into new concrete at least 40 diameters for plain bars and 30 diameters for deformed bars, unless otherwise noted.


Diagram illustrating a repair joint. A horizontal line represents the joint, with a section labeled "Epoxy Seal" and a dimension of "2'-6"".

STD. 606.22
STD. 617.10

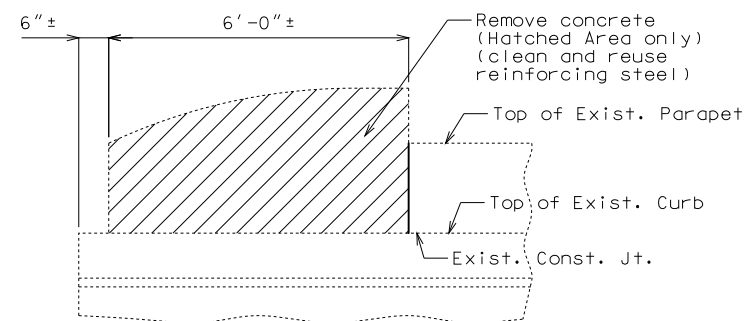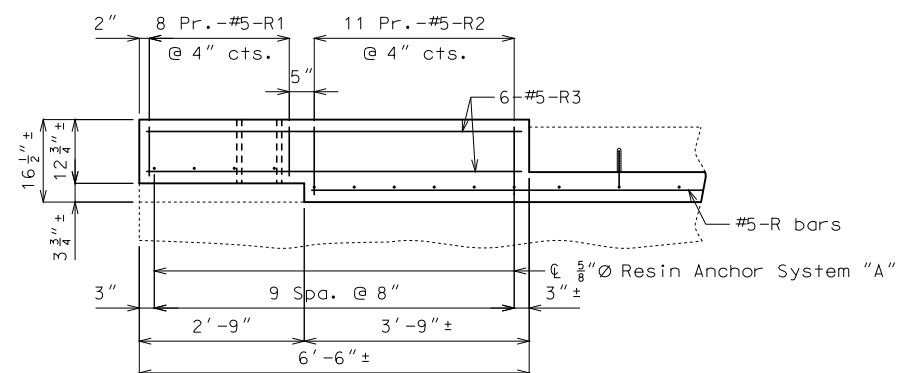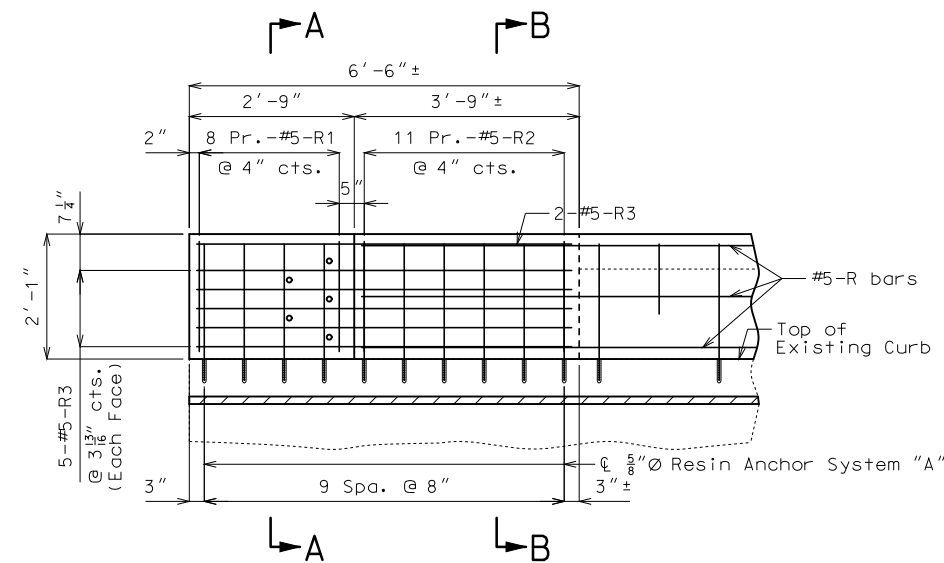


Note:




Cost of removing existing end posts will be considered completely covered by the contract unit price for Curb Blockout.

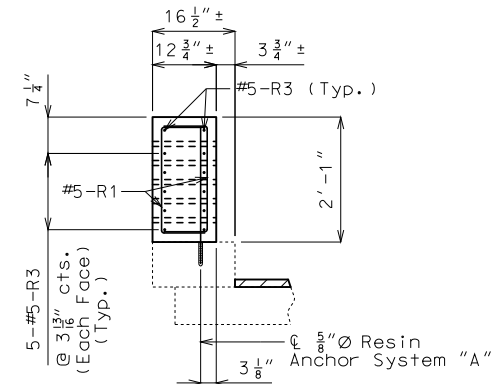

SECTION A-A

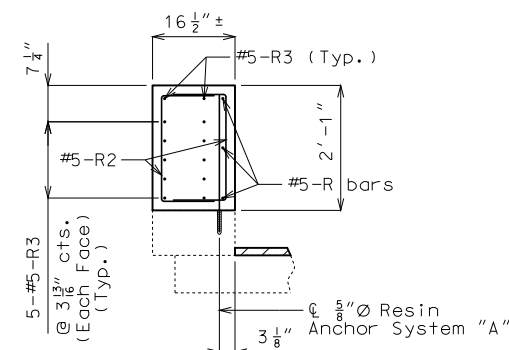

SECTION B-B

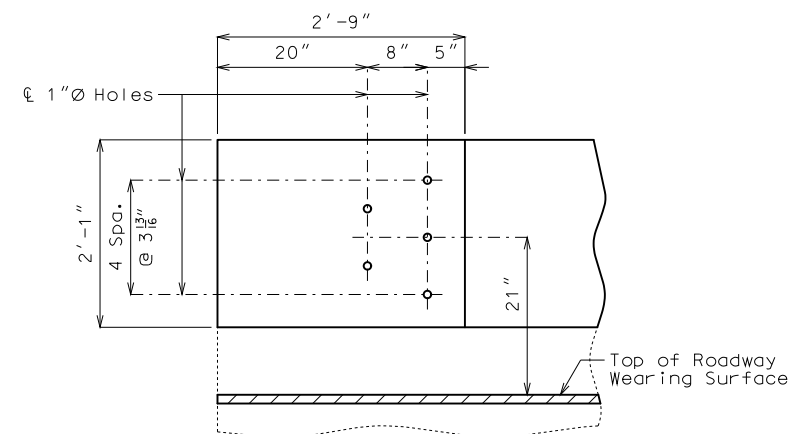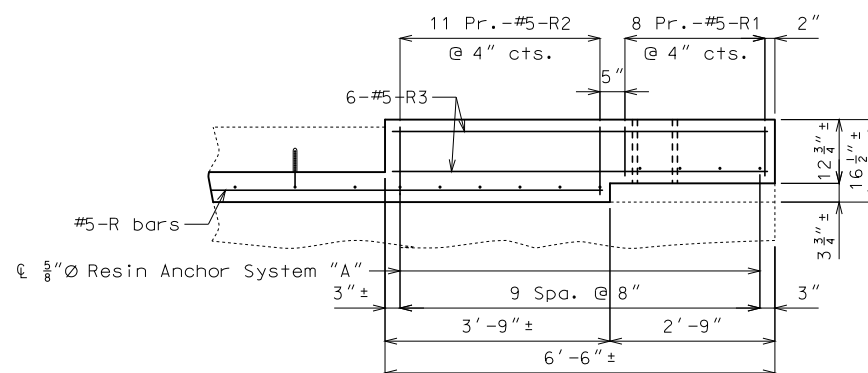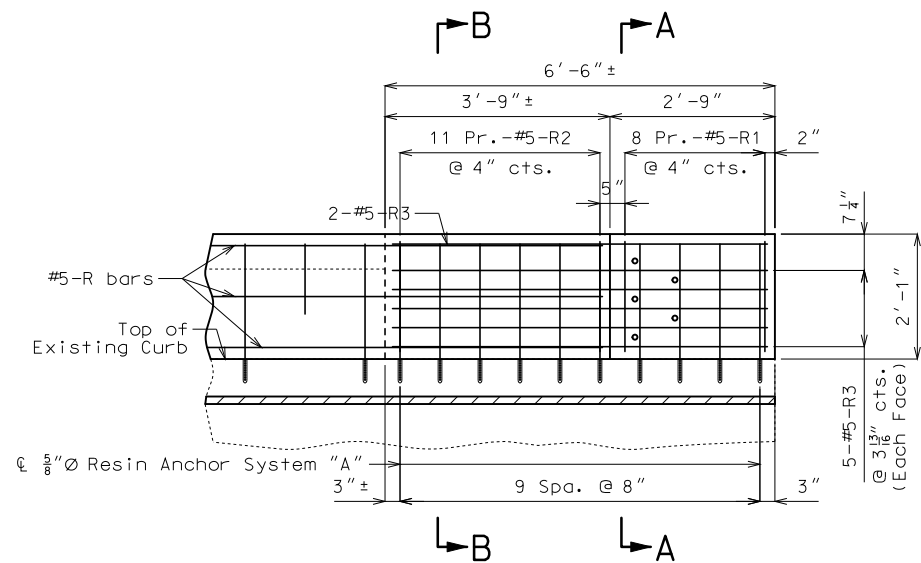

DETAILS OF GUARD RAIL ATTACHMENT

Notes:

All exposed edges of curb blockout shall have 1/2" radius or 3/8" bevel unless otherwise shown.

Payment for concrete, reinforcing steel, resin anchors, and any other work incidental to the curb blockout, complete in place, will be included in the contract unit price for Curb Blockout per linear foot.

Cost of any concrete curb or parapet repair will be included in the contract unit price for Curb Blockout.

Aluminum railing is not shown for clarity.

All reinforcement shall be epoxy coated.

The contractor shall use one of the qualified resin anchor systems in accordance with Sec 1039.

The minimum embedment depth in concrete with $f'c = 4,000$ psi for the resin anchor system shall be that required to meet the minimum ultimate pullout strength in accordance with Sec 1039 but shall not be less than 5".

An epoxy coated #5 Grade 60 reinforcing bar shall be substituted for the 5/8"Ø threaded rod.

DETAILS OF END POST AT END BENTS



THIS SHEET HAS BEEN
SIGNED, SEALED AND DATED
ELECTRONICALLY.

DATE PREPARED

ROUTE	STATE
-------	-------

DISTRICT	SHEET NO.
----------	-----------

COUNTY

JOB NO.

CONTRACT ID.

PROJECT NO.

BRIDGE NO.

[illegible]MISSOURI HIGHWAYS AND TRANSPORTATION
COMMISSION

105 WEST CAPITOL
JEFFERSON CITY, MO 65102
1-888-ASK-MDDOT (1-888-275-6636)


IF A SEAL IS PRESENT ON THIS SHEET IT HAS BEEN ELECTRONICALLY SEALED AND DATED.

BILL OF REINFORCING STEEL

NO.	REQ'D.	MARK NO.	LOCATION	EPOXY (E)	SHAPE NO.	STIRRUP (S)	SUBSTR. (X)	VARIES (V)	NO. EACH	DIMENSIONS												NOMINAL LENGTH	ACTUAL LENGTH	WEIGHT		
										B	C	D	E	F	H	K	FT.		IN.		FT.		IN.			
										FT.	IN.	FT.	IN.	FT.	IN.	FT.	IN.	FT.	IN.	FT.	IN.	FT.	IN.			
			BLOCKOUT																							
64	5	R1	BLOCKOUT	E	10	S																		3 6 3 3	217	
88	5	R2	BLOCKOUT	E	10	S																		4 1 3 11	359	
48	5	R3	BLOCKOUT	E	20					6	3.000													6 3 6 3	313	
12	5	R4	BLOCKOUT	E	20					32	9.000													32 9 32 9	410	
18	5	R5	BLOCKOUT	E	20					34	9.000													34 9 34 9	652	
			TOTALS																							
5			TOTAL	E																					1951	
			TOTAL	E																					0	
			TOTAL	E																					1951	

BILL OF REINFORCING STEEL

NO.	REQ'D.	MARK NO.	LOCATION	EPOXY (E)	SHAPE NO.	STIRRUP (S)	SUBSTR. (X)	VARIES (V)	NO. EACH	DIMENSIONS												NOMINAL LENGTH	ACTUAL LENGTH	WEIGHT																																																																																																																																																																																																																																																																																																																																																																																																																																																																																																																																																																																																																																																																																																																																																																																																																																																																																																																																																																																																																																																																																																																																																																																																																																																																																																									
										B		C		D		E		F		H					K																																																																																																																																																																																																																																																																																																																																																																																																																																																																																																																																																																																																																																																																																																																																																																																																																																																																																																																																																																																																																																																																																																																																																																																																																																																																																																								
										FT.	IN.	FT.	IN.	FT.	IN.	FT.	IN.	FT.	IN.	FT.	IN.	FT.	IN.	FT.	IN.	LBS.																																																																																																																																																																																																																																																																																																																																																																																																																																																																																																																																																																																																																																																																																																																																																																																																																																																																																																																																																																																																																																																																																																																																																																																																																																																																																																							

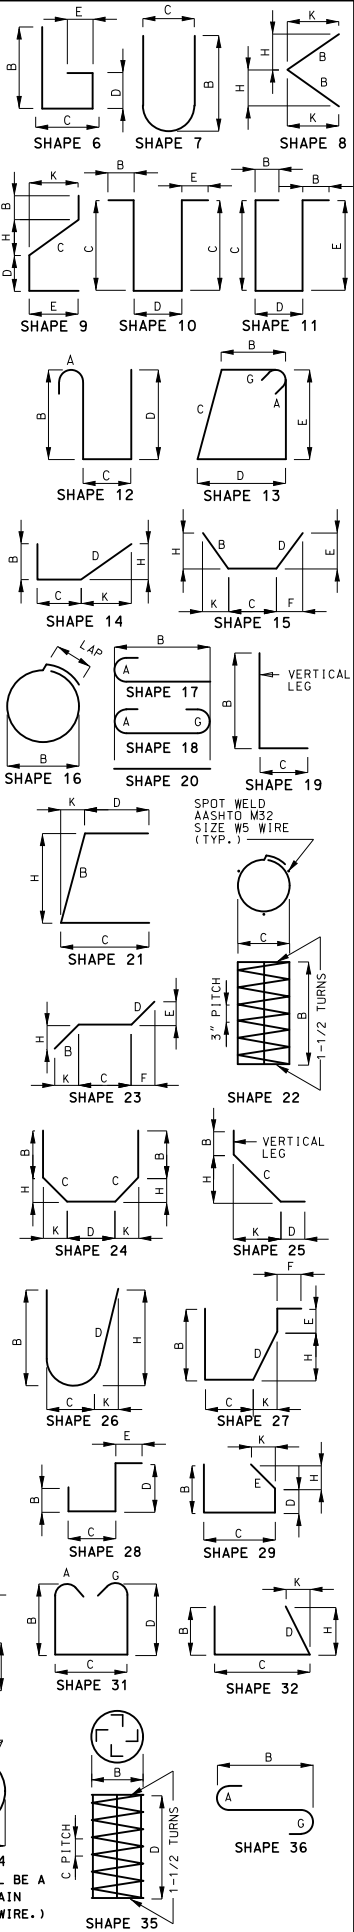

STATE OF MISSOURI

BRYAN A. HARTNAGEL

NUMBER PE-202024473

PROFESSIONAL ENGINEER

THIS SHEET HAS BEEN SIGNED, SEALED AND DATED ELECTRONICALLY.

DATE PREPARED 8/17/2015

ROUTE 7 STATE MO

DISTRICT BR SHEET NO. 4

COUNTY HENRY

JOB NO. J7P3047

CONTRACT ID.

PROJECT NO.

BRIDGE NO. A37011

DESCRIPTION


DATE

MISSOURI HIGHWAYS AND TRANSPORTATION COMMISSION

105 WEST CAPITOL


JEFFERSON CITY, MO 65102

1-888-ASK-MODOT (1-888-275-6636)

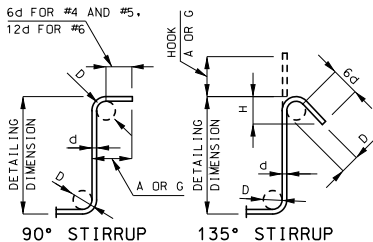

STIRRUP HOOK DIMENSIONS				
GRADES 40 - 50 - 60 KSI				
BAR SIZE	D (IN.)	90° HOOK A OR G	135° HOOK A OR G	APPROX. H
#4	2"	4 1/2"	4 1/2"	3"
#5	2 1/2"	6"	5 1/2"	3 3/4"
#6	4 1/2"	12"	8"	4 1/2"

NOTE: UNLESS OTHERWISE NOTED, DIAMETER "D" IS THE SAME FOR ALL BENDS AND HOOKS ON A BAR.

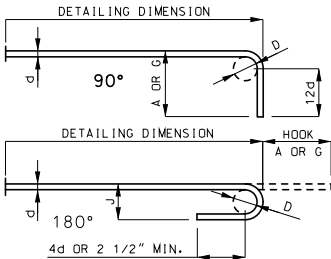

END HOOK DIMENSIONS				
ALL GRADES				
BAR SIZE	D (IN.)	180° HOOKS A OR G	90° HOOKS J	A OR G
#3	2 1/4"	5"	3"	6"
#4	3"	6"	4"	8"
#5	3 3/4"	7"	5"	10"
#6	4 1/2"	8"	6"	12"
#7	5 1/4"	10"	7"	14"
#8	6"	11"	8"	16"
#9	9 1/2"	15"	11 3/4"	19"
#10	10 3/4"	17"	13 1/4"	22"
#11	12"	19"	14 3/4"	2'-0"
#14	18 1/4"	2'-3"	21 3/4"	2'-7"

NOTE:
ALL STANDARD HOOKS AND BENDS OTHER THAN 180 DEGREE ARE TO BE BENT WITH SAME PROCEDURE AS FOR 90 DEGREE STANDARD HOOKS.
HOOKS AND BENDS SHALL BE IN ACCORDANCE WITH THE PROCEDURES AS SHOWN ON THIS SHEET.
E = EPOXY COATED REINFORCEMENT.
S = STIRRUP.
X = BAR IS INCLUDED IN SUBSTRUCTURE QUANTITIES.
V = BAR DIMENSIONS VARY IN EQUAL INCREMENTS BETWEEN DIMENSIONS SHOWN ON THIS LINE AND THE FOLLOWING LINE.
NO. EA. = NUMBER OF BARS OF EACH LENGTH.
NOMINAL LENGTHS ARE BASED ON OUT TO OUT DIMENSIONS SHOWN IN BENDING DIAGRAMS AND ARE LISTED FOR FABRICATORS USE. (NEAREST INCH)
ACTUAL LENGTHS ARE MEASURED ALONG CENTERLINE BAR TO THE NEAREST INCH.
PAYWEIGHTS ARE BASED ON ACTUAL LENGTHS.
FOUR ANGLE OR CHANNEL SPACERS ARE REQUIRED FOR EACH COLUMN SPIRAL. SPACERS ARE TO BE PLACED ON INSIDE OF SPIRALS. LENGTH AND WEIGHT OF COLUMN SPIRALS DO NOT INCLUDE SPLICES OR SPACERS.
REINFORCING STEEL (GRADE 60) F_y = 60,000 PSI.

