RECEIPT OF ADDENDUM

I received addendum No. # 02 on October 20, 2025 for 4823 Johnson County BRO-R051(41) Bridge Replacement Project

This addendum involves 4 pages including this sheet.

	Vendor's Name	
_	Vendor's Address	
	Signature / Date	

Return completed acknowledgment to Great River Engineering ASAP

Fax # 417-886-7591 Attention: Malena Hemenway Email Back to:

Secretary@greatriv.com



General Notes:

Design Specifications:

2020 A.A.S.H.T.O. LRFD Bridge Design Specifications (9th Ed.) Seismic Performance Category 'D'

2024 MODOT Standard Specifications for Highway Construction (latest edition) 2025 MODOT Standard Plans for Highway Construction (latest edition)

Design Loading:

Vehicular = HL-93

Future Wearing Surface = 35 psf (Min.) Earth = 120 pcf

Equivalent Fluid Pressure = 45 pcf

Superstructure: Simply-Supported, Non-Composite for dead load. Continuous Composite for live load.

Design Unit Stresses:

Class B Concrete (Substructure) f'c = 3,000 psiReinforcing Steel (Grade 60) fy = 60,000 psiSteel Pile (ASTM A709 Grade 50) fy = 50,000 psi

For precast prestressed panel stresses, see Sheet No. S11. For prestressed girder stresses, see Sheet No. S10.

Neoprene Pads:

Plain recognere bearing pads shall be 60 durometer and shall be in accordance with Sec 716.

All joint filler shall be in accordance with Sec 1057 of MoDOT Specifications for preformed sponge rubber expansion and partition joint filler, except as noted.

Reinforcing Steel:

Minimum clearance to reinforcing steel shall be $1 \frac{1}{2}$ ". unless otherwise shown.

Traffic Handling:


Structure to be closed during construction. Traffic to be maintained on other routes during construction. See roadway plans for traffic control.

"Sec" refers to sections in the Missouri Standard Specifications of Highway Construction and

High strength bolts, nuts and washers will be sampled for quality assurance as specified in

ltem		Substr.	Superstr.	Tota
Class 1 Excavation	cu. yard	60		60
Removal of Bridges	lump sum			1
Galvanized Structural Steel Piles (12 in.)	linear foot	200		20
Pre-Boring for Piling	linear foot	80		81
Pre-Boring for Piling Pile Point Reinforcement	each	8		
Class B Concrete (Substructure)	cu. yard	21.9		21.
Slab on Concrete Beam	sq. yard		166	16
Bridge Guardrail (Thrie Beam)	linear foot		150	15
27 inch Prestressed Concrete Spread Box Beam	linear foot	178		17
Bridge Approach Slab (Minor)	sq. yard		109	10
Plain Neoprene Bearing Pad	each		6	6
Vertical Drain at End Bents	each		2	2

Hydrologic	Date	a
Drainage Area	=	1.2 sq. mi.
Design Flood Frequency	=	500 years
Design Flood Discharge	=	1930 cfs
Design Flood (D.F.) Elevation	=	712.8 feet
Base Flood (100	D-year)	
Base Flood Elevation	=	712.1 feet
Base Flood Discharge	=	1430 cfs
Estimated Backwater	=	0.1 feet
Average Velocity Thru Opening	=	3.3 ft/s
Freeboard (50-	year)	
Freeboard	=	1.8 feet
Roadway Overtop	ping	
Overtopping Flood Discharge	=	N/A cfs
Overtopping Flood Frequency	=	>500 years
500 Year Flood Elevation	=	712.8 feet

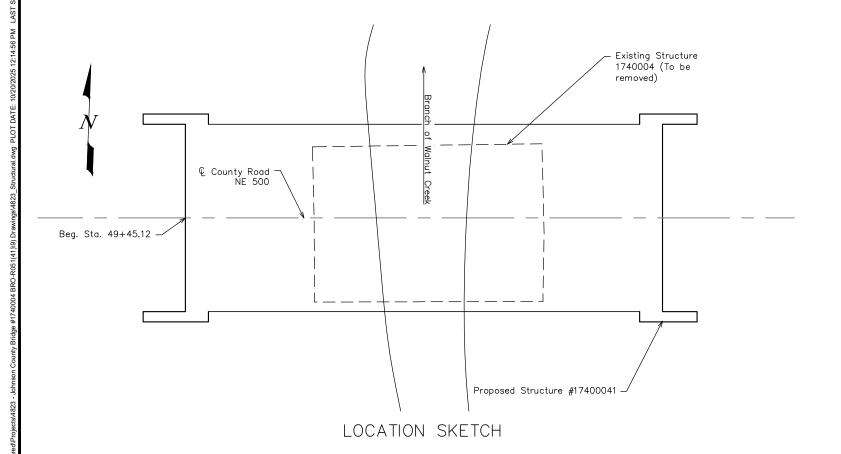

		Foundation D	ata			
	Туре	Design Data		Bent No. 1	Bent No. 2	
		Pile Type & Size		HP 12x53	HP 12x53	
		Number	ea	4	4	
		Approximate Length Per Each	ft	30	20	
	Load	Pile Point Reinforcement	ea	All	All	
	Bearing	Min. Galvanized Penetration (Elev.)	ft	Full	II Length	
	Pile	Pile Driving Verification Method		DF	DF	
		Resistance Factor		0.40	0.40	
		Minimum Nominal Axial Compressive Resistance	kip	437	435	

DF = FHWA-modified Gates Dynamic Pile Formula

Minimum Nominal Axial Compressive Resistance = <u>Maximum Factored Loads</u> Resistance Factor

Pre-bore for piles at Bent 2 to elevation 690.79. A minimum of 5 feet of prebore into rock shall also be obtained.

All piles shall be galvanized down to the minimum galvanized penetration (elevation).

Pile point reinforcement need not be galvanized. Shop drawings will not be required for pile point reinforcement.

Piles are anticipated to be driven to refusal on rock. Review all borings for depth of rock and restrict driving as appropriate to comply with hard rock driving criteria in accordance with Sec 702. When pile refusal on rock occurs, as approved by the engineer, the minimum nominal axial compressive resistance is verified and no additional pile driving verification method is required.


Estimated Quantities for Slab on Concrete Beam	
ITEM	TOTAL
Class B-2 Concrete cu. yard	56.2
Reinforcing Steel (Epoxy Coated) pound	12,820

The table of estimated quantities for Slab on Concrete Beam represents the quantities used by the county in preparing the cost estimate for concrete slabs. The area of the concrete slab will be measured to the nearest square yard longitudinally from end of slab to end of slab and transversely from out to out of bridge slab (or with the horizontal dimensions as shown on the plan of slab). Payment for prestressed panels conventional forms, all concrete and coated reinforcing steel will be considered completely covered by the contract unit price for the slab. Variations may be encountered in the Estimated Quantities but the variations cannot be used for an adjustment in the contract unit price.

Method of forming the slab shall be shown on the plans and in accordance with Section 703. all hardware for forming the slab to be left in place as a permanent part of the structure shall be coated in accordance with ASTM A123 or ASTM B633 with a thickness Class SC 4 and a finish type I, II or III.

Class B-2 concrete quantity is based on minimum top flange thickness and minimum joint material thickness.

The prestressed panel quantities are not included in the Table of Estimated Quantities for Slab on Concrete Beam

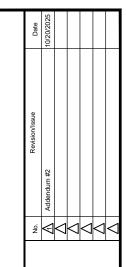






 \mathcal{O}

ANTITIE 4 9 00 \bigcirc STIMATE 4 #1 COUNTY, 4 AND 5 RO NOTE \bigcirc \forall Ω GENER,

> 10/20/2025 JOB 4823


> > S2



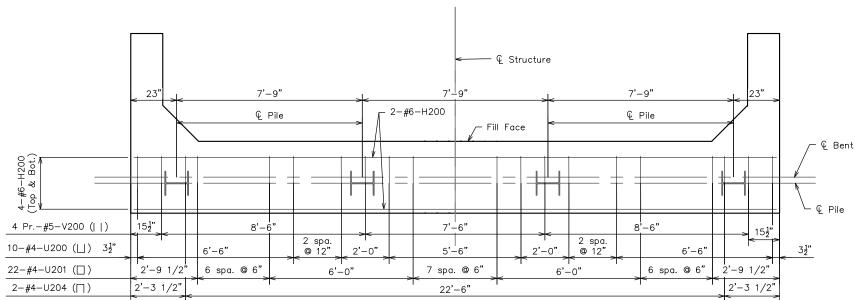


PLAN OF BEAM SHOWING REINFORCEMENT AND PILES

Keys and steps not shown for clarity

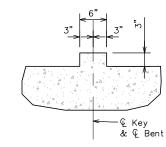

TYPICAL SECTION THRU KEY

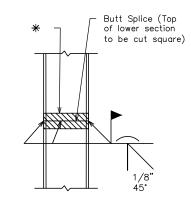

STEEL PILE SPLICE (if required)

* Galvanizing material shall be omitted or removed 1 inch clear of weld location. See special provisions.

General Notes:

For details of End Bent No. 2 not shown, see Sheets No. S8 & S9.


The U-bars and pairs of V-bars in the End Bent are to be placed parallel to & Roadway.

Reinforcing Steel shall be shifted to clear piles. U bars shall clear piles by at least 1 1/2".

	Substructure Quantity Table for Be	nt No. 2	
	Item		Quantity
	Class 1 Excavation	cu. yard	30
	Galvanized Structural Steel Piles (12 in.)	lin. foot	80
$\mathbb{A}\{$	Pre-Boring for Piling	lin. foot	80
	Pile Point Reinforcement	each	4
	Class B Concrete (Substructure)	cu. yard	10.8

These quantities are included in the Estimated Quantities table on Sheet No. S2.

Note: This drawing not to scale. Follow dimensions.

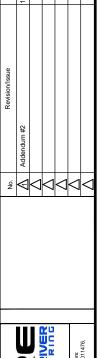

DETAL! \sim COUNTY, Š. BENT

740004

#1

-R051(41) END BR0-

> 10/20/2025 JOB 4823

> > S7



CONTRACTOR NAME:
ADDRESS LINE 1:
ADDRESS LINE 2:
PHONE NUMBER:
EMAIL:

Johnson County CO RD NE 500 BRO-R051(41)

DATE:

BRO-R	051(41	1)	ITEMIZED I	BID FOR	RM		
LINE		ITEM	DESCRIPTION	UNITS	QUANTITY	UNIT PRICE	AMOUNT
ROAD	WAY IT	EMS 201	CLEARING AND GRUBBING	ACRE	0.43		
2		203	UNCLASSIFIED EXCAVATION (ROADWAY)	C.Y.	146		
3		203	EMBANKMENT IN PLACE W/COMPACTION	C.Y.	46		
4		304	TYPE 1 AGGREGATE FOR BASE (5 IN. THICK)	S.Y	415		
5		401	BITUMINOUS PAVEMENT MIXTURE PG64-22, (BASE)	TON	70		
6		401	BITUMINOUS PAVEMENT MIXTURE PG64-22, (BP-1)	TON	35		
7		407	TACK COAT	GAL	21		
8		606	TYPE A CRASHWORTHY END TERMINAL	EACH	4		
9		606	ASYMETRICAL TRANSITION SECTION, 6.5 FT. POSTS	EACH	4		
10		607	WOVEN WIRE FENCE	L.F.	46		
11		611	TYPE 2 ROCK BLANKET	C.Y.	325		
12		616	TYPE III MOVEABLE BARRICADE WITH LIGHT	EACH	6		
13		616	CONSTRUCTION SIGNS	S.F.	63		
14		618	MOBILIZATION	L.S.	1		
15		805	SEEDING	ACRE	0.3		
16		806	SILT FENCE	EACH	317		
					ı	ROADWAY ITEMS SUBTOTAL	
17	SE ITEI	206	CLASS 1 EXCAVATION	C.Y.	60		
18		216	REMOVAL OF BRIDGES	L.S.	1		
19	\sim	503	BRIDGE APPROACH SLAB (MINOR ROAD)	S.Y.	109		
20	, ٢	702	STRUCTURAL STEEL PILES (12 IV)	~LF	~~~~	~~~~	~~~~~
21		702	PRE-BORE FOR PILING	L.F.	80	. 	
22	₹	702	PILE POINT REINFORCEMENT	EACH	8		
23	1	703	CLASS B-1 CONCRETE (SUBSTRUCTURE)	C.Y.	21.9		
24	3	703	SLAB ON CONCRETE BEAM	S.Y.	166		
25	3	705	27 IN., PRESTRESSED CONCRETE SPREAD BOX BEA	L.F.	178		
26	1	713	BRIDGE GUARD RAIL (THRIE BEAM)	L.F.	150		
27	3	715	VERTICAL DRAIN AT END BENTS	L.F.	2		
28	. 3	716	PLAIN NEOPRENE BEARING PAD	L.F.	6		
~~	~					BRIDGE ITEMS SUBTOTAL	
						TOTAL CONTRACT	
Adder	ıda		Signature				

ldenda	Signature
1	
2	
3	