MISSCURI STATE HIGHWAY DEPARTMENT Note: For details of handrail see "35H", "358" and "356" on 5td.0-6501R2 and "458" on 5td.0-6502R2 and madify as shown and noted on 5heet No.5 of 5. 1-47-5" (Overall) Dack Girder 2-35' Deck Girders 2-35' Deck Girders Elev. 452.65 Elev. 456.0 Elev. 452.01 All 11 25-0 Creos. Timber Piles (5) 35-0" Creos. Timber Piles 20-0"Creos. Timber Piles Elev. 452.0 Note:-See Special Provisions in regard to ordering pilling. All pilling to be creosoted timber and ordered in the following lengths: 15 & 15-0", 27 @ 20-0", 15 @ 25-0", and 27 @ 35-0". Alle lengths include 5-0" cut-offs. | W 20-0"Creos. Timber Piles 15-0"Creos. Timber Piles **(4**) GENERAL ELEVATION A- & Bent E RODOWAY -> Sta. 150+54.12 Sta. 150+91.80 Sia. 15/+ 39.20 -Sta. 151+70.88-Sta. 152+ 14.38 -Grade Elev. 478.8/ Grade Elev. 478.81 Grade Elev. 478.07 Grade Elev. 478,55 Sta. 150+16.62 Grade Elev. 473.55 Grade Ele 478.07 --47- 3" 37-841 3748**\$**" 19759 PLAN GENERAL NOTES:~ NEARL NOTES:"
Concrete in handrail to be 1:2:3 mix, Clc "9". Concrete in slabs, curbs, and girders to be 1:2:32 mix, Class"X". All other concrete to be 1:2:4 mix, Class 'B' teinforced concrete deck girder spans shall be constructed full length and width at one operation. constructed till length and width at one operation.

No construction joints permitted.

Exposed edges to be beveled. A where other bevel is noted.

Where rubber compound is specified on plans for use in partition and expansion joints, the premoulded joint shall be securely stitched to one face of concrete with copper wire.

Two name plates, type "I" as shown on 5td. 5-918"R, to be furnished and placed by contractor. Cost of name plates to be included in price bid for other items.

Bridge expansion in accordance with Section Laf Standard.

ESTIMATE	QUANT	ITIES		
ITEM		SUBSTR.	SUPERSTR.	707,4/
Excavation Class I	Cu. Yds.	€90		630
Concrete 1:2:3 Mix, Class "A"	Cu. Yds.		19.7	19.7
Concrete 1:2:4 Mix, Class"B"	Cu. Yds.	2:35.7		295.7
Concrete 1:2:32 Mix. Class"X"	Cu. Yds.	and the same of th	2755	275.5
Phasphor Bronze Bearing Pls. (F.	langed)(8×17)	Vets of	5 Plates e	sch.
Phosphor Bronze Bearing Pls.(Fla	inged) (8'420')	4 Sets of	5 Plates eac	ch.
Reinforcing Steel	Lb5.	16,950	63,500	85,450
Creos Timber Piling	Lin. Ft:	2169		2169
Creos Timber Pile Cut-offs	Lin. Ft.	252		252

Note-All bridge excavation to be paid for as Class I Bridge Excavation. Estimated quantity of creosoted trinber piling includes four linear feet per pile as allowance for me'al shoes in accordance with Specifications. Endge excavation in accordance with Section I of Standard Specifications issued April 1, 1930.

Chily sufficient comber to be used in construction to insure against settlement below lines given as finished grade. No permanent comber required in individual spans. Talsework for spans over existing railroad tracks shall be

constructed with a minimum vertical clearance of 20-0 and a minimum horizontal clearance of 7-0 from centerline of tracks. Piling to be driven to sustain a load of 20 ton per pile. Bar supports and spacers will be required for reinforcing steel in superstructure. See Std. C-110R and Special Provisions.


apediai rrovisions. Al-concrete shall be proportioned by the weight proportioning method. See Special Provisions.

NO. SIZE VENETH MARK LOCATION BENDING SKETCHET & CUTTING DIAGRAMS 18 17-3" H: Wing 19 23'3" H2 Bear 51.513.WI & WZ Coll.Wall DI & DZ

COMPLETE BILL OF REINFORCING STEE

STATE FED. AND FISCAL PROJ. NO. YEAR

Note:-Dimensions gie given along & of bars and are for computed lengths. Reinforcing bars & or over in diameter, which are bent to an angle greater than 90? shall be of structural grade.

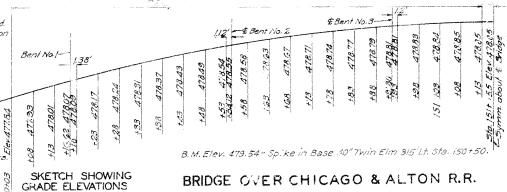

BRIDGE OVER CHICAGO & ALTON R.R.

STATE ROAD FROM GLASGOW TO FAYETTE ABOUT 3 MILES EAST OF GLASGOW

PROJECT NO. NRH256C (R5) STA. 150 + 16.62

COUNTY HOWARD

STD.C-HOR STDC-650IR STD.C-6502P2 STD.S-918R

K-382

Drawn Jan. 1934 By J.G. Checked Jan 1934 By AFK. & RAB.

Survey #2653

Proposed Wertead Crossing

M.P.-K.C.IIC

Scale: !"= & Mile

LOCATION SKETCH

Prosent Grane


Survey #2947

Crossing

Note:-This drawing is not to scale. Follow dimensions.

FA.

Sheet No. 1 of 5.

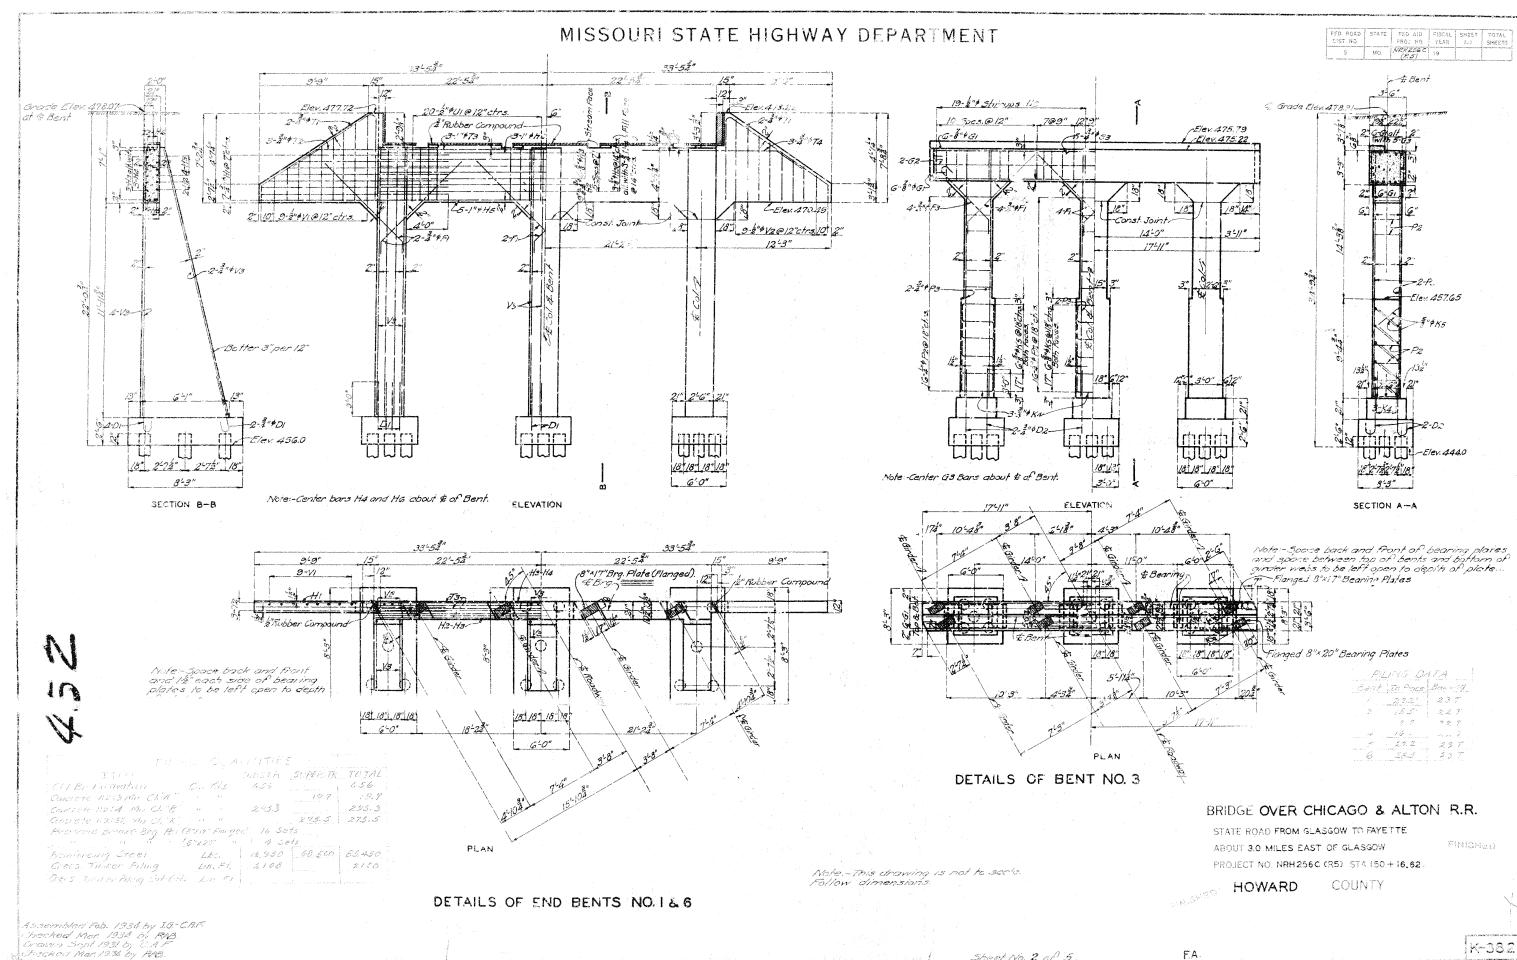

Sheet No. 2 of 5.

MISSOURI STATE HIGHWAY DEPARTMENT FED. ROAD STATE 150, AMD 1503, 5 505 TOTAL OIST, NO. 9PAOJ, HO. YEAR NO. SHEETS 5 MO. 1784 2560 19 19-2"\$ Stirrups U3 Grode Ele v. 478. 81 Grade Elev. 478.55 10-Spc. @ 12" 7-3pc @ 9" 12" 15 3 63 1-1-103 -Elev. 475.48 - Elev. 475.79 6-3-501 7-1 6 K2@ 18" Cts. -£ of Bent & Col. -€ of Col. Both Sides Const. Joint 2 5 " K2 Elev. 452.0 18 3-0" 18 10" 3'0" 18" 6-0" 12" 2'0" 2-0" 12" 6'0" SECTION A-A Note: Center bors G3 sm:h:m **ELEVATION** шшш 10" 18" 18" 15" ELEVATION 18" 2" 72" 2" 72" 18" 81-3" 51-24" SECTION B-B Flanged 8"x17" ELEVATION Bearing Plate Bearing Plate Flonged 8"x20" Ta " Fillet Weld" Bearing Plate 3" Bent Plote Let Pl. project beyond pipe shout & SECTION A-A PLAN DETAILS OF PILING SHOE Note: This drawing is not to seels. Follow dimensions. DETALS OF BENT NO. 4 PLAN PINISHED Note: Space back and front of bearing plates and space between top of bents and bottom of girder webs to be left open to depth of plates. BRIDGE OVER CHICAGO & ALTON R.R. DETAILS OF BENTS NO. 2 & 5 STATE POAD FROM GLASGOW TO PATETTE AROUT 3.0 MILES EAST OF GLASGOW PROJECT NO. NRH256C(RS) STA. 150 + 16-62


Drown Sock 1938 By HMH. Assembled Feb 1939 by J.C. R. L.W.Y. Checked Mar. 1934 By FAB. Credited Mar. 1934 by FAB.

HOWARD

COUNTY


50501 NO.3 OF 5


lK-382

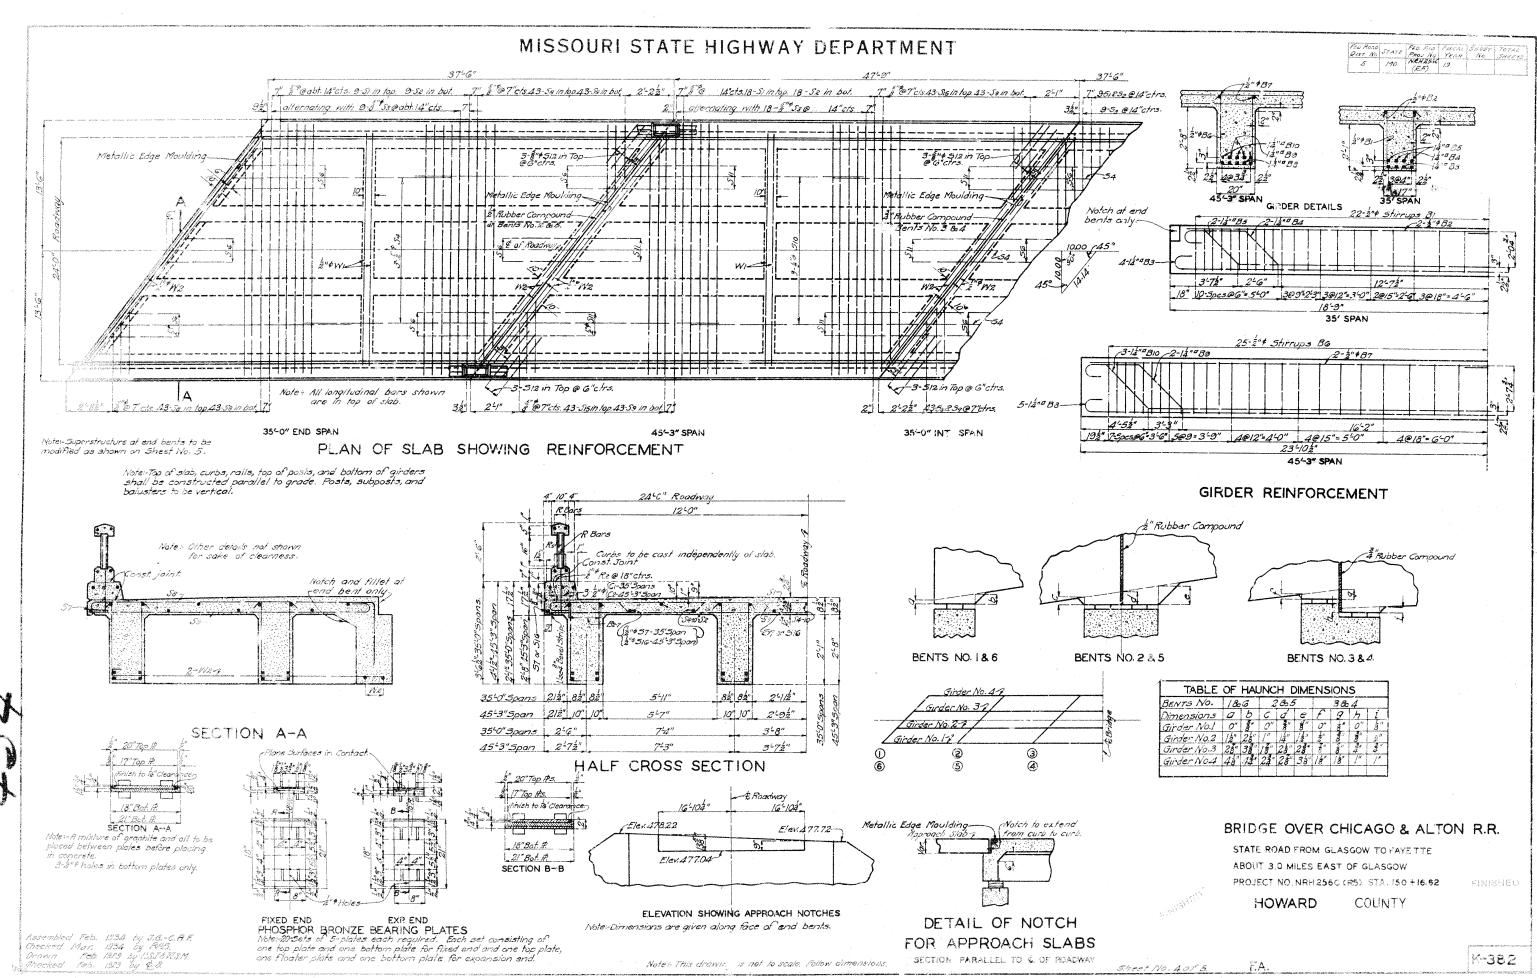


DECK GIRDERS C 615


3-8"\$ 514 @5"ch (Top and bottom PLAN SHOWING REINFORCING RIGHT ADVANCE SKEW 30° AND OVER

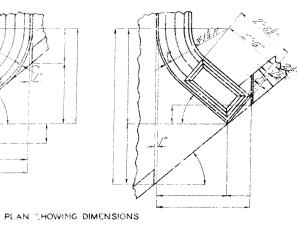


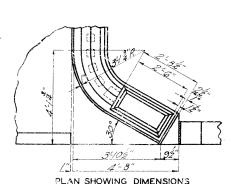

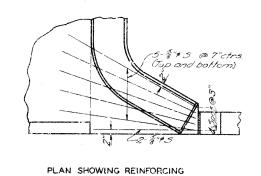


MISSOURI STATE HIGHWAY DEPARTMENT

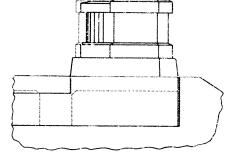


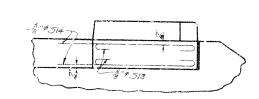

DECK GIRDER SPAN SHOWING POST

SLAB SPAN SHOVING REINFORCING

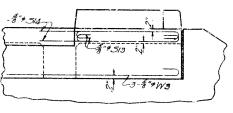

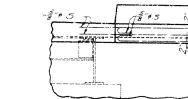


DECK GIRDER SPAN SHOWING REINFORCING

I-BEAM SPAN SHOWING REINFORCING

TYPICAL END ELEVATIONS

SQUARE END BENT

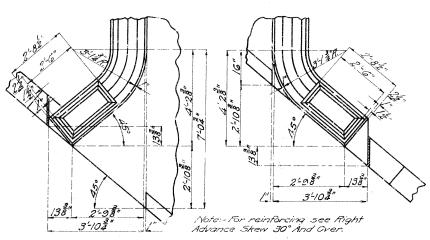

-6-8"\$ 514@9"ctrs. (Top and bottom)

LEFT ADVANCE SKEW 30° AND OVER

GENERAL NOTES:


For details of handrail see 35"A", 35"B" and 35"C" on 5rd. C-G501R2 and 45"B" on 5rd C-G502R2. Handrail. Curb and slab to be modified at end bents as shown on this sheet.

on this sneer.

Length of panels between subposts on right-hand rail on 35% and left-hand rail on 35% to be 7-88 instead of 7-2". Use II balusters in each panel. Add the lefter R to bar mark for all lengitudinal rail bers in these panels.

Length of panels between subposts on left-hand rail on 35°4" and right-hand rail on 35°6" to be 6°82" instead of 7°2". Use 10 balusters in each panel. Add the letter L to bar mark for all longitudinal rail bars in these panels.

Length of panels between subposts on 45"8" to be 10-04" instead of 9-114". Omit outlets

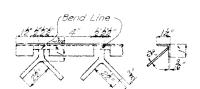

METALLIC EDGE MOULDING


Nate: Cost of metallic edge moulding will be included in unit bid price for concrete.

FR. SHED

BRIDGE OVER CHICAGO & ALTON R.R.

STATE ROAD FROM GLASGOW TO FAYETTE ABOUT 3.0 MILES EAST OF GLASGOW PROJECT NO. NRH256C(R5) STA. 150 + 16.02

COUNTY HOWARD

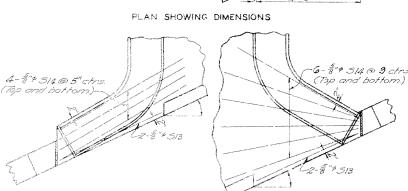

PLAN SHOWING REINFORCING

RIGHT ADVANCE SKEW LESS THAN 30°

Assembled Feb. 1934 by J.G.-C.A.F. Checked March 1934 by RAB on April 1932 by CAL

TYPICAL DETAILS OF CONCRETE RAIL AT END BENT

Note:-This drawing is not to scale.

K-382






-6- 8" + 514@ 9 ctrs.

4'-8"

Note:-For reinforcing see Right Advance Skew Less Than 30°

LEFT ADVANCE SKEW LESS THAN 30°

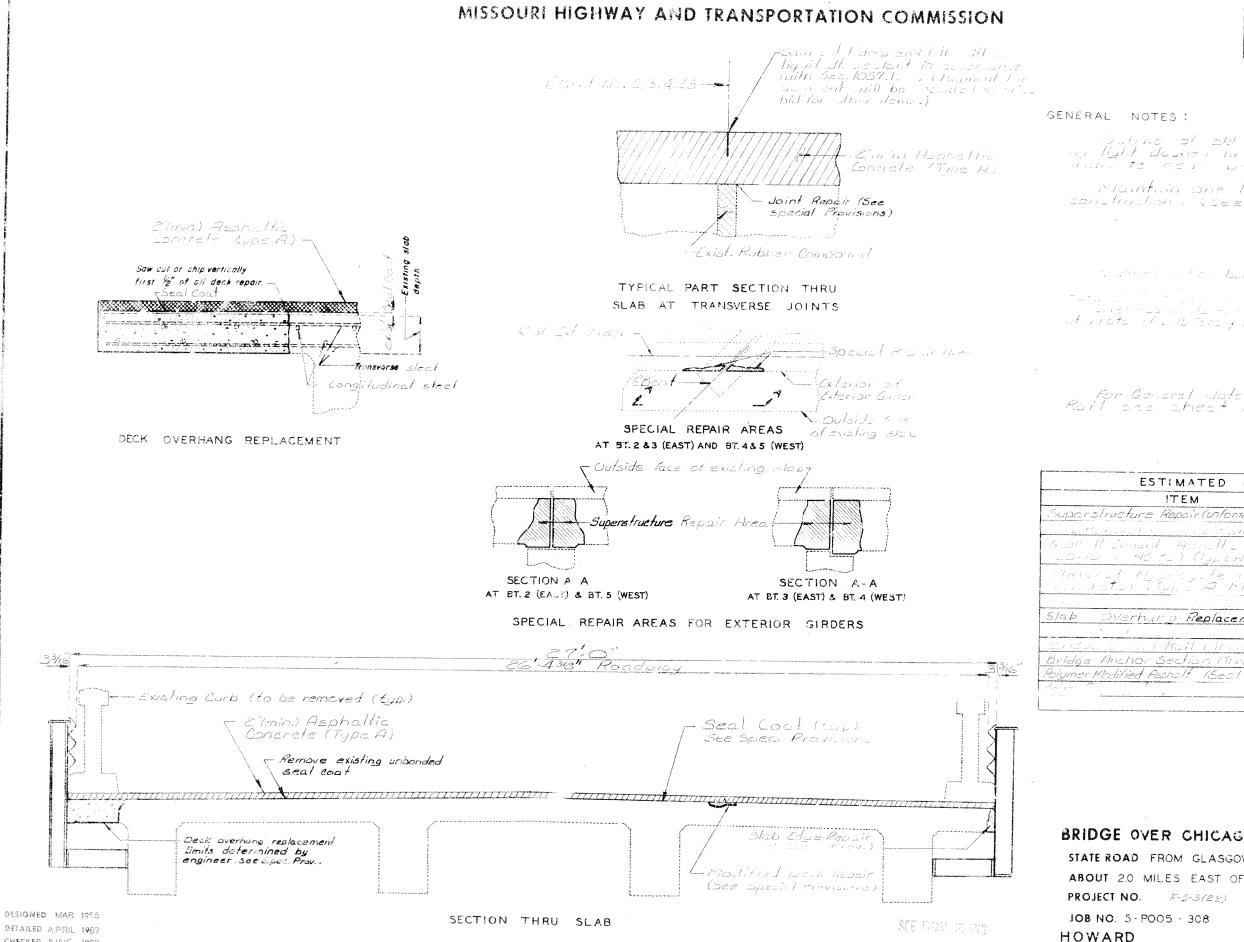

Note: This drawing is not to scale. Follow dimensions.

CHECKED JUNE 1987

I TWE SIN RGE 17 W

Outline of old work is mele to the land light desired lines. Heavy lines work.

Maintain one lane of traffic during construction. (See Hoad Minus).

Relament how Con Assistant at a rate of was tens por square sand.

Rail see sheet No. 3. Thrie Beam

ESTIMATED QUANTITIES	
!TEM	TOTAL
Superstructure Repair (unformed) See SpecProx, Sq.Fl.	50
war the many I am it is a sum Installation in Ft.	396
Abot Al Censul Associate Consider) 120-10 - 40-20 (Type H Mix) Ton	2,9
Mineral Aggregate (Asonaltic Convetor (Type A Mix) Ton	3
Slab Overhung Replacement Lin. F.	225
59. 71.	44.7
Bridge Chart Kail (Thris Bean) Lim. Fl.	393
Bridge Anchor Section (Trice Ecom) Fact	4
Polymer Modified Asphalt (Seal Coal) Gal.	210

BRIDGE OVER CHICAGO, MO. & WESTERN R.R.

STATE ROAD FROM GLASGOW TO FAYETTE ABOUT 2.0 MILES EAST OF GLASGOW

DATE // 1/88


Sheet No. 1 of 4

RTE. 5

STA. 150 + 16.62

COUNTY

STD. STD. 606.00 K-382R

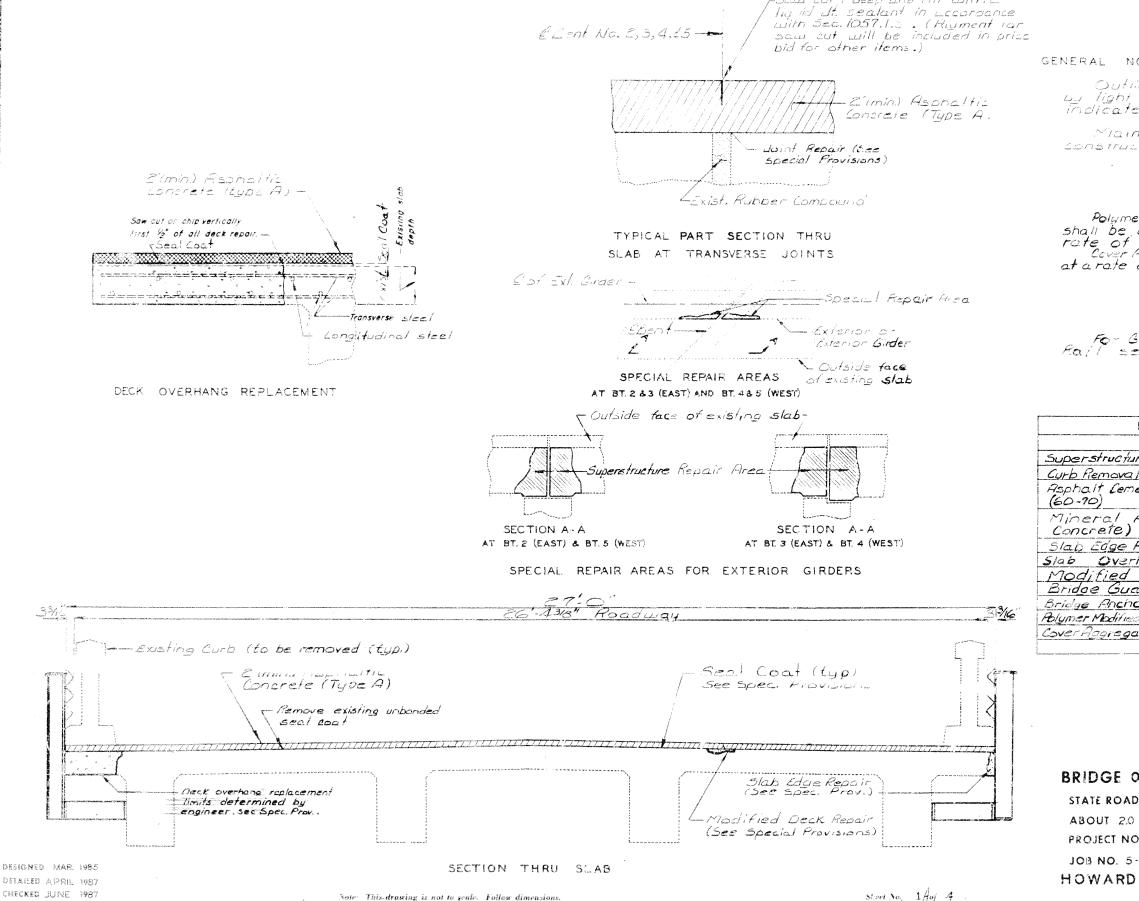

MISSOURI HIGHWAY AND TRANSPORTATION COMMISSION

-saw out I'deep and fill with a

PROJ NO F-5-3(22) SEC SUR II TWP SIN RGE 17W

GENERAL NOTES:

Outline of old work is indicated by light dashed lines. Heavy lines indicate new work.

Maintain one lane of traffic during construction. (See Koad Floris)

Polymer Modified Asphalt Emploion for seal coat shall be Grade CRS & (modified) applied at a rate of .35 gal. per square vard. Cover Aggregate for seal coat shall be applied at a rate of .015 Tons per square good.

For General Notes for Thrie Beam Rail see sheet No. 3.

ESTIMATED QUANTITIES	
ITEM	TOTAL
Superstructure Repair (unformed) See Spec Prov. Sq. Fl.	50
Curb Removal for Thrie Beam Installation Lin.Ft.	396
Asphalt Cement (Asphaltic Concrete) (60-70) (Type A Mix) Ton	3./
Mineral Aggregate (Asphaltic Concrete) (Type A Mix) Ton	.55
Slab Edge Repair (Bridges) Lin.Ft.	/2
Slab Overhang Replacement Lin. Ft.	227
Modified Deck Repair 59. Ft.	.86/
Bridge Guard Rail (Thrie Beam) Lin. Ft.	393
Bridge Anchor Section (Thrie Beam) Each	4
Polymer Modified Asphalt (Seal Coat) Gal.	210
Cover Aggregate , See Special Provisions Ton	9

BRIDGE OVER CHICAGO, MO. & WESTERN R.R.


STATE ROAD FROM GLASGOW TO FAYETTE ABOUT 2.0 MILES EAST OF GLASGOW


PROJECT NO. FS-3(22) STA. 150 + 16.62


JOB NO. 5 - POO5 - 308


RTE. 5 COUNTY STD. STD. 606.00 K-382R


DATE 11/16/88

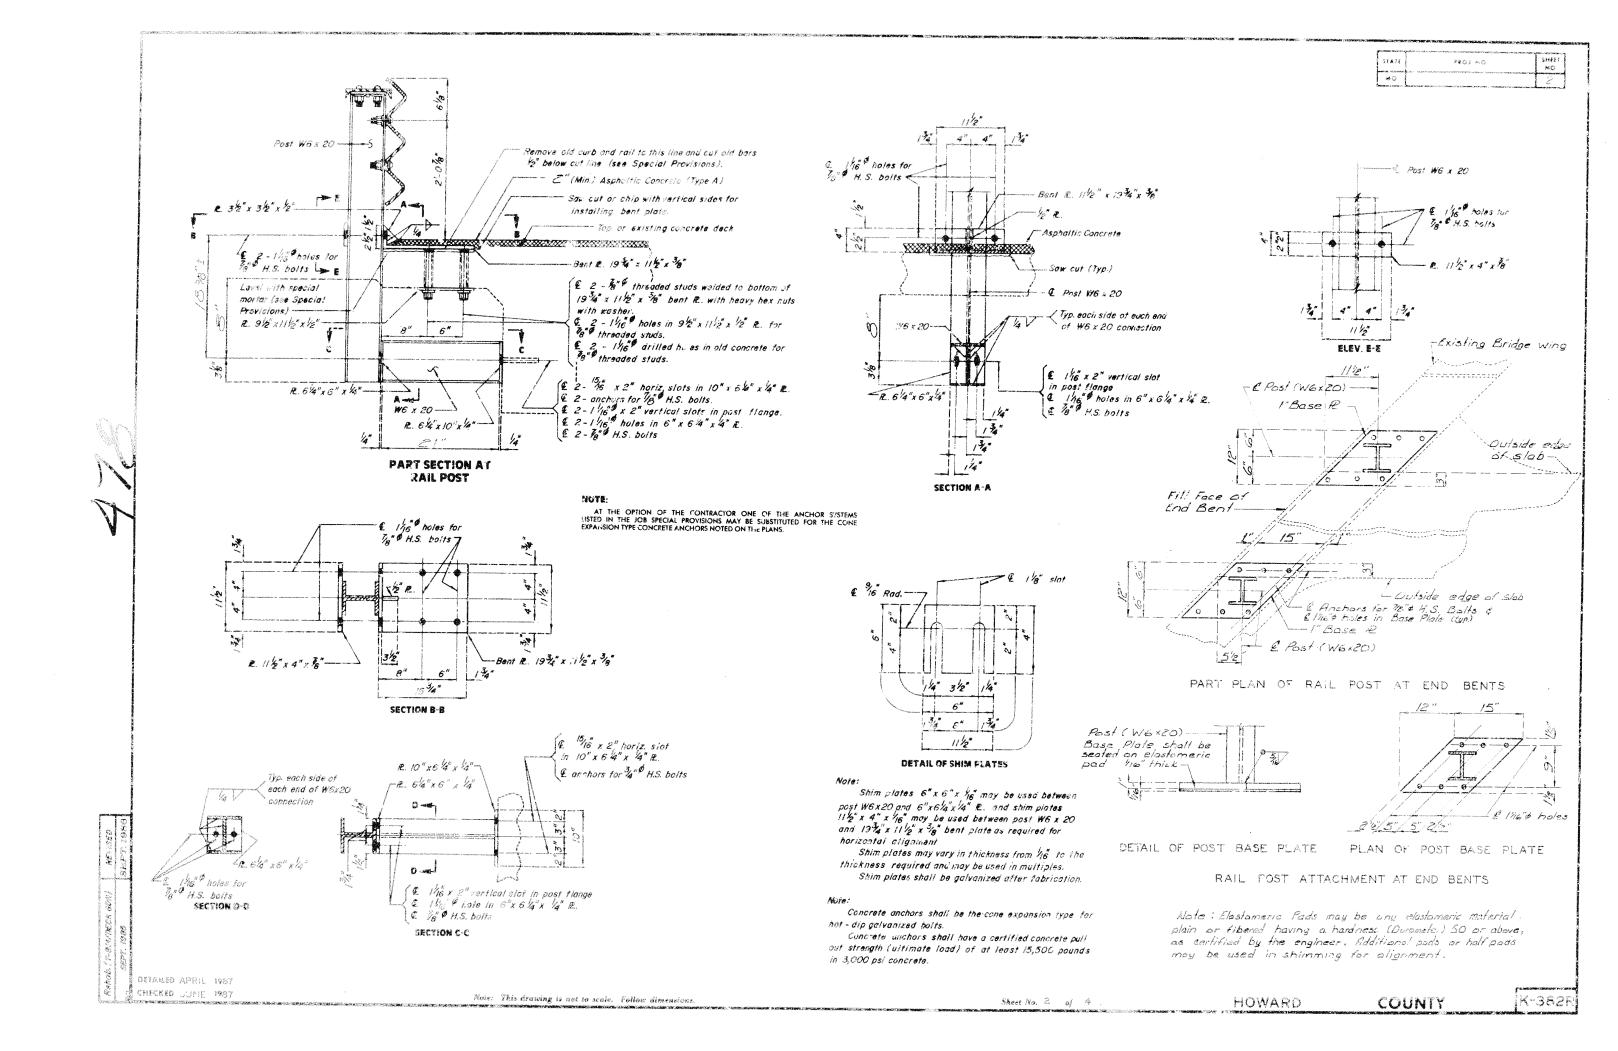

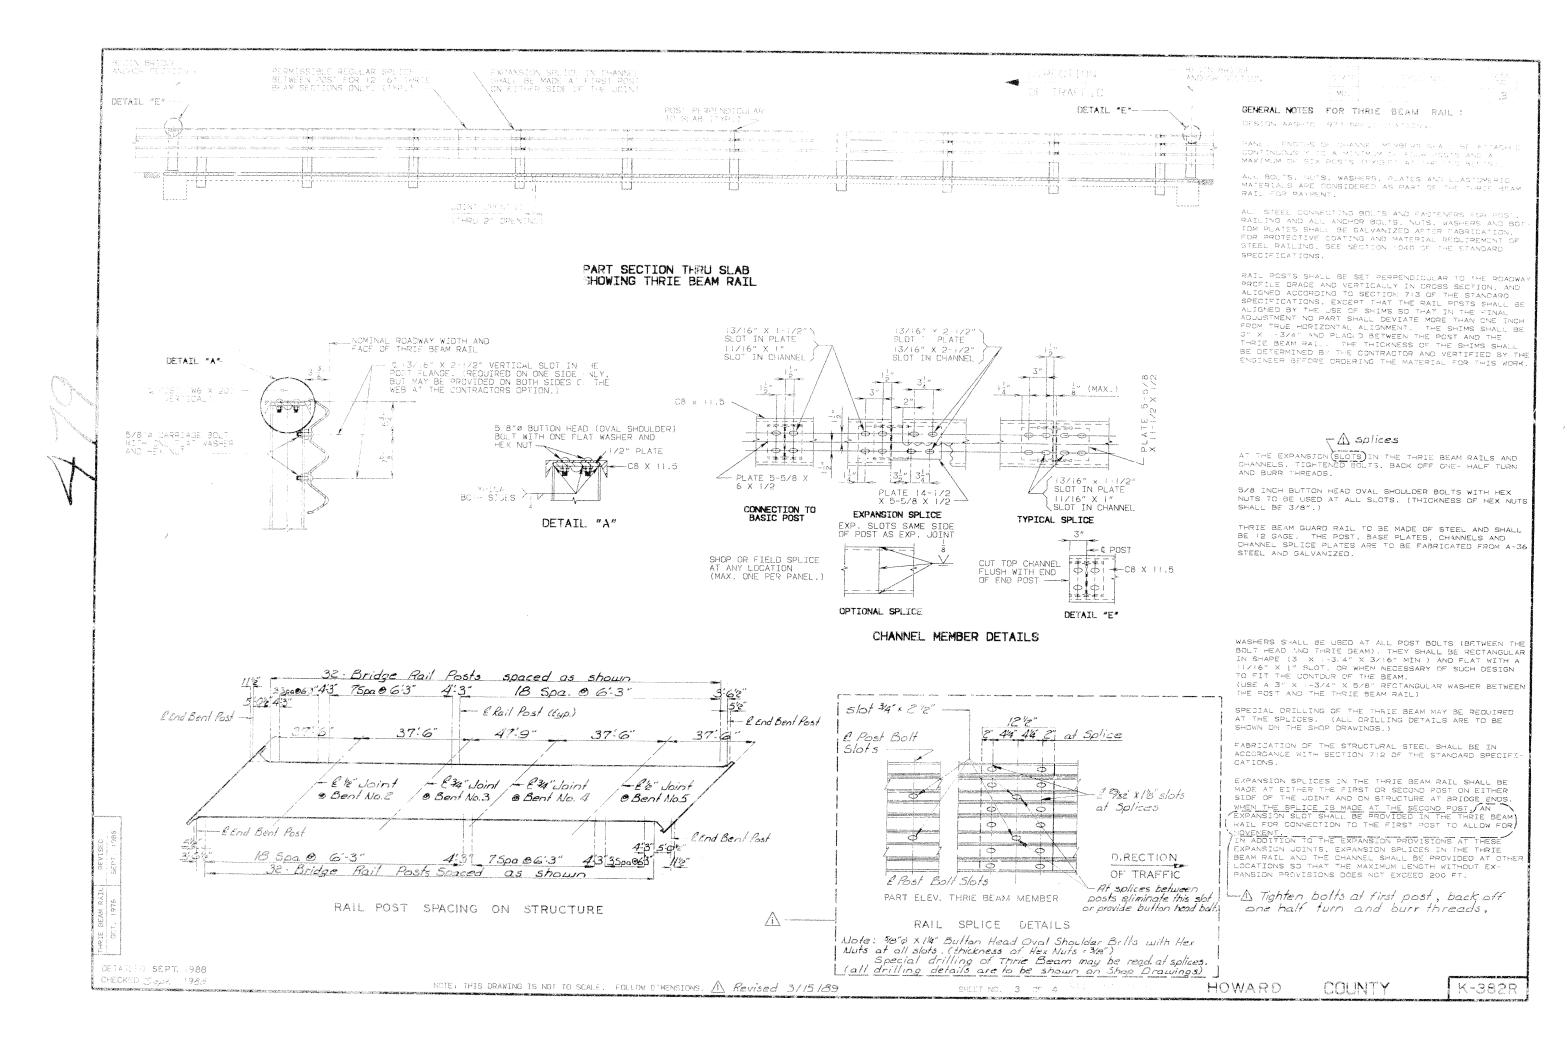

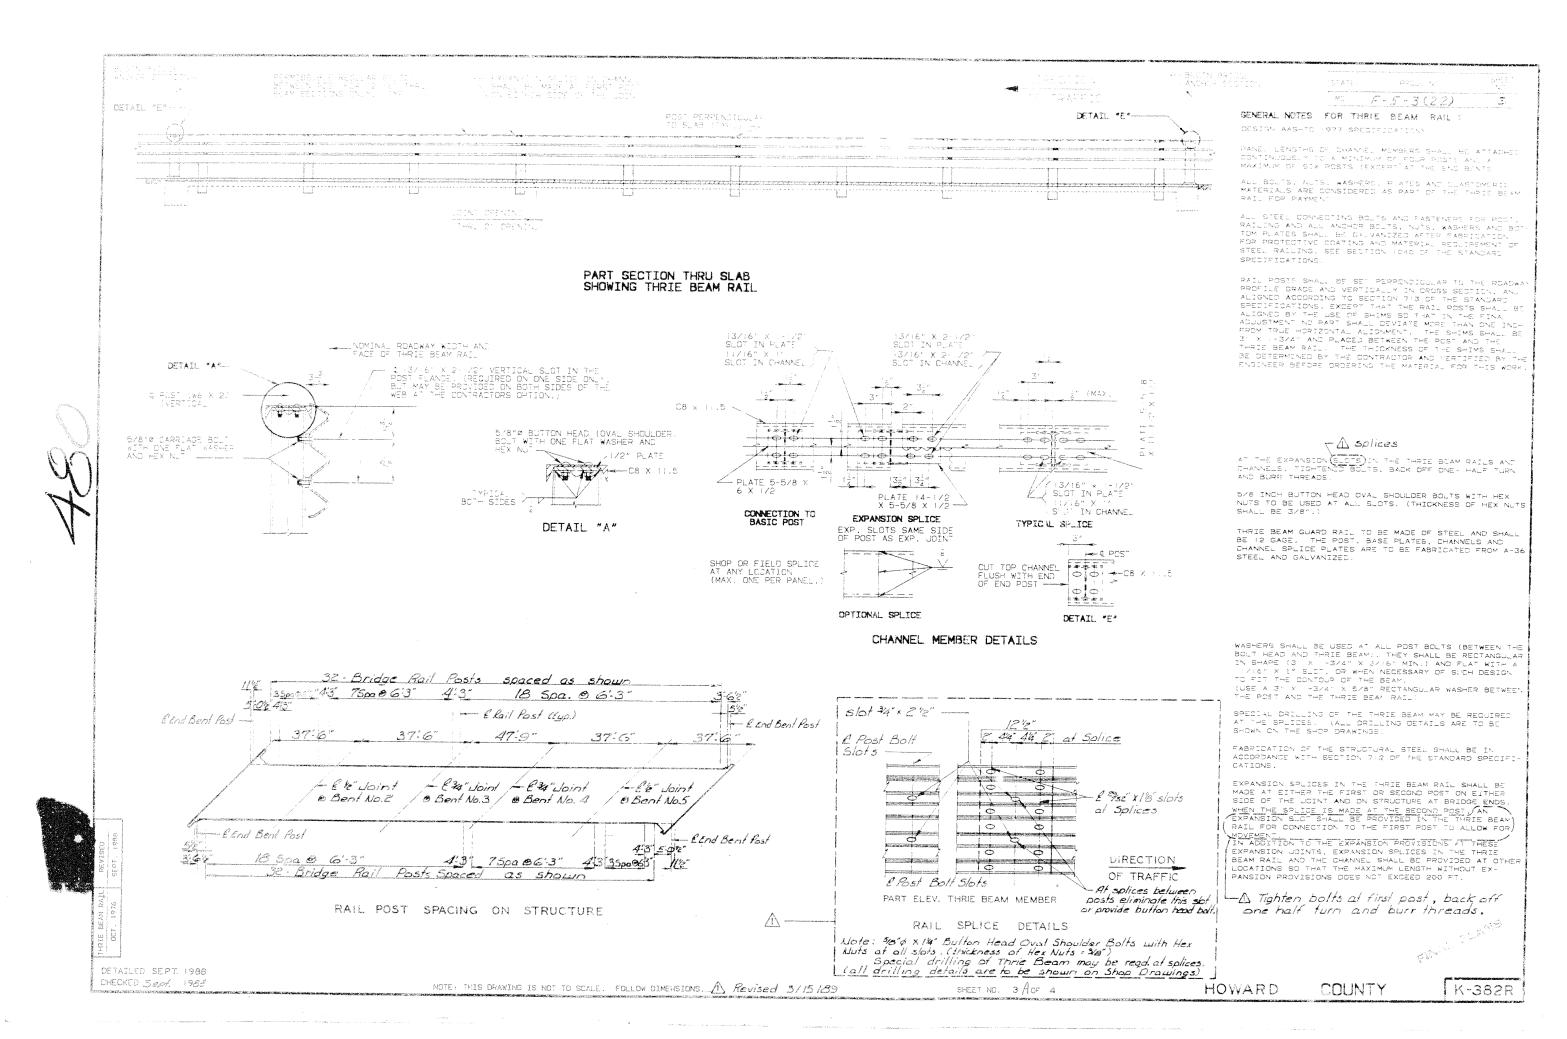

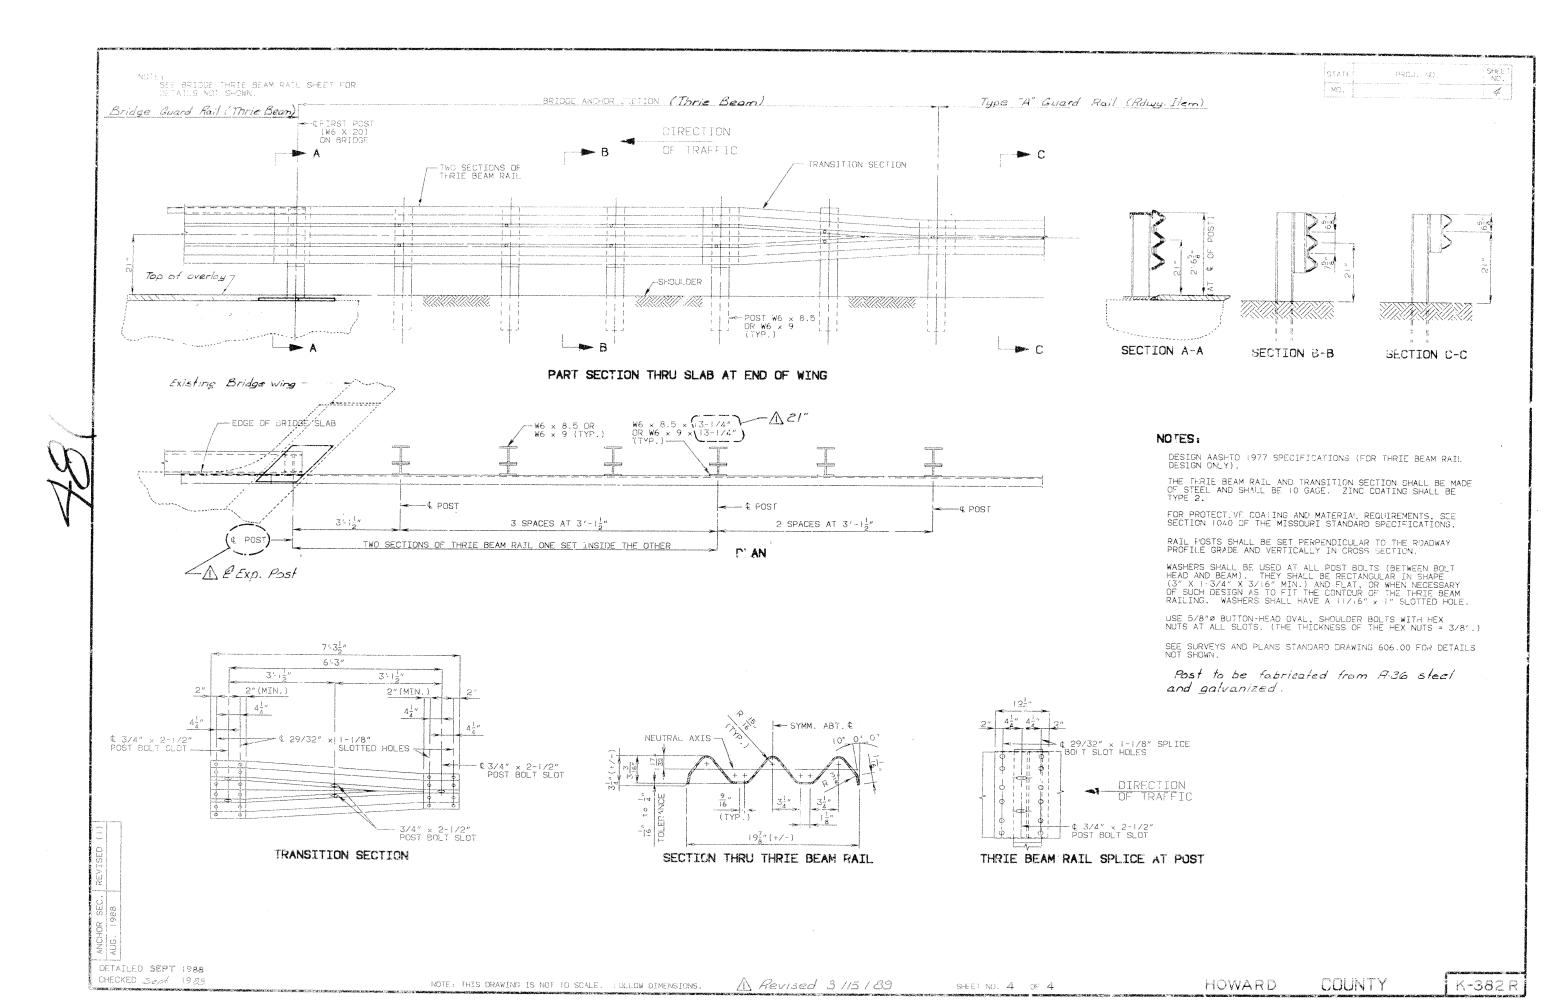

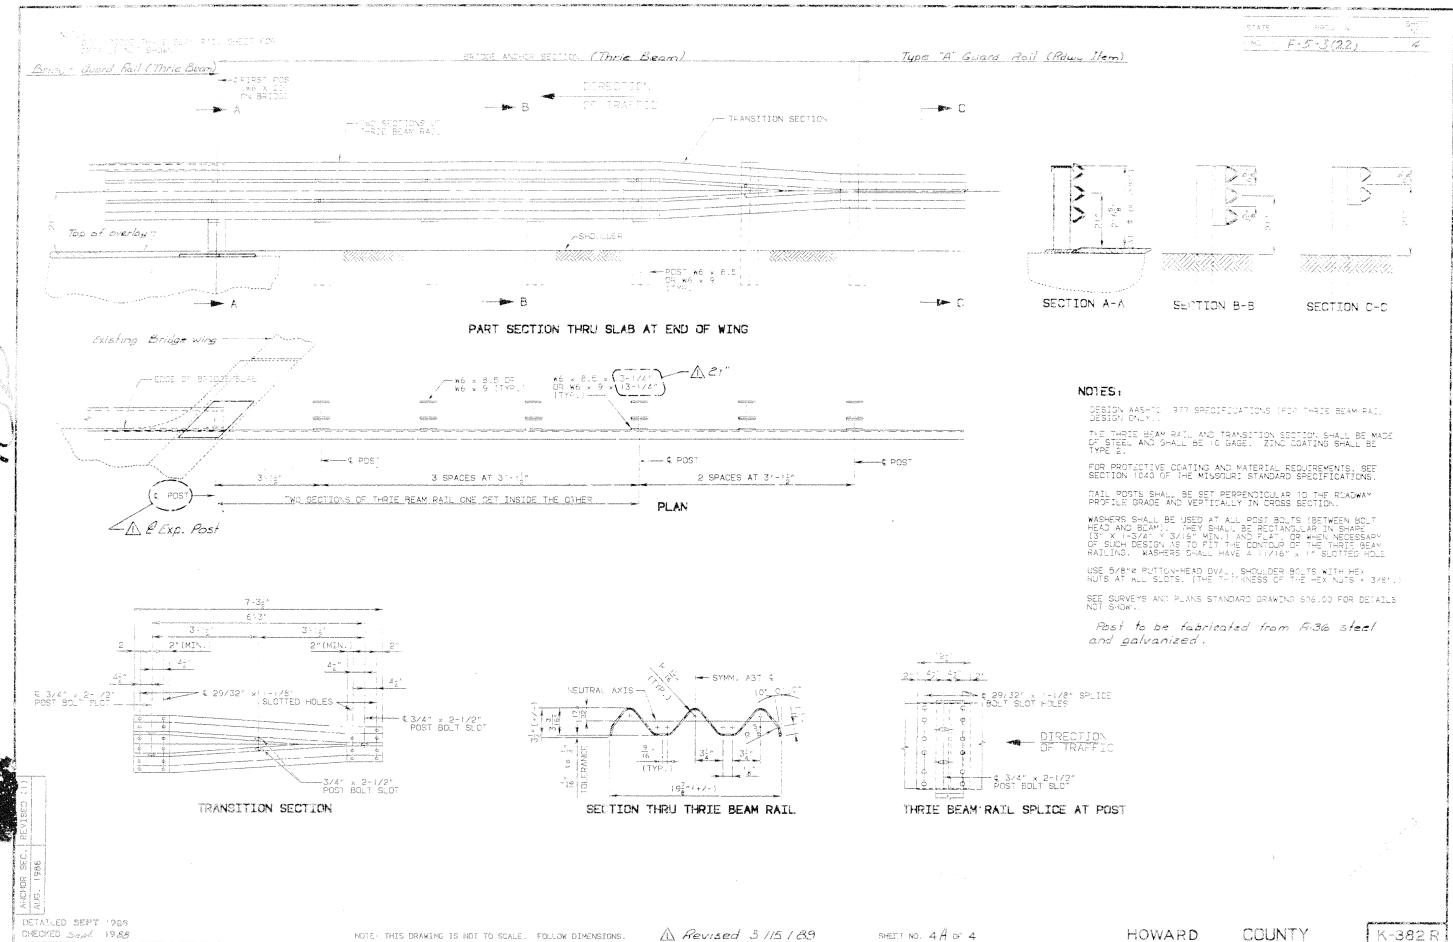

COUNTY

April 29, 2025 1:35:49PM

COUNTY: HOWARD DISTRICT: CD CLASS: STATBR FED-ID: 5794 BRIDGE: K0382

GENERAL STRUCTURE INFORMATION ***BRIDGE INSPECTION INFORMATION*** ROUTE: BU240E # **SPANS**: 5 PLACE CODE: 13222 CHARITON **RESPONSIBILITY: DISTRICT DATE:** 06/05/2023 LANES ON: 2 FEATURE: KCS RR **LENGTH:** 198 FT 0 IN FREQUENCY: 24 **CALCULATED INTERVAL**: 24** LANES UNDER: 0 STATUS: A-OPEN **MAXIMUM SPAN: 47 FT 5 IN TEAM LEADER:** JOE GREEN **ELEMENT: NO LOG MILE: 3.498 COMPASS DIRECTION: WEST to EAST** APPROACH ROADWAY: 22 FT 0 IN **INSPECTOR 2: INSPECTOR 4: DETOUR: 22.00 MILES DIRECTION OF TRAFFIC: 2-WAY TRAF CURB TO CURB: 26 FT 4 IN INSPECTOR 3: OUT TO OUT: 27 FT 0 IN** NHS: NO **FUNCTIONAL CLASS: RL-LOCAL** ** When calculated interval exceeds the frequency, a justification comment per BIRM is required. **BUILT:** 1934 **NBI OWNER: MODOT AADT:** 705 **GENERAL INSPECTION COMMENTS** REHAB: **NBI MAINTAINED: MODOT AADT YEAR: 2024** MAINTENANCE DISTRICT: CD LOCATION: S 11 T 51 R 17 W **AADT TRUCK: 6.4% LATITUDE:** 39 14 4.58 (DMS) **MAINTENANCE COUNTY: HOWARD FUTURE AADT: 881 LONGITUDE:** 92 47 43.80 (DMS) SUB AREA: 7D24 **FUTURE AADT YEAR: 2044** ***INDEPTH INSPECTION INFORMATION*** ***FRACTURE CRITICAL INSPECTION INFORMATION*** DATE: RESPONSIBILITY: **CATEGORY: CATEGORY:** DATE: **RESPONSIBILITY: FREQUENCY: CALCULATED INTERVAL**: NBI**: **FREQUENCY: CALCULATED INTERVAL**: NBI**: **TEAM LEADER: INSPECTOR 3: METHOD: TEAM LEADER: INSPECTOR 3: METHOD: INSPECTOR 2: INSPECTOR 4: INSPECTOR 2: INSPECTOR 4:** ** When calculated interval exceeds the frequency, a justification comment per BIRM is required. ** When calculated interval exceeds the frequency, a justification comment per BIRM is required. FRACTURE CRITICAL INSPECTION COMMENTS **INDEPTH INSPECTION COMMENTS** ***SPECIAL INSPECTION INFORMATION*** ***UNDERWATER INSPECTION INFORMATION*** **CATEGORY: CATEGORY:** DATE: **DATE: RESPONSIBILITY: RESPONSIBILITY:** FREOUENCY: FREOUENCY: **CALCULATED INTERVAL**: NBI**: CALCULATED INTERVAL**: **NBI**: TEAM LEADER: **INSPECTOR 3: METHOD: TEAM LEADER: INSPECTOR 3: METHOD: INSPECTOR 2: INSPECTOR 4: INSPECTOR 2: INSPECTOR 4:** * When calculated interval exceeds the frequency, a justification comment per BIRM is required. ** When calculated interval exceeds the frequency, a justification comment per BIRM is required. SPECIAL INSPECTION COMMENTS **UNDERWATER INSPECTION COMMENTS** OTHER SPECIAL INSPECTIONS OTHER UNDERWATER INSPECTIONS **DATE FREQUENCY CATEGORY** NBI CALCULATED INTERVAL RESPONSIBILITY **METHOD** DATE **FREQUENCY CATEGORY** NBI CALCULATED INTERVAL RESPONSIBILITY **METHOD**

April 29, 2025 1:35:49PM

COUNTY: HOWARD

DISTRICT: CD

CLASS: STATBR

FED-ID: 5794

BRIDGE: K0382

	AKD DISTRICT: CI		CLASS: STATBR	FED-1D:	5/94 BRIDGE: KU382	
	-		***STRUC	CTURE POSTING***		
APPROVED CATEGORY: S-1 Ton 1:	NO POSTING REQUIRED Ton 2:		Ton 3:			
COMMENTS:						
FIELD CATEGORY: S-1 Ton 1: COMMENTS:	NO POSTING REQUIRED Ton 2:		Ton 3:	PROBLEM:	PROBLEM DIRECTION:	
		**	**GENERAL COMM	ENTS/MAJOR RATED IT	EMS***	
GENERAL COMMENTS: (BOWDEJ1, (03/07/2008)(35'-35'-47'-35'-35') DECK GDR	SPANS				
-	K: 4-POOR CONDITION G: 06/06/2023	COMMENTS	S: (MADSEJ, 10/05/2015)	APPROXIMATELY 25% SATUR.	ATION, DELAMINATIONS, AND SPALLS ON SPAN 1.	
-	R: 4-POOR CONDITION G: 06/06/2023	COMMENTS	S: (GREENA2, 06/06/2023)- EXTERIOR GIRDERS.	CRACKING, SPALLING, AND	HEAVY DETERIORATION ON THE EXTERIOR GIRDERS AND DIAP	HRAMS. MANY H-CRACKS IN
	B: 5-FAIR CONDITION G: 09/30/2019	COMMENTS			HIGHSTEEL SPALLS THROUGHOUT ALL SUBSTRUCTURE UNITS. MOD SL IN PRIMARY STEEL IN CAP	
	L: N-NOT APPLIC NO WATRWAY G: 05/18/2001	COMMENTS	S: (BOWDEJ1, 02/11/2010)-	BRUSHY & VINES - 2008 EAS	T SLOPE EROSIONS UP TO ABUT 6 CAP, ABUT COLUMN'S NOT PIL	E
[ITEM 113] SCOU	R: N-NOT APPLIC NOT WATERW	COMMENTS	S:			
RATING EVALUATION TYPE	G: 05/18/2001 C:					
[ITEM 71] WATERWAY ADEQUACY RATING	Y: NOT APPLICABLE G: 05/18/2001	COMMENTS	S:			
[ITEM 72] APPRRDWY ALIGNMENT RATING	Γ: 5 - FAIR G: 05/18/2001	COMMENTS	S:			
		RAILING	AND APPROACH PA	VEMENT COMPONENTS	S AND RATINGS	
[ITEM 36A] BRIDGE RAILING R	ATING: MEETS CURRENT STANDARDS-1		RATING : 05/18/2001	COMMENTS:		
<u>MATERIAL</u> GALVANIZED STEEL	<u>CONSTRUCTION</u> THRIE BEAM	<u>DIRECTION</u> BOTH	<u>COMMENTS</u>			
[ITEM 36B] TRANSITION RAILING R.	ATING: MEETS CURRENT STANDARDS-1		RATING: 05/18/2001	COMMENTS:		
<u>MATERIAL</u> GALVANIZED STEEL	<u>CONSTRUCTION</u> THRIE BEAM TO W-BEAM	<u>DIRECTION</u> ALL	<u>COMMENTS</u>			
[ITEM 36C] APPROACH RAILING R.	ATING: MEETS CURRENT STANDARDS-1		RATING: 05/18/2001	COMMENTS:		
<u>MATERIAL</u> GALVANIZED STEEL	<u>CONSTRUCTION</u> W-BEAM	<u>DIRECTION</u> ALL	<u>COMMENTS</u>			
[ITEM 36D] RAIL END TREATMENT RA	ATING: DOESN'T MEET CUIDDN'T STAID O		RATING : 01/26/2004	COMMENTS:		

April 29, 2025 1:35:49PM

Missouri Department of Transportation State Bridge Inspection Report

COUNTY: HOWARD DISTRICT: CD CLASS: STATBR FED-ID: 5794 BRIDGE: K0382 CONSTRUCTION DIRECTION **COMMENTS** MATERIAL **GALVANIZED STEEL** TURN DOWN SECTION > 45 ALL APPROACH PAVEMENT: *Overall condition assigned for each approach pavemenet component is shown below. **MATERIAL CONSTRUCTION DIRECTION CONDITION* COMMENTS ASPHALT BITUMINOUS MAT BOTH GOOD** ***DRAINAGE, EXPANSION DEVICES, BANK/SLOPE, AND DECK PROTECTIVE COMPONENTS*** **DECK PROTECTIVE COMPONENTS: SERIES TYPE-# COMPONENT MATERIAL CONSTRUCTION THICKNESS** YEAR APPLIED MANUFACTURE **OVERALL CONDITION** MAIN SERIES-1 WEARING SURFACE ASPHALTBITUMINOUS MAT 1.5 IN *FAIR* **COMMENT: DECK PROTECTION NONE** *NOTAPPLICABLE* **COMMENT:** *MEMBRANE* **NONE** *NOTAPPLICABLE* **COMMENT:** SECONDARY DECK PROTECTION LIQUID SEALANT INTERNALLY SEALED 2021 PAVON INDECK **COMMENT: DRAINAGE COMPONENTS: COMPONENT MATERIAL CONSTRUCTION DIRECTION COMMENTS EXPANSION DEVICE COMPONENTS:** SUB UNIT-# SUB LABEL <u>COMPONENT</u> **MATERIAL CONSTRUCTION GAP** YEAR APPLIED **OVERALL CONDITION** *MANUFACTURE* **COMMENT: BANK/SLOPE PROTECTION COMPONENTS: COMPONENT MATERIAL CONSTRUCTION DIRECTION COMMENTS** ***DECK COMPONENTS*** SPAN TYPE-# **COMPONENT MATERIAL CONSTRUCTION COMMENTS** MAIN SPANS-1 DECKREINFORCED CONCRETE CAST-IN-PLACE LOCATION 1 **CONDITION LOCATION 2 SEVERITY MEASUREMENT COMMENT DELAMINATION THROUGHOUT MODERATE MODERATE** DETERIORATION **OVERHANGS** EFFLORESCENCE THROUGHOUT LIGHT

SATURATION THROUGHOUT TRANSVERSE CRACKS THROUGHOUT

DECK

REINFORCED CONCRETE

CAST-IN-PLACE

<u>CONDITION</u> <u>LOCATION 1</u> <u>LOCATION 2</u> <u>SEVERITY</u> <u>MEASUREMENT</u> <u>COMMENT</u>

 $Design_No = k0382$

MAIN SPANS-2

MODOT

Page

MODERATE

MANY

25 %

MODOT

COUNTY: HOWARD DISTRICT: CD CLASS: STATBR FED-ID: 5794 BRIDGE: K0382 THROUGHOUT MODERATE DELAMINATION **MINOR** DETERIORATION **OVERHANGS EFFLORESCENCE** THROUGHOUT LIGHT 10 % SATURATION THROUGHOUT **MINOR** RANDOM **FEW** SPALLS TRANSVERSE CRACKS THROUGHOUT MANY MAIN SPANS-3 DECKCAST-IN-PLACE REINFORCED CONCRETE **CONDITION** LOCATION 1 **LOCATION 2 SEVERITY MEASUREMENT COMMENT** DELAMINATION THROUGHOUT **MODERATE MODERATE** DETERIORATION **OVERHANGS EFFLORESCENCE** THROUGHOUT LIGHT **MODERATE** 25 % SATURATION THROUGHOUT (MEYERM3, 02/06/2020)--HARD TO JUDGE THIS FROM UNDERNEATH DUE TO THE BUILD UP OF RAILROAD SUIT TRANSVERSE CRACKS THROUGHOUT MANY MAIN SPANS-4 DECKREINFORCED CONCRETE CAST-IN-PLACE **CONDITION** LOCATION 1 LOCATION 2 **SEVERITY MEASUREMENT COMMENT** THROUGHOUT **FEW DELAMINATION** DETERIORATION **OVERHANGS MINOR EFFLORESCENCE** THROUGHOUT LIGHT 10 % SATURATION THROUGHOUT MINOR THROUGHOUT MANY TRANSVERSE CRACKS MAIN SPANS-5 DECK REINFORCED CONCRETE CAST-IN-PLACE **CONDITION** LOCATION 1 LOCATION 2 **SEVERITY MEASUREMENT COMMENT** THROUGHOUT **MODERATE DELAMINATION DETERIORATION OVERHANGS MODERATE** EFFLORESCENCE THROUGHOUT LIGHT SATURATION THROUGHOUT **MINOR** 10 % TRANSVERSE CRACKS THROUGHOUT MANY ***SUPERSTRUCTURE COMPONENTS*** SERIES TYPE-# SPAN TYPE **MATERIAL CONSTRUCTION** LABEL **COMMENTS** MAIN SERIES-1 SIMPLE SPAN REINFORCED CONCRETE DECK GIR **COMPOSITE INDICATOR LENGTH WEATHERING STEEL COMMENTS** <u>SPAN</u> MAIN SPANS-1 NON-COMPOSITE 37 FT 6 IN (SIMPSB, 07/26/2004)--GIRDERS BRACKETED @ CAPS NO **SEVERITY CONDITION** LOCATION 1 **MEASUREMENT** LOCATION 2 **COMMENT DETERIORATION DIAPHRAGMS** HEAVY **EXTERIOR GIRDERS HEAVY** DETERIORATION HORIZONTAL CRACKS **EXTERIOR GIRDERS** MANY LIGHT LEACHING **DIAPHRAGMS SPALLS ENDS LARGE** (GREENA2, 06/06/2023)--HEAVY DESENTEGRATION ON THE EAST GIRDER AT THE BEARING **AREA** FEW VERTICAL CRACKS DIAPHRAGMS **THROUGHOUT** MANY VERTICAL CRACKS MAIN SPANS-2 NON-COMPOSITE NO (SIMPSB, 07/26/2004)--GIRDERS BRACKETED @ CAPS 37 FT 8 IN LOCATION 2 **CONDITION** LOCATION 1 **SEVERITY MEASUREMENT COMMENT** (MADSEJ, 10/05/2015)--EXTERIOR GIRDERS. **DETERIORATION ENDS MODERATE** Design $N_0 = k0382$

This report contains information that is protected from disclosure by federal law, 23 USC Section 409 and the Missouri Open Records Law (Sunshine Act), Section 610.021 RSMo. Please review MoDOT's policy and procedure manual on the Sunshine Act before releasing any of the information contained herein.

April 29, 2025 1:35:49PM

Missouri Department of Transportation State Bridge Inspection Report

COUNTY: HOWARD DISTRICT: CD CLASS: STATBR FED-ID: 5794 BRIDGE: K0382

HORIZONTAL CRACKSEXTERIOR GIRDERSMANYVERTICAL CRACKSTHROUGHOUTFINE

MAIN SPANS-3 NON-COMPOSITE 47 FT 5 IN NO (SIMPSB, 07/26/2004)--GIRDERS BRACKETED @ CAPS

<u>CONDITION</u> <u>LOCATION 1</u> <u>LOCATION 2</u> <u>SEVERITY</u> <u>MEASUREMENT</u> <u>COMMENT</u>

DETERIORATION ENDS MODERATE (MADSEJ, 10/05/2015)--EXTERIOR GIRDERS.
HORIZONTAL CRACKS EXTERIOR GIRDERS MANY

LEACHINGDIAPHRAGMSLIGHTVERTICAL CRACKSDIAPHRAGMSFEWVERTICAL CRACKSTHROUGHOUTFINE

MAIN SPANS-4 NON-COMPOSITE 37 FT 8 IN NO (SIMPSB, 07/26/2004)--GIRDERS BRACKETED @ CAPS

<u>CONDITION</u> <u>LOCATION 1</u> <u>LOCATION 2</u> <u>SEVERITY</u> <u>MEASUREMENT</u> <u>COMMENT</u>

DETERIORATION ENDS MODERATE (MADSEJ, 10/05/2015)--EXTERIOR GIRDERS.

EFFLORESCENCEEXTERIOR GIRDERSLIGHTHORIZONTAL CRACKSEXTERIOR GIRDERSMANYVERTICAL CRACKSDIAPHRAGMSFEWVERTICAL CRACKSTHROUGHOUTFINE

MAIN SPANS-5 NON-COMPOSITE 37 FT 6 IN NO (SIMPSB, 07/26/2004)--GIRDERS BRACKETED @ CAPS

<u>CONDITION</u> <u>LOCATION 1</u> <u>LOCATION 2</u> <u>SEVERITY</u> <u>MEASUREMENT</u> <u>COMMENT</u>

DETERIORATION ENDS MODERATE (MADSEJ, 10/05/2015)--EXTERIOR GIRDERS.

EFFLORESCENCE DIAPHRAGMS MEDIUM

TRANSVERSE CRACKS DIAPHRAGMS MANY

VERTICAL CRACKS GIRDER ENCASEMENT
VERTICAL CRACKS THROUGHOUT

MATERIAL

REINFORCED CONCRETE

SUBSTRUCTURE COMPONENTS

OPEN

FINE

SUBSTRUCTURE	<u>SKEW</u>	LENGTH	<u>MATERIAL</u>	<u>CONSTRUCTION</u>	LABEL	COMMENTS	<u>S</u>	
ABUTMENT-1	LA-45 DEGREES	44 FT 11 IN	REINFORCED CONCRETE	OPEN CONCRETE				
	CONDITION		<u>LOCATION 1</u>	<u>LOCATION 2</u>	4	<u>SEVERITY</u>	MEASUREMENT	<u>COMMENT</u>
<u>ASSOCIATE</u>	ED COMPONENT	<u>MAT</u>	<u>'ERIAL</u>	<u>CONSTRUCTION</u>				
BEAM CAP		REII	NFORCED CONCRETE	CAST-IN-PLACE				
	CONDITION		<u>LOCATION 1</u>	<u>LOCATION 2</u>	<u>s</u>	SEVERITY	MEASUREMENT	<u>COMMENT</u>
	VERTICAL CRACK	S	THROUGHOUT			FEW		
COLUMN		REII	NFORCED CONCRETE	CAST-IN-PLACE				
	CONDITION		<u>LOCATION 1</u>	<u>LOCATION 2</u>	<u>s</u>	SEVERITY	MEASUREMENT	<u>COMMENT</u>
	HIGH STEEL SPALL	LS	THROUGHOUT			FEW		
FOOTING		REII	NFORCED CONCRETE	TIMBER PILE				
	CONDITION		<u>LOCATION 1</u>	<u>LOCATION 2</u>	<u>s</u>	SEVERITY	MEASUREMENT	<u>COMMENT</u>
STRAIGHT	WINGS	REII	NFORCED CONCRETE	CAST-IN-PLACE				
	CONDITION		<u>LOCATION 1</u>	<u>LOCATION 2</u>	<u>s</u>	SEVERITY	MEASUREMENT	<u>COMMENT</u>
	DETERIORATION		THROUGHOUT		N	MODERATE		
EXPANSIO	N BEARING	BRC	NZE	SLIDING FLAT PLATE				
	CONDITION		<u>LOCATION 1</u>	<u>LOCATION 2</u>	<u>s</u>	SEVERITY	MEASUREMENT	<u>COMMENT</u>
BENT-2	LA-45 DEGREES	35 FT 10 IN	REINFORCED CONCRETE	MULTIPLE COLUMN		(ZENTZA1, 0	6/03/2010)GIRDERS	S BRACKETED - SEVERE SECTION LOSS ON BRACKETS
	CONDITION		<u>LOCATION 1</u>	<u>LOCATION 2</u>	4	<u>SEVERITY</u>	<u>MEASÚREMENT</u>	<u>COMMENT</u>

CONSTRUCTION

CAST-IN-PLACE

ASSOCIATED COMPONENT

BEAM CAP

MODOT

COUNTY: HOWARD DISTRICT: CD CLASS: STATBR FED-ID: 5794 **BRIDGE: K0382** LOCATION 2 SEVERITY MEASUREMENT COMMENT **CONDITION** LOCATION 1 HIGH STEEL SPALLS THROUGHOUT MANY **SPALLS** THROUGHOUT MANY VERTICAL CRACKS THROUGHOUT **MANY COLUMN** REINFORCED CONCRETE CAST-IN-PLACE **CONDITION LOCATION 1** LOCATION 2 **SEVERITY** MEASUREMENT COMMENT REBAR EXPOSED **FEW** THROUGHOUT **SPALLS FEW** THROUGHOUT **FEW** VERTICAL CRACKS THROUGHOUT **FOOTING** REINFORCED CONCRETE TIMBER PILE **CONDITION** LOCATION 1 LOCATION 2 **SEVERITY MEASUREMENT COMMENT EXPANSION BEARING BRONZE** SLIDING FLAT PLATE **CONDITION** LOCATION 1 LOCATION 2 **SEVERITY** MEASUREMENT COMMENT BENT-3 LA-45 DEGREES 35 FT 10 IN REINFORCED CONCRETE MULTIPLE COLUMN (ZENTZA1, 06/03/2010)--GIRDERS BRACKETED - SEVERE SECTION LOSS ON BRACKETS **CONDITION LOCATION 1 LOCATION 2** SEVERITY MEASUREMENT COMMENT ASSOCIATED COMPONENT **CONSTRUCTION MATERIAL** BEAM CAP REINFORCED CONCRETE CAST-IN-PLACE **CONDITION LOCATION 1 LOCATION 2 SEVERITY MEASUREMENT** COMMENT DELAMINATION **BOTTOM MODERATE** DETERIORATION **THROUGHOUT** MODERATE HIGH STEEL SPALLS THROUGHOUT MANY HORIZONTAL CRACKS **BOTTOM** MANY REBAR EXPOSED **BOTTOM** MANY REBAR SECTION LOSS **THROUGHOUT SEVERE** (MEYERM3, 02/06/2020)--100% AT COLUMN 2 (MEYERM3, 02/06/2020)--STIRRUPS SPALLS **BOTTOM MANY** VERTICAL CRACKS THROUGHOUT **FEW** COLUMN CAST-IN-PLACE REINFORCED CONCRETE LOCATION 2 **SEVERITY** MEASUREMENT COMMENT **CONDITION** LOCATION 1 HIGH STEEL SPALLS **FEW** TOP VERTICAL CRACKS **MANY** THROUGHOUT **FOOTING** REINFORCED CONCRETE TIMBER PILE **CONDITION** LOCATION 1 **LOCATION 2 SEVERITY MEASUREMENT COMMENT EXPANSION BEARING BRONZE** SLIDING FLAT PLATE **SEVERITY CONDITION LOCATION 1 LOCATION 2** MEASUREMENT COMMENT BENT-4 35 FT 10 IN REINFORCED CONCRETE MULTIPLE COLUMN LA-45 DEGREES (ZENTZA1, 06/03/2010)--GIRDERS BRACKETED - SEVERE SECTION LOSS ON BRACKETS **CONDITION** LOCATION 1 LOCATION 2 **SEVERITY** MEASUREMENT COMMENT ASSOCIATED COMPONENT **MATERIAL CONSTRUCTION** BEAM CAP REINFORCED CONCRETE CAST-IN-PLACE LOCATION 1 LOCATION 2 **SEVERITY** MEASUREMENT COMMENT **CONDITION FEW** HIGH STEEL SPALLS THROUGHOUT HORIZONTAL CRACKS **BOTTOM FEW SPALLS FEW** THROUGHOUT VERTICAL CRACKS THROUGHOUT **FEW** COLUMN REINFORCED CONCRETE CAST-IN-PLACE **CONDITION** LOCATION 1 LOCATION 2 **SEVERITY** MEASUREMENT COMMENT REBAR EXPOSED TOP **FEW** TOP **SPALLS** LARGE TOP FEW VERTICAL CRACKS **FOOTING** REINFORCED CONCRETE TIMBER PILE

MoDOT

April 29, 2025 1:35:49PM

Missouri Department of Transportation State Bridge Inspection Report

COL	UNTY: HOWARD	DISTRICT: CD	CLASS: STATBR	FED-ID): 5794	BRIDGE: K0382
	<u>CONDITION</u>	<u>LOCATION 1</u>	<u>LOCATION 2</u>	<u>SEVERITY</u>	<u>MEASUREMENT</u>	<u>COMMENT</u>
COLLISIO		REINFORCED CONCRETE	CAST-IN-PLACE			
	<u>CONDITION</u>	<u>LOCATION 1</u>	<u>LOCATION 2</u>	<u>SEVERITY</u>	<u>MEASUREMENT</u>	<u>COMMENT</u>
EXPANSIO	ON BEARING	BRONZE	SLIDING FLAT PLATE	GELVED IMI	145 4645514514	COLUMNIT
	<u>CONDITION</u>	<u>LOCATION 1</u>	<u>LOCATION 2</u>	<u>SEVERITY</u>	<u>MEASUREMENT</u>	<u>COMMENT</u>
BENT-5		35 FT 10 IN REINFORCED CONCRETE	MULTIPLE COLUMN	,	/	S BRACKETED - SEVERE SECTION LOSS ON BRACKETS
1550 57 17	<u>CONDITION</u>	<u>LOCATION 1</u>	LOCATION 2	<u>SEVERITY</u>	<u>MEASUREMENT</u>	COMMENT
	<u>TED COMPONENT</u>	MATERIAL PER HORGER GONGRETE	<u>CONSTRUCTION</u>			
BEAM CAI	CONDITION	REINFORCED CONCRETE	CAST-IN-PLACE	CELEDITY	MEACUDEMENT	COMMENT
		<u>LOCATION 1</u>	<u>LOCATION 2</u>	<u>SEVERITY</u>	<u>MEASUREMENT</u>	<u>COMMENT</u>
	DELAMINATION HIGH STEEL SPALL	THROUGHOUT S THROUGHOUT		MODERATE FEW		
	SPALLS	THROUGHOUT		LARGE		
COLUMN	SIALLS	REINFORCED CONCRETE	CAST-IN-PLACE	LARGE		
COLUMN	CONDITION	LOCATION 1	LOCATION 2	<u>SEVERITY</u>	MEASUREMENT	COMMENT
	DELAMINATION	TOP	<u> </u>	MANY	THE IS CITED IN THE	COMPARING
	SPALLS	TOP		FEW		
	VERTICAL CRACKS			OPEN		
FOOTING		REINFORCED CONCRETE	TIMBER PILE			
	CONDITION	<u>LOCATION 1</u>	<u>LOCATION 2</u>	SEVERITY	MEASUREMENT	<u>COMMENT</u>
EXPANSIC	ON BEARING	BRONZE	SLIDING FLAT PLATE			
	CONDITION	<u>LOCATION 1</u>	<u>LOCATION 2</u>	<u>SEVERITY</u>	MEASUREMENT	<u>COMMENT</u>
ABUTMENT-6	LA-45 DEGREES	44 FT 11 IN REINFORCED CONCRETE	OPEN CONCRETE			
	CONDITION	LOCATION 1	LOCATION 2	SEVERITY	MEASUREMENT	COMMENT
ASSOCIAT	TED COMPONENT	MATERIAL	<i>CONSTRUCTION</i>			
BEAM CAI	•	REINFORCED CONCRETE	CAST-IN-PLACE			
	CONDITION	<u>LOCATION 1</u>	<u>LOCATION 2</u>	SEVERITY	MEASUREMENT	<u>COMMENT</u>
	EROSION	BOTTOM		INOR UNDERMININ	((ZENTZA1, 06/03/2010)NE CORNER
COLUMN		REINFORCED CONCRETE	CAST-IN-PLACE			
	CONDITION	<u>LOCATION 1</u>	<u>LOCATION 2</u>	<u>SEVERITY</u>	<u>MEASUREMENT</u>	<u>COMMENT</u>
FOOTING		REINFORCED CONCRETE	TIMBER PILE			
	CONDITION	<u>LOCATION 1</u>	<u>LOCATION 2</u>	<u>SEVERITY</u>	<u>MEASUREMENT</u>	<u>COMMENT</u>
STRAIGHT	ΓWINGS	REINFORCED CONCRETE	CAST-IN-PLACE			
	CONDITION	<u>LOCATION 1</u>	<u>LOCATION 2</u>	<u>SEVERITY</u>	<u>MEASUREMENT</u>	<u>COMMENT</u>
BACKWAL		REINFORCED CONCRETE	CAST-IN-PLACE			
	<u>CONDITION</u>	<u>LOCATION 1</u>	<u>LOCATION 2</u>	<u>SEVERITY</u>	<u>MEASUREMENT</u>	<u>COMMENT</u>
EXPANSIO	ON BEARING	BRONZE	SLIDING FLAT PLATE			
	<u>CONDITION</u>	<u>LOCATION 1</u>	<u>LOCATION 2</u>	<u>SEVERITY</u>	<u>MEASUREMENT</u>	<u>COMMENT</u>

OVER/UNDER ROUTES CLEARANCE INFORMATION

CLEARANCES OVER DECK

**NOTE: Vertical clearances for permitting purposes are taken as 2 inches less than the actual field measured clearance.

VERTICAL CLEARANCE TYPE**

VALUE

DIRECTION

DATE

COMMENT

Missouri Department of Transportation

April 29, 2025 1:35:49PM **State Bridge Inspection Report**

CLEARANCES UNDER BRIDGE

COUNTY: HOWARD

ROUTE

MODOT

RECORD #

DISTRICT: CD

LANES

DIRECTION OF TRAFFIC

**NOTE: Vertical clearances for permitting purposes are taken as 2 inches less than the actual field measured clearance.

CLASS: STATBR

RIGHT LATERAL CLEARANCE

FED-ID: 5794

LEFT LATERAL CLEARANCE

BRIDGE: K0382

UR-ID

12882 KCS RR 8 FT 6 IN **VERTICAL CLEARANCE TYPE** VALUE DIRECTION DATE COMMENT** 22 FT 6 IN **PLANNED** ***STRUCTURE PAINT INFORMATION*** **CONDITION: RUST AMOUNT:** STEEL TONS: 0 **ORIGINAL PAINT CONTRACT REPAINT DEPARTMENT REPAINT PAINT TYPE: PAINT TYPE: PAINT TYPE: MANUFACTURE:** NAME: NAME: NAME: **SURFACE PREP: PAINT COLOR: PAINT COLOR: PAINT COLOR: PAINT YEAR: PAINT YEAR: PAINT YEAR:** MILS: MILS: MILS: ***REQUESTED WORK ITEMS*** **GENERAL WORK COMMENTS: LOCATION DATE** RESPONSIBILITY **ITEM CATEGORY PRIORITY WORK ITEM COMMENT** FILL HOLES **SLOPE** DISTRICT ROUTINE SLOPE 09/30/2009 (BOWDEJ1, 02/11/2010)--LARGE WASHOUT N.E. CORNER @ ABUT 6 (NO PILE EXPOSED) 2 2 DISTRICT ROUTINE SLOPE **CUT BRSH&TREES SPAYVINES** SLOPE 10/05/2015 **DECK** 3 08/17/2024 DISTRICT SPECIAL ROADWAY SURFACE SEAL DECK WITH IN DECK ***UTILITY ATTACHMENTS*** **UTILITY OWNER METHOD MEASUREMENT TYPE** UTILITY ATTACHMENT COMMENT **VALUE NUMBER** ***PROGRAM NOTES INFORMATION*** PROJECT# **MONTH LET** YEAR LET **ITEMS COMMENT YEAR**



April 29, 2025 1:35:49PM

COUNTY: HOWARD DISTRICT: CD CLASS: STATBR FED-ID: 5794 BRIDGE: K0382

COUNTY: HC	JWAKD DISTRICT: CD	CLASS: STATER	FED-ID: 3/94	DKIDGE: KU302		
CON	MPUTER GENERATED RATINGS AND D	EFICIENCY ITEMS		***ADVANCED SI	GN INFORMATION*	**
NOTE: The items listed in this section a	re updated whenever computer edits are ran on a structu	are after the inspection updates have been entered in to TMS.	SIGN #	SIGN TYPE	PROBLEM	PROBLEM DIRECTION
Rated Item	<u>Rating</u>	Rating Date	1			
[Item 67] Structure Evaluation Rating:	4-MEETS MINIMUM TOLERABLE	6/7/2023				
[Item 68] Deck Geometry Rating:	5-BETTER THAN MINIMUM	7/22/2019				
[Item 69] Underclearance:	4-MEETS MINIMUM TOLERABLE	2/20/2003				
Sufficiency Rating:	56.1%	1/16/2025				
Deficiency:	STRUCTURAL	6/7/2023				
Funding Eligibility:				***OUTFALL INSPEC	CTION INFORMATIO	N***
Estimated New Structure Length:			" ONE TO 1	Diche	COROR	
Estimated Structure Cost:			# OUTFALLS:	INSPE	ECTOR:	
Estimated Total Project Cost:			STATUS:		DATE:	
Year of Cost Estimate:			NOTES:			
generalized to use NBI items to come up v	ost estimates are computer generated using algorithms in with a new structure length and width to calculate a new cost may vary significantly from these numbers once sit	area which is taken times a representative cost per				



April 29, 2025 1:35:49PM

COUNTY: HOWARD DISTRICT: CD CLASS: STATBR FED-ID: 5794 BRIDGE: K0382

 $Design_No = k0382$





Missouri Department of Transportation Bridge Inventory and Inspection System Structural Inventory & Appraisal Sheet

COUNTY: HOWARD K0382 R REVIEW STATUS: APPROVED T **BRIDGE:** NBI STATUS: 4/18/2025 2025 ROUTE CARRIED 'ON' STRUCT **RECORD TYPE:** RUN DATE: **SUBMITTAL YEAR:** GENERAL STRUCTURE INFORMATION ROUTE DESIGNATION INFORMATION ROUTE CARRIED 'ON' STRUCT State MISSOURI 5A Record Type MO District 5B CD Route Signing Prefix **BUSINESS** HOWARD County 5C Designated Level of Service 00240 5794 8 Federal ID No. 5D Route Number 1934 NOT APPLICABLE 27 Year Built 5E Directional Suffix BU 240 E 106 0 7 Year Reconstructed Facility Carried NO HIGHWAY Type of Service On 12 Base Hwv. Network STATE HIGHWAY AGENCY 21 Structure Maintenance 13A LRS Inventory Route No. STATE HIGHWAY AGENCY 22 Structure Owner 13B Subroute No. 33 NO MEDIAN ON FREE ROAD Br. Median Code 20 Toll Status 09-RURAL LOCAL 37 Historical Significance NOT ELIGIBLE FOR NR OF HP 26 Functional Classification NONE EXISTS 02 101 28A Parallel Struc Desg Lanes on Structure NOT TEMPORARY Temporary Structure 103 RTE NOT A DEFENSE HWY 100 STRAHNET Designation NBIS Bridge Length YES NOT ON NHS 104 National Highway System NOT APPLICABLE 105 Federal Lands Highway NO 110 Designated Nat. Network STRUCTURE LOCATION INFORMATION STRUCTURE TRAFFIC INFORMATION 705 4 Place **CHARITON** 29 AADT 13222 2024 Code 30 AADT Year 2-WAY TRAFFIC S 11 T 51 N R 17 W Location 102 Direction of Traffic 11 Milepoint 3.52 miles 6% 109 AADT Truck Percent 16 Latitude 39 D 14 M 5 S 881 114 Future AADT 17 Longitude 92 D 47 M 44 S 2044 115 Future AADT Year UNDERRECORD INFORMATION STRUCTURE GEOMETRIC INFORMATION 10 99 Ft. 99 In. Features Intersected KCS RR Inventory Rte. Vert. Clear 42B 19 21.88 miles Type of Service Under RAILROAD By pass Detour Length 28B Lanes Under Structure 00 32 Approach Roadway Width 21 Ft. 12 In. RAIL ROAD 45.00 Degrees 54A Vert. Clearance Ref. 34 Skew 54B Vert. Clearance 35 Struct. Flared 22 Ft. 6 In. Rt. Lat Clear Ref. RAIL ROAD Total Horiz. Clear 26 Ft. 3 In. 55A 47 55B Rt. Lat Clearance 8 Ft. 6 In. 48 47 Ft. 7 In. Maximum Span Length 198 Ft. 2 In. 0 Ft. 0 In. Left Lat Clearance 49 Structure Length N/A Navigation Control 50A 0 Ft. 0 In. Left Curb/Sidewalk Width Nav Vertical Clear 0 Ft. 0 In. 39 50B Right Curb/Sidewalk Width 0 Ft. 0 In. 0 Ft. 0 In. Curb to Curb Br. Width 26 Ft. 3 In. 40 Nav Horizontal Clear 51 26 Ft. 11 In. Nav. Pier Protection Deck Width (Out-Out) 111 52 99 Ft. 99 In. Nav. Cl. Vert. Clear 53 Vert.Clearance Over Deck





Missouri Department of Transportation Bridge Inventory and Inspection System Structural Inventory & Appraisal Sheet

COUNTY: HOWARD BRIDGE: K0382 R REVIEW STATUS: APPROVED NBI STATUS: T

RECORD TYPE: ROUTE CARRIED 'ON' STRUCT RUN DATE: 4/18/2025 SUBMITTAL YEAR: 2025

RECORD TYPE: ROUTE CARRIED ON STRUCT	RUN DATE: 4/10/2025 SUBMITTAL TEAR: 2025
LOAD RATING AND POSTING INFORMATION	MATERIAL/CONSTRUCTION INFORMATION
31 Design Load	43A Main Struc. Mat type CONCRETE 43B Main struc Constr. Type TEE BEAM 45 # of Main Spans 5 44A Appr Struc. Mat type 000 44B Appr Struc. Cnstr. type 000 46 # of Approach Span 0 107 Deck Mat/Constr. 1 CONCRETE CIP 108A Wear Surf Mat/Constr. 6 BITUMINOUS
Sufficiency Rating 56.1 Percent Deficiency Rating STRUCTURAL	108B Membrane Mat/Constr. 0 NONE 108C Deck Protect Mat/Constr. 0 NONE
Funding Eligibility PARTIAL 75A Proposed Work REHAB-GENERAL DETERIORAT 75B Work Done By Contract 76 New Struc Length 232 Ft. 11 In. 94 Struc Improve Cost \$ 776,000 95 Roadway Improve Cost \$ 78,000	CONDITION RATING INFORMATION 58 Deck Cond. Rating 4 59 Superstructure Cond. Rating 4 60 Substructure Cond. Rating 5 61 Channel /Channel Protection Cond. Rating N 62 Culvert Cond. Rating N
96 Total Project Cost \$ 1,164,000 97 Year of Cost Estimates 2025	INSPECTION INFORMATION
APPRAISAL RATING INFORMATION 36A Br. Rail App. Rating MEETS ACCEPTBLE STND 36B Transition Rail App. Rating MEETS ACCEPTBLE STND 36C Approach Rail App. Rating MEETS ACCEPTBLE STND 36D Rail End Treat. App. Rating DOES NOT MEET ACCEPT STND 67 Struc Eval App. Rating 4 68 Deck Geometry App. Rating 5 69 Underclearance App. Rating 4 71 Waterway Adeq. App. Rating N 72 Approach Road App. Rating 5 113 Scour Assess App. Rating N	90 Gen. Insp Date 6 / 23 91 Gen. Insp. Frequency 24 Months 92A Frac. Critical Inspection N Months 93A Frac. Critical Insp. Date 92B Underwater Inspection N Months 93B Underwater Insp. Date 92C Special Inspection N Months 93C Special Inspection N Months 93C Special Inspection Date BORDER BRIDGE INFORMATION 98 Neighboring State Code 98B Neighboring State % Respon 99 Neighboring State Struc. No.
APPROVED POSTING INFORMATION	FIELD POSTING INFORMATION
Approved Posting Category S-1 Ton1 Ton2 Ton3 Tonnage Values for Posting Sign General Text for Posting Sign NO POSTING REQUIRED	Field Posting Category S-1 Ton1 Ton2 Ton3 Tonnage Values for Posting Sign General Text for Posting Sign NO POSTING REQUIRED

Design_No = k0382

K0382R	Route/County: Bus 240/Haward
Asbestos-Containing Yes: If yes, see report	No:
Structural Ste Yes:	eel Present? No: If No, then skip the following.
Lead-Based Paint Yes:	: (LBP) Present? No:
Trusses LBP? Yes: No:	Girder LBP? Yes: No:
Railing LBP? Yes: No: X	Pile LBP? Yes: No:

Galvani 2ed

MEMORANDUM



Missouri Department of Transportation Construction and Materials Central Laboratory

TO: TMS

FROM: Diane Roegge

Environmental Chemist

DATE: January 25, 2016

SUBJECT: Materials

Asbestos Inspection & Heavy Metal Paint Survey

Route Bus 240 Bridge K-0382R Howard County

We are providing you with the results of the inspection on the above referenced bridge. The inspection report contains an asbestos and a heavy metals survey. The asbestos inspection included identifying suspect asbestos-containing material and NVLAP accredited testing to confirm the presence of asbestos.

Form T746 – This will show if samples were taken, where from, and, if the sample was found to contain asbestos, our estimated quantity of material present. Under the column "Friability Category", this is the meaning for the following:

N-ACM – No asbestos detected.

I NF – Asbestos is present. Material shall be handled carefully by a licensed abatement worker and kept wet if removing as part of a maintenance activity.

II NF – Asbestos is present. If removal is required for the maintenance activity, use an abatement contractor.

In accordance with Missouri Department of Natural Resources' Technical Bulletin "Managing Construction and Demolition Waste" dated January 31, 2003, a heavy metal paint survey has been performed on the above referenced bridge. This survey includes locating concrete which has been painted with something other than traffic paint or graffiti, and testing the painted surface(s) to determine if hazardous heavy metals are present. If the bridge is being removed completely, or the maintenance repairs include removing the painted concrete, then, non-hazardous painted concrete may be used as clean fill materials, if properly handled. You must contact the Central Office Design Division for proper handling of the reported painted surfaces.

Although our survey included observing and sampling all accessible areas, it is possible that potentially hidden asbestos-containing materials may exist within the structure. Should you have any questions regarding these reports, please contact me at (573) 526-4359.

db/fr/dr

 $http://sp/sites/cm/chemicallab/environmental/shared\ documents/asbestos/districts/central\ (cd)/mt/k0382r/dr1601253.docx$

Attachments

MISSOURI DEPARTMENT OF TRANSPORTATION CONSTRUCTION AND MATERIALS **Asbestos Survey Report**

All Suspect ACM

PARCEL NO.: DATE OF SURVEY: COUNTY: DISTRICT: MODOT JOB NO.: ROUTE: September 10, 2010 J2S2195 Bus 240 Bridge K-0382R Howard

CERTIFICATION #: CERTIFICATION #: SURVEYED BY:

Frank Reichart and Diane Roegge

Over KCS RR (Gateway Western RR), 1.4 miles West of Rt 5 7028011210MOIR7165, D.R.

(2.2 miles West of Steinmetz)

TYPE(S) OF STRUCTURE(S): Bridge

SITE ADDRESS:

MISSOURI DEPARTMENT OF TRANSPORTATION CONSTRUCTION AND MATERIALS

Asbestos Survey Report

Nonfriable Asbestos-Containing Materials (Abatement not required if not made friable during demolition.)

											Sample ID Type of Material	bildge N-0362K	PARCEL NO. September 13, 2010	27		MODOT JOB NO.: J2S2195		
										No	Aaterial		010					
										None Located	Location of Material	TYPE(S) OF STRUCTURE(S):		SITE ADDRESS:	CERTIFICATION #:	CERTIFICATION #:	TESTED BY:	
												Bridge	(2.2 miles W	Over KCS R	7028011210	7028011210	Frank Reichart and Diane Roegoe	
										INF	Friability Category		(2.2 miles West of Steinmetz)	R (Gateway V	7028011210MOIR7165, D.R.	7028011210MOIR11239, F.R.	and Diane	3
											Field Measure		etz)	Over KCS RR (Gateway Western RR), 1.4 miles West of Rt 5	J.R.	F.R.	Roegge D	3
											Asbestos Type			1.4 miles West			1	
											Percen			of Rt 5				

All necessary work to handle this material is the contractor's responsibility.

MISSOURI DEPARTMENT OF TRANSPORTATION CONSTRUCTION AND MATERIALS Asbestos Survey Report

Asbestos Survey Report
All materials requiring removal or special handling.


ROUTE: MODOT JOB NO.: DISTRICT: COUNTY: DATE OF TESTS: PARCEL NO.:		Bus 240 J2S2195 2 Howard September 13, 2010 Bridge K-0382R	TESTED BY: CERTIFICATION #: CERTIFICATION #: SITE ADDRESS: TYPE(S) OF STRUCTURE(S):	Frank Reichart and Diane Roegge 7028011210MOIR11239, F.R. 7028011210MOIR7165, D.R. Over KCS RR (Gateway Western R (2.2 miles West of Steinmetz) Bridge	and Diane OIR11239 OIR7165, (Gateway t of Steinn	Frank Reichart and Diane Roegge 7028011210MOIR11239, F.R. 7028011210MOIR7165, D.R. Over KCS RR (Gateway Western RR), 1.4 miles West of Rt 5 (2.2 miles West of Steinmetz) Bridge	.4 miles West	of Rt 5
PARCEL NO.:	848 77	idge K-0382R	TYPE(S) OF STRUCTURE(S):	Bridge				
Bid Item No.	Sample ID	Type of Material	Location of Material	Fr	Friability Category	Field Measure	Asbestos Type	Percent
			None Located		ч			
			None Located		II NF			

MISSOURI DEPARTMENT OF TRANSPORTATION CONSTRUCTION AND MATERIALS

Metals Survey Report of Painted Concrete, Block, Brick Surfaces for Clean Fill Purposes

								No	Sample ID			BUXE OF SOUVEY.	DATE OF SUBVEY.	COUNTY:	DISTRICT:	MODOT JOB NO.:	ROUTE:
		OX.						No samples taken. No painted surfaces located.	Color/Location of Material/Substrate			september 10, 2010	Frank Reichart W	Howard	2	J2S2195	Bus 240
							Ī		As			TYPE(S) O		SITE ADDRESS:	PARCEL NO.:	DATE OF TESTS:	TESTER
									Cr			TYPE(S) OF STRUCTURE(S): Bridge		RESS:	O.:	TECTS.	
									Pb			URE(S): Br	(2:	9	Brid	N/A	
									Cd	Id)	Me	idge	(2.2 miles West of Steinmetz)	er KCS RR	Bridge K-0382R	A	
									Se	(ppm)	Metals		t of Steinme	(Gateway W	R		
									Ba				tz)	/estern RR).			
									Hg					Over KCS RR (Gateway Western RR), 1.4 miles West of Rt 5			
									Ag					est of Rt 5			



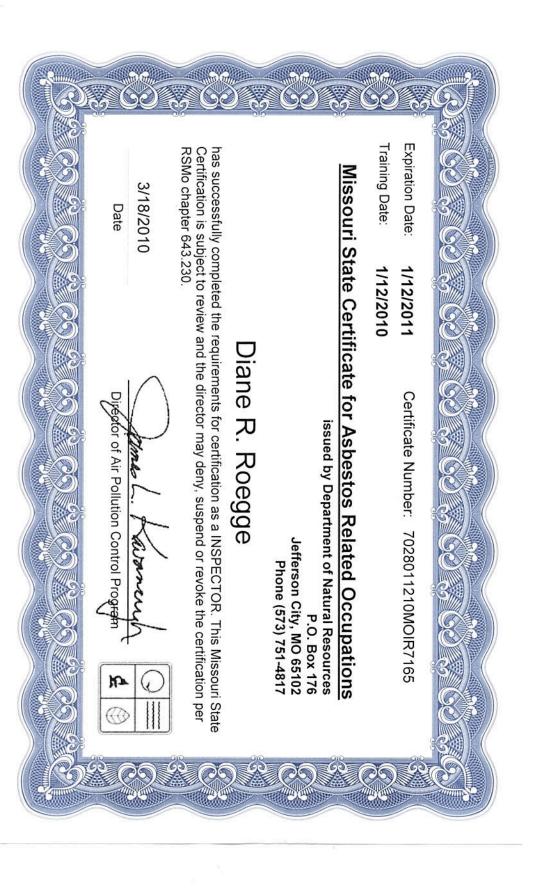



	PILING D	ATA	PER-MINAD STATE PRODUID PERSON SHEET TOOTING
FOOTING NOIL - BENT NO !.	FOOTING NO.3 - BENT NO.1	FOOTING NO.1-BENT 6	FOST IN G NO 3 BENT NO G DIV. NO. COUNTY ROUTS SEC. NO. 5 HOWARD 3 BENT NO G DIV. NO. COUNTY ROUTS SEC. NO. 5 HOWARD 3
			FINAL PLANS
	(2) (4) (4) (5) (4) (1) (1) (1) (1) (1) (1) (1) (1) (1) (1	3 20	
1 2 3 3 5 5 5 5 5 5 5 5 5 5 5 5 5 5 5 5 5	535,6 KM N N 983.0 Phon - Top Eng gets built	S S S S S S S S S S S S S S S S S S S	821.5 S.
20 637 5 Man - 7 m Auths 20 637 5 Man - 7 m Auths 20 6 A 5 Levil Picke - 4/25 23 0 Plan Bellion Ang. 33 1 No Built De Asim Mag.	855.0 R & S & B & Bus a Pau - The fire fats built 8.5 p Pau - Pie builts 23.70 Pie builts - As built 855.0 Rolem fire - Pau	S25.5 Suiton, Pting, Plan S 6.5 Suit	green Pages 1 825 F Gettom Eng. Plan
		Tay Pile from Catoffi Eleo of 328 o to Tip Elev.	Surface Later)
Reg. Lie from to Eigu to Lev 8345 (See Jeffer actes epril 1947) Div Engr. MSH 5. to C EMAXWE!	Cau Pik from III, Jeu to E ev 83:5 (Sec Isler faled April 1, 1947 DIV Ever I'M State Willyway To	Pie No II- 827.9 - 827.925 - 305-201,	
Pile No. 1 - 23:5 - 5 il 5 - 20 or 20 f il 20 or 20	File No. 12 - 2815 - 211.8 ± 19.1720 3.00 (3 - 8250 - 8850 - 194 - 194 - 194 - 1 4 - 8250 - 8850 - 194 - 194 - 194 - 1 5 - 8550 - 8658 - 1925 - 1925 - 194 -	14 6880 808 1 5 1911 1 2613 4 11 7 1 1 1 1 1 1 1 1 1 1 1 1 1 1 1 1 1
2-8315 - \$168 - \$13 - 2 3-8315 - \$10.6 - \$235 - \$2 4-8315 - \$10.6 - \$25 - \$2 5-8310 - \$10.6 - \$25 - \$2 10.1 - \$10.6 - \$2 10.1 - \$2		* Pile No i vised as deview. **Remainder of Pile Cutoff fi Elea 3280	Remaind Cr. Guroff to Elevi Res. 2
Note: File! Cutoff to stay 650.0	C C C C C C C C C C C C C C C C C C C	FOOTING NO 2-BENT NO 6	FOOTING NO.4-BENT NO.6
Pic*3 used as druces Pic*4 used as druces Pic*5 used as druces Pic*5 used as druces Pic*5 used as druces * 9-14 a stell has 3.8* long used to reinflower as cond sprince			3
FCOTINE NO 2- BENT NO.	FOOTING NO.4-BENT NO.1	6 9 10 Stal.	39 SSdL
Ecos	4.C., 19.		
2 6 9	19 28 S S S S S S S S S S S S S S S S S S	878/0: Fils Futura = Prn	92 8 8 829.5 top fing : Plac \$ 92 built
E SESSE SES SES PARAMATES DUILT	233.0 Han tep Afrag & as 20114	Stand Stand Standing Plan Standing Standing Standing	22 25 25 25 25 25 25 25 25 25 25 25 25 2
2800 Pile Pulls Pan 2800 Pile Pulls As South 8290 Bottom Hings Flan	S.M. S. Poet by the Prica Fad of Price but S. A. Boute 229. S. Britan Line Plan	TAM MINE MONTER STREET OF THE	Tau Pike (from Flew \$2.8.0 to Tip Eidit
But File from The Elev. 13 11.6" Sec. Title from The Elev. 13 11.6" (Sec. Titler Refered to a bove.)	Re.1.5 Before the case built. Reg. (Sign from the cleus has been a sour)	Pric No 1 \$23.0 \$67.1 201 pr 20" 7 1 318 p - 503 177 20 3 20 7 8 1 323 p - 508	1 1 1 1 1 1 1 1 1 1
OBJECT ON THE PROPERTY OF THE	Cla No. 18 - 83 5 - 850 2 - 208 or 2.75	0 2150 505 1194 194 194 194 195 1950 1950 1950 1950 1950 1950 1950	Hara Fire Pile VIDS
S S S S S S S S S S	20 8315 \$104 2211 2211 21 3315 803 211 211 22 8315 803 225 225 22 8315 803 225 225	Note: Ries No (6\$7 vised) as driven Remander actriff to Sieu Risco	NOTE: ALL RIVE ASSET OF BELLEN
Note: Pric #6: Curoff to cay from	Walls: Piles No. 12 19 and 20 cot wife	BENT NO FINE NO LINETE PILE	
\$ 1	To Elevi Raise Pile No 21 used as drugen Pile No 21 used as drugen Pile No 22 used fif to Elevi Pile No 22 used fi	4 1/2/2 3 3 1/2/2 4 4 1/2/2 4 4 1/2/2 4 4 1/2/2 4 1/2 4 1/2 4 1/2 4 1/2 4 1/2 4 1/2 4 1/2 4 1/2 4 1/2	THE WAS THE WAS TO SERVICE THE PARTY OF THE
	## ## ## ## ## ## ## ## ## ## ## ## ##	2	Kata
		S/	FINAL PLANS


PLATE 3. CROSS SECTION-O, P. R. & R. E. STANDARD
U.S., LUX, CHICAGO

Ħ

Sheet No.2A of 7.

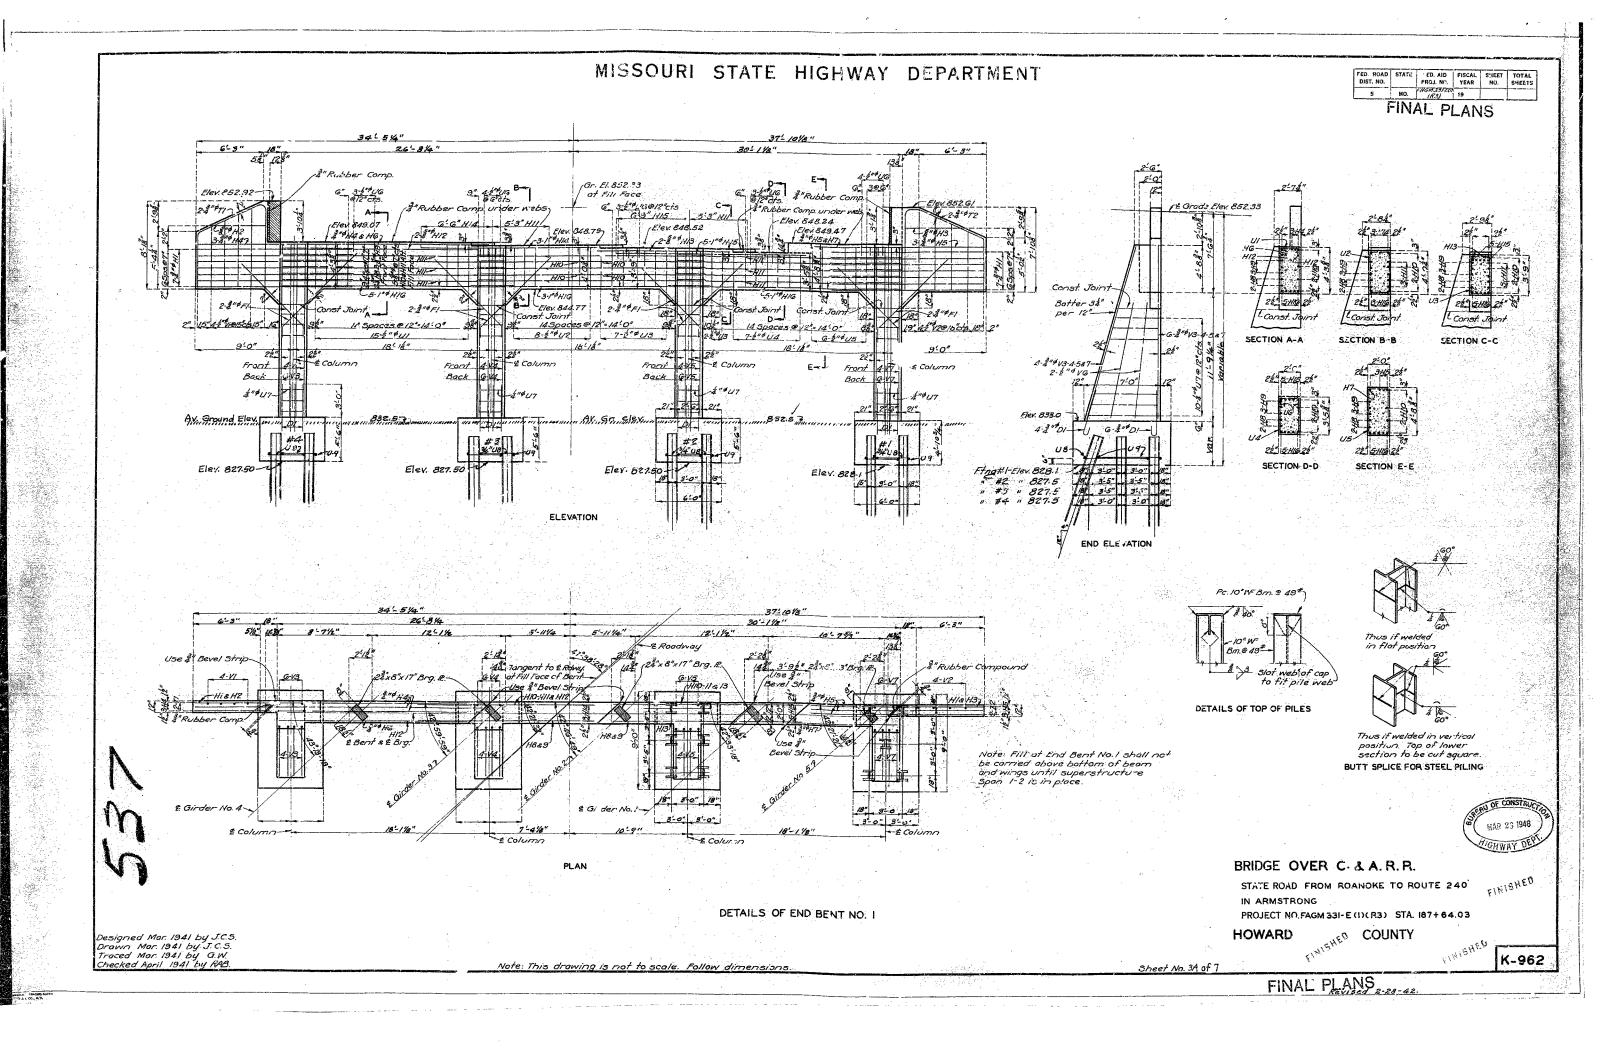

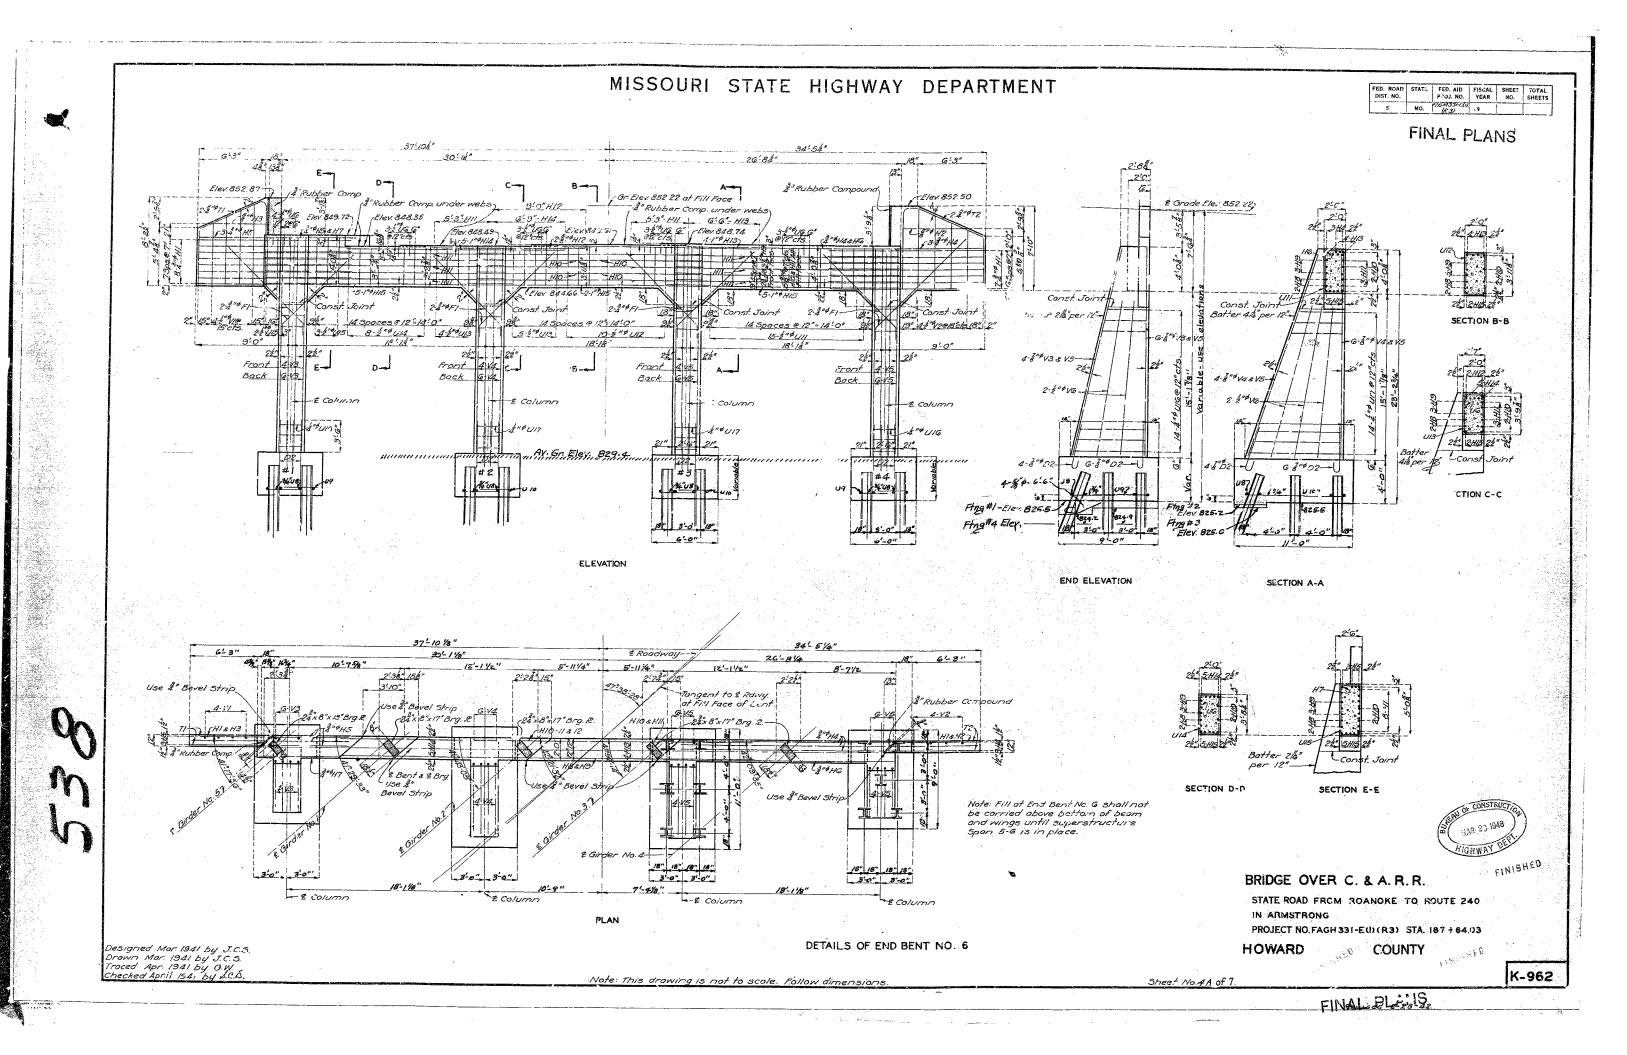

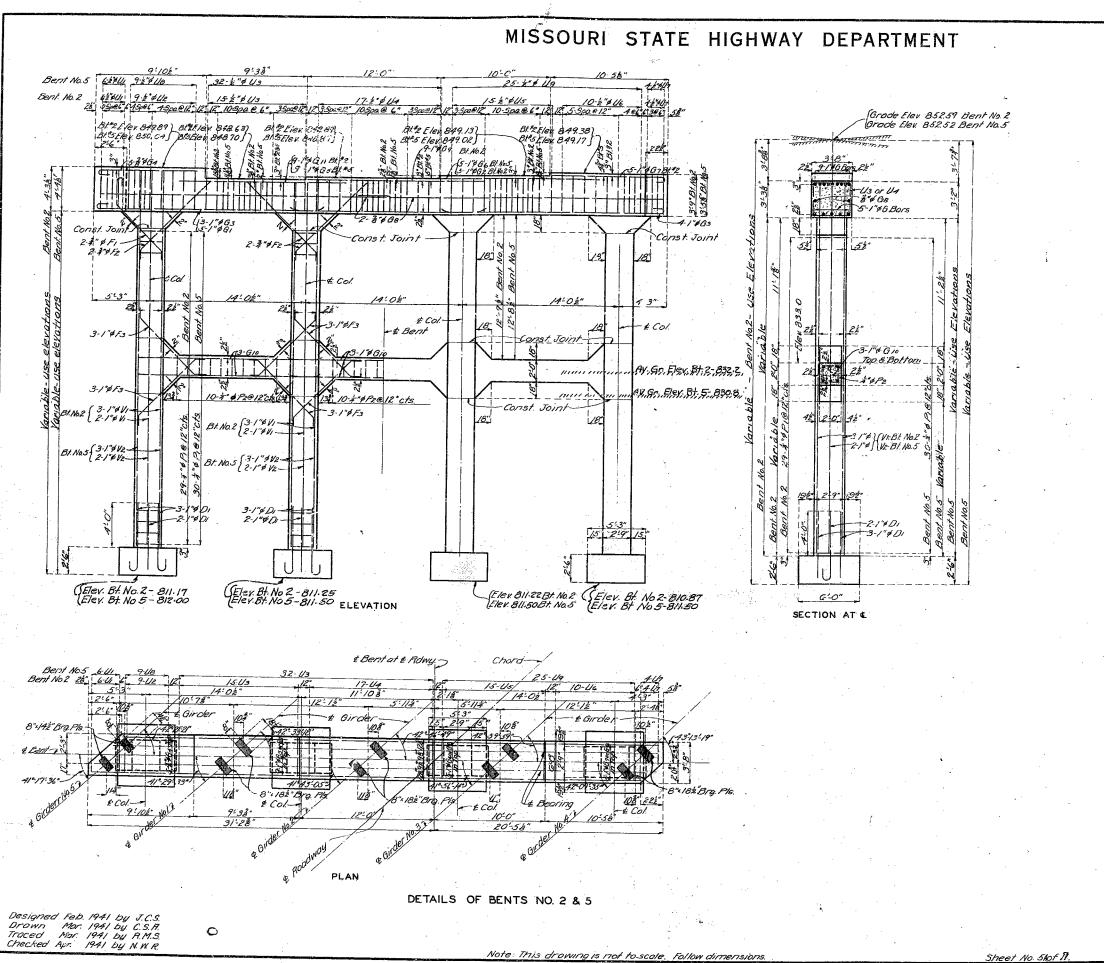

| FED. ROAD | STATE | FED. AID | FISCAL | SHEET | TOTAL | SHEET

FINAL PLANS

FIRISHED

BRIDGE OVER C. & A. R.R.


STATE ROAD FROM ROANOKE TO ROUTE 240


IN ARMSTRONG


PROJECT NO.FAGM 331-E(1) (R3) STA. 187 + 64.03 COUNTY

HOWARD


K-962

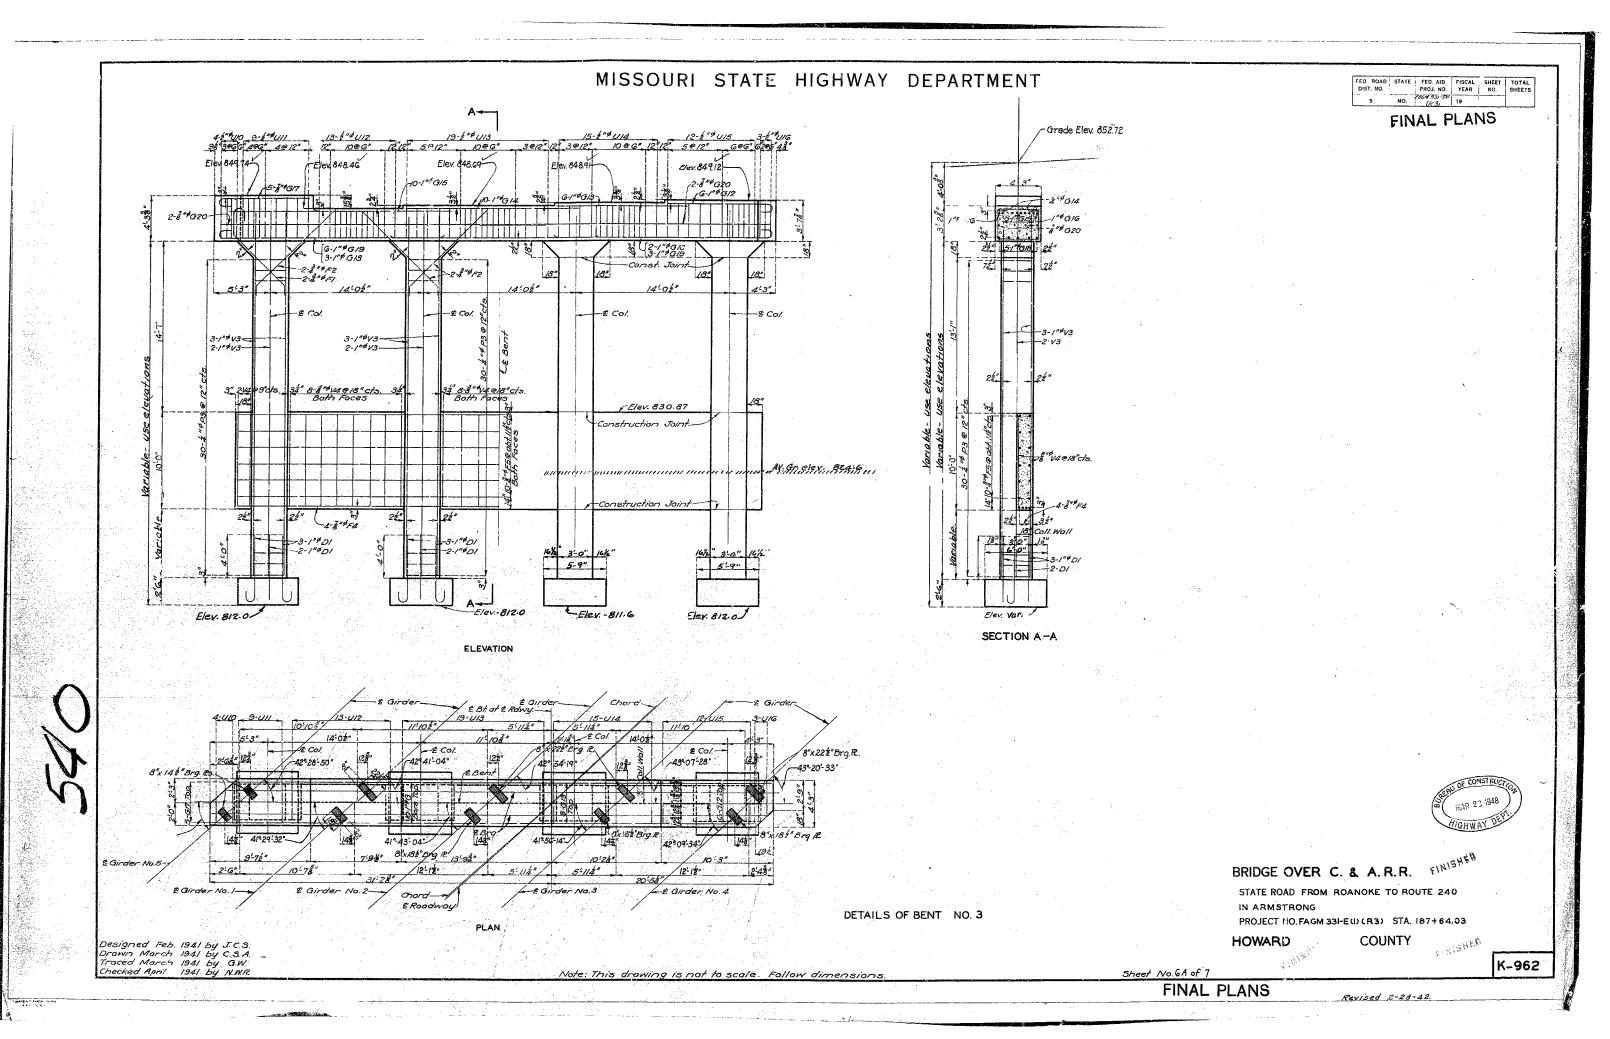

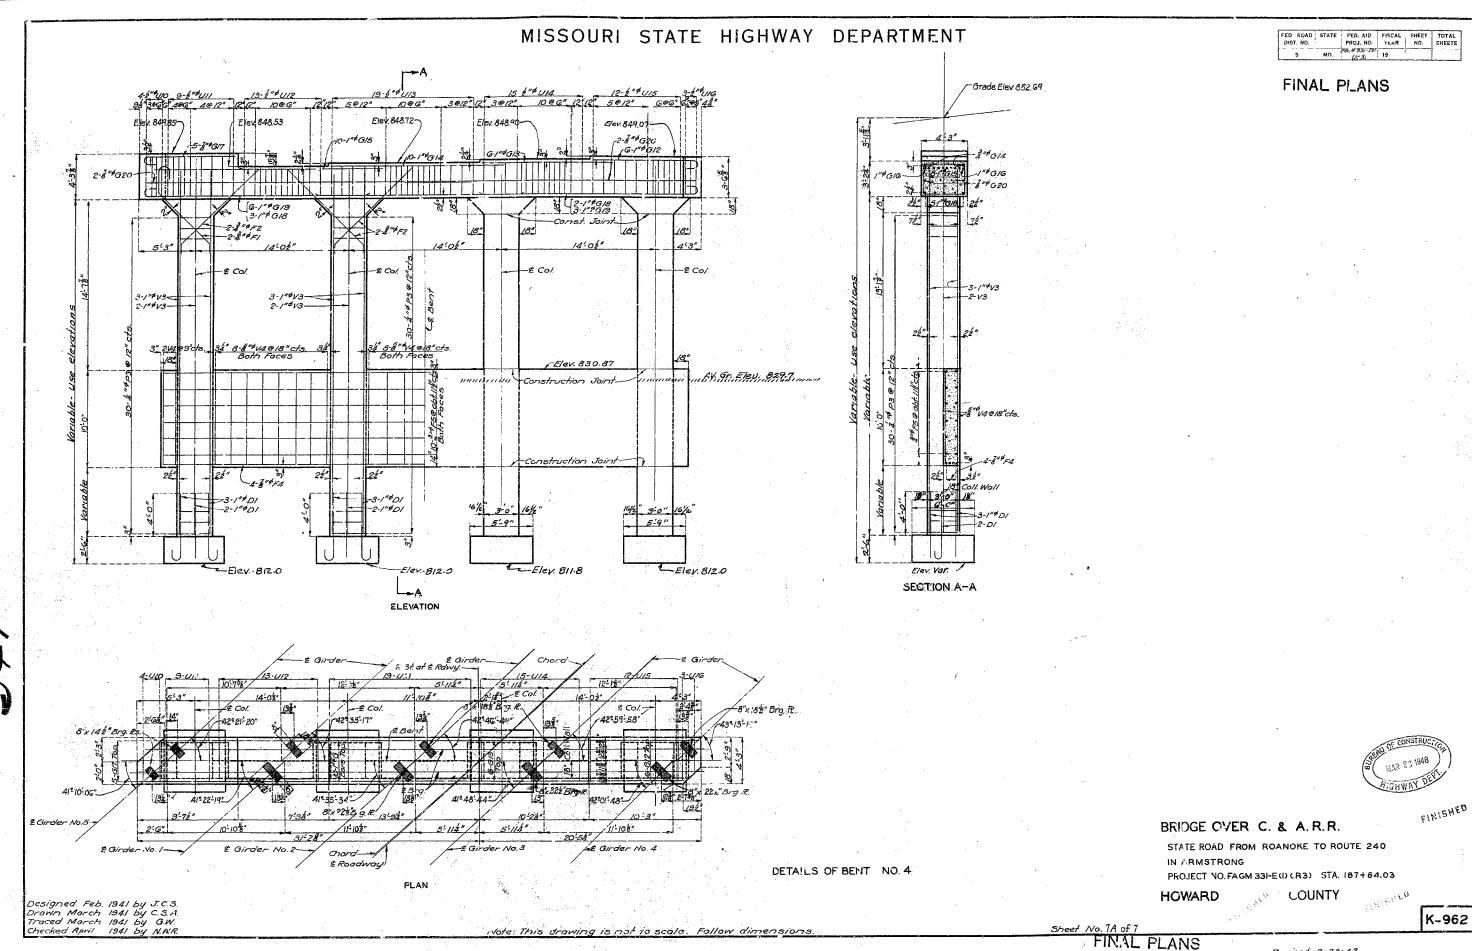


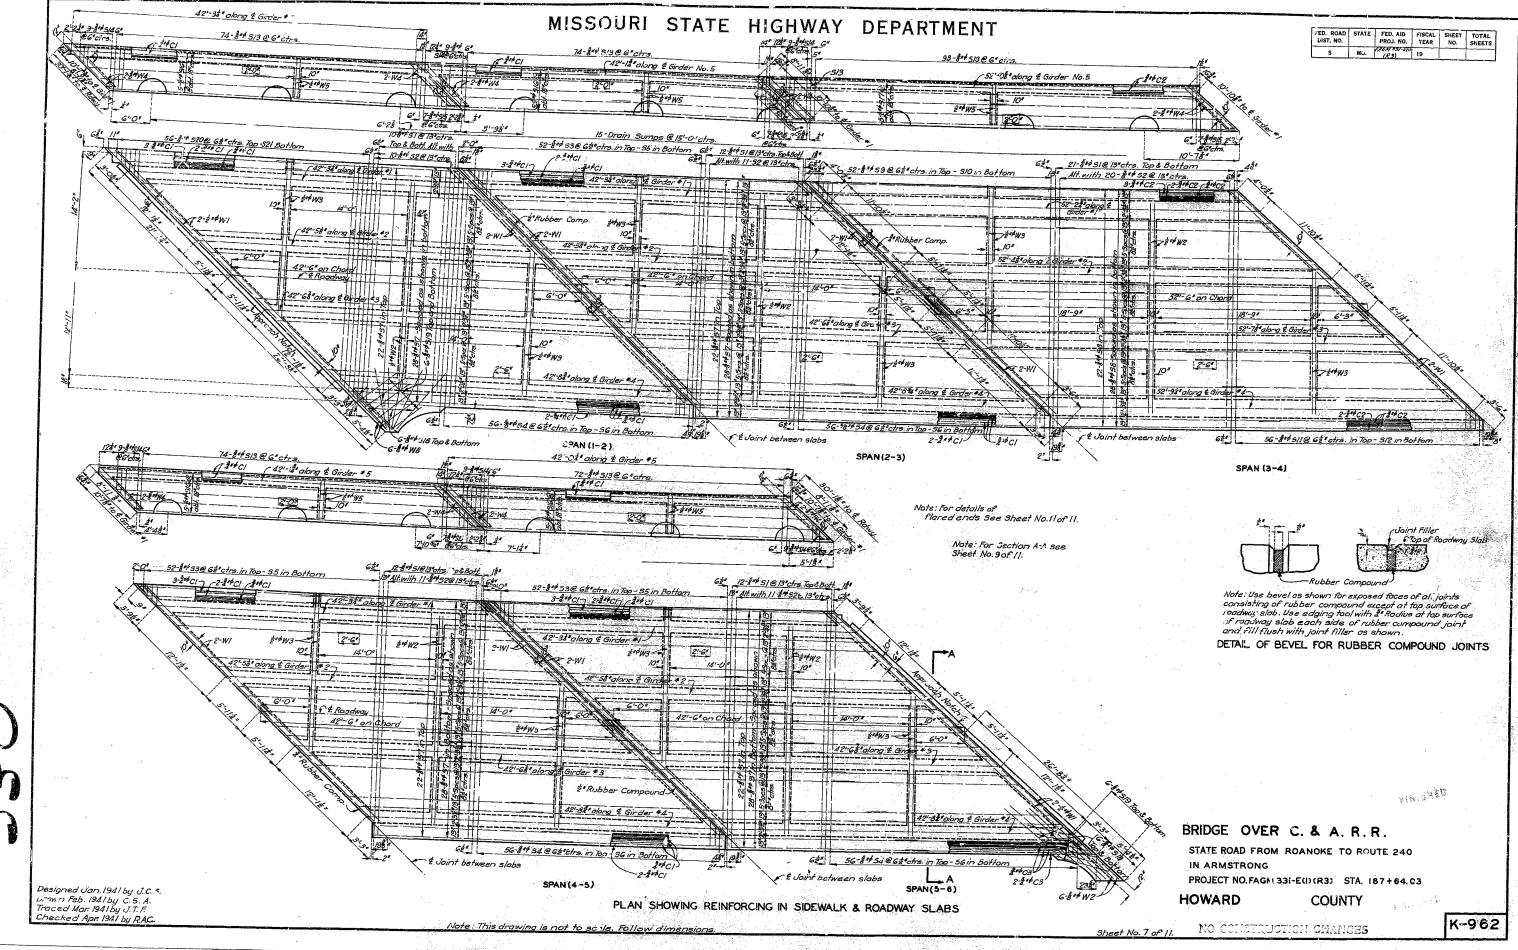


Pevised 2-28-42.

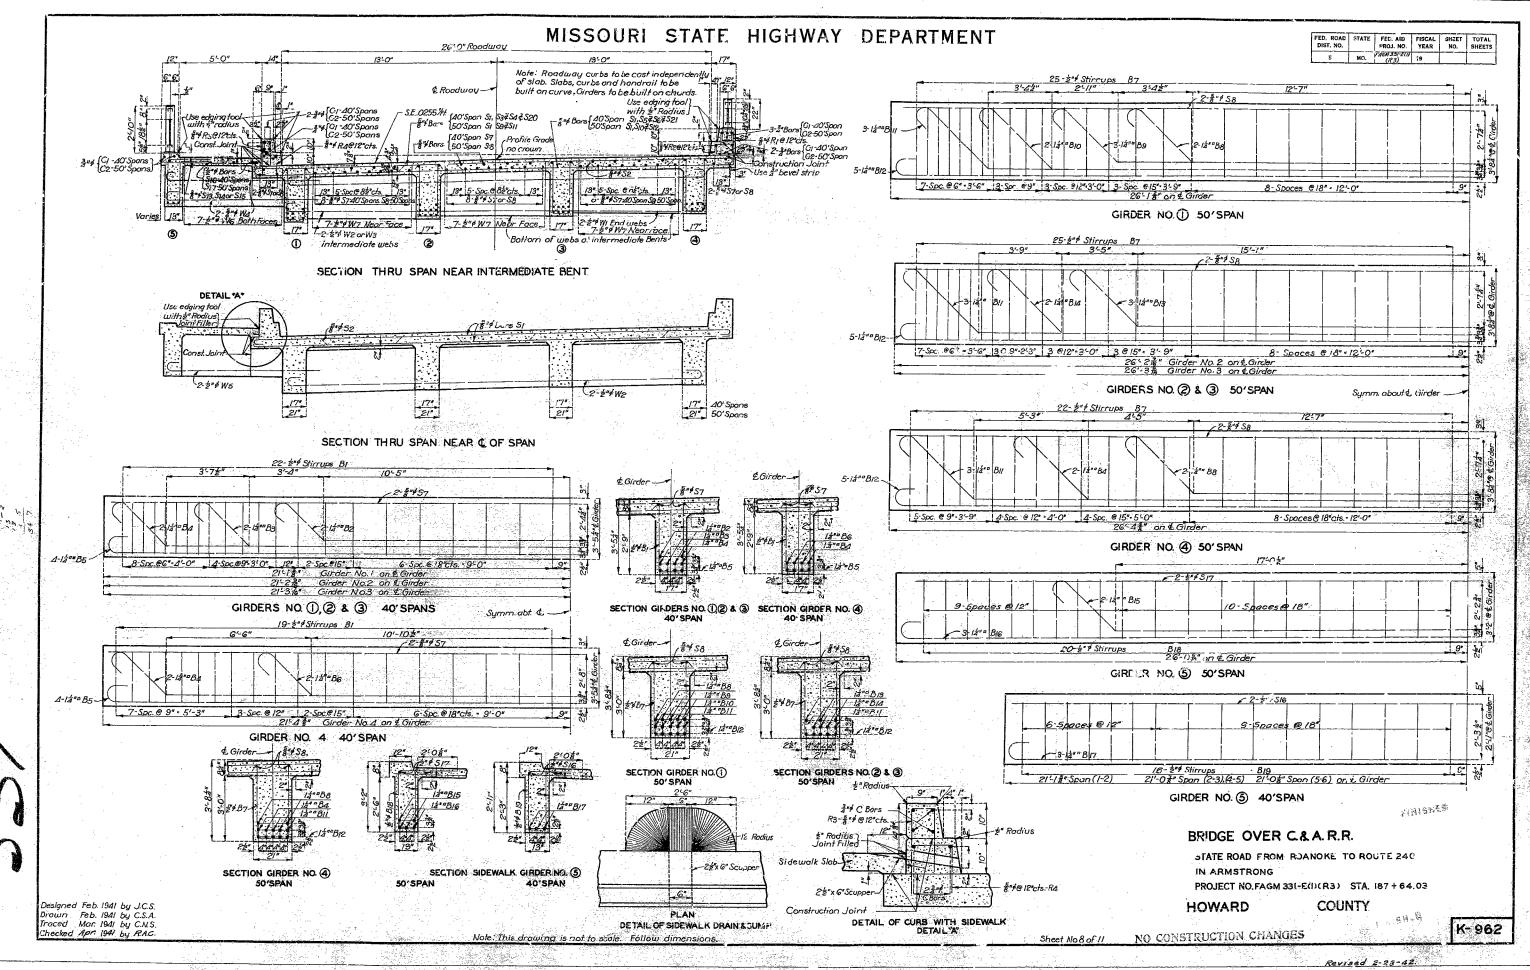


ALAL TRACING CLOTH X S (CO., K.Y.

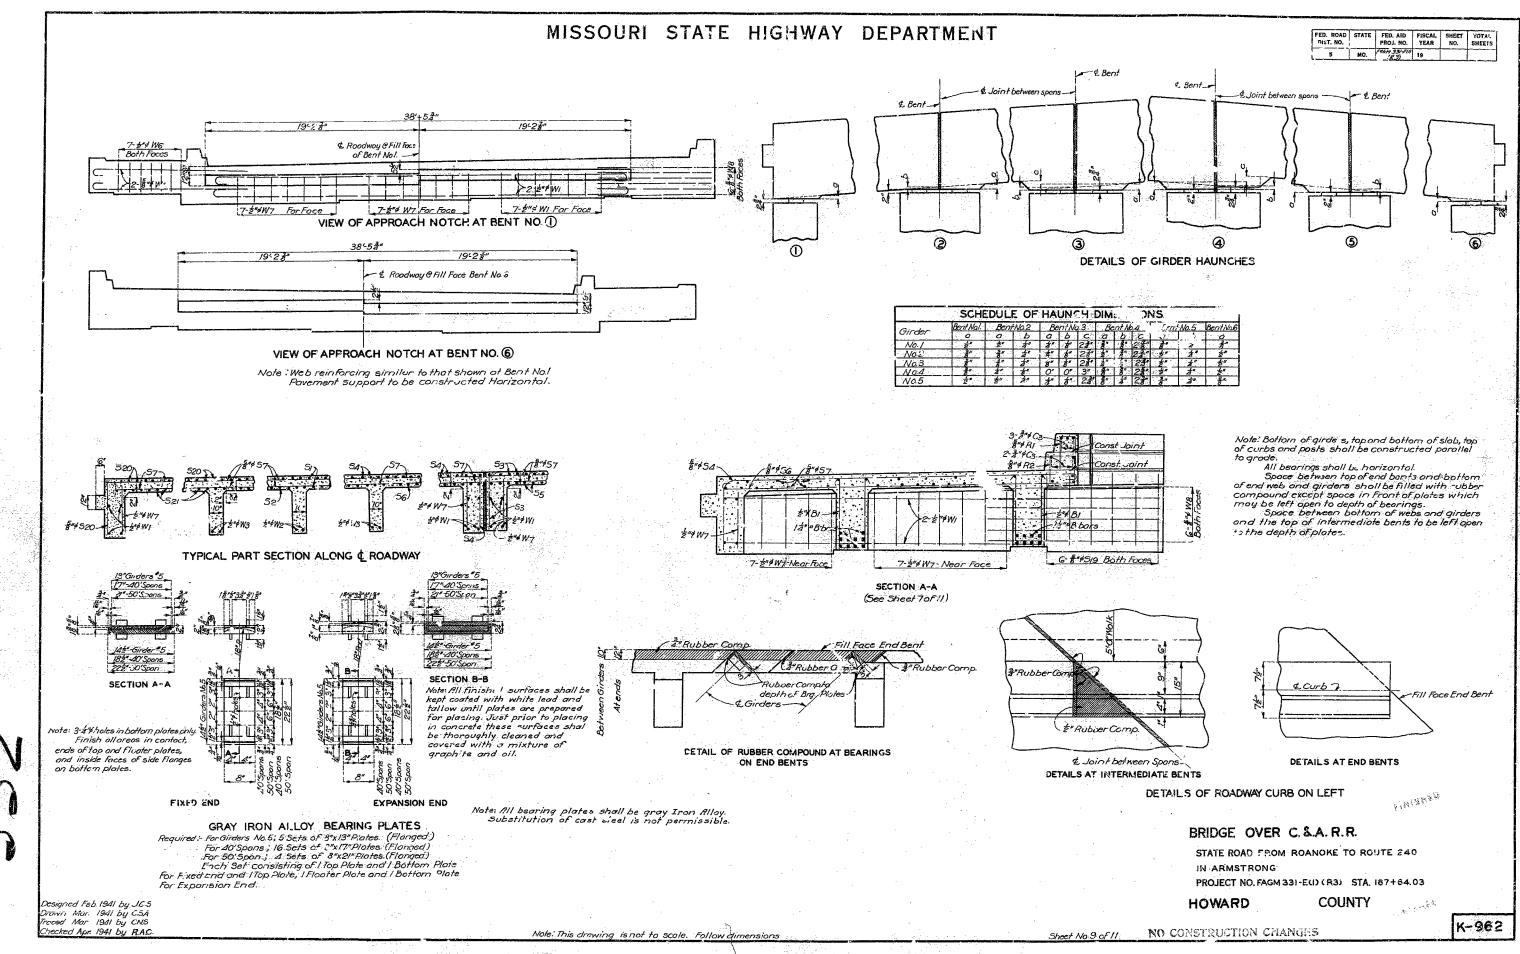



Revised 2-28-42.

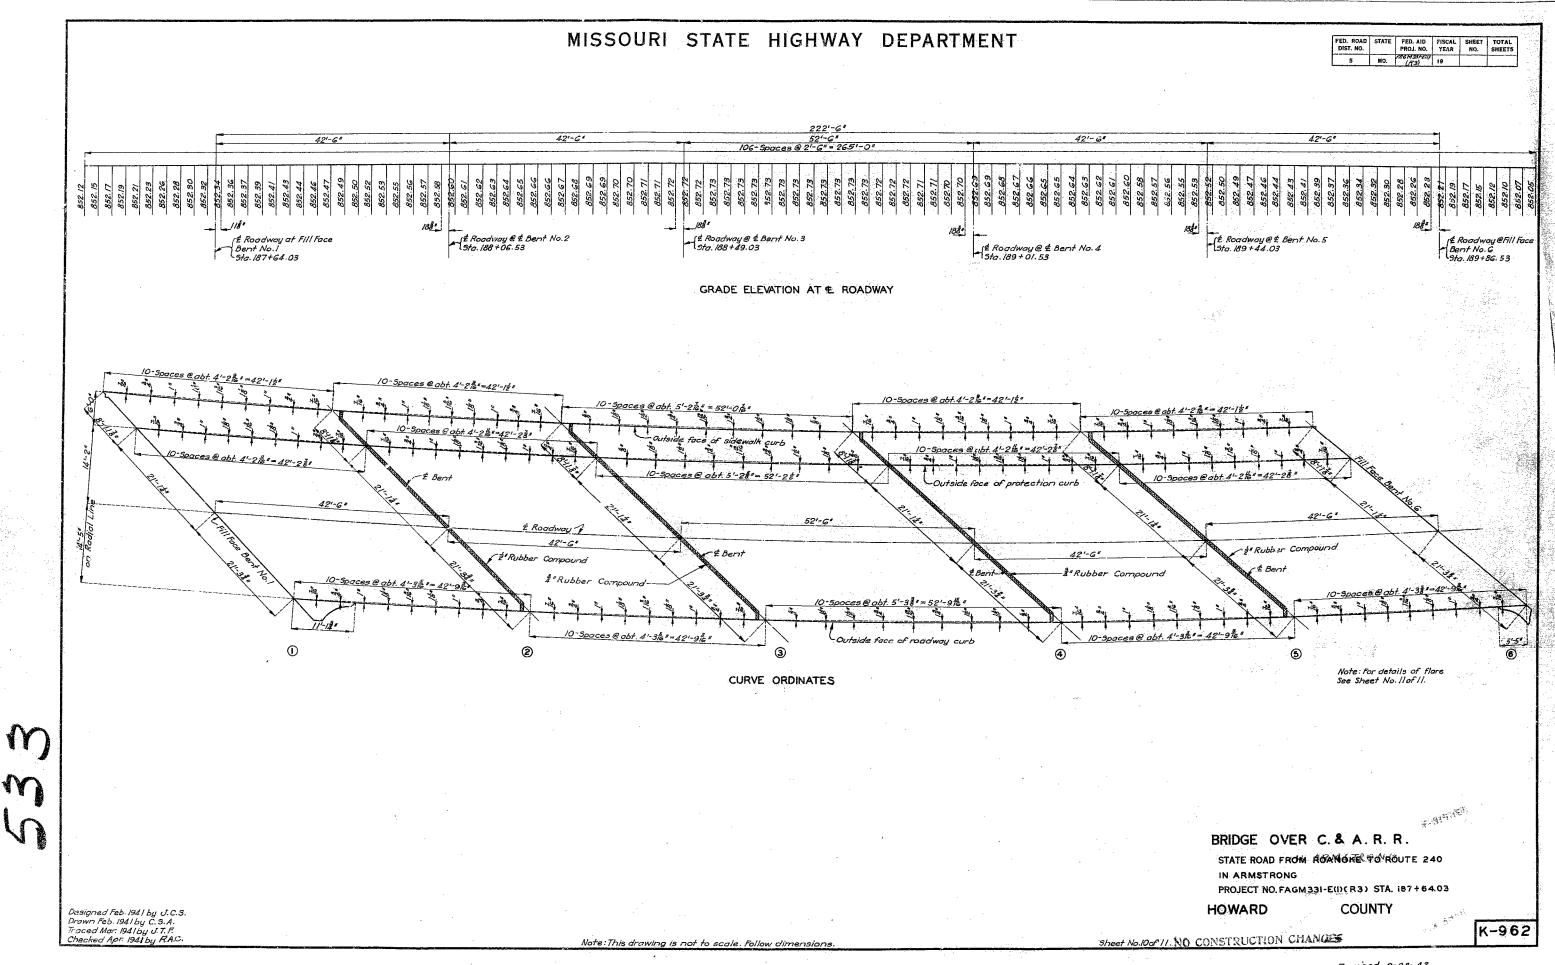

Revised 2-28-42.

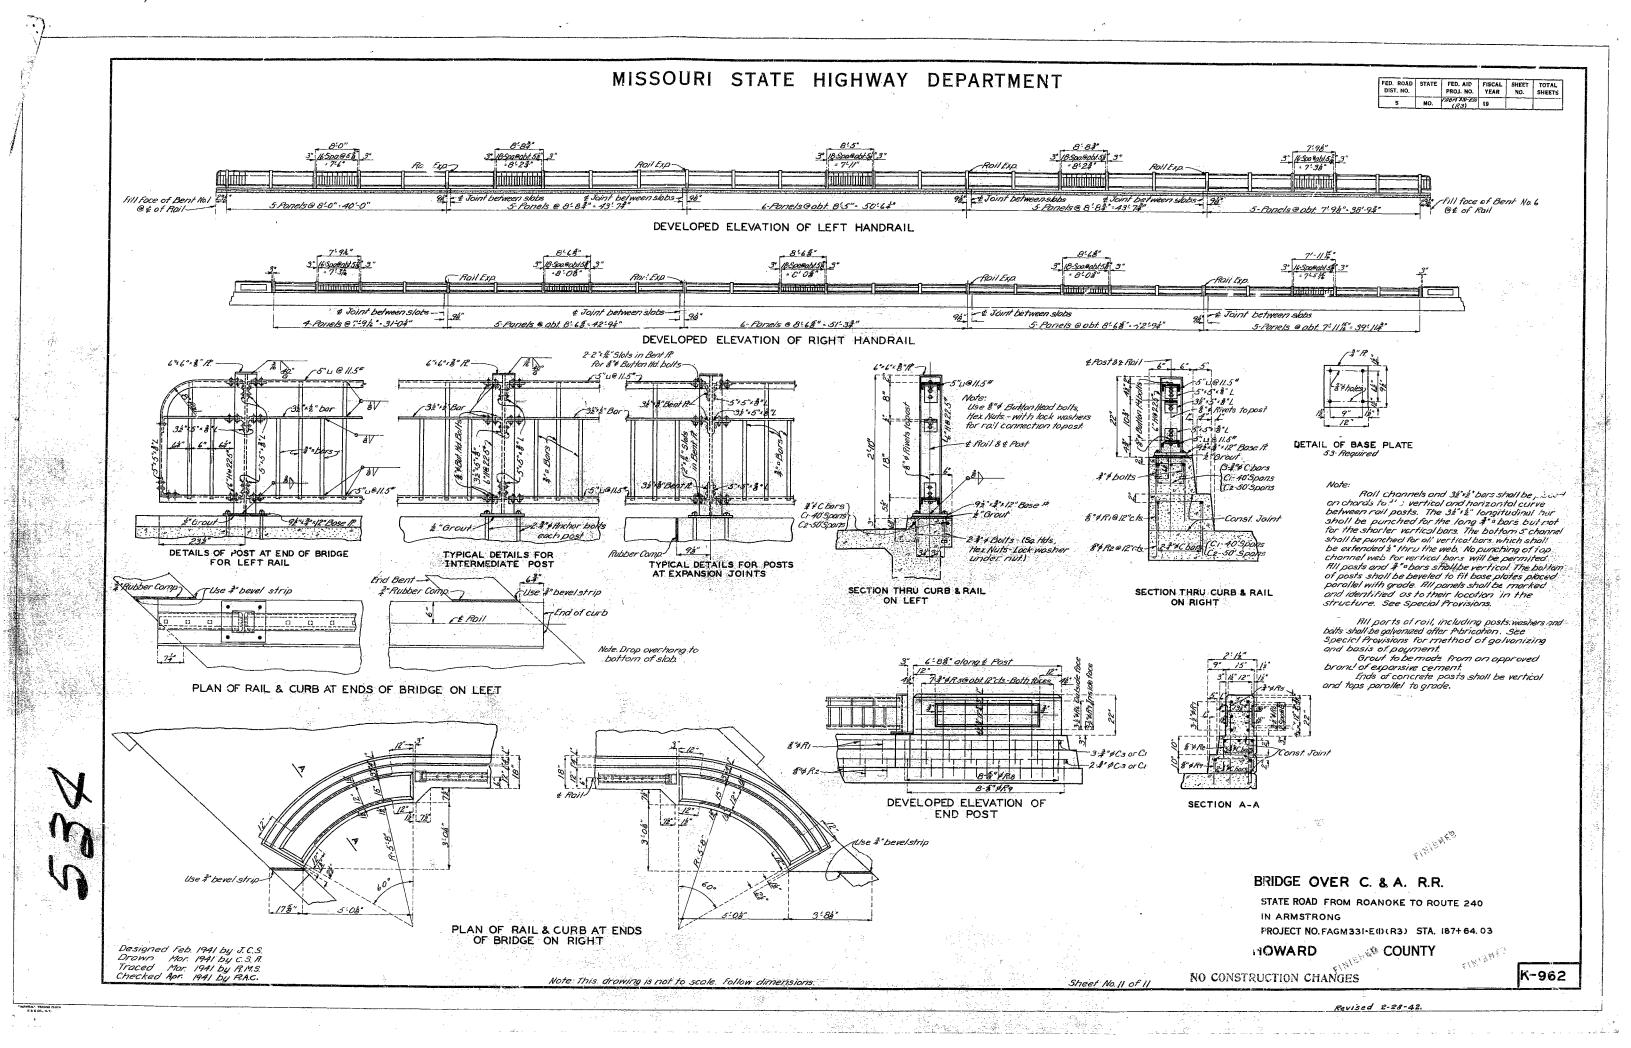

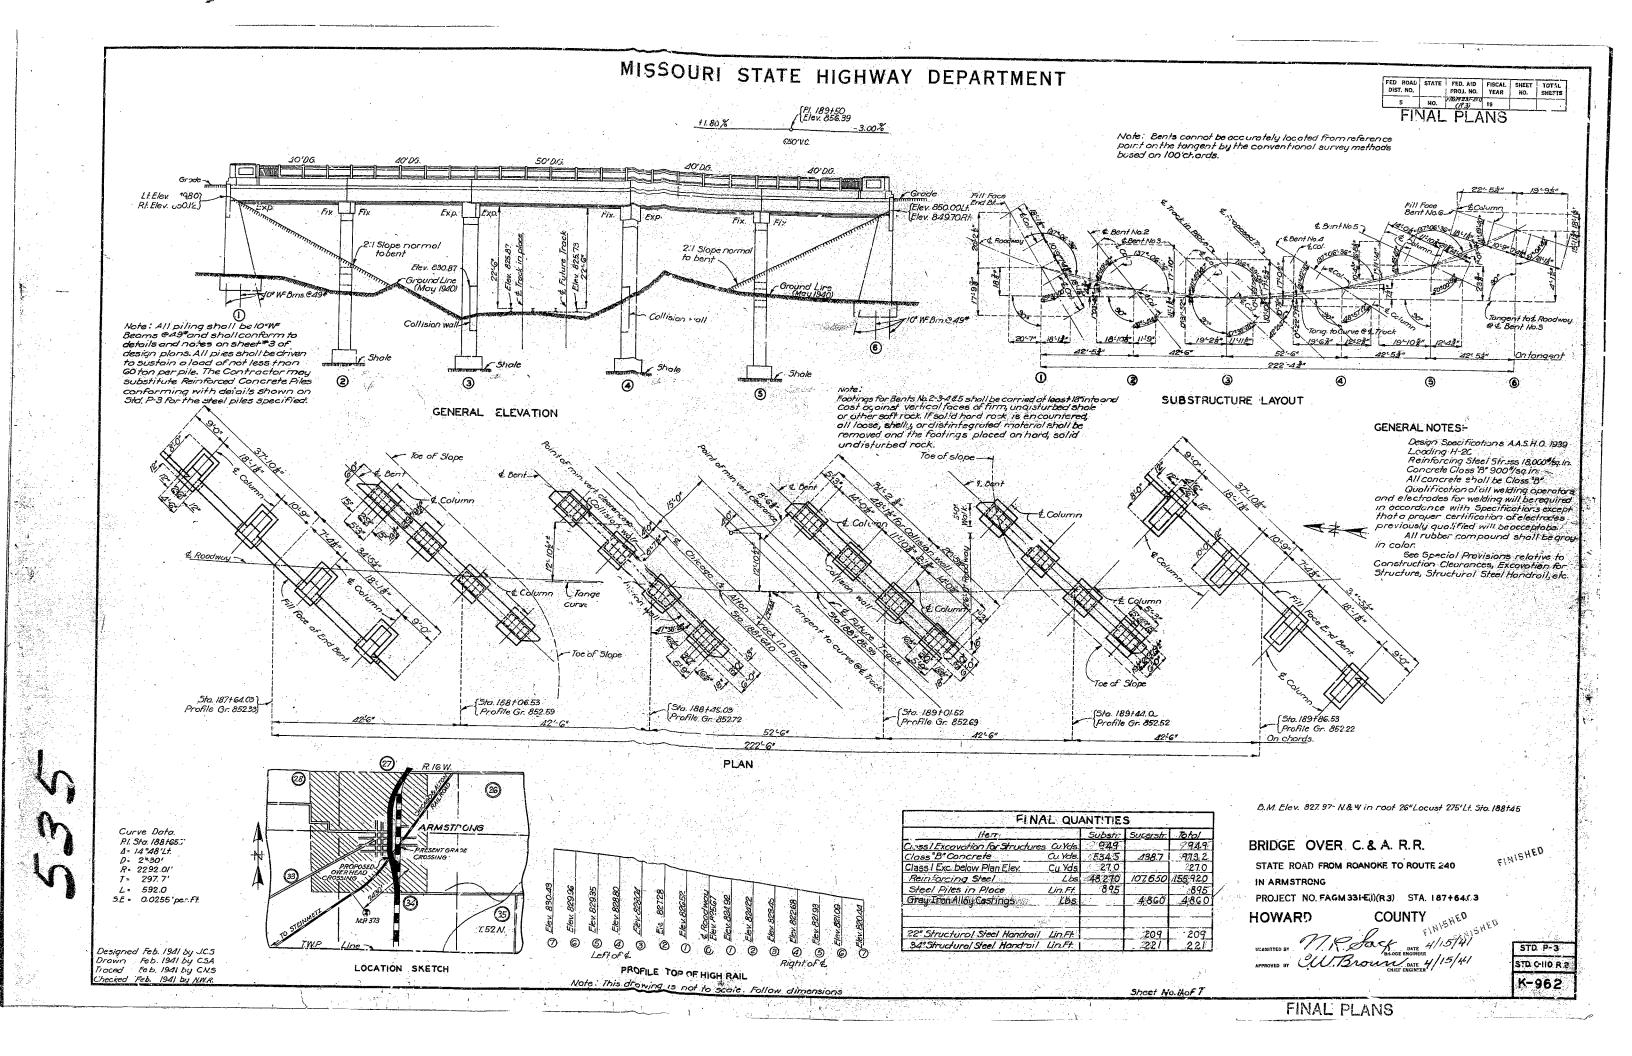

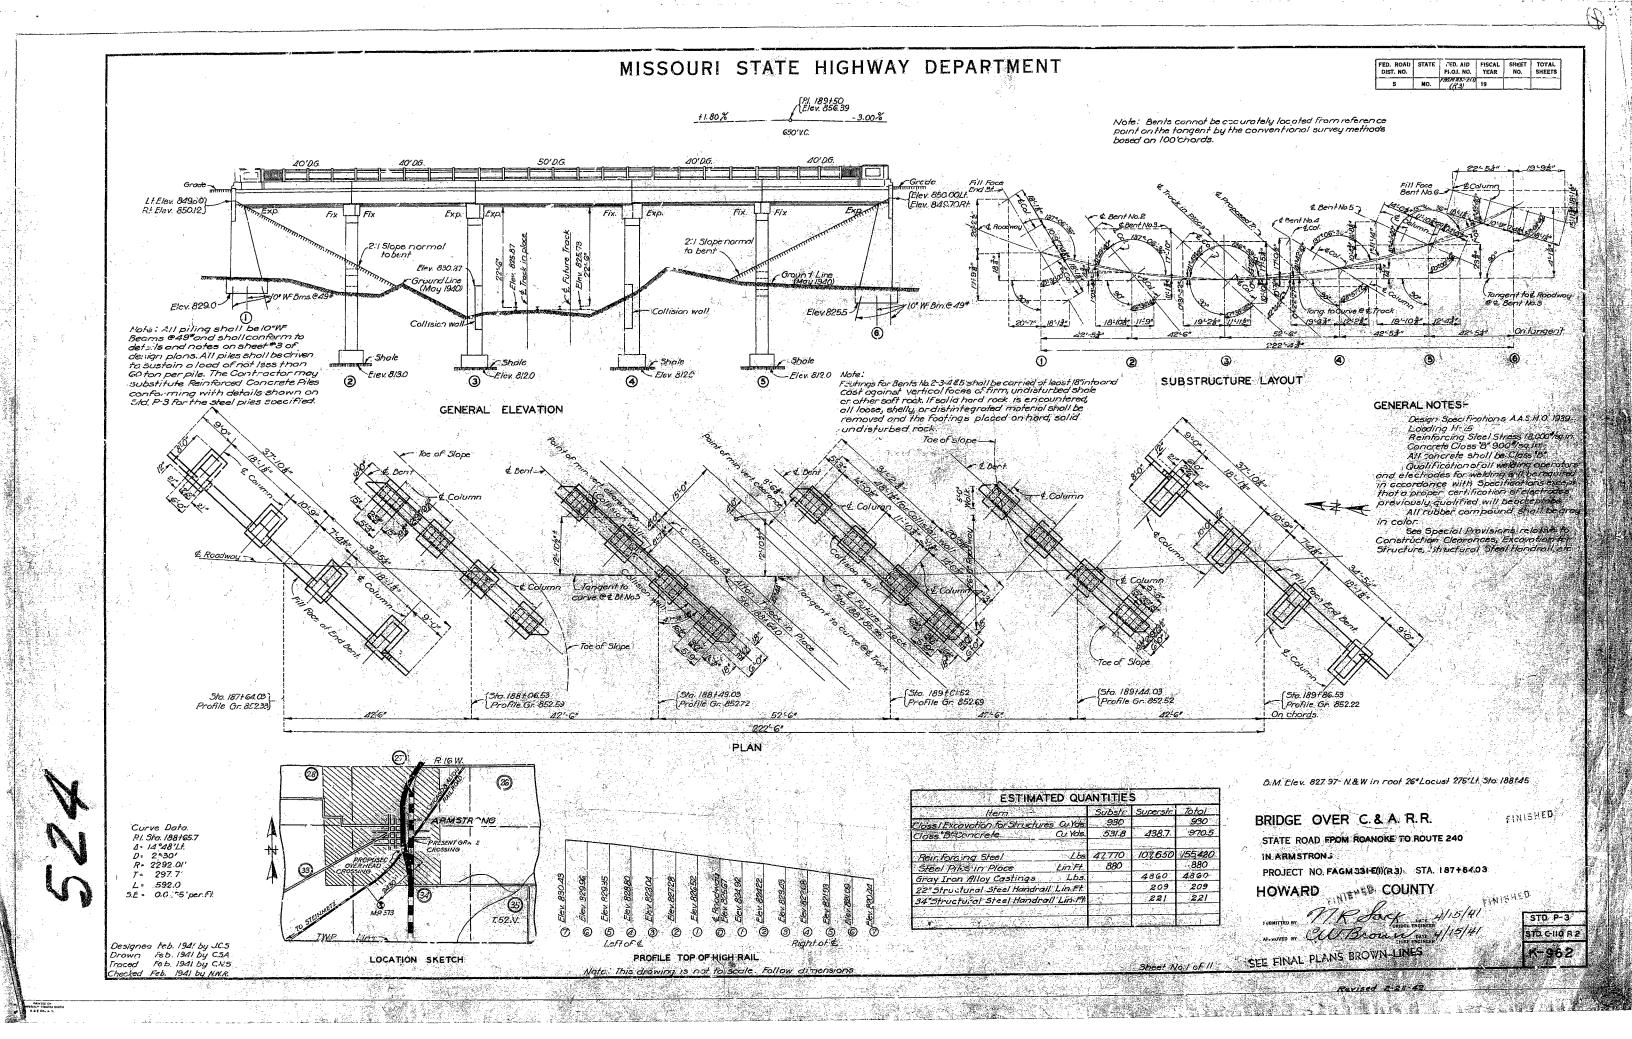

MISSOURI STATE HIGHWAY DEPARTMENT

FED. ROAD	STATE	FED. AID	FISCAL	SHEET	TOTAL
DIST. NO.		PROJ. NO.	YEAR	NO.	SHEETS
5	MO.	FREN 3372 (1)	19		

		COMPLETE BILL O	F REINFORCING STEEL	
	Bending Sketches & Cutting Diayroms in End Bents		Bending Sketches & Cutting Diagrams in Superstr & Intermediate Bent	
End Bent No. 1 40 3" 5'6" DI Footings	1-22" DI 82" 8'0"	End Bent No. 6 (Contd.)	12"U8 U9 14" U3-U4-U5-UG-U2	Superstructure 134 \$ 1 \$ 30 3" 51 51ab
16 2 9'0' FI Columns	4-88 D2 8	14 4°\$ 36'3' U17 "	ু ু ু ু ু ু ু ু ু ু ু ু ু ু ু ু ু ু ু	G3 8"\$ 3/-3" 52 "
14 \$"\$ 12.13" H1 Wing 1 \$"\$ 6'0" H2 "	© DI-D2 FI	2 2 186 13'0" VI Aling		78 \$"\$ 35'-6" 53 "
1 8" 6" H3 "	5'65" 85"	2 2 13 V V2 "	So Sold Marin Am	78 8"9 30'0" 55
3 2" 26'0" H4 "	فأ ا	10 8 19 9" V3 Column	12-U3-U4-U5-U6-U8-U9	112 8"4 31-3" 56
3 \$ " 15'9" H5 "	2 2 2	10 8" 18'5" V4 " 20 8" 19'0" V5 "	ELECTION OF THE PROPERTY OF TH	400 8" 22' 6" 57 1
/ 2° / 17'3" HG Beam	90 05 05 00 00 00 00 00 00 00 00 00 00 00	20 2° 14'0° V6 "	300000	26 gmg 36-6" 59 "
6 1 d 21 0" H8 "			2'-28" 10'-5" BZ E	26 8"1 30'0" 510 1
9 8"4 20'6" H9 " 4 8"4 29'6" H10 "	, 💐	Int Bents No. 285	6" 1:05" 2'68" 13'9" B3 8 3'115" WILLIAM 9	28 8" 38"3" 5// 28 8" 3/9" 5/2
6 8 4 10 6 HII "	6'/" 92"6" 3'62' U8	64 1 7 7-3 DI Footings	2.92" 17-0" 84 0" 2.52 P	388 8" 5'G" 513 Walk
2 8 4 16 0" 1112 "	G-8" 4'!!" U9 G'!!" U10	8 4 10'G" FI Hounch	b 2:55° 12:7° 88 2:81° 83 1 712'87	27 8"4 6'9" 5,4 .
2 8 1/4 12 0" H/3 "	0 08-03-010	24 3"# 10'0" F2 " 72 1"# 10'0" F3 "	2.95" 18'105" BIG UIZ-UI3-UI4 UI5	14 8° \$ 5'9" 5/5 " 40 2° \$ 22'0" 5/6 "
5 1"9 17'9" HIS "	6 2	10 1" 35'3" GI Beam	SI9 2:95" 22:3" 8// 2:53" 15:1" 8/3	10 2" 27'0" 517 "
13 1"\$ 21'G" HIG "		5 1" 15 10" 32 "	2-92" 18'G" BI4 84" RI NO	24 8"9 7'G' 5/8 Flore
2 2 4 19'0" 71 Wing	T2	14 1° 21'3" G3 " 10 2° 8'3" G4 "	82-B3-B4-B6-B8-79-BIO-BII-BI3-BI4-BI5 54" R2 2 2 2 2 2 2 2 2 2 2 2 2 2 2 2 2 2 2	24 8 7 6 5/9 " 28 8 4 36 6 5/0 5/ab
2 3 20'0" 72 "	13° 01	9 /" 29'9" G5 "	1'04" 44 1'04 " " R4 " 104" R4 " 104" R4 " 104" R4	28 8 9 3/2° 52/ "
15 486 101 CT 111 CT	B\$U2 [4]*'U3	5 /"\$ /9'0" GG "	[6" R8 19 1 2" R8	And and a
15 12-G" UI Beam 8 2" 12-0" U2 "	10 14	5 /** 9'0" G7 8 3"* 26'6" G8	52 RI-R2-R3-R4-R8-R9	40 2"\$ 39'3" WI Web
9 2nd il'-G" U3 "	72 UII	9 14 16'6" 69 -	2-1/2"	20 ½"# /9'3" W3 "
7 2"# 1/40" U4 " 6 2"# 1343" U5 "	122 UI2 128 UI3	36 1"\$ 16'6' G10 Tie Becm	201.07	40 8"\$ 12'0" W4 "
17 2 5 2 19 UG "	PE UIS PEGIA TESUIS	9 19 17:9" G Beam 236 4"4 10:9" PI Column		10 2"\$ 10'0" N5 " 140 2"\$ 2'3" W6 "
20 2" 31'-6" U7 Column	্য তা অ অ এ ই ই এ ই ই	60 1 7 9 P2 Tie Beam	33'1/2" GI	210 2"6 2'6" W7 "
20 3 8 8-0" U8 Footings	333333333	G 2" 16-6" UI Beam 9 2" 15:9" U2 "	31:11/2" GIB SI-54" 8 3 0 54"51	24 8 10 0° W8 "
2 2 4 13'0' VI Wing	204 36 57 4 6 2 9 4 6	47 2" 13'3' U3 1	3/://2" GIB 5/-54" B 3 0 54"5/ 1 1 1 1 1 1 1 1 1 1 1 1 1 1 1 1 1 1 1	G80 2"9 8'0" BI GOSPAN
2 2"# 13'0" V2 "		17 2 13 9" U4 "	THE THE PROPERTY OF THE PROPER	24 14" 30'6" B2 40'SPAN
10 3" 15-9" V3 Column	UITO US INCL. & UII TO UIS INCL.	15 2° 14'3" U5 "	5-1/2" DI 41-12" B5 B5 B5 B12 B12	24 /4 38 0" B3 40 5PAN 34 /4" 45 3" B4 50 56 67 4
10 2"\$ 15'3" 15 1	/3 ¹ -0" /3 ¹ -0"	4 2"8 17 0° U7 "	G'112" G4 50'102" B16 212 5'8"	64 14 " 44 6" B5 00 173 4
16 2"\$ 11'-0" V6 "	5'72" 7'42" 5'6" 7'6"	9 200 15'9" UB	7'82" 67. 40'72" 87. 82. 3'0"	3 /4" 32'3" BG GGF 4
10 3° 16'3' V7 "		25 2" 13'9" U9 " 32 1" 32'9" VI Column	6'82' 671 [7'112' 619	194 2"4 8'9" B7 50'594N 4 14"4 35'6" B6 650'599
End Bent No. G	G-25 0'05 G'2" G10:	32 1" 34"0" V2 "	10'82" W4 28' 7" SI F2 0 1	3 /1" 42'3" B9 GG/
40 8 4 60 D2 Footing	2-VI BARS CUT 4 2-V2 BARS CUT 4		DI-G3-G4-G7-GI2 24-8" WZ	2 14" 49"0" 810 50"5PAN 12 14" 55"9" 811 50"5PAN
15 3 4 14 3 HI Wing	3/-'G"		GI7-GI9-W4-W5 16'8" W3 10 10	12 14"9 55"9" BII 6 5 123". 20 14"8 54"6" BI2 50 SPAN
1 \$"\$ 5!9" H2 "	13:32" 18:24"	Int. Bents No. 3 & 4	61-66-618 B5-B12-B16-B17-S1 628 6-0" 628 W1-W2-W3 F3	6 14" 40'G" BI3 GOTS 23
1 8 4 G'O' H3 " 3 3 4 27 0' H4 "	- 62	8 3 10 10 1 Footings	a Varies	4 14" 48'3" BI4 GGISSEN
3 3 4 21-0 H4 "	12" U7	8 1 10 6" FI Hoursh	pb c 6	2 14" 43'3" BI5 SW 30' 55 3 14" 54'3" BIG SW 34' 5
1 3 16 21 0 HG Beam	12 116 18-24 13-32	16 8 25 9" F4 Coll. Wall.	tories o	12 14"0 44"0" BIT SWEDT #5
1 \$10 7:3" H7 " 6 \$10 21:3" H8 "	10-U7BARS CUT 20	80 2 25-6" F5 " " 12 1" 9 3' 3" G/2 Bears	d e 9 55 56 50 Si2-52	40 2 9 9 6 BIJ SWGL-5
9 8 9 21 0 H9 "	& BEND AS SHOWN	12 1"\$ 14'-G" G/3 "	S3-S4-S9-SII-S20 UI-U7-UIOUI6	728 27 3-0 Bl9 s.w.6dr.≱s
4 8 30 31 HIO "	3/-3" /2'-82" /6'-G2"	20 /"# 18'-0" G14 "	Mark a b c/ d e f Na.17 No. of No. to	94 3 6 22 9 CI Curbs
6 \$ 10'6' HII 1 2 \$ 90 14'6' HI2 "	2'24'	20 1"\$ 16'-0" G15 "	53 6" 5.0" 30.6" 17.6" 18.0" 35.6" 26 3 156 54 54 41" 31.10" 18.48" 18.78" 36.9" 28 4 224	26 2° 27'-9 C2 " 10 2° 24'-9" C3 "
4 1" 18'-G" HI3 "	2 - 1	10 3" 8"0" GI7 "	55 6" 2'3" 27'9" 14'9" 15'3" 30'0" .6 3 156	24-9 (3
5 1"6 20'0" H14 "	18' 62" 12' 82	10 1"\$ 33'-3" G18 "	56 58 2'2" 29'1" 15'48" 15'108" 31'3" 28 4 224	209 8"# 3'9" Ri Curb
12 14 2210" HI5 "	U7-U16-U17 14-U16 BARS CUT 14 & BEND AS SHOWN	18 14 13 3" G19 "	59 6° 5½° 3½° 18½° 18½° 36½° 26 1 52 500 6° 2½³ 27½° 14½° 15½³ 30½° 26 1 52	269 8"# 3'6" R2 " 223 8"# 3'6" R3 "
2 3 19 19 0" 71 Wing		240 4"# 11'-9" P3 Column	5:1 58" 5-8" 32-7" 18-102" 19-42" 38-3" 28 1 56	223 8" 543" R4 "
2 2 4 20'0" 72 " 16 2 4 2'9" UG Beam	36:3" 3:84" 22'64"	4 2"\$ 18.0" U10 Beam 18 2"\$ 16.0" U11 "	5/2 5\$\frac{5}{2} 25\frac{1}{2} 29\frac{1}{4} \q	28 3 9 3-9" R5 Post
16 2" 2-9" UG Beam 20 4" 8'0" U8 Footing	88"	18 2 16 9 UII " 26 2 4 14 3 UI2 "	$\begin{array}{cccccccccccccccccccccccccccccccccccc$	G 2"4 5:9" RG " G 2"5 G'9" R7 "
8 2 10'9" U9 "		38 2º4 14º6" U13 "	520 G" 4'-G" 32'-O" 18'-O" 18'-G" 36'-G" 28 1 56	16 8 4 4'3" R8 Curb
8 3 4 14 9 UIO " 15 2 4 12 0 UI! Beam	22'64" (3'84"	30 2"\$ 15'-0" U14 " 24 2"\$ 15'-3" U15 "	$\begin{array}{c ccccccccccccccccccccccccccccccccccc$	16 g 4'0" R9 "
10 ½"\$ 11'9" U12 "	4 -UIT BARS CUT IT & BEND AS SHOWN	3 2" 18'3' UIG "	U7 52 7 24 9 44 8 34 8 8 8 17 0 2 2 8	
9 2 1/2 0/3 1/3 1		G4 1"\$ 33'9" V3 Column	UIO 55 8'34" 3'84" 8'94" 3'24" 18'0 2 2 8	
8 2"\$ 11'3" U14 " 5 2"\$ 14'0" U15 "		112 g 9'9" V4 Coll. Wall	U652''8'8'' - $9'7''8'8''18'3''3'$ 3 / 6	
	***	Note: Bare in the above uni	ts to be billed and tagged Separately.	

Note: Bars in the above units to be billed and tagged separately.

COUNTY SEE FINAL PLANS EROWN-LINES THE STATE

STATE ROAD FROM ROANOKE TO ROUTE 240

PROJECT NO.FAGM331-E(0)(R3) STA. 187+64.03


BRIDGE OVER C. & A. R. R.

IN ARMSTRONG

HOWARD

K-962


Figure 1

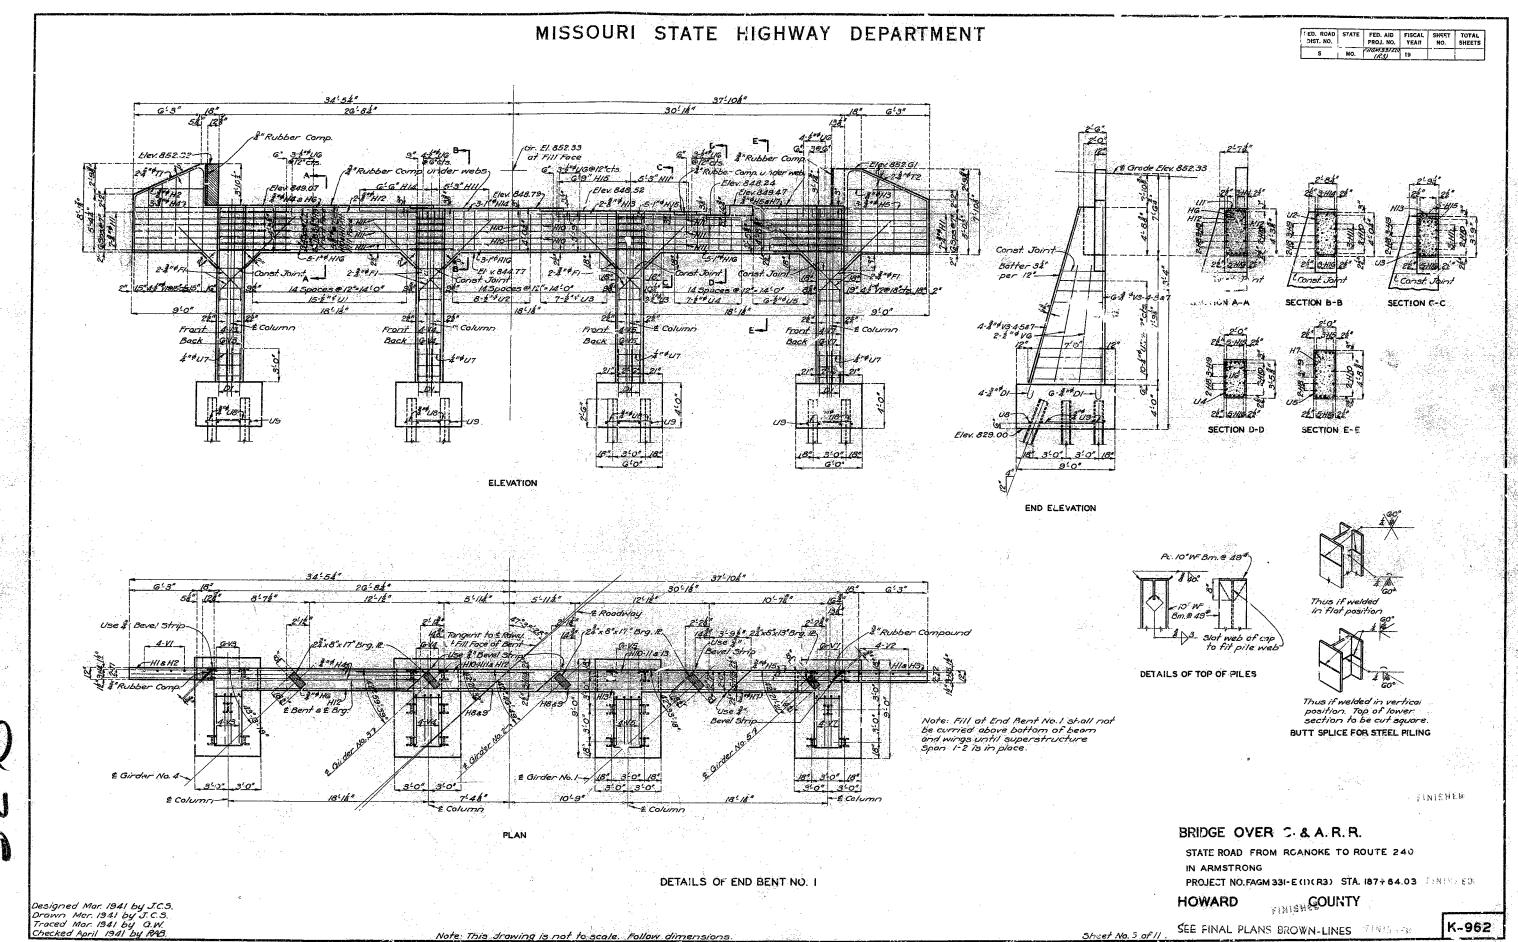


Note This drawing is not to scale. Follow dimensions

SEE FINAL PLANS BROWN-LINES TENES TO BE


K-962

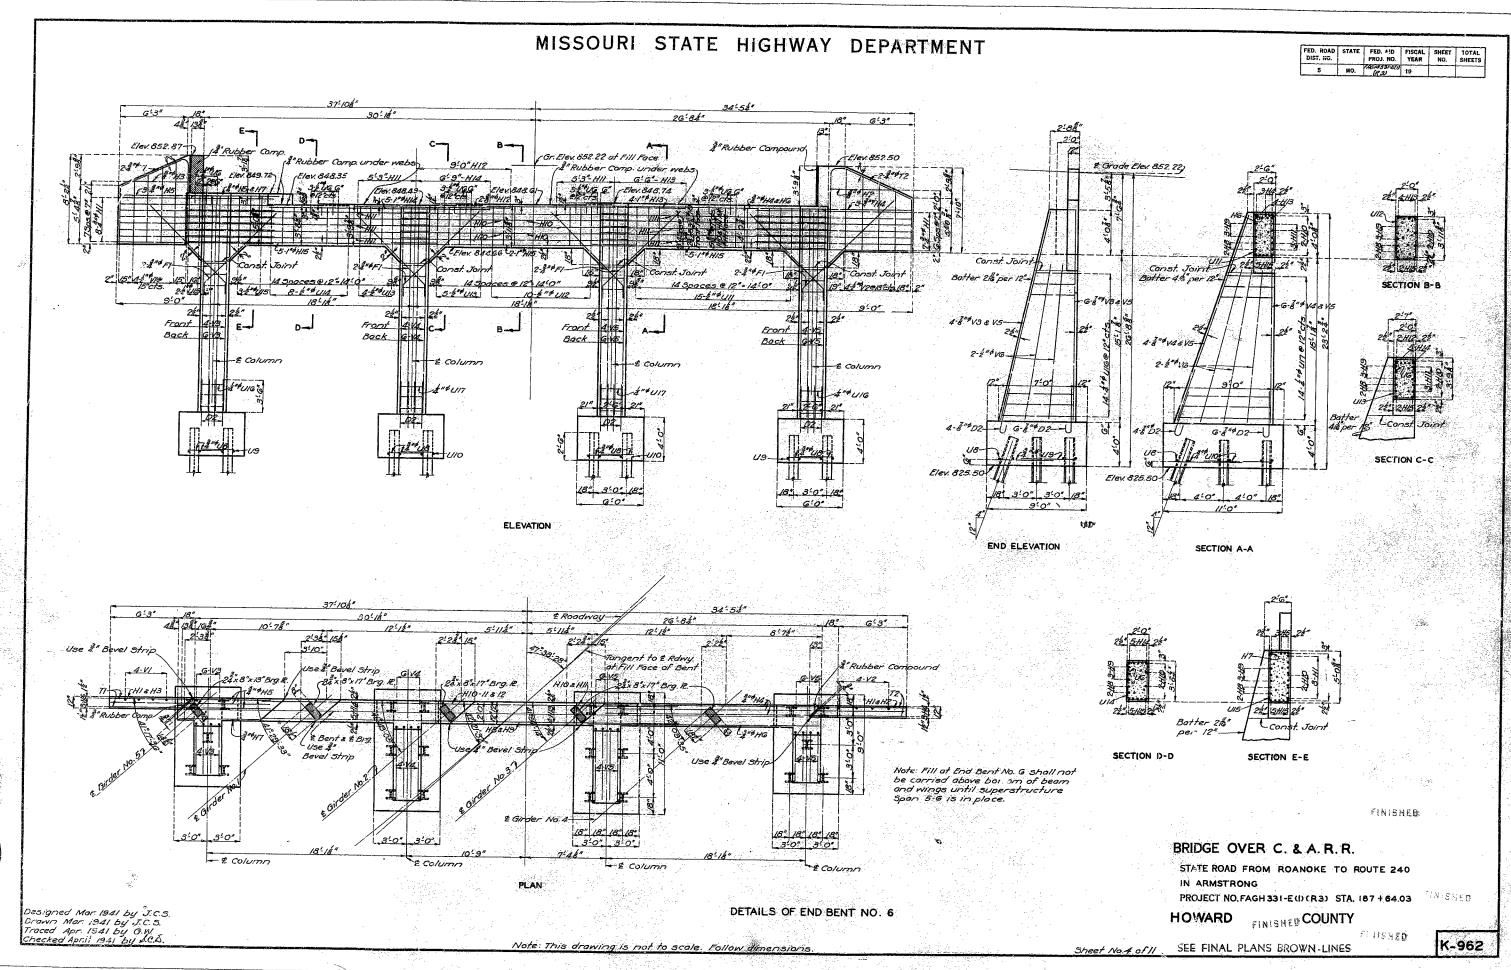

evised 2-28-42

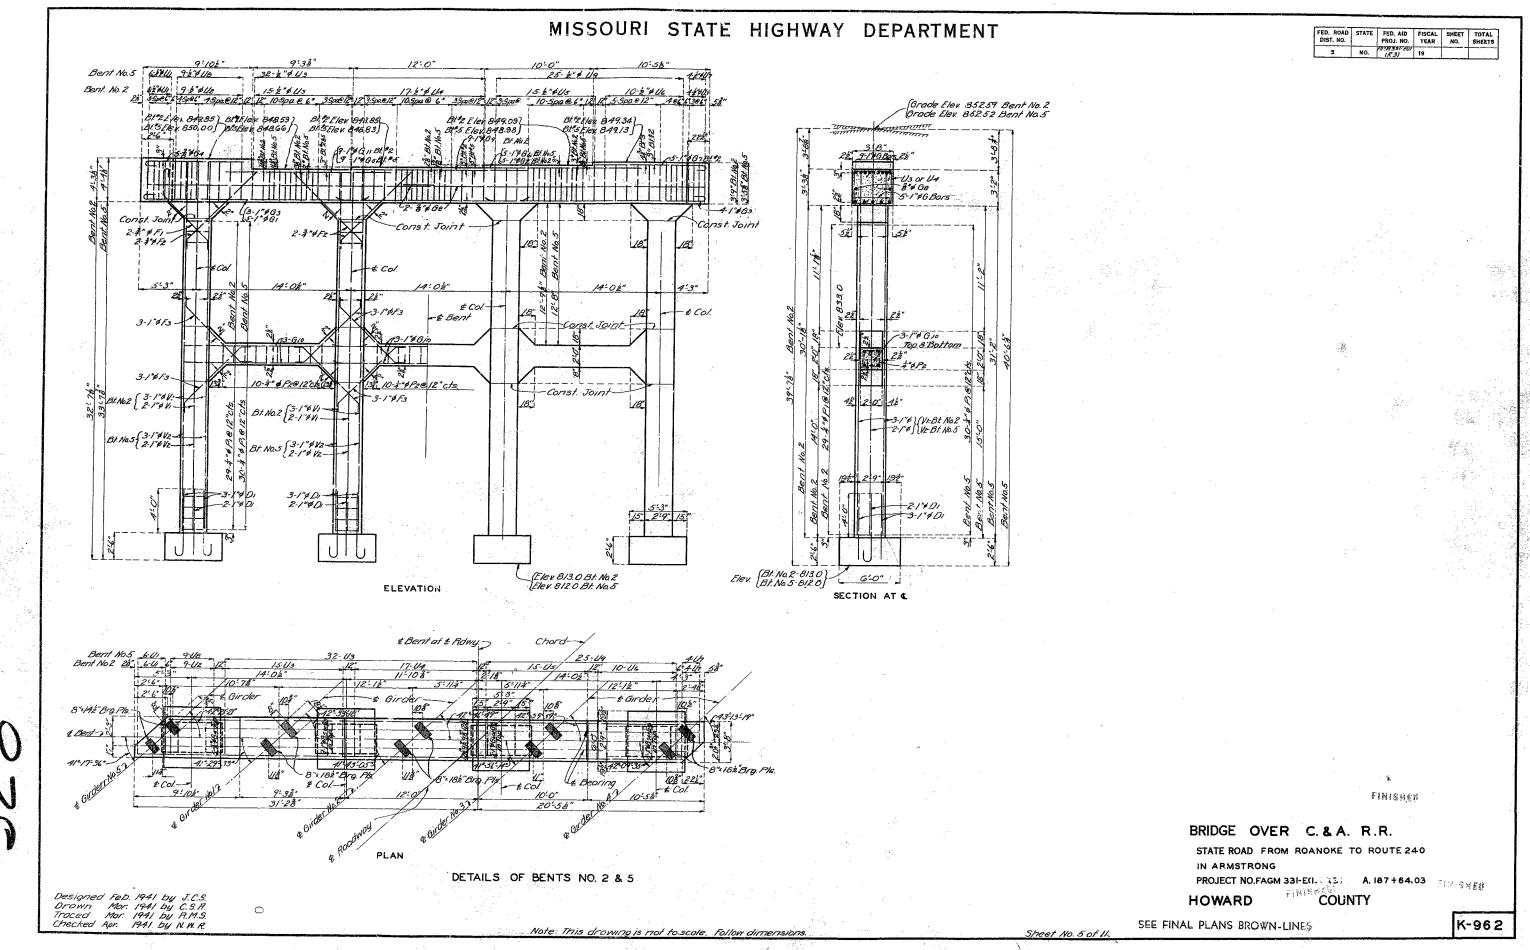

Revised 2-28-42.

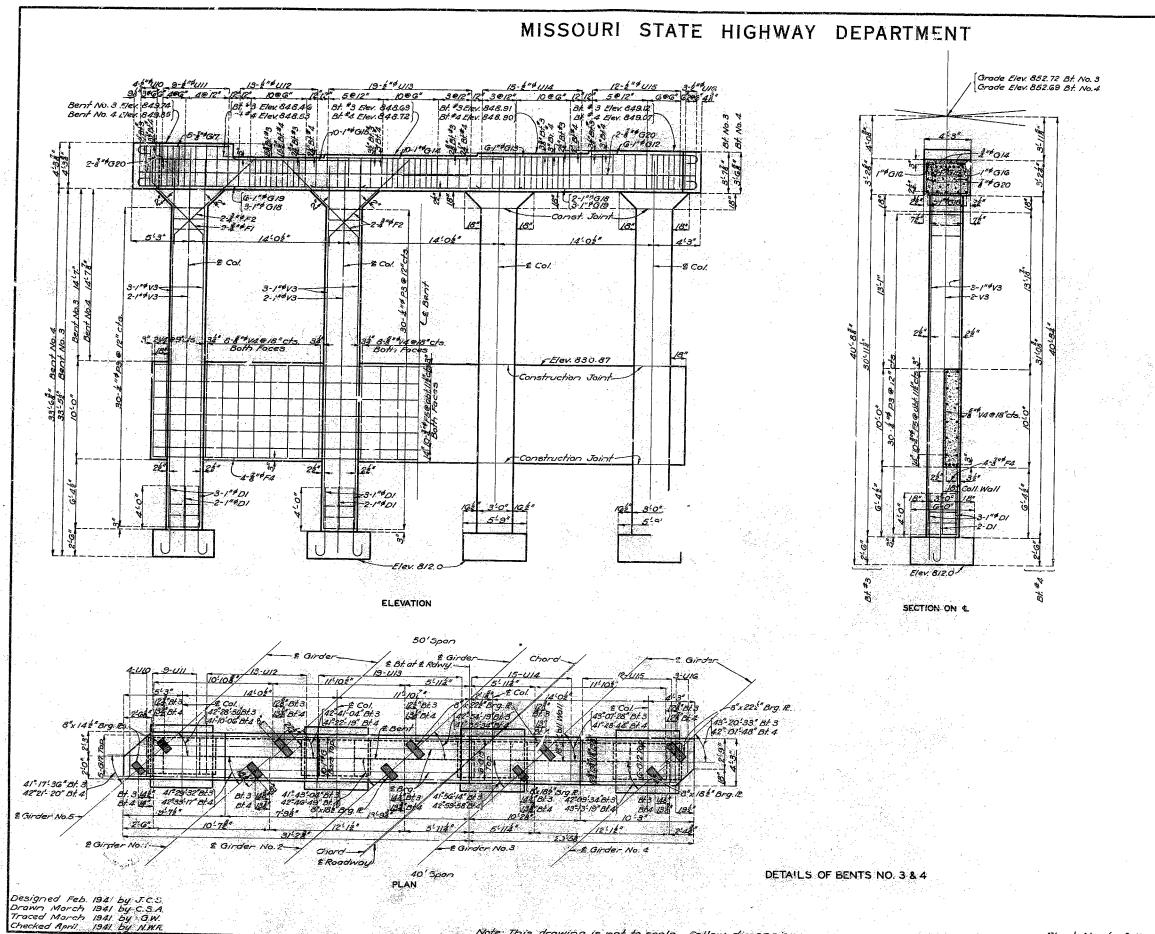

Note: This drawing is not to scale. Follow dimensions

BRIDGE OVER C. & A.R.R.

STATE ROAD FROM ROANOKE TO ROUTE 240 IN ARMSTRONG

PROJECT NO.FAGM 331-E(I) (R3) STA. 187+64.03

HOWARD

COUNTY

K-962

Sheet No. 6 of //. SEE FINAL PLANS BROWN-LINES

Missouri Department of Transportation State Bridge Inspection Report

April 29, 2025 1:37:14PM

COUNTY: HOWARD DISTRICT: CD CLASS: STATBR FED-ID: 6009 BRIDGE: K0962

GENERAL STRUCTURE INFORMATION ***BRIDGE INSPECTION INFORMATION*** **ROUTE: MO3S** # **SPANS**: 5 PLACE CODE: 01954 ARMSTRONG CITY **DATE:** 06/05/2023 **RESPONSIBILITY: DISTRICT** LANES ON: 2 FEATURE: KSC RR LENGTH: 223 FT 0 IN FREQUENCY: 24 **CALCULATED INTERVAL**: 24** LANES UNDER: 0 STATUS: A-OPEN **MAXIMUM SPAN: 52 FT 6 IN TEAM LEADER:** JOE GREEN **ELEMENT: NO LOG MILE: 69.329 COMPASS DIRECTION: NORTH to SOUTH** APPROACH ROADWAY: 26 FT 0 IN **INSPECTOR 2: INSPECTOR 4: DETOUR: 22.00 MILES DIRECTION OF TRAFFIC: 2-WAY TRAF CURB TO CURB: 26 FT 0 IN INSPECTOR 3: OUT TO OUT:** 29 FT 8 IN NHS: NO FUNCTIONAL CLASS: RL-MAJOR COLLECTOR ** When calculated interval exceeds the frequency, a justification comment per BIRM is required. **BUILT:** 1941 **NBI OWNER: MODOT AADT:** 1775 **GENERAL INSPECTION COMMENTS** REHAB: **NBI MAINTAINED: MODOT AADT YEAR: 2024** MAINTENANCE DISTRICT: CD LOCATION: S 34 T 52 R 16 W **AADT TRUCK: 17.3% LATITUDE:** 39 15 58.97 (DMS) **MAINTENANCE COUNTY: HOWARD FUTURE AADT: 2219 LONGITUDE:** 92 42 4.03 (DMS) SUB AREA: 7D24 **FUTURE AADT YEAR: 2044** ***INDEPTH INSPECTION INFORMATION*** ***FRACTURE CRITICAL INSPECTION INFORMATION*** DATE: RESPONSIBILITY: **CATEGORY: CATEGORY:** DATE: **RESPONSIBILITY: FREQUENCY: CALCULATED INTERVAL**: NBI**: **FREQUENCY: CALCULATED INTERVAL**: NBI**: **TEAM LEADER: INSPECTOR 3: METHOD: TEAM LEADER: INSPECTOR 3: METHOD: INSPECTOR 2: INSPECTOR 4: INSPECTOR 2: INSPECTOR 4:** ** When calculated interval exceeds the frequency, a justification comment per BIRM is required. ** When calculated interval exceeds the frequency, a justification comment per BIRM is required. FRACTURE CRITICAL INSPECTION COMMENTS **INDEPTH INSPECTION COMMENTS** ***SPECIAL INSPECTION INFORMATION*** ***UNDERWATER INSPECTION INFORMATION*** **CATEGORY: CATEGORY: QUALITY ASSURANCE DATE: DATE:** 03/26/2024 **RESPONSIBILITY: BRIDGEDIV** RESPONSIBILITY: FREOUENCY: 999 **NBI:** NO CALCULATED INTERVAL**: FREOUENCY: CALCULATED INTERVAL**: **NBI**: TEAM LEADER: JESSE ELSEMAN **INSPECTOR 3: METHOD:** VISUAL **TEAM LEADER: INSPECTOR 3: METHOD: INSPECTOR 2:** TERRY L SHUNAMON **INSPECTOR 4: INSPECTOR 2: INSPECTOR 4:** * When calculated interval exceeds the frequency, a justification comment per BIRM is required. ** When calculated interval exceeds the frequency, a justification comment per BIRM is required. SPECIAL INSPECTION COMMENTS **UNDERWATER INSPECTION COMMENTS** OTHER SPECIAL INSPECTIONS OTHER UNDERWATER INSPECTIONS **DATE FREQUENCY CATEGORY** NBI CALCULATED INTERVAL RESPONSIBILITY **METHOD** DATE **FREQUENCY CATEGORY** NBI CALCULATED INTERVAL RESPONSIBILITY **METHOD**

MoDOT

Missouri Department of Transportation State Bridge Inspection Report

April 29, 2025 1:37:14PM

COUNTY: HOWARD

DISTRICT: CD

CLASS: STATBR

FED-ID: 6009

BRIDGE: K0962

COUNTY: HOWAR	DISTRICT: C	D CI	LASS: STATER	FL	D-1D: 6009	BRIDGE: KU902	
			***STRU	CTURE POSTING**	*		
APPROVED CATEGORY: S-1	NO POSTING REQUIRED						
Ton 1:	Ton 2:	Ton 3	3:				
COMMENTS:							
FIELD CATEGORY: S-1	NO POSTING REQUIRED						
Ton 1:	Ton 2:	Ton 3	3:	PROBLEM:		PROBLEM DIRECTION:	
COMMENTS:							
		GF	ENERAL COMM	ENTS/MAJOR RATI	ED ITEMS		
GENERAL COMMENTS: (BOWDEJ1, 03/0	7/2008)(40'-40'-50'-40'-40') CONC DE	CK GDR SPANS					
[ITEM 58] DECK: 3	-SERIOUS CONDITION	COMMENTS: (EL	SEMJ, 03/28/2024)8	80% SATURATION IN SPA	ANS 1 & 3. SEVERA	L AREAS COULD BENEFIT FROM REPAIR.	
RATING: 0		`	,				
HTEM 501 CUDED. 5	EAID CONDITION	COMMENTS. (TD	DAMDA 11/00/2017)	MINIOD CD A CIZC AND C	ATUDATION, CDD E	NID/DIADII DETED.	
[ITEM 59] SUPER: 5 RATING: 0		COMMENTS: (1R	(AMPA, 11/08/2017)	-MINOR CRACKS AND S	ATUKATION; GDR E	IND/DIAPH DETER;	
KAIII.	3/16/2001						
	S-SATISFACTORY CONDITION	COMMENTS: (MA	ADSEJ, 09/26/2013)	MINOR SPALLING THRO	OUGHOUT ALL UNIT	rs	
RATING: 0	05/18/2001						
[ITEM 61] BANK/CHANNEL: N	J-NOT APPLIC NO WATRWAY	COMMENTS: (BC	OWDEJ1 03/22/2005)	MINOR SLOPE EROSIC	ON E BANK		
RATING: 0		001111211131 (Be	, , , , , , , , , , , , , , , , , , ,	min voit bear E Encosic	or E. Brit II		
	N-NOT APPLIC NOT WATERW	COMMENTS:					
RATING: 0	15/18/2001						
EVALUATION TYPE:	LOT A DRIVE A DATE	COLUMNITA					
[ITEM 71] WATERWAY ADEQUACY: N RATING: 0		COMMENTS:					
KATING. 0	3/18/2001						
[ITEM 72] APPRRDWY ALIGNMENT: 6	-SATISFACTORY	COMMENTS:					
RATING: 0	05/18/2001						
		RAILING AND) APPROACH PA	WEMENT COMPON	JENTS AND RAT	INGS	
[ITEM 36A] BRIDGE RAILING RATIN	NG: DOESNT MEET CURRNT STND-0		TING: 08/12/2004	COMMENTS:	VETTE TELLE TELLE	1100	
MATERIAL	CONSTRUCTION	DIRECTION	<u>COMMENTS</u>				
REINFORCED CONCRETE	CURB	ВОТН	COMMINICATION				
<u>CONDITION</u>	<u>LOCATION</u>		OCATION 2	<u>SEVERITY</u>	<u>COMMENT</u>		
DETERIORATIO				MODERATE			
REBAR EXPOSE REINFORCED CONCRETE	ED THROUGHO SIDEWALKS	RIGHT		MODERATE			
CONDITION	<u>LOCATION</u>		OCATION 2	<u>SEVERITY</u>	COMMENT		
SCALING	TOP			MEDIUM			
STEEL	ORNAMENTAL	BOTH					
[ITEM 36B] TRANSITION RAILING RATIO	NG: NOT PROVIDED-0	RAT	TING: 05/18/2001	COMMENTS:			
		1011					

MODOT

Missouri Department of Transportation State Bridge Inspection Report

April 29, 2025 1:37:14PM

COUNTY: HOWARD

DISTRICT: CD

CLASS: STATBR

RATING: 11/21/2017

FED-ID: 6009

BRIDGE: K0962

[ITEM 36C] APPROACH RAILING RATING: NOT PROVIDED-0

CONSTRUCTION

DIRECTION COMMENTS

GALVANIZED STEEL W-BEAM

(SIMPSB, 07/27/2004)--NOT STANDARD

ALL LOCATION 1

COMMENTS:

COMMENTS:

CONDITION COLLISION DAMAGE

THROUGHOUT

SEVERITY

COMMENT MINOR

[ITEM 36D] RAIL END TREATMENT RATING: NOT PROVIDED-0

RATING: 05/18/2001

LOCATION 2

(BOWDEJ1, 10/14/2009)--N.E. END

APPROACH PAVEMENT: *Overall condition assigned for each approach pavemenet component is shown below.

MATERIAL ASPHALT/CONCRETE

MATERIAL

CONSTRUCTION BITUMINOUS MAT/SLAB **DIRECTION BOTH**

CONDITION* FAIR

COMMENTS

DRAINAGE, EXPANSION DEVICES, BANK/SLOPE, AND DECK PROTECTIVE COMPONENTS

DECK PROTECTIVE COMPONENTS: SERIES TYPE-#

COMPONENT MAIN SERIES-1 WEARING SURFACE **MATERIAL ASPHALT**

CONSTRUCTION CINDER SEAL

THICKNESS .5 IN

YEAR APPLIED MANUFACTURE

OVERALL CONDITION VERY GOOD

COMMENT: (MADSEJ, 09/26/2013)--LOOKS NEW IN 2013

DECK PROTECTION

NOTAPPLICABLE

NONE

COMMENT:

MEMBRANE

NOTAPPLICABLE

NONE

COMMENT:

SECONDARY DECK PROTECTION

LIQUID SEALANT

INTERNALLY SEALED

2021

2009

PAVON INDECK

COMMENT:

MAIN SERIES-2

WEARING SURFACE

ASPHALT

CINDER SEAL

2009

COMMENT

COMMENT:

CONDITION DEBONDING

LOCATION 1 THROUGHOUT **LOCATION 2**

SEVERITY MINOR

DECK PROTECTION

NOTAPPLICABLE

NONE

COMMENT:

MEMBRANE

NOTAPPLICABLE

NONE

COMMENT:

SECONDARY DECK PROTECTION

LIQUID SEALANT

INTERNALLY SEALED

2021

PAVON INDECK

COMMENT:

DRAINAGE COMPONENTS:

COMPONENT DRAINAGE

MATERIAL STEEL

CONSTRUCTION MODOT PIPE DRAIN **DIRECTION**

COMMENTS

Design $N_0 = k0962$

Missouri Department of Transportation State Bridge Inspection Report

COUNTY: HOWARD DISTRICT: CD **CLASS: STATBR FED-ID: 6009 BRIDGE: K0962**

EXPANSION DEVICE COMPONENTS: SUB UNIT-#

COMMENT:

MODOT

SUB LABEL

MATERIAL COMPONENT

CONSTRUCTION

<u>GAP</u> YEAR APPLIED **MANUFACTURE**

OVERALL CONDITION

BANK/SLOPE PROTECTION COMPONENTS:

COMPONENT

MATERIAL

CONSTRUCTION

DIRECTION

COMMENTS

			DI	ECK COMPONEN	ITS	
SPAN TYPE-#	COMPONENT	<u>MATERIAL</u>	CONSTRU	CTION COM	MENTS	
MAIN SPANS-1 CONDITION DETERIORATIO MAP CRACKS	<i>DECK</i> ON	REINFORCED CONCRETE LOCATION 1 AT JOINTS RANDOM			<u>MEASUREMENT</u>	<u>COMMENT</u>
PATCHES SATURATION SCALING		THROUGHOUT THROUGHOUT THROUGHOUT		MANY HEAVY LIGHT	80 %	(SIMPSB, 07/27/2004)UNDERSIDE
MAIN SPANS-2 <u>CONDITION</u> DETERIORATIO MAP CRACKS		REINFORCED CONCRETE LOCATION 1 AT JOINTS RANDOM	CAST-IN-F LOCATION 2	<i>LACE</i> <u>Severity</u> Moderate Many	<u>MEASUREMENT</u>	<u>COMMENT</u>
PATCHES SATURATION SCALING		THROUGHOUT THROUGHOUT THROUGHOUT		MANY HEAVY MODERATE	70 %	
<i>MAIN SPANS-3</i> <u>CONDITION</u> DETERIORATIO	<i>DECK</i> ON	REINFORCED CONCRETE LOCATION 1 AT JOINTS	CAST-IN-F LOCATION 2	<u>SEVERITY</u> Moderate	<u>MEASUREMENT</u>	<u>COMMENT</u>
PATCHES SATURATION SCALING TRANSVERSE CRA		THROUGHOUT THROUGHOUT THROUGHOUT RANDOM		MANY HEAVY LIGHT FEW	70 %	
MAIN SPANS-4 <u>CONDITION</u> DETERIORATIO PATCHES	<i>DECK</i> ON	REINFORCED CONCRETE LOCATION 1 AT JOINTS THROUGHOUT	CAST-IN-F LOCATION 2	<i>LACE</i> <u>Severity</u> Moderate Many	<u>MEASUREMENT</u>	<u>COMMENT</u>
SATURATION SCALING TRANSVERSE CRA		THROUGHOUT THROUGHOUT RANDOM		MANT MODERATE LIGHT FEW	25 %	
MAIN SPANS-5 <u>CONDITION</u> DETERIORATIO PATCHES	<i>DECK</i> ON	REINFORCED CONCRETE LOCATION 1 AT JOINTS THROUGHOUT	CAST-IN-F LOCATION 2	<i>LACE</i> <u>Severity</u> Moderate Many	<u>MEASUREMENT</u>	<u>COMMENT</u> (ZENTZA1, 06/03/2010)ALL JOINTS LEAKING
SATURATION		THROUGHOUT		MODERATE	30 %	

 $Design_No = k0962$

Missouri Department of Transportation State Bridge Inspection Report

DISTRICT: CD **CLASS: STATBR COUNTY: HOWARD** FED-ID: 6009 BRIDGE: K0962

THROUGHOUT LIGHT SCALING TRANSVERSE CRACKS RANDOM FEW

SERIES TYPE-#	CD AN TUDE			SUPERSTRUCTURE C	01/11 01/11/12	
	SPAN TYPE	<u>MATERI</u>	<u>AL</u>	<u>CONSTRUCTION</u>	<u>LABEL</u>	<u>COMMENTS</u>
MAIN SERIES-1	SIMPLE SPAN	REINFORCED C	ONCRETE	DECK GIR		
<u>SPAN</u>	COMPOSITE INDICATOR	LENGTH	WEATHERING STEEL	<u>COMMENTS</u>		
MAIN SPANS-1	NON-COMPOSITE	42 FT 6 IN	NO			
CONDITION	LOC A	ATION 1	LOCATION 2	<u>SEVERITY</u>	<u>MEASUREMENT</u>	<u>COMMENT</u>
DELAMINATIO	<u></u>	DERS		MINOR		
DETERIORATION		HRAGMS		MODERATI	Ξ	(ZENTZA1, 06/03/2010)DIAPHRAGMS UNDER SIDEWALK BREAKING UP
DETERIORATIO		RHANGS		MODERAT		
LEACHING		UGHOUT		LIGHT		
REBAR EXPOS		HRAGMS		MINOR		
SPALLS		DR1		FEW		
VERTICAL CRA		NDOM		FEW		
MADI CDANG A	NON COMPOSITE	42 ET. (D.	NO			
MAIN SPANS-2	NON-COMPOSITE	42 FT 6 IN	NO LOCATION) CEI/EDITI	MEACHDEMENT	COMMENT
<u>CONDITION</u> COLLISION DAM		ATION 1	<u>LOCATION 2</u>		<u>MEASUREMENT</u>	<u>COMMENT</u> (EL SEMI, 02/28/2024). CDB #5 NEAR BENT 4
		DERS		MINOR	7	(ELSEMJ, 03/28/2024)GDR #5 NEAR BENT 4
DELAMINATION ATTEMPT A		DERS		MODERATI		(ELSEMJ, 03/28/2024)GDR #2 NEAR BENT 4
DETERIORATION		HRAGMS		MODERATI		
DETERIORATION		RHANGS		MODERAT		
DIAGONAL CRA		NDS		FINE		
LEACHING		UGHOUT		LIGHT		
SPALLS		NDS		FEW		
SPALLS	RAN	NDOM		MINOR		(MADSEJ, 09/26/2013)DECK SHIFTING ON SKEW 2 IN., CAUSING SPALL @ BT. #2 GIRDER NORTH ABUTMENT
VERTICAL CRA	CKS RAN	NDOM		FEW		
MAIN SERIES-2	SIMPLE SPAN	REINFORCED C	ONCRETE	DECK GIR		
SPAN MADI CDANIC 2	COMPOSITE INDICATOR		WEATHERING STEEL	<u>COMMENTS</u>		
MAIN SPANS-3	NON-COMPOSITE	52 FT 6 IN	NO LOCATION (CELERIE	A CHIDENESIE	COMMENT
<u>CONDITION</u>		ATION 1	<u>LOCATION 2</u>			<u>COMMENT</u>
DETERIORATION		HRAGMS		MODERAT		
DETERIORATION		RHANGS		MODERAT	<u> </u>	
DIAGONAL CRA		NDS		FINE		
HORIZONTAL CR		R GIRDERS		FEW		
LEACHING		UGHOUT		LIGHT		
SPALLS		NDS		FEW		
VERTICAL CRA	CKS RAN	NDOM		FEW		
MAIN SPANS-4	NON-COMPOSITE	42 FT 6 IN	NO			
<u>CONDITION</u>		ATION 1	LOCATION 2	<u>SEVERITY</u>	<u>MEASUREMENT</u>	<u>COMMENT</u>
DETERIORATIO		HRAGMS		MODERATI		
DETERIORATION		NDS		MODERAT		
DIAGONAL CRA		NDS		FINE		
SPALLS		NDS		FEW		

MODOT

April 29, 2025 1:37:14PM

Missouri Department of Transportation State Bridge Inspection Report

MEASUREMENT

COMMENT

COUNTY: HOWARD DISTRICT: CD CLASS: STATBR FED-ID: 6009 BRIDGE: K0962

CONDITIONLOCATION 1LOCATION 2SEVERITYDETERIORATIONDIAPHRAGMSMODERATEDETERIORATIONENDSMODERATEDIAGONAL CRACKSENDSFINESPALLSENDSFEW

			***SUBSTRUCTURE C			
<u>UBSTRUCTURE</u>		<u>LENGTH</u> <u>MATERIAL</u>	<u>CONSTRUCTION</u> <u>LABI</u>	<u>COMMENT</u>	<u>rs</u>	
ABUTMENT-1		55 FT 8 IN REINFORCED CONCRETE	OPEN CONCRETE			
	<u>CONDITION</u>	<u>LOCATION 1</u>	<u>LOCATION 2</u>	<u>SEVERITY</u>	<u>MEASUREMENT</u>	<u>COMMENT</u>
·	ED COMPONENT	<u>MATERIAL</u>	<u>CONSTRUCTION</u>			
BEAM CAI		REINFORCED CONCRETE	CAST-IN-PLACE			
	<u>CONDITION</u>	<u>LOCATION 1</u>	<u>LOCATION 2</u>	<u>SEVERITY</u>	<u>MEASUREMENT</u>	<u>COMMENT</u>
	DETERIORATION	THROUGHOUT		MODERATE		
	EFFLORESCENCE	THROUGHOUT		MINOR		
COLUMN		REINFORCED CONCRETE	CAST-IN-PLACE			
	<u>CONDITION</u>	<u>LOCATION 1</u>	<u>LOCATION 2</u>	<u>SEVERITY</u>	<u>MEASUREMENT</u>	<u>COMMENT</u>
	REBAR EXPOSED	COLUMN		FEW		
	SPALLS	COLUMN		FEW		
FOOTING		REINFORCED CONCRETE	H-PILE			
	<u>CONDITION</u>	<u>LOCATION 1</u>	<u>LOCATION 2</u>	<u>SEVERITY</u>	<u>MEASUREMENT</u>	<u>COMMENT</u>
STRAIGHT	`WINGS	REINFORCED CONCRETE	CAST-IN-PLACE			
	<u>CONDITION</u>	<u>LOCATION 1</u>	<u>LOCATION 2</u>	<u>SEVERITY</u>	<u>MEASUREMENT</u>	<u>COMMENT</u>
FIXED BEA	ARING	STEEL	CURVED PLATE(ROTATING)			
	CONDITION	<u>LOCATION 1</u>	<u>LOCATION 2</u>	<u>SEVERITY</u>	<u>MEASUREMENT</u>	<u>COMMENT</u>
	PACK RUST	THROUGHOUT		HEAVY		
BENT-2		51 FT 7 IN REINFORCED CONCRETE	MULTIPLE COLUMN	~~		
	<u>CONDITION</u>	<u>LOCATION 1</u>	<u>LOCATION 2</u>	<u>SEVERITY</u>	<u>MEASUREMENT</u>	<u>COMMENT</u>
	ED COMPONENT	<u>MATERIAL</u>	<u>CONSTRUCTION</u>			
BEAM CAI		REINFORCED CONCRETE	CAST-IN-PLACE	~		
	<u>CONDITION</u>	<u>LOCATION 1</u>	<u>LOCATION 2</u>	<u>SEVERITY</u>	<u>MEASUREMENT</u>	<u>COMMENT</u>
	REBAR EXPOSED	THROUGHOUT		MINOR		
	REBAR SECTION LOS			INITIAL		
	SPALLS	THROUGHOUT		MODERATE		
		DEDUCAD CED CONCRETE				
COLUMN	CONDITION	REINFORCED CONCRETE	CAST-IN-PLACE	CEL ED LEV	ME ACHIDENCENT	COLUMNIT
COLUMN	<u>CONDITION</u>	<u>LOCATION 1</u>	CAST-IN-PLACE <u>LOCATION 2</u>	<u>SEVERITY</u>	<u>MEASUREMENT</u>	<u>COMMENT</u>
COLUMN	REBAR EXPOSED	<u>LOCATION 1</u> RANDOM		FEW	<u>MEASUREMENT</u>	<u>COMMENT</u> (ELSEMJ, 03/28/2024)2 STURRIPS RUSTED IN TWO
COLUMN	REBAR EXPOSED RUST STAINS	<u>LOCATION 1</u> RANDOM COLUMN		FEW FEW	<u>MEASUREMENT</u>	
COLUMN	REBAR EXPOSED RUST STAINS SPALLS	<u>LOCATION 1</u> RANDOM COLUMN COLUMN		FEW FEW MODERATE	<u>MEASUREMENT</u>	
	REBAR EXPOSED RUST STAINS SPALLS VERTICAL CRACKS	<u>LOCATION 1</u> RANDOM COLUMN COLUMN COLUMN	<u>LOCATION 2</u>	FEW FEW	<u>MEASUREMENT</u>	
COLUMN	REBAR EXPOSED RUST STAINS SPALLS VERTICAL CRACKS	LOCATION 1 RANDOM COLUMN COLUMN COLUMN REINFORCED CONCRETE	<u>LOCATION 2</u> SPREAD	FEW FEW MODERATE MEDIUM		(ELSEMJ, 03/28/2024)2 STURRIPS RUSTED IN TWO
FOOTING	REBAR EXPOSED RUST STAINS SPALLS VERTICAL CRACKS CONDITION	LOCATION 1 RANDOM COLUMN COLUMN COLUMN REINFORCED CONCRETE LOCATION 1	SPREAD LOCATION 2	FEW FEW MODERATE	MEASUREMENT MEASUREMENT	
	REBAR EXPOSED RUST STAINS SPALLS VERTICAL CRACKS CONDITION	LOCATION 1 RANDOM COLUMN COLUMN COLUMN REINFORCED CONCRETE LOCATION 1 REINFORCED CONCRETE	SPREAD LOCATION 2 CAST-IN-PLACE	FEW FEW MODERATE MEDIUM SEVERITY	<u>MEASUREMENT</u>	(ELSEMJ, 03/28/2024)2 STURRIPS RUSTED IN TWO <u>COMMENT</u>
FOOTING TIE BEAM	REBAR EXPOSED RUST STAINS SPALLS VERTICAL CRACKS CONDITION CONDITION	LOCATION 1 RANDOM COLUMN COLUMN COLUMN REINFORCED CONCRETE LOCATION 1 REINFORCED CONCRETE LOCATION 1	SPREAD LOCATION 2 CAST-IN-PLACE LOCATION 2	FEW FEW MODERATE MEDIUM SEVERITY		(ELSEMJ, 03/28/2024)2 STURRIPS RUSTED IN TWO
FOOTING	REBAR EXPOSED RUST STAINS SPALLS VERTICAL CRACKS CONDITION CONDITION ARING	LOCATION 1 RANDOM COLUMN COLUMN COLUMN REINFORCED CONCRETE LOCATION 1 REINFORCED CONCRETE LOCATION 1 STEEL	SPREAD LOCATION 2 CAST-IN-PLACE LOCATION 2 CURVED PLATE(ROTATING)	FEW FEW MODERATE MEDIUM SEVERITY SEVERITY	MEASUREMENT MEASUREMENT	(ELSEMJ, 03/28/2024)2 STURRIPS RUSTED IN TWO COMMENT COMMENT
FOOTING TIE BEAM	REBAR EXPOSED RUST STAINS SPALLS VERTICAL CRACKS CONDITION CONDITION ARING CONDITION	LOCATION 1 RANDOM COLUMN COLUMN COLUMN REINFORCED CONCRETE LOCATION 1 REINFORCED CONCRETE LOCATION 1 STEEL LOCATION 1	SPREAD LOCATION 2 CAST-IN-PLACE LOCATION 2	FEW FEW MODERATE MEDIUM SEVERITY SEVERITY	<u>MEASUREMENT</u>	(ELSEMJ, 03/28/2024)2 STURRIPS RUSTED IN TWO COMMENT COMMENT
FOOTING TIE BEAM	REBAR EXPOSED RUST STAINS SPALLS VERTICAL CRACKS CONDITION CONDITION ARING	LOCATION 1 RANDOM COLUMN COLUMN COLUMN REINFORCED CONCRETE LOCATION 1 REINFORCED CONCRETE LOCATION 1 STEEL	SPREAD LOCATION 2 CAST-IN-PLACE LOCATION 2 CURVED PLATE(ROTATING)	FEW FEW MODERATE MEDIUM SEVERITY SEVERITY	MEASUREMENT MEASUREMENT	(ELSEMJ, 03/28/2024)2 STURRIPS RUSTED IN TWO COMMENT COMMENT
FOOTING TIE BEAM FIXED BEA	REBAR EXPOSED RUST STAINS SPALLS VERTICAL CRACKS CONDITION CONDITION ARING CONDITION PACK RUST	LOCATION 1 RANDOM COLUMN COLUMN COLUMN REINFORCED CONCRETE LOCATION 1 REINFORCED CONCRETE LOCATION 1 STEEL LOCATION 1 THROUGHOUT	SPREAD LOCATION 2 CAST-IN-PLACE LOCATION 2 CURVED PLATE(ROTATING) LOCATION 2	FEW FEW MODERATE MEDIUM SEVERITY SEVERITY	MEASUREMENT MEASUREMENT	(ELSEMJ, 03/28/2024)2 STURRIPS RUSTED IN TWO COMMENT COMMENT
FOOTING TIE BEAM	REBAR EXPOSED RUST STAINS SPALLS VERTICAL CRACKS CONDITION CONDITION ARING CONDITION PACK RUST	LOCATION 1 RANDOM COLUMN COLUMN COLUMN REINFORCED CONCRETE LOCATION 1 REINFORCED CONCRETE LOCATION 1 STEEL LOCATION 1	SPREAD LOCATION 2 CAST-IN-PLACE LOCATION 2 CURVED PLATE(ROTATING)	FEW FEW MODERATE MEDIUM SEVERITY SEVERITY	MEASUREMENT MEASUREMENT	COMMENT COMMENT COMMENT

MODOT

Missouri Department of Transportation State Bridge Inspection Report

COUNTY: HOWARD DISTRICT: CD CLASS: STATBR FED-ID: 6009 BRIDGE: K0962 CONSTRUCTION ASSOCIATED COMPONENT **MATERIAL** BEAM CAP REINFORCED CONCRETE CAST-IN-PLACE LOCATION 1 **LOCATION 2 SEVERITY CONDITION** MEASUREMENT COMMENT DELAMINATION **BOTTOM MODERATE FEW** HORIZONTAL CRACKS **RANDOM** REBAR EXPOSED **BOTTOM MINOR** REBAR SECTION LOSS **BOTTOM INITIAL SPALLS BOTTOM MODERATE** COLUMN REINFORCED CONCRETE **CAST-IN-PLACE CONDITION LOCATION 1 LOCATION 2 SEVERITY** MEASUREMENT COMMENT **RUST STAINS COLUMN FEW MODERATE SPALLS COLUMN VERTICAL CRACKS COLUMN MEDIUM** REINFORCED CONCRETE **FOOTING** SPREAD LOCATION 2 MEASUREMENT COMMENT **CONDITION LOCATION 1 SEVERITY** REINFORCED CONCRETE **COLLISION WALL CAST-IN-PLACE CONDITION** LOCATION 1 **LOCATION 2 SEVERITY** *MEASUREMENT* COMMENT HIGH STEEL SPALLS RANDOM **FEW FEW** VERTICAL CRACKS THROUGHOUT FIXED BEARING STEEL CURVED PLATE(ROTATING **CONDITION** LOCATION 1 LOCATION 2 **SEVERITY** MEASUREMENT COMMENT PACK RUST **THROUGHOUT MODERATE** BENT-4 RA-42 DEGREES 51 FT 7 IN REINFORCED CONCRETE MULTIPLE COLUMN **CONDITION SEVERITY** LOCATION 1 **LOCATION 2** MEASUREMENT **COMMENT** ASSOCIATED COMPONENT **CONSTRUCTION MATERIAL** BEAM CAP REINFORCED CONCRETE CAST-IN-PLACE **CONDITION LOCATION 1 LOCATION 2 SEVERITY** MEASUREMENT COMMENT **DETERIORATION** RANDOM MINOR **FEW SPALLS BOTTOM** COLUMN REINFORCED CONCRETE CAST-IN-PLACE LOCATION 1 LOCATION 2 SEVERITY MEASUREMENT COMMENT **CONDITION** HIGH STEEL SPALLS RANDOM **FEW RUST STAINS COLUMN FEW SPALLS COLUMN** FEW VERTICAL CRACKS **COLUMN** MINOR **FOOTING** REINFORCED CONCRETE SPREAD LOCATION 2 MEASUREMENT **CONDITION LOCATION 1** SEVERITY **COMMENT EXPOSED PARTIAL** TOP **COLLISION WALL** REINFORCED CONCRETE CAST-IN-PLACE **CONDITION** LOCATION 2 **LOCATION 1 SEVERITY** *MEASUREMENT* **COMMENT** STEEL CURVED PLATE(ROTATING FIXED BEARING **CONDITION LOCATION 1 LOCATION 2 SEVERITY** MEASUREMENT **COMMENT** PACK RUST **THROUGHOUT MODERATE** BENT-5 RA-42 DEGREES 51 FT 7 IN REINFORCED CONCRETE MULTIPLE COLUMN **CONDITION** LOCATION 2 **SEVERITY** MEASUREMENT **COMMENT** LOCATION 1 ASSOCIATED COMPONENT **CONSTRUCTION MATERIAL** BEAM CAP REINFORCED CONCRETE CAST-IN-PLACE **CONDITION LOCATION 1 LOCATION 2 SEVERITY** MEASUREMENT COMMENT **DETERIORATION RANDOM MINOR** HORIZONTAL CRACKS **RANDOM** MANY

MODOT

MoDOT

Missouri Department of Transportation State Bridge Inspection Report CLASS: STATER

April 29, 2025 1:37:14PM

COUNTY: HOWARD	DISTRICT: CD	CLASS: STATBR	-	D: 6009	BRIDGE: K0962
LEACHING	RANDOM		MINOR		
REBAR EXPOSED	RANDOM		FEW		
REBAR SECTION LOSS	BOTTOM		MODERATE		
SPALLS	RANDOM		LARGE		
COLUMN	REINFORCED CONCRETE	CAST-IN-PLACE			
<u>CONDITION</u>	<u>LOCATION 1</u>	<u>LOCATION 2</u>	<u>SEVERITY</u>	<u>MEASUREMENT</u>	<u>COMMENT</u>
RUST STAINS	COLUMN		FEW		
SPALLS	COLUMN		MODERATE		
VERTICAL CRACKS	COLUMN		MEDIUM		
FOOTING	REINFORCED CONCRETE	SPREAD			
<u>CONDITION</u>	<u>LOCATION 1</u>	<u>LOCATION 2</u>	<u>SEVERITY</u>	<u>MEASUREMENT</u>	<u>COMMENT</u>
TIE BEAM	REINFORCED CONCRETE	CAST-IN-PLACE			
<u>CONDITION</u>	<u>LOCATION 1</u>	<u>LOCATION 2</u>	<u>SEVERITY</u>	<u>MEASUREMENT</u>	<u>COMMENT</u>
FIXED BEARING	STEEL	CURVED PLATE(ROTATING			
<u>CONDITION</u>	<u>LOCATION 1</u>	<u>LOCATION 2</u>	<u>SEVERITY</u>	<u>MEASUREMENT</u>	<u>COMMENT</u>
PACK RUST	THROUGHOUT		MODERATE		
ABUTMENT-6 RA-42 DEGREES 55	FT 8 IN REINFORCED CONCRETE	OPEN CONCRETE			
CONDITION	LOCATION 1	LOCATION 2	SEVERITY	MEASUREMENT	COMMENT
ASSOCIATED COMPONENT	MATERIAL	CONSTRUCTION			
BEAM CAP	REINFORCED CONCRETE	CAST-IN-PLACE			
CONDITION	LOCATION 1	LOCATION 2	SEVERITY	MEASUREMENT	COMMENT
DELAMINATION	THROUGHOUT		MODERATE		
DETERIORATION	THROUGHOUT		MODERATE		
HORIZONTAL CRACKS	THROUGHOUT		MANY		
REBAR EXPOSED	THROUGHOUT		FEW		(ELSEMJ, 03/28/2024)ADV SEC LOSS IN OUTER BAR ONE OUTER BAR RUSTED
					IN TWO.
					MOD SEC LOSS IN SECOND ROW OF REBAR.
SPALLS	THROUGHOUT		MINOR		
COLUMN	REINFORCED CONCRETE	CAST-IN-PLACE			
<u>CONDITION</u>	<u>LOCATION 1</u>	<u>LOCATION 2</u>	<u>SEVERITY</u>	<u>MEASUREMENT</u>	<u>COMMENT</u>
REBAR EXPOSED	COLUMN		FEW		
SPALLS	COLUMN		MODERATE		
FOOTING	REINFORCED CONCRETE	H-PILE			
<u>CONDITION</u>	<u>LOCATION 1</u>	<u>LOCATION 2</u>	<u>SEVERITY</u>	<u>MEASUREMENT</u>	<u>COMMENT</u>
STRAIGHT WINGS	REINFORCED CONCRETE	CAST-IN-PLACE			
<u>CONDITION</u>	<u>LOCATION 1</u>	<u>LOCATION 2</u>	<u>SEVERITY</u>	<u>MEASUREMENT</u>	<u>COMMENT</u>
FIXED BEARING	STEEL	CURVED PLATE(ROTATING)			
<u>CONDITION</u>	<u>LOCATION 1</u>	<u>LOCATION 2</u>	<u>SEVERITY</u>	<u>MEASUREMENT</u>	<u>COMMENT</u>
PACK RUST	THROUGHOUT		MODERATE		
		OVER ADDED DOUBER OF EAR		3.5.1 m x 0.3 x 1.1 1	

OVER/UNDER ROUTES CLEARANCE INFORMATION

CLEARANCES OVER DECK

**NOTE: Vertical clearances for permitting purposes are taken as 2 inches less than the actual field measured clearance.

VERTICAL CLEARANCE TYPE**

VALUE

DIRECTION

DATE

COMMENT

Missouri Department of Transportation
State Bridge Inspection Report

April 29, 2025
1:37:14PM

COUNTY: HOWARD

ROUTE

MoDOT

RECORD #

CLEARANCES UNDER BRIDGE

DISTRICT: CD

LANES

DIRECTION OF TRAFFIC

**NOTE: Vertical clearances for permitting purposes are taken as 2 inches less than the actual field measured clearance.

CLASS: STATBR

RIGHT LATERAL CLEARANCE

FED-ID: 6009

LEFT LATERAL CLEARANCE

BRIDGE: K0962

UR-ID

13345 KSC RR 8 FT 6 IN **VERTICAL CLEARANCE TYPE** VALUE DIRECTION DATE COMMENT** 22 FT 6 IN **PLANNED** ***STRUCTURE PAINT INFORMATION*** **CONDITION: RUST AMOUNT:** STEEL TONS: 0 **ORIGINAL PAINT CONTRACT REPAINT** DEPARTMENT REPAINT **PAINT TYPE:** PAINT TYPE: **PAINT TYPE: MANUFACTURE:** NAME: NAME: NAME: **SURFACE PREP: PAINT COLOR: PAINT COLOR: PAINT COLOR: PAINT YEAR: PAINT YEAR: PAINT YEAR:** MILS: MILS: MILS: ***REQUESTED WORK ITEMS*** **GENERAL WORK COMMENTS: LOCATION PRIORITY DATE** RESPONSIBILITY **ITEM CATEGORY WORK ITEM COMMENT** DISTRICT ROUTINE ROADWAY SURFACE REPAIR CONCRETE > 50 SF **DECK** 11/08/2017 3 3 DISTRICT SPECIAL ROADWAY SURFACE **DECK** 08/17/2024 SEAL DECK WITH IN DECK ***UTILITY ATTACHMENTS*** **UTILITY OWNER METHOD MEASUREMENT TYPE** UTILITY ATTACHMENT COMMENT **VALUE NUMBER** ***PROGRAM NOTES INFORMATION*** PROJECT# **MONTH LET** YEAR LET **ITEMS COMMENT YEAR**



Missouri Department of Transportation State Bridge Inspection Report

April 29, 2025 1:37:14PM

COUNTY: HOWARD DISTRICT: CD CLASS: STATBR FED-ID: 6009 BRIDGE: K0962

COUNTY: HOW	VARD DISTRICT: CD	CLASS: STATBR	FED-1D: 0009	BRIDGE: KU902		
COMP	UTER GENERATED RATINGS AND D	EFICIENCY ITEMS		***ADVANCED S	IGN INFORMATION*	**
NOTE: The items listed in this section are u	updated whenever computer edits are ran on a structu	re after the inspection updates have been entered in to TMS.	SIGN#	SIGN TYPE	PROBLEM	PROBLEM DIRECTION
Rated Item	Rating	Rating Date	1			
[Item 67] Structure Evaluation Rating:	5-BETTER THAN MINIMUM	3/19/2002				
[Item 68] Deck Geometry Rating:	4-MEETS MINIMUM TOLERABLE	12/29/2004				
[Item 69] Underclearance:	4-MEETS MINIMUM TOLERABLE	2/20/2003				
Sufficiency Rating:	56.7%	3/29/2024				
Deficiency:	STRUCTURAL	10/4/2019				
Funding Eligibility:	PARTIAL			***OUTFALL INSPE	CTION INFORMATIO	N***
Estimated New Structure Length:	256 FT.				7.07.07	
Estimated Structure Cost:	\$1,113,938		# OUTFALLS:	INSP	ECTOR:	
Estimated Total Project Cost:	\$1,670,907		STATUS:		DATE:	
Year of Cost Estimate:	2025		NOTES:			
generalized to use NBI items to come up with	estimates are computer generated using algorithims in a new structure length and width to calculate a new st may vary significantly from these numbers once significantly from the numbers of the numb	area which is taken times a representative cost per				





Missouri Department of Transportation Bridge Inventory and Inspection System Structural Inventory & Appraisal Sheet

COUNTY: HOWARD K0962 REVIEW STATUS: APPROVED T **BRIDGE:** NBI STATUS: 4/18/2025 2025 ROUTE CARRIED 'ON' STRUCT **RECORD TYPE: RUN DATE: SUBMITTAL YEAR:** GENERAL STRUCTURE INFORMATION ROUTE DESIGNATION INFORMATION ROUTE CARRIED 'ON' STRUCT State MISSOURI 5A Record Type MO District 5B CD Route Signing Prefix MAINLINE HOWARD County 5C Designated Level of Service 00003 6009 8 Federal ID No. 5D Route Number 1941 NOT APPLICABLE 27 5E Year Built Directional Suffix MO3S 106 0 7 Year Reconstructed Facility Carried NO HIGHWAY-PEDESTRIAN Type of Service On 12 Base Hwv. Network STATE HIGHWAY AGENCY 21 Structure Maintenance 13A LRS Inventory Route No. STATE HIGHWAY AGENCY 22 Structure Owner 13B Subroute No. 33 NO MEDIAN ON FREE ROAD Br. Median Code 20 Toll Status 07-RURAL MAJOR COLLECTOR 37 Historical Significance NOT ELIGIBLE FOR NR OF HP 26 Functional Classification NONE EXISTS 101 28A Parallel Struc Desg Lanes on Structure NOT TEMPORARY Temporary Structure 103 RTE NOT A DEFENSE HWY 100 STRAHNET Designation NBIS Bridge Length YES NOT ON NHS 104 National Highway System NOT APPLICABLE 105 Federal Lands Highway NO 110 Designated Nat. Network STRUCTURE LOCATION INFORMATION STRUCTURE TRAFFIC INFORMATION 1775 4 Place ARMSTRONG CITY 29 AADT 01954 2024 Code 30 AADT Year 2-WAY TRAFFIC S 34 T 52 N R 16 W Location 102 Direction of Traffic 11 Milepoint 69.73 miles 17% 109 AADT Truck Percent 16 Latitude 39 D 15 M 59 S 2219 114 Future AADT 17 Longitude 92 D 42 M 4 S 2044 115 Future AADT Year UNDERRECORD INFORMATION STRUCTURE GEOMETRIC INFORMATION KSC RR 10 99 Ft. 99 In. Features Intersected Inventory Rte. Vert. Clear 42B 19 21.88 miles Type of Service Under RAILROAD By pass Detour Length 28B Lanes Under Structure 00 32 Approach Roadway Width 25 Ft. 11 In. RAIL ROAD 42.00 Degrees 54A Vert. Clearance Ref. 34 Skew 54B Vert. Clearance 35 Struct. Flared 22 Ft. 6 In. Rt. Lat Clear Ref. RAIL ROAD Total Horiz. Clear 25 Ft. 11 In. 55A 47 55B Rt. Lat Clearance 8 Ft. 6 In. 48 52 Ft. 6 In. Maximum Span Length 223 Ft. 1 In. 0 Ft. 0 In. Left Lat Clearance 49 Structure Length N/A Navigation Control 50A 4 Ft. 11 In. Left Curb/Sidewalk Width Nav Vertical Clear 0 Ft. 0 In. 39 50B Right Curb/Sidewalk Width 0 Ft. 0 In. 0 Ft. 0 In. Curb to Curb Br. Width 25 Ft. 11 In. 40 Nav Horizontal Clear 51 29 Ft. 6 In. Nav. Pier Protection Deck Width (Out-Out) 111 52 Nav. Cl. Vert. Clear 99 Ft. 99 In. 53 Vert.Clearance Over Deck





Missouri Department of Transportation Bridge Inventory and Inspection System Structural Inventory & Appraisal Sheet

COUNTY: HOWARD BRIDGE: K0962 REVIEW STATUS: APPROVED NBI STATUS: T

RECORD TYPE: ROUTE CARRIED 'ON' STRUCT RUN DATE: 4/18/2025 SUBMITTAL YEAR: 2025

RECORD TYPE: ROUTE CARRIED ON STRUCT	RUN DATE: 4/10/2023 SUDMITTAL YEAR: 2023
LOAD RATING AND POSTING INFORMATION	MATERIAL/CONSTRUCTION INFORMATION
31 Design Load	43A Main Struc. Mat type CONCRETE 43B Main struc Constr. Type TEE BEAM 45 # of Main Spans 5 44A Appr Struc. Mat type 000 44B Appr Struc. Cnstr. type 000 46 # of Approach Span 0 107 Deck Mat/Constr. 1 CONCRETE CIP 108A Wear Surf Mat/Constr. 6 BITUMINOUS
Sufficiency Rating 56.7 Percent Deficiency Rating STRUCTURAL Funding Eligibility PARTIAL	108B Membrane Mat/Constr. 0 NONE 108C Deck Protect Mat/Constr. 0 NONE
Funding Eligibility PARTIAL 75A Proposed Work REHAB-GENERAL DETERIORAT 75B Work Done By Contract 76 New Struc Length 255 Ft. 11 In. 94 Struc Improve Cost \$1,114,000 95 Roadway Improve Cost \$111,000	CONDITION RATING INFORMATION 58 Deck Cond. Rating 3 59 Superstructure Cond. Rating 5 60 Substructure Cond. Rating 6 61 Channel /Channel Protection Cond. Rating N 62 Culvert Cond. Rating N
96 Total Project Cost \$ 1,671,000 97 Year of Cost Estimates 2025	INSPECTION INFORMATION
APPRAISAL RATING INFORMATION 36A Br. Rail App. Rating DOES NOT MEET ACCEPT STND 36B Transition Rail App. Rating DOES NOT MEET ACCEPT STND 36C Approach Rail App. Rating DOES NOT MEET ACCEPT STND 36D Rail End Treat. App. Rating DOES NOT MEET ACCEPT STND 5 Struc Eval App. Rating 5 68 Deck Geometry App. Rating 4 69 Underclearance App. Rating 4 71 Waterway Adeq. App. Rating N 72 Approach Road App. Rating 6 113 Scour Assess App. Rating N	90 Gen. Insp Date 6 / 23 91 Gen. Insp. Frequency 24 Months 92A Frac. Critical Inspection N Months 93A Frac. Critical Insp. Date 92B Underwater Inspection N Months 93B Underwater Insp. Date 92C Special Inspection N Months 93C Special Inspection Date BORDER BRIDGE INFORMATION 98 Neighboring State Code 98B Neighboring State % Respon 99 Neighboring State Struc. No.
APPROVED POSTING INFORMATION	FIELD POSTING INFORMATION
Approved Posting Category S-1 Ton1 Ton2 Ton3 Tonnage Values for Posting Sign General Text for Posting Sign NO POSTING REQUIRED	Field Posting Category S-1 Ton1 Ton2 Ton3 Tonnage Values for Posting Sign General Text for Posting Sign NO POSTING REQUIRED

 $Design_No = k0962$

Bridge Number:	Route/County:
K0962	3/Howard
Yes: If yes, see repor	Material Present? No: To for location(s). The seed Present? No: N
163.	If No, then skip the following
Lead-Based Pair Yes:	nt (LBP) Present? No:
Trusses LBP?	Girder LBP?
Yes: No:	Yes: No:
Railing LBP?	Pile LBP?
Yes: No:	Yes: No:

MEMORANDUM



Missouri Department of Transportation Construction and Materials Central Laboratory

TO:

TMS

FROM:

Diane Roegge

Environmental Chemist

DATE:

June 16, 2016

SUBJECT:

Materials

Asbestos Inspection & Heavy Metal Paint Survey

Route 3

Bridge K-0962 Howard County

We are providing you with the results of the inspection on the above referenced bridge. The inspection report contains an asbestos and a heavy metals survey. The asbestos inspection included identifying suspect asbestos-containing material and NVLAP accredited testing to confirm the presence of asbestos.

Form T746 – This will show if samples were taken, where from, and, if the sample was found to contain asbestos, our estimated quantity of material present. Under the column "Friability Category", this is the meaning for the following:

N-ACM – No asbestos detected.

I NF – Asbestos is present. Material shall be handled carefully by a licensed abatement worker and kept wet if removing as part of a maintenance activity.

II NF – Asbestos is present. If removal is required for the maintenance activity, use an abatement contractor.

In accordance with Missouri Department of Natural Resources' Technical Bulletin "Managing Construction and Demolition Waste" dated January 31, 2003, a heavy metal paint survey has been performed on the above referenced bridge. This survey includes locating concrete which has been painted with something other than traffic paint or graffiti, and testing the painted surface(s) to determine if hazardous heavy metals are present. If the bridge is being removed completely, or the maintenance repairs include removing the painted concrete, then, non-hazardous painted concrete may be used as clean fill materials, if properly handled. You must contact the Central Office Design Division for proper handling of the reported painted surfaces.

Although our survey included observing and sampling all accessible areas, it is possible that potentially hidden asbestos-containing materials may exist within the structure. Should you have any questions regarding these reports, please contact me at (573) 526-4359.

db/fr/dr

 $http://sp/sites/cm/chemicallab/environmental/shared\ documents/asbestos/districts/central\ (cd)/mt/k0962/dr1606162.docx$

Attachments

Form T746 Rev. 08/2012

MISSOURI DEPARTMENT OF TRANSPORTATION CONSTRUCTION AND MATERIALS Asbestos Survey Report All Suspect ACM

ROUTE: MODOT JOB NO.: DISTRICT: COUNTY: DATE OF SURVEY: PARCEL NO.:	:: N/A N/A CD Howard June 16, 2016 Bridge K-0962	SURVEYED BY: CERTIFICATION #: SITE ADDRESS: TYPE(S) OF STRUCTURE(S): Bridge	Diane Roegge 7118110315MOIR7165 Over Kansas City Southern Railroad (KCS RR) Bridge	nd (KCS RR)	
Sample ID	Type of Materials	Location of Material	f Material	Friability Category	Field Measu
16MD1R 400	Asphalt Joint Material	8-Sidewall, 4-Deck and Sidewalk, and 4-Curb Joints	llk, and 4-Curb Joints	N-ACM	
	Bridge Paint is not a suspect ACM per MSDS's				
	on file.				
				20	

MISSOURI DEPARTMENT OF TRANSPORTATION CONSTRUCTION AND MATERIALS

Asbestos Survey Report

Nonfriable Asbestos-Containing Materials (Abatement not required if not made friable during demolition.)

ROUTE: MODOT JOB NO.: DISTRICT:	3 N/A CD	TESTED BY: CERTIFICATION #: CERTIFICATION #:	Frank Reichart and Diane Roegge 7118110315MOIR7165, D.R. 7118110315MOIR11239, F.R.	D.R.		
COUNTY:	Howard	SITE ADDRESS:	Over Kansas City Southern Railroad (KCS RR)	ern Railroad (Ko	CS RR)	
PARCEL NO.:	Bridge K-0962	TYPE(S) OF STRUCTURE(S):	Bridge			
Sample ID	Type of Material	Location of Material	Friability Category	Field Measure	Asbestos Type	Percen
		None Located	INF			
			i de			

All necessary work to handle this material is the contractor's responsibility.

MISSOURI DEPARTMENT OF TRANSPORTATION CONSTRUCTION AND MATERIALS

Asbestos Survey Report
All materials requiring removal or special handling.

MODOT JOB NO.: COUNTY: DISTRICT: ROUTE: PARCEL NO.: DATE OF TESTS: Item No. Sample ID CD N/A Bridge K-0962 June 28, 2016 Howard Type of Material None Located None Located SITE ADDRESS: CERTIFICATION #: CERTIFICATION #: TYPE(S) OF STRUCTURE(S): TESTED BY: Location of Material 7118110315MOIR11239, F.R. Frank Reichart and Diane Roeggel 7118110315MOIR7165, D.R. Over Kansas City Southern Railroad (KCS RR) Category Friability IINF Measure Field Asbestos Type Percent

MISSOURI DEPARTMENT OF TRANSPORTATION CONSTRUCTION AND MATERIALS

Metals Survey Report of Painted Concrete, Block, Brick Surfaces for Clean Fill Purposes

MODOT JOB NO.: DISTRICT: COUNTY: SURVEYED BY: DATE OF SURVEY:	N/A CD Howard Diane Roegge June 16, 2016	TESTED BY: DATE OF TESTS: PARCEL NO.: SITE ADDRESS: TYPE(S) OF STRUCTURE(S): Bridge Over K	Y: TESTS: IO.: F STRUCT	URE(S): BIO	N/A N/A Bridge K-0962 Over Kansas City Southern Railroad (KCS RR) Bridge	ity Southern	Railroad (K	CS RR)	
					(p)	Metals (ppm)			
Sample ID	Color/Location of Material/Substrate No samples taken. No painted surfaces located.	As	Cr	Pb	Cd	Se	Ba	Hg	Ag

