

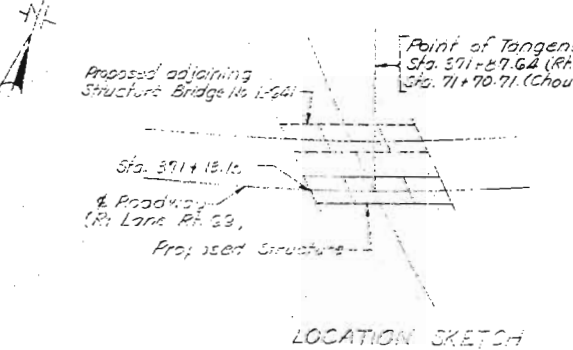
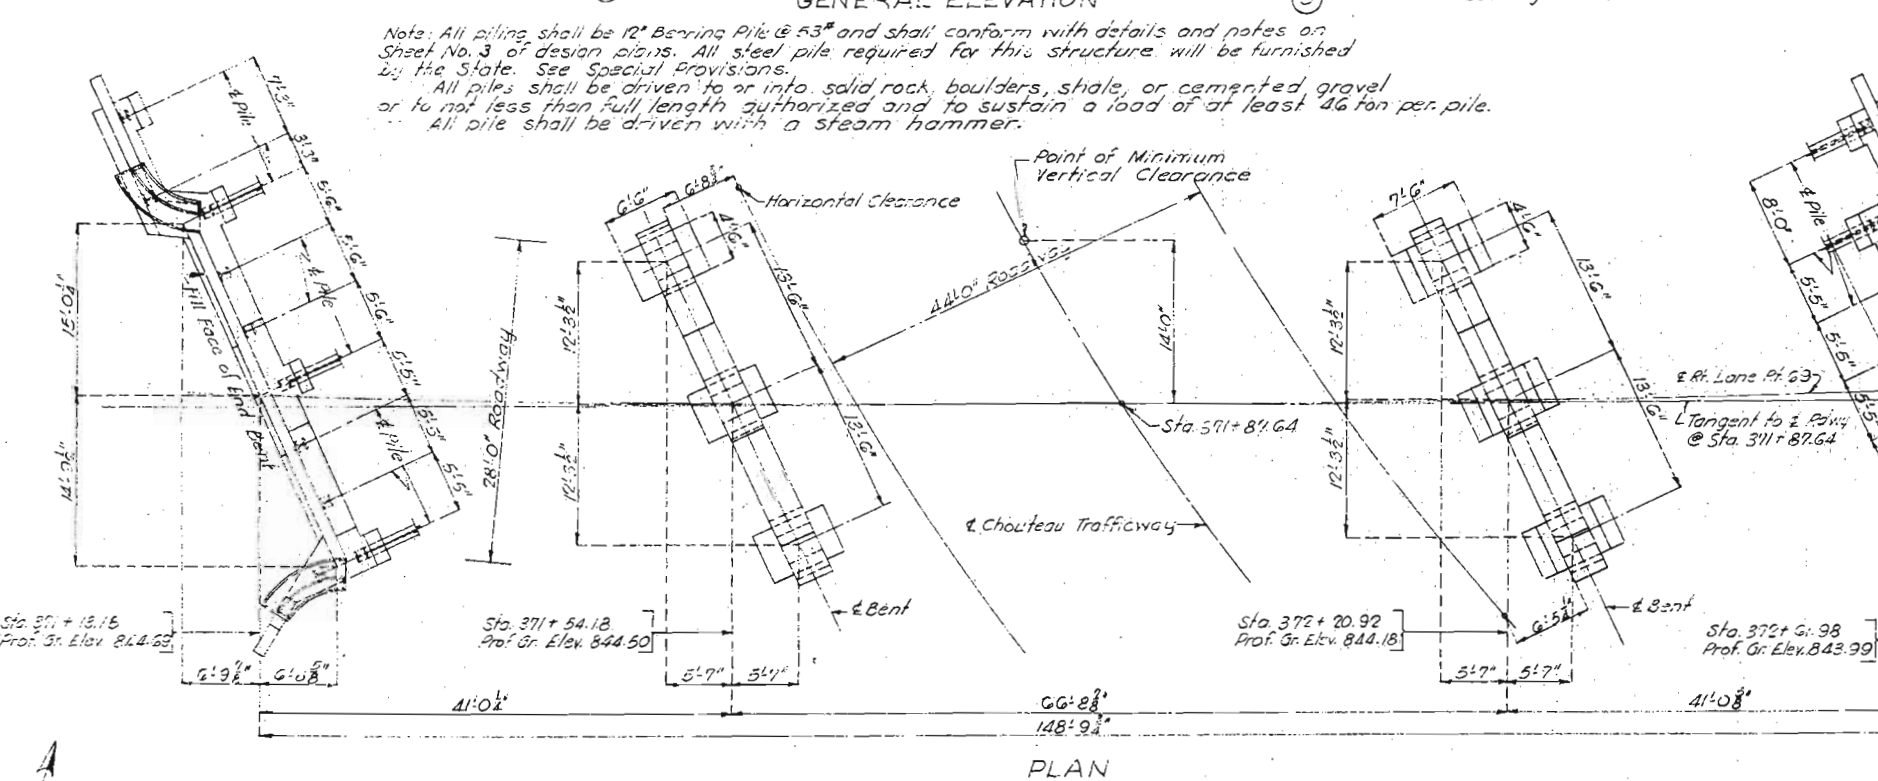


MISSOURI STATE HIGHWAY DEPARTMENT

FED. ROAD DIST. NO.	STATE	FED. AID PROJ. NO.	FISCAL YEAR	SHEET NO.	TOTAL SHEETS
5	MO.	U.S. 99-7 (RT 69)	19		

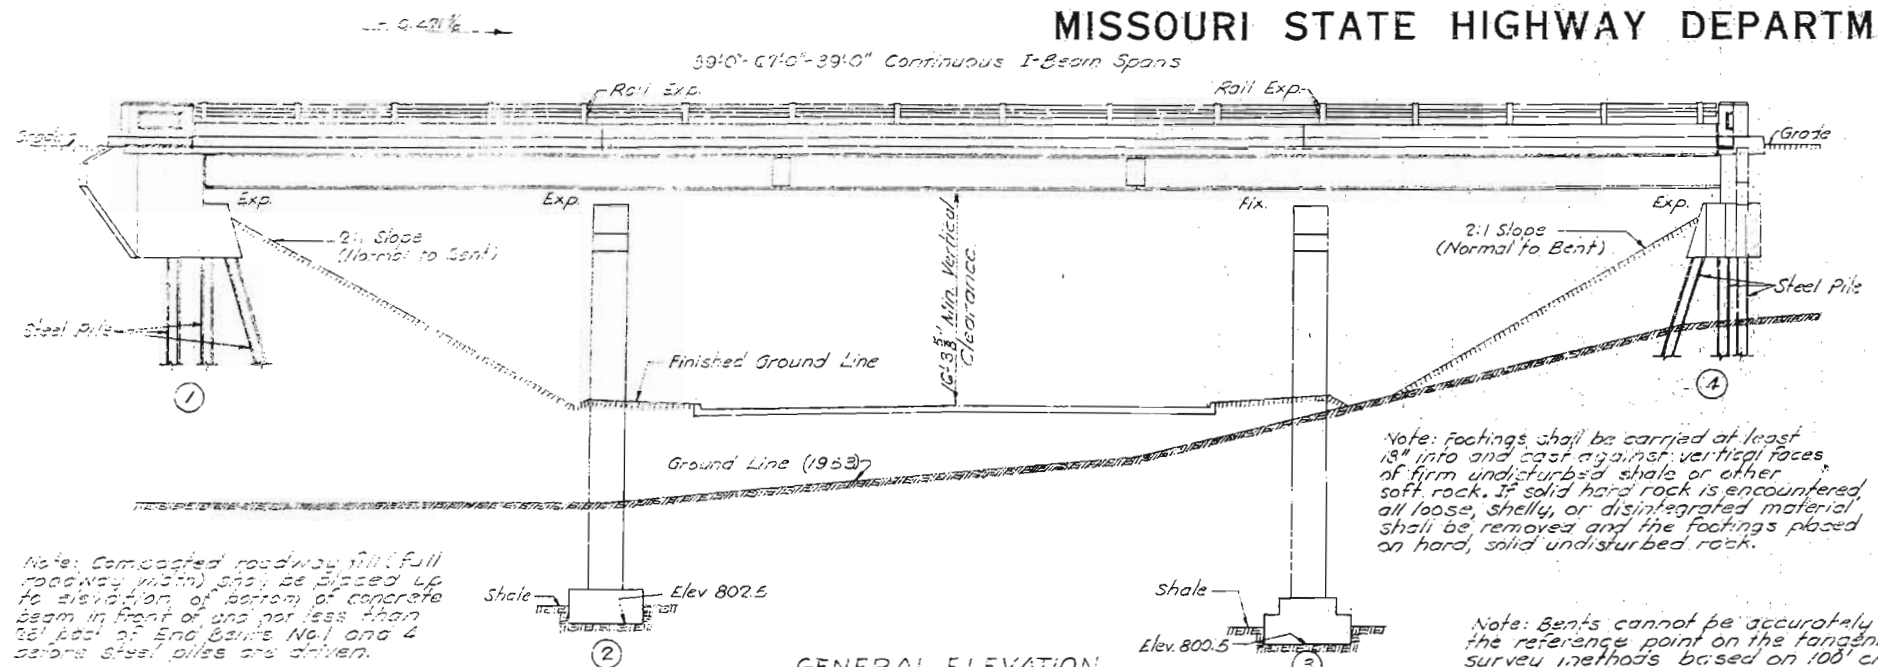

CURVE DATA (Rt. Lane)
 P.C. 370+22.60
 Δ 26° 14' 05" L
 R 2316.93
 T 650.13
 L 1336.53
 D 1° 57' 46.7359"
 SE = 0.03'/ft.

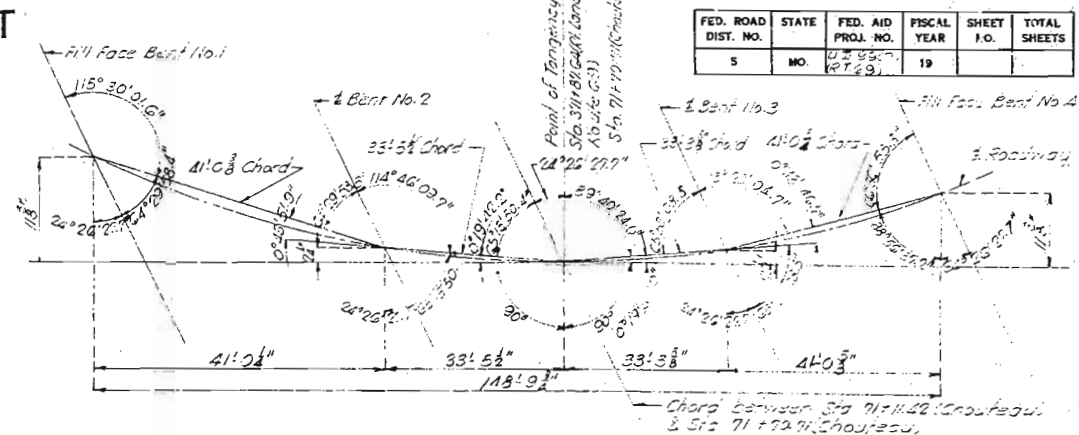

GENERAL NOTES:

Design Specifications A.A.S.H.O. 1952
 Loading H 20-S16-44
 Reinforcing Steel Stress 18,000 psi
 Structural Steel Stress 18,000 psi
 Class "B" Concrete Stress 1,000 psi
 All concrete shall be Class "B" (Air Entrained)
 Where joint filler is specified on plans it shall conform with the requirements for Gray Rubber Compound Joints as given in Section 33-13.42 of the Standard Specifications.
 For requirements on welding electrodes see Special Provisions.
 Qualification of welding operators will be required.
 Surfaces of piers at Bents No. 1 & 4 from bottom of concrete cap to 30" below bottom of concrete cap shall be painted with one coat of an approved brand of emulsified asphalt paint. Payment for excavating ground piled to 3' below bottom of cap and backfilling same, furnishing emulsified asphalt paint and cleaning and painting steel surfaces specified will be included in the unit price bid for other items.
 A rubbed surface finish will be required on all exposed surfaces of concrete and posts above top of curb.
 Rivets 3/4" holes 1/2" except as noted.
 Field connections shall be riveted or if the Contractor desires he may use high tensile steel bolts with corrugated washers in place of rivets. (See Special Provisions).
 Paint: Shop, name, field, contact surfaces of casting connections one coat of red lead and surfaces inaccessible after erection three coats of red lead. All other exposed surfaces first coat red lead, second coat brown, third coat aluminum. Payment for cleaning and painting such surfaces will be included in price bid for items painted.

ESTIMATED QUANTITIES				
Item	Substr.	Supersr.	Total	
Class I Excavation for Structures	Cu. Yds.	290		290
Class "B" Concrete	Cu. Yds.	183.6	150.4	339.0
Fabricated Structural Steel	Lbs.		112,900	112,900
Aluminum Alloy Handrail	Lin. Ft.		292	292
Steel Castings	Lbs.		5220	5220
Reinforcing Steel	Lbs.	22,360	32,980	55,340
Steel Pile in place (State Furnished)	Lin. Ft.	792		792

Note: Concrete in end posts is included in Estimated Quantities of Class "B" Concrete for Substructure.
 All excavation for bridge will be paid for as Class I Excavation for Structures.

3.11'±20 Elev. 852.63 "on N.W. Wingwall" Conc. Sulk Sta. 374+87

BRIDGE OVER CHOUTEAU TRAFFICWAY
 STATE ROAD FROM ARMOUR ROAD IN NORTH KANSAS CITY N.E.
 ABOUT 3.75 MILES NORTH OF NORTH KANSAS CITY
 PROJECT NO. UI-99(7) (RT 69) STA. 371+0.15 (RIGHT LANE)

CLAY COUNTY

SUBMITTED BY J. A. Williams DATE 7/19/1954
 APPROVED BY R. M. Whitton DATE 7/19/1954

FINISHED
 STD. C-10-R3
 L-6-42

Drawn May 1952 by M.E.L.
 Checked June 1954 by H.B.B. & R.A.L.


Note: This drawing is not to scale. Follow dimensions.

FINISHED
 Sheet No. 1 of 9

SEE FINAL PLANS BROWN LINES

MISSOURI STATE HIGHWAY DEPARTMENT

FED. ROAD DIST. NO.	STATE	FED. AID PROJ. NO.	FISCAL YEAR	SHEET NO.	TOTAL SHEETS
5	MO.	US-99(7) (67-69)	15		

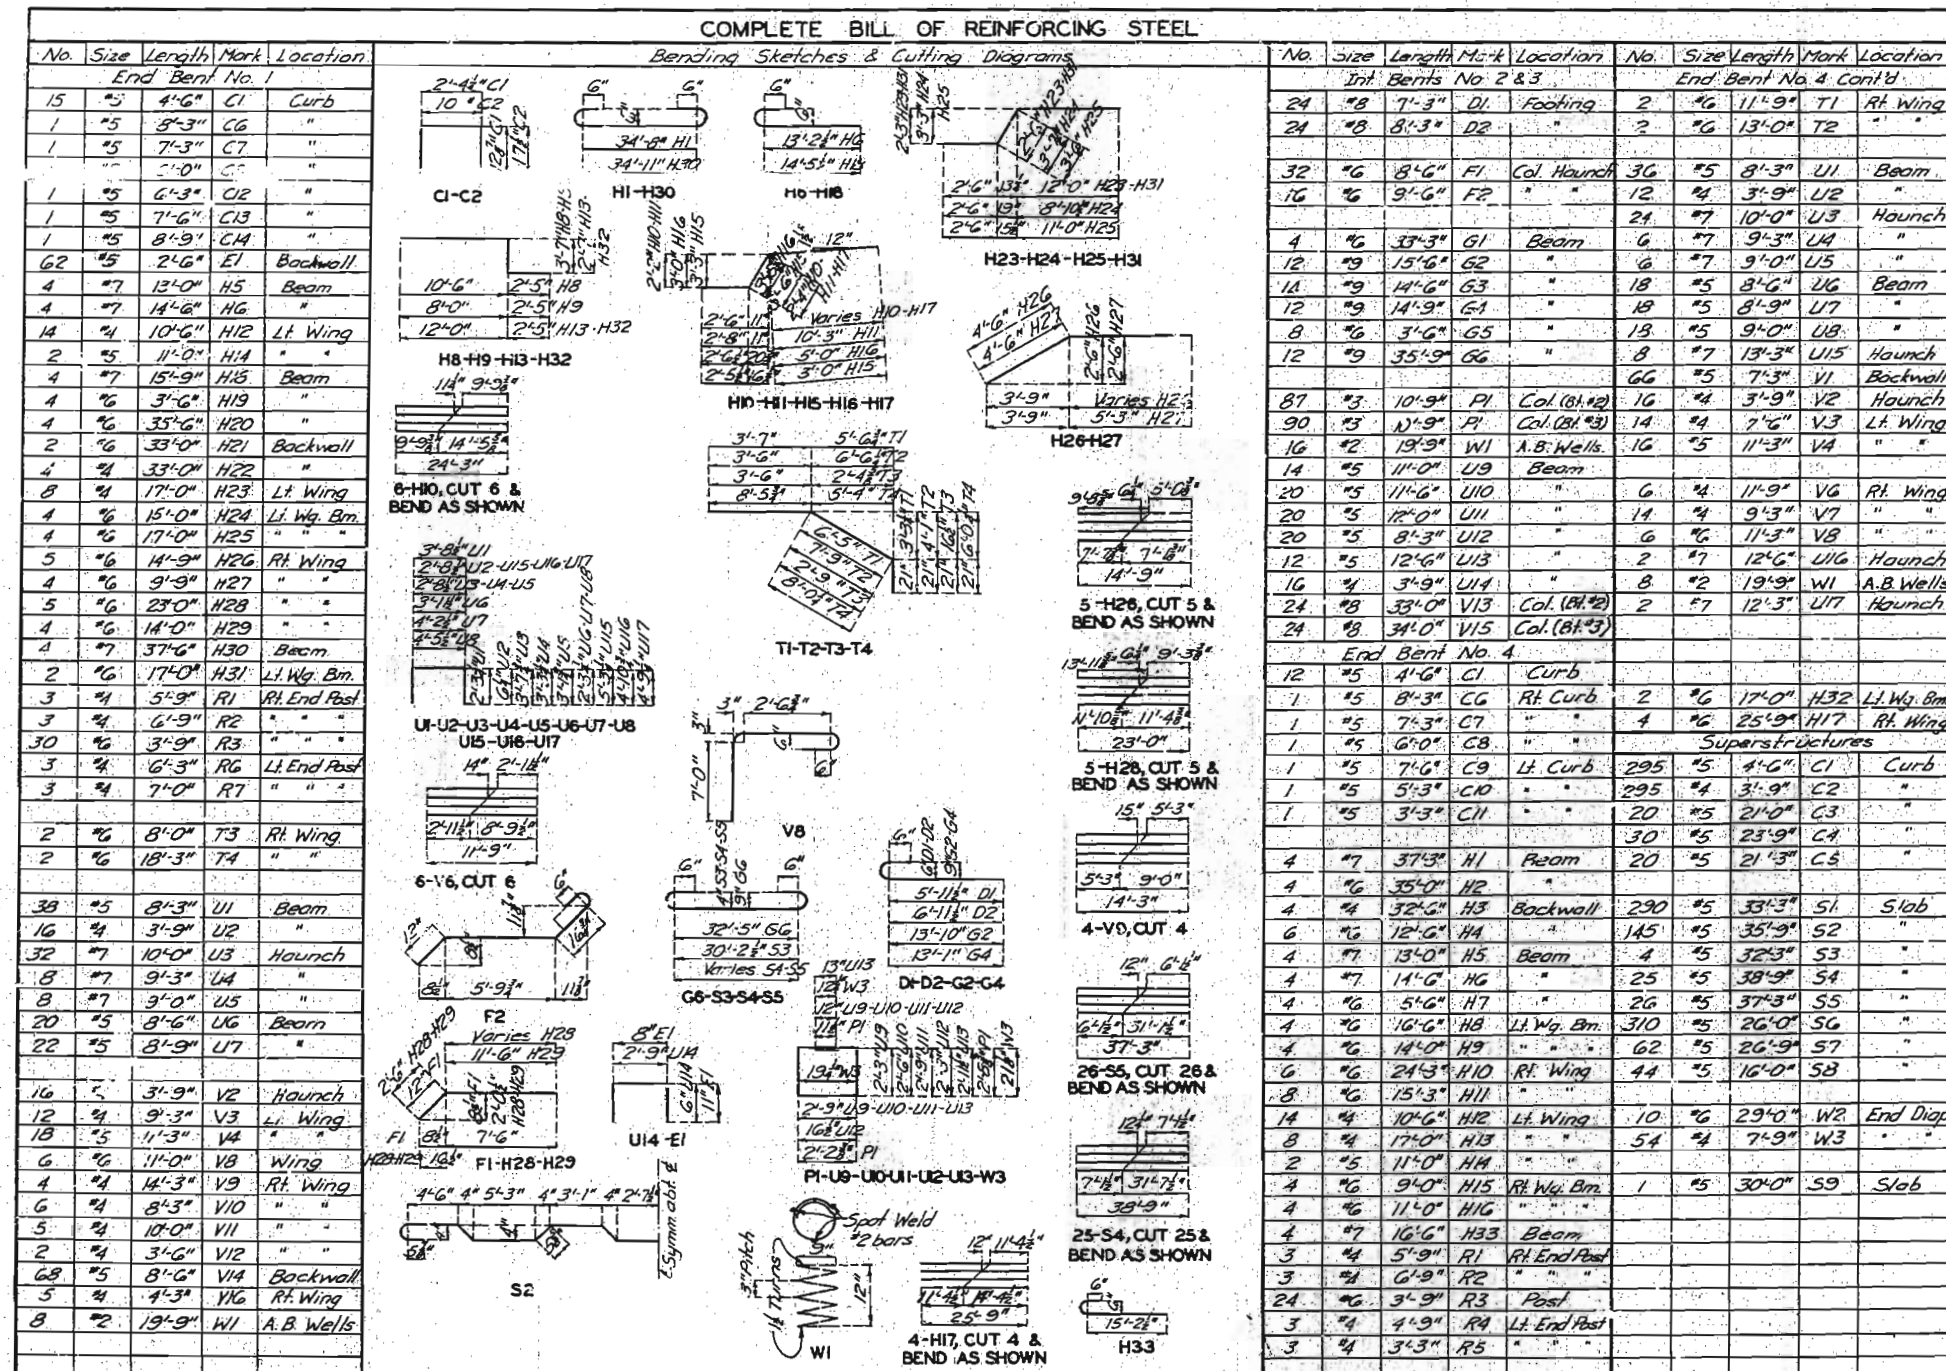

BRIDGE OVER CHOUTEAU TRAFFICWAY
 STATE ROAD FROM ARMOUR ROAD IN NORTH KANSAS CITY N. E.
 ABOUT 3.75 MILES NORTH OF NORTH KANSAS CITY
 PROJECT NO. U-99(7) (RT. 69) STA. 371+13.15 (RIGHT LANE)

CLAY COUNTY

L-642


Sheet No. 2 of 9.

Note: This drawing is not to scale. Follow dimensions.

Drawn May 1954 by M.H.P.
 Checked June 1954 by H.R.B.

MISSOURI STATE HIGHWAY DEPARTMENT



FED. ROAD DIST. NO.	STATE	FED. AID PROJ. NO.	FISCAL YEAR	SHEET NO.	TOTAL SHEETS
5	MO.	01-99(1) (R.L. 62)	19		

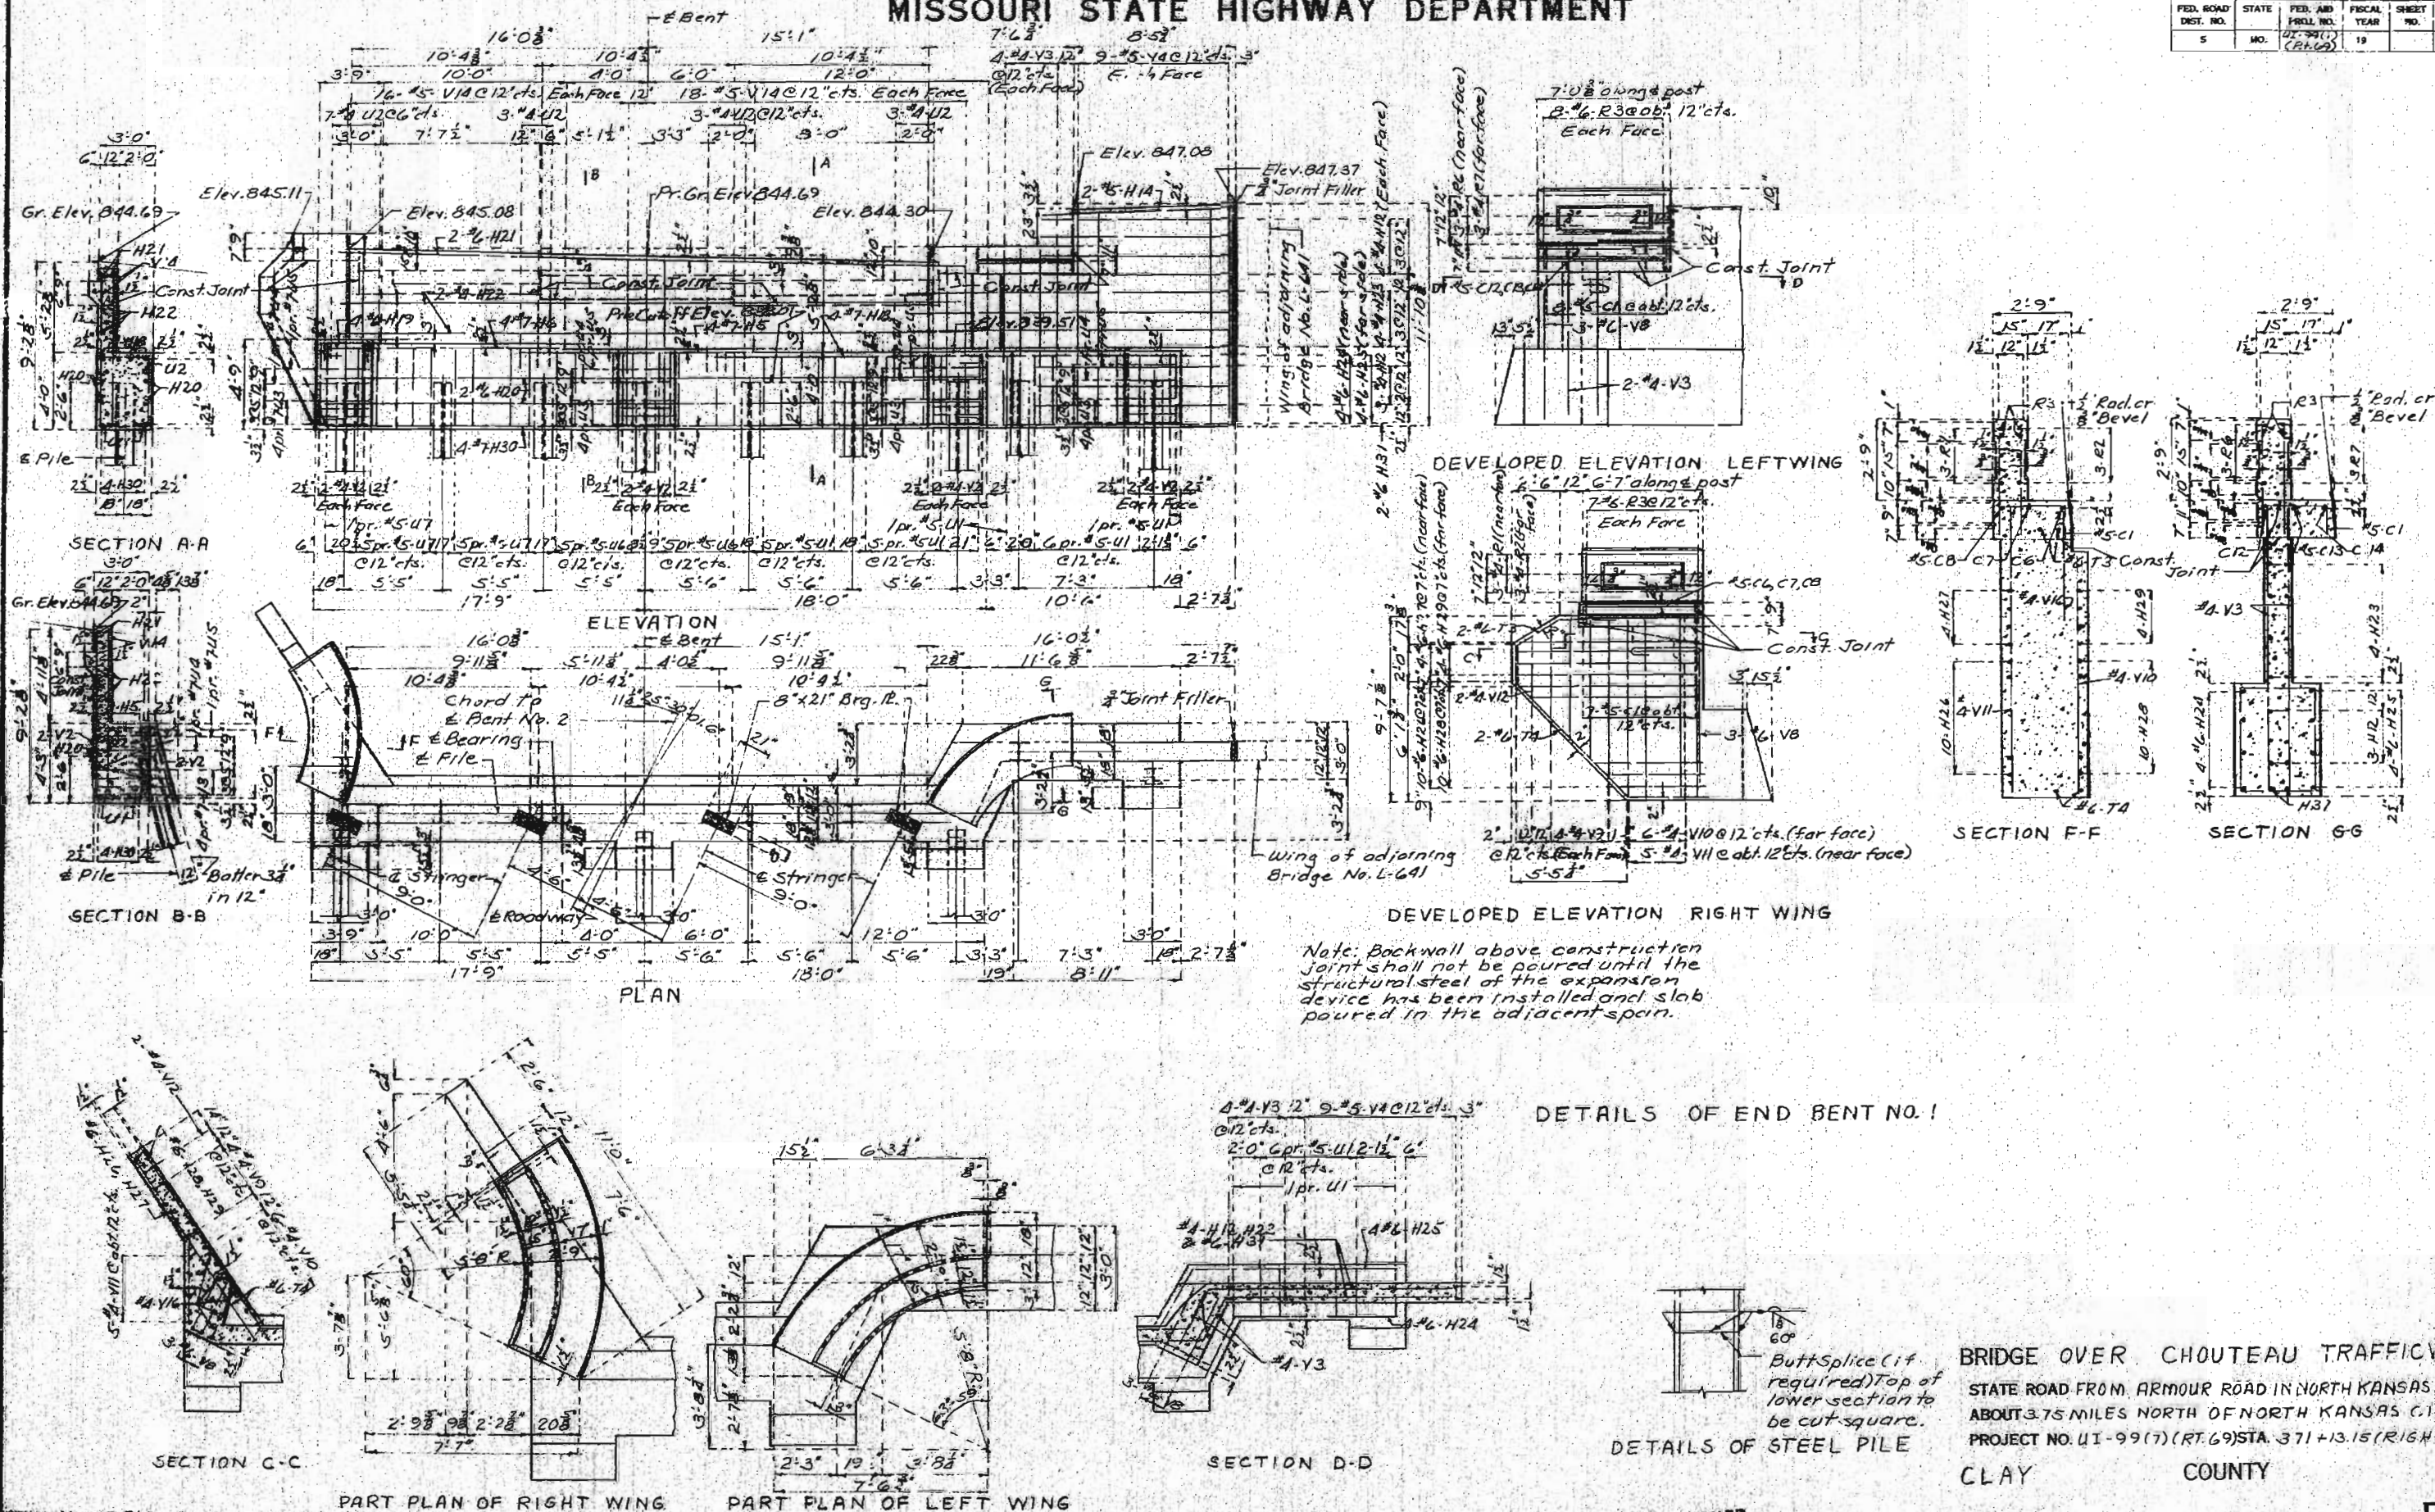

BRIDGE OVER CHOUTEAU TRAFFICWAY
 STATE ROAD FROM ARMOUR ROAD IN NORTH KANSAS CITY N.E.
 ABOUT 3.75 MILES NORTH OF NORTH KANSAS CITY
 PROJECT NO. 01-99(1) (RT. 69) STA. 371+13.15 (RIGHT LANE)
 CLAY COUNTY
 FINISHED
 L-642

NO CONSTRUCTION CHANGES

FED. ROAD DIST. NO.	STATE	FED. AID PROJ. NO.	FISCAL YEAR	SHEET NO.	TOTAL SHEET
5	MO.	41-9970	19		

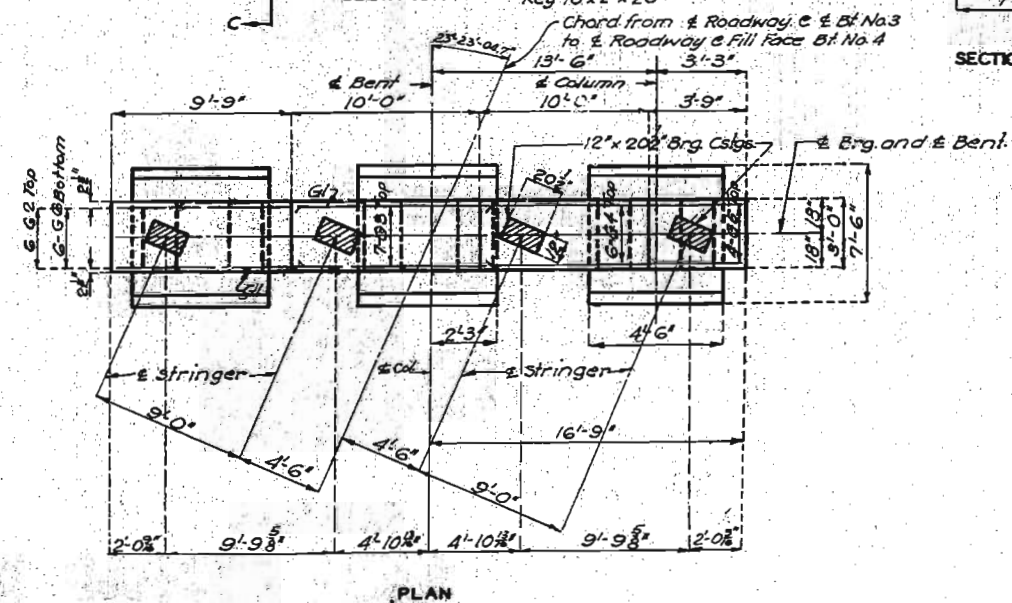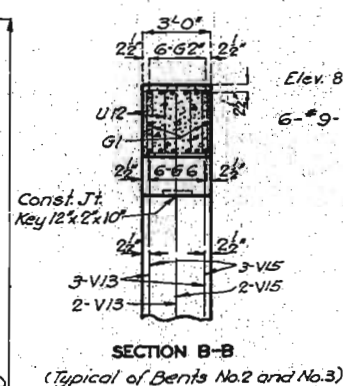

DETAILS OF INTERMEDIATE BENT, NO.3

STATE ROAD FROM ARMOUR ROAD IN NORTH KANSAS CITY N.E.
ABOUT 3.75 MILES NORTH OF NORTH KANSAS CITY
PROJECT NO. UI-99C7 (RT. 69) STA. 371+13.15 (RIGHT LANE).

FINISHED


Note: This drawing is not to scale. Follow dimensions.

Sheet No 4 of 9.

2 or 3 Col. Int. } All Loadings
Square or Skewed }

L-642

FED. ROAD DIST. NO.	STATE	FED. AID PROJ. NO.	FISCAL YEAR	SHEET NO.	TOTAL SHEETS
5	MO.	02-9971 (Rt. 69)	19		

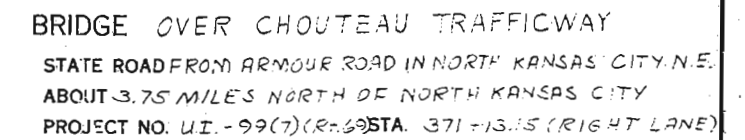



L-642

NO CONSTRUCTION CHANGES

MISSOURI STATE HIGHWAY DEPARTMENT

FED. ROAD DIST. NO.	STATE	FED. AID PROJ. NO.	FISCAL YEAR	SHEET NO.	TOTAL SHEETS
5	MO.	UI-99(7) (RT. 69)	19		

Note: Dimensions given thus () for beams are horizontal lengths from centerline of bearings to centerline of bearings, from centerline of bearing to centerline of splices or from centerline of splices to centerline of splices.
All centerlines of bearings and centerlines of splices shown are parallel to each other throughout the length of the bridge. Beams (1-A) and Chord (1-2) are parallel and Beams (6-A) and Chord (3-4) are parallel. Beams (A-B) are not parallel.
Elevations given over centerline of bearings and splices are for top of beams.

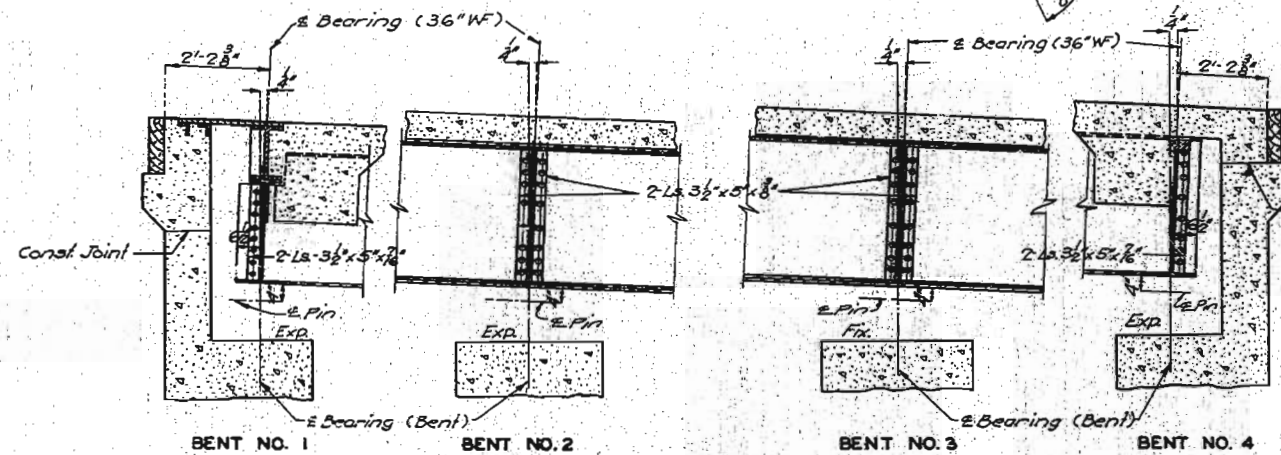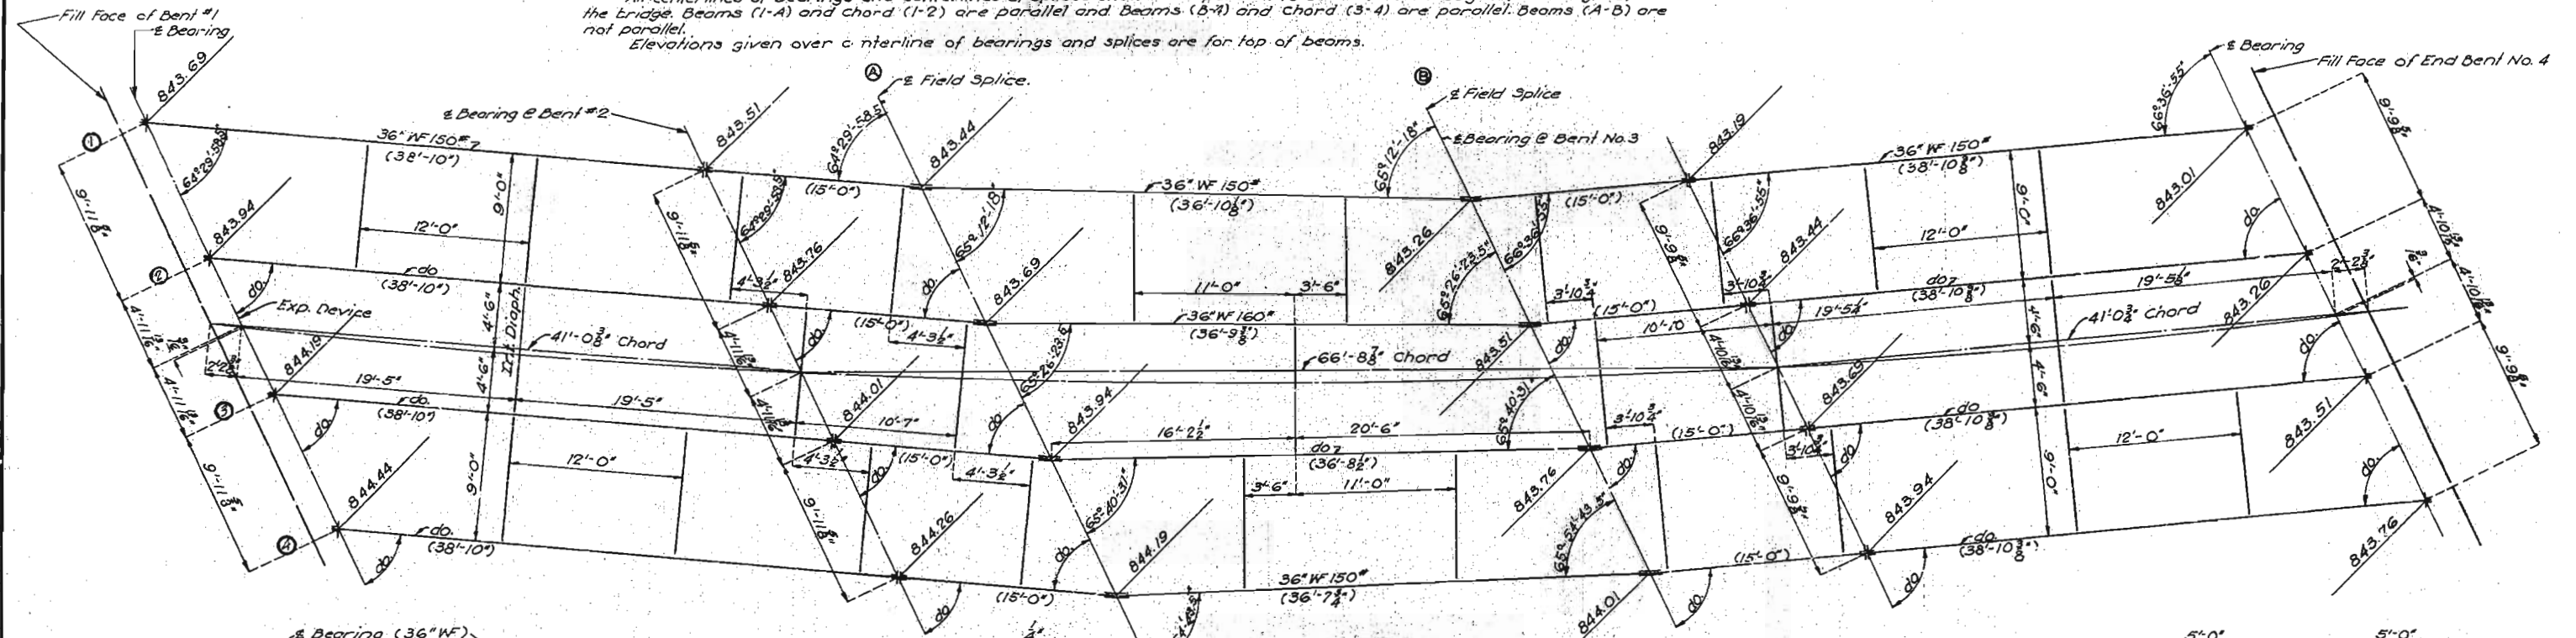


3/4" Bolt 6 1/2" long,
Thread 3" long,
C 61.3" O.D.
Square head




3/4" Standard
Ogee Washer

Note: Cost of timber headers complete in
place to be included in price bid for concrete.

DETAILS OF TIMBER HEADER

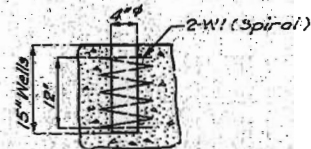

Note: Holes for all anchor bolts
shall be formed in substructure
by placing and setting with template
4" Wells of depth shown.
Grout for anchor bolt wells
shall contain Iron Oxide (Embecco
or an approved equivalent)

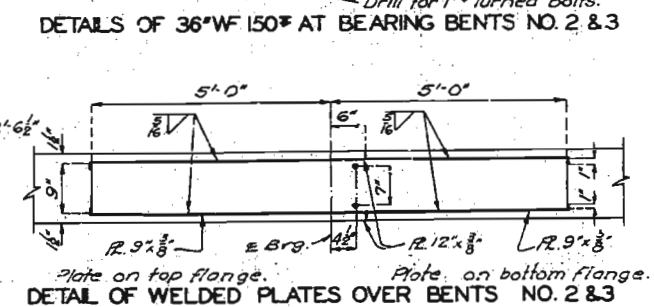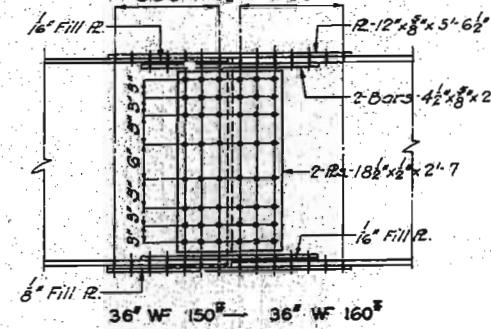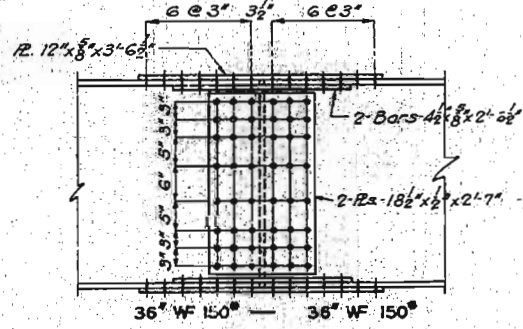

BRIDGE OVER CHOUTEAU TRAFFICWAY
STATE ROAD FROM ARMOUR ROAD IN NORTH KANSAS CITY N.E.
ABOUT 3.75 MILES NORTH OF NORTH KANSAS CITY
PROJECT NO. UI-99(7) (RT. 69) STA. 371+13.15 (RIGHT LANE)
CLAY COUNTY

Drawn May 1954 by H.R.B.
Traced May 1954 by K.R.W.
Checked June 1954 by H.J.K. & R.H.L.

PART ANCHOR BOLT PLAN

Note: This drawing is not to scale. Follow dimensions.


Sheet No. 6 of 9.

NO CONSTRUCTION CHANGES


L-642

MISSOURI STATE HIGHWAY DEPARTMENT


FED. ROAD DIST. NO.	STATE	FED. AID PROJ. NO.	FIS-TAL YEAR	SHEET NO.	TOTAL SHEETS
5	MO	U.S. 99 (7) (RT 69)	19		

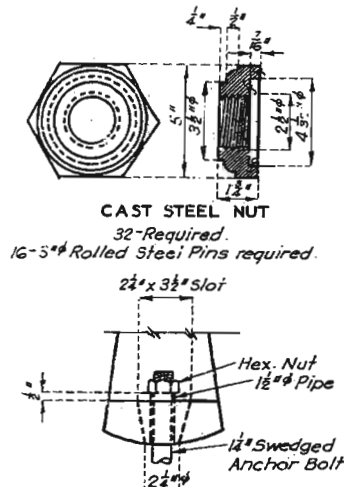

CAST STEEL NUT
32-Required.
16-5 inch Rolled Steel Pins required.

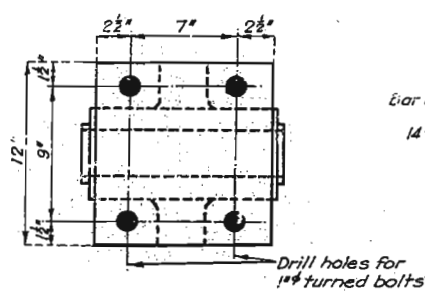


EXPANSION ROCKER

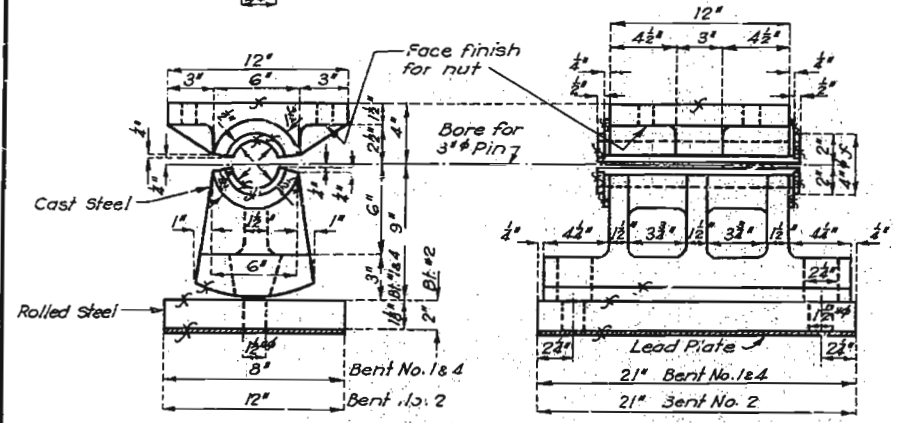

FIXED PEDESTAL
DETAILS OF BEARING CASTINGS


GENERAL NOTES:

Finish all surfaces marked 'x'.
All fillets for castings shall have 1/2 inch radius.
Materials for castings shall be cast steel.
All pins, bolts, nuts, pipe sleeves, and rolled steel shall be paid for as Structural Steel.
Anchor bolts shall be 1/2 inch swaged bolts with Hex. Nuts and shall extend 12 inches into concrete.
Lead plates under bearings shall be approximately 1/2 inch thickness and weigh 8 lb./sq. ft. Cost of lead plates shall be included in price bid for other items.

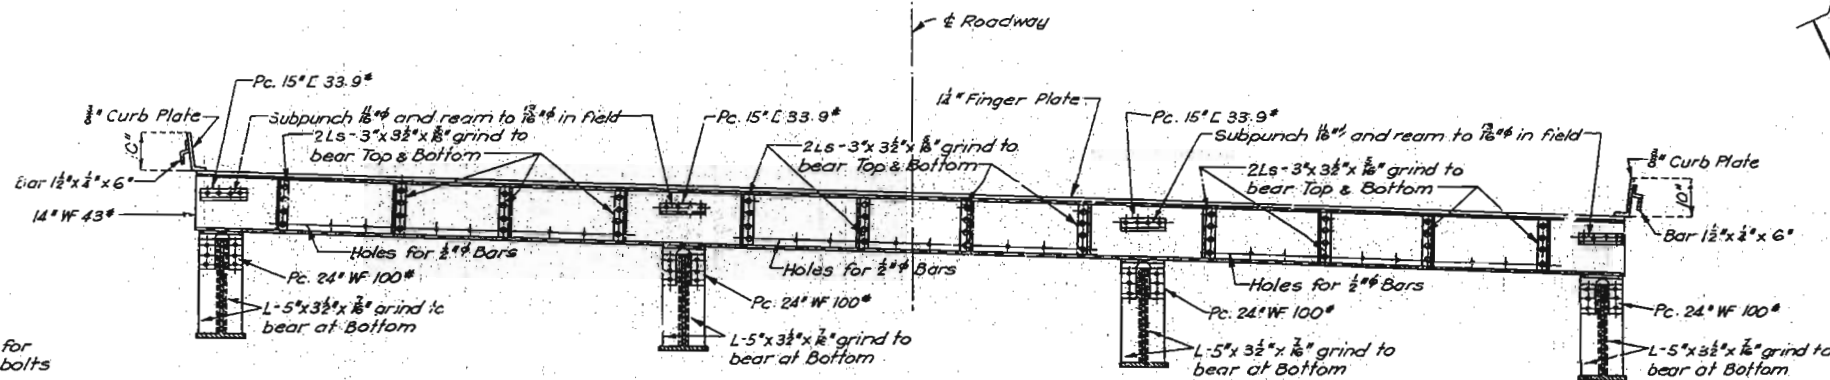


HORIZONTAL SECTION THRU END DIAPHRAGM
AT END BENTS NO. 1 & 4

SECTION A-A

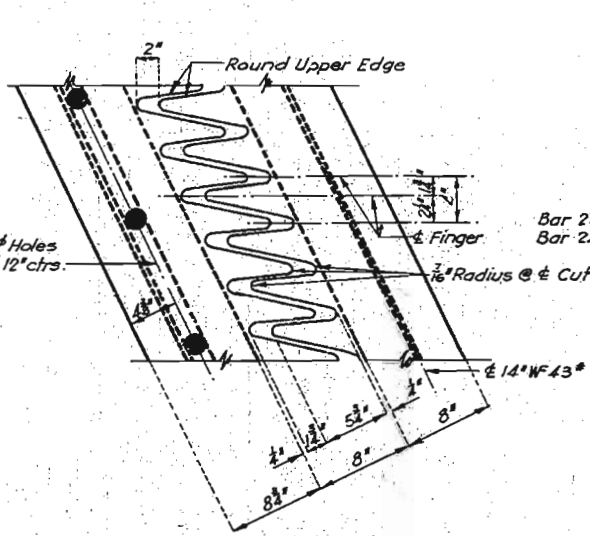


FINGER PLATE LAYOUT


SECTION D-D

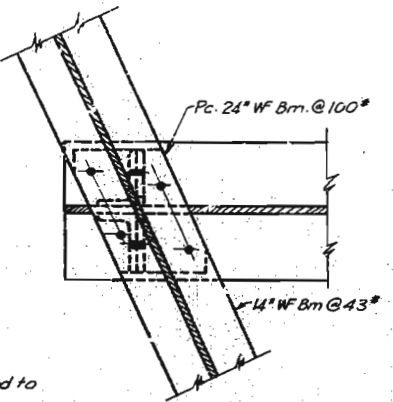

PART SECTION B-B

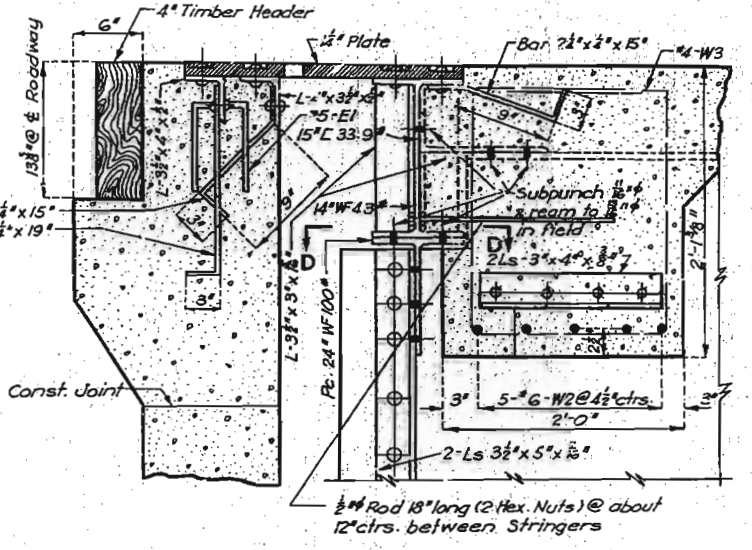

PART SECTION C-C

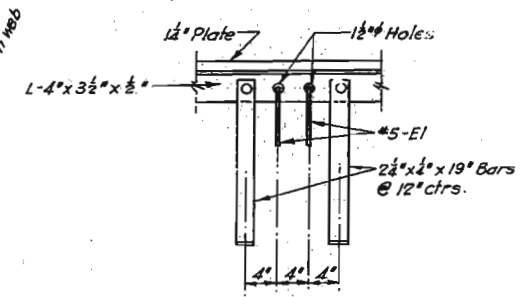

BRIDGE OVER CHOUTEAU TRAFFICWAY

STATE ROAD FROM ARMOUR ROAD IN NORTH KANSAS CITY N.E.
ABOUT 3.75 MILES NORTH OF NORTH KANSAS CITY
PROJECT NO. 99 (7) (RT 69) STA. 371+13.15 (RIGHT LANE)


CLAY COUNTY

SECTION NORMAL TO END DIAPH.
AT BENT NO. 4
Sheet No. 7 of 9.


NO CONSTRUCTION CHANGES

MISSOURI STATE HIGHWAY DEPARTMENT


FED. ROAD DIST. NO.	STATE	PROJ. NO.	YEAR	SHEET NO.	TOTAL SHEETS
5	MO.	111-0322 (RT 69)	19		

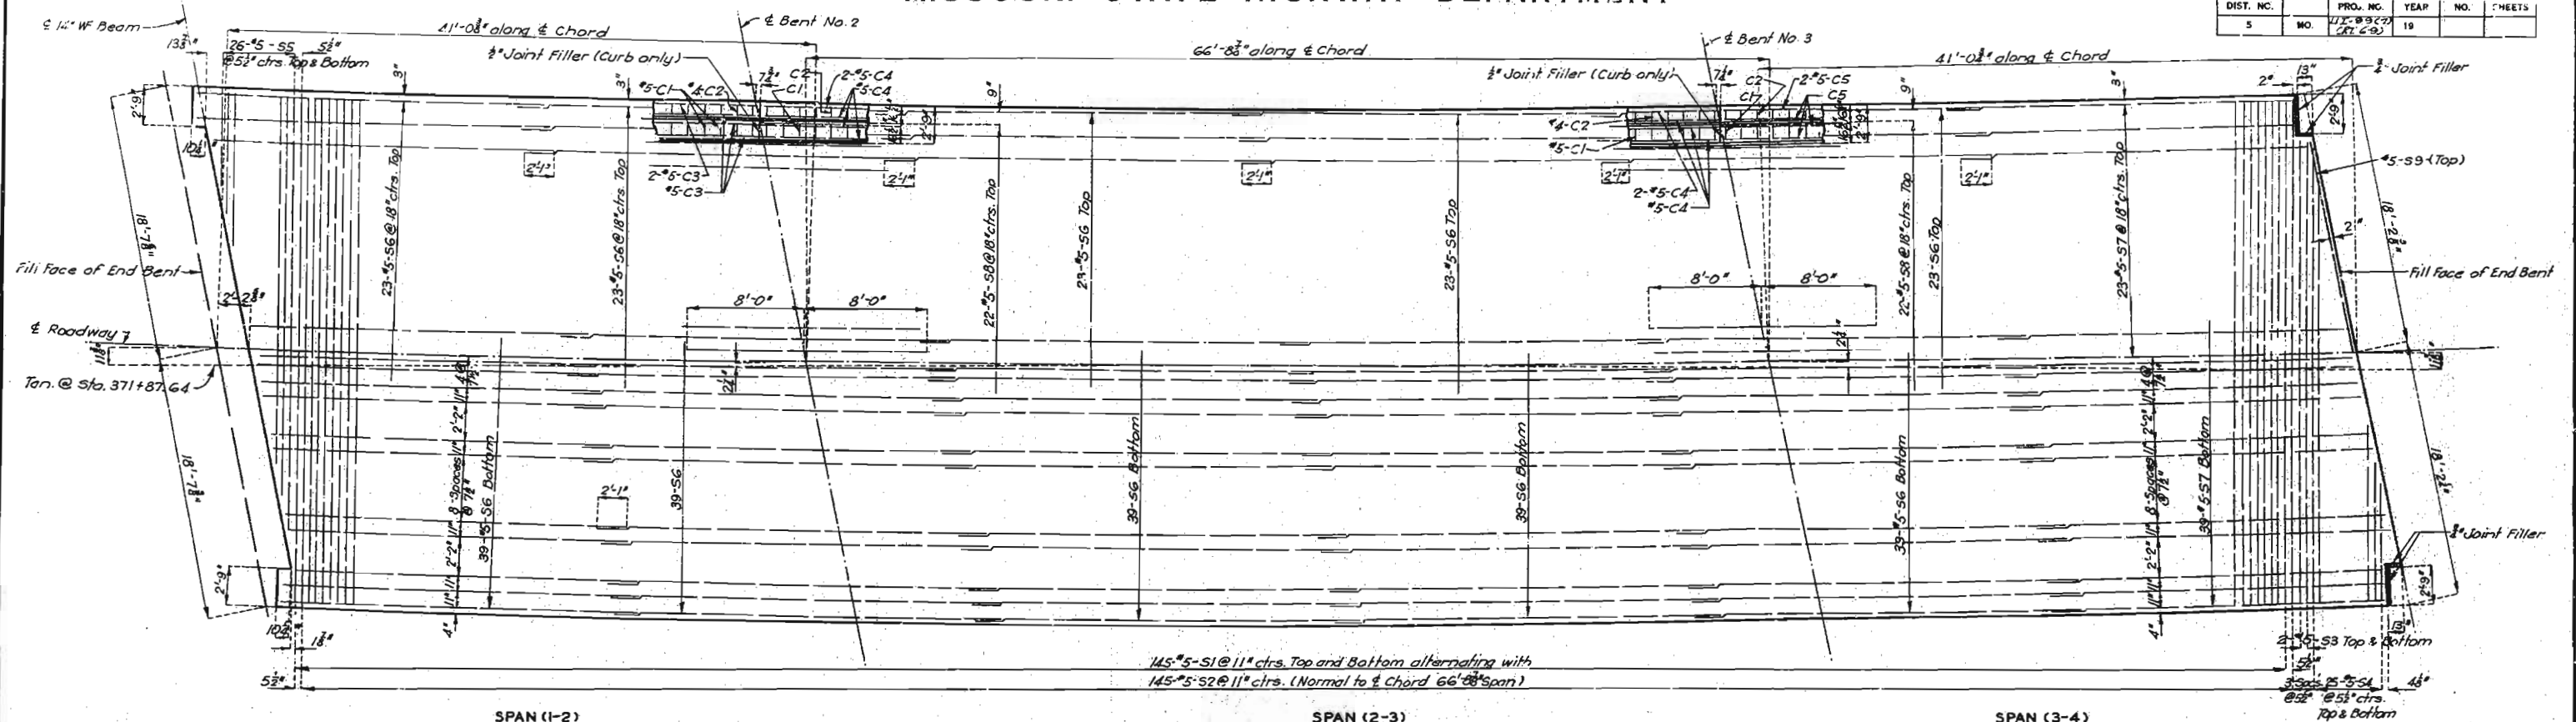

PLAN OF SLAB SHOWING REINFORCEMENT

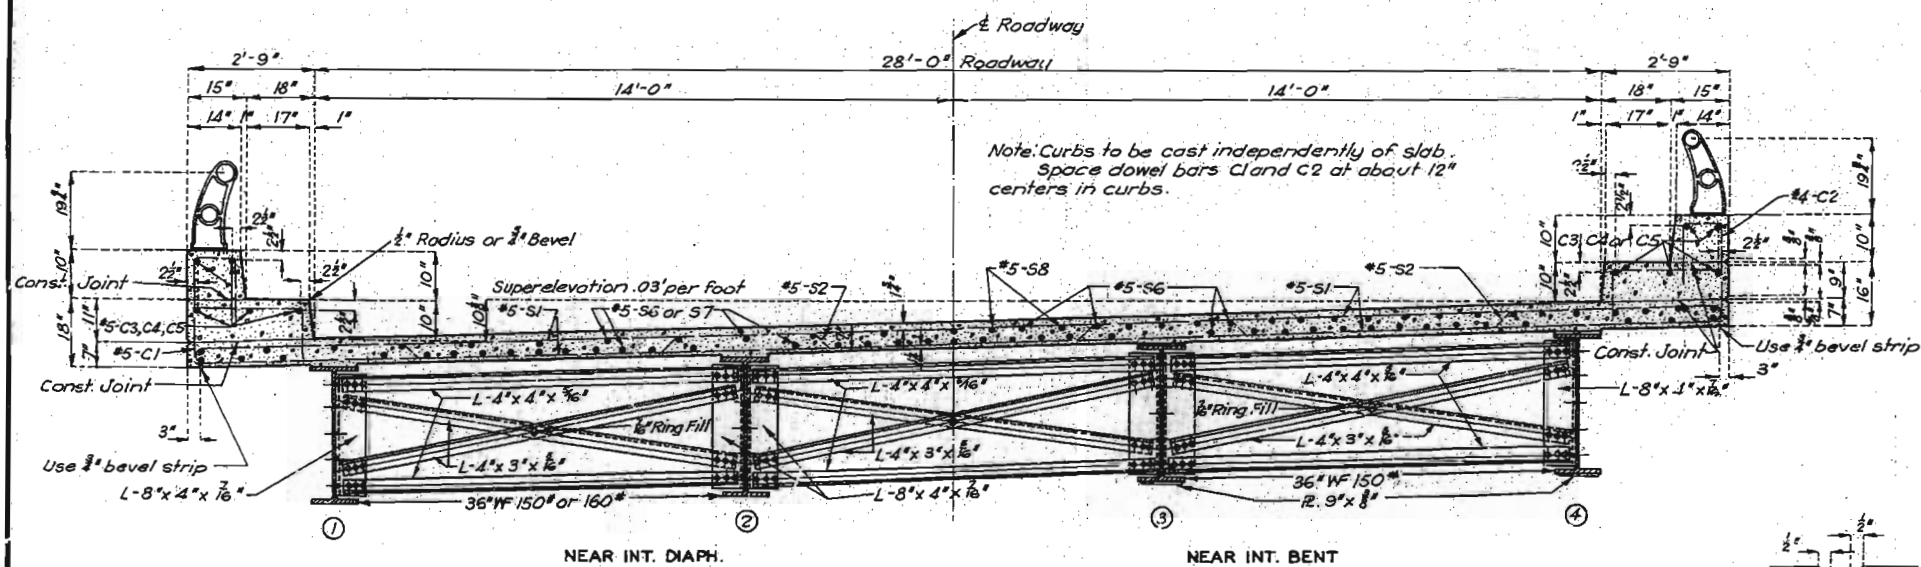


TYPICAL RADIAL SECTION THRU SPANS

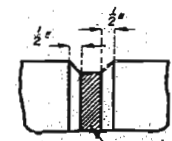


Note: Use bevel as shown for exposed faces of all joints consisting of joint filler.

DETAILS OF BEVEL FOR FILLED JOINTS

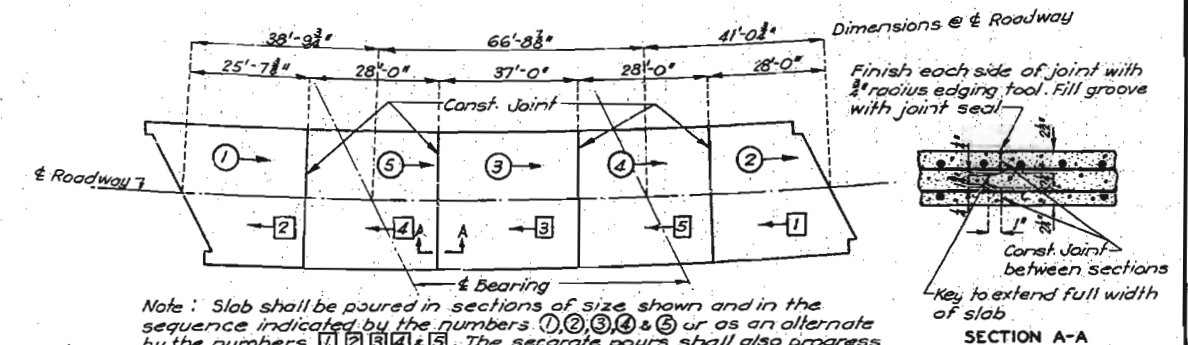

Note: Slab shall be poured in sections of size shown and in the sequence indicated by the numbers ①, ②, ③, ④, ⑤ or as an alternate by the numbers ①, ②, ③, ④, ⑤. The separate pours shall also progress in the direction indicated by the arrows. If the contractor desires indicated pours 3 and 4 may be made as one continuous pour in the direction indicated. Longitudinal construction joints will not be permitted.

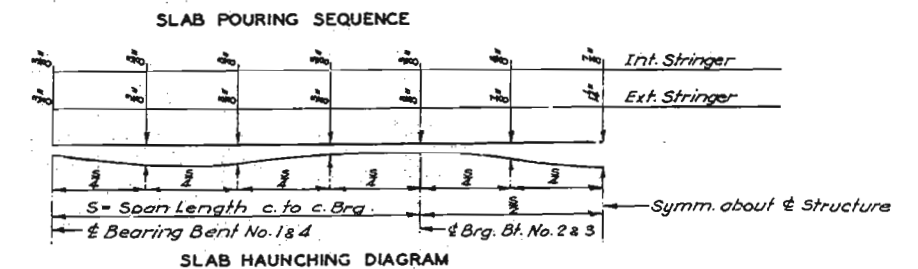

BRIDGE OVER CHOUTEAU TRAFFICWAY

STATE ROAD FROM ARMOUR ROAD IN NORTH KANSAS CITY N. E.
ABOUT 3.75 MILES NORTH OF NORTH KANSAS CITY
PROJECT NO. U-99 (7) (RT 69) STA. 371+13.15 (RIGHT LANE)

CLAY COUNTY

Drawn May 1954 By R.H.L.
Traced May 1954 By J.T.F.
Checked June 1954 By H.R.B.


Note: This drawing is not to scale. Follow dimensions.

Sheet No. 8 of 9.


NO CONSTRUCTION CHANGES

L-642

FED. ROAD DIST. NO.	STATE	FED. AID PROJ. NO.	FISCAL YEAR	SHEET NO.	TOTAL SHEETS
5	MO.	U.S. 907 (R.T. 69)	19		

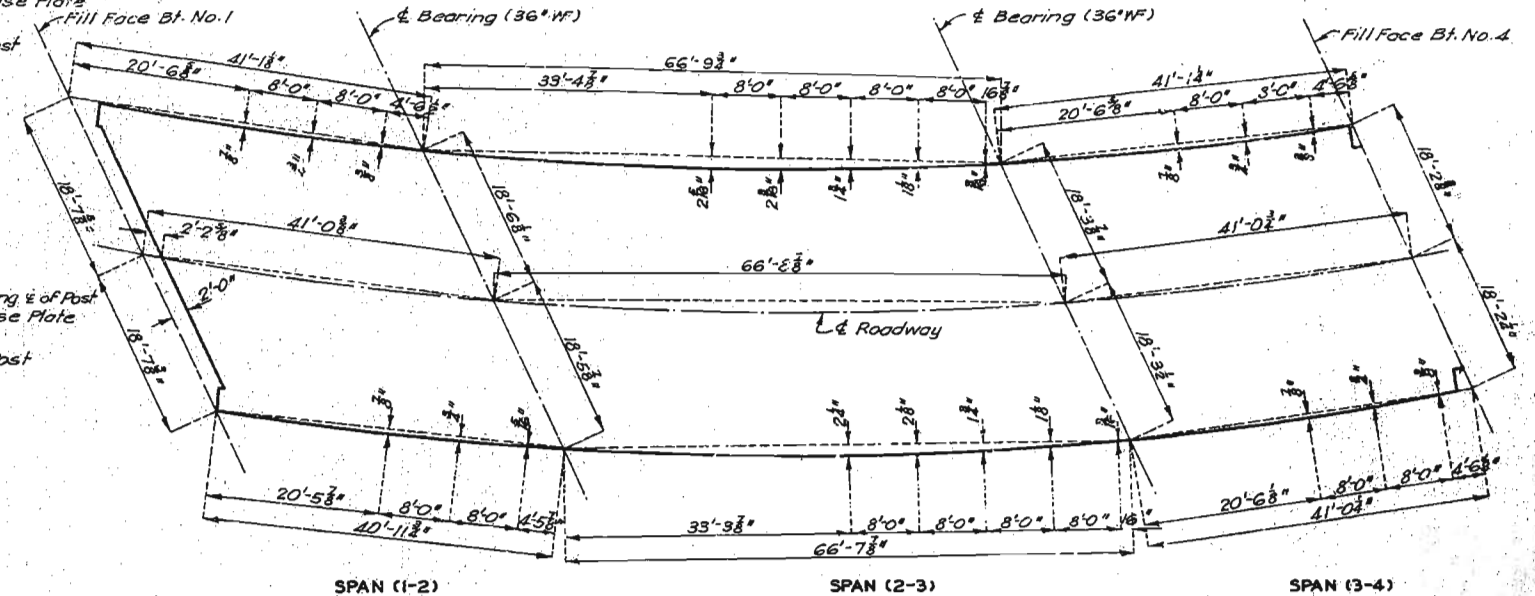



Note: All dimensions shown are parallel to grade at top surface of Roadway Slab.

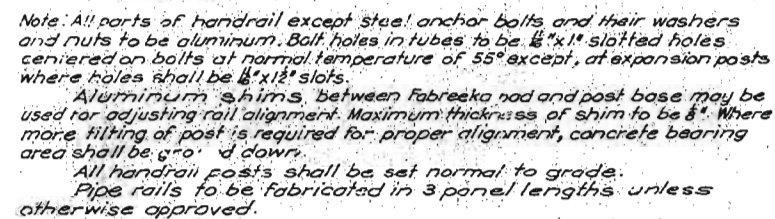

Sheet No. 9 of 9.


L-642

Drawn May 1954 By H.R.B.
Traced May 1954 By J.T.F.
Checked June 1954 By H.J.K. & R.H.L.

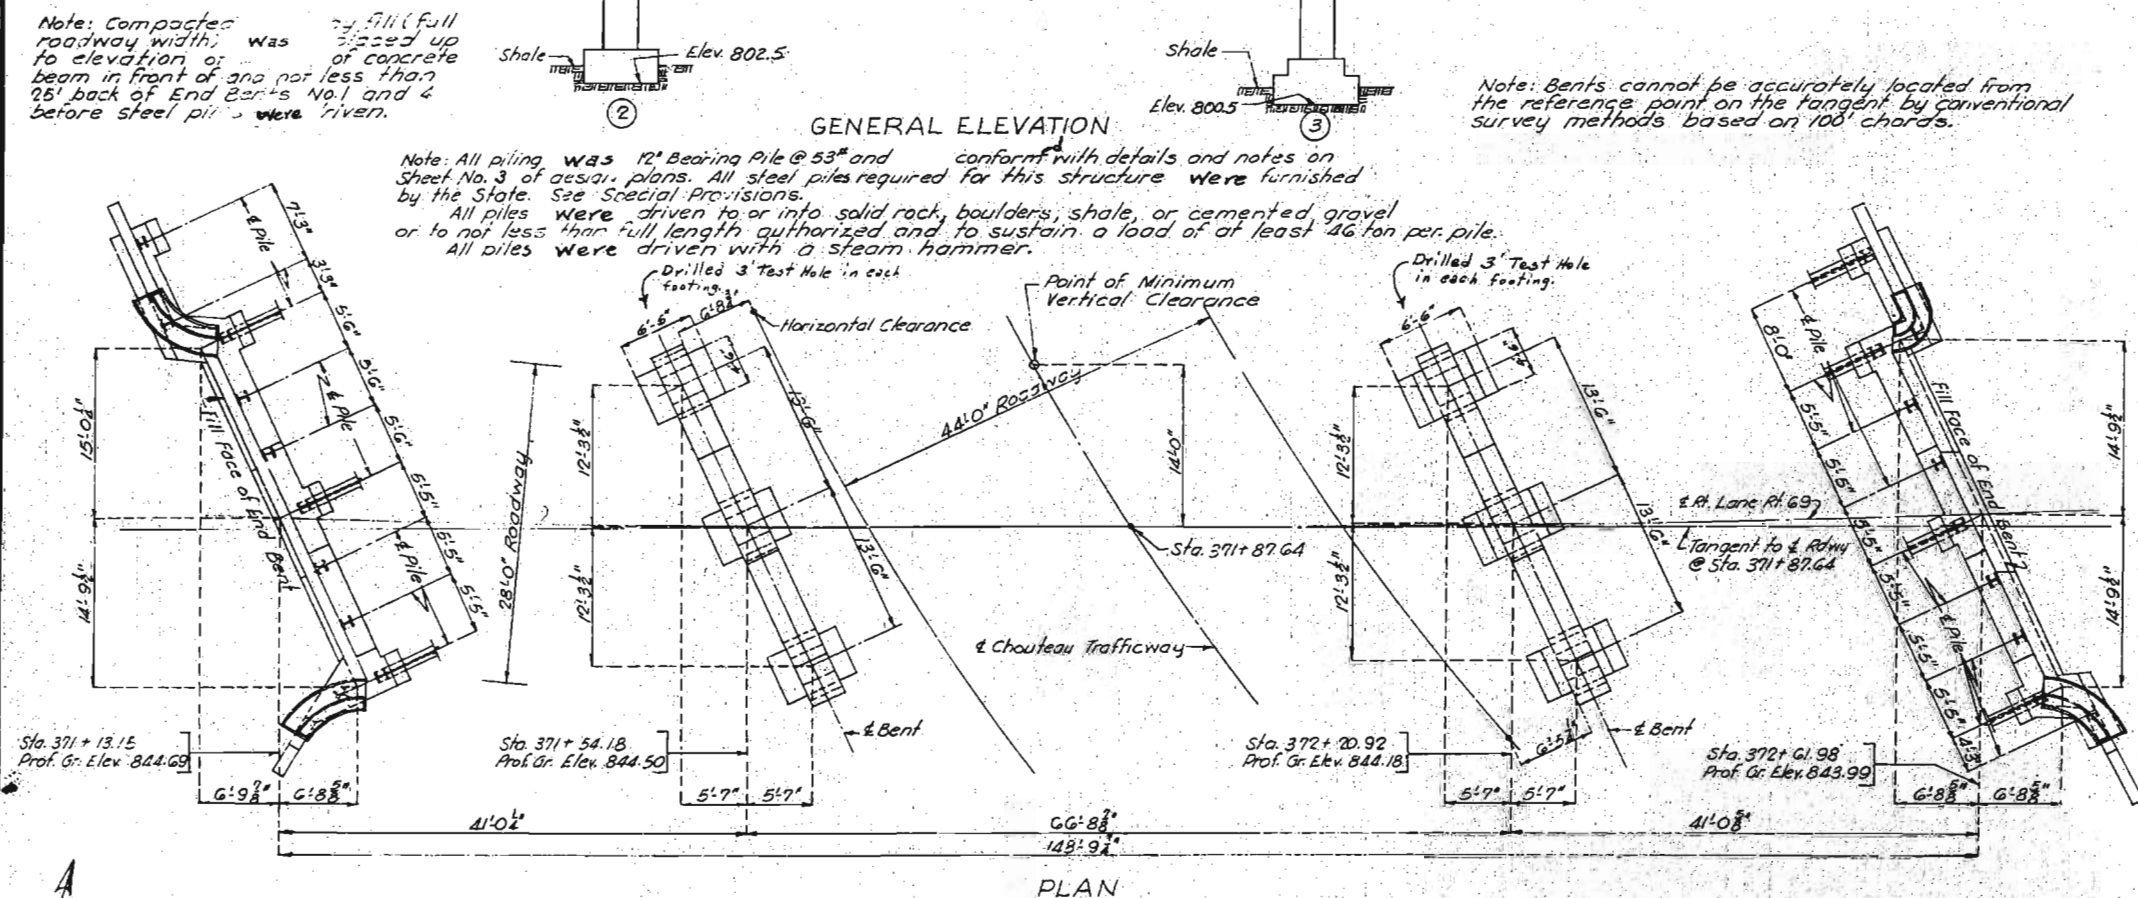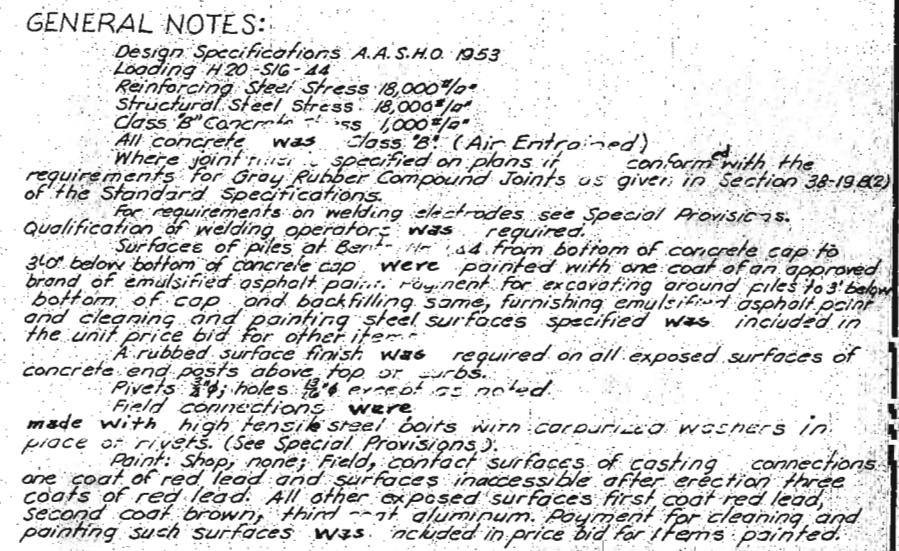[illegible]

FINAL QUANTITIES			
Item	Substr.	Superstr.	Total
Class I Excavation for Structures	Cu. Yds. 273		273
Class "B" Concrete	Cu. Yds. 188.6	150.4	339.0
Fabricated Structural Steel	Lbs.	112,270	112,270
Aluminum Alloy Handrail	Lin. Ft.	292	292
Steel Castings	Lbs.	5210	5210
Reinforcing Steel	Lbs.	22,360	32,220
Steel Pile in place (State Furnished)	Lin. Ft.	690	690
Cont Item - Test Holes		13	13

Note: Concrete in end posts is included in Estimated Quantities of Class 9th Concrete for Substructure.
All excavation for bridge will be paid for as Class 1 Excavation for Structures.

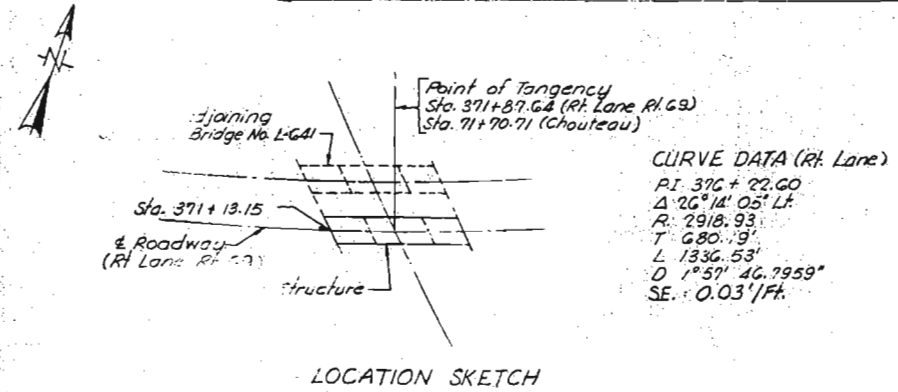

8M Elev. 843.38 □ on Lt. wing Abut. #4 Left Lane
adjoining bridge.

BRIDGE OVER CHOUTEAU TRAFFICWAY
STATE ROAD FROM ARMOUR ROAD IN NORTH KANSAS CITY N.E.
ABOUT 3.75 MILES NORTH OF NORTH KANSAS CITY
PROJECT NO. UI-99(7) (RT 69) **STA.** 371+0.15 (RIGHT LANE)

CLAY COUNTY

SUBMITTED BY J. A. Williams DATE 7/19/1954
NAME OF AGENT
 APPROVED BY Ber M. Whitton DATE 7/19/1954
NAME, GRADE

FINISHED
STD. C-10 R3
L-642

Note: This drawing is not to scale. Follow dimensions.

Sheet No. 1A of 2

FINISHED


FINAL PLANS

FED. ROAD DIST. NO.	STATE	FED. AID PROJ. NO.	FISCAL YEAR	SHEET NO.	TOTAL SHEETS
5	MO.	41-9977 (RT 62)	19		

[illegible]

Technical drawing of a roof truss section. The drawing shows a cross-section of a roof with a gabled structure. Key dimensions and labels include:

- Top width: 3'-0"
- Top slope: 2 1/2"
- Top horizontal dimension: 6'-0 1/2"
- Top vertical dimension: 2 1/2"
- Internal vertical dimension: 7'-0"
- Internal horizontal dimension: 6'-5 1/2"
- Bottom slope: 2 1/2"
- Bottom horizontal dimension: 6'-5 1/2"
- Bottom vertical dimension: 2 1/2"
- Labels: U12, G1, 3-V13, 2-V13, 3-V15, 2-V15

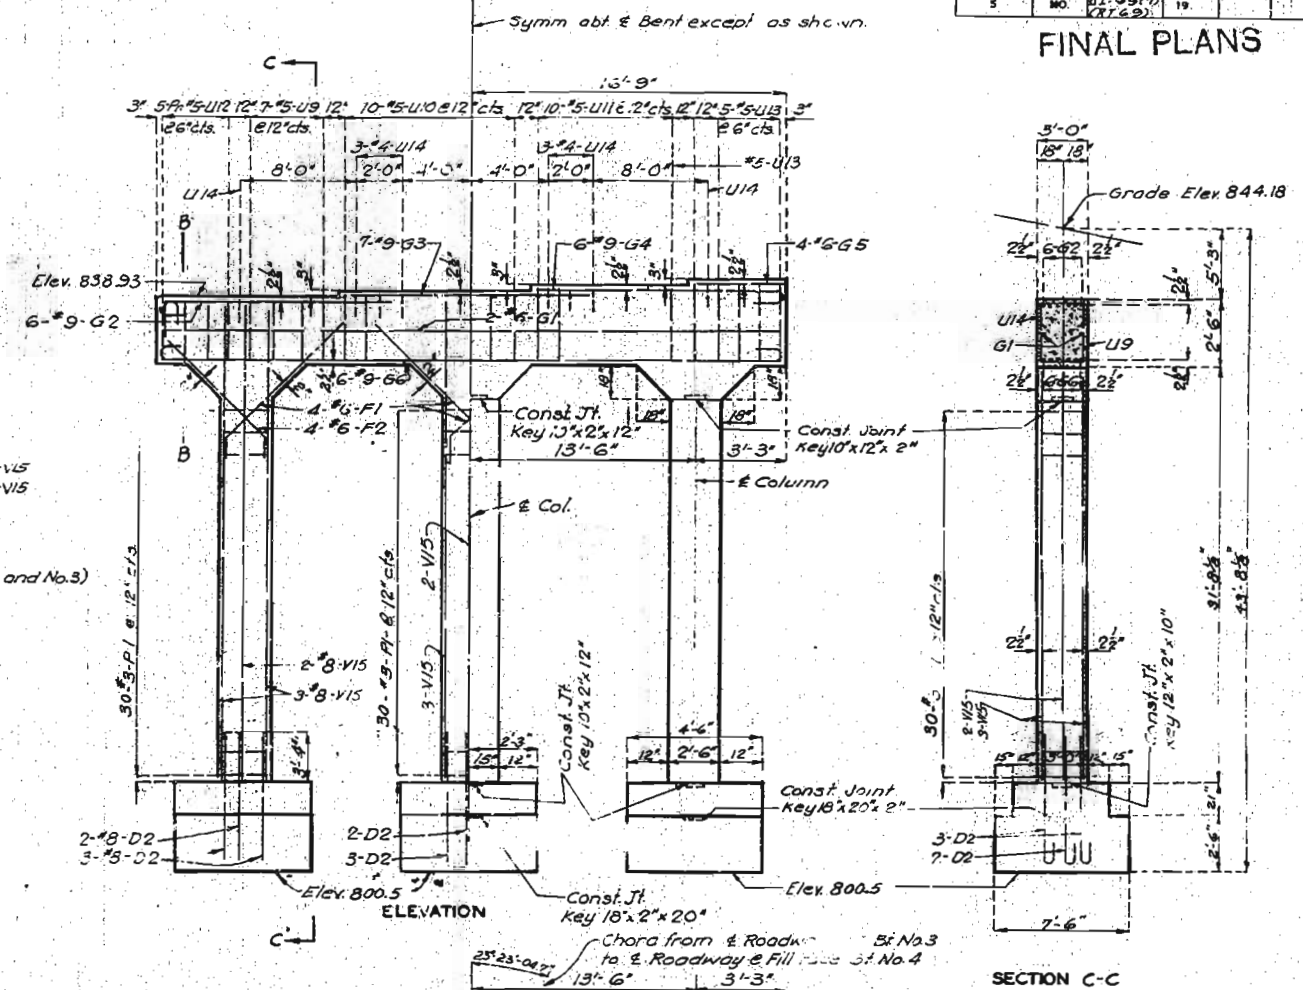[illegible][illegible]

0-2-5-7-9


Zor3 Co. Int } All Loadings

L-642

MISSOURI STATE HIGHWAY DEPARTMENT

FED. ROAD DIST. NO.	STATE	FED. AID PROJ. NO.	FISCAL YEAR	SHEET NO.	TOTAL SHEETS
5	MO.		75		


* See Special Provisions for alternate type anchors.

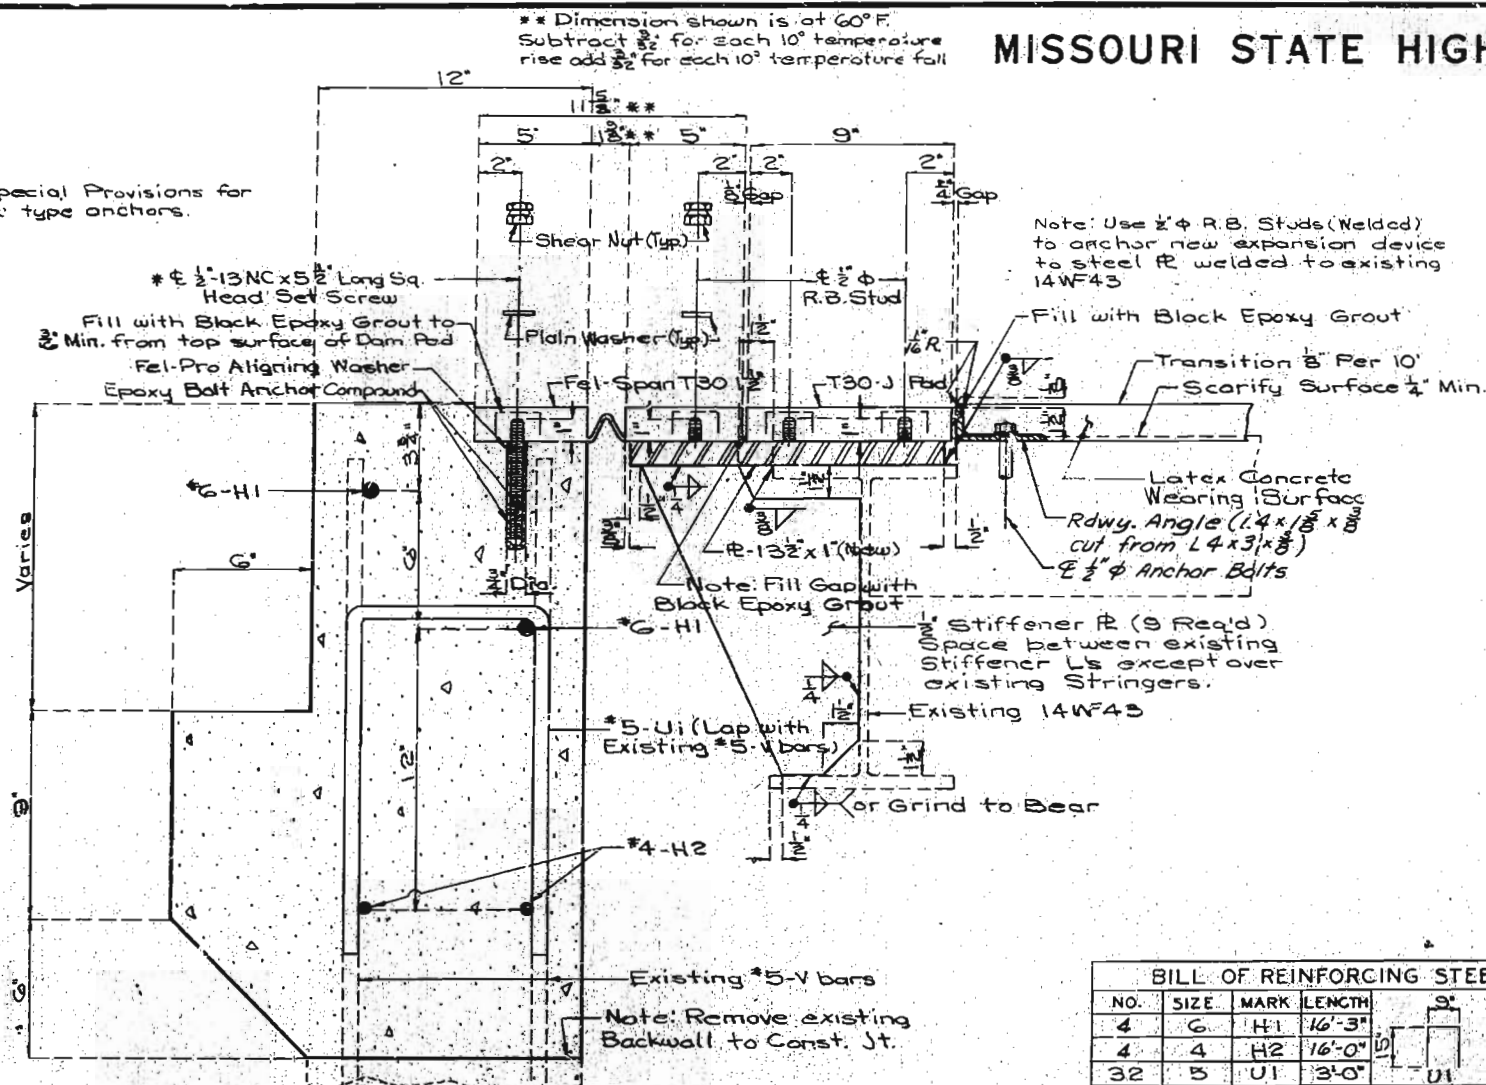




PART SECTION THRU BACKWALL AND EXPANSION DEVICE

BILL OF REINFORCING STEEL				
NO.	SIZE	MARK	LENGTH	
4	6	H1	16'-3"	
4	4	H2	16'-0"	
32	3	U1	3'-0"	

Note: Total lengths of reinforcing steel are measured along centerline bar to the nearest inch.
All bending dimensions are out to out.

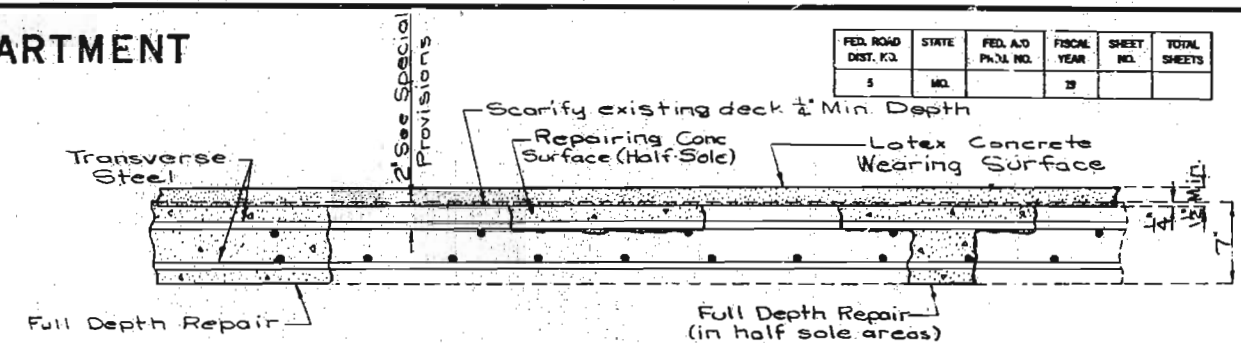

PART CROSS SECTION THRU SLAB

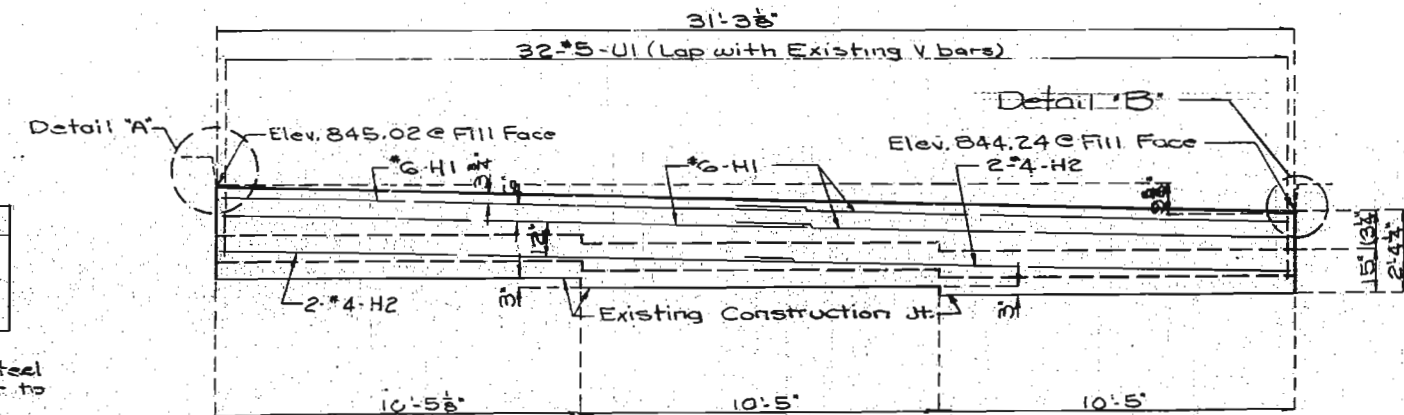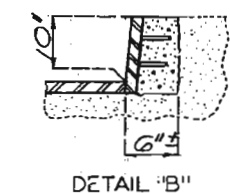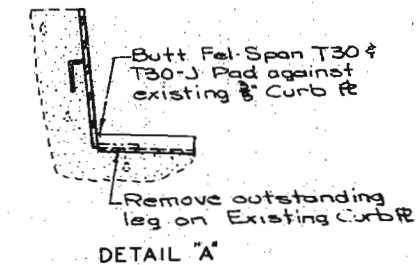

PART ELEVATION OF BACKWALL END BENT NO. 1 SHOWING NEW REINFORCEMENT S.E. .03' CONTINUOUS ACROSS STRUCTURE

ESTIMATED QUANTITIES		
ITEMS		TOTAL
Latex Concrete Wearing Surface	Sq. Yd.	458
Repairing Concrete Deck (Half Sole)	Sq. Ft.	823
Full Depth Repair	Sq. Ft.	206
Reinforced Neoprene Expansion Joint Seal (16) Lin. Ft.		32
Reinforced Neoprene Dam (J Pad)	Lin. Ft.	32
Special Work	Lump Sum	1

Roadway Angle Note:
Payment for furnishing, painting and placing structural steel for roadway angles shall be included in unit price bid for other items. (See Special Provisions)

REPAIRS TO BRIDGE OVER CHOUTEAU TRAFFICWAY

STATE ROAD FROM ARMOUR ROAD IN NORTH KANSAS CITY N.E. ABOUT 3.75 MILES NORTH OF NORTH KANSAS CITY

PROJECT NO. I-IR-35-1(63) STA. 370+83.82

JOB NO. 4-135-33

RTE I-35

CLAY

COUNTY

STD.
STD.
L-642R

DETAILED Nov. 1975
CHECKED Nov. 1975

REVISED PART PLAN

Note: This drawing is not to scale. Follow dimensions.


PART PLAN

Sheet No. 1 of 2 Revised 11-30-76


DATE 10/21/76

MISSOURI STATE HIGHWAY DEPARTMENT

PL. DIST. NO.	FED. AID PROJ. NO.	FISCAL YEAR	SHEET NO.	TOTAL
5	MD	78	9	

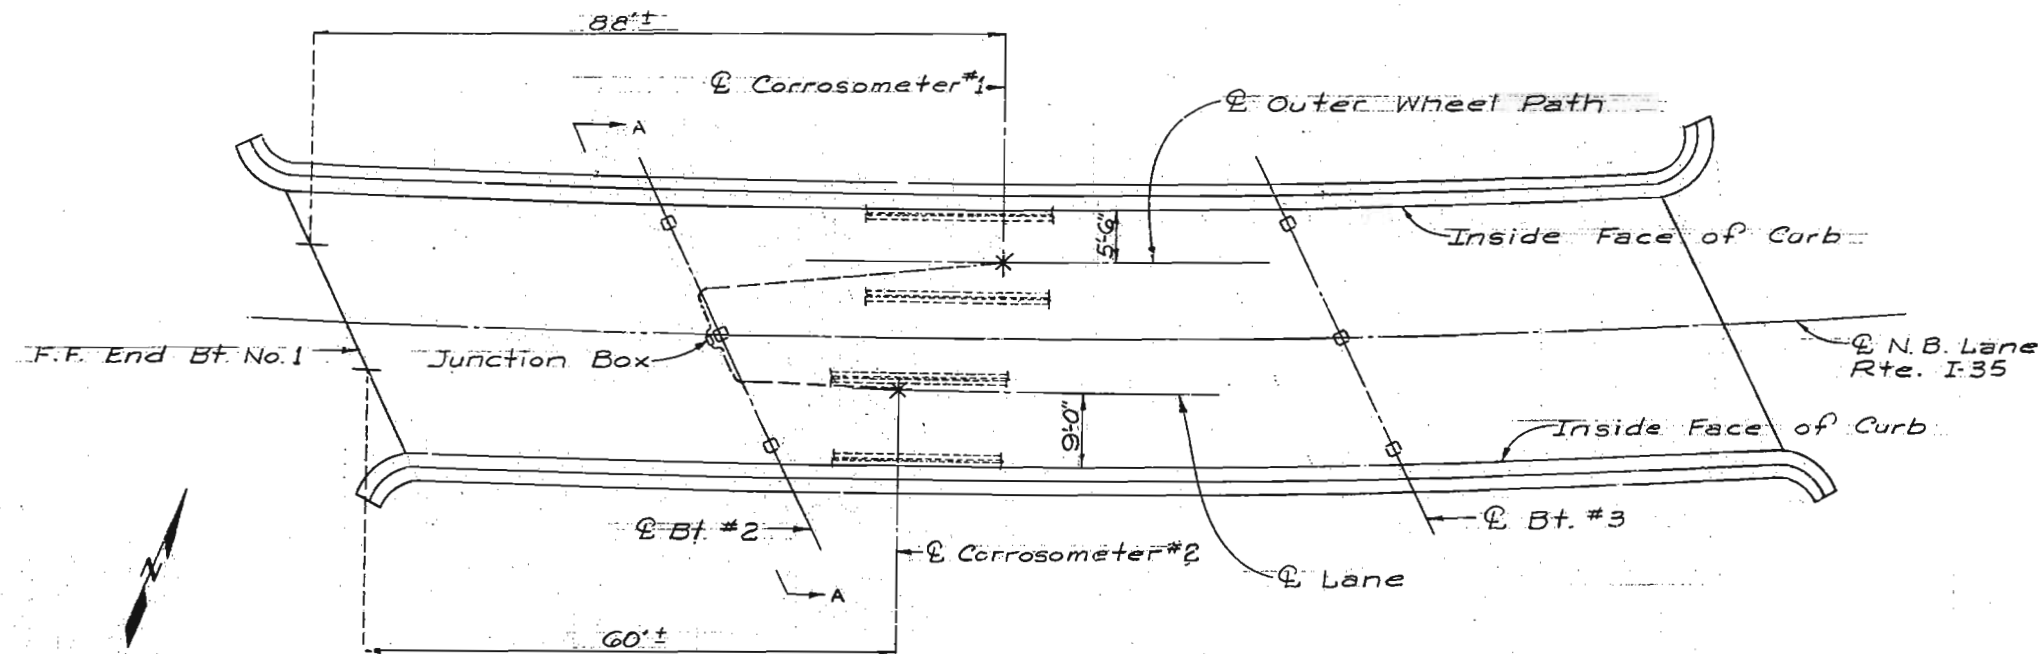

PLAN OF SLAB SHOWING LOCATION OF CORROSOMETERS

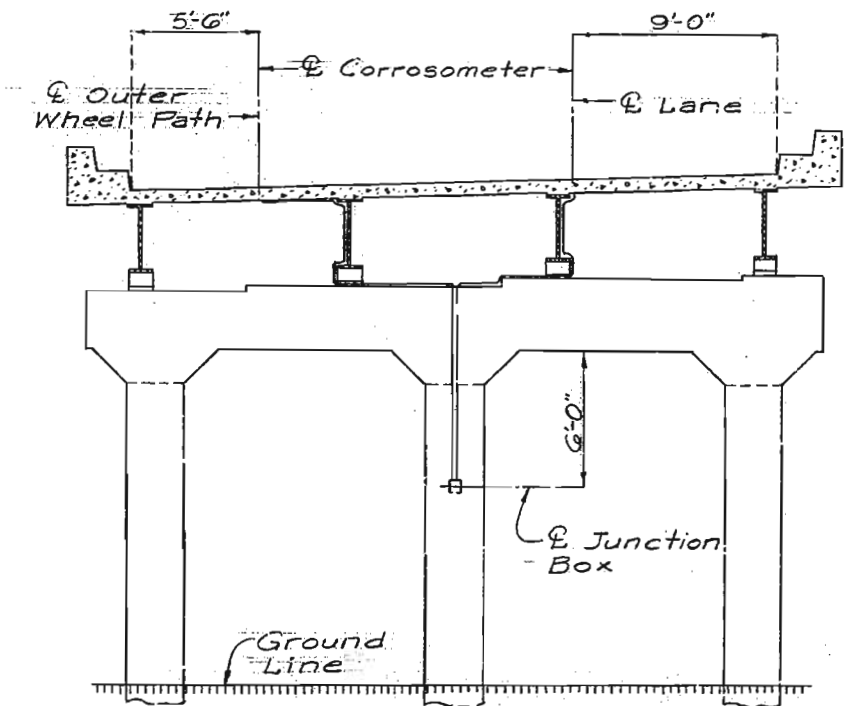


SECTION A-A

JUNCTION BOX NOTE:

See Bridge L-563 R, Sheet No. 2 of 2 for General Notes.

Concrete shall only be removed to the depth necessary to completely encapsulate the corrosion probe in chloride bearing mortar.

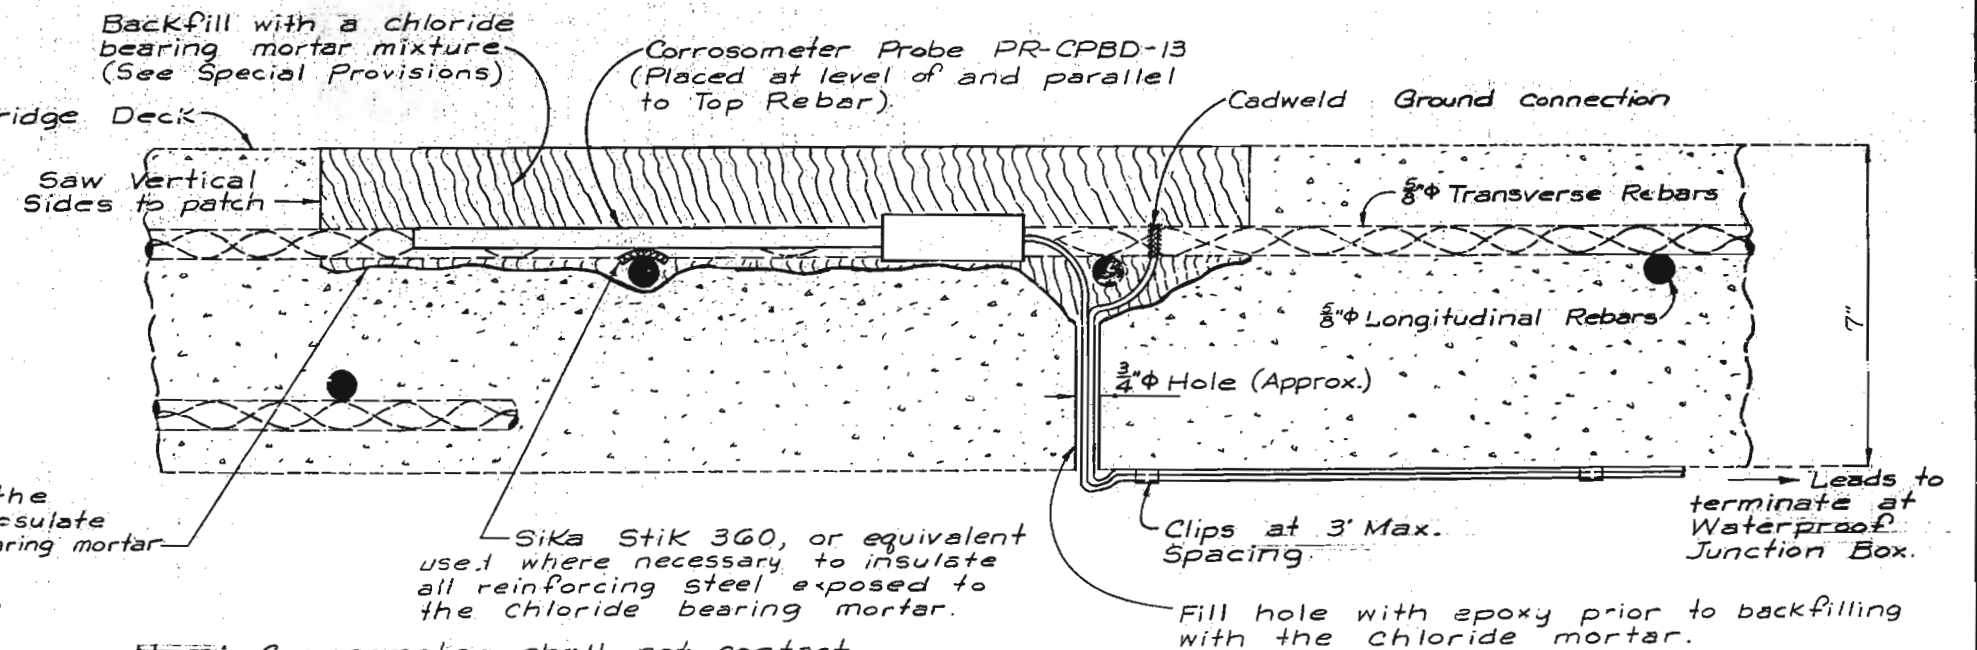


NOTE: Corrosometer shall not contact any reinforcing steel. Tag each Corrosometer and ground lead with proper location number.

METHOD FOR PLACING CORROSOMETER

MISSOURI STATE HIGHWAY DEPARTMENT

* * Dimension shown is at 60°F.
Subtract $\frac{3}{32}$ " for each 10° temperature
rise add $\frac{3}{32}$ " for each 10° temperature fall


* See Special Provisions for alternate type anchors.

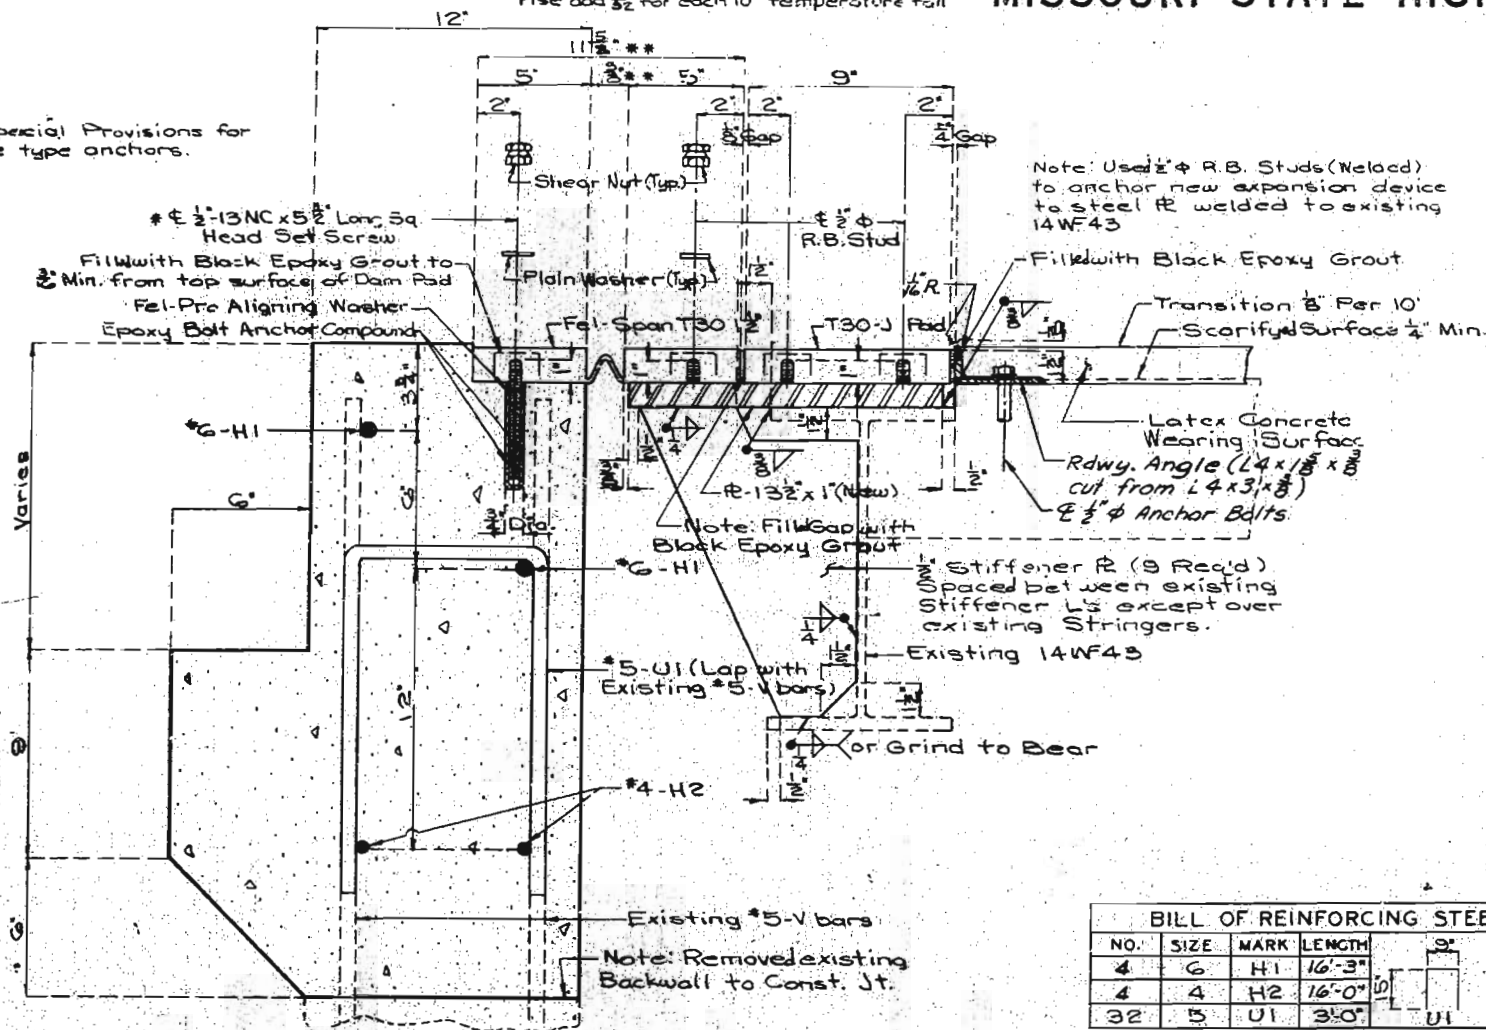


PART SECTION THRU BACKWALL AND
EXPANSION DEVICE

BILL OF REINFORCING STEEL			
NO.	SIZE	MARK	LENGTH
4	6	H1	16'-3"
4	4	H2	16'-0"
32	5	U1	3'-0"

Note: Total lengths of reinforcing steel are measured along centerline bar to the nearest inch.
All bending dimensions are out to out.

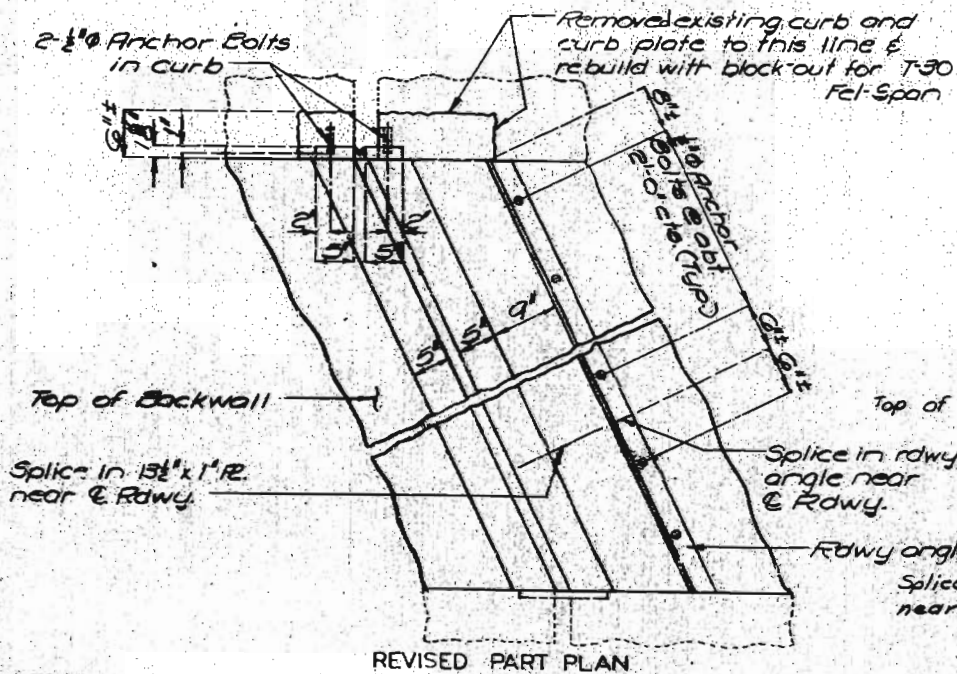

REVISÉ PART PLAN

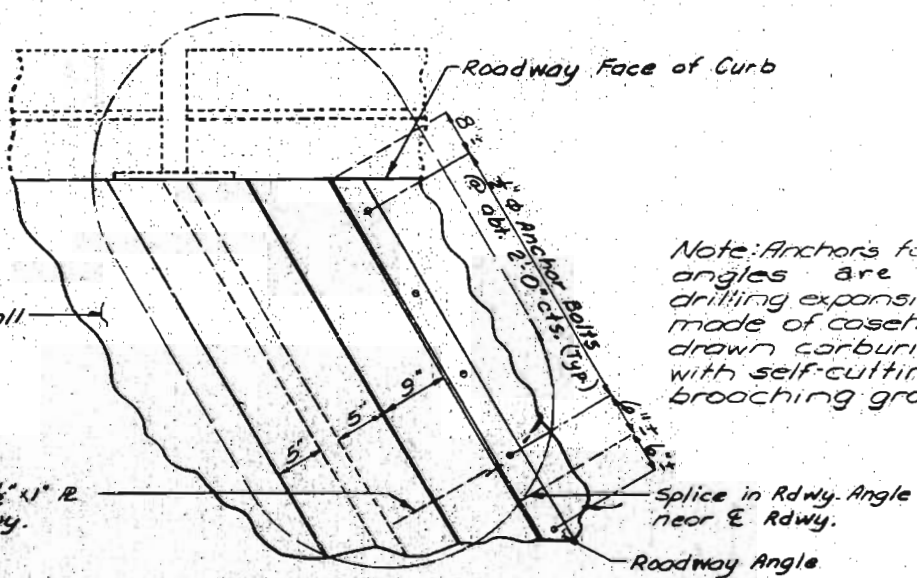

PART PLAN


Note: Anchors for Roadway angles are of the self-drilling expansion type, made of casehardened and drawn carburized steel with self-cutting annular broaching grooves.

- Splice in Rdwy. Angle
near E Rdwy.


- Roadway Angle

FINAL PLANS


FED. ROAD DIST. NO.	STATE	FED. AID PROJ. NO.	FISCAL YEAR	SHEET NO.	TOTAL SHEETS
5	MO.		19		

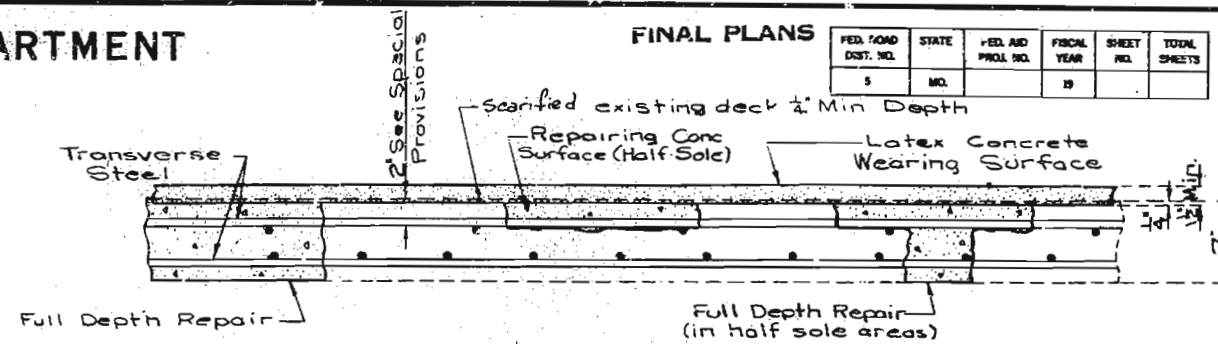


PART CROSS SECTION THRU SLAB

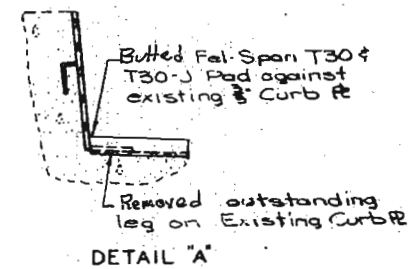

DETAIL "A"

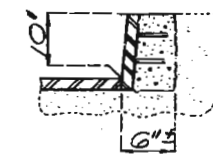

DETAIL "B"

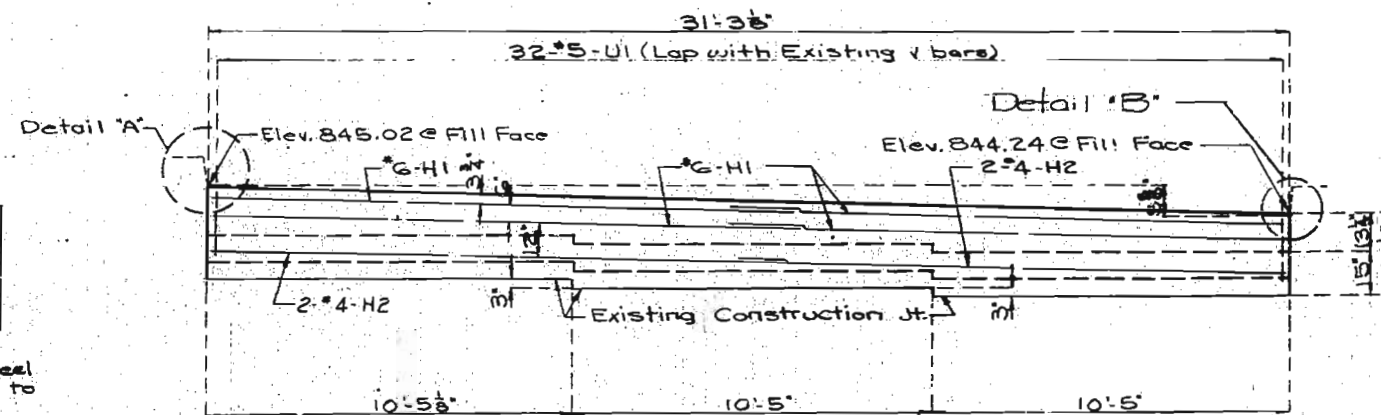

PART ELEVATION OF BACKWALL
END BENT NO. 1 SHOWING NEW REINFORCEMENT
S.E. .03' CONTINUOUS ACROSS STRUCTURE

ESTIMATED QUANTITIES	
ITEMS	TOTAL
Low Slump Concrete Wearing Surface	Sq. Yd. 60
Repairing Concrete Deck (Half Saling)	Sq. Ft. 669
Full Depth Repair	Sq. Ft. 1423
Reinforced Neoprene Expansion Joint Seal	(6) Lin Ft. 32
Reinforced Neoprene Dam (J Pad)	Ln Ft. 32
Special Work	Lump Sum 1
CONTINGENT ITEMS	
Low Slump Concrete Wearing Surface	Sq. Yd. 455

Roadway Angle Note:

Payment for furnishing, painting and placing structural steel for roadway angles was included in unit price bid for other items. (See Special Provisions)

REPAIRS TO BRIDGE OVER CHOUTEAU TRAFFICWAY

STATE ROAD FROM ARMOUR ROAD IN NORTH KANSAS CITY N.E.

ABOUT 3.75 MILES NORTH OF NORTH KANSAS CITY

PROJECT NO. I-IR-35-1(63) STA. 370+83.82

JOB NO. 4-135-33

RTE. I-35

CLAY

COUNTY

STQ



L-642R

DETAILED Nov. 1975
CHECKED Nov. 1975

Note: This drawing is not to scale. Follow dimensions.


Sheet No. 1A of 2 Revised 11-30-76

DATE 10/21/76

MISSOURI HIGHWAY AND TRANSPORTATION COMMISSION

U. I. P. Widen and Redeck (39', 67', 39') Cont. Comp. WF Spans


STATE	PROJ. NO.	SHEET NO.
MO.		15
SEC./SUR.	TWP. 50N RGE. 32W	

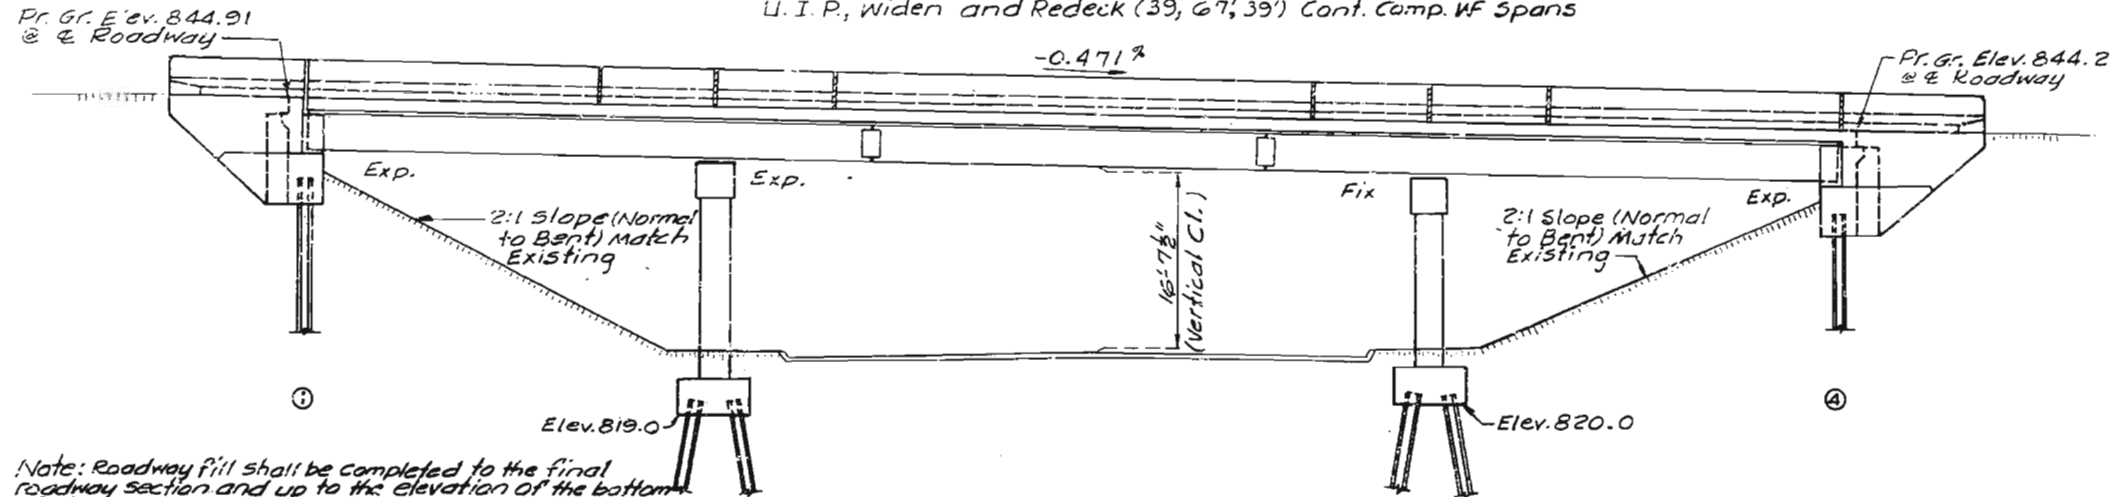

Note: Roadway fill shall be completed to the final roadway section and up to the elevation of the bottom of the concrete beam within the limits of the structure and not less than 25' in back of the fill face of the End Bents before piles are driven for any Bents falling within the embankment section.

DEVELOPED ELEVATION

Note: All Bents are parallel.

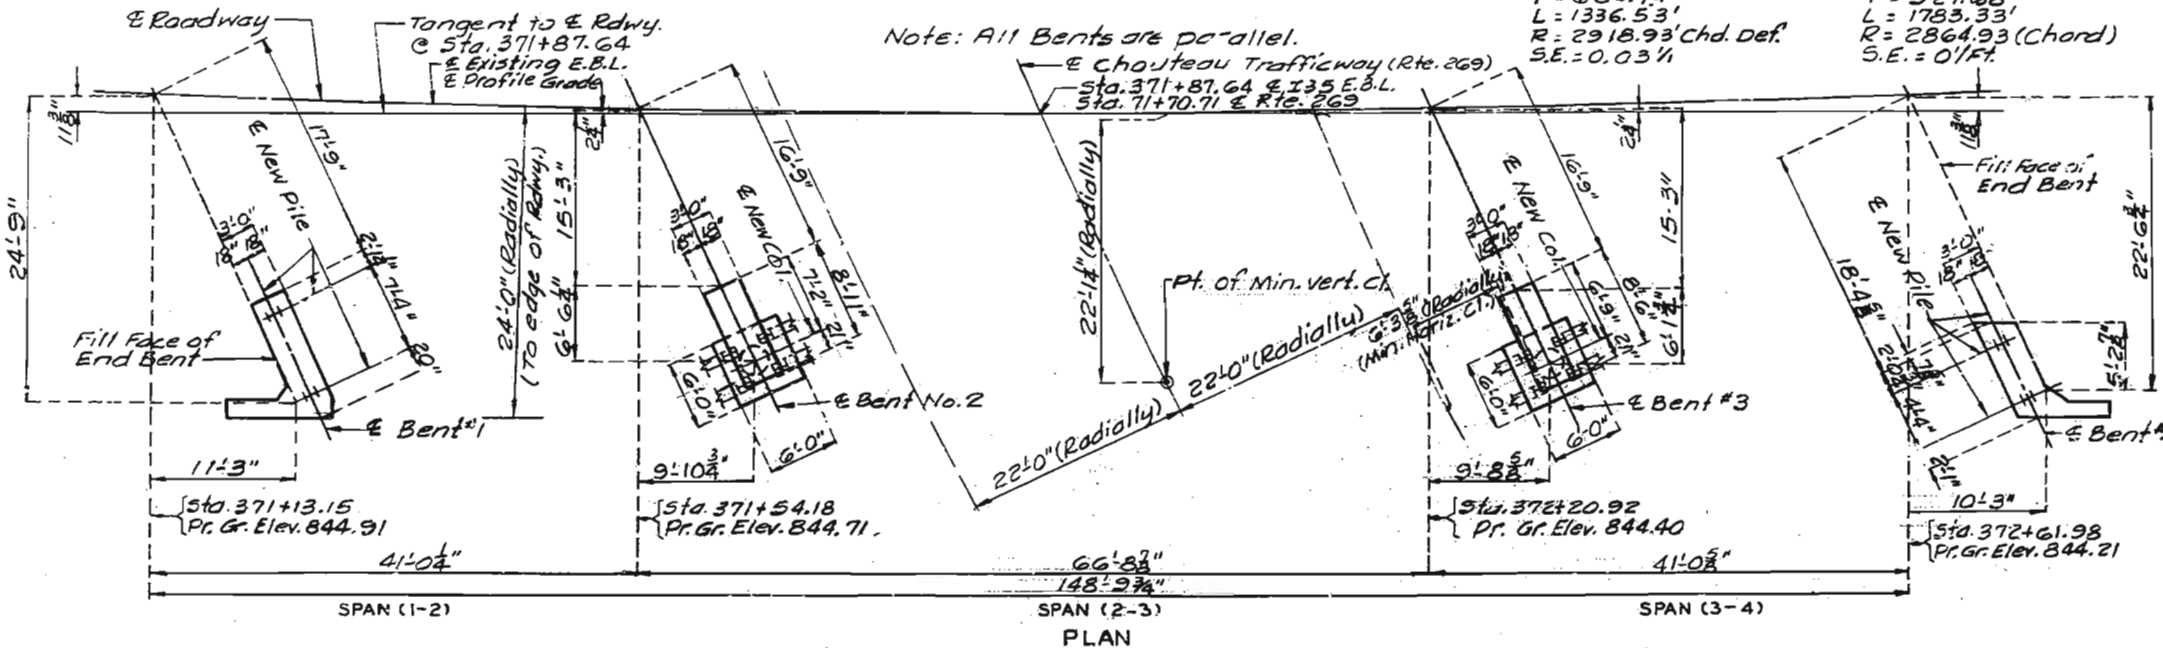

Note: Elevation and Plan showing New work only.

PILE DATA					
BENT		1	2	3	4
PILE TYPE AND SIZE		HP10x42	HP10x42	HP10x42	HP10x42
NUMBER		2	4	4	2
APPROXIMATE LENGTH	FT.	34	18	21	35
DESIGN BEARING	TONS	20	30	30	20
HAMMER ENERGY REQ'D.	FT.-LBS.	7,000	7,000	7,000	7,000

Note: Minimum energy requirement of hammer is based on plan length and design bearing value of piles.
All piles are driven to practical refusal.

* Approximately 13.9 tons of new steel and 53.1 tons of existing steel shall be painted (See special provisions)

ESTIMATED QUANTITIES			
ITEM	SUBSTR.	SUPERSTR.	TOTAL
Partial Removal of Substructure Concrete	Lump Sum		1
Removal and Storage of Exist. Bridge Rail	Lin. Ft.		293
Non-Destructive Testing	Lin. Ft.		37
Removal of Existing Bridge Deck	Sq. Ft.		4,943
Class I Excavation	Cu. Yd.	95	95
Structural Steel Pile (10")	Lin. Ft.	294	294
Class B Concrete (Substr.)	Cu. Yd.	51.4	51.4
Class B2 Concrete (Superstr. on steel)	Cu. Yd.	180.1	180.1
Safety Barrier Curb	Lin. Ft.	323	323
Preformed Compression Exp. Jt. Seal (3.0 in.)	Lin. Ft.		44
Reinforcing Steel (Bridges)	Lb.	4,880	4,880
Reinforcing Steel (Epoxy Coated)	Lb.	560	49,500
Fabricated Str Carbon Steel (I-Beam)	Lb.		29,450
Clean and Lubricate Bearings	Each		16
Painting Existing and New Steel	Lump Sum		1

Note: Concrete above upper construction joint in backwall @ End Bent No. 1 is included with Class B (substructure) quantities.
Weight of threaded rods and nuts in End Diaphragm is included in weight of Fabricated Structural Steel.

Note: This drawing is not to scale. Follow dimensions.

Sheet No. 1 of 20. SEE FINAL PLANS

GENERAL NOTES:

Design Specifications: A.A.S.H.T.O. -1983 and Interims thru 1988. Load Factor Design.

Design Loading:

HS 20-44, 15#/sq. Ft. Future Wearing Surface
Modified 24,000# Tandem Axle
Earth 120 #/Cu. Ft., Equivalent Fluid Pressure 45#/cu. Ft.
Fatigue Stress Case II

Design Unit Stress:

Class B Concrete (substructure) $f'_c = 3,000$ psi.
Class B1 Concrete (Safety Barrier Curb) $f'_c = 4,000$ psi.
Class B2 Concrete (Superstructure, except Safety Barrier Curb) $f'_c = 4,000$ psi.
Reinforcing Steel (Grade 60) $f_y = 60,000$ psi.
Structural Carbon Steel $f_y = 36,000$ psi.
Steel Pile $f_b = 9,000$ psi.

Fabricated steel Connections:

Field connections, High Strength Bolts $\frac{3}{4}" \phi$, holes $\frac{1}{16}" \phi$, except as noted.

Joint Filler:

All joint filler shall meet the requirements of Std. Spec. 1057.2.4, except as noted.

Reinforcing steel:

Minimum clearance to reinforcing steel shall be 1 1/2", unless otherwise shown.
All reinforcing bars in tops of substructure beams or caps shall be spaced to clear anchor bolts for bearings by at least 8".

Painting:

Paint system C by Contractor in accordance with Std. Spec. 712.12 & 712.13 (Color of the final field coat shall be green).

Areas to be encased in End Bent concrete shall be painted one coat of system C primer and scratched or damaged surfaces are to be touched up in the field before concrete is poured.

Construction Clearance:

A minimum vertical clearance of 14'-9" from crown of existing lanes and a minimum lateral clearance of 28'-0" centered on existing lanes shall be maintained during construction.

Traffic Maintained:

Traffic over structure to be maintained during construction.

Outline of old work is indicated by light dashed lines. Heavy lines indicate new work.

Contractor shall verify all dimensions in field before ordering new steel.

Bars banded in old concrete not removed shall be cleanly stripped and embedded into new concrete where possible. If length is available, old bars shall extend into new concrete at least 40 diameters for smooth bar and 30 diameters for deformed bars, unless otherwise noted.

Clean, lubricate & reset all bearings. See special provisions.

Cost of furnishing and installing Resin Anchor Assemblies shall be included in Contract unit price for concrete.

All dimension tied to existing elevations are subject to variance. For new top of substructure beam caps, use elevations given.

B.M. Elev. 843.38 on Lt. Wingwall Abut. #4 Adjoining Bridge.

BRIDGE OVER RTE. 269 (CHOUTEAU TRAFFICWAY)

STATE ROAD: INTERSTATE 35

IN KANSAS CITY

PROJECT NO.

STA. 371+13.15 EBL

JOB NO. 4-I-35-816

RTE. I-35


CLAY

COUNTY


DATE 1/13/89

DESIGNED Aug. 1988
DETAILED NOV. 1988
CHECKED NOV. 1988


STD.
STD. 706.35
L 642 R1

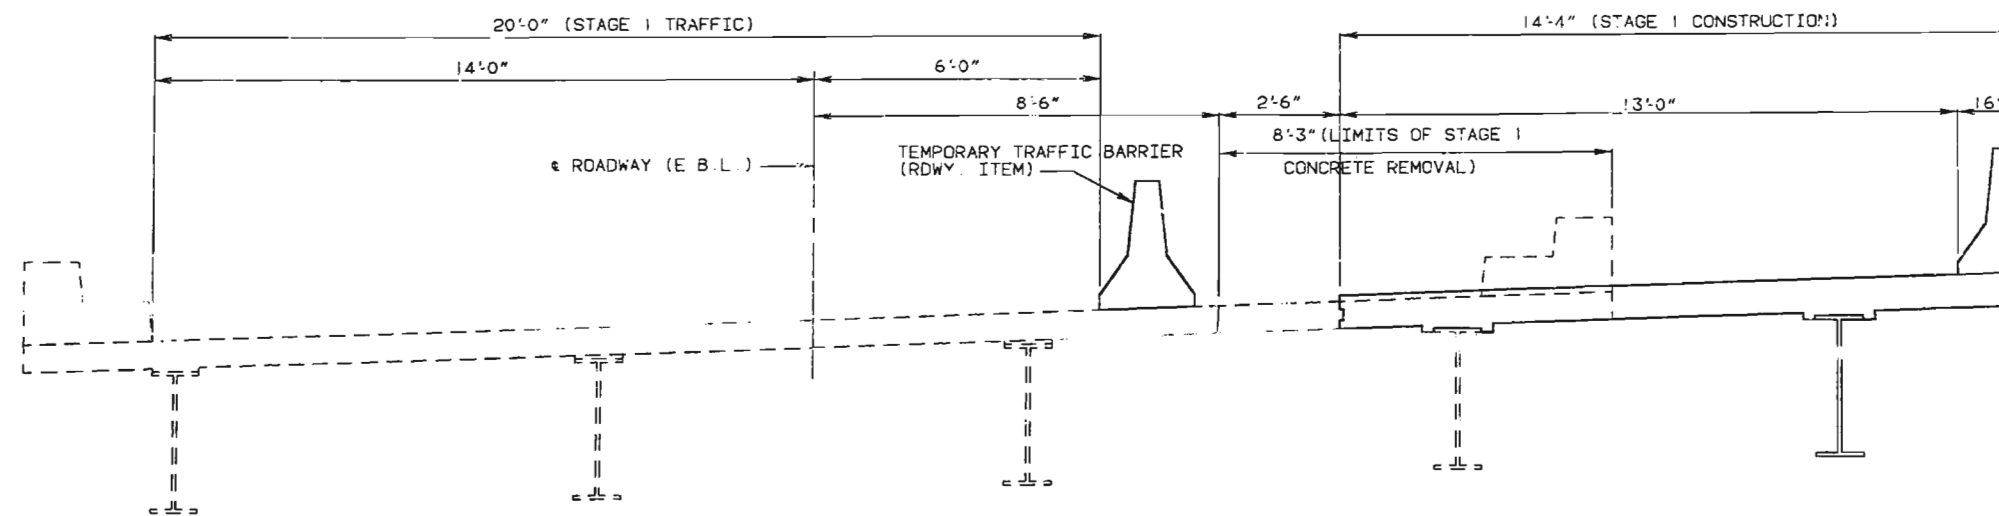

STAGE 1 CONSTRUCTION

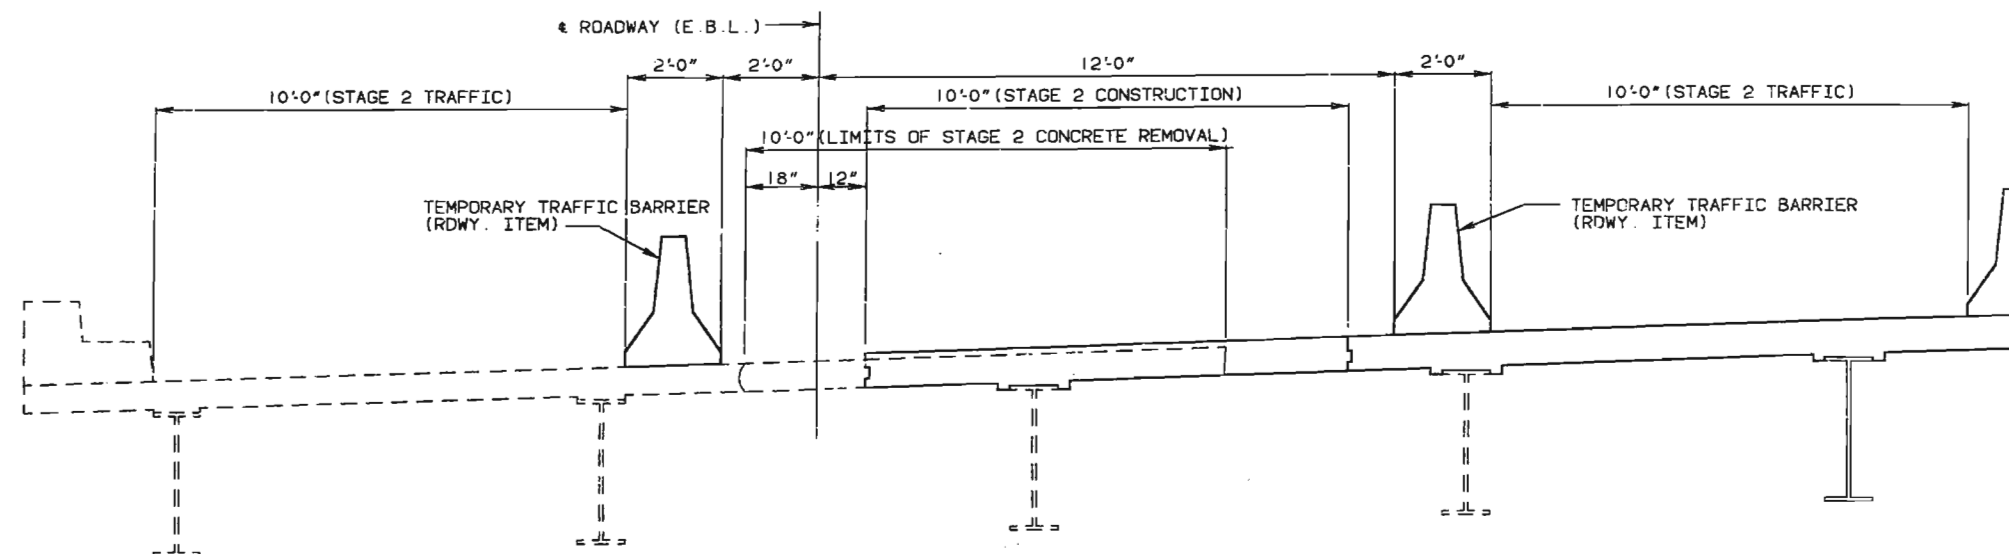

STAGE 2 CONSTRUCTION

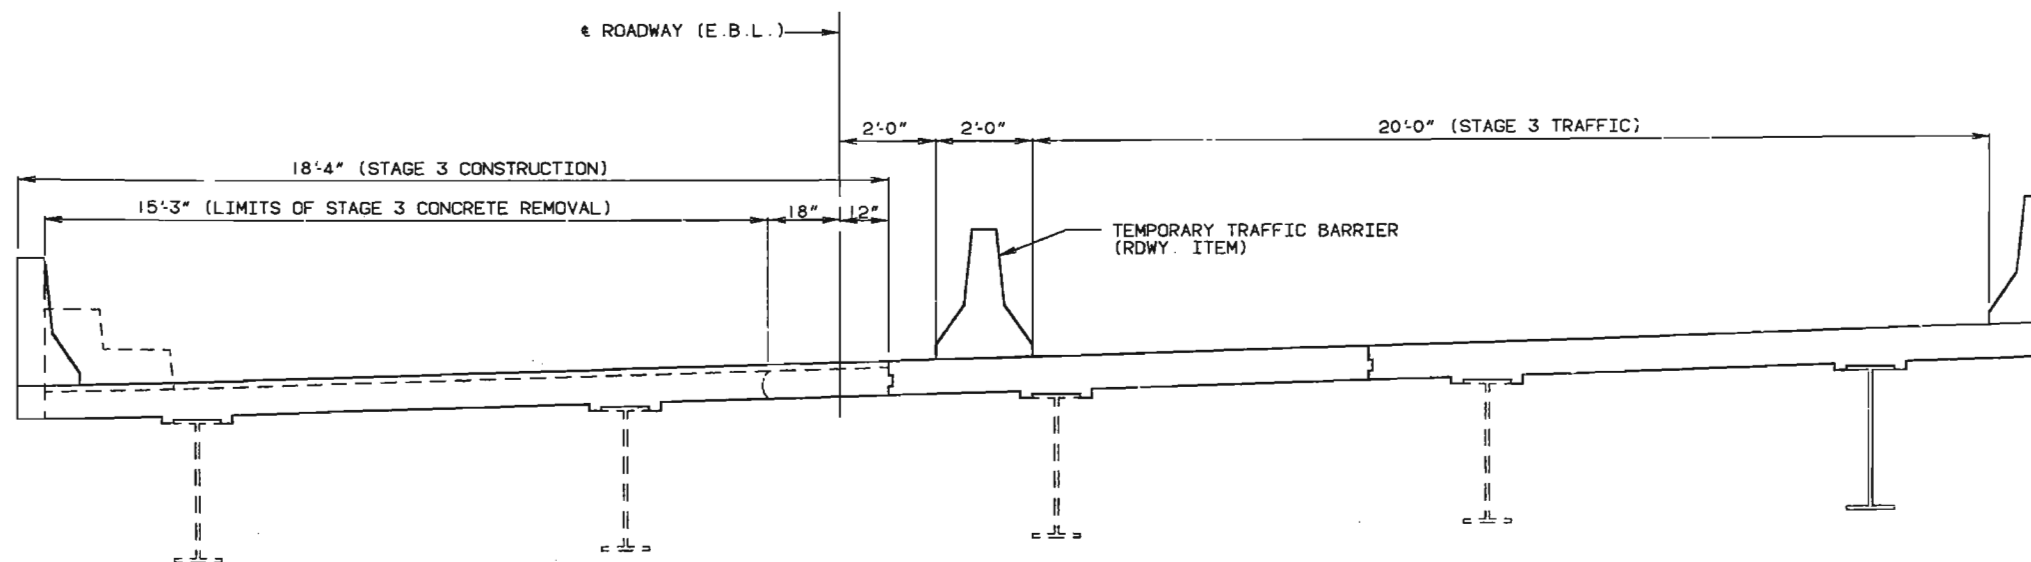


STAGE 3 CONSTRUCTION

STAGE CONSTRUCTION SEQUENCE

NOTE: ALL DIMENSIONS ARE RADIAL DIMENSIONS.







556 283

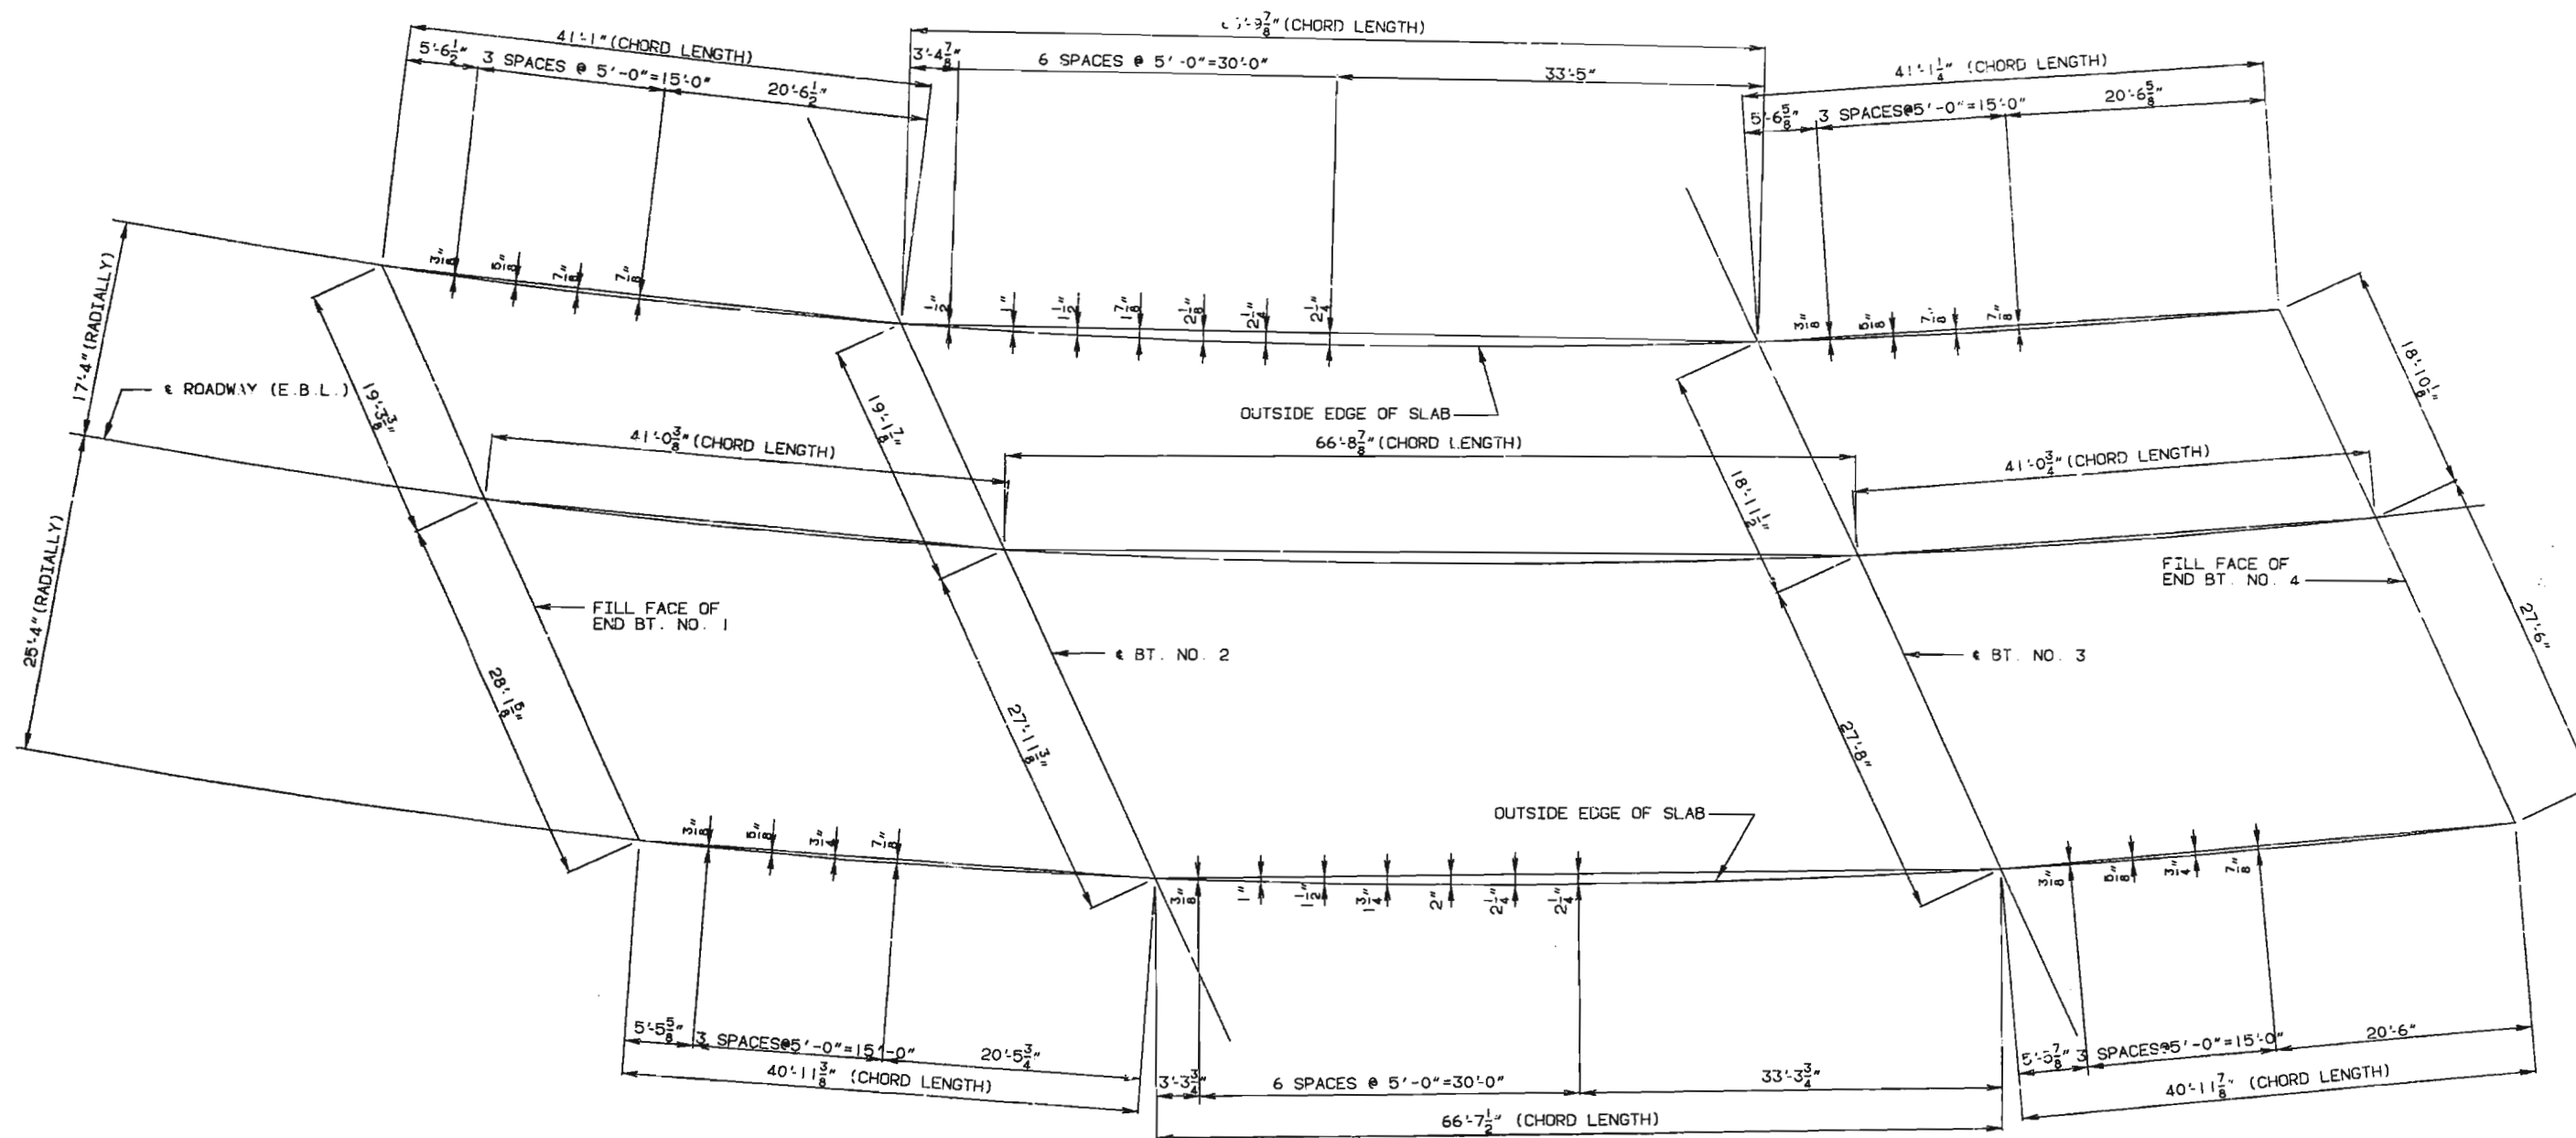

PLAN OF SLAB SHOWING CURVE ORDINATES

NOTE: ALL DIMENSIONS SHOWN ARE HORIZONTAL.

357204

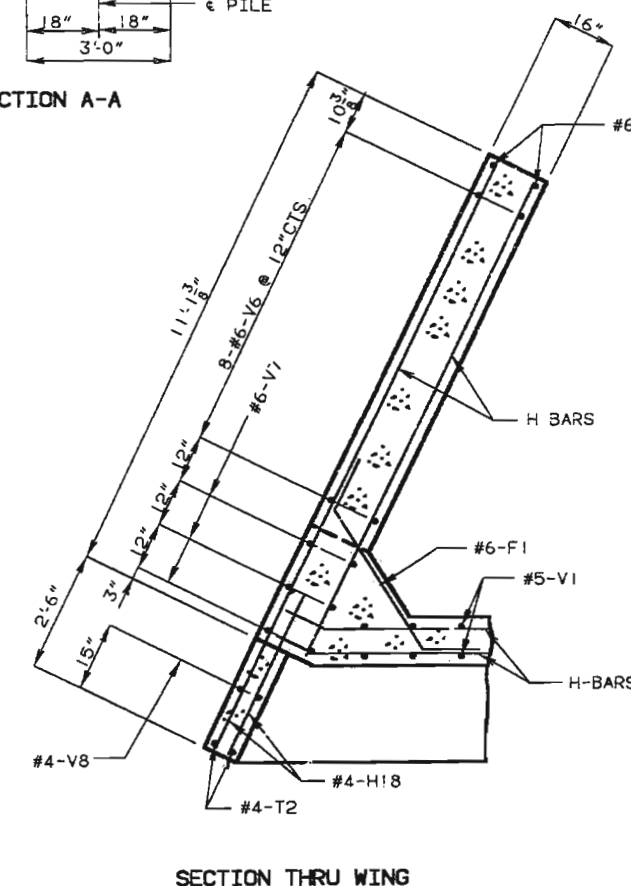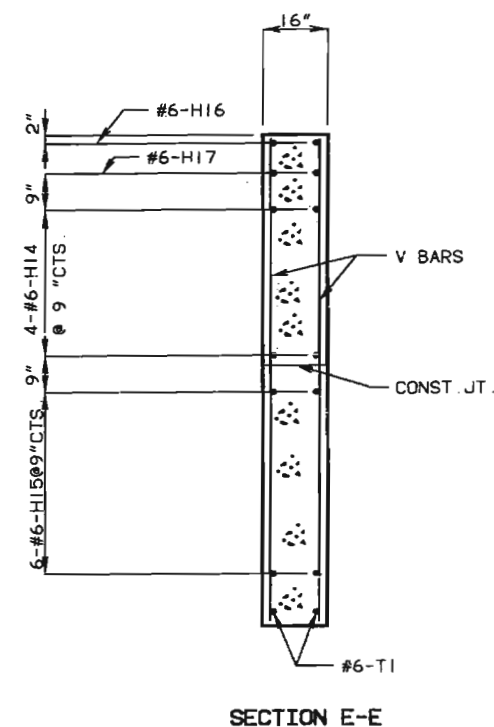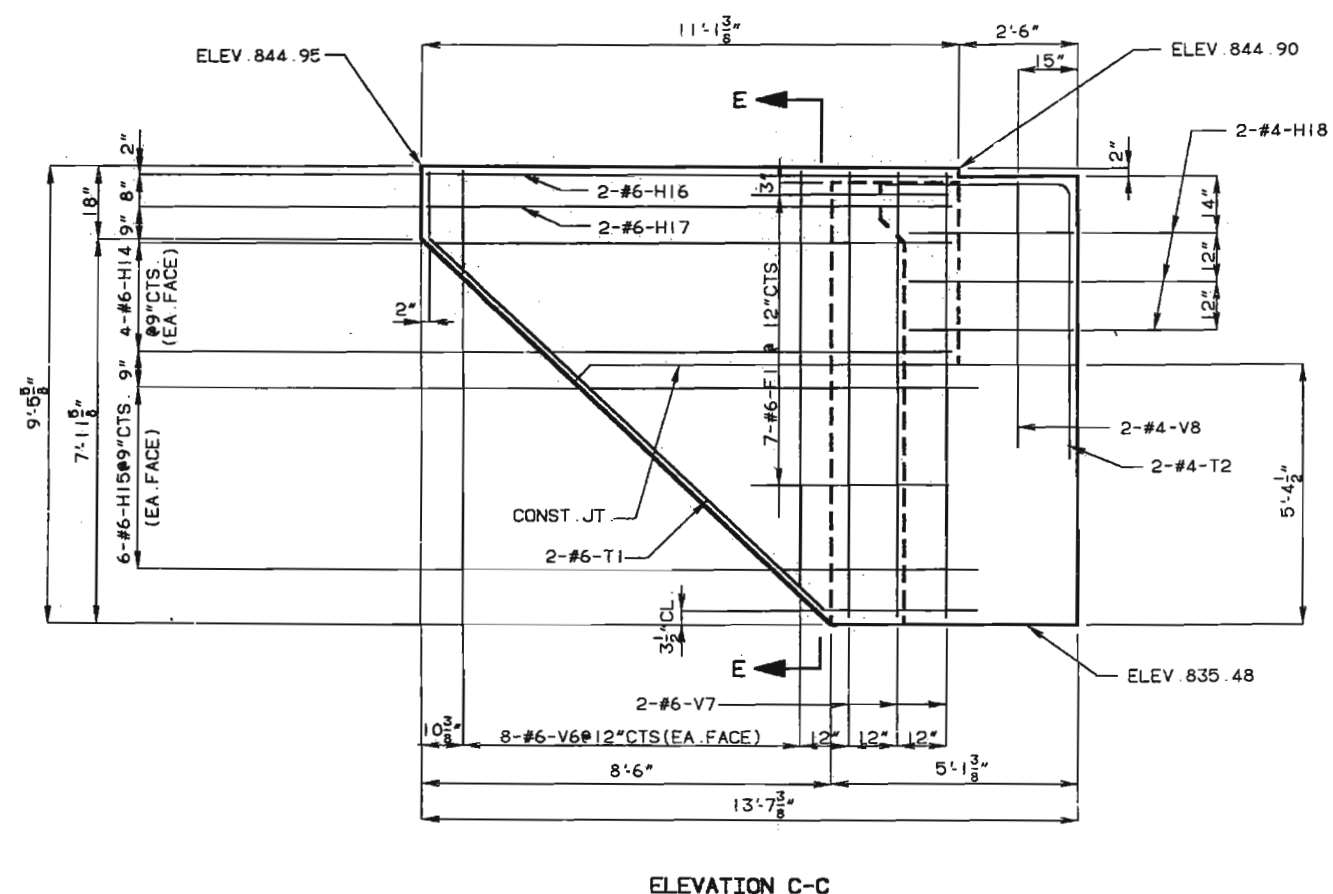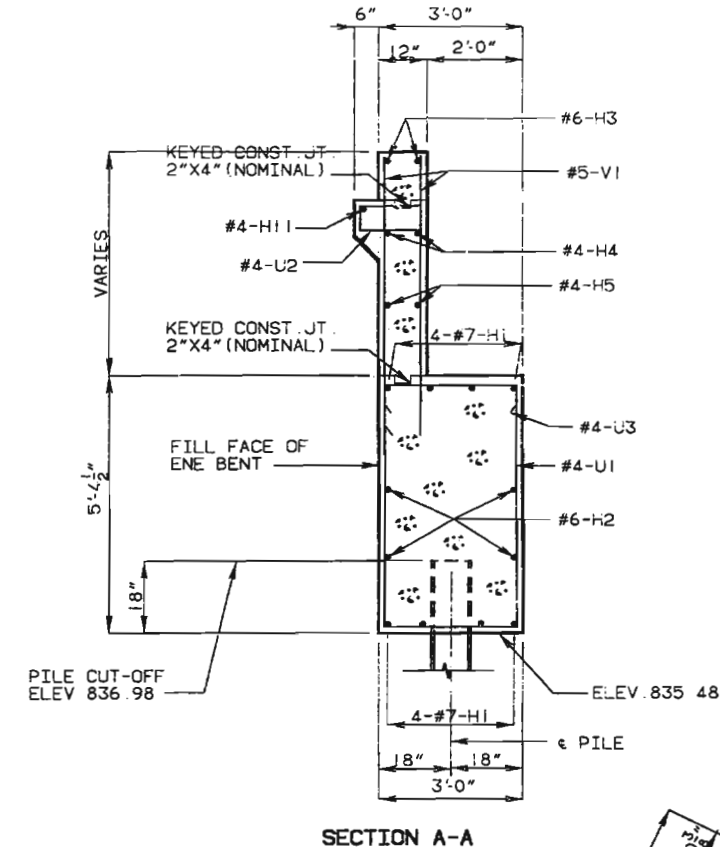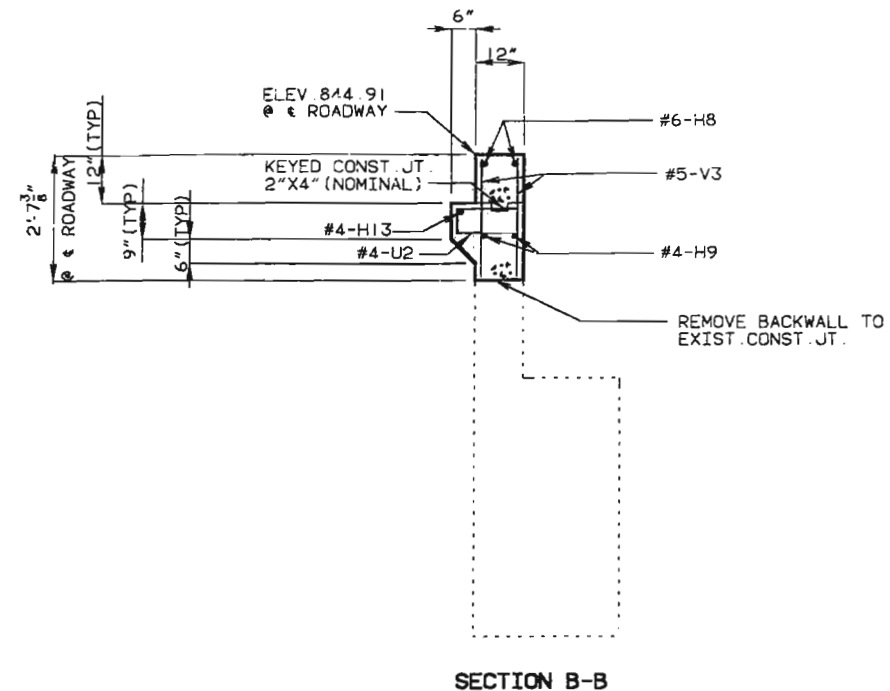
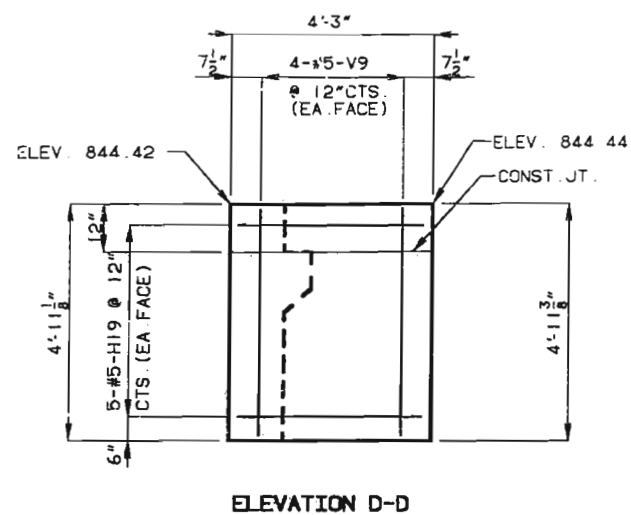


NOTE: FOR LOCATION OF SECTION A-A, SECTION B-B, ELEVATION C-C & ELEVATION D-D, SEE SHEET NO. 4.
FOR LOCATION AND SPACING OF #5-R BARS IN WINGS, SEE SHEET NO. 18.



DETAILS OF END BENT NO. 1

557 206

Note: The Contractor shall Use One Of The Resin Anchor Systems Listed In The Job Special Provisions. This Anchor System shall Be Installed According To The Manufacturers Specifications, Except That A #6, Grade 60 Reinforcing Bar 2'-6" Long shall Be Substituted For The 3/4" Threaded Rod Stud.

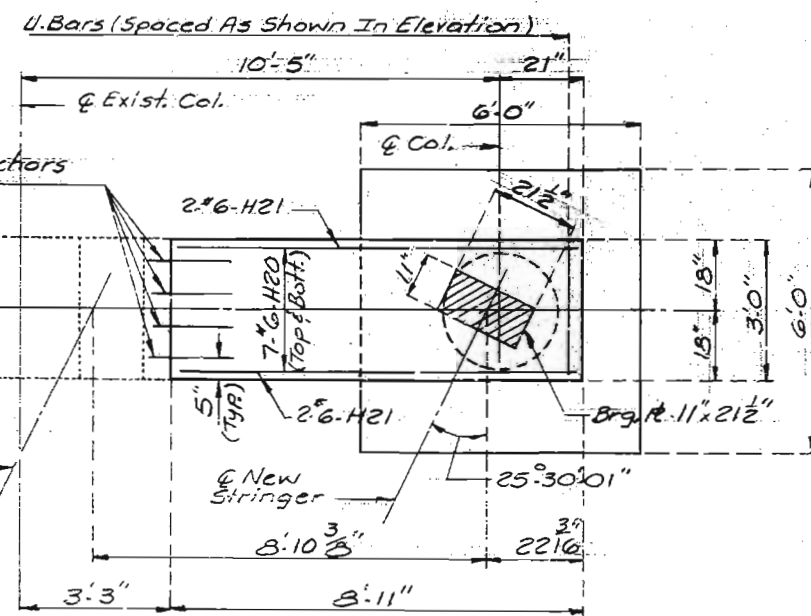
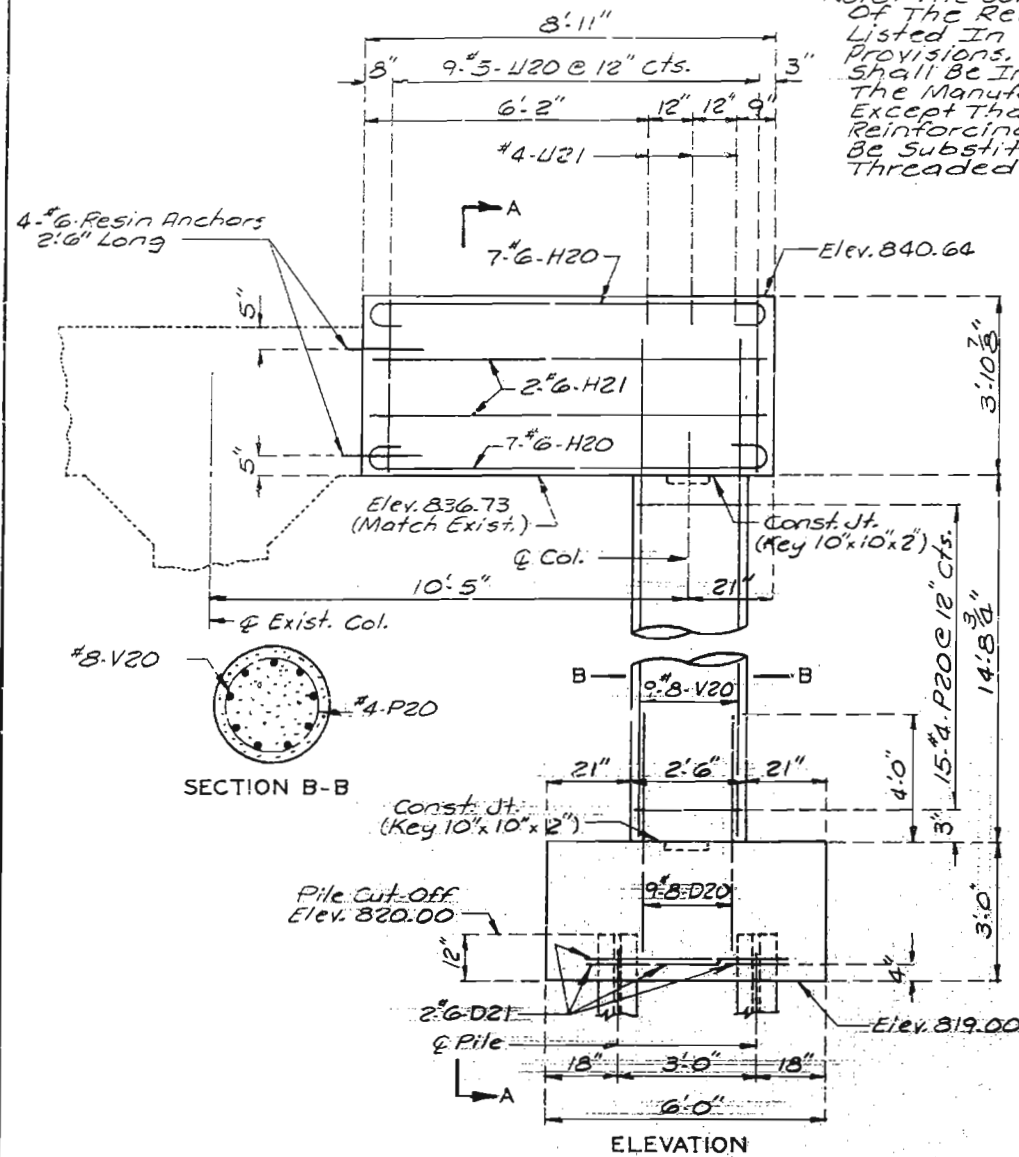


DETAILS OF INT. BENT NO. 2

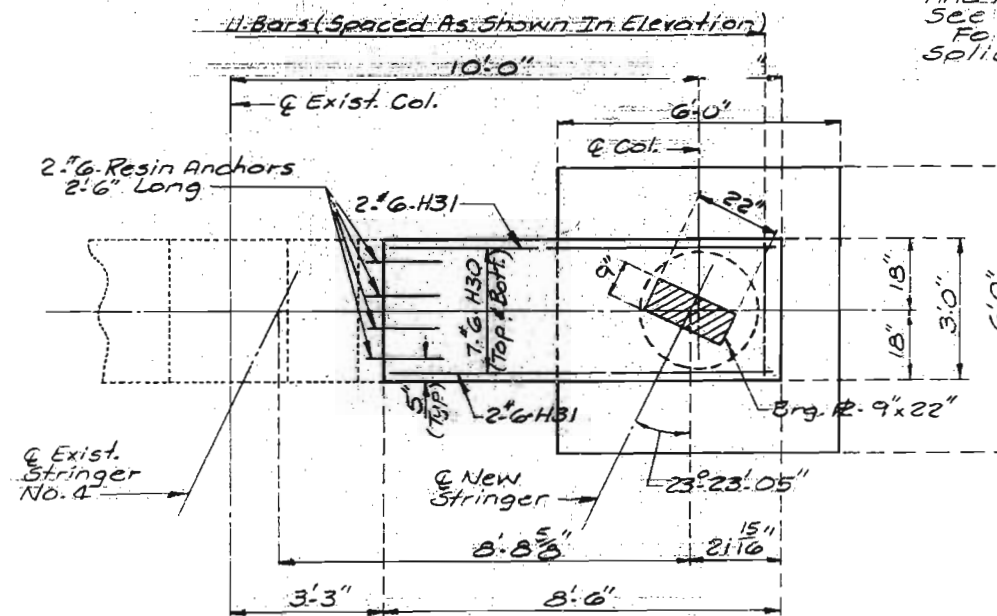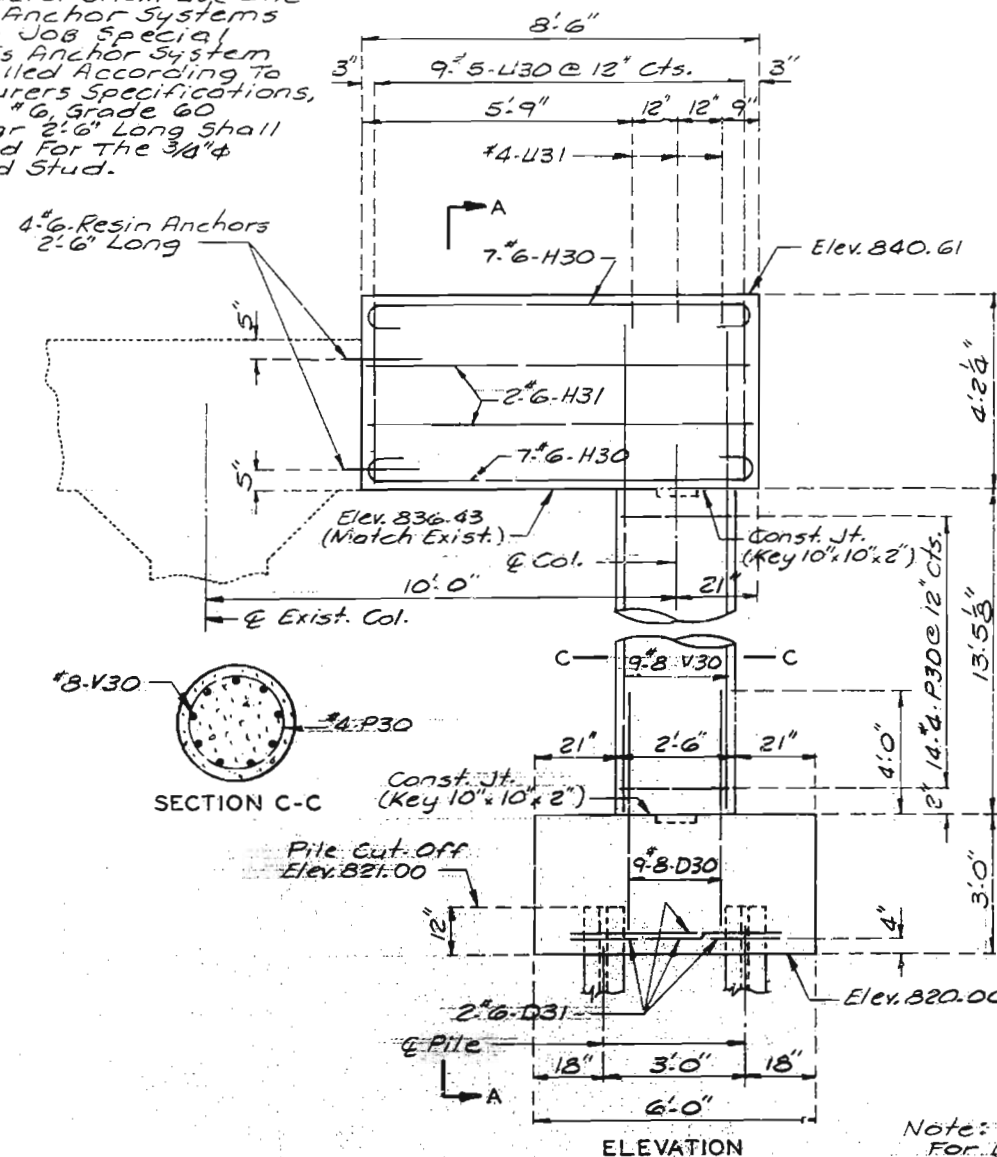


DETAILS OF INT. BENT NO. 3

Note: For Bearing Alignment And Anchor Bolt Well Details See Sheet No. 9. For Detail Of Steel Pile Splice See Sheet No. 4.

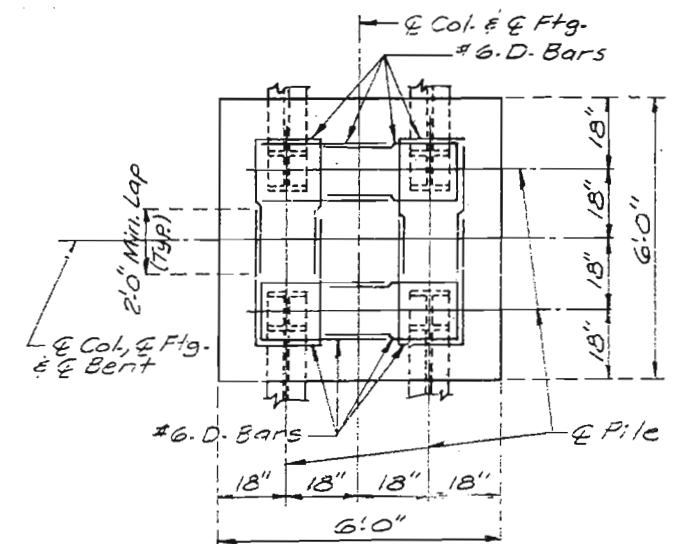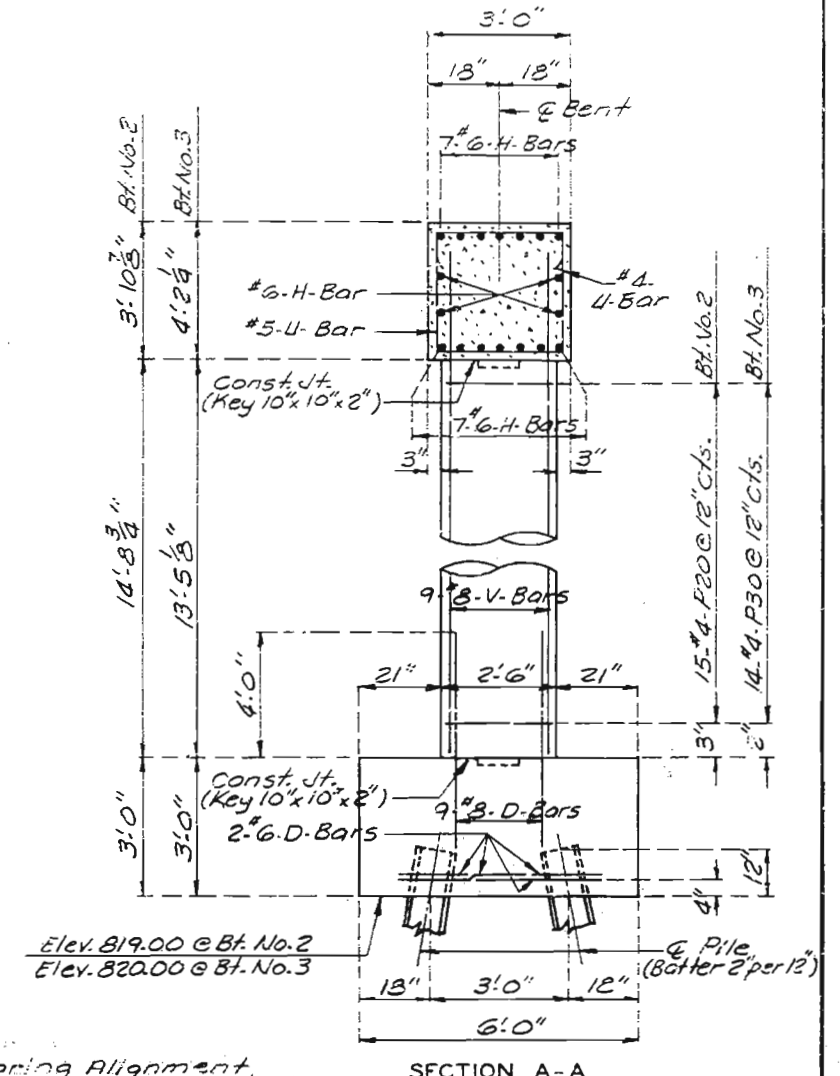


PLAN OF FOOTING SHOWING REINFORCEMENT

360 707

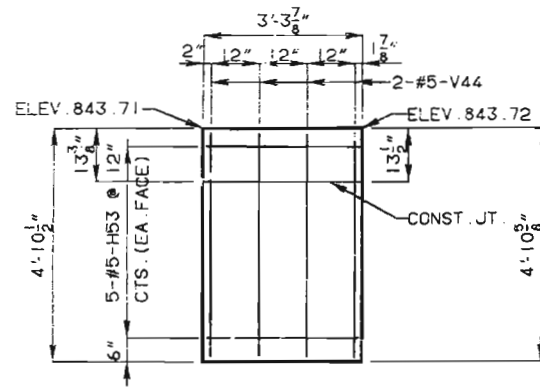


ELEVATION C-C


NOTE: FOR LOCATION OF SECTION A-A, ELEVATION B-B AND ELEVATION C-C, SEE SHEET NO. 7.
FOR LOCATION AND SPACING OF #5-R BARS IN WING, SEE SHEET NO. 18.

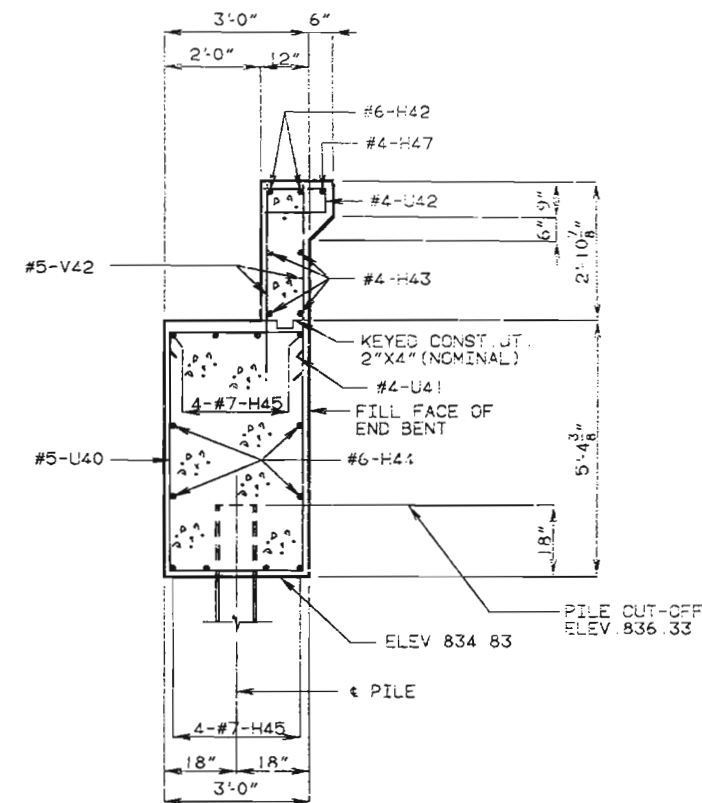


SECTION A-A

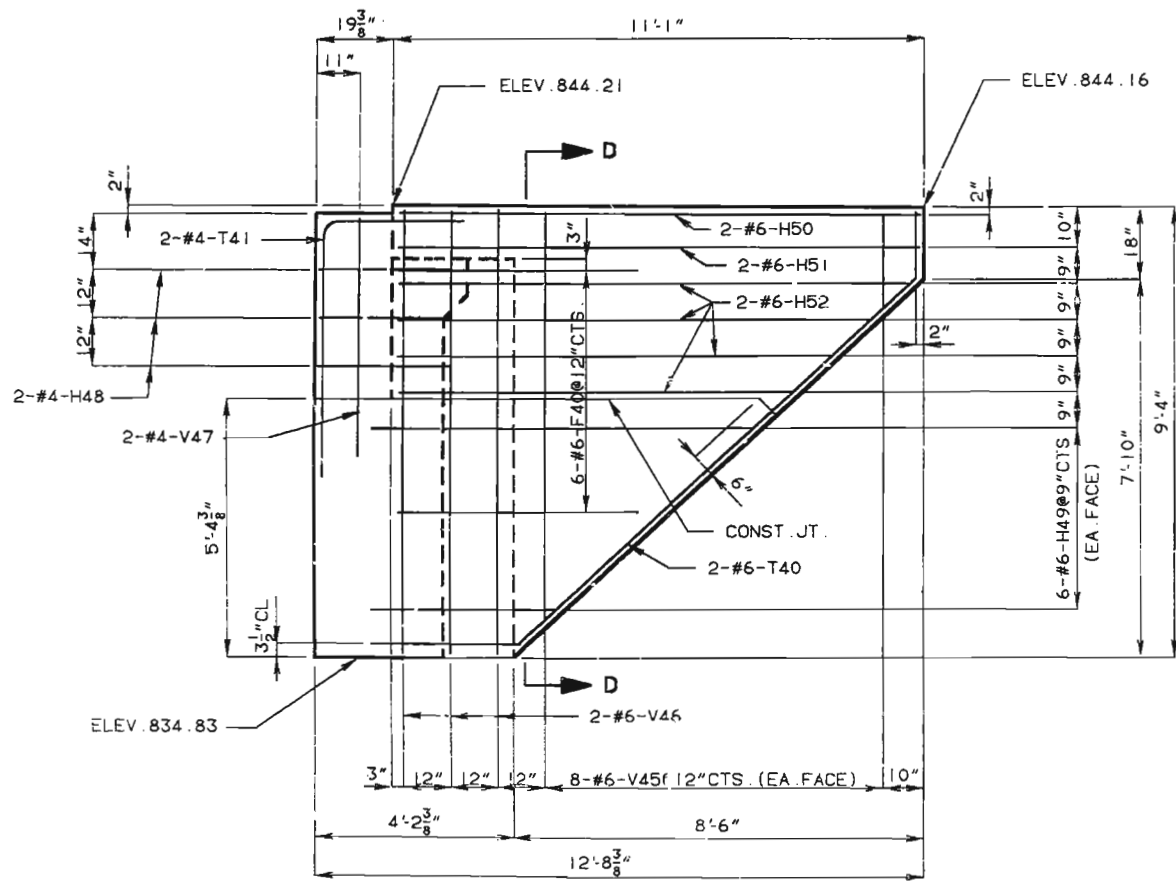

ELEVATION B-B

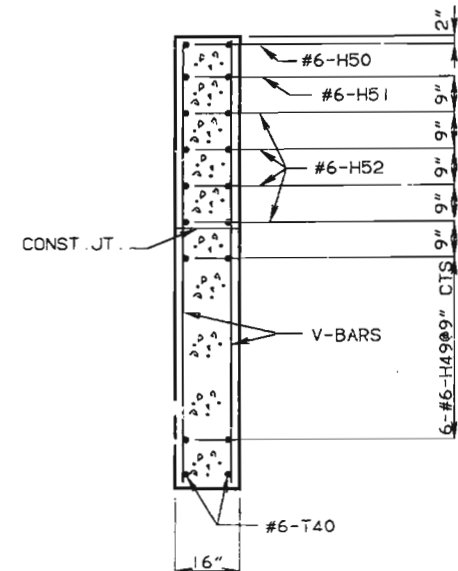


SECTION D-D

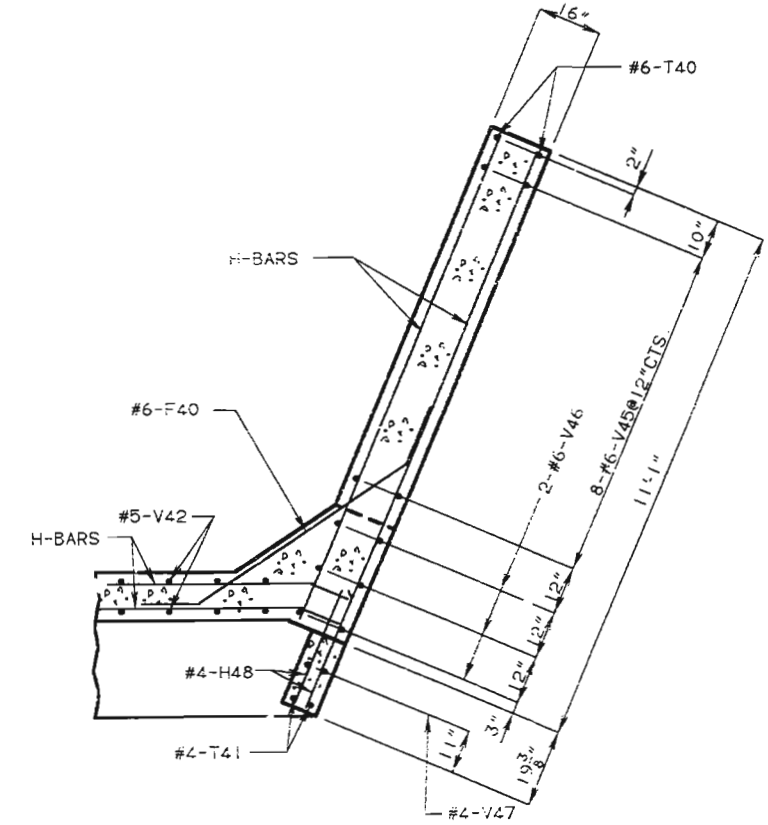

SECTION THRU WING

DETAILS OF END BENT NO. 4



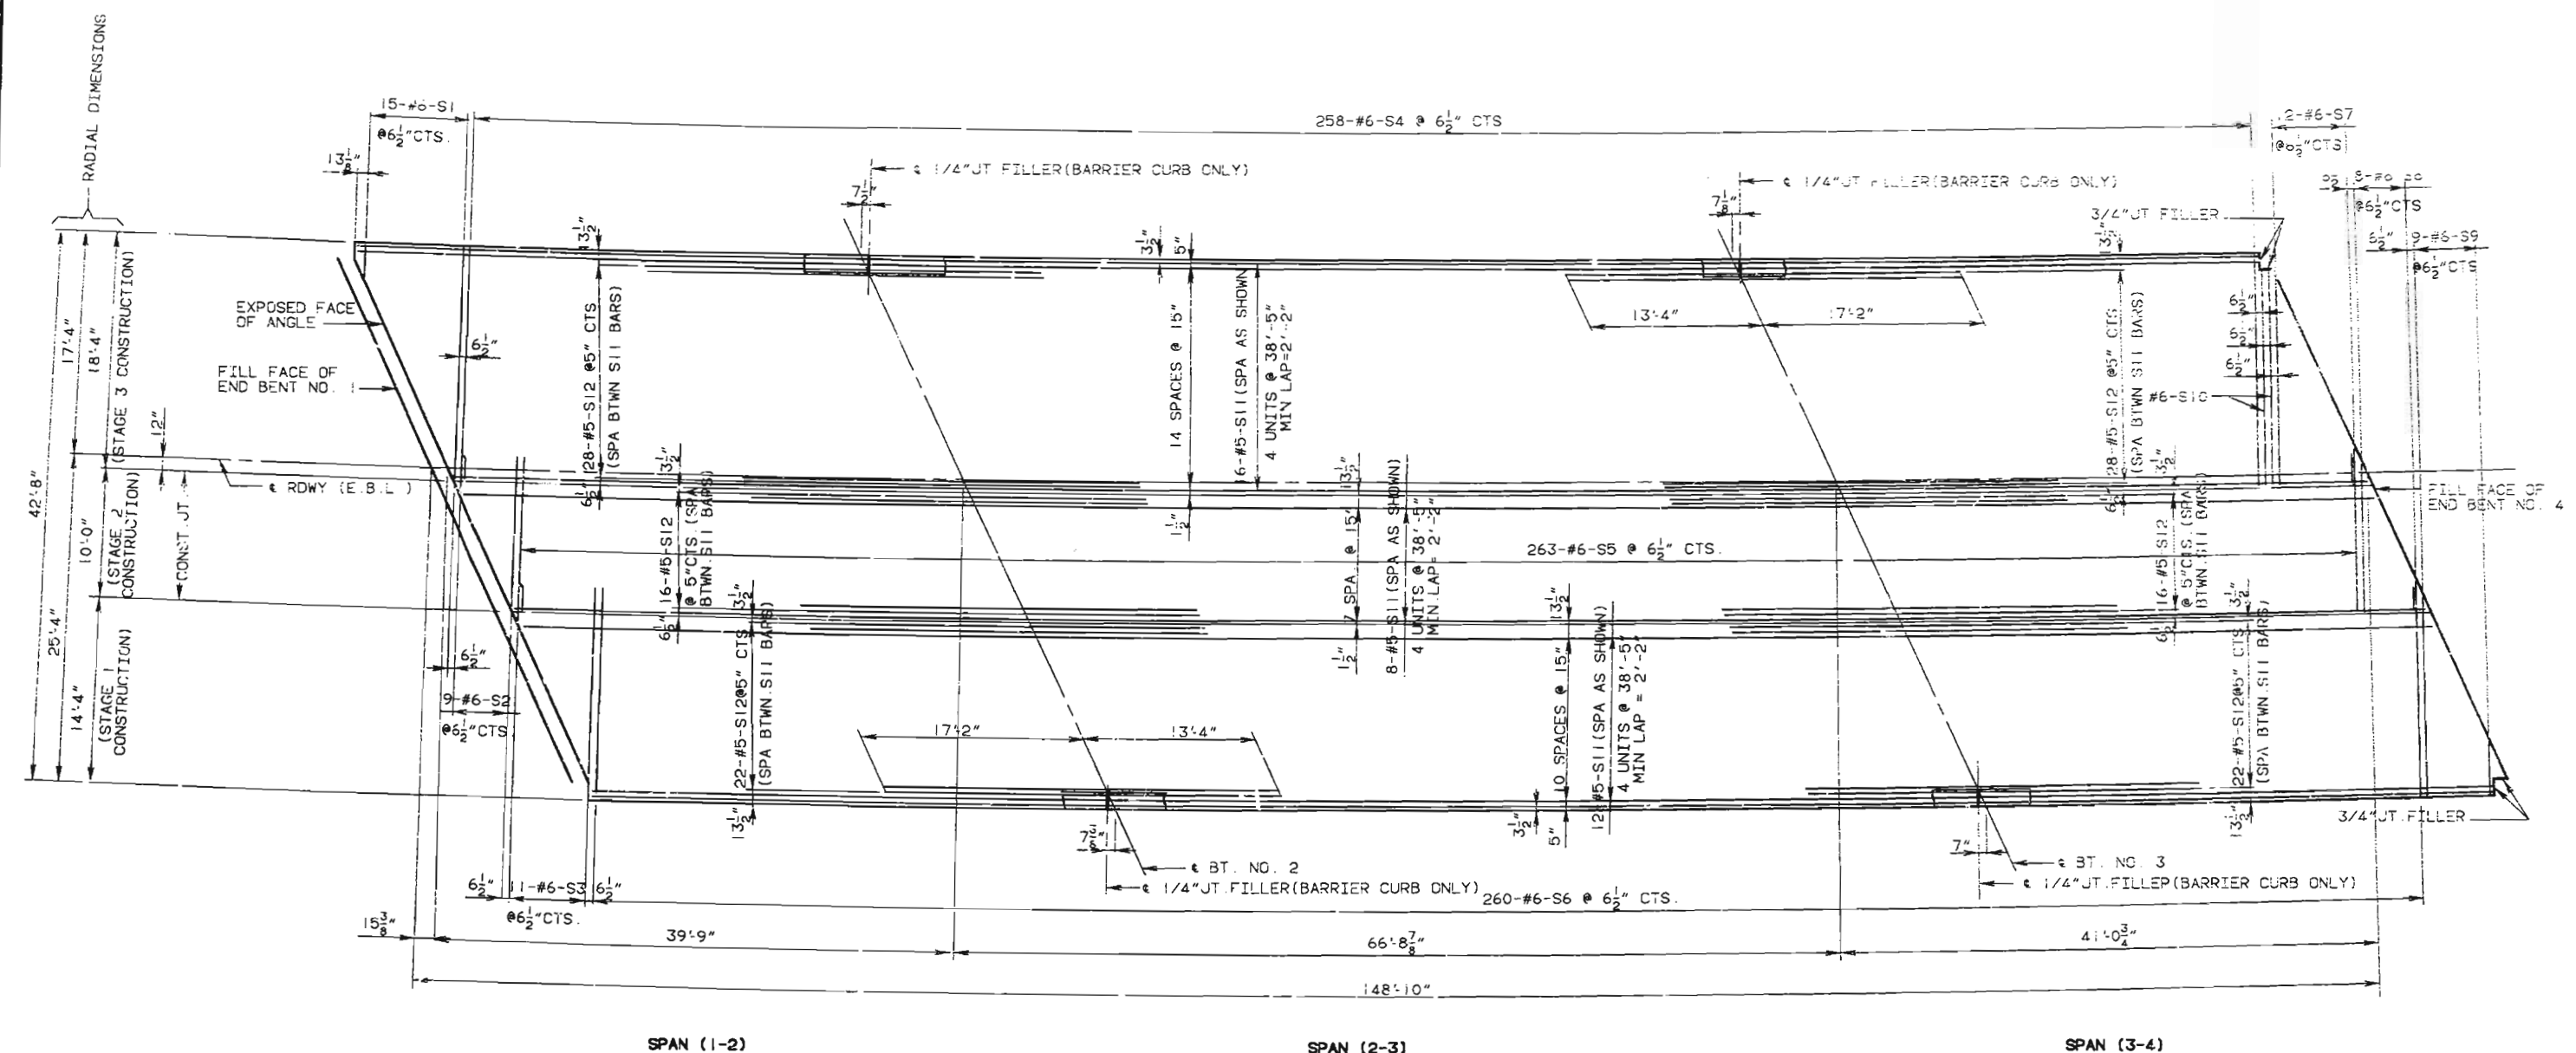

PLAN OF SLAB SHOWING TOP REINFORCING


NOTE: LONGITUDINAL DIMENSIONS SHOWN ARE HORIZONTAL DIMENSIONS AT ROADWAY. LONGITUDINAL REINFORCEMENT TO BE PLACED PARALLEL TO ROADWAY. TRANSVERSE REINFORCING TO BE PLACED RADIAL AND SPACED ALONG THE OUTSIDE EDGE OF SLAB. SLAB LENGTHS SHOWN ARE BASED ON EXPANSION GAP AS NOTED ON SHEET NO. 12. ADJUST SLAB LENGTH FOR ANY CHANGES IN EXPANSION GAP AS NOTED ON SHEET NO. 12. LONGITUDINAL REINFORCING STEEL SHALL BE PLACED SO THAT ENDS SHALL NOT BE MORE THAN 1" FROM VERTICAL LEG OF ANGLE AT EXPANSION DEVICE. FOR DETAILS AND REINFORCEMENT OF SAFETY BARRIER CURB NOT SHOWN, SEE SHEET NO. 18.

BOTTOM OF SLAB ELEVATIONS AT QUARTER POINTS

	BRG. BT#1	.25	.50	.75	BRG. BT#2	.25	.50	.75	BRG. BT#3	.25	.50	.75	BRG. BT#4
1	843.82	843.77	843.72	843.68	843.63	843.55	843.47	843.40	843.32	843.27	843.22	843.18	843.13
2	844.06	844.02	843.97	843.93	843.88	843.80	843.72	843.65	843.57	843.52	843.47	843.43	843.38
3	844.31	844.27	844.22	844.18	844.13	844.05	843.97	843.90	843.82	843.77	843.73	843.68	843.63
4	844.56	844.52	844.47	844.43	844.38	844.31	844.23	844.15	844.07	844.02	843.98	843.93	843.89
NEW STR.	844.78	844.74	844.69	844.65	844.61	844.53	844.45	844.37	844.29	844.25	844.20	844.16	844.11

NOTE: BOTTOM OF SLAB ELEVATIONS DO NOT INCLUDE ALLOWANCE FOR DEAD LOAD DEFLECTION.

367 214



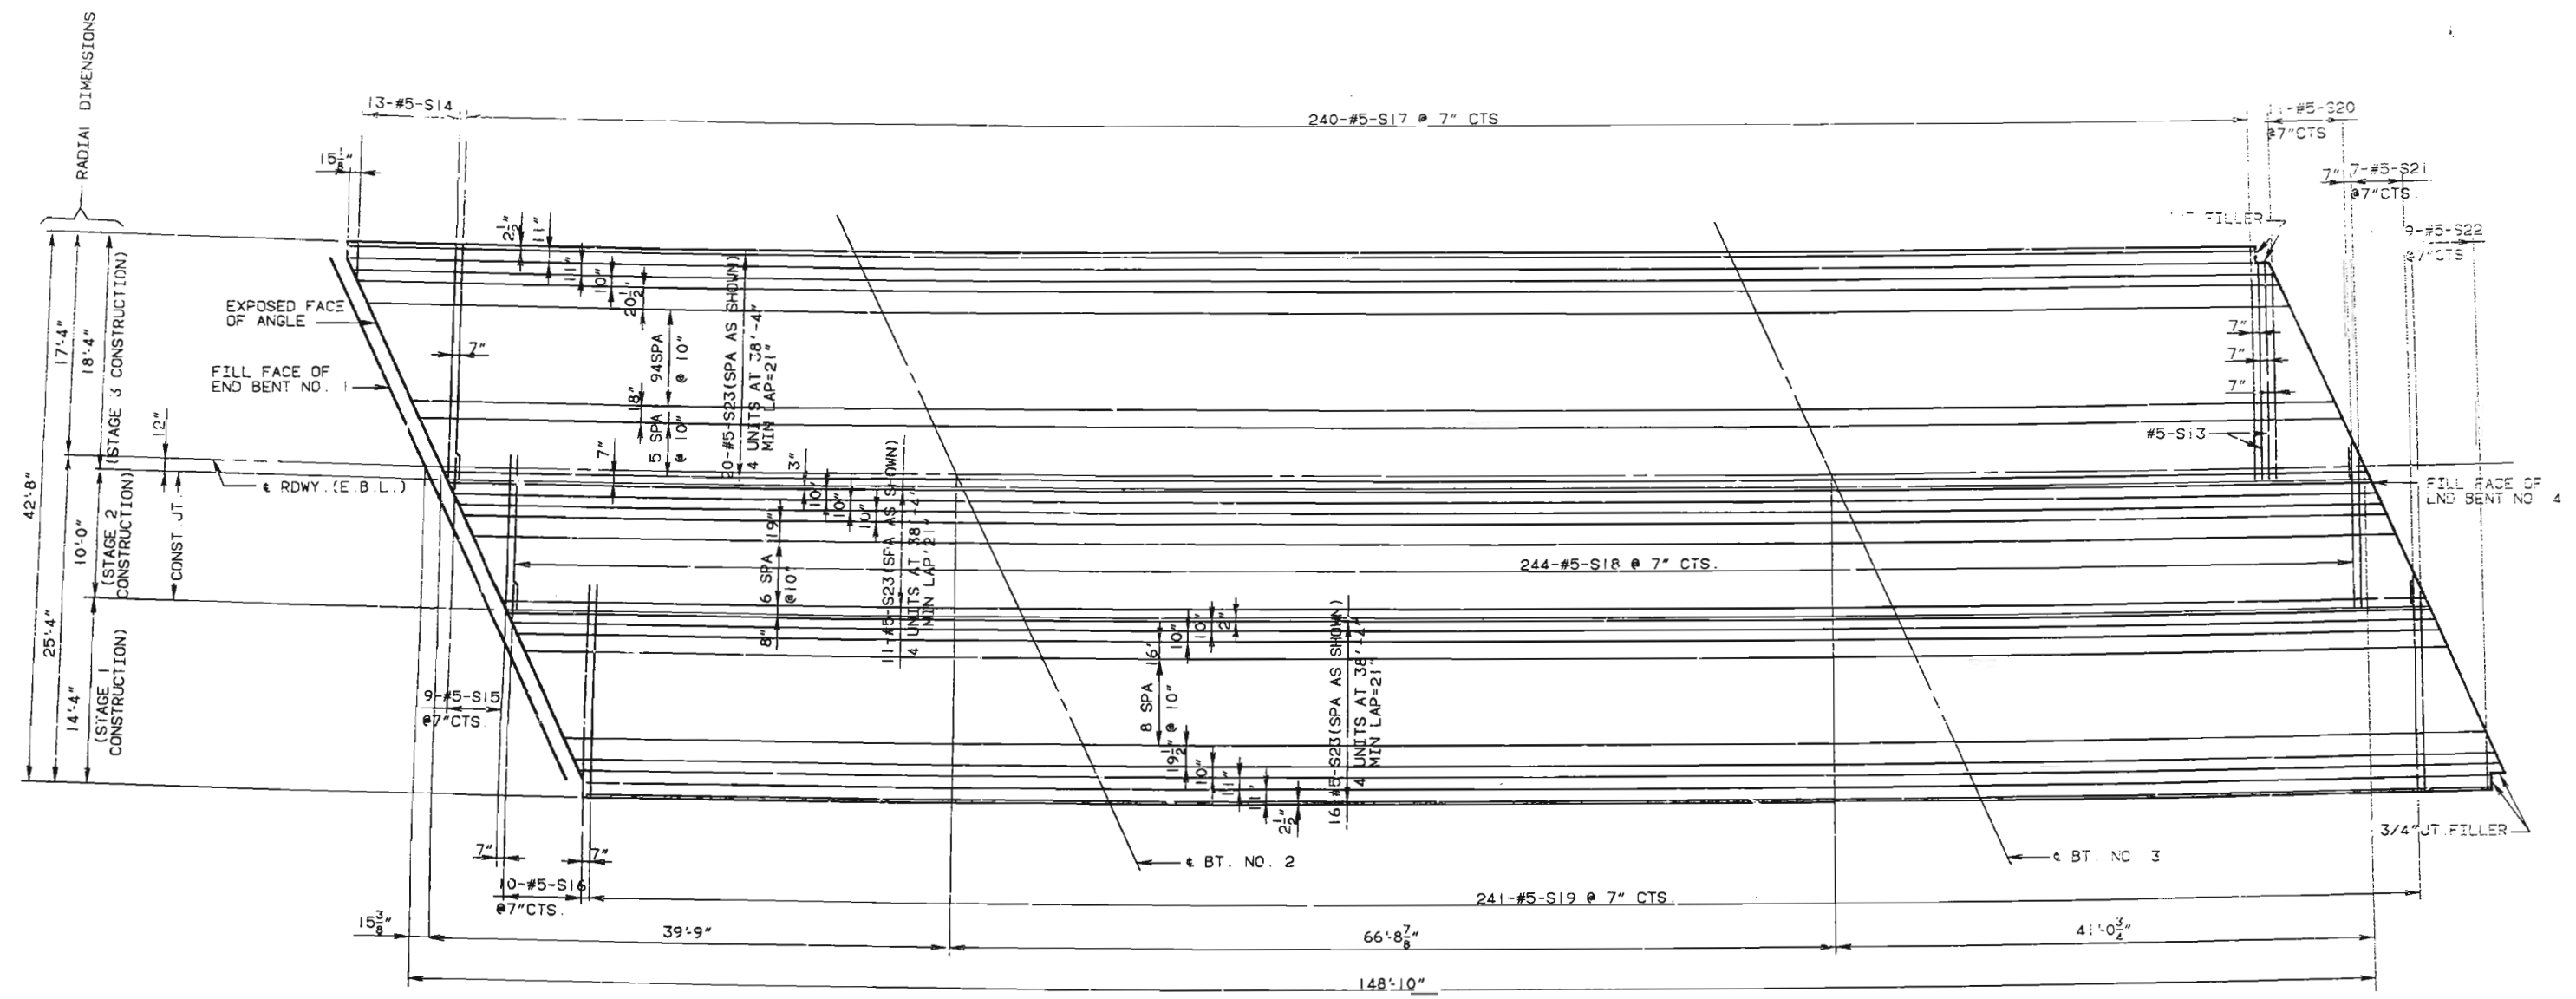


SPAN (1-2) SPAN (2-3) SPAN (3-4)

PLAN OF SLAB SHOWING BOTTOM REINFORCING


NOTE: LONGITUDINAL DIMENSIONS SHOWN ARE HORIZONTAL DIMENSIONS ALONG ROADWAY.
 LONGITUDINAL REINFORCEMENT TO BE PLACED PARALLEL TO ROADWAY.
 TRANSVERSE REINFORCEMENT TO BE PLACED RADIAL AND SPACED
 ALONG OUTSIDE EDGE OF SLAB.
 SLAB LENGTHS SHOWN ARE BASED ON EXPANSION GAP AS NOTED ON
 SHEET NO. 12. ADJUST SLAB LENGTH FOR ANY CHANGES IN EXPANSION GAP AS
 NOTED ON SHEET NO. 12.
 FOR DETAILS AND REINFORCEMENT OF SAFETY BARRIER CURB NOT SHOWN,
 SEE SHEET NO. 18.

368 JTS

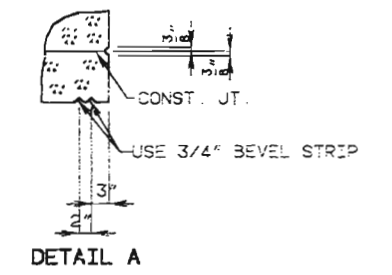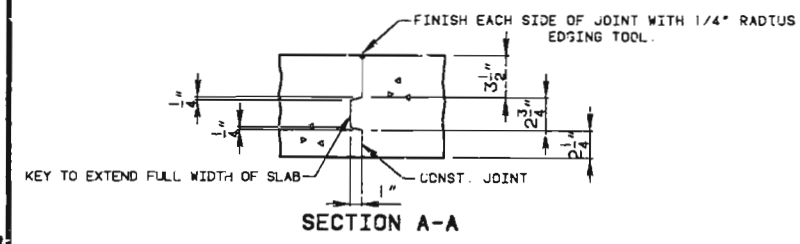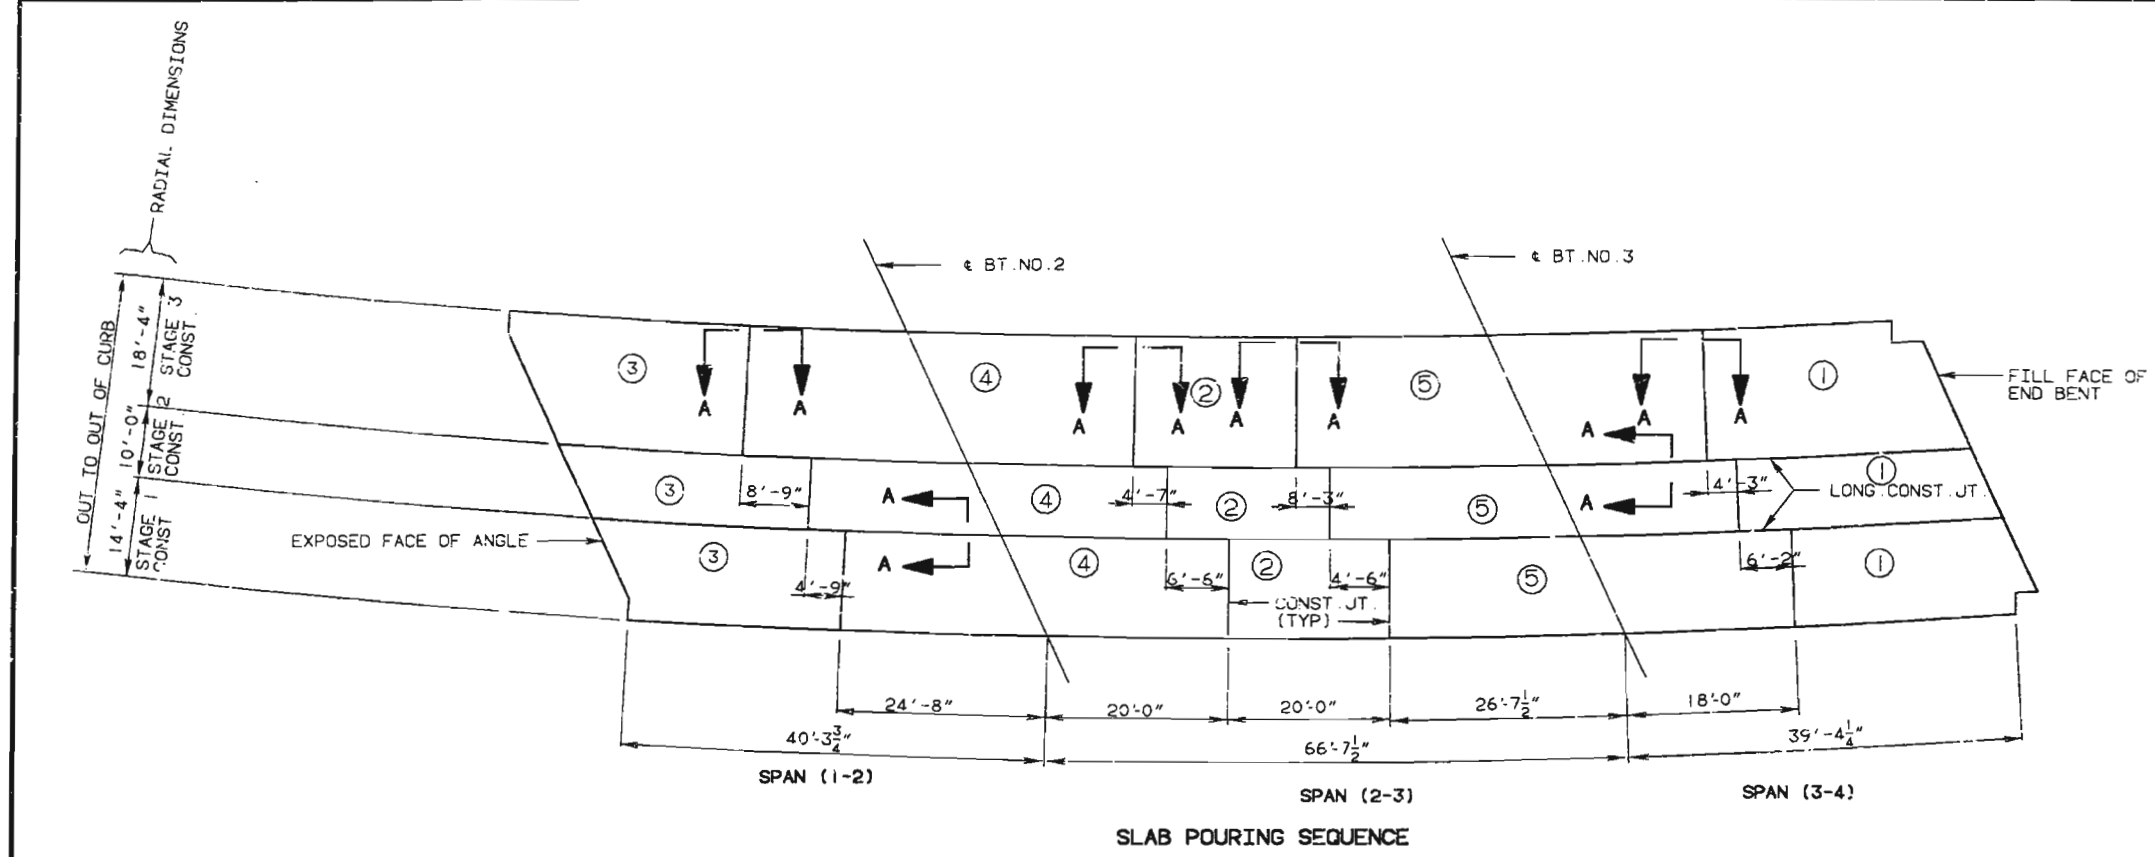

	SEQUENCE OF POURS					MINIMUM RATE OF POUR (CUBIC YARDS PER HOUR)	
	DIRECTION					WITH RETARDER	NO RETARDER
BASIC SEQUENCE	1	2	3	4	5	25	25
EITHER DIRECTION							
ALTERNATE POURS TO THE BASIC SKIP SEQUENCE ARE SUBJECT TO THE APPROVAL OF THE ENGINEER IN ACCORDANCE WITH SECTION 703.3.12.4 OF MISSOURI STANDARD SPECIFICATIONS.							
ALTERNATE "A" POURS	1	5 + 2	4 + 3			25	25
	END TO 5	1 TO 4	2 TO END				
ALTERNATE "B" POURS	1 + 5 + 2	4 + 3				25	25
	END TO 4	2 TO END					
ALTERNATE "C" POURS	1 + 5 + 2 + 4 + 3					25	25
	END TO END						

THE CONTRACTOR SHALL POUR AND SATISFACTORILY FINISH THE SLAB POURS AT THE RATE GIVEN ABOVE. RETARDER, IF USED, SHALL BE AN APPROVED TYPE AND RETARD THE SET OF CONCRETE TO 2.5 HOURS.

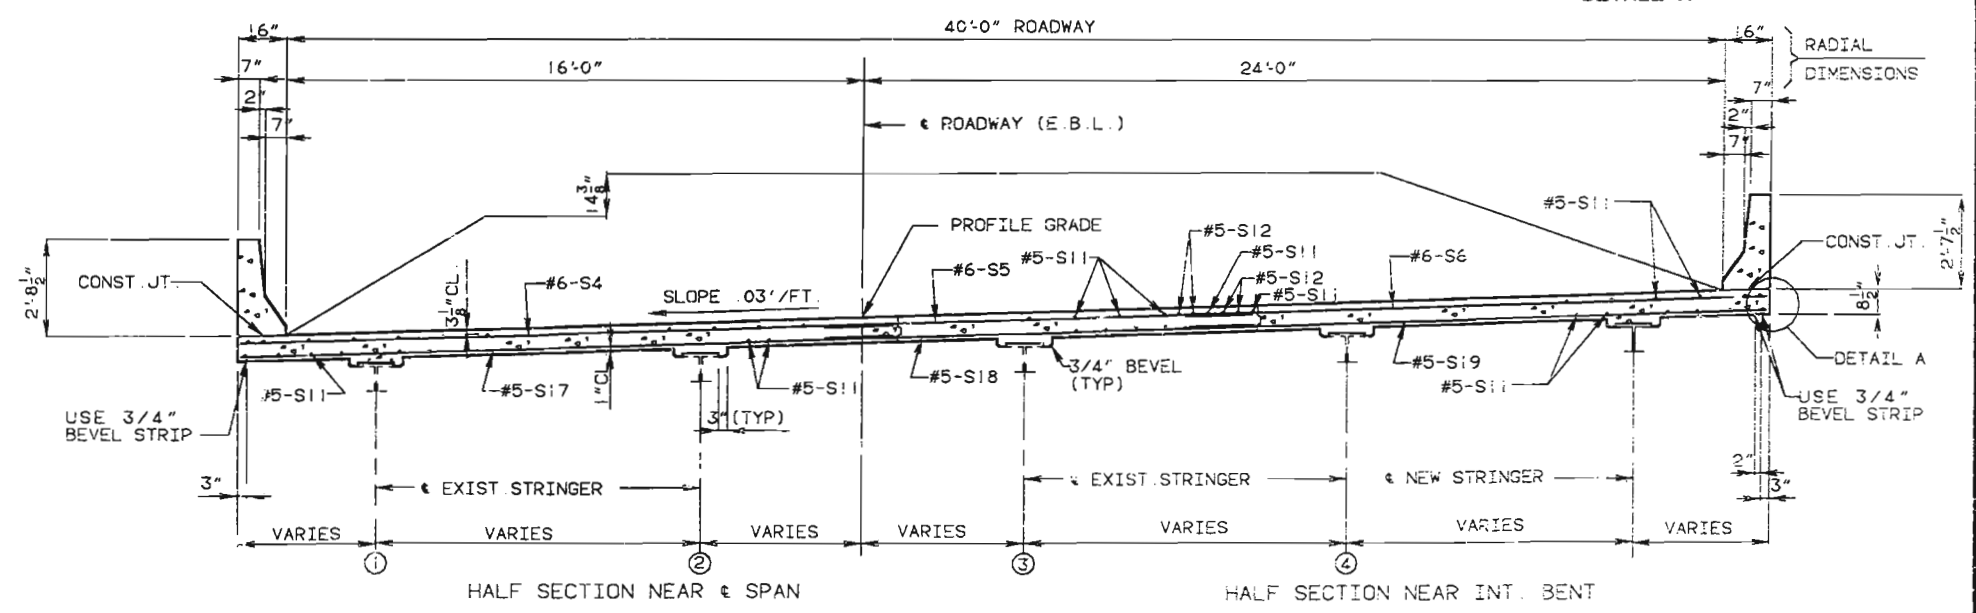

FOR DETAILS AND REINFORCEMENT OF SAFETY BARRIER CURB, SEE SHEET NO. 18.


DETAILED SEPT. 19 88
CHECKED NOV. 19 88

NOTE: THIS DRAWING IS NOT TO SCALE. FOLLOW DIMENSIONS.


SHEET NO. 15 OF 20

CLAY COUNTY


L-642R1

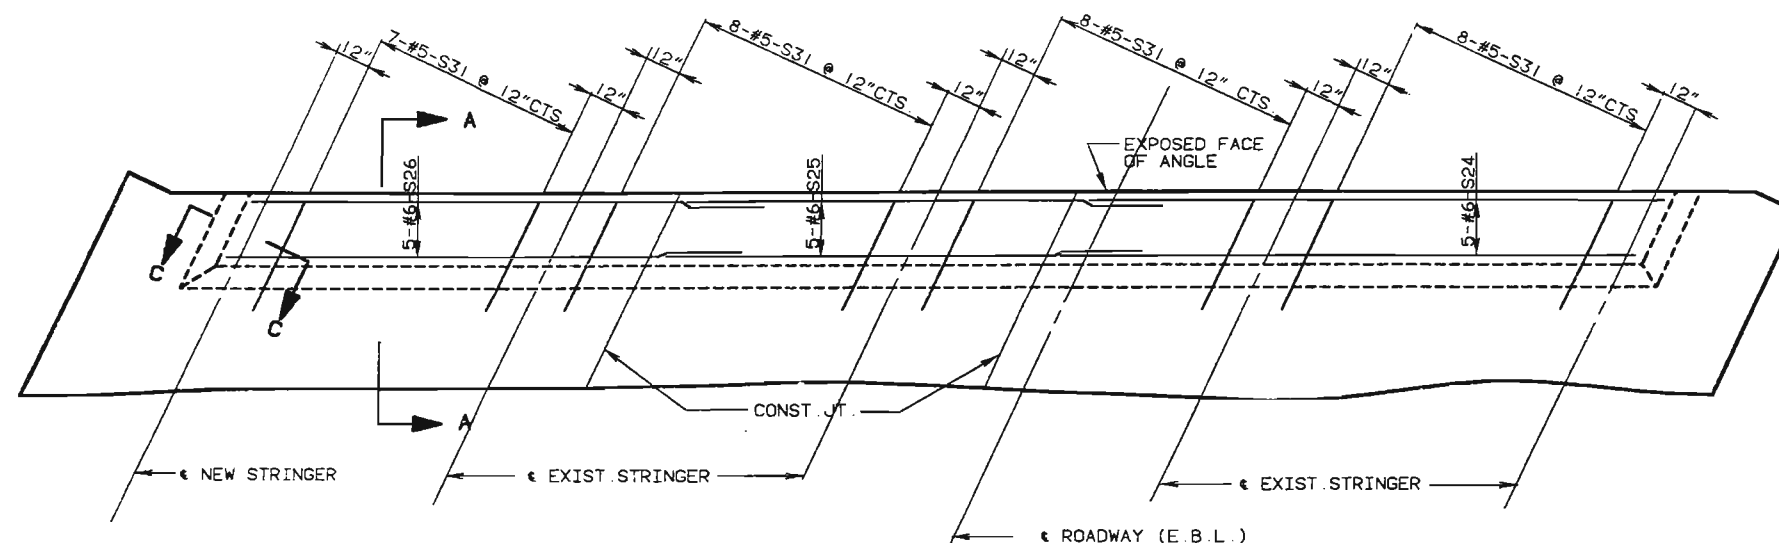


PLAN OF SLAB NEAR END BENT NO. 1

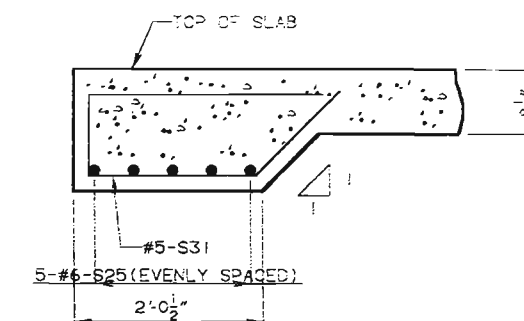


SECTION A-A

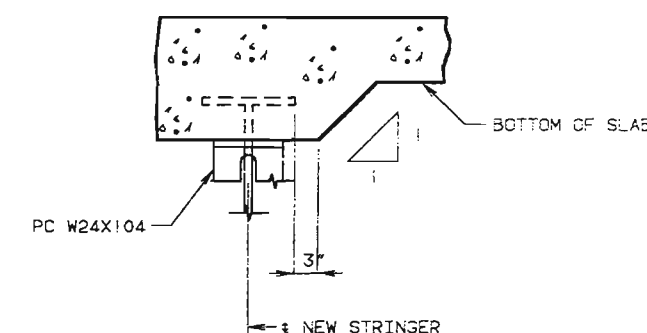

SECTION C-C

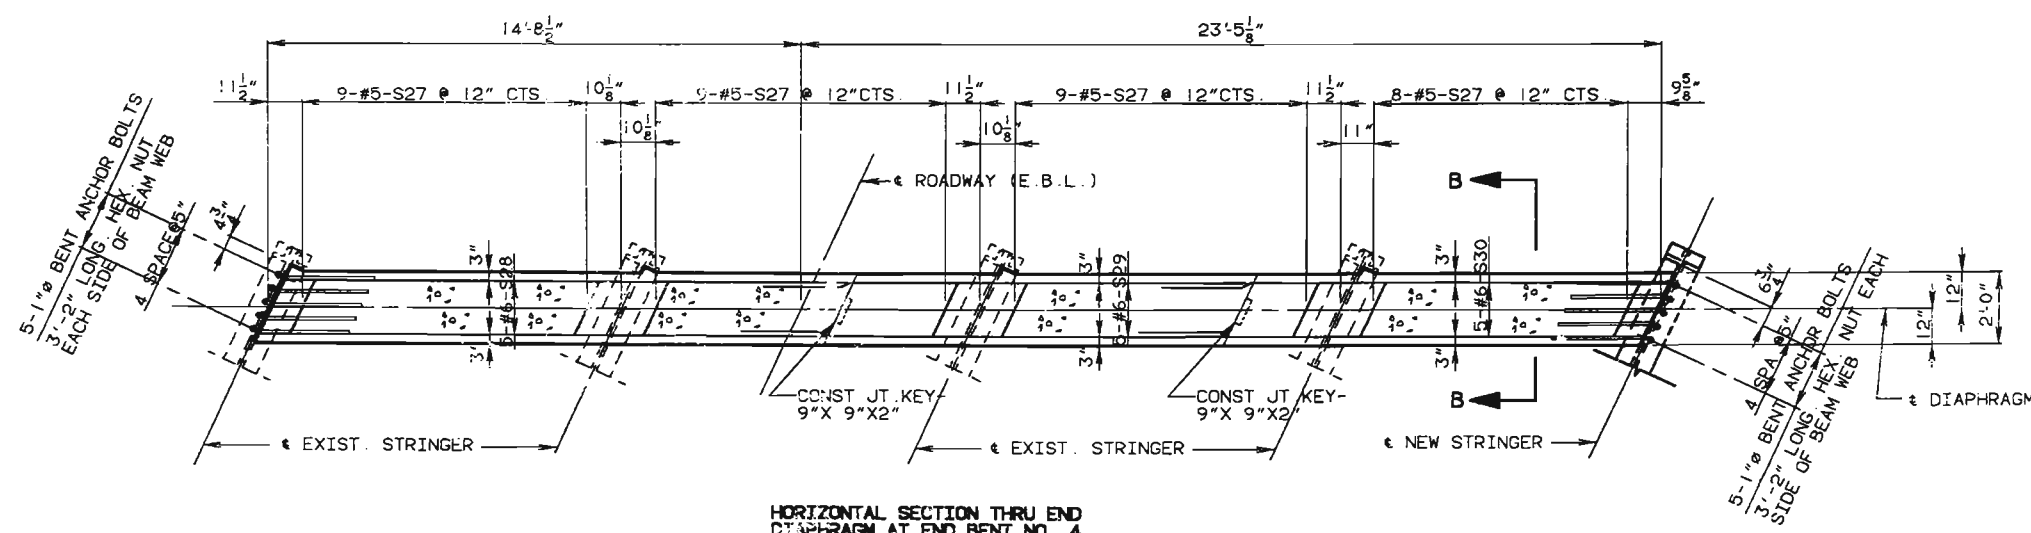


HORIZONTAL SECTION THRU END DIAPHRAGM AT END BENT NO. 4

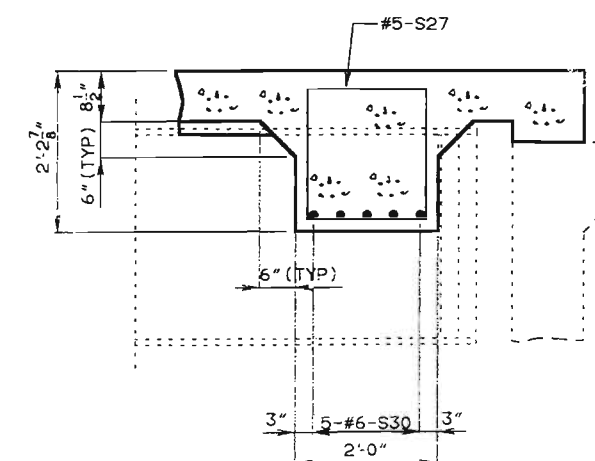

SECTION B-B


NOTE: 1"Ø ANCHOR BOLTS ARE TO BE SHOP BENT.
#6-S28, S29, AND S30 BARS TO BE PLACED
THRU 1 1/2"Ø HOLES IN EXIST. STRINGERS.
COST OF FURNISHING AND INSTALLING 1"Ø ANCHOR
BOLTS SHALL BE INCLUDED IN FABRICATED STRUCTURAL STEEL.
NO DIRECT PAYMENT WILL BE MADE FOR FIELD DRILLING.

370077

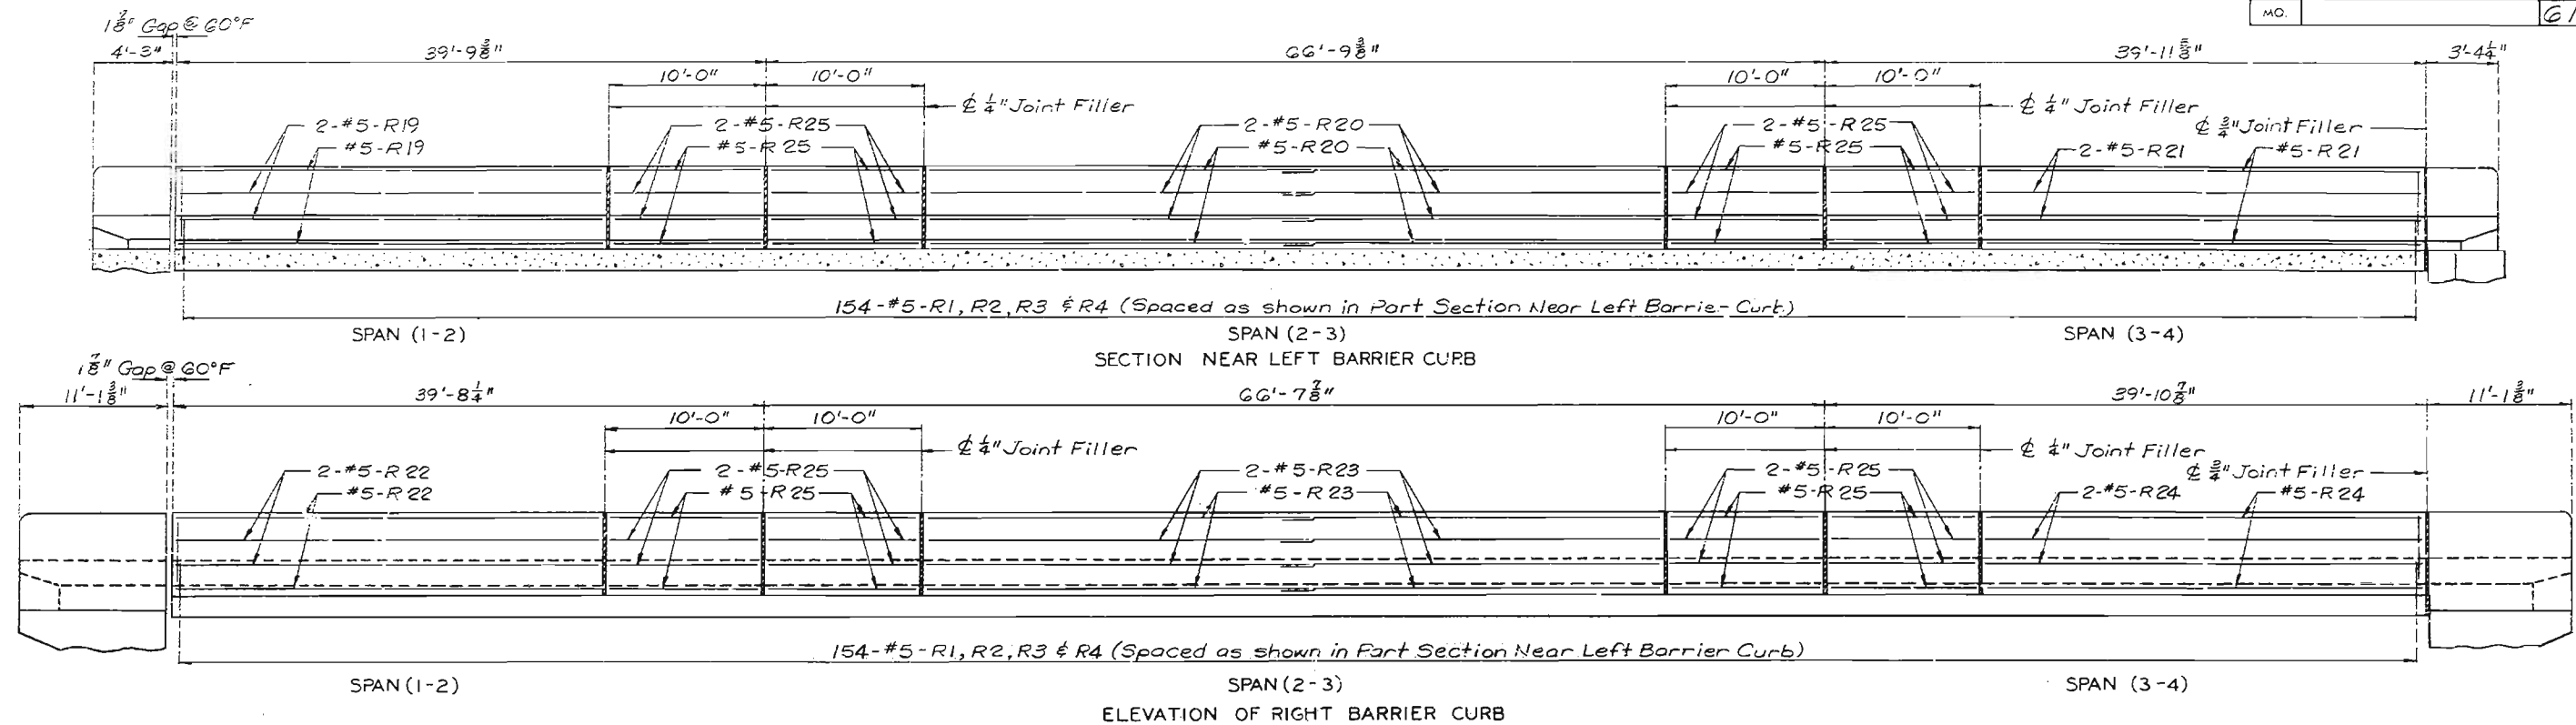


37/1818


STATE	PROJ NO	SHEET NO
MO		62

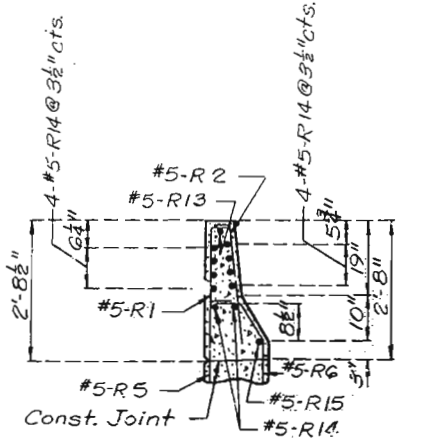


SECTION F-F

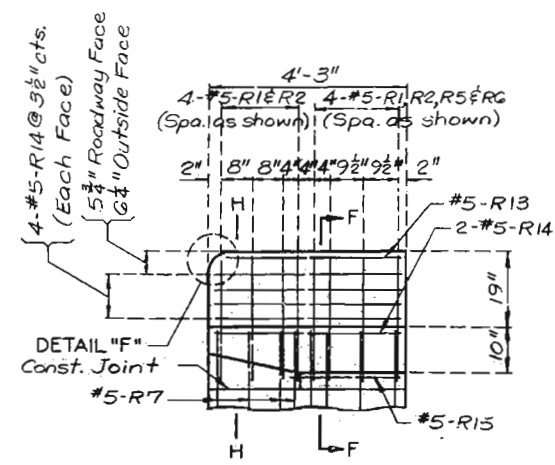


DETAIL 'F'

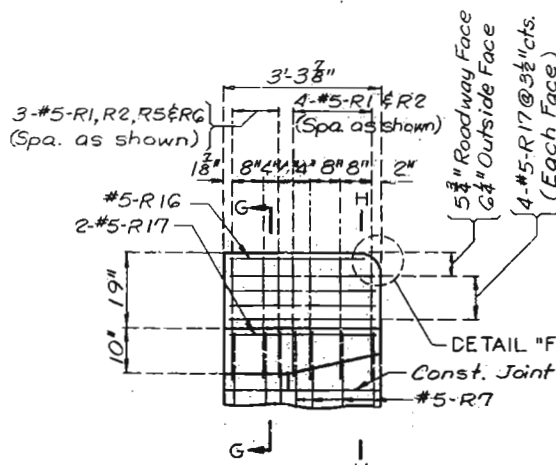


DETAIL 'F'

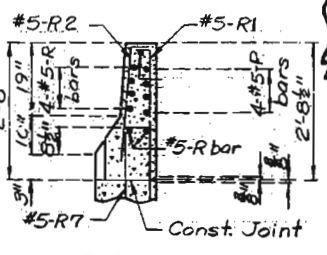

SECTION H-H

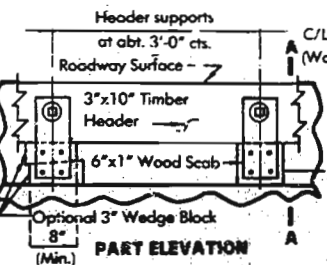

PART ELEVATION

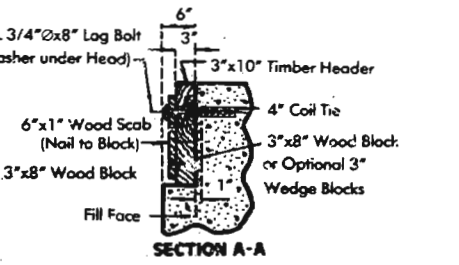


SECTION A-A


NOTE: Cost of Timber Headers complete in place to be included in contract unit price for concrete.

DETAILS OF TIMBER HEADER AT END BENTS


Note: Rustication not required on Left Safety Barrier Curb Ends.

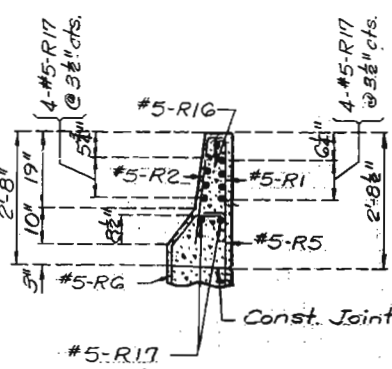


SECTION G-G

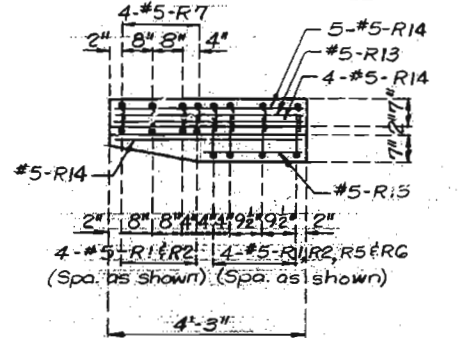

ELEVATION OF LEFT CURB

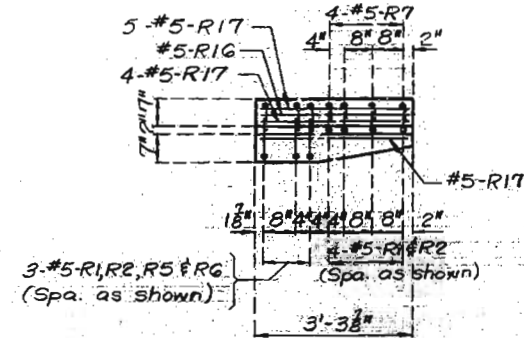

PLAN OF LEFT CURB

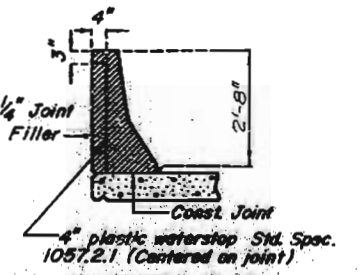


NOTE: PLASTIC WATERSTOP SHALL BE PLACED IN ALL SAFETY BARRIER CURB FILLED JOINTS. (EXCEPT STRUCTURES WITH SUPERELEVATION, USE ON ALL LOWER SAFETY BARRIER CURB JOINTS ONLY.)


COST OF PLASTIC WATERSTOP COMPLETE IN PLACE TO BE INCLUDED IN CONTRACT UNIT PRICE FOR SAFETY BARRIER CURB.

DETAILS OF PLASTIC WATERSTOP


NOTE:
TOP OF SAFETY BARRIER CURB SHALL BE BUILT PARALLEL TO GRADE WITH SAFETY BARRIER CURB JOINTS (EXCEPT AT END BENTS) NORMAL TO GRADE.
ALL EXPOSED EDGES OF SAFETY BARRIER CURB SHALL HAVE EITHER A 1/2" RADIUS OR A 3/8" BEVEL, UNLESS OTHERWISE NOTED.
WHEN THE SAFETY BARRIER CURB IS BID BY LINEAR FEET, THE CONTRACT UNIT PRICE SHALL INCLUDE THE COST OF ALL CONCRETE AND REINFORCEMENT, COMPLETE IN PLACE.
CONCRETE FOR THE SAFETY BARRIER CURB SHALL BE CLASS B1.
MEASUREMENT OF SAFETY BARRIER CURB IS TO THE NEAREST LINEAR FOOT FOR EACH STRUCTURE, MEASURED ALONG THE OUTSIDE TOP OF SLAB FROM END OF WING TO END OF WING.

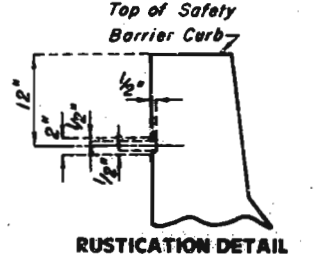

RUSTICATION DETAIL

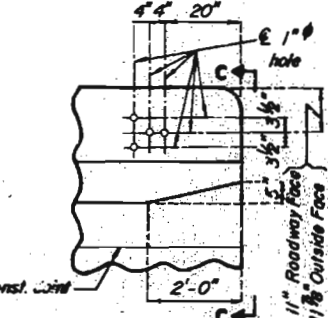


PART ELEVATION

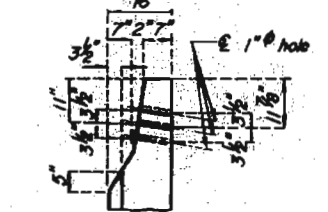


DETAILS OF GUARD RAIL ATTACHMENT


PART ELEVATION C-C

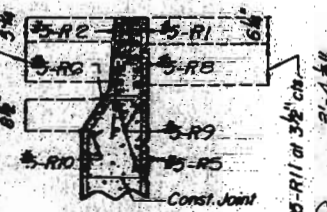


SECTION B-B

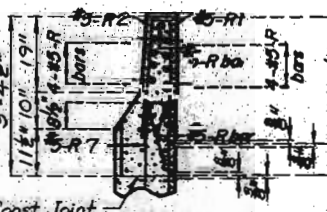

SECTION E-E

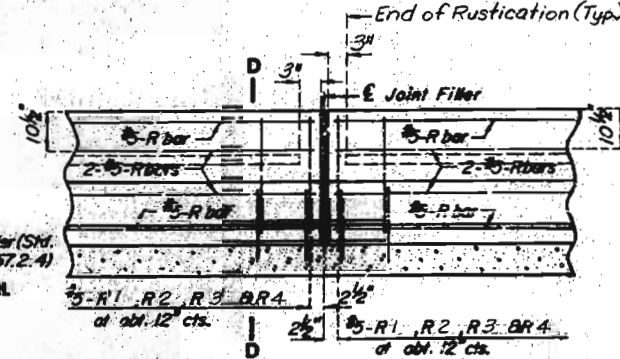


PART SECTION NEAR LEFT SAFETY BARRIER CURB

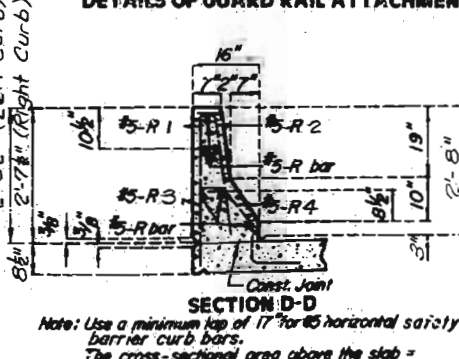


SECTION D-D

Note: Use a minimum lap of 17" for horizontal safety barrier curb bars.
The cross-sectional area above the slab =
2.28 sq. ft. (Left Curb)
2.23 sq. ft. (Right Curb).

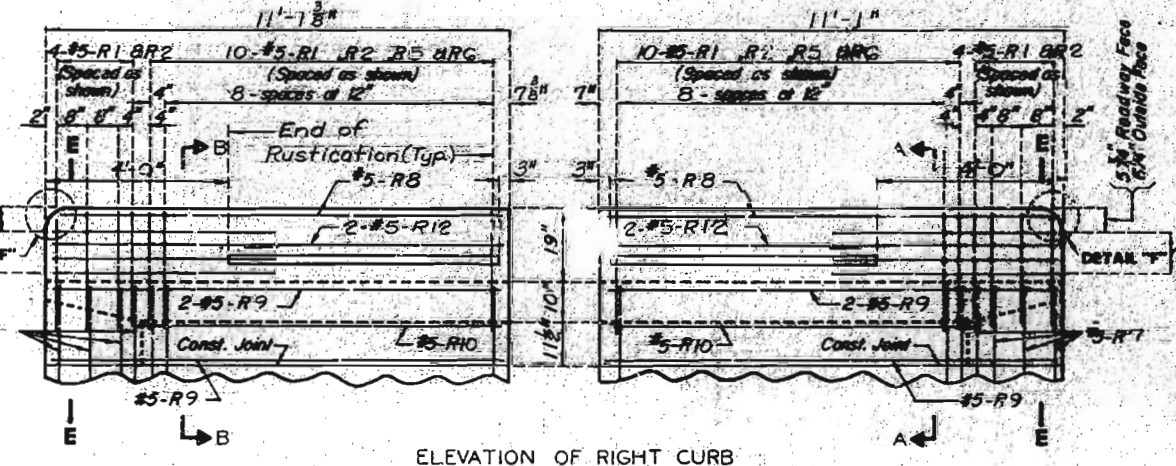

ELEVATION OF RIGHT CURB

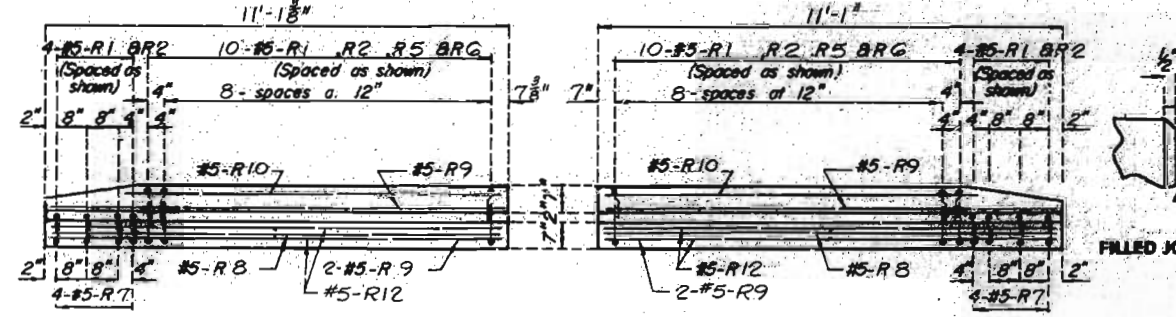

PLAN OF RIGHT CURB

DETAILS OF SAFETY BARRIER CURB AT END BENTS

Note: This drawing is not to scale. Follow dimensions.

Sheet No. 18 of 20

CLAY COUNTY


L-642RI

SPS 177(N) REVISED MAY 1987
AUG. 1978
372

DETAILED Oct. 1988
CHECKED Nov. 1988

COMPLETE BILL OF REINFORCING STEEL																
NO. RECD.	MARK NO.	LOCATION	EPOXY	SHAPE NO.	STIRRUP	SUBSTR.	VARIES	NO. EACH	DIMENSIONS							
									B	C	D	E	F	H	K	NOMINAL
									FT.	IN.	FT.	IN.	FT.	IN.	FT.	IN.
		END BENT NO 1														
7	6F1	WING HAUNCH		15	S	X			14.000	3	9.125	14.000	11.875	7.500	11.875	7.500
8	7H1	BEAM		18	X				10	1.000						11 9 11 9
4	6H2	BEAM		20	X				10	1.000						10 1 10 1
2	6H3	BACKWALL	E	20	X				16	1.000						16 1 16 1
2	6H4	BACKWALL		20	X				17	1.000						17 1 17 1
2	6H5	BACKWALL		20	X				14	2.000						14 2 14 2
2	6H6	BACKWALL	E	20	X				12	11.000						12 11 12 11
2	6H7	BACKWALL		20	X				12	11.000						12 11 12 11
2	6H8	BACKWALL	E	20	X				19	6.000						19 6 19 6
2	6H9	BACKWALL		20	X				19	6.000						19 6 19 6
2	6H10	BACKWALL		20	X				3	4.000						3 4 3 4
1	6H11	APP HAUNCH		20	X				14	0.000						14 0 14 0
1	6H12	APP HAUNCH		20	X				12	11.000						12 11 12 11
1	6H13	APP HAUNCH		20	X				18	9.000						18 9 18 9
8	6H14	WING		20	X	V		2	10	8.000						10 8 10 8
		INCR = 9.625 IN							8	3.000						8 3 8 3
12	6H15	WING		20	X	V		2	8	1.000						8 1 8 1
		INCR = 9.625 IN							4	1.000						4 1 4 1
2	6H16	WING	E	20	X				10	18.000						10 18 10 18
2	6H17	WING		20	X				10	18.000						10 18 10 18
6	6H18	CURTAIN WALL		20	X				3	4.000						3 4 3 4
10	5H19	WING		20	X				4	0.000						4 0 4 0
2	6T1	WING		25	S	X			16.000	11	3.000	3	2.000			16 11 3 2
2	4T2	CURTAIN WALL		19	S	X			5	8.000	3	10.000				5 8 3 10
10	5U1	BEAM		13	S	X			2	9.000	5	1.000	2	9.000	5	1.000
43	4U2	APP HAUNCH		10	S	X			15.000	6.000						15 6 15 6
2	4U3	BEAM		10	S	X			6.000	2	9.000					6 2 6 2
10	5V1	BACKWALL	E	20	X				5	9.000						5 9 5 9
8	5V2	BACKWALL	E	20	X				4	9.000						4 9 4 9
50	5V3	BACKWALL	E	20	X				2	3.000						2 3 2 3
4	5V4	BACKWALL	E	20	X				4	8.000						4 8 4 8
4	5V5	WING		20	X				7	3.000						7 3 7 3
16	6V6	WING		20	X	V		2	2	1.000						2 1 2 1
		INCR = 11.125 IN							8	7.000						8 7 8 7
4	6V7	WING		20	X				9	2.000						9 2 9 2
2	4V8	CURTAIN WALL		20	X				5	6.000						5 6 5 6
6	5V9	WING		20	X				4	3.000						4 3 4 3
2	2W1	A.B. WELL		22	X				12.000	9.125						12 9 12 9
		INT BENT NO 2														
9	8D20	FOOTING & COL		20	X				6	8.000						6 8 6 8
8	6D21	FOOTING		10	S	X			3	2.000	16.000					3 2 3 16
14	6H20	BEAM		18	X				8	8.000						8 8 8 8
4	6H21	BEAM		20	X				8	6.000						8 6 8 6
9	5U20	BEAM		13	S	X			2	9.000	3	7.875	2	9.000	3	7.875
3	4U21	BEAM		10	S	X			6.000	2	9.000					6 2 6 2
15	4P20	COLUMN		16	X				2	3.000						2 3 2 3
9	8V20	COLUMN		20	X				7	1.000						7 1 7 1
2	2W1	A.B. WELL		22	X				12.000	9.125						12 9 12 9

COMPLETE BILL OF REINFORCING STEEL																
NO. RECD.	MARK NO.	LOCATION	EPOXY	SHAPE NO.	STIRRUP	SUBSTR.	VARIES	NO. EACH	DIMENSIONS							
									B	C	D	E	F	H	K	NOMINAL
									FT.	IN.	FT.	IN.	FT.	IN.	FT.	IN.
		INT BENT NO 3														
9	8D30	FOOTING & COL		20	X				6	8.000						6 8 6 8
6	6D31	FOOTING		10	X				3	2.000	16.000					3 2 3 16
14	6H30	BEAM		18	X				8	3.000						8 3 8 3
4	6H31	BEAM		20	X				8	3.000						8 3 8 3
9	5U30	BEAM		13	S	X			2	9.000	3	11.250	2	9.000	3	11.250
3	4U31	BEAM		10	X				6.000	2	9.000					6 2 6 2
14	4P30	COLUMN		16	X				2	3.000						2 3 2 3
9	8V30	COLUMN		20	X				17	1.000						17 1 17 1
2	2W1	A.B. WELL		22	X				12.000	9.125						12 9 12 9
		END BENT NO 4														
6	6F40	WING HAUNCH		15	S	X			14.000	5	8.125	14.000	7.750	11.625	7.750	11.625
2	6H40	BACKWALL	E	20	X				3	9.000						3 9 3 9
4	6H41	BACKWALL		20	X				3	9.000						3 9 3 9
2	6H42	BACKWALL	E	20	X				12	0.000						12 0 12 0
4	6H43	BACKWALL		20	X				12	0.000						12 0 12 0
4	6H44	BEAM		20	X				8	2.000						8 2 8 2
8	7H45	BEAM		18	X				8	2.000						8 2 8 2
1	6H47	APP HAUNCH		20	X				10	4.000						10 4 10 4
4	6H48	CURTAIN WALL		20	X				2	9.000						2 9 2 9
12	6H49	WING		20	X	V		2	7	11.000						7 11 7 11
		INCR = 9.750 IN							3	18.000						3 18 3 18
2	6H50	WING	E	20	X				10	10.000						10 10 10 10
2	6H51	WING		20	X				10	10.000						10 10 10 10
8	6H52	WING		20	X	V		2	10	7.000						10 7 10 7
		INCR = 9.625 IN							8	2.000						8 2 8 2
10	5H53	WING		20	X				5	0.000						5 0 5 0
2	6V40	WING		25	S	X			14.000	11	1.750	2	2.000			14 11 2 2
2	4V41	CURTAIN WALL		19	S	X			5	4.000	3	8.000				5 4 3 8
6	5V40	BEAM		13	S	X			2	9.000	5	8.375	2	9.000	5	8.375
3	4U41	BEAM		10	S	X			6.000	2	9.000					6 2 6 2
10	5U42	APP HAUNCH		10	S	X			15.000	6.000						15 6 15 6
6	5V40	WING		20	X				7	3.000						7 3 7 3
6	5V41	BACKWALL		20	X				3	6.000						3 6 3 6
14	5V42	BACKWALL		20	X				4	8.000						4 8 4 8
8	5V43	BACKWALL		20	X				3	3.000						3 3 3 3
16	6V44	WING		20	X				4	7.000						4 7 4 7
16	6V45	WING		20	X	V		2	8	3.000						8 3 8 3
		INCR = 13.875 IN							23.000							23 23 23 23
6	4V46	WING		20	X				9	2.000						9 2 9 2
2	4V47	CURTAIN WALL		20	X				4	11.000						4 11 4 11
2	2W1	A.B. WELL		22	X				12.000	9.125						12 9 12 9

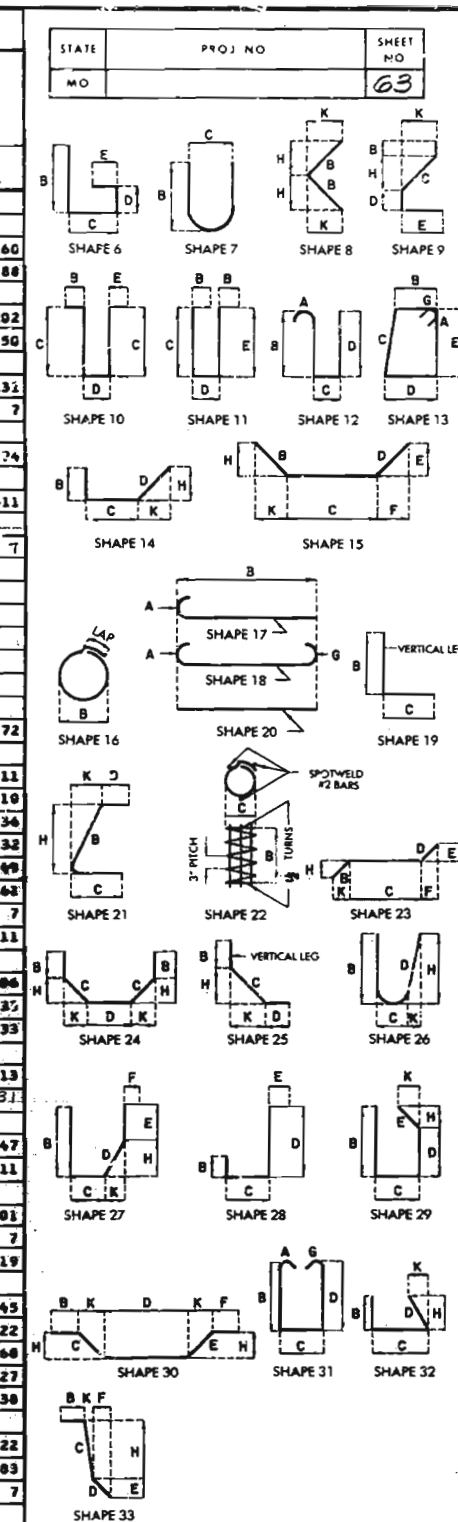

BENDING DIAGRAMS

NOTES:
 ALL STANDARD HOOKS AND BENDS OTHER THAN 180 DEG. TO BE BENT WITH SAME PROCEDURE AS FOR 90 DEG. STD. HOOKS.
 HOOKS AND BENDS SHALL BE IN ACCORDANCE WITH THE PROCEDURES AS SHOWN ON THIS SHEET.
 E - EPOXY COATED REINFORCEMENT.
 S - STIRRUP
 X - BAR IS INCLUDED IN SUBSTRUCTURE QUANTITIES.
 V - BAR DIMENSIONS VARY IN EQUAL INCREMENTS BETWEEN DIMENSIONS SHOWN ON THIS LINE AND THE FOLLOWING LINE.
 NO. EA. - NUMBER OF BARS OF EACH LENGTH.
 NOMINAL LENGTHS - ARE BASED ON OUT TO OUT DIMENSIONS SHOWN IN BENDING DIAGRAMS AND ARE LISTED FOR FABRICATORS USE. (NEAREST INCH)
 ACTUAL LENGTHS - ARE MEASURED ALONG CENTERLINE BAR TO THE NEAREST INCH.
 PAYWEIGHTS ARE BASED ON ACTUAL LENGTHS.

BAR SIZE	D (IN.)	END HOOK DIMENSIONS			
		180° HOOKS		90° HOOKS	
		ALL GRADES		ALL GRADES	
		A OR G	J	A OR G	
#3	2K"	5"	3"	6"	
#4	3"	6"	4"	8"	
#5	3K"	7"	5"	10"	
#6	4K"	8"	6"	12"	
#7	5K"	10"	7"	14"	
#8	6"	11"	8"	16"	
#9	9K"	15"	11K"	19"	
#10	10K"	17"	13K"	22"	
#11	12"	19"	14K"	20"	
#14	18K"	2'-3"	21K"	2'-7"	


COMPLETE BILL OF REINFORCING STEEL

NO. REQ.	MARK NO.	LOCATION	EPOXY	SHAPE NO.	STIRRUP	S	I	X	V	NO. EACH	DIMENSIONS																NOMINAL LENGTH	ACTUAL LENGTH	WEIGHT																																																																																																																																																																																																																																																																																																																																																																																																																																																																																																																																																																																																																																																																																																																																																																																																																																																																																																																																																																																																																																																																																																																																																																																																																																																																																																																													
											B		C		D		E		F		H		K																																																																																																																																																																																																																																																																																																																																																																																																																																																																																																																																																																																																																																																																																																																																																																																																																																																																																																																																																																																																																																																																																																																																																																																																																																																																																																																																			
											FT.	IN.	FT.	IN.	FT.	IN.	FT.	IN.	FT.	IN.	FT.	IN.	FT.	IN.	FT.	IN.	FT.	IN.	LBS.																																																																																																																																																																																																																																																																																																																																																																																																																																																																																																																																																																																																																																																																																																																																																																																																																																																																																																																																																																																																																																																																																																																																																																																																																																																																																																																													
		SUPERSTRUCTURE																																																																																																																																																																																																																																																																																																																																																																																																																																																																																																																																																																																																																																																																																																																																																																																																																																																																																																																																																																																																																																																																																																																																																																																																																																																																																																																																																								

82x37x

COMPLETE BILL OF REINFORCING STEEL

NO. REQ.	MARK NO	LOCATION	EPOXY	SHAPE NO	STIRRUP	S	I	X	V	NO. EACH	DIMENSIONS												NOMINAL LENGTH	ACTUAL LENGTH	WEIGHT
											B	C	D	E	F	H	K								
																		FT.	IN.	FT.	IN.	FT.	IN.	FT.	IN.
10	5R14	BARRIER CURB	E	20							4	0.000								4	0	4	0		4
1	5R15	BARRIER CURB	E	20							2	1.000								2	1	2	1		
1	5R16	BARRIER CURB	E	20							2	8.000								2	8	2	8		
10	5R17	BARRIER CURB	E	20							3	0.000								3	0	3	0		3
6	5R19	BARRIER CURB	E	20							29	0.000								29	0	29	0		18
12	5R20	BARRIER CURB	E	20							24	0.000								24	0	24	0		30
6	5R21	BARRIER CURB	E	20							29	8.000								29	8	29	8		18
6	5R22	BARRIER CURB	E	20							29	5.000								29	5	29	5		18
12	5R23	BARRIER CURB	E	20							23	11.000								23	11	23	11		29
6	5R24	BARRIER CURB	E	20							29	7.000								29	7	29	7		18
48	5R25	BARRIER CURB	E	20							9	8.000								9	8	9	8		48
		END OF BAR LIST																							
																							</		

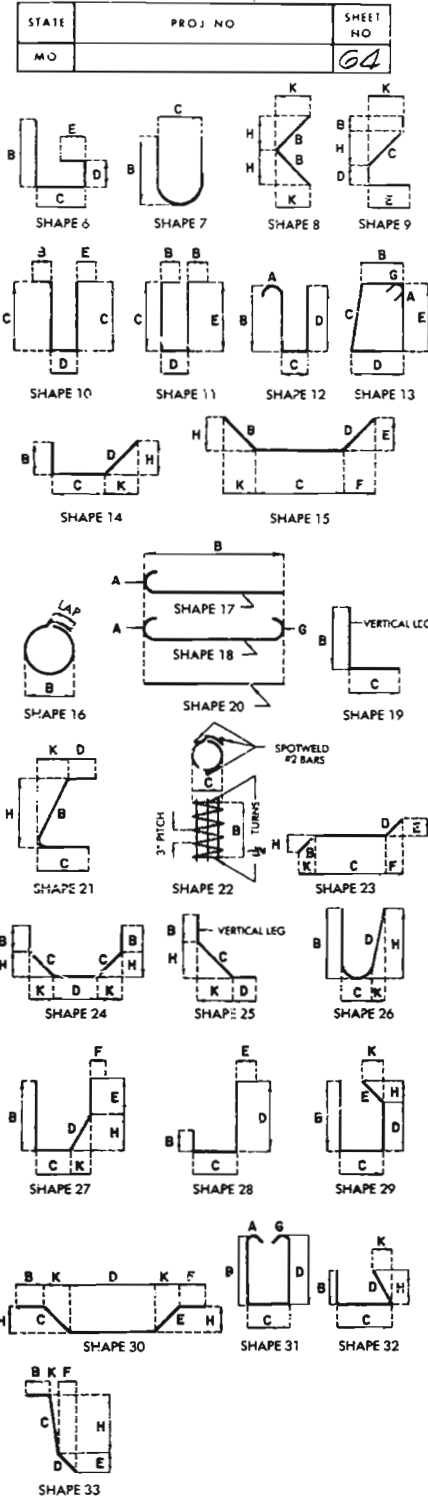

BENDING DIAGRAMS

NOTES:


ALL STANDARD HOOKS AND BENDS OTHER THAN 180 DEG. TO BE BENT WITH SAME PROCEDURE AS FOR 90 DEG. STD. HOOKS.
 HOOKS AND BENDS SHALL BE IN ACCORDANCE WITH THE PROCEDURES AS SHOWN ON THIS SHEET.
 E - EPOXY COATED REINFORCEMENT.
 S - STIRRUP.
 V - BAR IS INCLUDED IN SUBSTRUCTURE QUANTITIES.
 X - BAR DIMENSIONS VARY IN EQUAL INCREMENTS BETWEEN DIMENSIONS SHOWN ON THIS LINE AND THE FOLLOWING LINE.
 NO. EA. - NUMBER OF BARS OF EACH LENGTH.
 NOMINAL LENGTHS - ARE BASED ON OUT TO OUT DIMENSIONS SHOWN IN BENDING DIAGRAMS AND ARE LISTED FOR FABRICATORS USE (NEAREST INCH).
 ACTUAL LENGTHS - ARE MEASURED ALONG CENTERLINE BAR TO THE NEAREST INCH.
 PAYWEIGHTS ARE BASED ON ACTUAL LENGTHS.

STIRRUP HOOK DIMENSIONS


BAR SIZE	D (IN.)	GRADES 40-50-60 KSI		
		90° HOOK	135° HOOK	APPROX. H
#3	1 1/8"	4"	4"	2 1/2"
#4	2"	4 1/2"	4 1/2"	3"
#5	2 1/4"	6"	5 1/4"	3 1/2"
#6	4 1/8"	12"	7 1/4"	4 1/2"

NOTE: UNLESS OTHERWISE NOTED DIAMETER "D" IS THE SAME FOR ALL BENDS AND HOOKS ON A BAR.

Note: This drawing is not to scale. Follow dimensions.

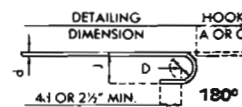

SIZE OF 180° HOOKS (GRADE 40 KSI)
 D - 5/8 FOR #3 THRU #11
 D - 1 1/4 FOR #14 AND #18

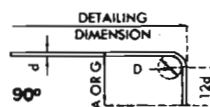

SIZE OF 90° HOOKS (ALL GRADES)
 AND 180° HOOKS (GRADE 60 KSI)
 D - 5/8 FOR #3 THRU #8
 D - 3/4 FOR #9, #10 AND #11
 D - 1 1/4 FOR #14 AND #18

END HOOK DIMENSIONS				
BAR SIZE	D (IN.)	180° HOOKS		90° HOOK
		ALL GRADES		ALL GRADES
		A O R G	J	A O R G
#3	2 1/8"	5"	3"	6"
#4	3"	6"	4"	8"
#5	3 3/8"	7"	5"	10"
#6	4 1/8"	8"	6"	12"
#7	5 1/8"	10"	7"	14"
#8	6"	11"	8"	16"
#9	9 1/8"	15"	11 1/2"	20"
#10	10 1/8"	17"	13 1/2"	22"
#11	12"	19"	14 1/2"	24"
#14	18 1/8"	24 3/4"	21 1/2"	27 1/2"


MISSOURI HIGHWAY AND TRANSPORTATION COMMISSION

U. I. P., Widen and Redeck (39', 67', 39') Cont. Comp. WF Spans

STATE	PROJ. NO.	SHEET NO.
MO.	IR-35-1 (203)	45
SEC./SUR.	G TWP. 50N RGE. 32 W	

Pr. Gr. Elev. 844.91
@ E Roadway


Pr. Gr. Elev. 844.21
@ E Roadway

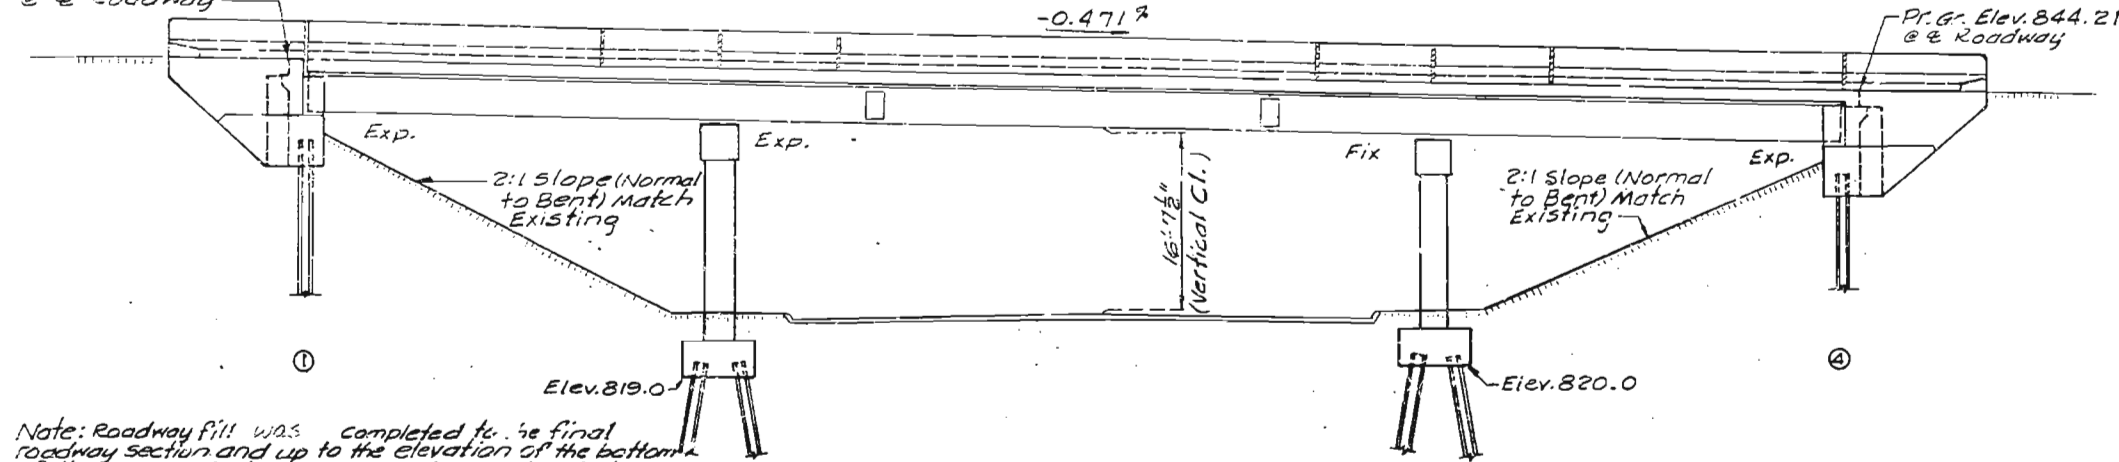

Note: Roadway fill was completed to the final roadway section and up to the elevation of the bottom of the concrete beam within the limits of the structure and not less than 25' in back of the fill face of the End Bents before piles were driven for any bents falling within the embankment section.

DEVELOPED ELEVATION

Note: All Bents are parallel.

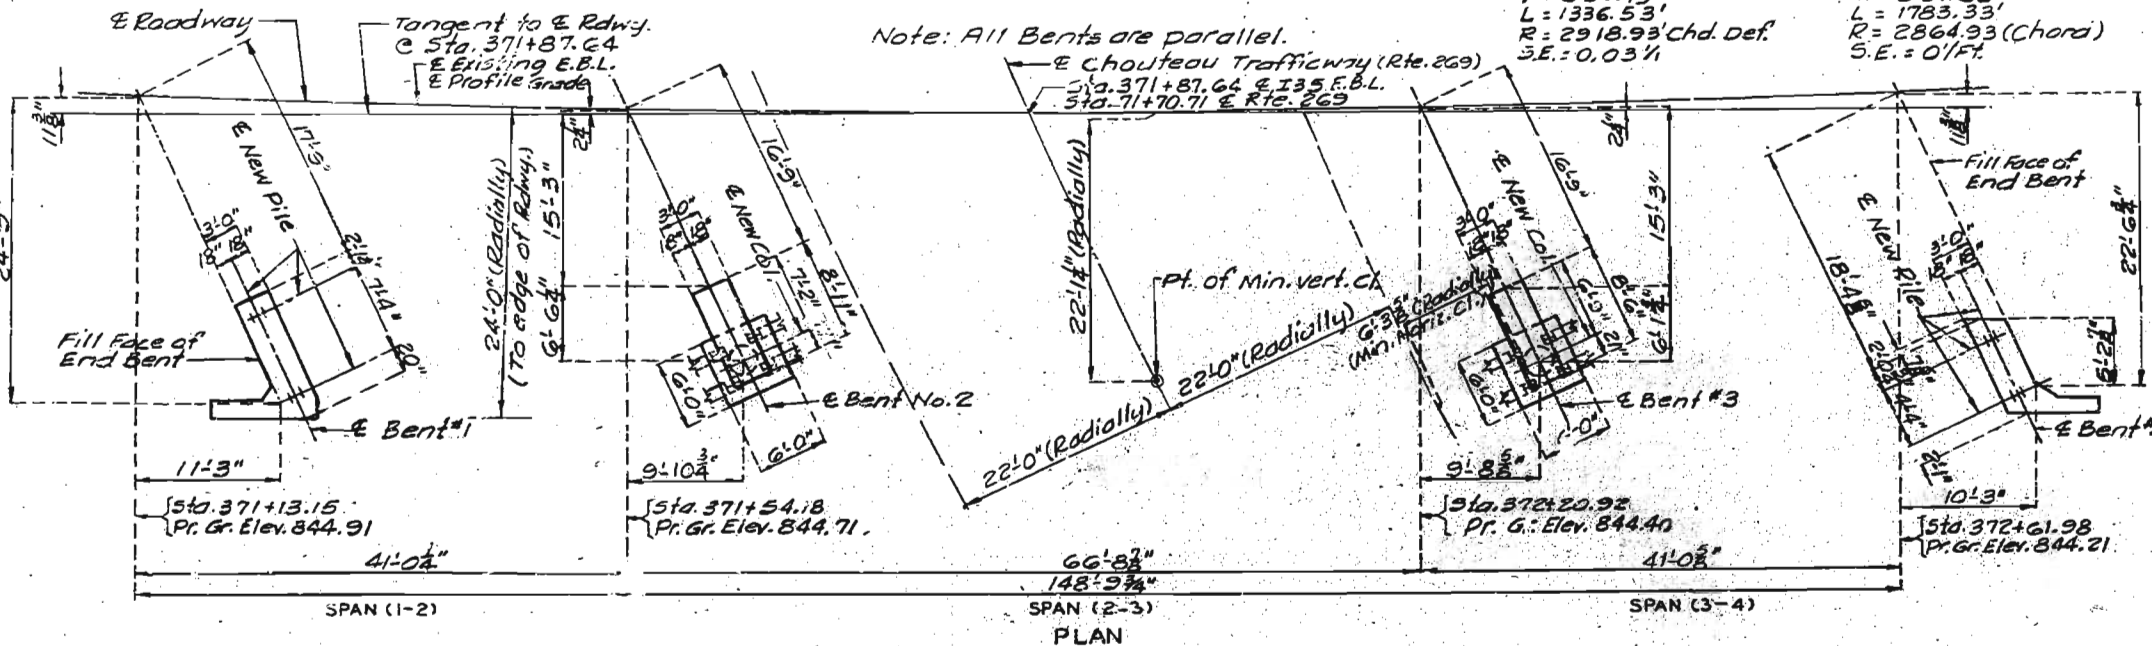

Note: Elevation and Plan showing New Work Only.

PILE DATA		BENT			
BEARING PILE		1	2	3	4
	PILE TYPE AND SIZE	HP10x42	HP10x42	HP10x42	HP10x42
	NUMBER	2	4	4	2
	APPROXIMATE LENGTH FT.	32	16	18	33
	DESIGN BEARING TONS	20	30	30	20
HAMMER ENERGY REQ'D. FT.-LBS.		1,000	7,000	7,000	7,000

Note: Minimum energy requirement of hammer was based on plan length and design bearing value of piles. All piles were driven to practical refusal.

* Approximately 139 tons of new steel and 53.1 tons of existing steel were painted (See Special Provisions)

ESTIMATED QUANTITIES			
ITEM	SUBSTR.	SUPERSR.	TOTAL
Partial Removal of Substructure Concrete	Lump Sum		1
Removal and Storage of Exist. Bridge Rail	Lin. Ft.		293
Non-Destructive Testing	Lin. Ft.		37
Removal of Existing Bridge Deck	Sq. Ft.		4,943
Class I Excavation	Cu. Yd.	99	99
Structural Steel Pile (IC)	Lin. Ft.	265	265
Class B Concrete (Substr.)	Cu. Yd.	51.4	51.4
Class B2 Concrete (Superstr. on Steel)	Cu. Yd.	180.1	180.1
Safety Barrier Curb	Lin. Ft.	323	323
Prefabricated Compression Exp. Jt. Seal (3.0in.)	Lin. Ft.		44
Reinforcing Steel (Bridges)	Lb.	4,880	4,880
Reinforcing Steel (Epoxy Coated)	Lb.	560	49,960
Fabricated Str. Carbon Steel (I-Beam)	Lb.		29,380
Clean and Lubricate Bearings	Each		16
Painting Existing and New Steel	Lump Sum		1
Contingent: Adjust Bearing Device	Each		4

Note: Concrete above upper construction joint in backwall @ End Bent No.1 was included with Class B (substructure) quantities. Weight of threaded 1" rods and nuts in End Diaphragm is included in weight of fabricated structural steel.

Note: This drawing is not to scale. Follow dimensions.

Sheet No. 1A of 20.

GENERAL NOTES:

Design Specifications: A.A.S.H.T.O.-1983 and Interims thru 1988. Load Factor Design.

Design Loading:
H-20-44, 15"/sq. Ft. Future Wearing Surface
Modified 24,000# Tandem Axis
Earth 120#/cu. Ft., Equivalent Fluid Pressure 45#/cu. Ft.
Fatigue Stress Case II

Design Unit Stress:
Class B Concrete (substructure) $f'_c = 3,000$ psi.
Class B1 Concrete (Safety Barrier curb) $f'_c = 4,000$ psi.
Class B2 Concrete (superstructure, except Safety Barrier Curb) $f'_c = 4,000$ psi.
Reinforcing Steel (Grade 60) $f_y = 60,000$ psi.
Structural Carbon Steel $f_u = 36,000$ psi.
Steel Pile $f_b = 9,000$ psi.

Fabricated Steel Connections:
Field connections, High Strength Bolts $\frac{3}{4}"$, holes $\frac{13}{16}"$, except as noted.

Joint Filler:
All joint filler shall meet the requirements of Std. Spec. 1057.2.4, except as noted.

Reinforcing steel:
Minimum clearance to reinforcing steel is 1 1/2", unless otherwise shown.
All reinforcing bars in tops of substructure beams or caps were spaced to clear anchor bolts for bearings by at least 2".

Painting:
Paint system C by Contractor in accordance with Std. Spec. 712.12 & 712.13 (Color of the final field coat was Green).
Areas to be encased in End Bent concrete were painted one coat of System C primer and scratched or damaged surfaces were touched up in the field before concrete was poured.

Construction Clearance:
A minimum vertical clearance of 14'-9" from crown of existing lanes and a minimum lateral clearance of 28'-0" centered on existing lanes was maintained during construction.

Traffic Maintained:
Traffic over structure was maintained during construction.

Outline of old work is indicated by light dashed lines. Heavy lines indicate new work.
Contractor verified all dimensions in field before ordering new steel.
Bars bonded in old concrete not removed were cleanly stripped and embedded into new concrete where possible. If length was available, old bars extend into new concrete at least 40 diameters for smooth bar and 30 diameters for deformed bars, unless otherwise noted.

Cleaned, lubricated & reset all bearings. See special provisions.
Cost of furnishing and installing Resin Anchor Assemblies were included in Contract unit price for concrete.

All dimension tied to existing elevations were subject to variance. For new top of substructure beam caps, use elevations given.

B.M. Elev. 848.34 BOLT IN RIGHT BARRIER CURB SOUTH END OF BRIDGE.

BRIDGE OVER RTE.269 (CHOUTEAU TRAFFICWAY)

STATE ROAD: INTERSTATE 35
IN KANSAS CITY

PROJECT NO.

JOB NO. 4-I-35-816

CLAY

STA. 371+13.15 E.B.L.

RTE. I-35

COUNTY

STD.

STD. 706.35


L-642 RI

DATE 1/13/89


DESIGNED Aug. 1988
DETAILED NOV. 1988
CHECKED NOV. 1988

375-202


STATE	PROJ. NO.	SHEET NO.
MO.	IR-35-1 (233)	53

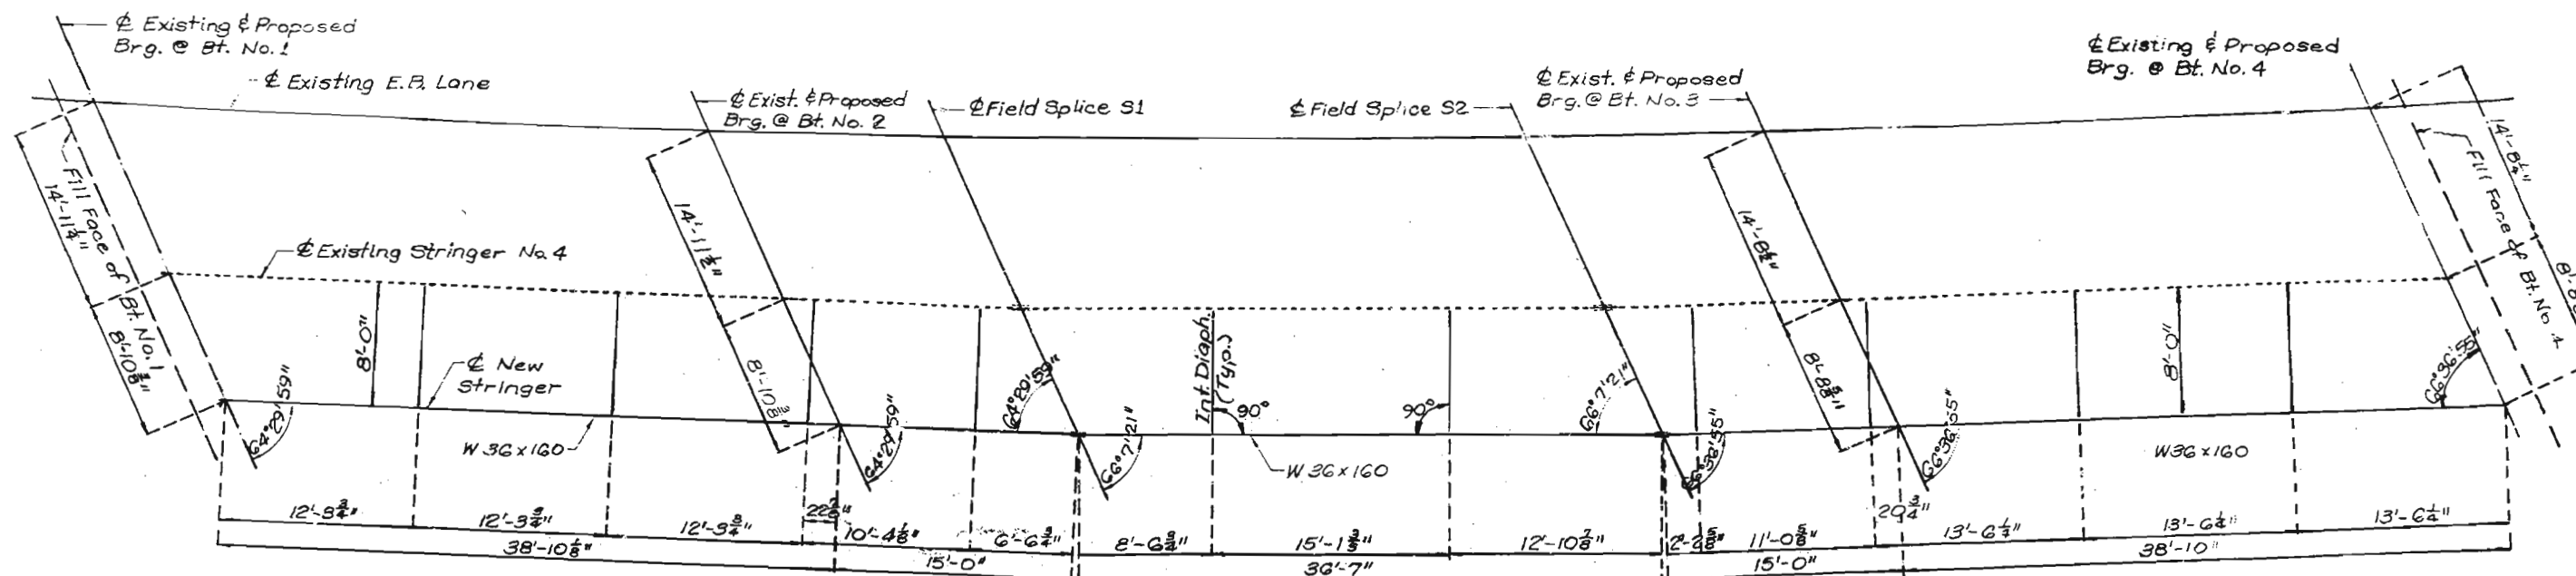


PLAN OF STEEL

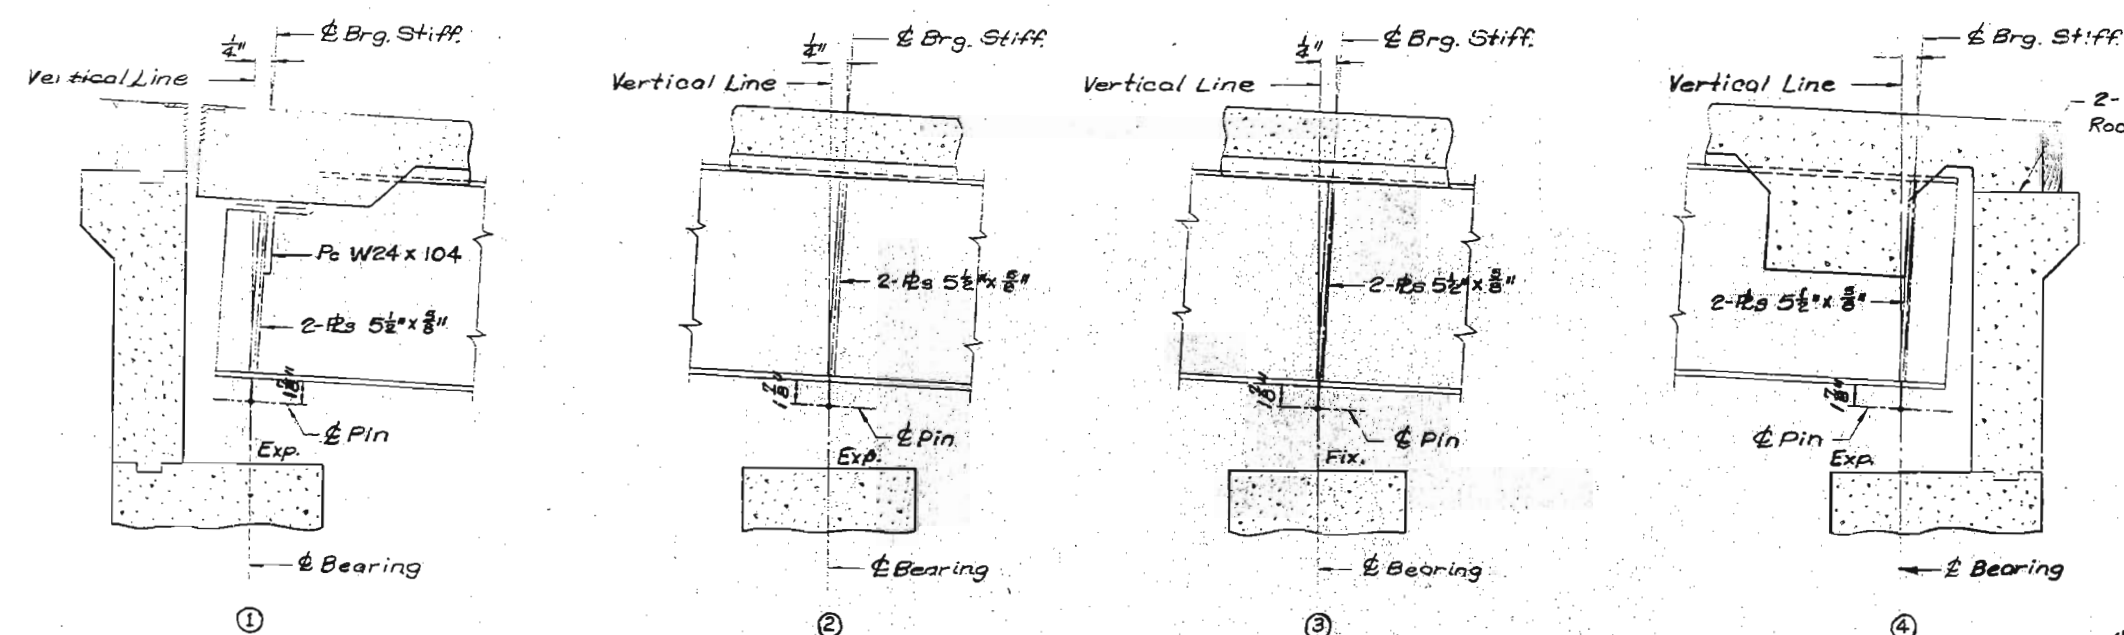


PART LONGITUDINAL SECTION
(Parallel to Stringer Line)

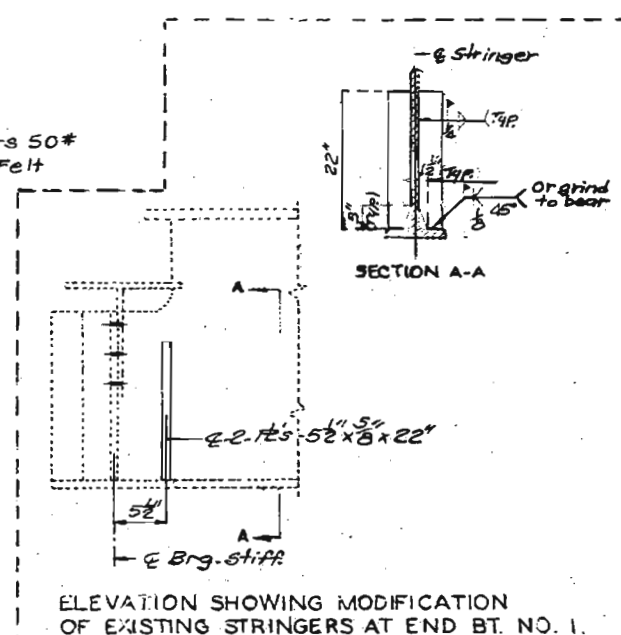

ELEVATION SHOWING MODIFICATION
OF EXISTING STRINGERS AT END BR. NO. 1.

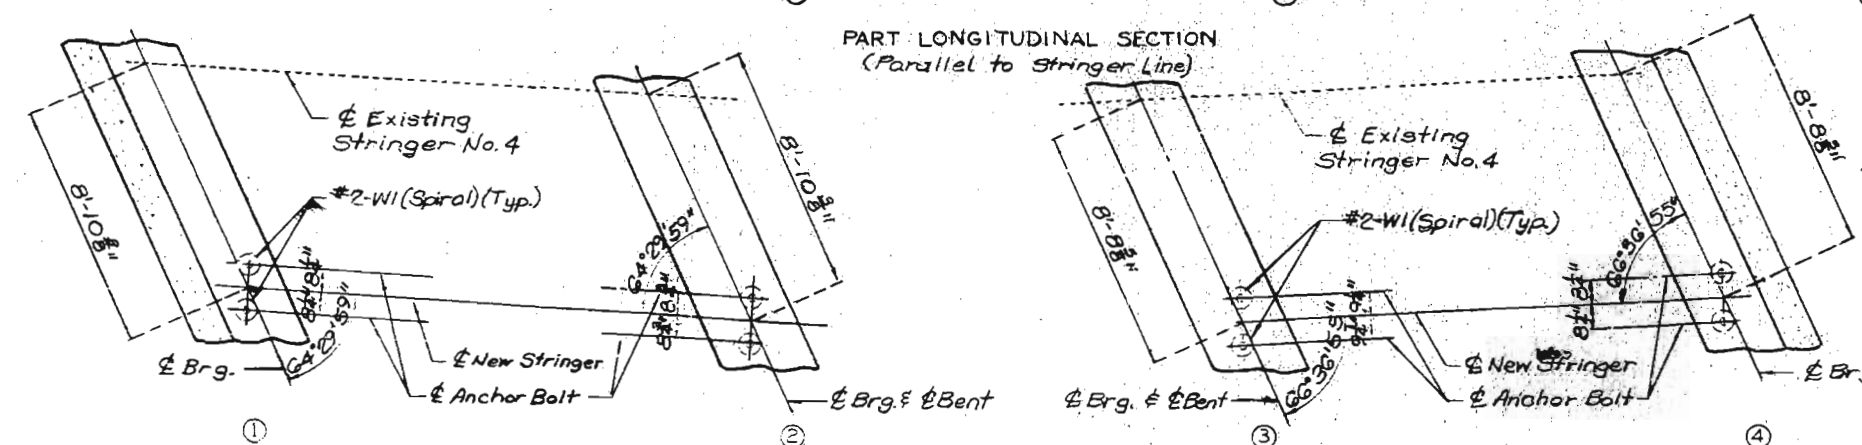

ANCHOR BOLT PLAN

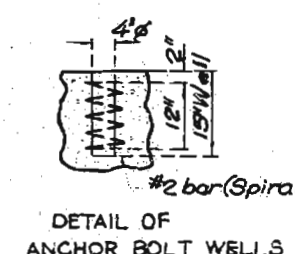


DETAIL OF
ANCHOR BOLT WELLS

Note: All dimensions are horizontal.
Longitudinal dimensions are
along \bar{C} of Stringers.
Fabricated structural steel
is A36.
Notch toughness required for all
WF Beams.

376818

FED. ROAD DIST. NO.	STATE	FED. AID PROJ. NO.	FISCAL YEAR	SHEET NO.	TOTAL SHEET
5	MO.	11-3333 (11-3333)	19		

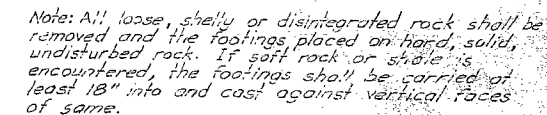

Note: All excavation for bridge will be paid for as Class 1 Excavation for Structures.
Estimated quantities of Class 1 Excavation for Structures includes only amount of excavation below Roadway Excavation (See Special Provisions).
Concrete in end posts is included with substructure concrete.

GENERAL NOTES:

Design Specifications: A.A.S.H.O. -1953

Loading: H20-44
 Structural Steel Stress: 18,000 psi
 Reinforcing Steel Stress: 18,000 psi
 Concrete, Class "B" Stress: 1000 psi
 All concrete shall be Class "B" (Air-Entrained)
 Rivers 3 1/2' below B.M. except as noted

Field connections shall be riveted or if the Contractor desires he may use high tensile steel bolts with carburized washers in place of rivets. (See Special Provisions).

Where joint filler is specified on the plans it shall conform with the requirements for Gray Rubber Compound Joints as given in section 38.19B(2) of the Standard Specifications.

For requirements on welding electrodes see Special Provisions.
qualification of welding operators will be required.

Point; Shop, none; field, contact surfaces of bolted field connections, except where high tensile bolts are used, one coat of red lead and surfaces inaccessible after erection three coats of red lead. All other exposed surfaces first coat red lead, second coat brown, third coat aluminum. Payment for cleaning and painting such surfaces will be included in the unit price for erection.

A rubbed surface finish will be required on all exposed surfaces of concrete end posts above top of curbs. **Sheet No. 1 of 11. FINISHED.**

B.M. #21 Elev. 940.80 - R.R. Spike in S. Side P.R. Lt.
Sto. 414+50 (Lt. Lane).

BRIDGE OVER RT. & LT. LANES (RT.69)

STATE ROAD FROM ANTIOCH ROAD IN NORTH KANSAS CITY N.E.

ABOUT 4.5 MILES N.E. OF NORTH KANSAS CITY

PROJECT NO. U.I-99(7) (RT. 69) STA. 4+04.77

CLAY

COUNTY

25
SUBMITTED BY: J. A. Williams DATE 10/13/1954
BRIDGE ENGINEER
APPROVED BY: Per M. Whitton DATE 10/13/1954
CHIEF ENGINEER

FINISHED

STD E-11033

-655

SEE FINAL PLANS BROWN-LINES

Designed June 1954 by H.J.K.

Drawn Aug. 1954 by M.H.P.

Checked Sept 1954 by C.S.A.

FED. ROAD DIST. NO.	STATE	FED. AID PROJ. NO.	FISCAL YEAR	SHEET NO.	TOTAL SHEETS
5	MO.	41-39(4) (41-5)	19		

BENDING SKETCHES & CUTTING DIAGRAMS

[illegible]

No.	Size	Length	Mark	Location
*End Bent No.5				
40	"7	6'-3"	D3	Footing
116	"5	2'-0"	E1	Bk Wall
24	"6	8'-6"	F1	Col. Hcf.
3	"6	10'-6"	F3	Column
3	"8	41'-9"	G7	Beam
9	"11	14'-0"	G8	Beam
4	"6	38'-6"	G9	Beam
7	"10	28'-9"	G10	Beam
6	"8	28'-0"	G11	Beam
7	"9	28'-9"	G12	Beam
4	"6	32'-6"	G13	Bk Wall
8	"4	39'-0"	G14	Bk Wall
4	"6	8'-3"	G15	Bk Wall
2	"11	27'-9"	G16	Beam
3	"8	17'-6"	G17	Beam
2	"5	18'-6"	H1	Wing
4	"5	12'-6"	H2	Wing
2	"5	21'-6"	H3	Wing
2	"6	18'-6"	H4	Wing
4	"6	15'-3"	H5	Wing
1	"6	11'-6"	H6	Wing
4	"6	16'-0"	H7	Wing
3	"6	9'-9"	H8	Wing
4	"5	15'-3"	H9	Wing
3	"5	9'-3"	H10	Wing
1	"7	9'-0"	H11	Wing
1	"5	8'-6"	H12	Wing
8	"6	12'	H13	Safety Curb
1	"6	10'-6"	H14	Wing
1	"6	13'-6"	H15	Wing
6	"4	6'-0"	R1	End Post
6	"4	6'-0"	R2	End Post
28	"6	3'-6"	R3	End Post
14	"5	2'-9"	R4	Curb
4	"5	6'-0"	R5	Curb
2	"5	6'-6"	R6	Curb
4	"5	7'-0"	R7	Curb
2	"6	14'-3"	T1	Wing
2	"6	15'-3"	T2	Wing
2	"6	10'-9"	T3	Wing
2	"6	11'-3"	T4	Wing
77	"4	12'-3"	U3	Beam
18	"4	4'-0"	U4	Beam
4	"5	3'-6"	U5	Safety Curb
4	"5	3'-3"	U6	Safety Curb
118	"5	7'-3"	V5	Bk Wall
39	"5	8'-0"	V6	Bk Wall
16	"3	18'-0"	V14	Column
32	"-	11'-6"	V15	Column
16	"3	18'-3"	V16	Column
18	"7	20'-0"	V17	Column
4	"7	20'-6"	V18	Column
8	"7	21'-3"	V19	Column

2-8-72

2-8-72

-655

CONSTRUCTION CHANGES NOTED HEREON

00
5

FED. ROAD DIST. NO.	STATE	FED. AID PROJ. NO.	FISCAL YEAR	SHEET NO.	TOTAL SHEETS
8	MO.	11 99 (7) (41.69)	19		







FINISHED
L-655










SEE FINAL PLANS BROOKLYN LINES

MISSOURI STATE HIGHWAY DEPARTMENT

FED. ROAD DIST. NO.	STATE	FED. AID PROJ. NO.	FISCAL YEAR	SHEET NO.	TOTAL SHEETS
5	MO.	U.I. 99(7) (RT. 69)	19		

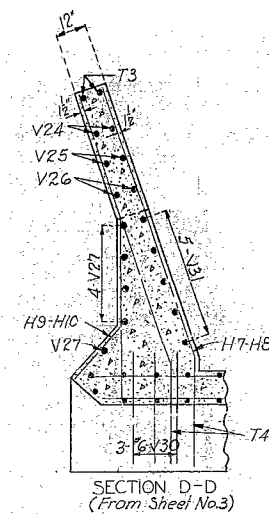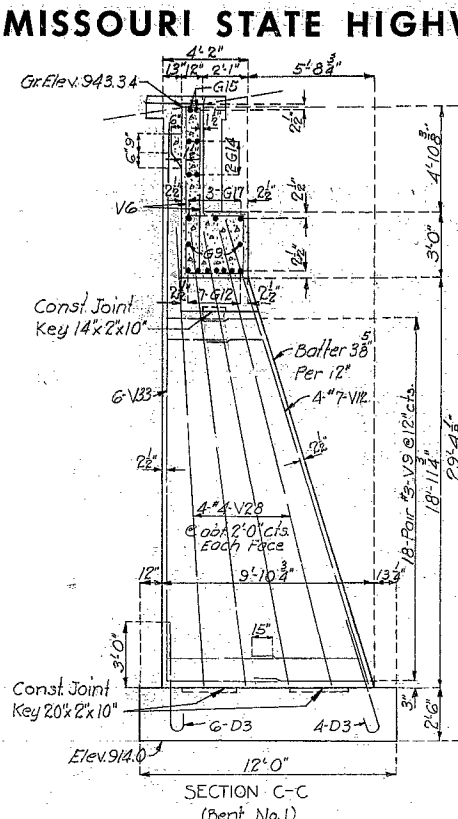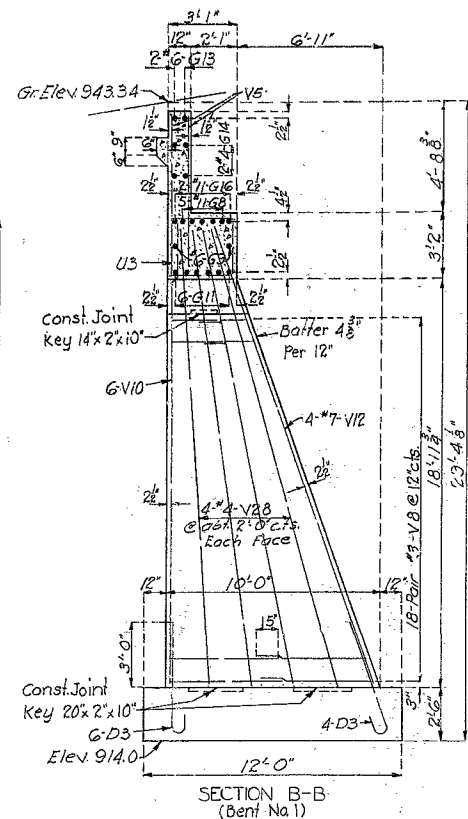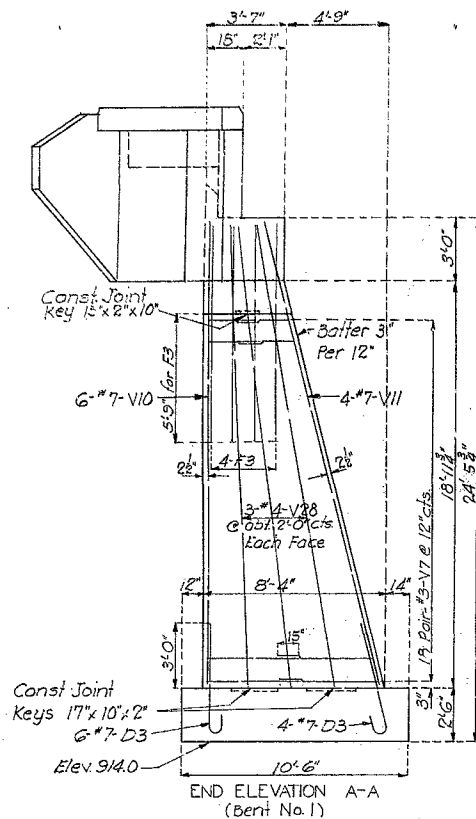

Note: Bend H7, H8 in field when necessary.

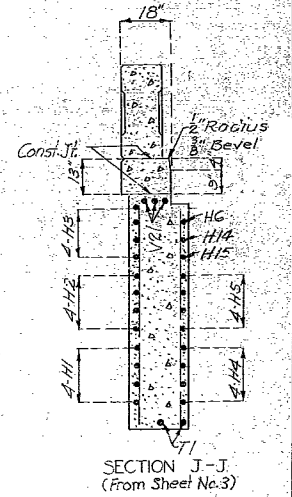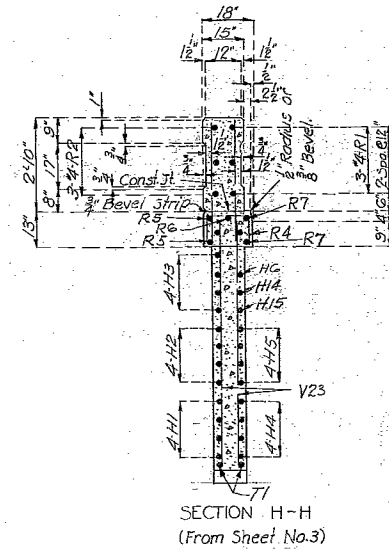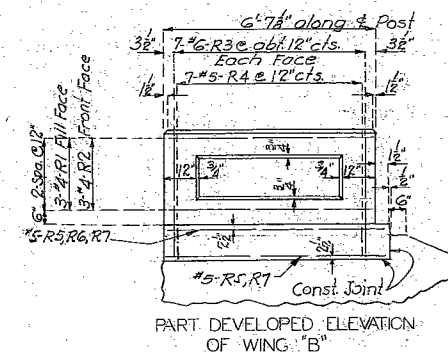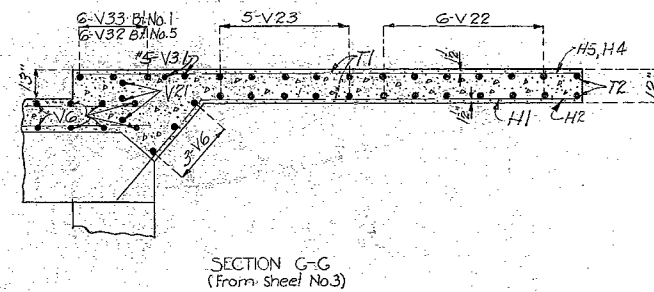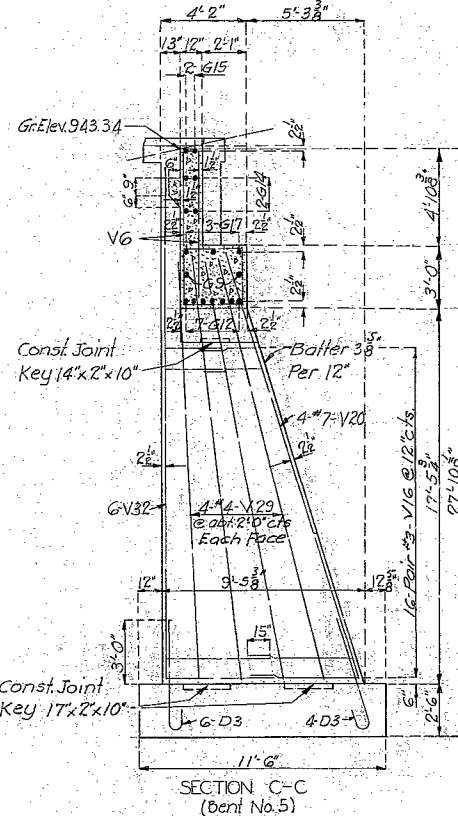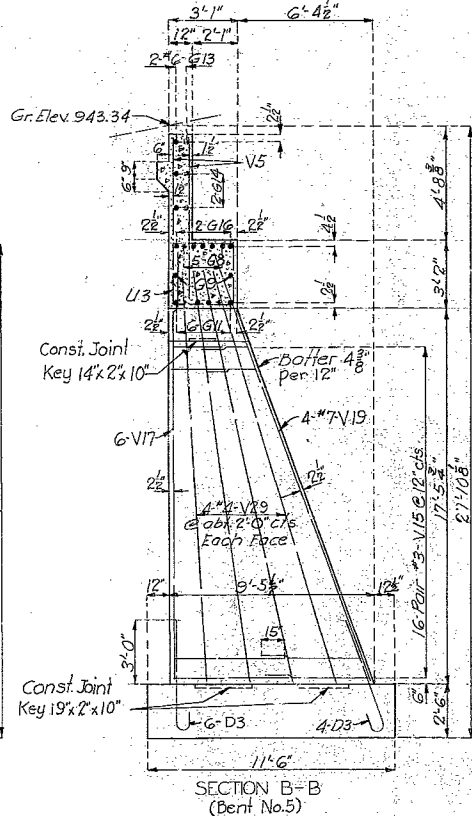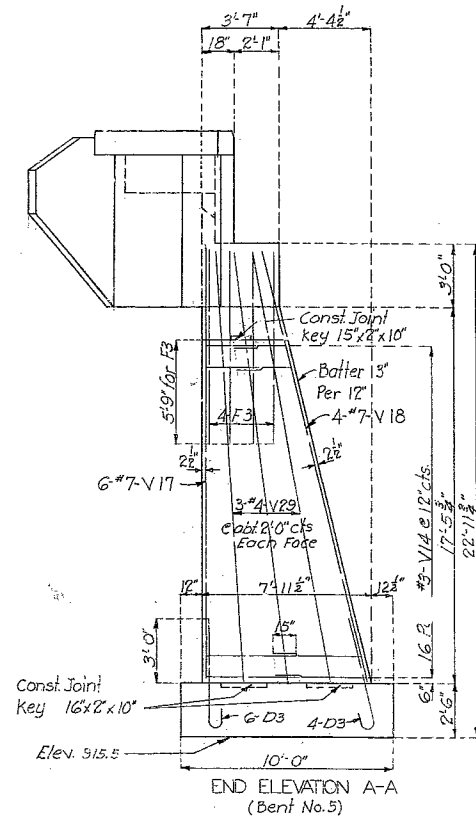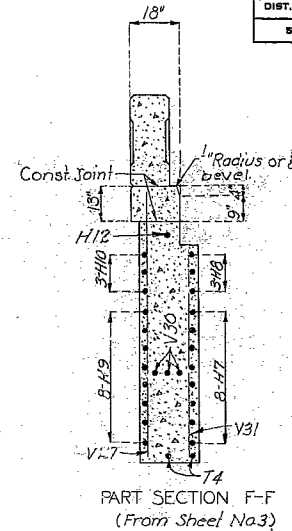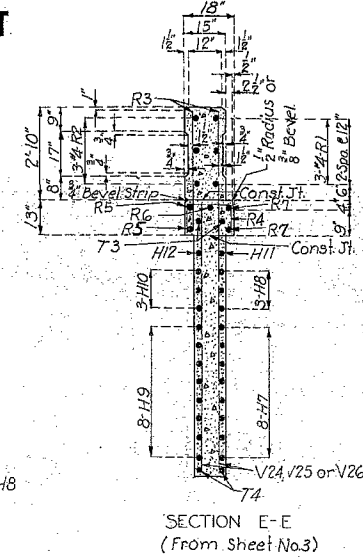

BRIDGE OVER RT & LT LANES (RT. 69)

STATE ROAD FROM ANTIOCH ROAD IN NORTH KANSAS CITY N.E.

ABOUT 4.5 MILES N.E. OF NORTH KANSAS CITY

PROJECT NO. U.I. 99(7) (RT. 69) STA. 4+04.77

CLAY

COUNTY

FINISHED

Drawn Aug. 1954 by K.W.
Checked Sept. 1954 by C.S.A.

Note: This drawing is not to scale. Follow dimensions.

Sheet No. 4 of 11. FINISHED





FINISHED

SEE FINAL PLANS BROWN-LINES

L-655

MISSOURI STATE HIGHWAY DEPARTMENT

FED. ROAD DIST. NO.	STATE	FED. AID PROJ. NO.	FISCAL YEAR	SHEET NO.	TOTAL SHEETS
U	MO.	U-1-99(7)	10		

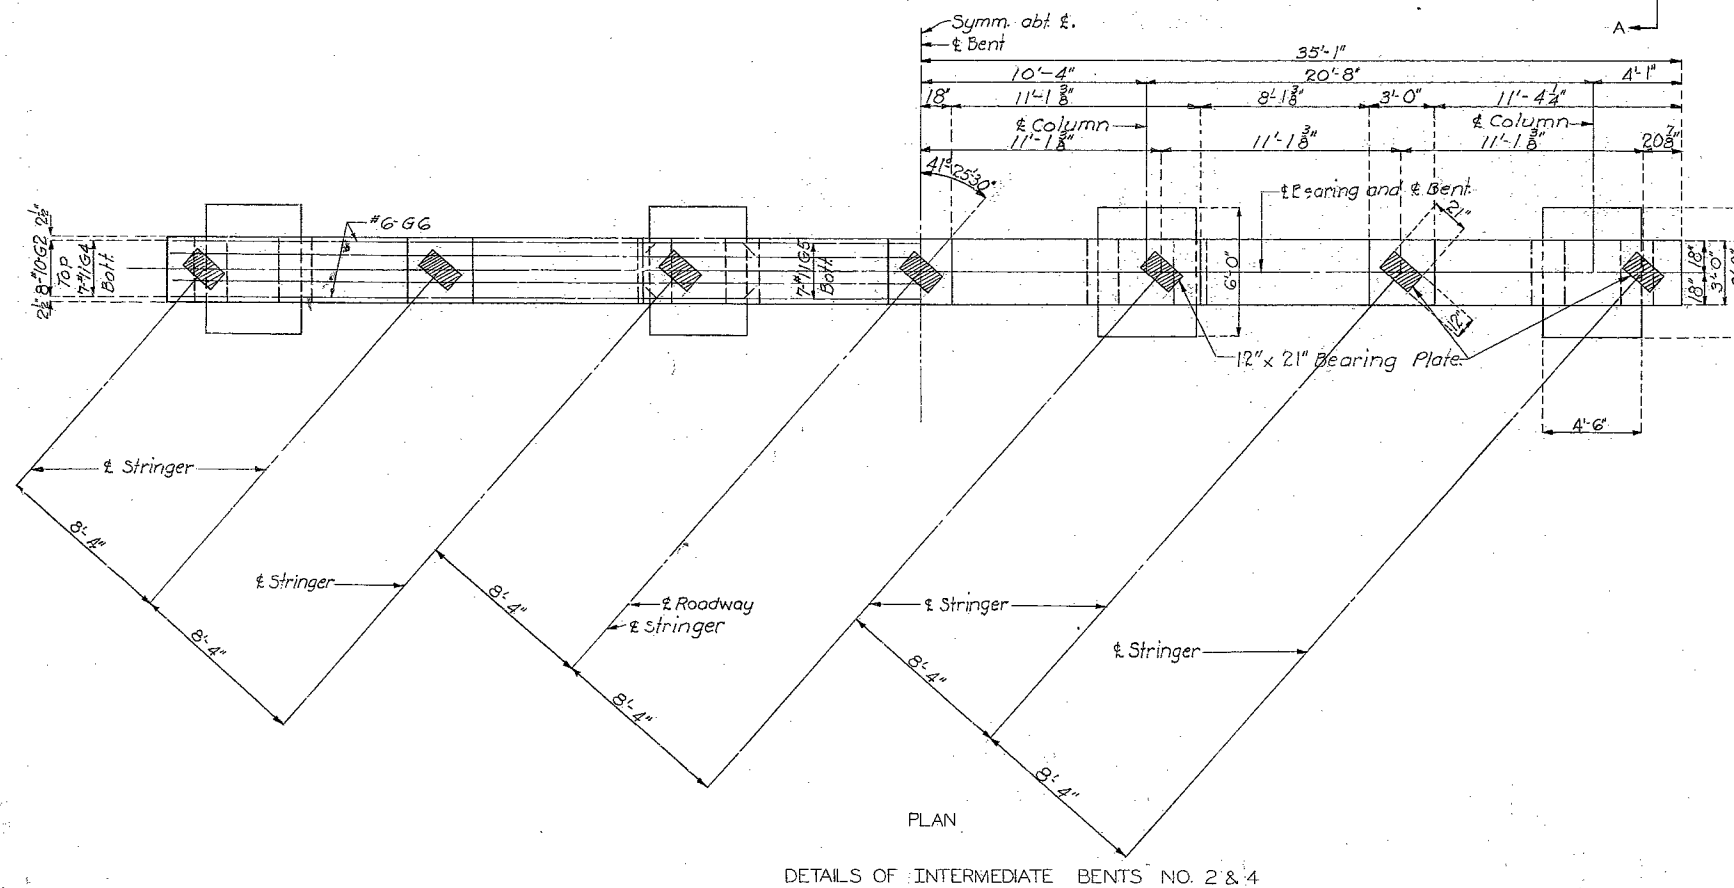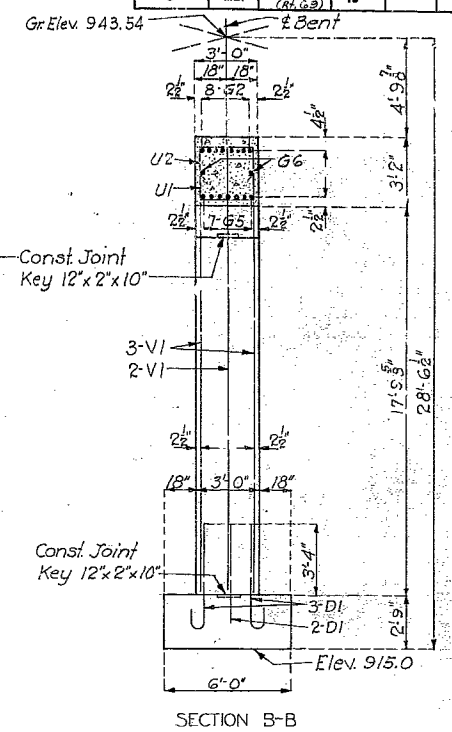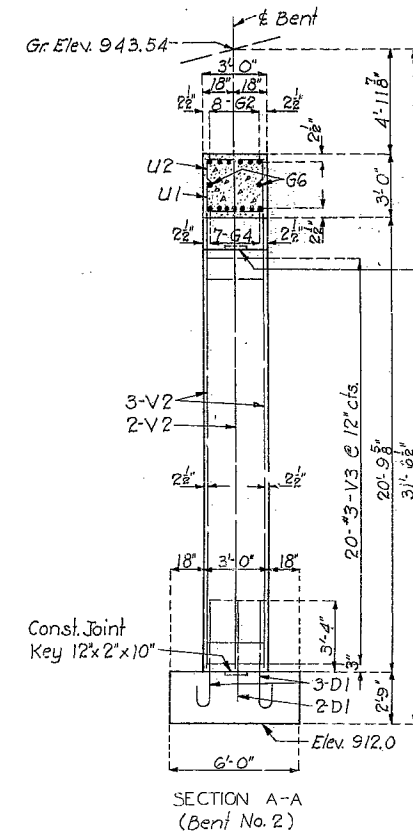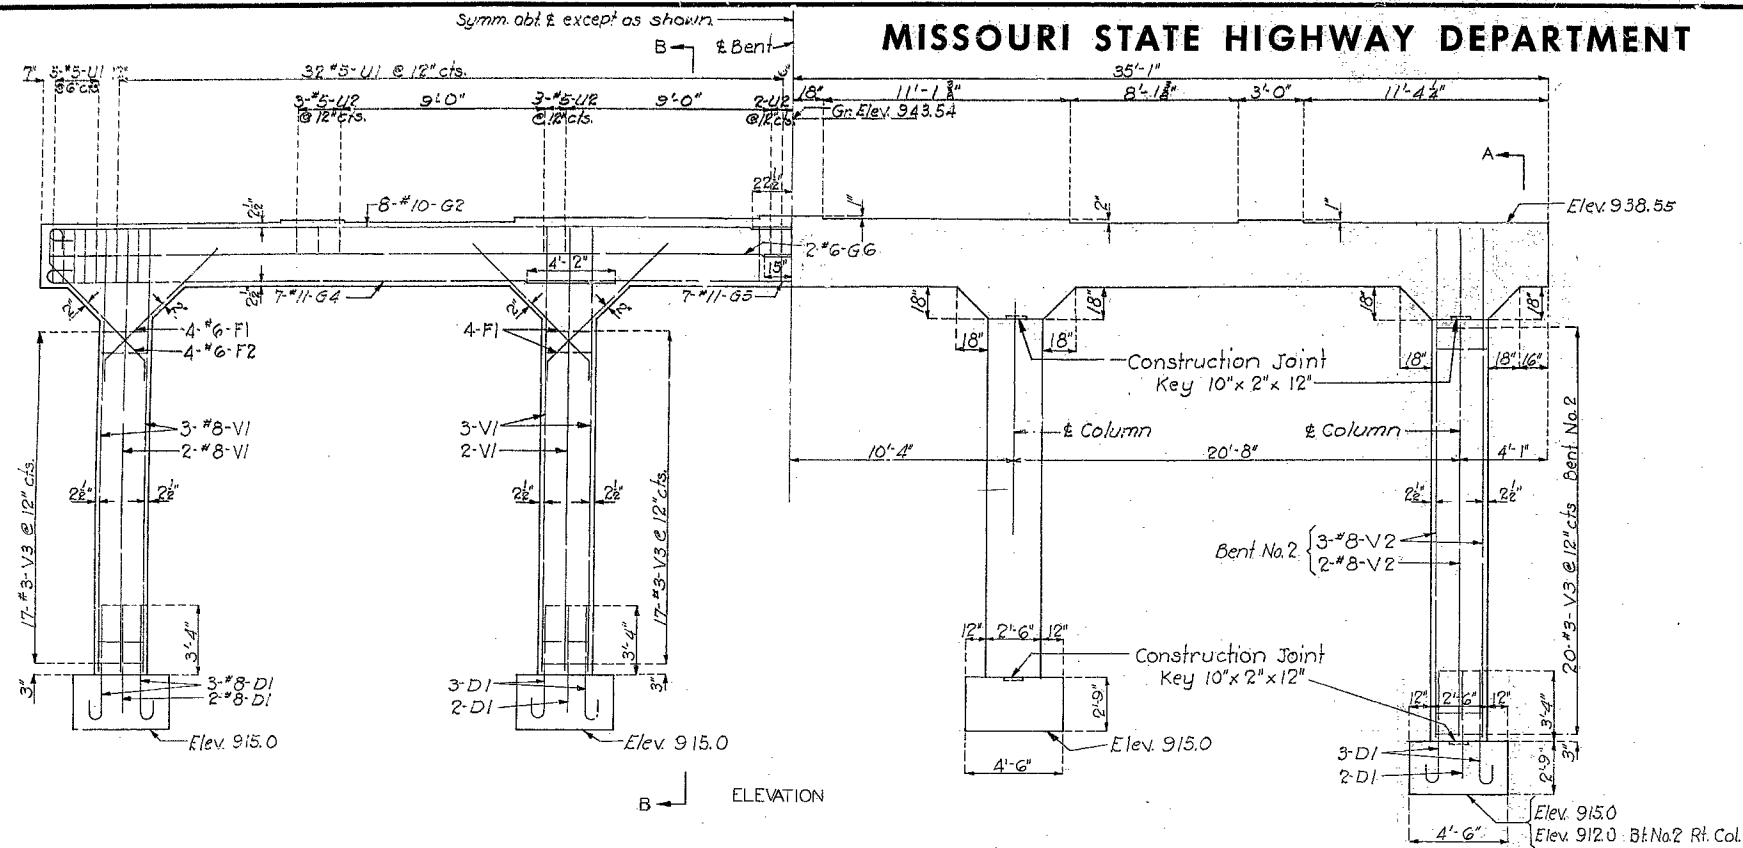

DETAILS OF INTERMEDIATE BENTS NO. 2 & 4

BRIDGE OVER RT. & LT. LANES (RT. 69)
 STATE ROAD FROM ANTIOCH ROAD IN NORTH KANSAS CITY N.E.
 ABOUT 4.5 MILES N.E. OF NORTH KANSAS CITY
 PROJECT NO. U-1-99(7) (RT. 69) STA. 4+04.77
 CLAY COUNTY

Drawn AUG. 1954 by K.R.W.
 Checked Sept. 1954 by C.S.A.

Note: This drawing is not to scale. Follow dimensions.

Sheet No. 5 of 11




FINISHED

FINISHED
 L-655

SEE FINAL PLANS BROWN LINES

MISSOURI STATE HIGHWAY DEPARTMENT

FED. ROAD DIST. NO.	STATE	FED. AID PROJ. NO.	FISCAL YEAR	SHEET NO.	TOTAL SHEETS
5	MO.	U.I.-99(7) (RT. 69)	19		

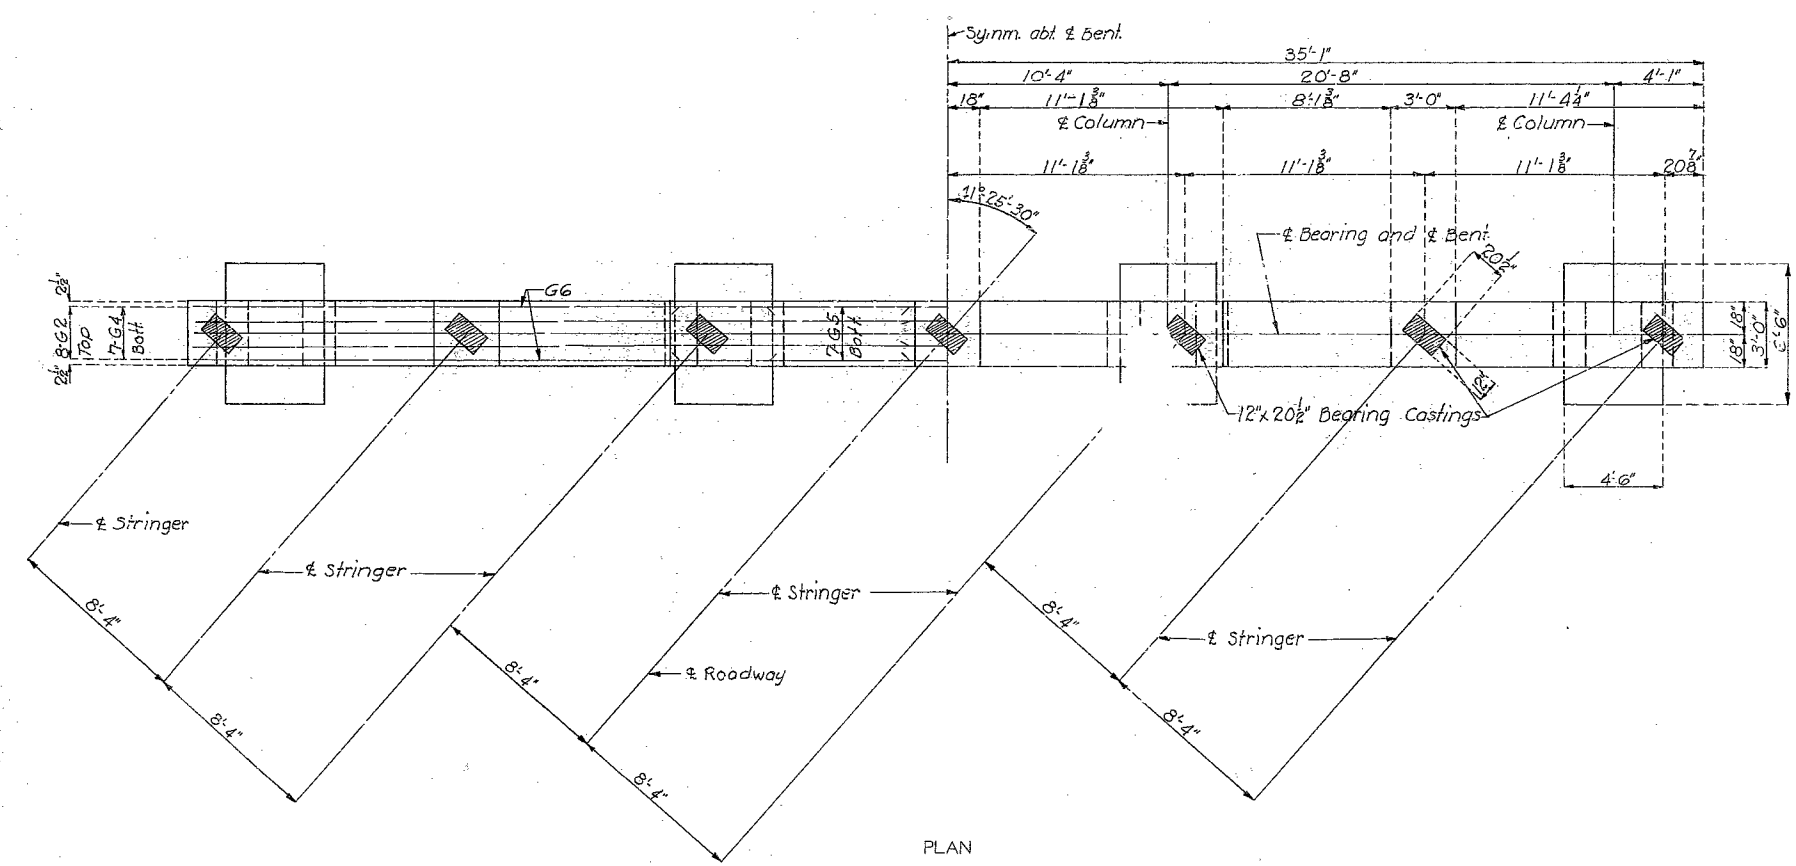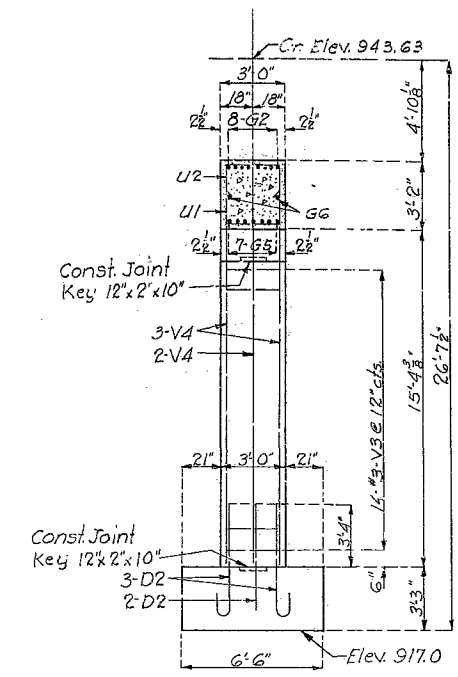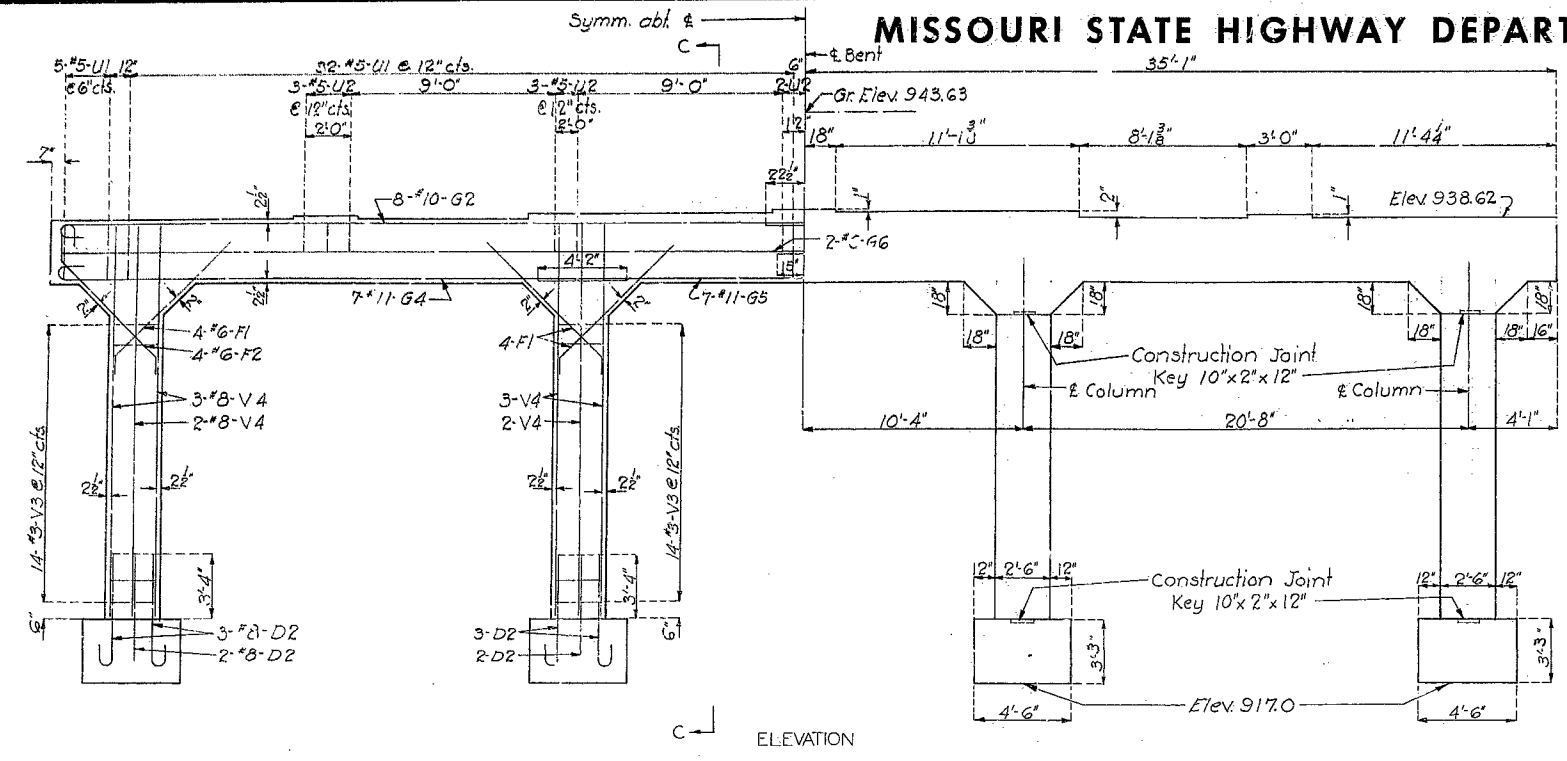

DETAILS OF INTERMEDIATE BENT NO. 3

BRIDGE OVER RT. & LT. LANES (RT. 69)
 STATE ROAD FROM ANTIOCH ROAD IN NORTH KANSAS CITY NE
 ABOUT 4.5 MILES N.E. OF NORTH KANSAS CITY
 PROJECT NO. U.I.-99(7) (RT. 69) STA. 4+04.77

CLAY COUNTY FINISHED

Drawn AUG. 1954 by K.R.W.
 Checked Sept. 1954 by C.S.A.


Note: This drawing is not to scale. Follow dimensions.

Sheet No. 6 of 11. FINISHED

SEE FINAL PLANS BROWN-LINES

L-655

FED. ROAD DIST. NO.	STATE	FED. AID PROJ. NO.	FISCAL YEAR	SHEET NO.	TOTAL SHEETS
8	MO.	W-937 (81.63)	19		

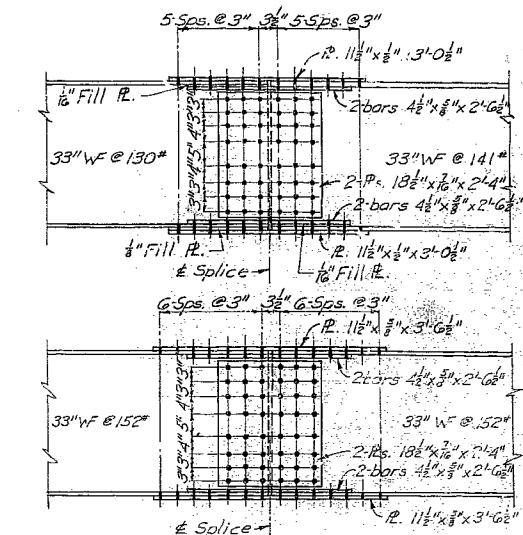

5'-0"

5'-0"

± 5/16"

{P. 9" x 1 1/4" x 10'-0" (Strs. #2 & 6)}

{P. 9" x 1 1/4" x 10'-0" (Strs. #3, 4 & 5)}

{P. 9 1/2" x 1 1/4" x 10'-0" (Strs. #1 & 12)}

2L 3 1/2" x 5" 7/8" Gr 10 to bear top & bottom

2L 3 1/2" x 5" 7/8" Gr 10 to bear top & bottom

2L 3 1/2" x 5" 7/8" Gr 10 to bear top & bottom


{P. 9 1/2" x 1 1/4" x 10'-0" (Strs. #1 & 12)}

{P. 9" x 1 1/4" x 10'-0" (Strs. #2 & 6)}


{P. 9" x 1 1/4" x 10'-0" (Strs. #3, 4 & 5)}

Drill for 1" Turned Bolts

DETAILS AT BEARING

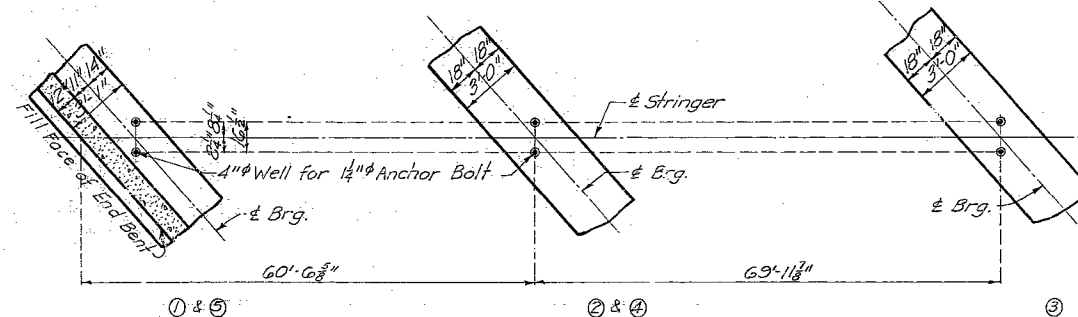[illegible]

PART LONGITUDINAL SECTION NEAR ϕ ROADWAY
(Parallel to ϕ Roadway)

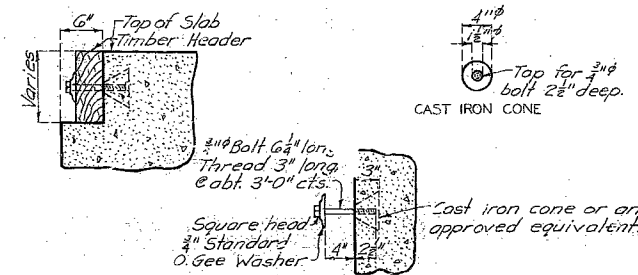

Note. Holes for all anchor bolts shall be formed in substructure by placing and setting with template 4" Wells of depth shown.

Grout for anchor bolts shall contain Iron Oxide. (Embeco or an approved equivalent.)


DETAILS OF ANCHOR BOLT WELLS

FINISHED


L-655

NO CONSTRUCTION CHANGES

FED. ROAD DIST. NO.	STATE	FED. AID PROJ. NO.	FISCAL YEAR	SHEET NO.	TOT. SHEETS
5	MO.	W.I.-88(7) (P. 2)	19		

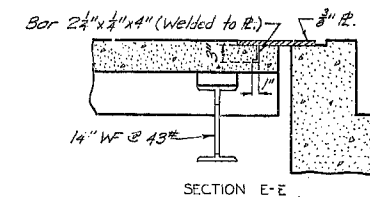


SECTION E-

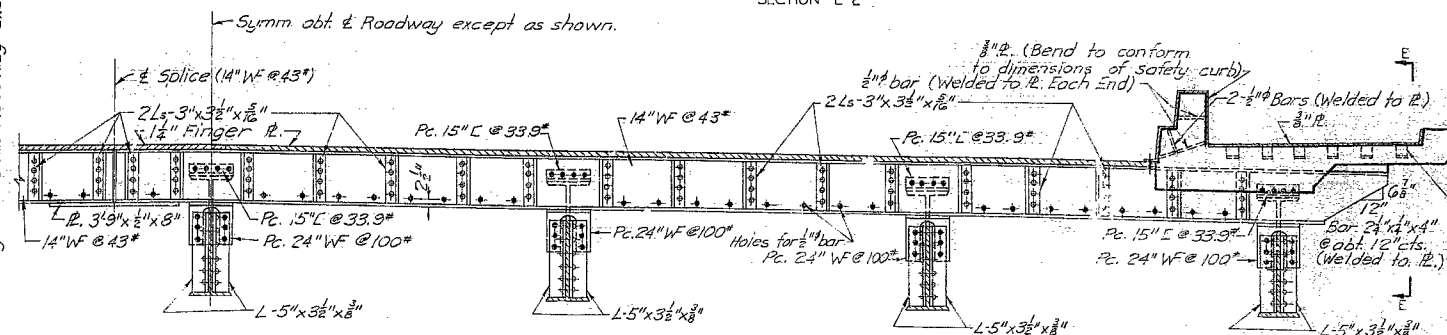

PART SECTION A-A


Note: 1 $\frac{1}{2}$ " Finger Pcs., 1 $\frac{1}{4}$ " WF @ 45° and 1" x 3 $\frac{1}{2}$ " x 1 $\frac{1}{2}$ " Ls to be bent to conform with crown of roadway.
Subpunch 1 $\frac{1}{2}$ " and ream to 1 $\frac{1}{2}$ " in field all holes in air direction of Pc. 24" WF @ 100° and Pc. 15" L @ 33.9°.
All 3" x 3 $\frac{1}{2}$ " x 1 $\frac{1}{2}$ " stiffener Ls to be ground to bear top and bottom.
All 5" x 3 $\frac{1}{2}$ " x 3" stiffener Ls to be ground to bear at bottom.

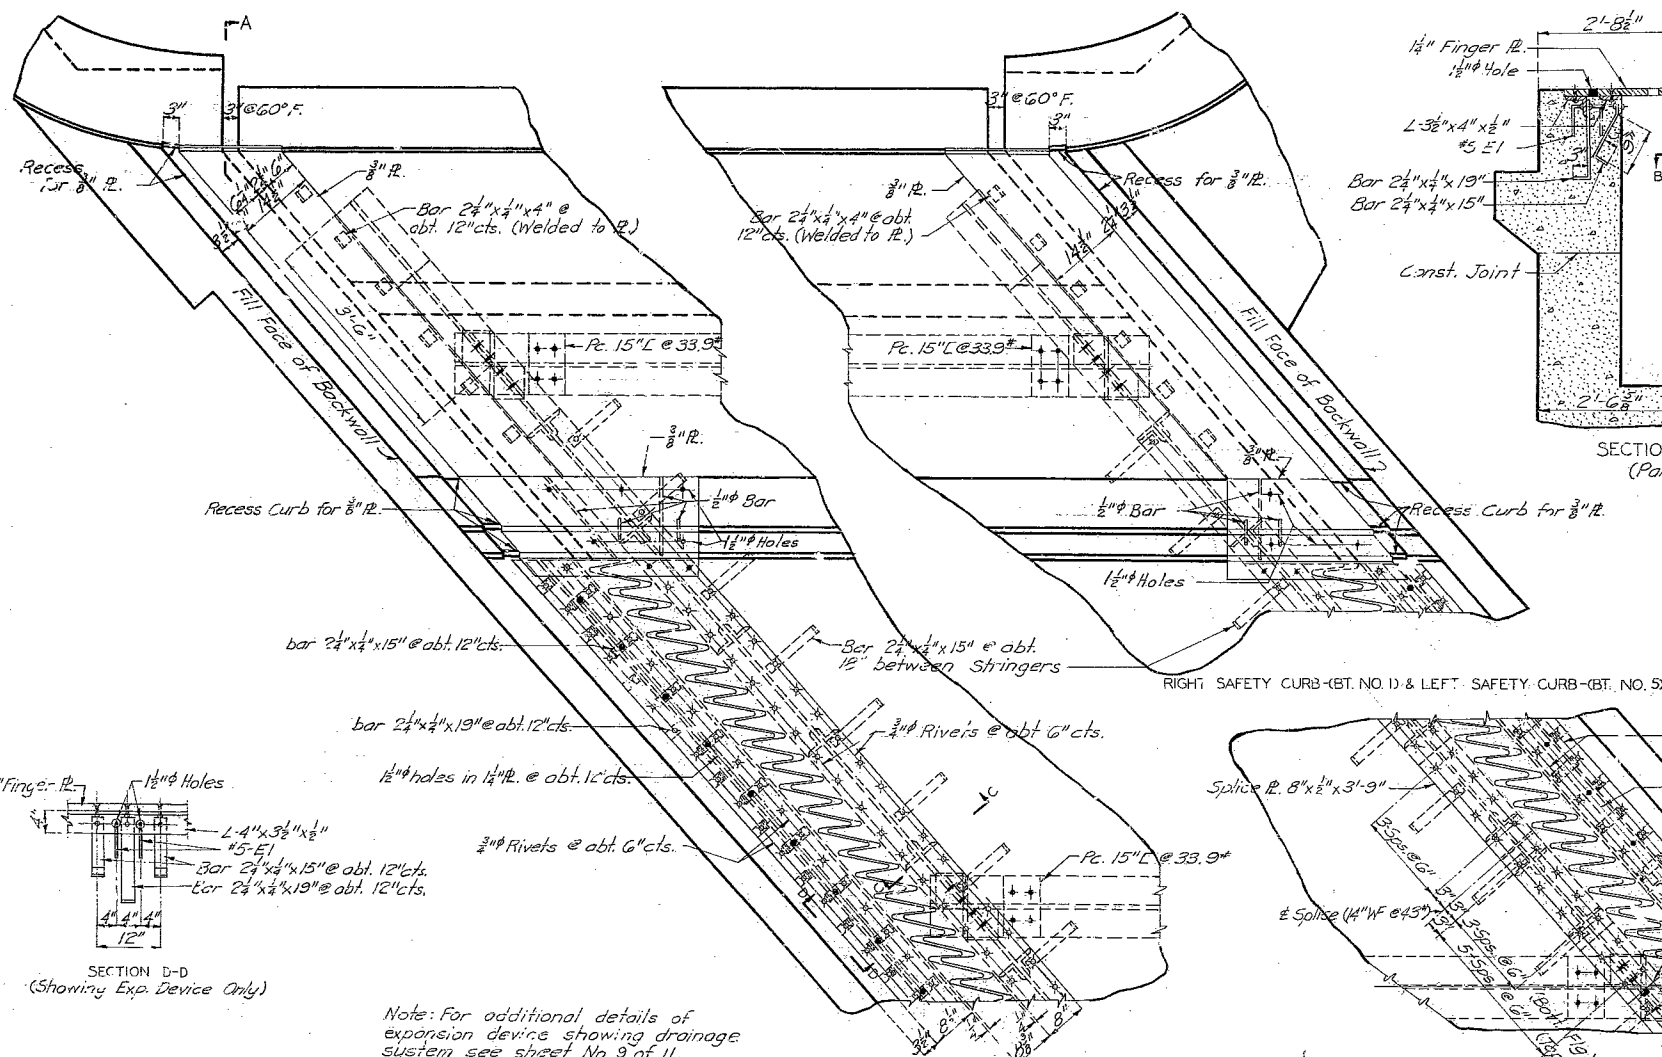


SECTION D-D
(Showing Exp. Device Only)

Drawn Aug. 1954 by M.H.P.
Checked Sept. 1954 by C.S.A.

Note: For additional details of expansion device showing drainage system see sheet No. 9 of 11.

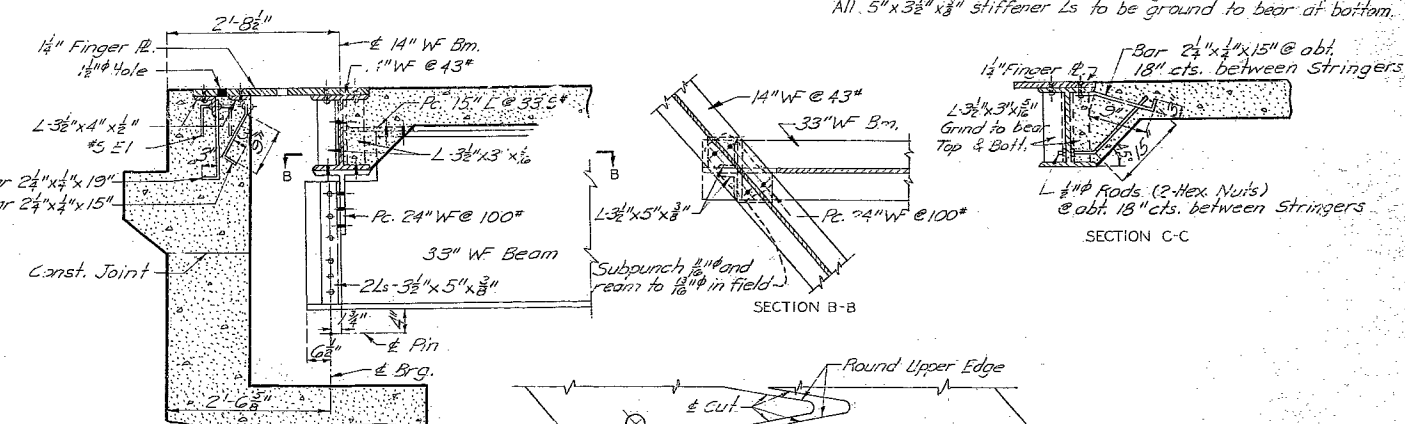


SECTION THRU EXP. DEVICE
(Parallel to & Stringer

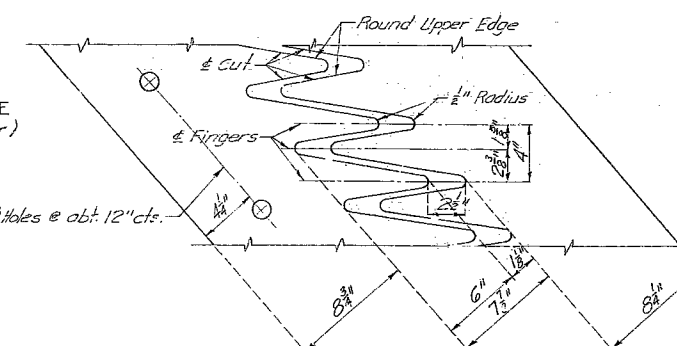

FINGER PLATE LAYOUT

Note: Finger plates shall be cut from one plate 23"x1 1/2". The surface of cut shall be perpendicular to the surface of plate. The cut shall not exceed 8" in width. The centerline of cut shall not deviate more than 1/8" from the position of cut shown above. Expansion device to be spliced as shown.

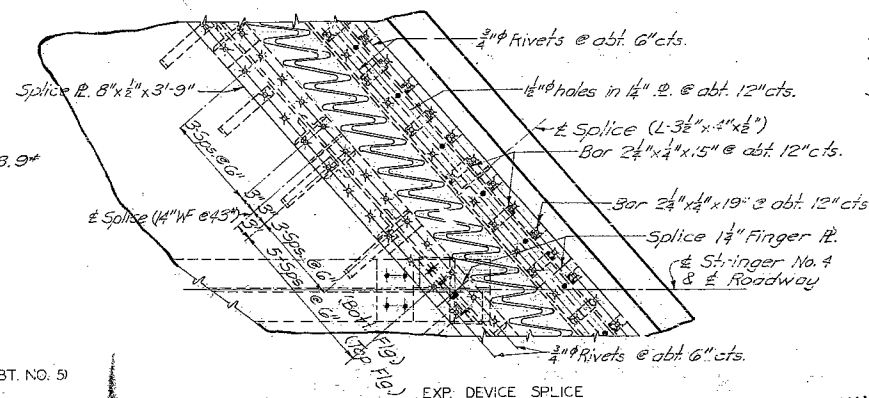

EXP. DEVICE SPLICE

Sheet No. 8 of 11

FINISHED

FINISHED

FINISHED


1-655

Note: This drawing is not to scale. Follow dimensions.

PART PLAN OF EXPANSION DEVICE

NO CONSTRUCTION CHANGES


FED. ROAD DIST. NO.	STATE	FED. AID PROJ. NO.	FISCAL YEAR	SHEET NO.	TOTAL SHEETS
5	MO.	41-99(1) (81-2)	19		

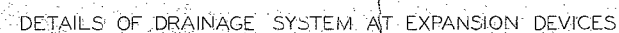



L-655

MISSOURI STATE HIGHWAY DEPARTMENT

FED. ROAD DIST. NO.	STATE	FED. AID PROJ. NO.	FISCAL YEAR	SHEET NO.	TOTAL SHEETS
5	MO.	42-997 (Rt. 69)	19		

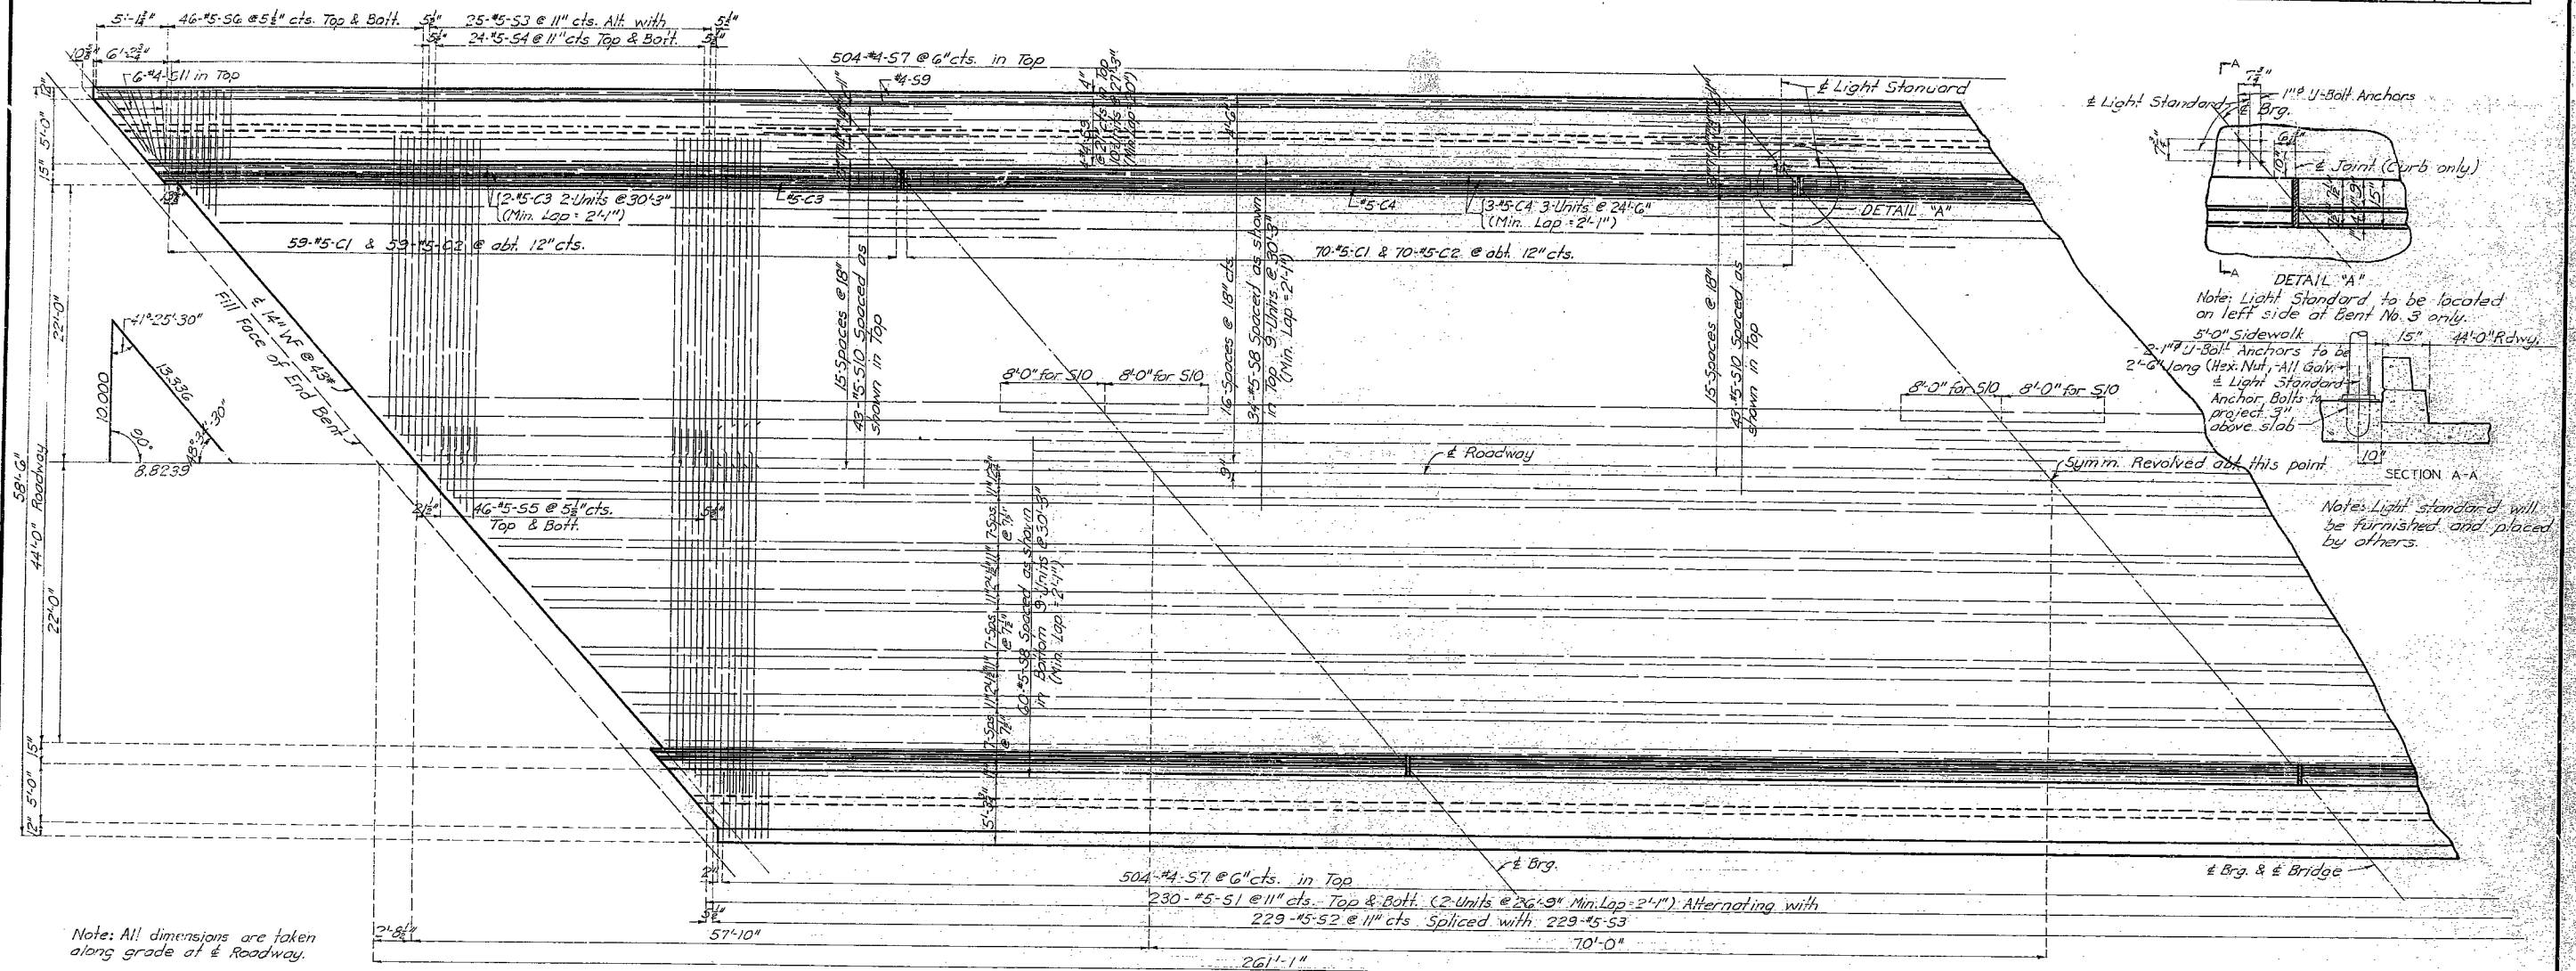


Note: All dimensions are taken along grade at \pm Roadway.

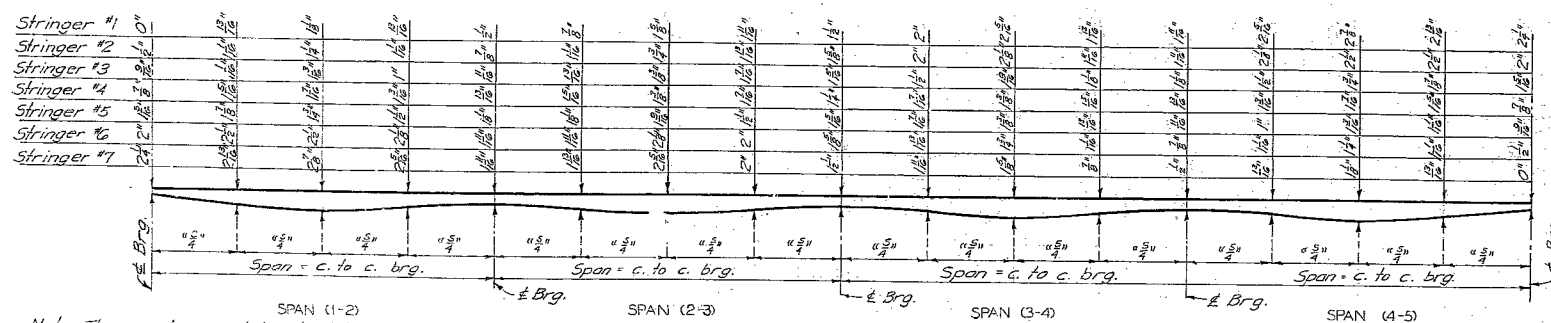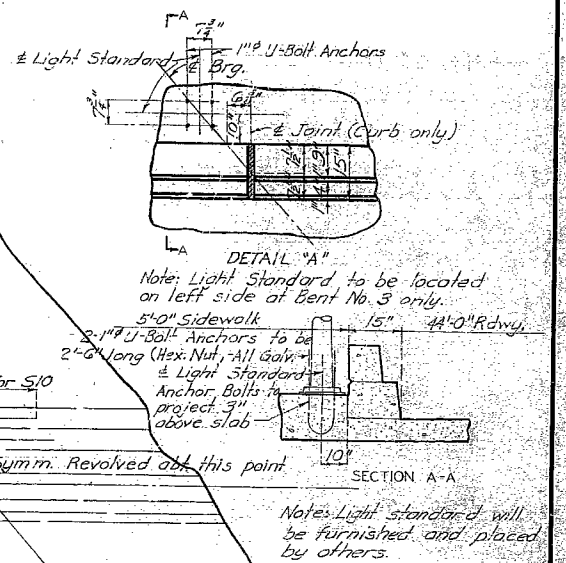

Note: The roadway slab shall be built parallel to grade and to a uniform thickness of 6". Dead load deflection, vertical curve, difference in depth of stringers, and crown shall be taken care of by haunching to stringers by the amounts shown above. This additional concrete is included in Estimated Quantities.

SLAB HAUNCHING DIAGRAM

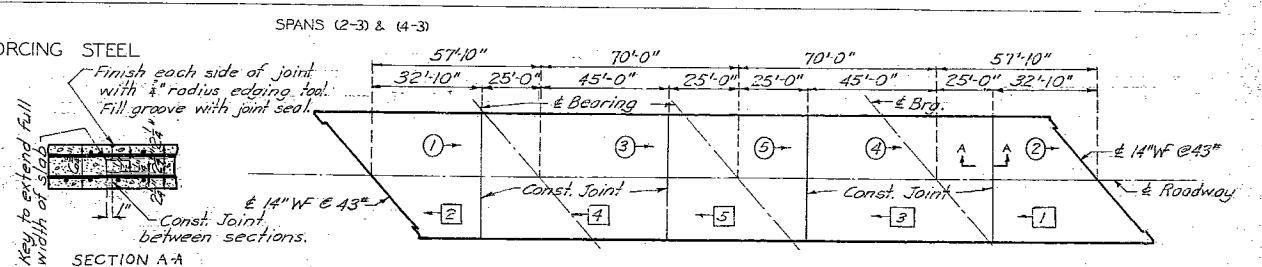

Note: The slab shall be poured in sections of the lengths shown above and in the sequence indicated by the numbers 1, 2, 3, 4, 5 or, as an alternate, by the numbers 1, 2, 3, 4, 5. The separate pours shall progress in the direction indicated by the arrows. Longitudinal construction joints will not be permitted.

SLAB POURING SEQUENCE

BRIDGE OVER RT. & LT. LANES (RT. 69)

STATE ROAD FROM ANTILOCH ROAD IN NORTH KANSAS CITY, MO.

ABOUT 4.5 MILES N.E. OF NORTH KANSAS CITY

PROJECT NO. U.I.-997 (RT. 69) STA. 4+0.77

CLAY

COUNTY

FINISHED

FINISHED

L-655

Drawn Aug. 1954 by M.H.P.
Checked Sep. 1954 by C.S.A.

Note: This drawing is not to scale. Follow dimensions.


DETAIL OF BEVEL FOR FILLED JOINTS

Sheet No. 10 of 11. FINISHED



NO CONSTRUCTION CHANGES

MISSOURI STATE HIGHWAY DEPARTMENT


FED. ROAD DIST. NO.	STATE	FED. AID PROJ. NO.	FISCAL YEAR	SHEET NO.	TOTAL SHEETS
5	MO.	117-0870 (11.68)	19		

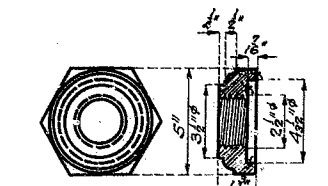

CAST STEEL NUT
70-Required
35-3" Rolled steel pins required.

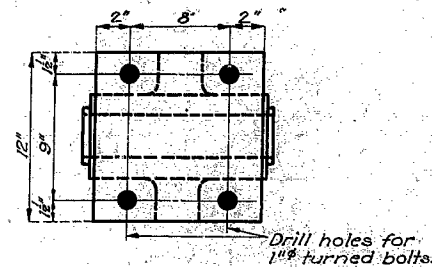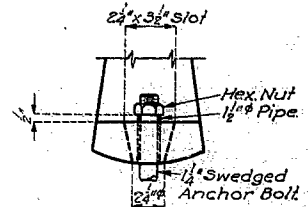


Drill holes for 1" turned bolts.

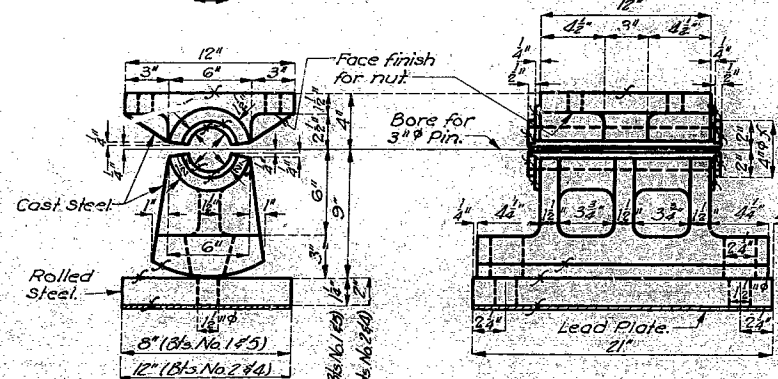

EXPANSION ROCKER FOR BENTS NO. 1, 2, 4, 5
28-Required

Note: Cast steel cap same as shown above.

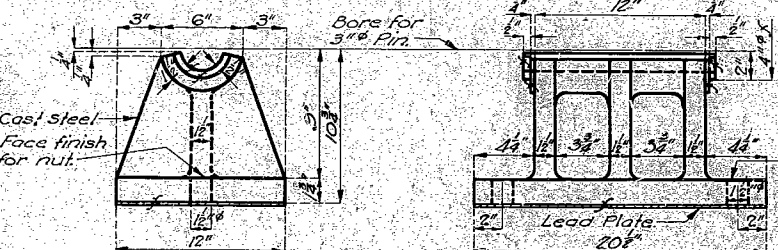


FIXED PEDESTAL FOR BENT NO. 3
7-Required


GENERAL NOTES:

- All fillets shall have 3/4" radius.
- Finish all surfaces marked "f".
- All pins, bolts, nuts, pipe, sleeves and rolled plates will be paid for as structural steel.
- Anchor bolts shall be 1/2 inch swaged bolts with hex. nuts and shall extend 12" into concrete.
- Lead plates under bearings shall be approximately 3/8" thickness and weigh 8#/sq. ft. Cast or lead plates shall be included in price bid for other items.


DETAILS OF BEARING CASTING

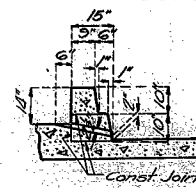

SECTION A-A

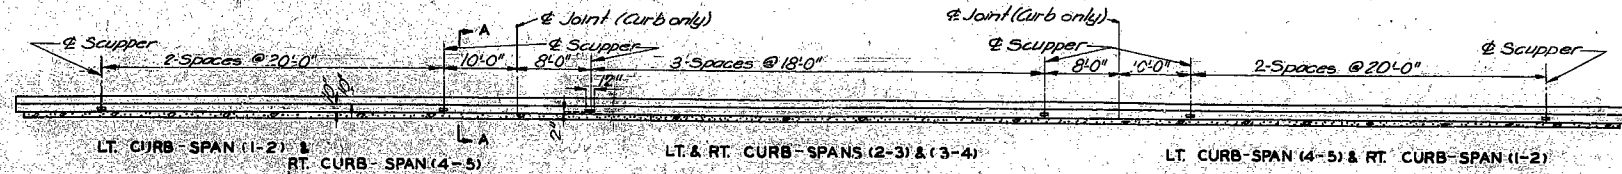


SECTION ALONG GUTTER LINE SHOWING SCUPPER SPACING IN SAFETY CURB

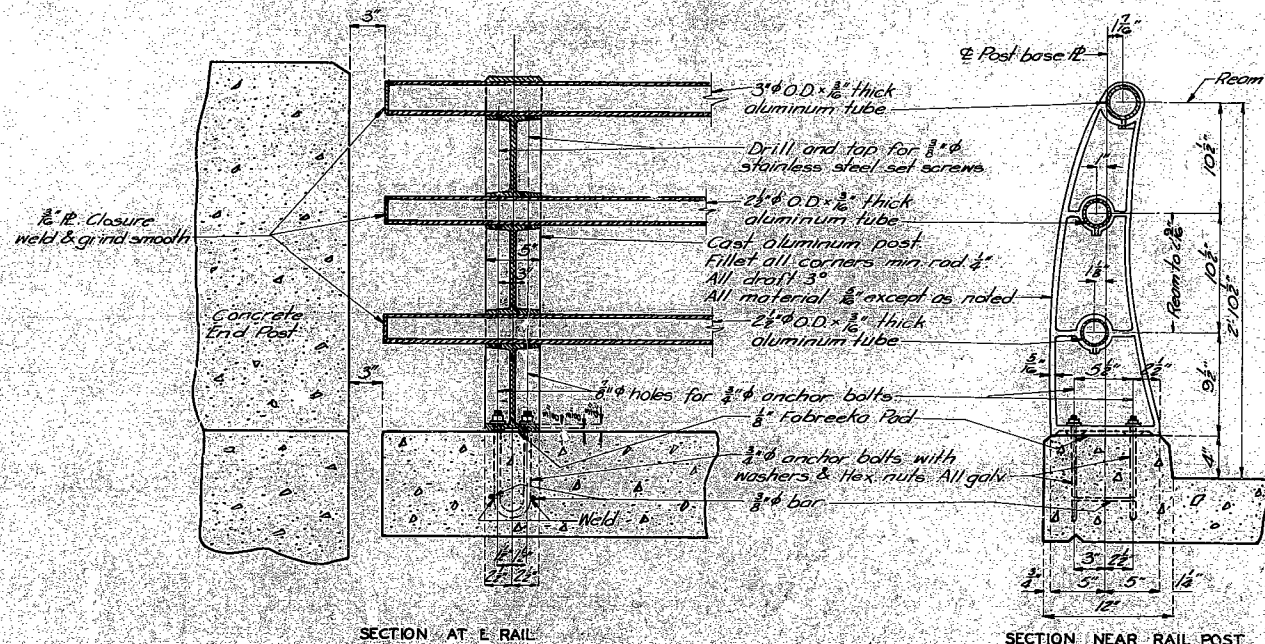

SECTION AT RAIL


SECTION NEAR RAIL POST

DETAILS OF HANDRAIL

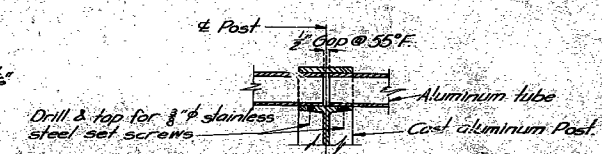


RAIL SPLICE

- Note: Use similar details of rail expansion joints except use 1" gap and tighten 3/8" set screw nearest bearing to a snug fit only. (See Special Provisions)
- Note: All handrail post shall be set normal to grade. All parts of handrail except set screws and steel anchor bolts and their washers and nuts to be aluminum. Pipe rail to be fabricated in 3 panel lengths unless otherwise approved. Aluminum shims between fabeeka pad and post base may be used for adjusting rail alignment. Maximum thickness of shim to be 3/8". Where more tilting of post is required for proper alignment concrete bearing surface may be ground down.

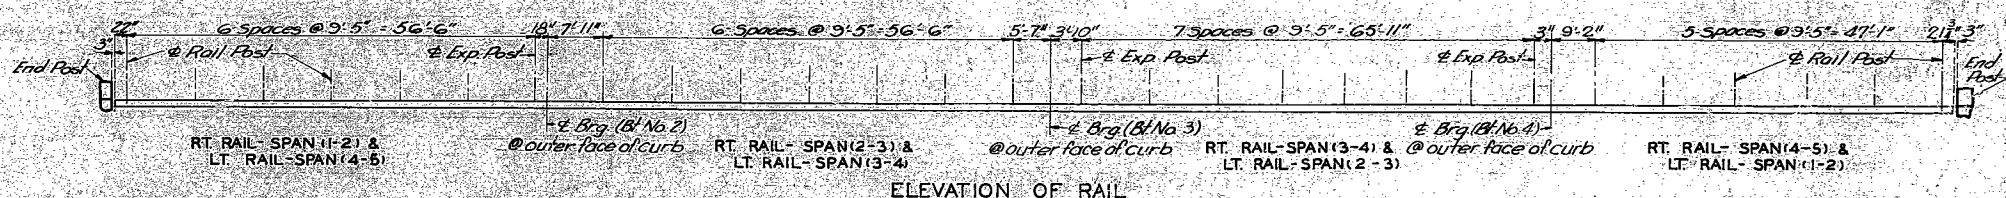

ELEVATION OF RAIL

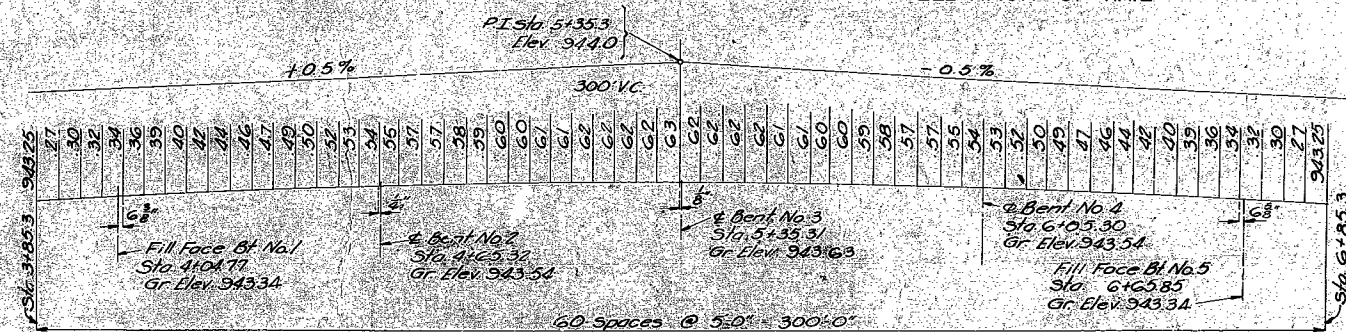

GRADE ELEVATION ALONG ROADWAY

Note: This drawing is not to scale. Follow dimensions.

Sheet No. 11 of 11.

NO CONSTRUCTION CHANGES

BRIDGE OVER RT. & LT. LANES (RT. 69)

STATE ROAD FROM ANTIOCH ROAD IN NORTH KANSAS CITY N.E.
ABOUT 4.5 MILES N.E. OF NORTH KANSAS CITY
PROJECT NO. U-1-99(7) (RT. 69) STA. 4+04.77

CLAY COUNTY

FINISHED


L-655

Assembled Aug. 1954 by MHP:SNs.
Checked Sept. 1954 by C.S.A.


MISSOURI STATE HIGHWAY DEPARTMENT

FED. ROAD DIST. NO.	STATE	FED. AID PROJ. NO.	FISCAL YEAR	SHEET NO.	TOTAL SHEETS
8	MO.	U.I.-99(7) (R. 69)	16		

FINAL PLANS

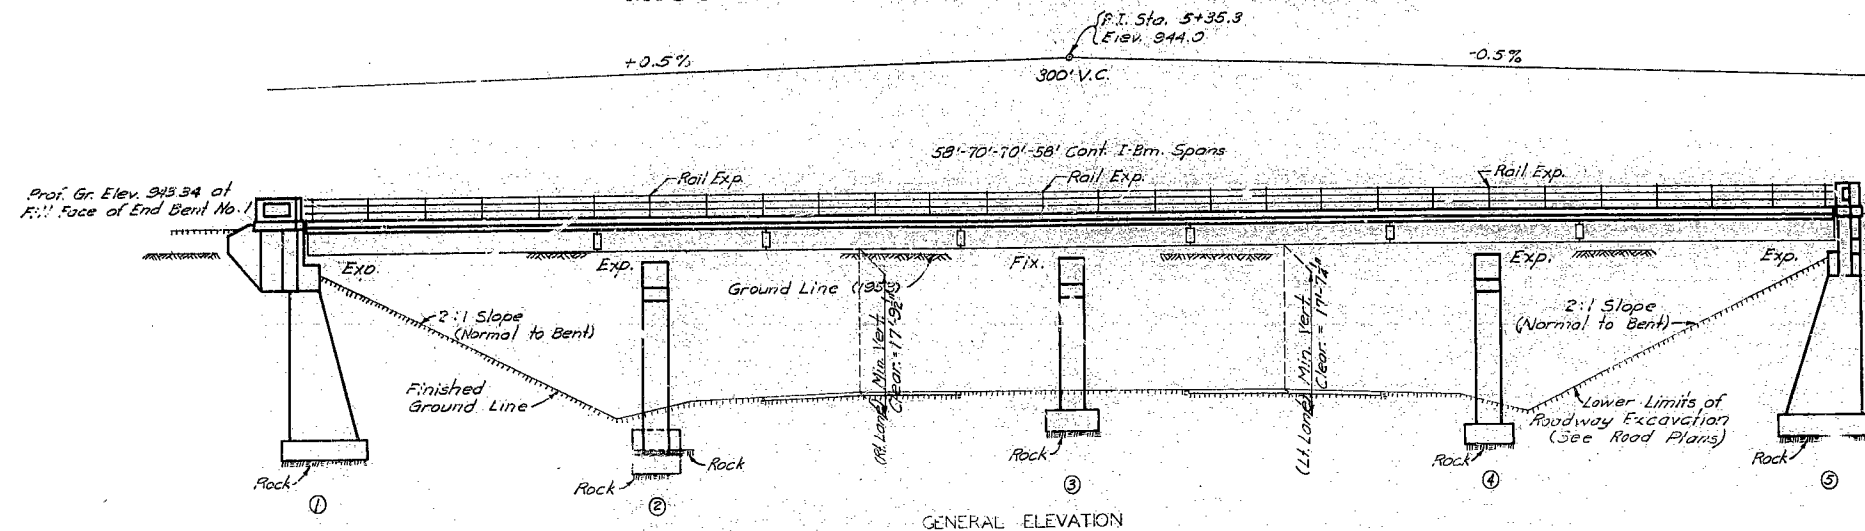

Note: All loose, shelly or disintegrated rock was removed and the surface placed on hard, undisturbed rock.

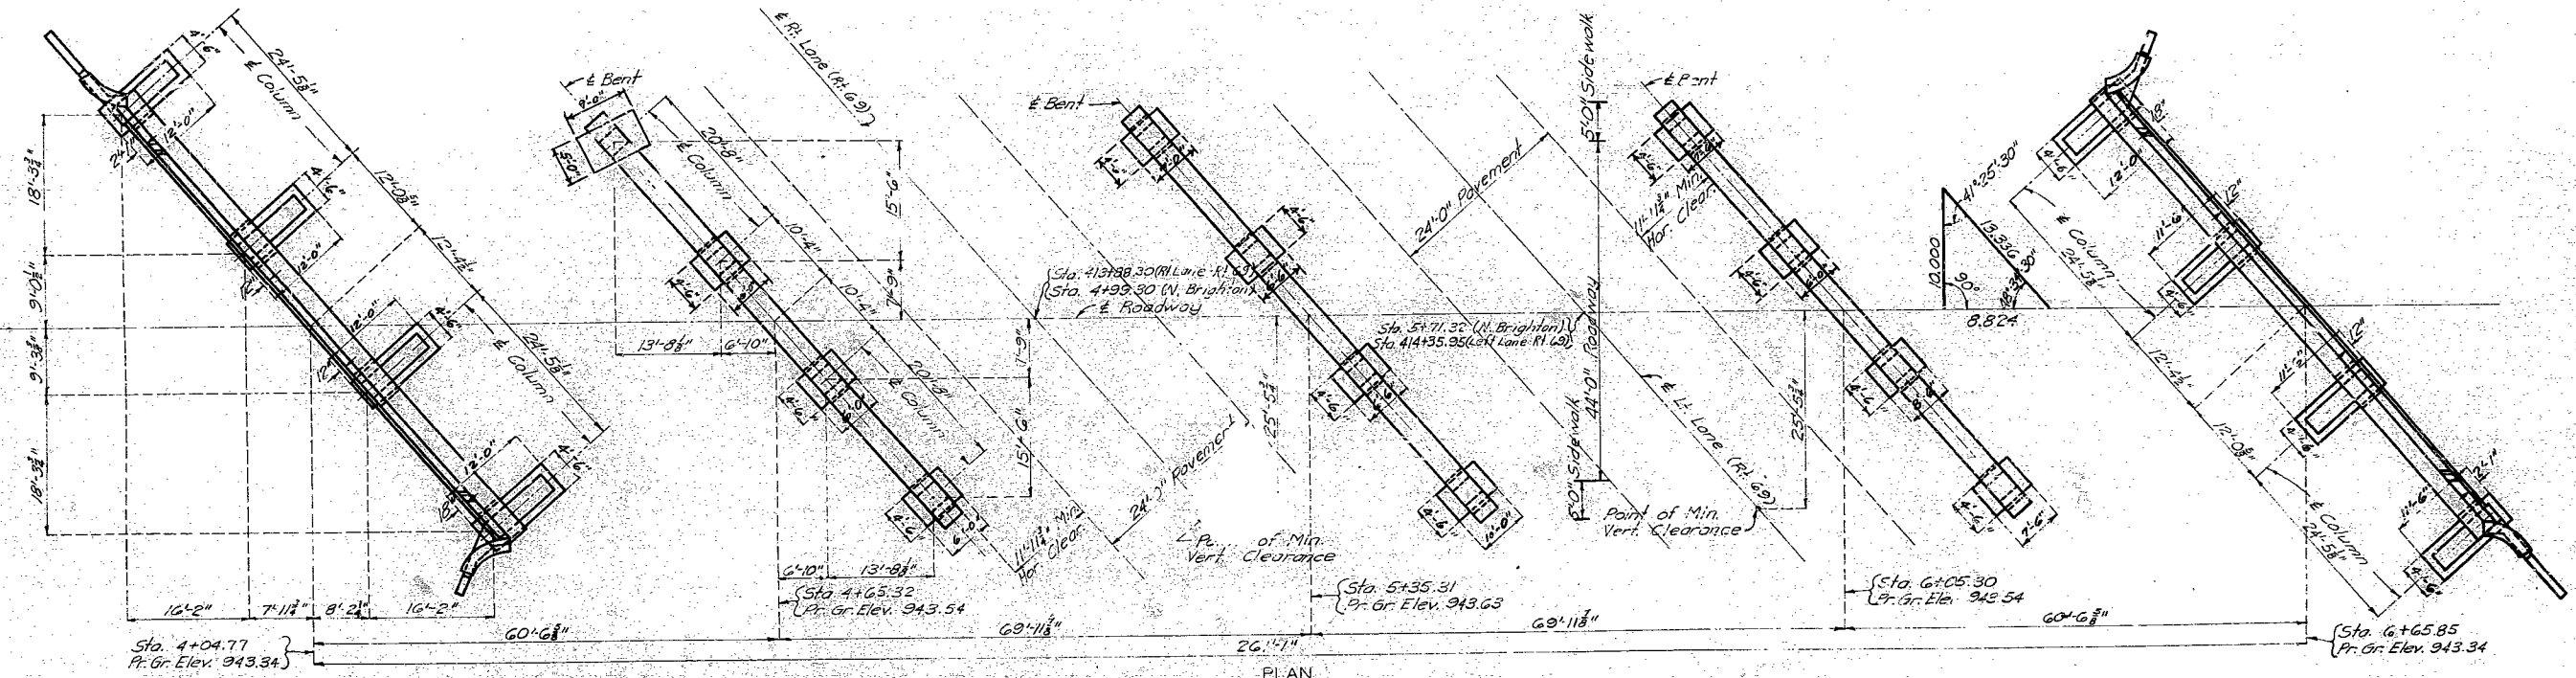

FINAL QUANTITIES				
Item	Units	Quantity	Supers	Total
Class I Excavation for Structures	Cu Yds.	1001.5		1001.5
Class "B" Concrete	Cu Yds.	411.2	31.7	442.9
Reinforcing Steel	Lbs.	56290	70760	127050
Fabricated Structural Steel	Lbs.	336870	336870	
Steel Castings	Lbs.	11,270	11,270	
Aluminum Alloy Handrail	Lin. Ft.		516	516
Wrought Iron Drains	Lbs.		2430	2430
6" 12 Gauge Metal Pipe	Lin. Ft.		170	170
Class I Excavation Below Plan Grade	Cu Yds.	22.5		22.5
Foundation Test Holes	Ft.	161.0		161.0

Note: All excavation for bridge will be paid for as Class I Excavation for Structures. Estimated quantities of Class I Excavation for Structures includes only amount of excavation below Roadway Excavation (See Special Provisions). Concrete in end posts is included with substructure concrete.

Note: This drawing is not to scale. Follow dimensions.

GENERAL NOTES:
Design Specifications: A.A.S.H.O. 1953
Loading: 120,000 lbs.
Structural Steel Stress: 18,000 psi
Reinforcing Steel Stress: 18,000 psi
Concrete, Class "B" Stress: 1200 psi
All concrete was Class "B" (Air-Entrained)
Rivets 3/8", spaced 12" except as noted.
Field connections were riveted.

Where joint filler is specified on the plans it conform with the requirements for Gray Rubber Compound Joints as given in section 38-19B(2) of the Standard Specifications.
For requirements on welding also see Special Provisions.
Qualification of welding operators was required.
Paint, Shop, name, field, contact, 3 coats of field connections, one coat of red lead and surfaces surfaces first coat red lead, second coat brown, third coat aluminum. Payment for cleaning and painting such surfaces is included in price bid for items painted.
A rubbed surface finish was required on all exposed surfaces of concrete end posts above top of curbs.

E.M. Elev. 943.79 @ Top of Right Wing Abut. No. 1

BRIDGE OVER RT. & LT. LANES (RT. 69)
STATE ROAD FROM ANTIOCH ROAD IN NORTH KANSAS CITY NE. ABOUT 4.5 MILES NE. OF NORTH KANSAS CITY
PROJECT NO. U.I.-99(7) (RT. 69) STA. 4+04.77
CLAY COUNTY

SUBMITTED BY J.A. Williams DATE 10/13/1954
APPROVED BY J.A. Williams DATE 10/13/1954

FINISHED
STD. C-110R3
L-655

FINAL PLANS


Designed June 1954 by H.J.K.
Drawn Aug. 1954 by M.H.P.
Checked Sept. 1954 by C.S.A.

68

MISSOURI STATE HIGHWAY DEPARTMENT



FED. ROAD DIST. NO.	STATE	FED. AID PROJ. NO.	FISCAL YEAR	SHEET NO.	TOTAL SHEETS
5	MO.	U.S. 99 (7)	19		

FINAL PLANS

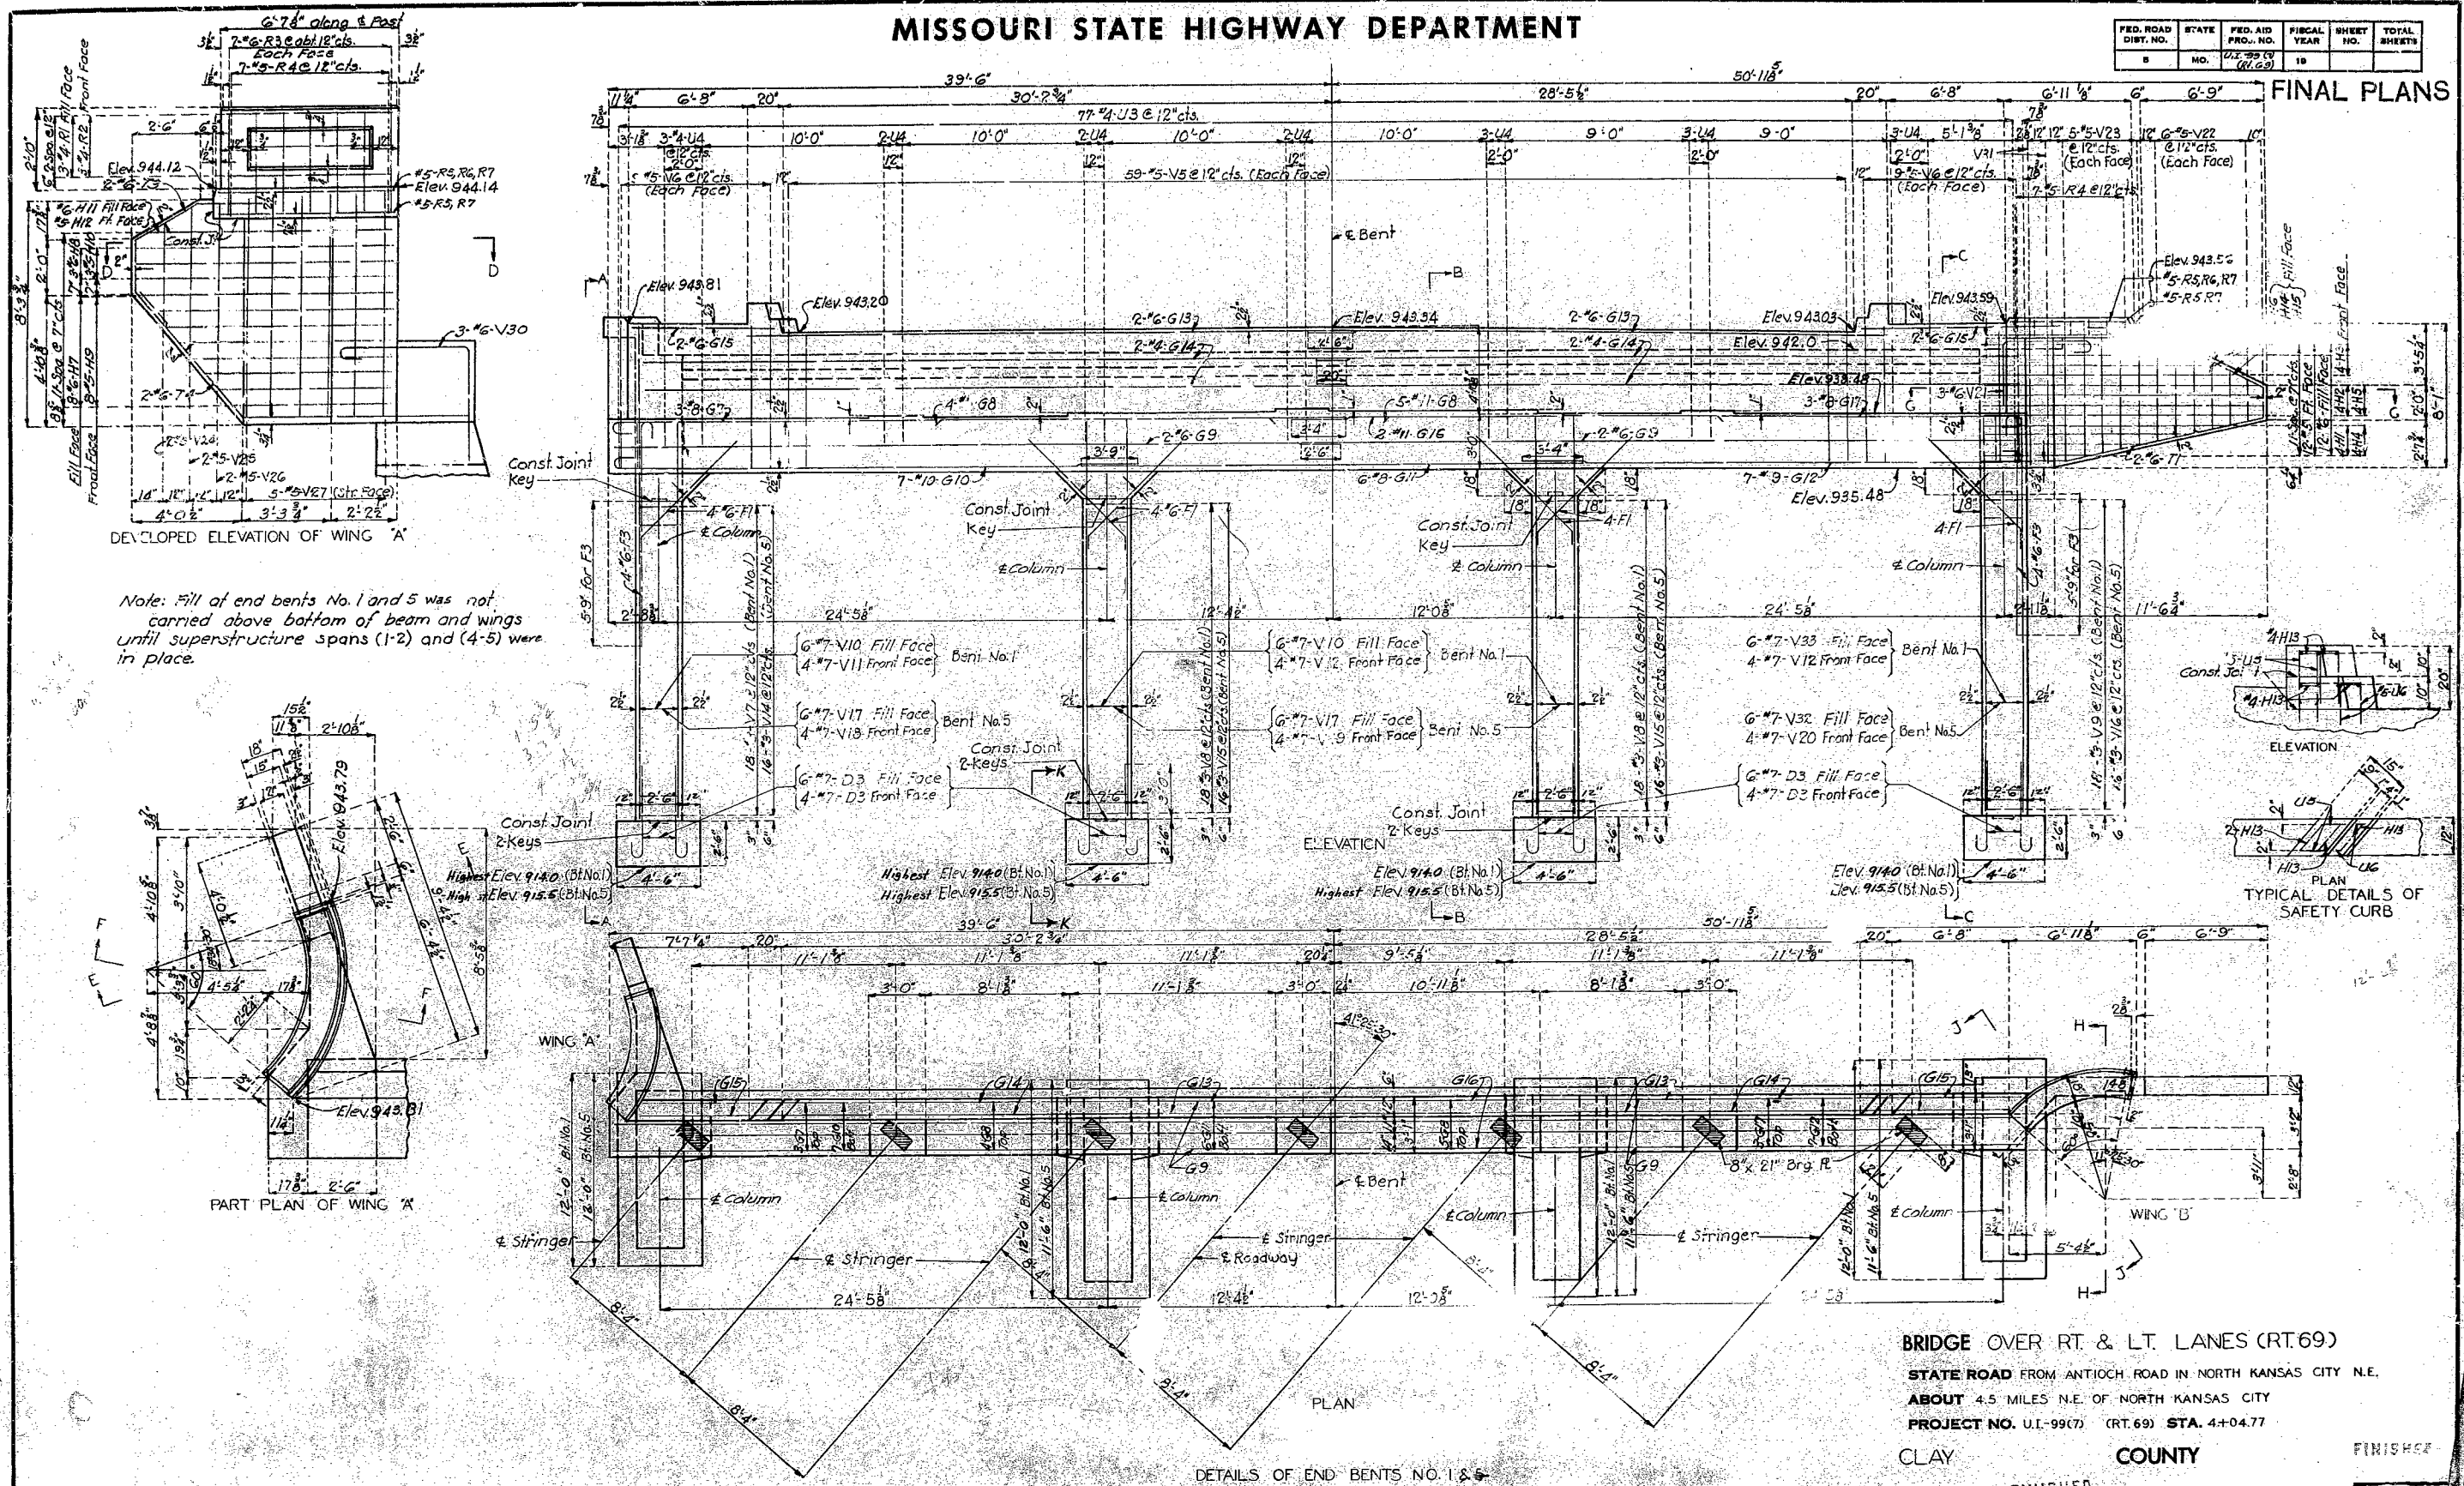

DEVELOPED ELEVATION OF WING 'A'

Note: Fill of end bents No. 1 and 5 was not carried above bottom of beam and wings until superstructure spans (1-2) and (4-5) were in place.

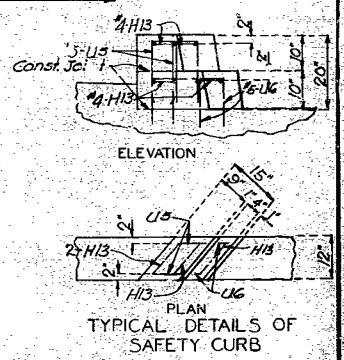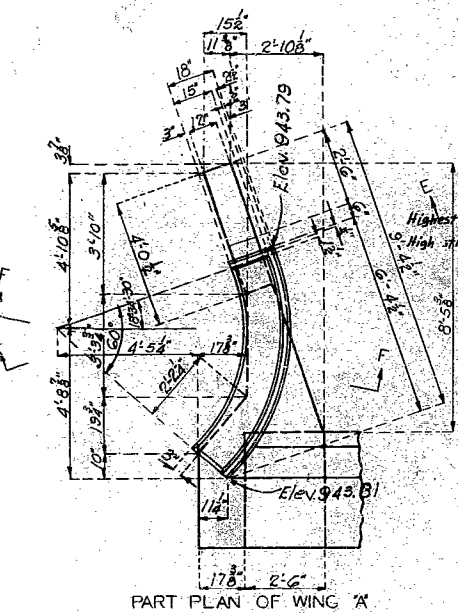

BRIDGE OVER RT. & LT. LANES (RT. 69)
 STATE ROAD FROM ANTIOCH ROAD IN NORTH KANSAS CITY N.E.
 ABOUT 4.5 MILES N.E. OF NORTH KANSAS CITY
 PROJECT NO. U.I.-99(7) (RT. 69) STA. 4+04.77

CLAY COUNTY FINISHED
 FINISHED

L-655

Drawn AUG. 1954 by K.R.W.
 Checked Sept. 1954 by C.S.A.









Note: This drawing is not to scale. Follow dimensions.

Sheet No. 3A of 5

FINAL PLANS

69

MISSOURI STATE HIGHWAY DEPARTMENT

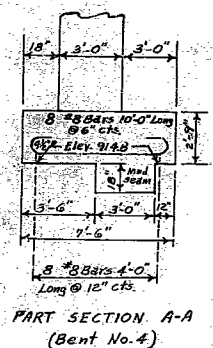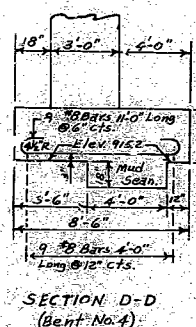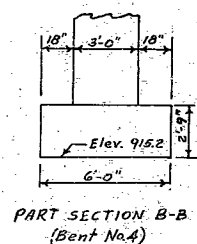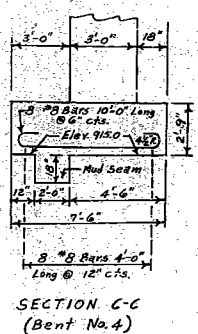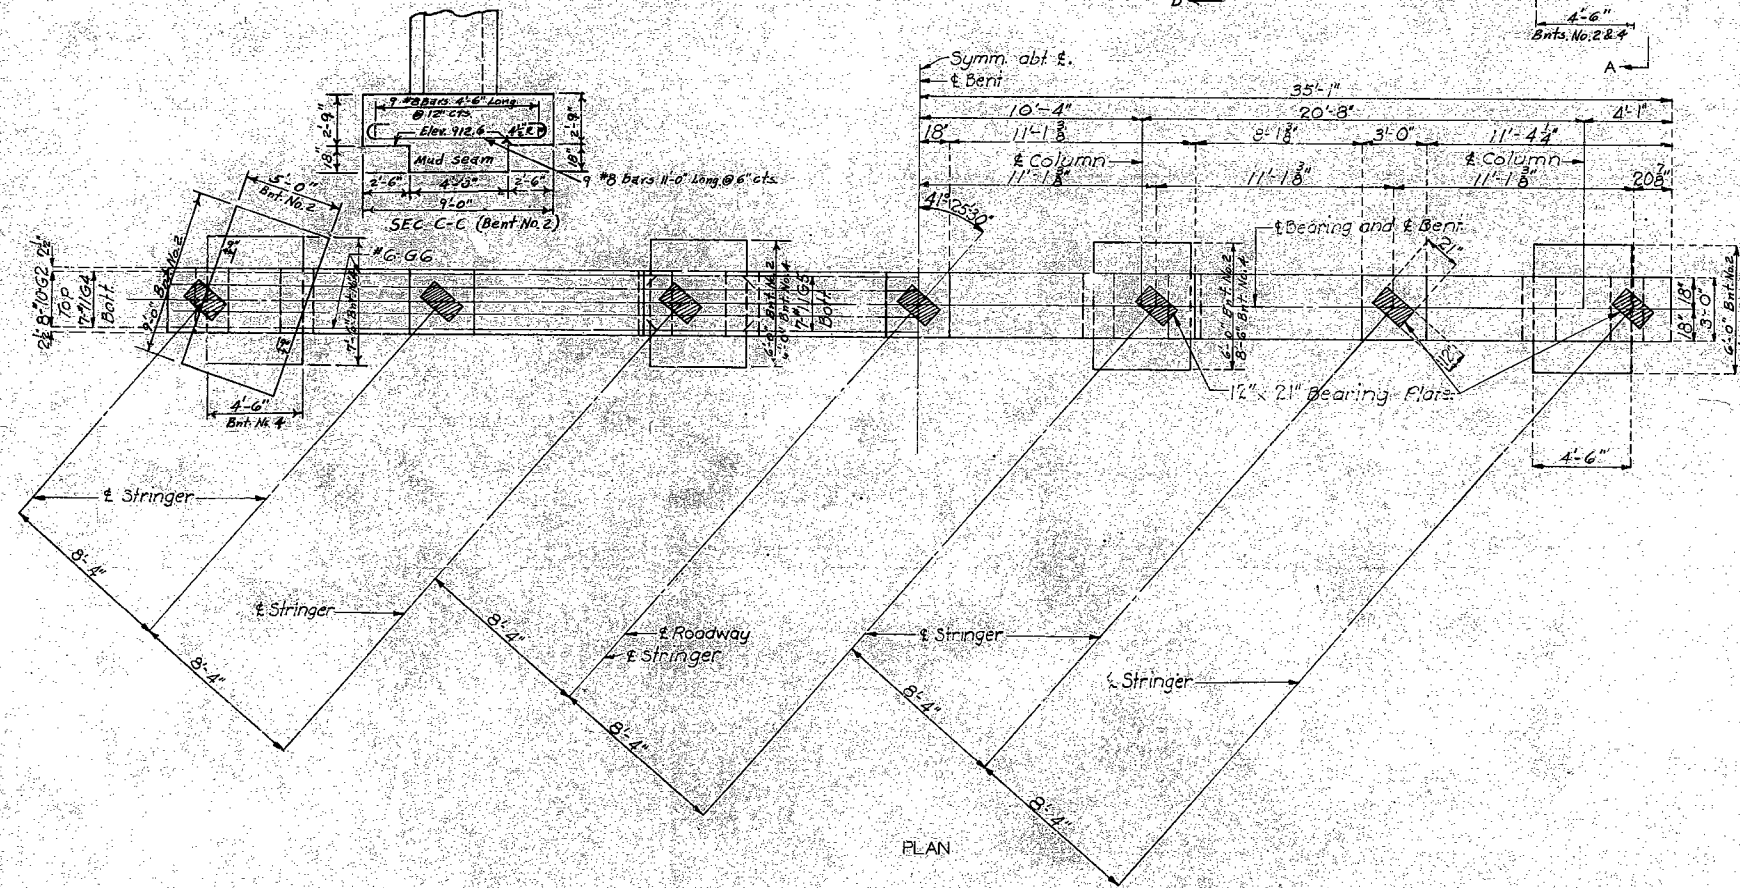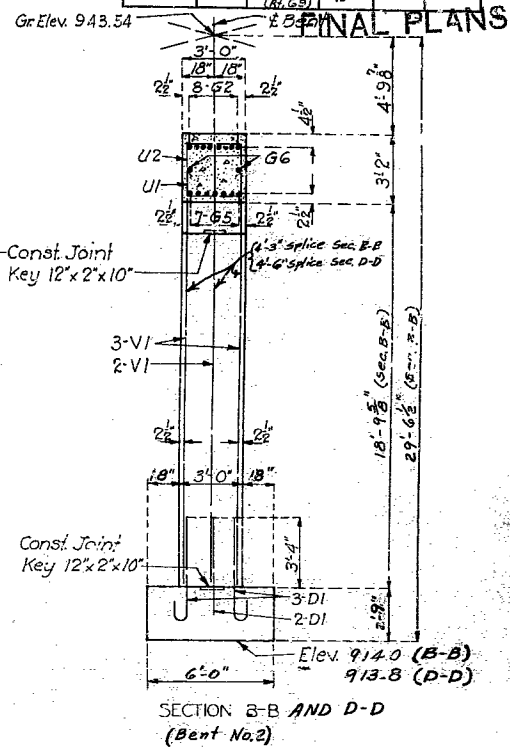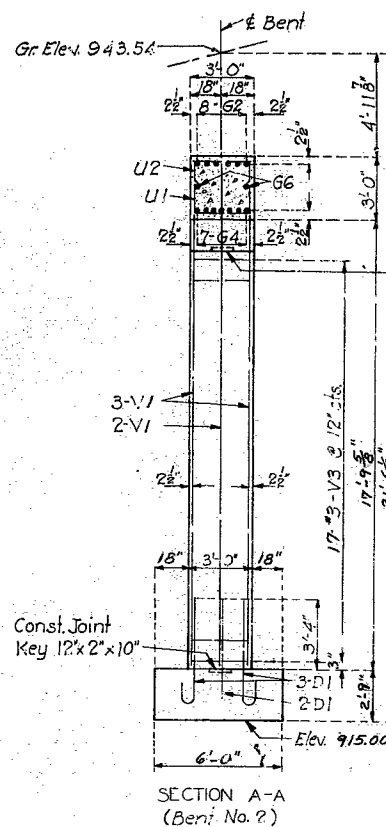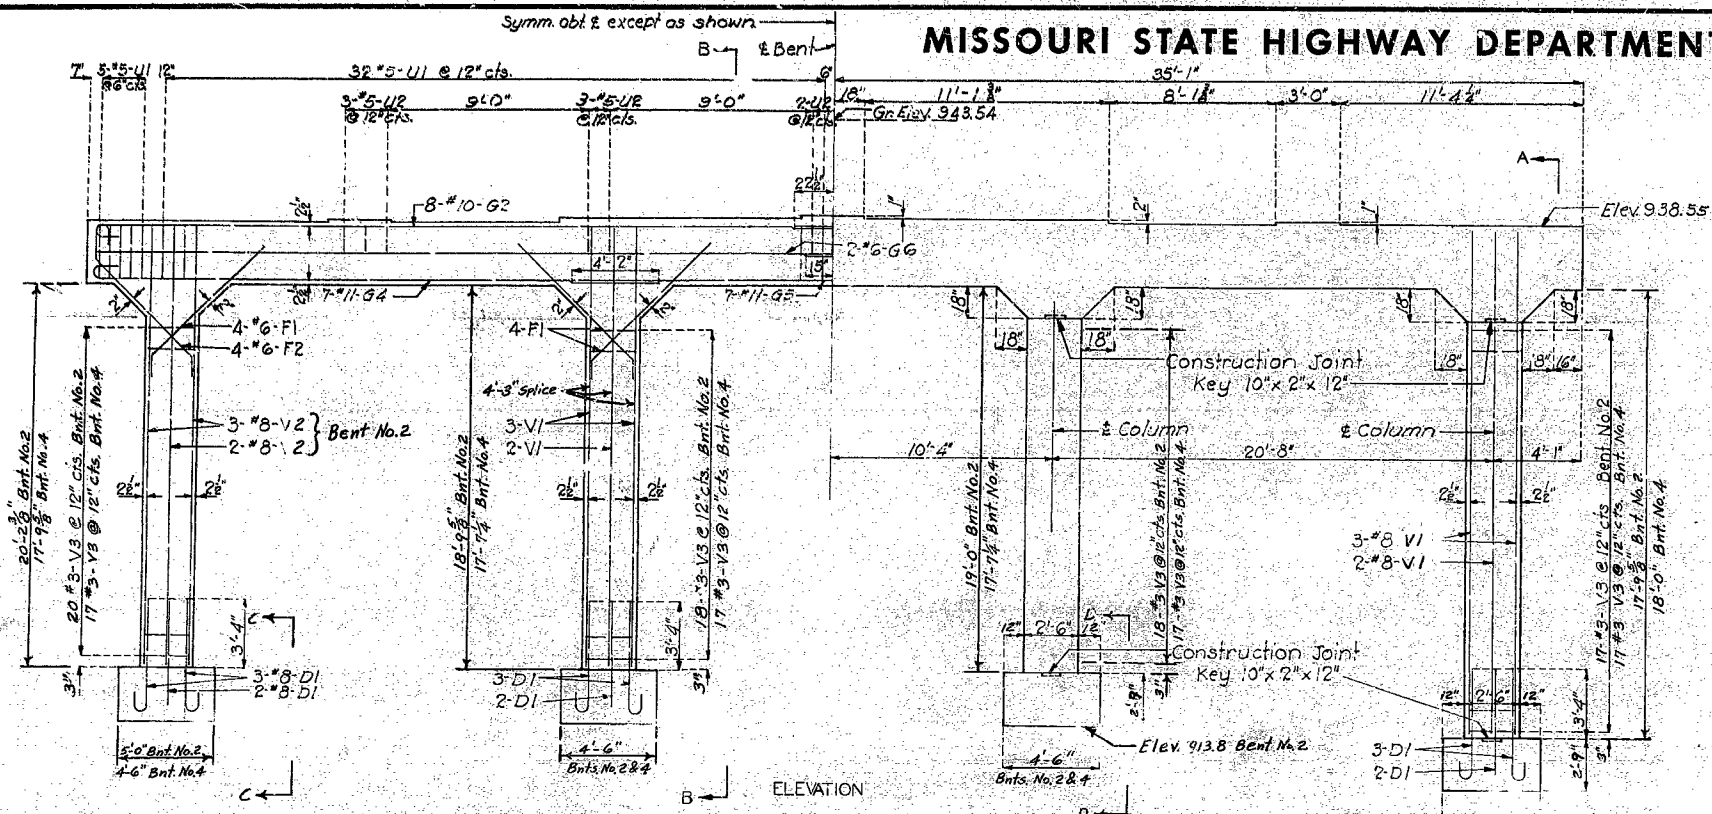

BRIDGE OVER RT. & LT. LANES (RT. 69)

STATE ROAD FROM ANTIOCH ROAD IN NORTH KANSAS CITY, MO.

ABOUT 4.5 MILES N.E. OF NORTH KANSAS CITY

PROJECT NO. UI-99(7) RT. 69 STA. 4+04.77

CLAY

COUNTY

FINISHED

Drawn AUG. 1954 by K.R.W.
Checked Sept. 1954 by C.S.A.

Note: This drawing is not to scale. Follow dimensions.

Sheet No. 5A of 5 FINISHED

FINISHED

-655

FINAL PLANS

-655

FED. ROAD DIST. NO.	STATE	FED. AID PROJ. NO.	FISCAL YEAR	SHEET NO.	TOTAL SHEETS
5	MO.	L.I.-99(7) (R. 69)	19		

Technical drawing of a bridge structure, showing two cross-sections (A and B) and an elevation view.

Cross-Section A:

- Width: 17'-0 ³/₄"
- Top reinforcement: 5"-U1 @ 12" c/c/s
- Bottom reinforcement: 3"-B-V4 + 5'-0" splice, 2"-B-V4 + 5'-0" splice
- Vertical dimensions: 16'-3-V3 @ 12" c/c/s, 3'-4", 6"
- Reinforcement bars: 4"-G-F1, 4"-G-F2, 3"-D2, 2"-D2
- Elevation: Elev. 917.0


Cross-Section B:

- Width: 35'-1"
- Top reinforcement: 3"-U1 @ 12" c/c/s
- Bottom reinforcement: 3"-B-V4 + 5'-0" splice, 2"-B-V4 + 5'-0" splice
- Vertical dimensions: 16'-3-V3 @ 12" c/c/s, 3'-4", 6"
- Reinforcement bars: 4"-G-F1, 4"-G-F2, 3"-D2, 2"-D2
- Elevation: Elev. 917.0


Elevation View:

- Centerline Elevation: Gr Elev. 943.63
- Bottom Elevation: Elev. 938.62
- Width: 10'-4"
- Construction Joint Key: 10"x2"x12"
- Columns: 4"-3" splice on all #8 V4 Rt. Col.
- Reinforcement bars: 4"-G-F1, 4"-G-F2, 3"-D2, 2"-D2


ELEVATION

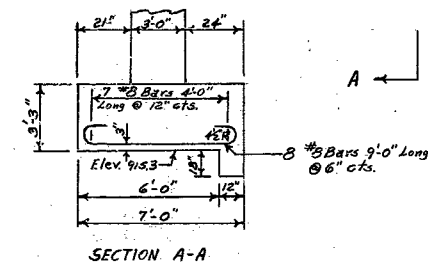


SECTION A-A

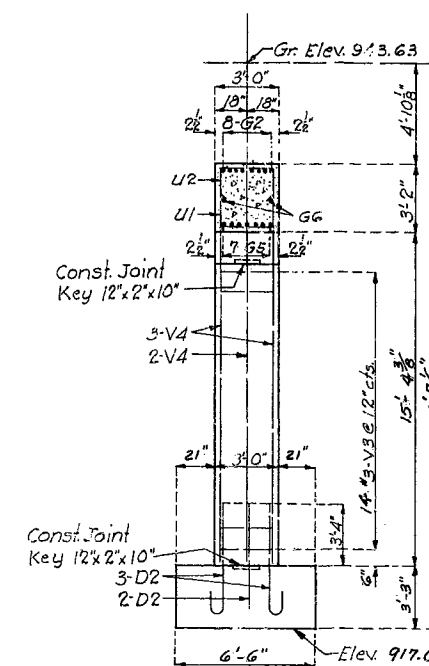

SECTION C-C

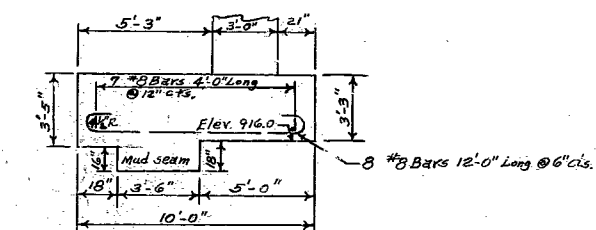

SECTION B-B

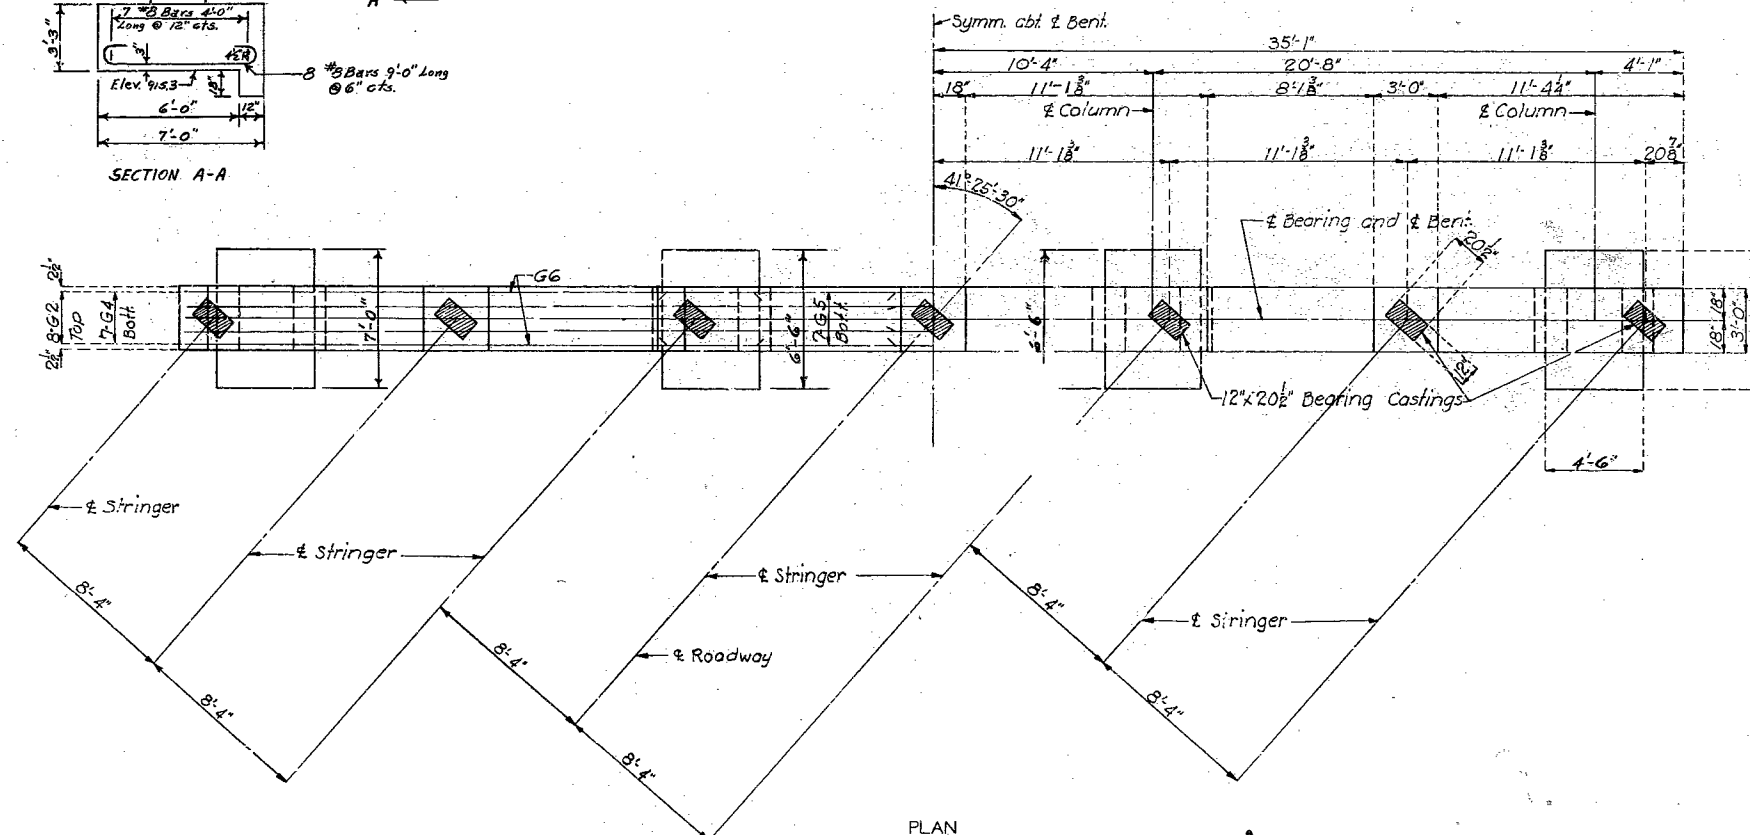

PLAN

DETAILS OF INTERMEDIATE BENT NO. 3

Drawn AUG. 1954 by K.R.W.
Checked Sept. 1954 by C.S.A.

Note: This drawing is not to scale. Follow dimensions.

Sheet No. 6A of 5.

BRIDGE OVER RT. & LT. LANES (RT.69)
STATE ROAD FROM ANTIOCH RD IN NORTH KANSAS CITY NE.
ABOUT 4.5 MILES N.E. OF NORTH KANSAS CITY
PROJECT NO. U.I.-99(7) (RT.69) **STA.** 4+04.77

CLAY

COUNTY

FINISHED

FINAL PLANS

L-655

MISSOURI STATE HIGHWAY DEPARTMENT

FED. ROAD DIST. NO.	STATE	FED. AID PROJ. NO.	FISCAL YEAR	SHEET NO.	TOTAL SHEETS
5	MO.		8	8	

GENERAL NOTES:

Design Specifications: A.A.S.H.T.O. - 1973
 Design Loading: H20-44 No Future Wearing Surface
 Design Unit Stress:
 Class B1 concrete (Superstructure) $f_c = 1600$ psi
 Reinforcing Steel $f_s = 20,000$ psi
 Structural Carbon Steel $f_s = 20,000$ psi

Paint: System A or B by contractor in accordance with Std Spec. 712.12 or 712.13 as applicable. Color of final coat shall be aluminum.

Field connections, High Strength Bolts $\frac{3}{4}$ " ϕ , holes $\frac{13}{16}$ " ϕ except as noted.
 Minimum clearance to reinforcing steel shall be $\frac{1}{2}$ " unless otherwise shown.

All concrete and reinforcement is included with superstructure quantities.

Light dotted lines indicate old work. Heavy lines indicate new work.

A min. vertical clearance of 14'-0" and a min. lateral clearance of 28'-0" centered on existing roadway, shall be maintained for both right and left lanes of I-35.



Contractor shall verify all dimensions in field before ordering new steel.

Bars bonded in old concrete not removed shall be cleanly stripped and bent into new concrete where possible. If length is available, old bars shall extend into new concrete at least 40 diameters for smooth bars and 30 diameters for deformed bars.

Remove existing concrete as shown on sheet No. 3 and see Special Provisions

Fill Face of End Bent

P.I. Sta. 5+35.30
 Elev. 944.25
 +0.5%
 -0.5%
 700' V.C.
 58'-70'-70'-58' Cont. Comp. I-Bm Spans

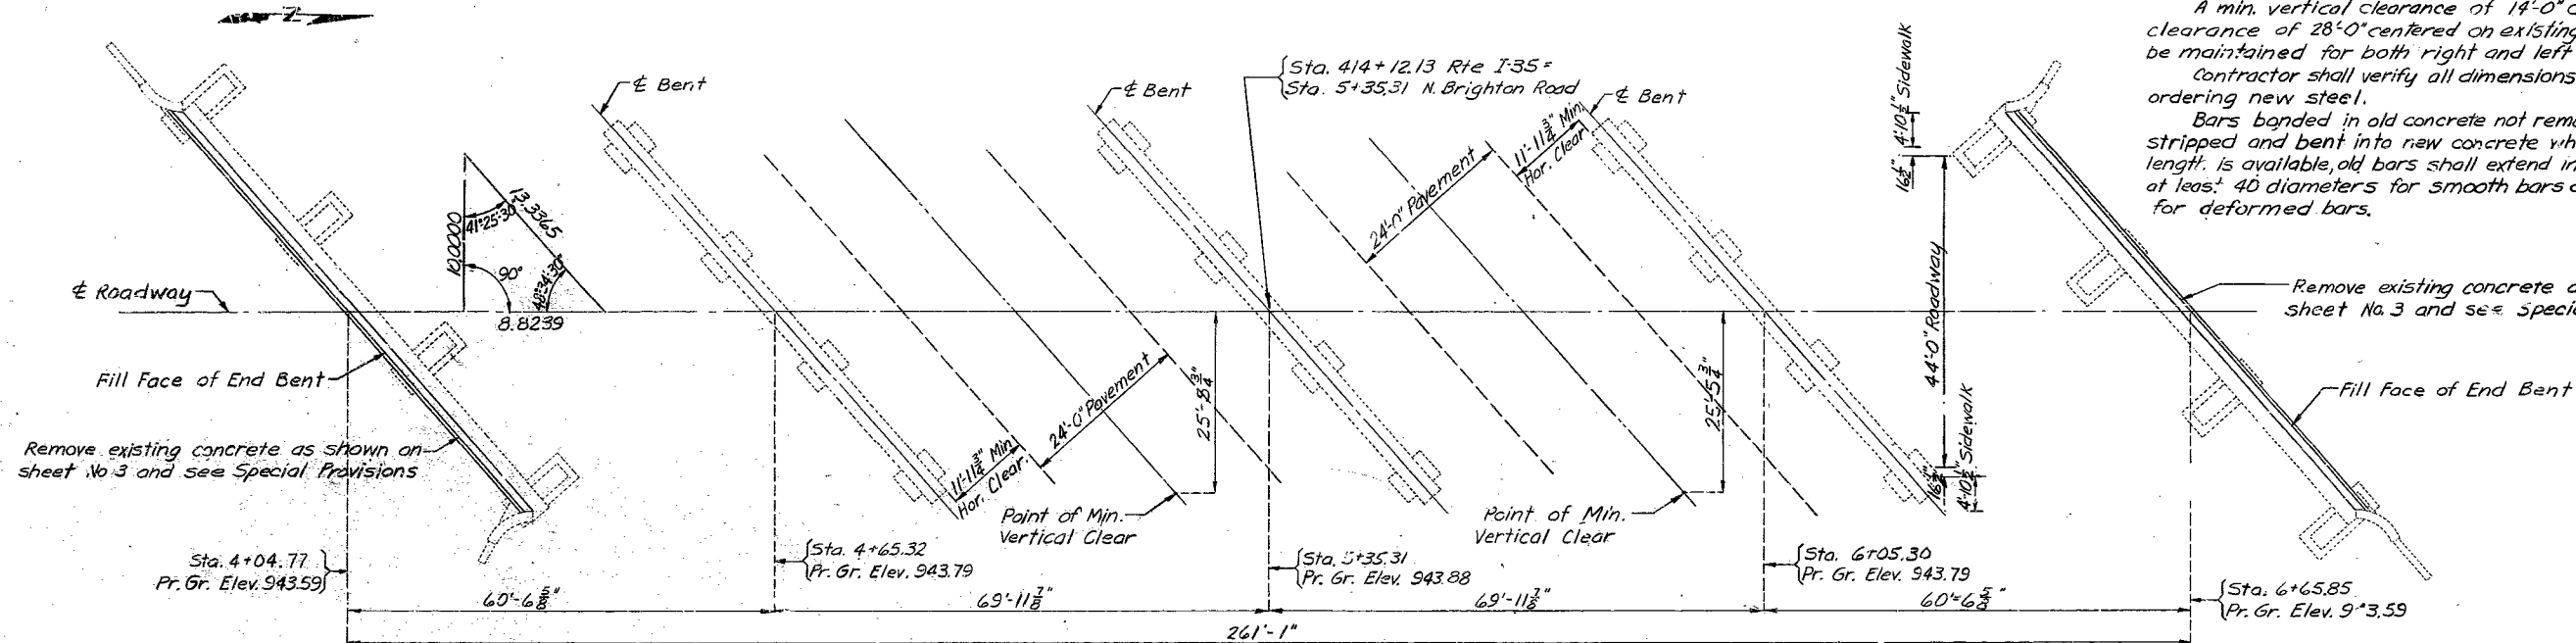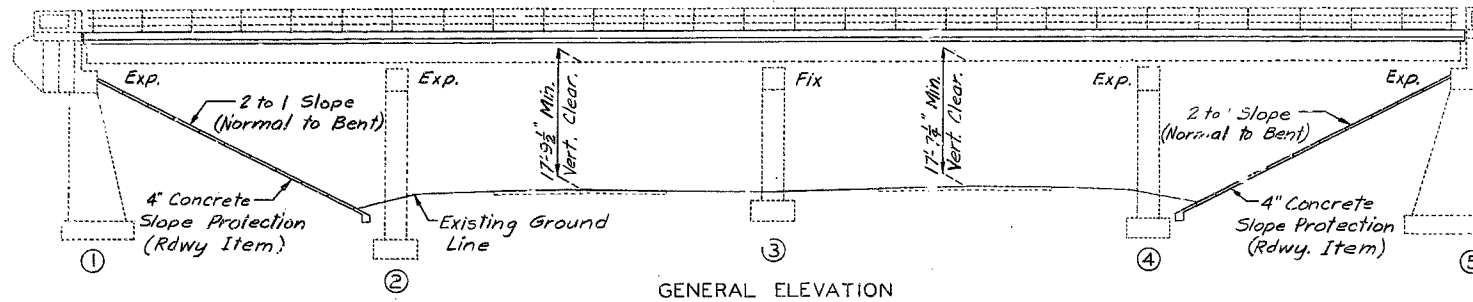

ESTIMATED QUANTITIES

ITEM		TOTAL
Removal of Existing Bridge Deck	Sq. ft.	14,989
Asphalt Cement (Asphaltic Concrete)	Ton	7.9
Mineral Aggregate (Asph. Conc.) (Special Mix)	Ton	148
Class B1 concrete	Cu. yd.	455.2
Steel Reinf. Elastomeric Expansion Jt. Seal (20") Lin. ft.		118
Preformed Compression Exp. Jt. Seal (30 in.) Lin. ft.		26
Reinforcing Steel	Lb.	125110
Conduit System on Structure	Lump Sum	1
Bridge Deck Waterproofing (Liquid)	Sq. yd.	1282
Fabricated Structural Carbon Steel	Lb.	7800
Painting (System A or B) Aluminum	Lump Sum	1
Handrail Replacement	Lump Sum	1
Cleaning Existing Bearings	Each	35
Special Work	Lump Sum	1

Concrete for backwall repair at Bents 1 & 5 is included in the quantities for Class B1 concrete. The Contractor will be permitted to furnish Class B or B1 concrete for end bent repair.

Note: This drawing is not to scale. Follow dimensions.

B.M. ELEV. 943.79 CHISELED \square ON TOP RT. WINGWALL BENT #1
 TAKEN FROM FINAL BR. PLANS DATED 1954.

BRIDGE: NORTH BRIGHTON ROAD UNDERPASS

STATE ROAD: INTERSTATE ROUTE 35

IN KANSAS CITY

PROJECT NO. I-35-1(104)

STA. 414+12.13

JOB NO. 4-I-35-72

RT. I-35

CLAY

COUNTY

DATE 11/3/76

STD. 611.60
STD. 706.30
L-655 R

Sheet No. 1 of 10.


DESIGNED FEB 1975
 DETAILED APR 1975
 CHECKED JUNE 1975

Roll 885


153

MISSOURI STATE HIGHWAY DEPARTMENT



FED. ROAD DIST. NO.	STATE	FED. AID PROJ. NO.	FISCAL YEAR	SHEET NO.	TOTAL SHEETS
3	MO.		15	9	

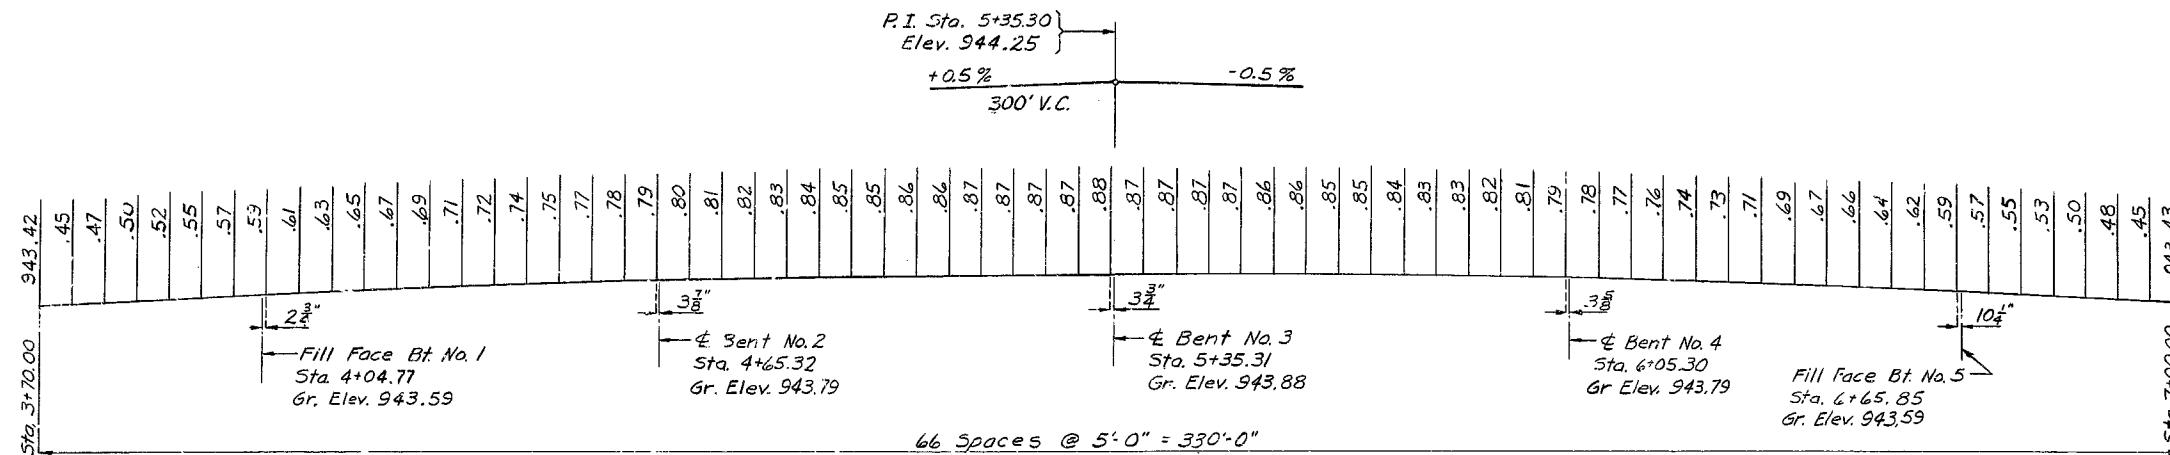


PROFILE GRADE ELEVATIONS

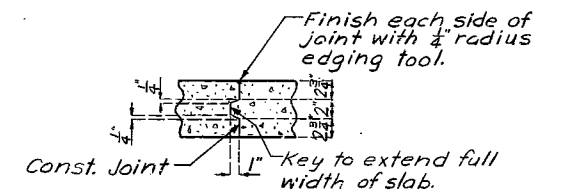

SECTION A-A

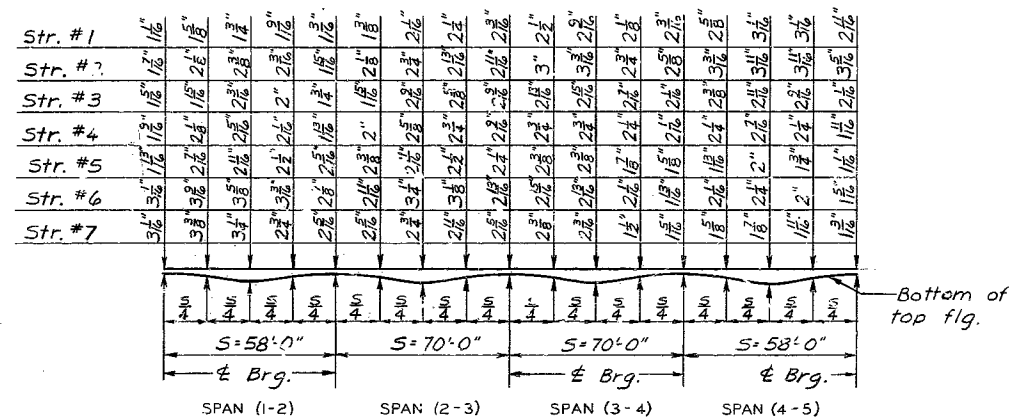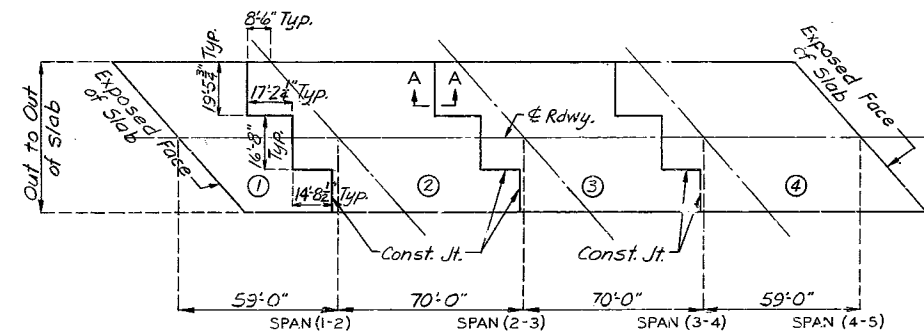

THEORETICAL SLAB HAUNCHING DIAGRAM

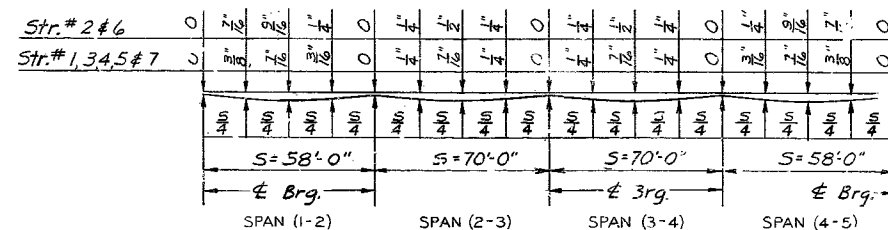

DEAD LOAD DEFLECTION

Note: 13% of dead load deflection due to weight of structural steel


	SEQUENCE OF POURS			
	DIRECTION			
BASIC SEQUENCE	1	2	3	4
END TO 2	1 TO 3	2 TO 4	3 TO END	
ALTERNATE "A" POURS	1 + 2	3	4	
END TO 3	2 TO 4	3 TO END		
ALTERNATE "B" POURS	1 + 2	3 + 4		
END TO 3	2 TO END			
ALTERNATE "C" POURS	1 + 2 + 3 + 4			
END TO END				

Note: The contractor shall pour and satisfactorily finish the slab pours at a rate of not less than 50 cubic yards per hour unless he elects to use an approved retarder to retard the set of the concrete to 2.5 hours in which case he may reduce his pouring and finishing rate to not less than 31 cubic yards per hour.

SLAB POURING SEQUENCE

MISSOURI STATE HIGHWAY DEPARTMENT


FED. ROAD DIST. NO.	STATE	FED. AID PROJ. NO.	FISCAL YEAR	SHEET NO.	TOTAL SHEETS
5	MO.		19	11	

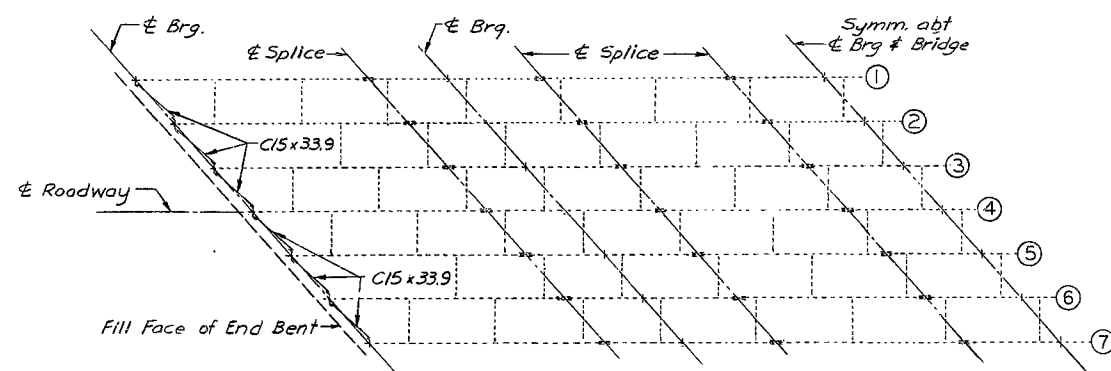

SPAN (1-2) & (5-4)



SPAN (2-3) & (4-3)

PLAN OF STRUCTURAL STEEL
SHOWING GDR. NUMBERING

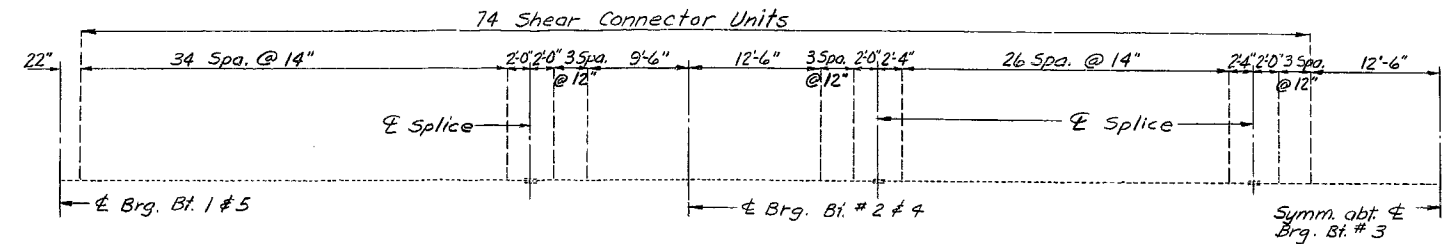


PLAN OF SHEAR CONNECTOR SPACING
TYP. ALL GIRDERS


Note: Weight of 1,560 lbs for
Shear Connectors is included
in the weight of fabricated
structural carbon steel.

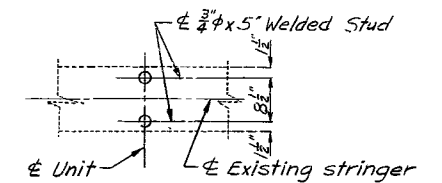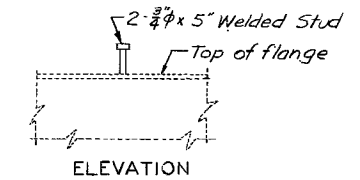


PLAN OF STUD CONN.
DETAIL OF SHEAR CONNECTORS

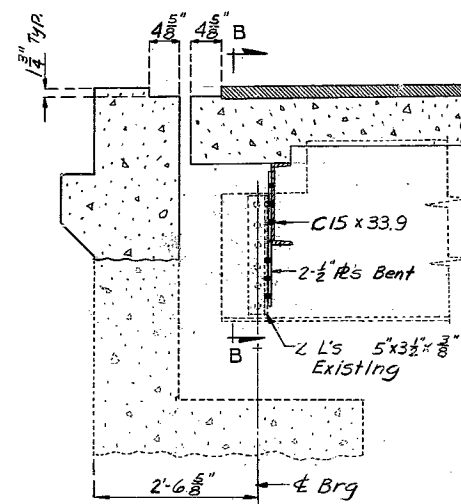

LONGITUDINAL SECTION NEAR
END BENT

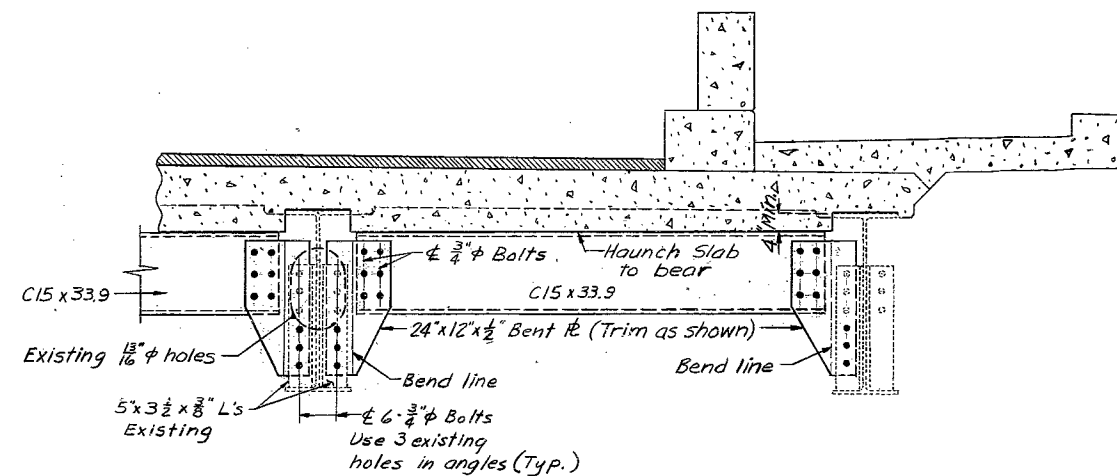

PART SECTION B-B
SHOWING END DIAPHRAGM

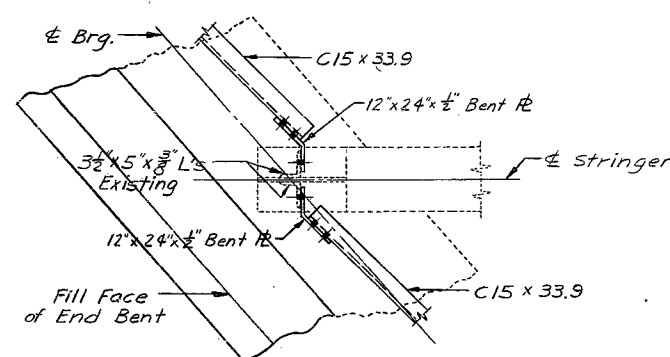


PLAN OF END DIAPHRAGM
CONNECTION PLATE

156

150

STD. 5.7.2	REVISED
DEC. 1974	JAN. 1976

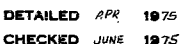

Sheet No. 5 of 10

CLAY COUNTY

DETAILS OF STEEL REINFORCED ELASTOMERIC EXPANSION JOINT SEAL AT BENTS NO. 1 & 5

L-655 R

ROADWAY ANGLE NOTES:



PAYMENT FOR FURNISHING, PAINTING AND PLACING STRUCTURAL STEEL FOR ROADWAY ANGLES SHALL BE INCLUDED IN UNIT PRICE BID FOR OTHER ITEMS.

TIGHTEN ALL NUTS TO 40 FOOT POUNDS. RETIGHTEN TO 40 FOOT POUNDS A MINIMUM OF 30 MINUTES AFTER INITIAL TIGHTENING.


ROADWAY ANGLE NOTES:

PAYMENT FOR FURNISHING, PAINTING AND PLACING STRUCTURAL STEEL FOR ROADWAY ANGLES SHALL BE INCLUDED IN UNIT PRICE BID FOR OTHER ITEMS.



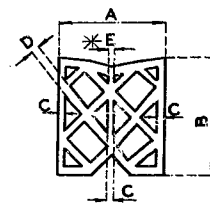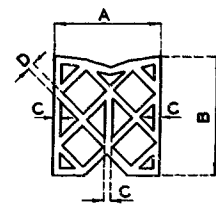

*Optional E or C

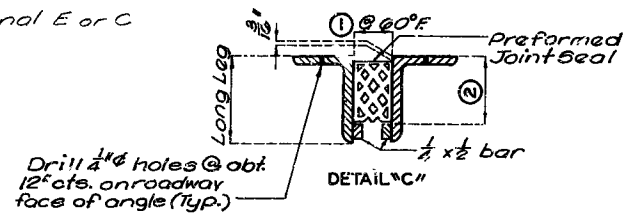

MISSOURI STATE HIGHWAY DEPARTMENT

FED. ROAD DIST. NO.	STATE	FED. AID PROJ. NO.	FISCAL YEAR	SHEET NO.	TOTAL SHEETS
5	MO.		19	13	

GENERAL NOTES:

Structural Steel for Expansion Device shall be fabricated in one section except that when the length is over 50 feet, splicing is permissible. The expansion device shall be bent to conform to crown and grade of roadway. No. 5 bars for expansion device shall be structural grade. Approved stud welded anchors or deformed bar anchors (ASTM A496) may be used in lieu of #5 bars shown. Preformed Compression Joint Seal shall be installed before curbs are poured. 3/8" Curb plate shall be installed with curb. Plan dimensions are based on installation at 60°F. Expansion joint width shall be adjusted during installation for compliance with tables. See Special Provisions for the requirements of Compression Joint Seal.

TYPE	"A" (WIDTH)	"B" (HEIGHT)	"C" (SHELL)		"D" (WEBS)	"E"(B3 ONLY) (SMALL WEBS)
AI OR B3	2.500 +.250 -.000	2.750 +.125 -.125	0.187 +.046 -.015		0.093 +.031 -.015	0.062 +.051 -.031
AI OR B3	3.000 +.250 -.000	3.406 +.187 -.187	0.187 +.046 -.015		0.125 +.046 -.015	0.075 +.046 -.031
AI OR B3	3.500 +.250 -.000	3.500 +.187 -.187	0.187 +.046 -.015		0.125 +.046 -.015	0.097 +.046 -.031
AI OR B3	4.000 +.312 -.000	4.718 +.250 -.250	AI 4.250 +.046 -.031	B3 4.250 +.046 -.031	0.187 +.046 -.015	0.111 +.046 -.031




TEMP (°F.)	SEAL WIDTHS							
	CONCRETE STRUCTURES				STEEL STRUCTURES			
	2½"	3"	3½"	4"	2½"	3"	3½"	4"
-10°	-	-	-	-	2½"	2¾"	3"	3¾"
0°	2½"	2¾"	3"	3¾"	2"	2½"	2¾"	3½"
+20°	1¾"	2¼"	2¾"	3½"	1¾"	2¼"	2¾"	3"
+40°	1¾"	2½"	2½"	2¾"	1¾"	2½"	2½"	2¾"
+60°	1¾"	1¾"	2¼"	2¾"	1¾"	1¾"	2¼"	2¾"
+80°	1¾"	1¾"	2"	2¼"	1¾"	1¾"	2"	2¼"
+100°	1¾"	1½"	1¾"	2"	1¾"	1¾"	1¾"	2½"
+110°	1¾"	1¾"	1¾"	1¾"	1¾"	1½"	1¾"	2"
+120°	-	-	-	-	1¾"	1¾"	1¾"	1¾"

TABLE OF TRANSVERSE SEALS & ARMOR ANGLES					
TYPE	GROOVE SIZE AT 60° F.		SEAL SIZE		ANGLE SIZE
	①	②	WIDTH	HEIGHT	
AI OR B3	$\frac{5}{16}"$	$4"$	$2\frac{1}{2}"$	$2\frac{3}{4}"$	$5 \times 3 \times \frac{3}{8}$
AI OR B3	$\frac{7}{16}"$	$4"$	$3"$	$3\frac{13}{32}"$	$5 \times 3\frac{1}{2} \times \frac{3}{8}$
AI OR B3	$2\frac{1}{8}"$	$5\frac{1}{8}"$	$3\frac{1}{2}"$	$3\frac{1}{2}"$	$6 \times 3\frac{1}{2} \times \frac{3}{8}$
AI OR B3	$2\frac{5}{8}"$	$6\frac{3}{8}"$	$4"$	$4\frac{23}{32}"$	$8 \times 4 \times \frac{7}{16}$

TABLE OF LONGITUDINAL SEALS				
TYPE	GROOVE SIZE AT 60°F.		SEAL SIZE	
	WIDTH	HEIGHT	WIDTH	HEIGHT
A1 OR B3	$\frac{5}{16}$ "	$\frac{3}{4}$ "	2"	$2\frac{1}{16}$ "

Armor angles for longitudinal seals will not be used unless specified.

TYPE	"A" (WIDTH)	"B" (HEIGHT)	"C" (SHELL)	"D" (WEARS)
AI OR B3	2.000 + .187 - .000	2.0625 + .125 - .125	0.125 + .030 - .015	0.094 + .030 - .015

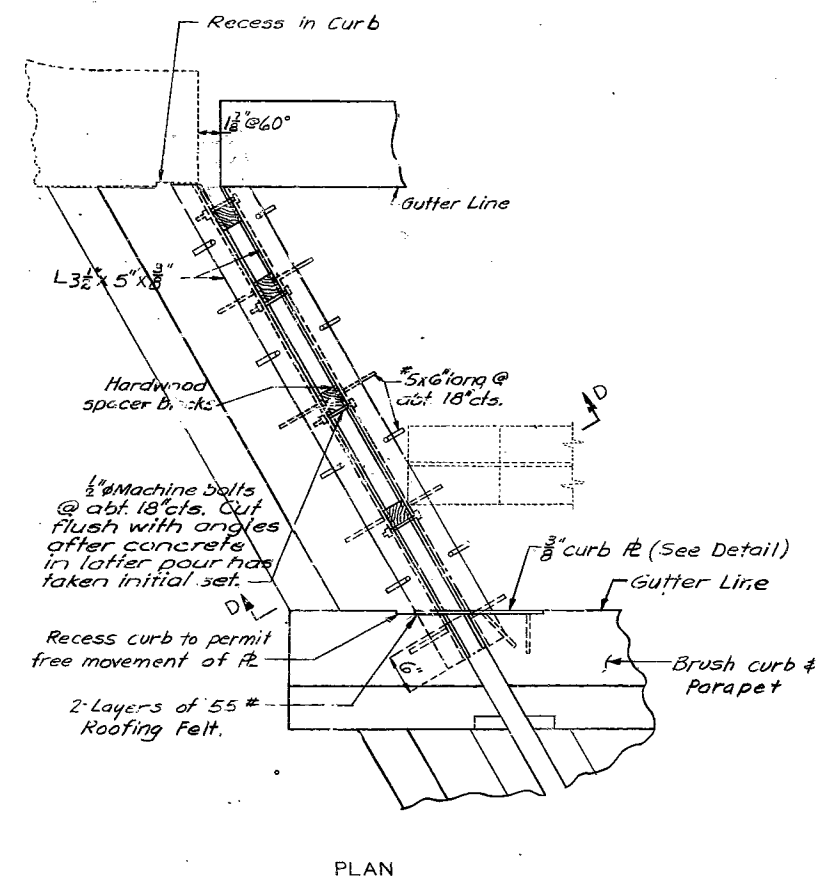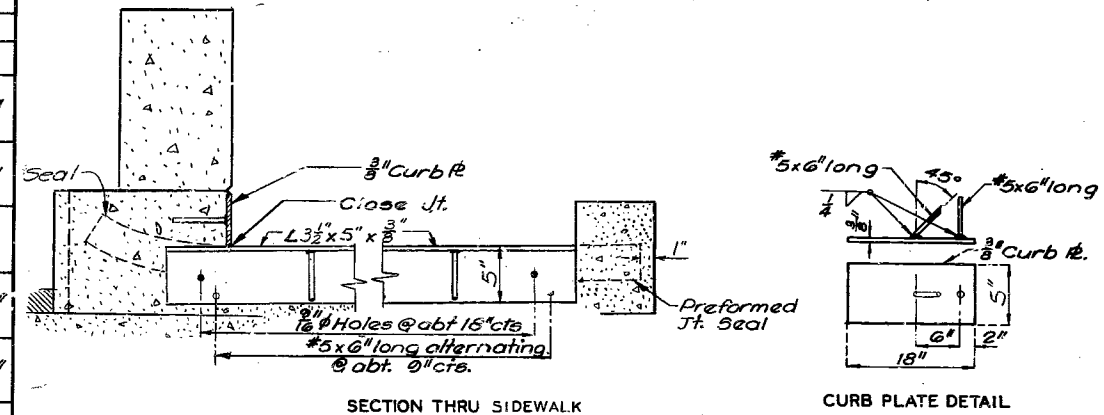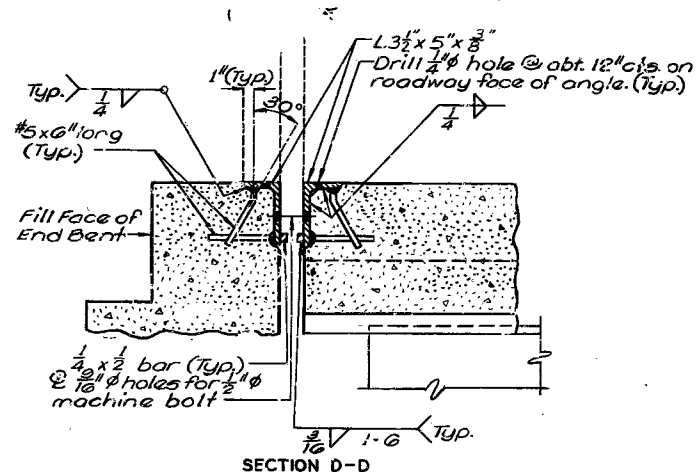

DETAILS OF EXPANSION DEVICE AT SIDEWALK

Note: This drawing is not to scale. Follow dimensions.

Sheet No. 6 of 10.

CLAY COUNTY


L-655 R

STD. PCJS	REVISED
OCT. 1973	FEB. 1975




DETAILED APR 1975
CHECKED JUNE 1975

MISSOURI STATE HIGHWAY DEPARTMENT

FED. ROAD DIST. NO.	STATE	FED. AID PROJ. NO.	FISCAL YEAR	SHEET NO.	TOTAL SHEETS
5	MO.		19	14	

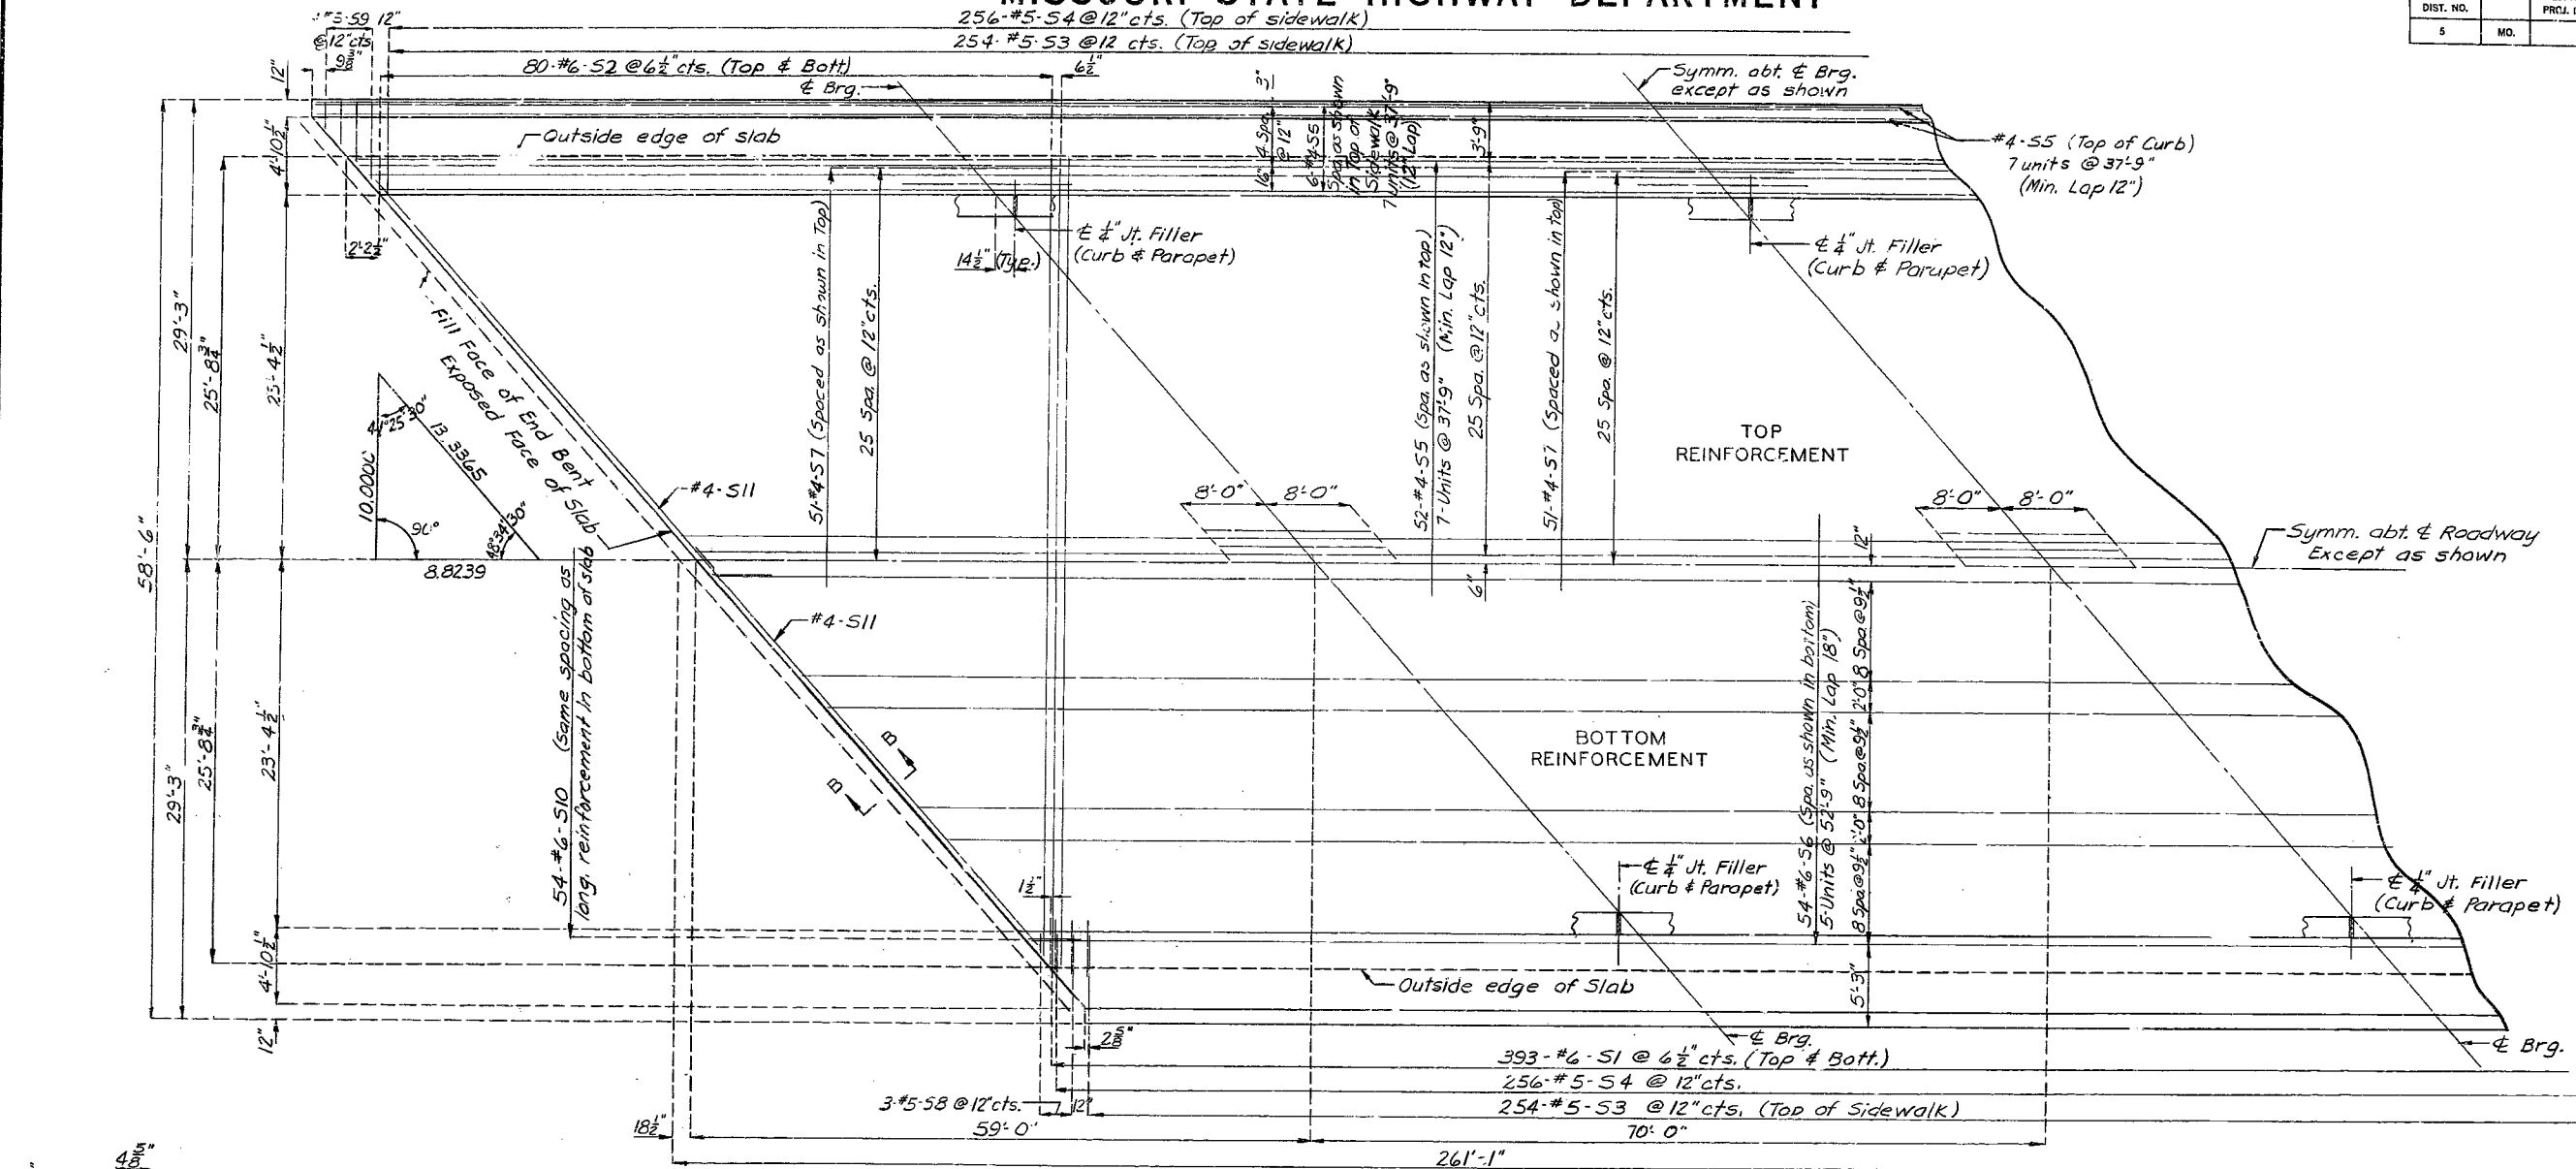

PLAN OF SLAB SHOWING REINFORCEMENT

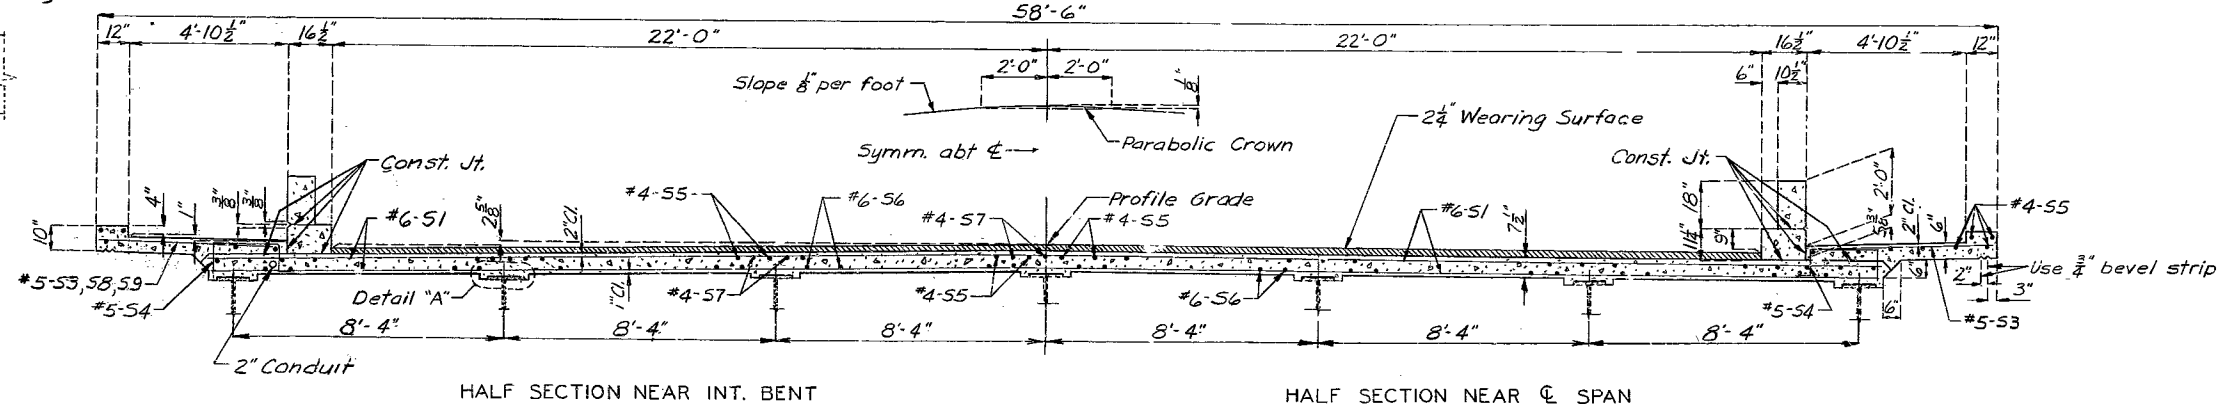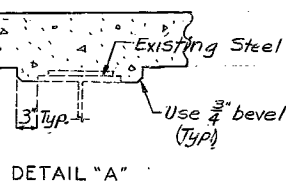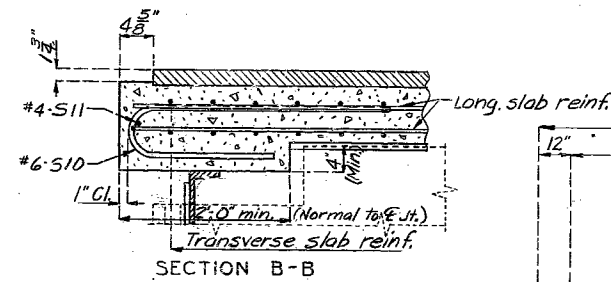

Note: This drawing is not to scale. Follow dimensions.

Sheet No. 7 of 10


CLAY COUNTY

L-655 R


DETAILED MAR 1975
CHECKED JUNE 1975

MISSOURI STATE HIGHWAY DEPARTMENT


FED. ROAD DIST. NO.	STATE	FED. AID PROJ. NO.	FISCAL YEAR	SHEET NO.	TOTAL SHEETS
5	MO.		19	15	

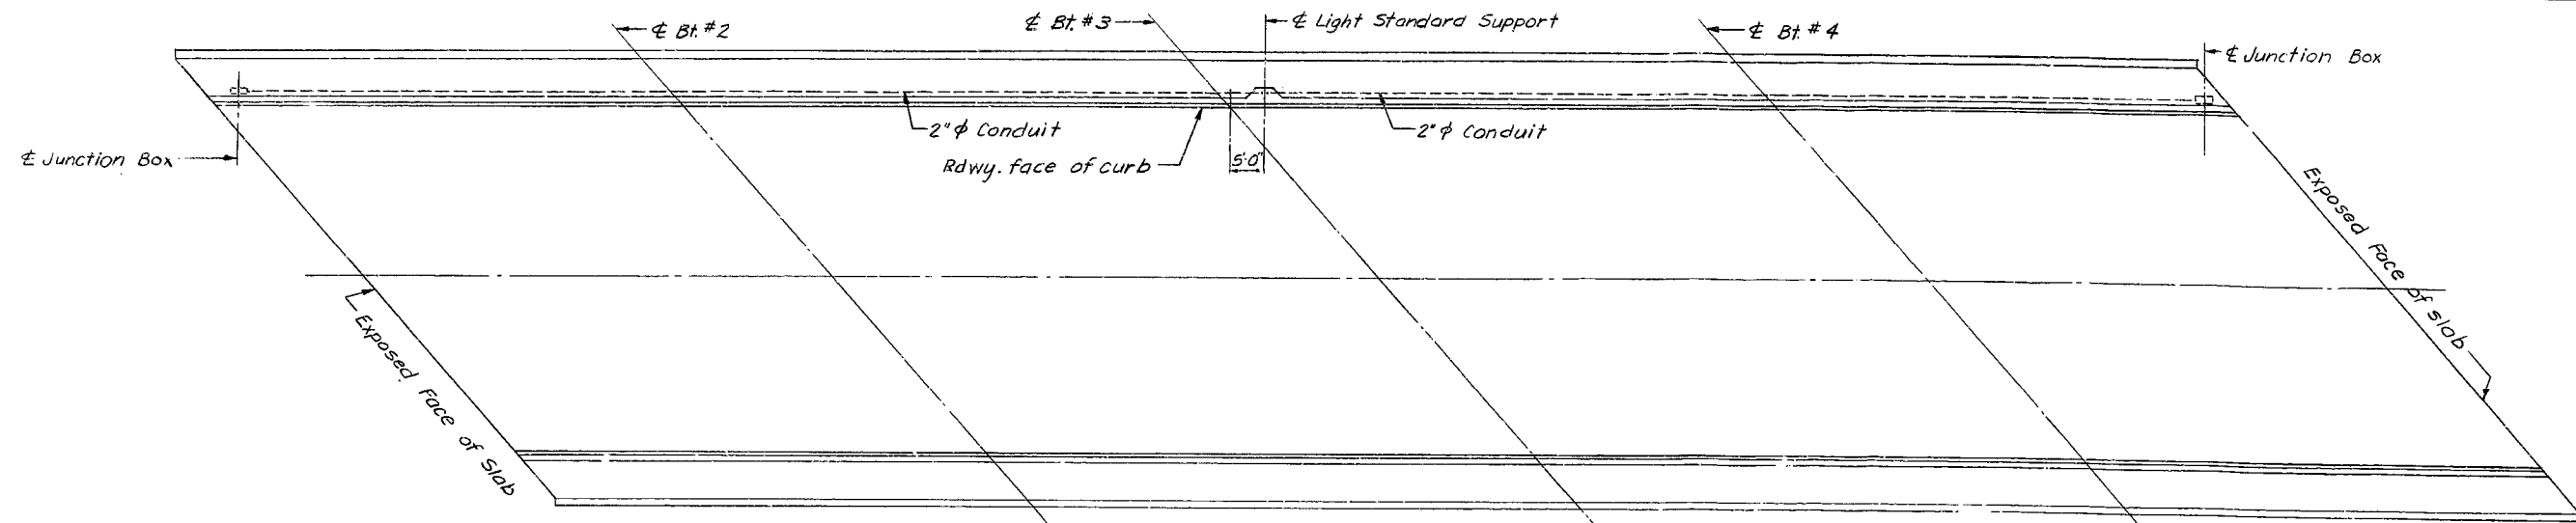

LIGHTING SYSTEM LOCATION DIAGRAM

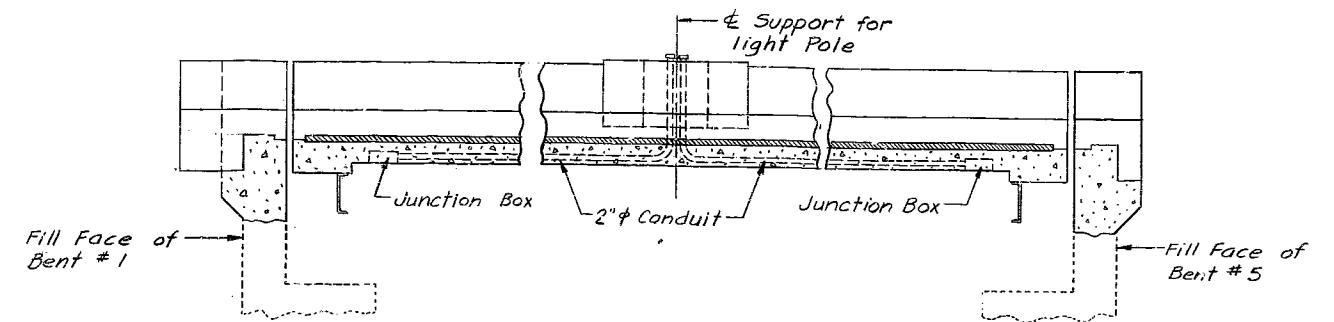


SECTION NEAR LEFT CURB AND PARAPET

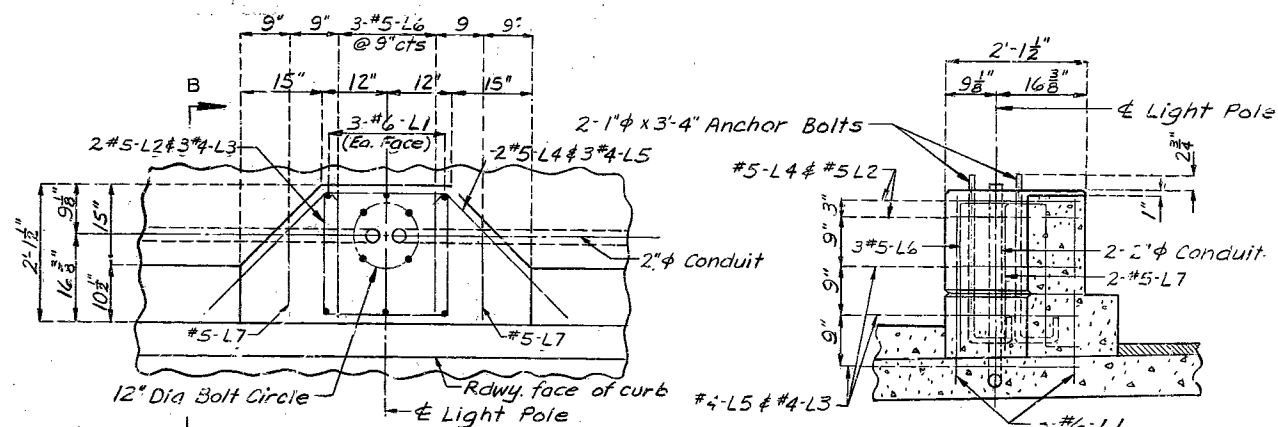

PLAN OF SUPPORT

SECTION B-B

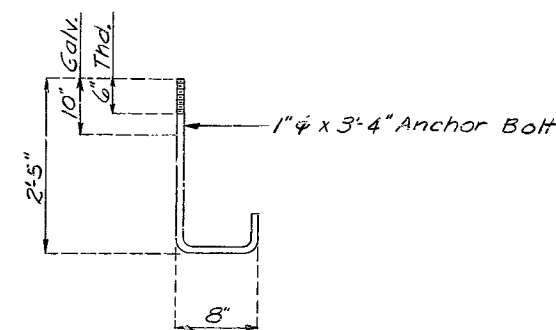

DETAIL OF ANCHOR BOLTS

Note: Cost of furnishing and placing anchor bolts for light standard shall be included in contract unit price bid for other items. All conduit to be rigid galvanized steel with 3" minimum cover in concrete. Shift reinforcing steel in field where necessary to clear conduit and junction boxes.

Light standard, wiring and fixtures to be furnished and installed by others. Top of light standard supports to be made horizontal, anchor bolts to be placed vertically. All junction boxes shall be 6"x6"x4" flush mounted and equal to O.Z. Elect. Mfg. Co. type "YU" and/or Spring City Elec Mfg. Co. type "IR". Wall thickness to be sufficient to provide 5 full threads for watertight conduit joint.

DETAILS OF CONDUIT SYSTEM

DETAILED APR. 1975
CHECKED AUG. 1975


Note: This drawing is not to scale. Follow dimensions.

Sheet No. 8 of 10



CLAY COUNTY

L-655 R

FED. ROAD DIST. NO.	STATE	FED. AID PROJ. NO.	FISCAL YEAR	SHEET NO.	TOTAL SHEETS
5	MO.		19	16	

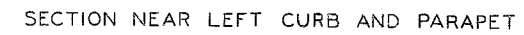


Note : All dimensions taken along top and at roadway face of curb.

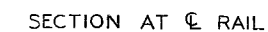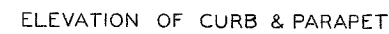

SECTION NEAR RAIL POST

DETAILS OF HANDRAIL ANCHOR BOLTS


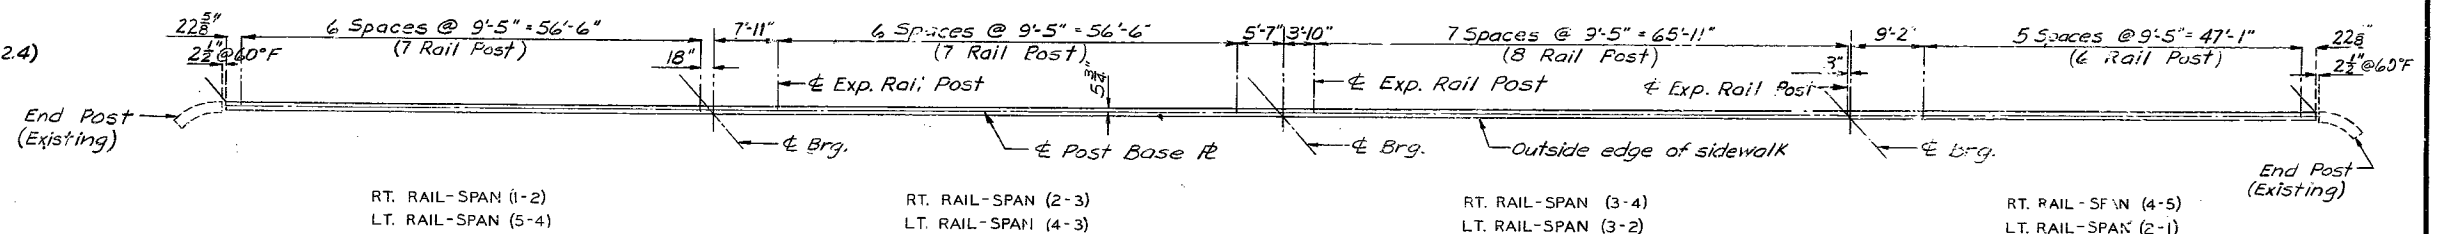


PLAN VIEW SHOWING LOCATION OF HANDRAIL POST


Note: For removal and replacement of existing handrail and posts, see Special Provisions.

FED. ROAD DIST. NO.	STATE	FED. AID PROJ. NO.	FISCAL YEAR	SHEET NO.	TOTAL SHEETS
5	MO.		19	17	

NO. REQD.	MARK NO.	LOCATION	GRADE (H)	SHAPE NO.	STIRRUP (S)	SUBSTR. (X)	VARIES (V)	NO. EACH	DIMENSIONS																NOMINAL LENGTH	ACTUAL LENGTH	WEIGHT
									B		C		D		E		F		H		K						
									FT.	IN.	FT.	IN.	FT.	IN.	FT.	IN.	FT.	IN.	FT.	IN.	FT.	IN.	FT.	IN.			
488	5C1	CURB		10					6.000	15.000	13.500								4 2	3 9	1909						
12	5C2	CURB-END BENTS		10						21.000	13.500								4 6	4 5	55						
4	5C3	CURB-END BENTS		10					6.000	15.000	19.000								4 7	4 3	18						
8	6C5	CURB		20					58 9.000										58 9	58 9	706						
16	6C6	CURB		20					35 8.000										35 8	35 8	857						
8	6H1	BACKWALL-END BTS		20					31 10.000										31 10	31 10	383						
8	6H2			20					8 1.000										8 1	8 1	97						
6	6L1	LIGHT PAD		20					2 10.000										2 10	2 10	26						
2	5L2	LIGHT PAD		31 S					22.500	22.750	22.500								6 8	6 5	13						
3	4L3	LIGHT PAD		31 S					22.500	22.750	22.500								6 5	6 3	13						
2	5L4	LIGHT PAD		15					2 7.875	22.750	2 7.875	22.500	22.500	22.500	22.500	22.500			7 3	7 2	15						
3	4L5	LIGHT PAD		15					2 7.875	22.750	2 7.875	22.500	22.500	22.500	22.500	22.500			7 3	7 2	14						
3	5L6	LIGHT PAD		10					6.000	2 3.375	22.500								6 11	6 7	21						
2	5L7	LIGHT PAD		10					6.000	2 3.375	15.750								6 5	6 0	13						
16	5R1	PARAPET		20					45 9.000										45 9	46 9	780						
16	5R2	PARAPET		20					45 9.000										45 9	45 9	763						
48	5R3	PARAPET		20					11 9.000										11 9	11 9	588						
512	5R4	PARAPET & CURB		19					2 2.625	7.000									2 10	2 8	1424						
512	5R5	PARAPET & CURB		12					2 2.625	7.000									3 5	3 3	1736						
28	5R6	PARAPET		19					19.000	1.000									2 2	2 1	61						
28	5R7	PARAPET		28						6.000	19.000	6.000							2 7	2 4	68						
4	5R8	PARAPET END BENT		19					2 2.625	11.000									3 2	3 0	13						
4	5R9	PARAPET END BENT		12					2 2.625	11.000									3 9	3 7	15						
786	6S1	SLAB		20					51 2.000										51 2	51 2	60406						
320	6S2	SLAB		20	V	4			2 2.000										2 2	2 2							
		INCR = 7.375 IN							50 5.625										50 6	50 6	12657						
508	5S3	SIDEWALK		20					5 7.000										5 7	5 7	2958						
512	5S4	SIDEWALK		10			</																				

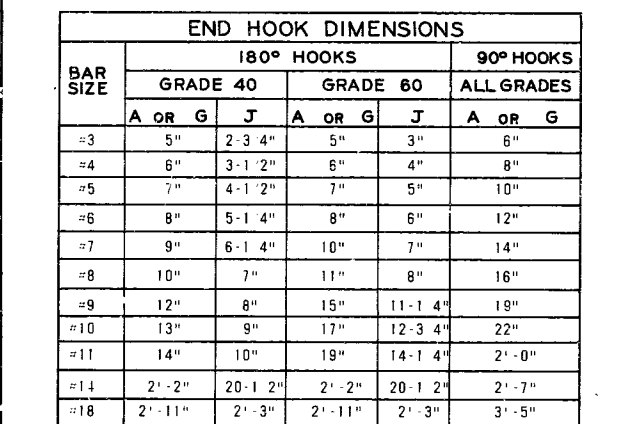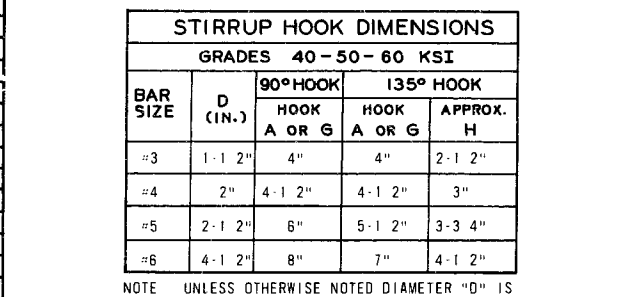


BENDING DIAGRAMS

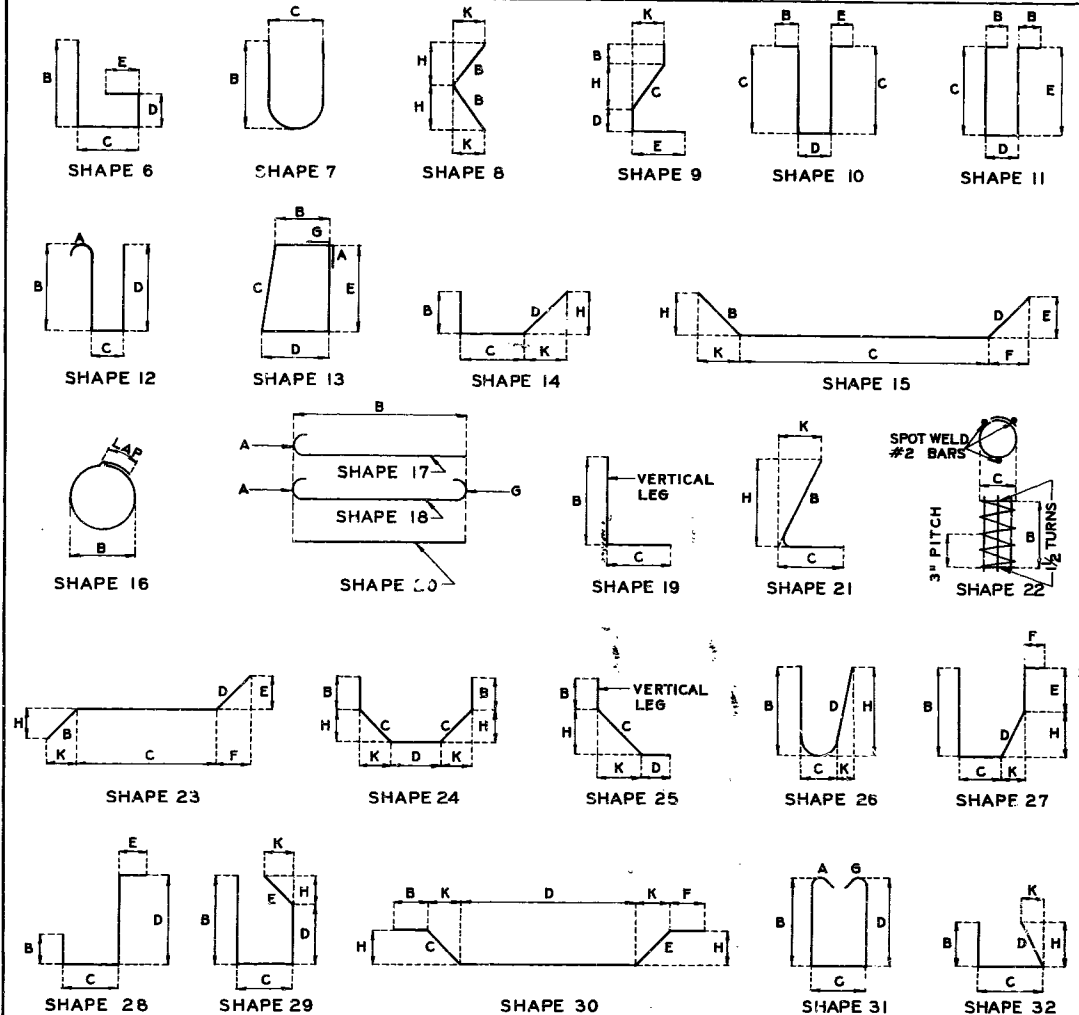


L-655 R

MISSOURI STATE HIGHWAY DEPARTMENT

FED. ROAD DIST. NO.	STATE	FED. AID PROJ. NO.	FISCAL YEAR	SHEET NO.	TOTAL SHEETS
5	MO.		19	8	

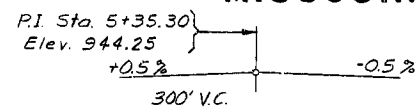

58'-70'-70'-58' Cont. Comp. 1-Bm Spans

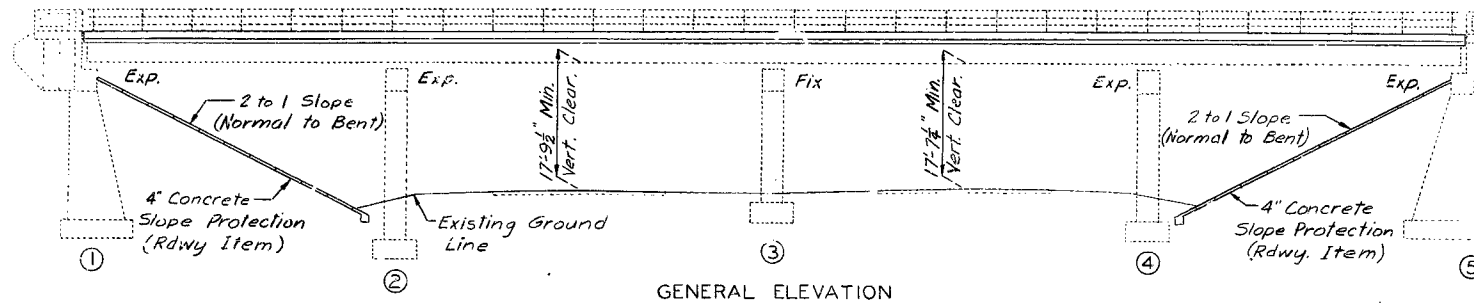

GENERAL NOTES:


Design Specifications: A.A.S.H.T.O. - 1973
Design Loading: H20-44 No Future Wearing Surface
Design Unit Stress:
Class B1 concrete (Superstructure) $f_c = 1600$ psi
Reinforcing Steel $f_s = 20,000$ psi
Structural Carbon Steel $f_s = 20,000$ psi

Paint: System A or B by contractor in accordance with Std Spec. 712.12 or 712.13 as applicable. Color of final coat shall be aluminum.

Field connections, High Strength Bolts $\frac{3}{4}$ " ϕ , holes $\frac{13}{16}$ " ϕ except as noted.
Minimum clearance to reinforcing steel shall be $\frac{1}{2}$ " unless otherwise shown.
All concrete and reinforcement is included with superstructure quantities.
Light dotted lines indicate old work. Heavy lines indicate new work.

A min. vertical clearance of 14'-0" and a min. lateral clearance of 28'-0" centered on existing roadway, shall be maintained for both right and left lanes of I-35.
Contractor shall verify all dimensions in field before ordering new steel.

Bars banded in old concrete not removed shall be cleanly stripped and bent into new concrete where possible. If length is available, old bars shall extend into new concrete at least 40 diameters for smooth bars and 30 diameters for deformed bars.

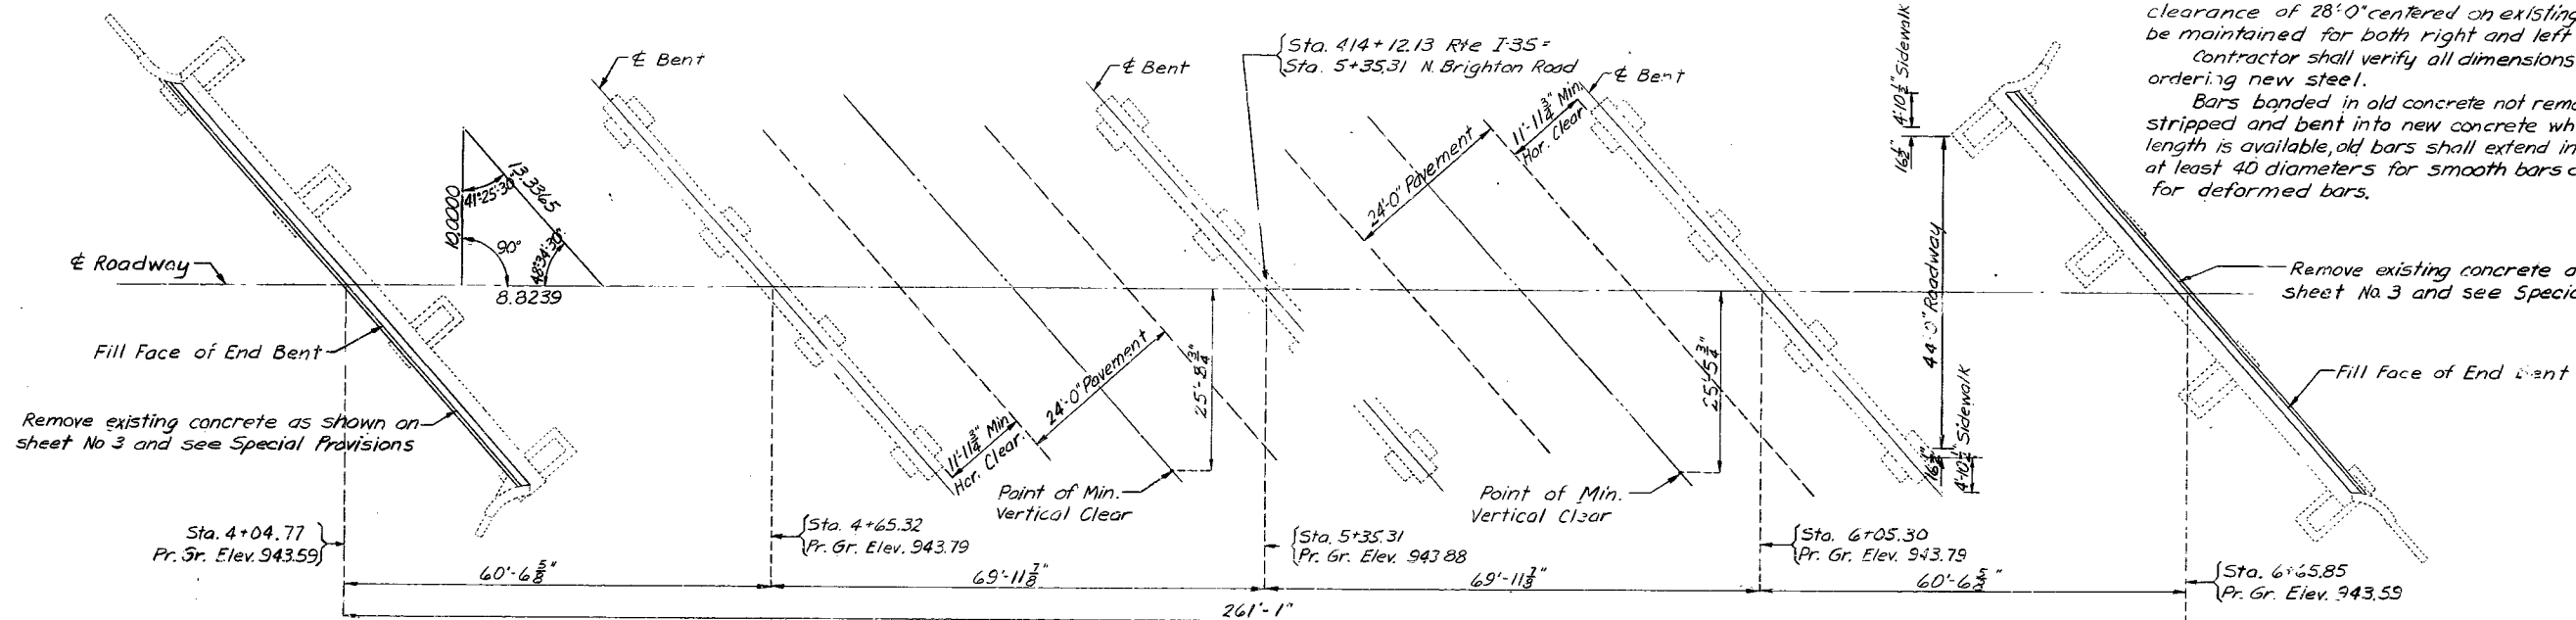

ESTIMATED QUANTITIES

ITEM	TOTAL
Removal of Existing Bridge Deck	Sq. ft. 14,989
Asphalt Cement (Asphaltic Concrete)	Ton 7.7
Mineral Aggregate (Asph. Conc.) (Special Mix)	Ton 153
Class B1 concrete	Cu. yd. 455.2
Steel Reinf. Elastomeric Expansion Jt. Seal (20") Lin. ft.	118
Preformed Compression Exp. Jt. Seal (3.0 in.) Lin. ft.	26
Reinforcing Steel	Lb. 125,110
Conduit System on Structure	Lump Sum 1
Bridge Deck Waterproofing (Liquid)	Sq. yd. 1282
Fabricated Structural Carbon Steel	Lb. 7920
Painting (System A or B) Aluminum	Lump Sum 1
Handrail Replacement	Lump Sum 1
Cleaning Existing Bearings	Each 35
Special Work	Lump Sum 1

Concrete for backwall repair at Bents 1 & 5 is included in the quantities for Class B1 concrete. The Contractor will be permitted to furnish Class B or B1 concrete for end bent repair.

Notes: This drawing is not to scale. Follow dimensions.

B.M. ELEV. 943.79 CHISELED \square ON TOP RT. WINGWALL BENT #1
TAKEN FROM FINAL BR. PLANS DATED 1954.

BRIDGE: NORTH BRIGHTON ROAD UNDERPASS

STATE ROAD: INTERSTATE ROUTE 35

IN KANSAS CITY

PROJECT NO. I-35-1(104)

STA. 414+12.13

JOB NO. 4-I-35-72

RTE. I-35

CLAY

COUNTY

DATE 11/3/76

STD. 611.60

STD. 706.30

L-655 R

DESIGNED FEB 1975

DETAILED APR 1975

CHECKED JUNE 1975

Sheet No. 1A of 10.

General Notes:

Design Specifications:
2002 - AASHTO LFD (17th Edition) Standard Specifications
Seismic Performance Category A

Design Loading:
HS20-44 (New Construction)
35#/sq. ft. Future Wearing Surface (New Construction)
Earth - 120 #/Cu. Ft., Equivalent Fluid Pressure 45#/Cu. Ft.
Fatigue Stress - Case III

Design Unit Stresses:
Class B-1 Concrete (Safety Barrier Curb) f'c = 4,000 psi
Class B-2 Concrete (End Bents & Superstructure, except Safety Barrier Curb) f'c = 4,000 psi
Reinforcing Steel (Grade 60) fy = 60,000 psi

Joint Filler:
All joint filler shall be in accordance with Sec 1057 for preformed sponge rubber expansion and partition joint filler, except as noted.

Reinforcing Steel:
Minimum clearance to reinforcing steel shall be 1 1/2", unless otherwise shown.

Miscellaneous:
Protective coating for concrete bents and piers (Epoxy) shall be applied as shown on the bridge plans and in accordance with Sec 711.

Bars bonded in old concrete not removed shall be cleanly stripped and embedded into new concrete where possible. If length is available, old bars shall extend into new concrete at least 40 diameters for smooth bars and 30 diameters for deformed bars, unless otherwise noted.

Roadway surfacing adjacent to bridge ends shall match new bridge slab surface (Roadway Item).

Outline of old work is indicated by light dashed lines. Heavy lines indicate new work.

Contractor shall verify all dimensions in field before ordering new material.

The area exposed by the removal of concrete and not covered with new concrete shall be coated with an approved qualified special mortar in accordance with Sec 704.

Traffic Handling:
Structure to be closed during construction.

Estimated Quantities		
Item		Total
* Removal of Existing Bridge Decks	sq. foot	15,273
	linear foot	544
	sq. yard	1,697
* Safety Barrier Curb	linear foot	526
Substructure Repair (Formed)	sq. foot	560
Conduit System on Structure	lump sum	1
Protective Coating - Concrete Bents and Piers (Epoxy)	lump sum	1
Surface Preparation for Recoating Structural Steel	sq. foot	1,300
Field Application of Inorganic Zinc Primer	sq. foot	1,300
Intermediate Field Coat (System G)	sq. foot	1,300
Finish Field Coat (System G)	sq. foot	1,300
*** Strip Seal Expansion Joint System	linear foot	155
Slab Drain	each	8

Estimated Quantities for Slab on Steel		
Item		Total
Class B-2 Concrete	cu. yard	404.6
Reinforcing Steel (Epoxy Coated)	pound	112,565

The table of Estimated Quantities for Slab on Steel represents the quantities used by the State in preparing the cost estimate for concrete slabs. The area of the concrete slab will be measured to the nearest square yard longitudinally from end of slab to end of slab and transversely from out to out of bridge slab (or with the horizontal dimensions as shown on the plan of slab). Payment for stay-in-place forms, conventional forms, all concrete and coated reinforcing steel will be considered completely covered by the contract unit price for the slab. Variations may be encountered in the estimated quantities but the variations cannot be used for an adjustment in the contract unit price.

Method of forming the slab shall be in accordance with Sec 703. All hardware for forming the slab to be left in place as a permanent part of the structure shall be coated in accordance with ASTM A123 or ASTM B633 with a thickness class SC 4 and a finish type I, II or III.


Slab shall be cast-in-place with conventional forming or stay-in-place corrugated steel forms. Precast prestressed panels will not be permitted.

For optional Stay-In-Place Form Details, see Sheet No. 7.

DETAILED: NOV 2014
CHECKED: NOV 2014


Note: This drawing is not to scale. Follow dimensions.

MISSOURI HIGHWAYS AND TRANSPORTATION COMMISSION
U.I.P. AND REDECK (58'-70'-70'-58') CONTINUOUS COMPOSITE WIDE FLANGE BEAM SPANS

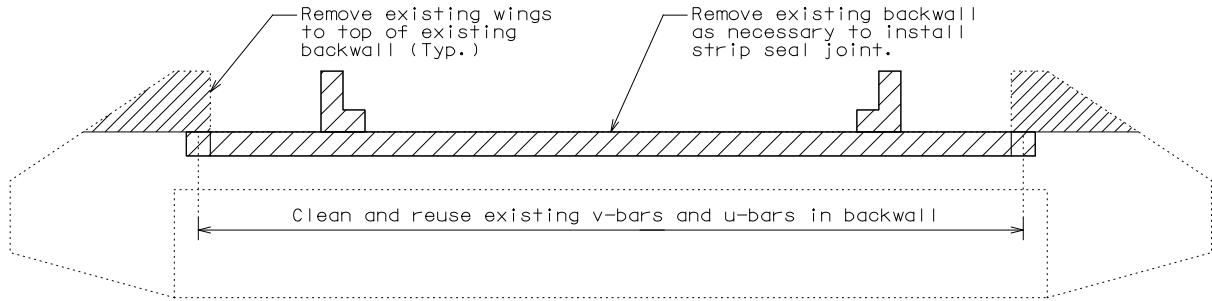

DETAILS OF CONCRETE REMOVAL @ END BENTS

Note:
The cost of concrete removal as shown will be considered completely covered by the contract unit price for Removal of Existing Bridge Decks. Vertical wingwall reinforcement to be cut off one inch below concrete removal surface and the resulting holes shall be filled with a qualified special mortar. Clean and reuse existing v-bars and u-bars in backwall.

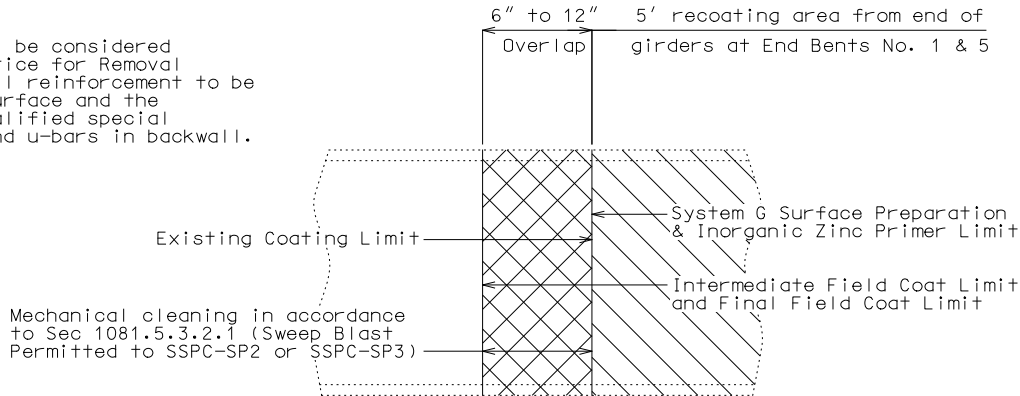

PART ELEVATION SHOWING LIMITS OF PAINT OVERLAP
(Vertical or horizontal paint limit. Horizontal limit shown)

* Safety barrier curb shall be cast-in-place option or slip-form option.

** Includes the cantilever sidewalks.

*** Measured from outside edge of sidewalk to outside edge of sidewalk along the centerline of joint.

Cost of any required excavation for bridge will be considered completely covered by the contract unit price for other items.

All reinforcement in the End Bents is included in the Estimated Quantities for Slab on Steel.

All concrete in the End Bents is included in the Estimated Quantities for Slab on Steel.

Structural Steel Protective Coatings
(Existing structural steel near End Bents):
Protective Coating: System G in accordance with Sec 1081.

Coating Limits: All existing structural steel within 5 feet from end of girders at End Bents No. 1 & 5.

Surface Preparation: Surface preparation of the existing steel shall be in accordance with Sec 1081 for "Recoating of Structural Steel (System G, H or I)". The cost of surface preparation will be considered completely covered by the contract unit price per sq. foot for "Surface Preparation for Recoating Structural Steel".

Prime Coat: The cost of the prime coat will be considered completely covered by the contract unit price per sq. foot for "Field Application of Inorganic Zinc Primer". Tint of the prime coat for System G shall be similar to the color of the field coat to be used.

Field Coat: The color of the field coat shall be Gray (Federal Standard #26373). The cost of the intermediate field coat will be considered completely covered by the contract unit price per sq. foot for "Intermediate Field Coat (System G)". The cost of the finish field coat will be considered completely covered by the contract unit price per sq. foot for "Finish Field Coat (System G)".

Sec 1081.4.5 shall be modified such that the word "RECOATED" is replaced by the word "RECOATED - SYSTEM G - EXPANSION AREAS ONLY".

REPAIRS TO BRIDGE: NORTH BRIGHTON OVER I-35

STATE ROAD FROM RTE. I-29 TO RTE. I-435
ABOUT 1 MILE N. OF RTE. 269
STA. 414+12.13 (Match Existing)

STD. 617.10
STD. 706.35
STD. 901.00



Professional Engineer
Mark Huck
PE-22266

DATE PREPARED
11-10-2014

ROUTE 35 STATE MO
DISTRICT BR SHEET NO. 1

COUNTY CLAY

JOB NO. J413028

CONTRACT ID.

PROJECT NO.

BRIDGE NO. L06552

DESCRIPTION	DATE


MISSOURI HIGHWAYS AND TRANSPORTATION COMMISSION
105 WEST CAPITAL
JEFFERSON CITY, MO 65102
1-888-ASK-MODOT (1-888-275-6636)

Burns & McDonnell Engineering Co., Inc.
9400 Ward Parkway
Kansas City, Missouri 64114
816-333-9400
Certificate of Authority
No. : 000165
BMOd Project No. 80028




IF A SEAL IS PRESENT ON THIS SHEET IT HAS BEEN ELECTRONICALLY SEALED AND DATED. REV.

1/2"Ø Machine bolt at abt. 18" cts.
Use two hex nuts to set gap before
concrete placement. Gap may be set
anytime up to but not exceeding 2
hours before concrete placement.
Cut machine bolt flush with steel
armor after concrete on each side
has taken initial set.

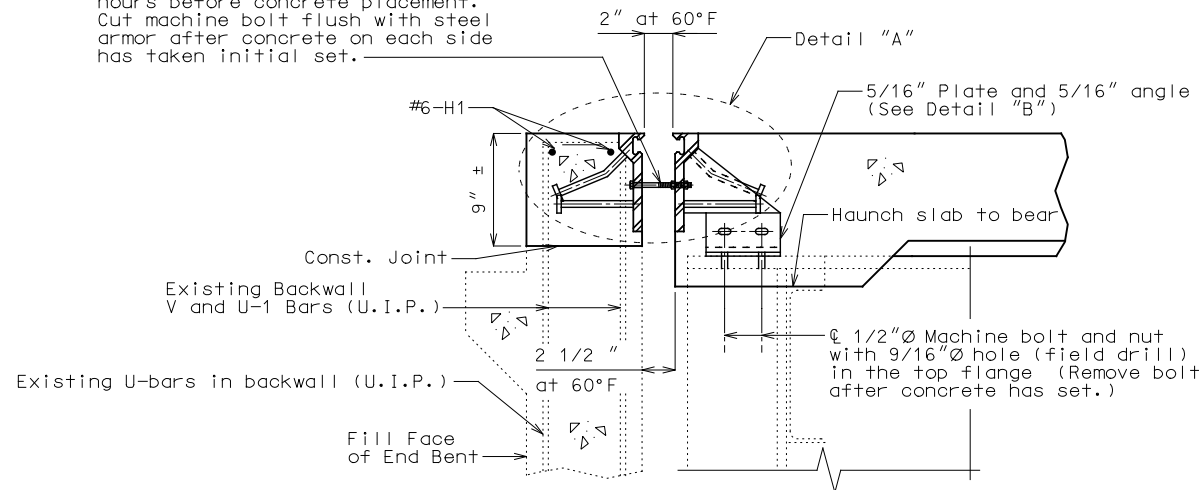


SECTION A-A

Note: Strip seal gland not shown for clarity.

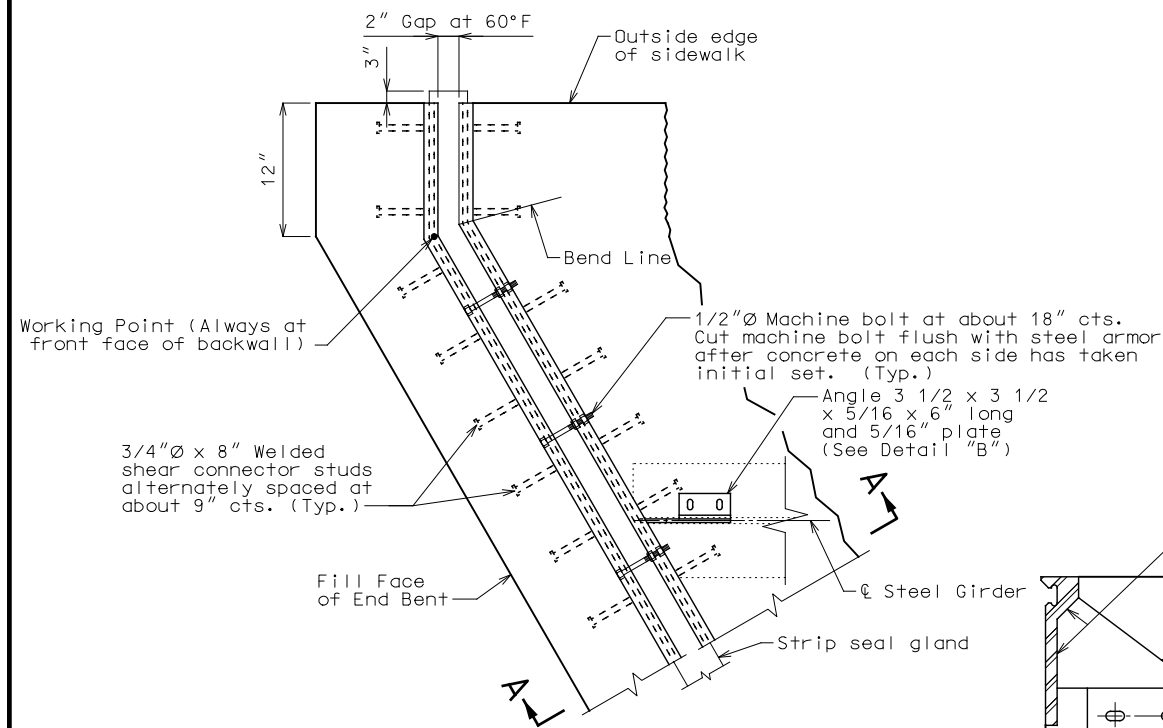

PART PLAN

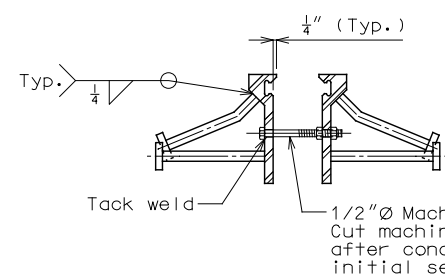


DETAIL "A"

1/2"Ø Machine bolts and nut with
9/16"Ø holes (field drill) in top
flange (Remove bolt after concrete
has set.)

9/16" x 1" Slotted holes
for 1/2"Ø machine bolts


Angle 3 1/2 x 3 1/2
x 5/16 x 6" long

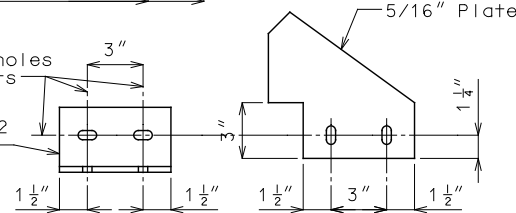

DETAIL "B"

DETAILS OF STRIP SEAL AT END BENT NO. 1 & 5


Note: This drawing is not to scale. Follow dimensions.

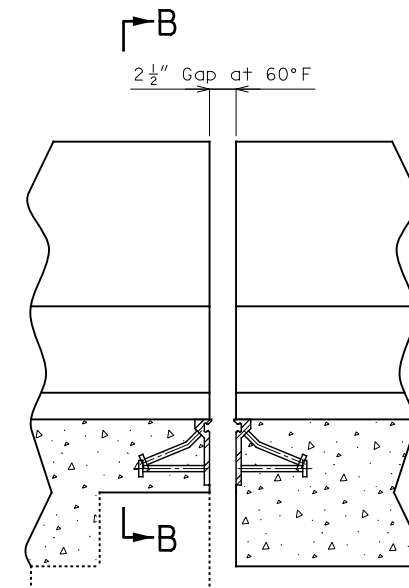


Note: Strip seal gland not shown for clarity.

PART ELEVATION OF BARRIER CURB


Modify location of shear
connectors in sidewalk to
clear bottom of sidewalk by 2".

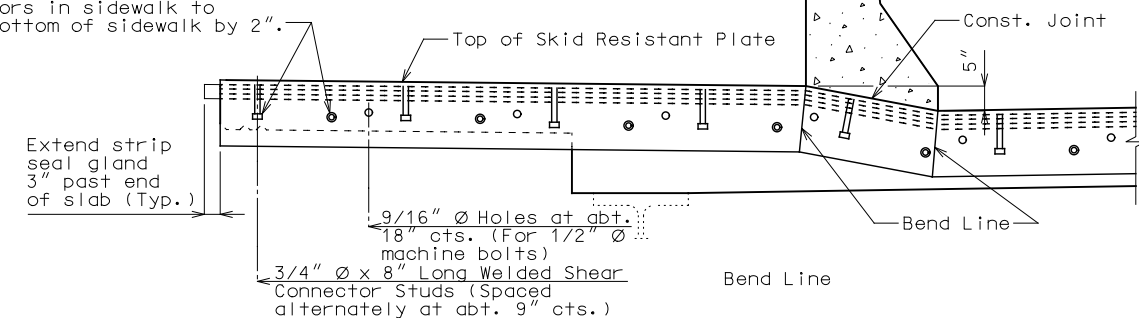

PART SECTION B-B

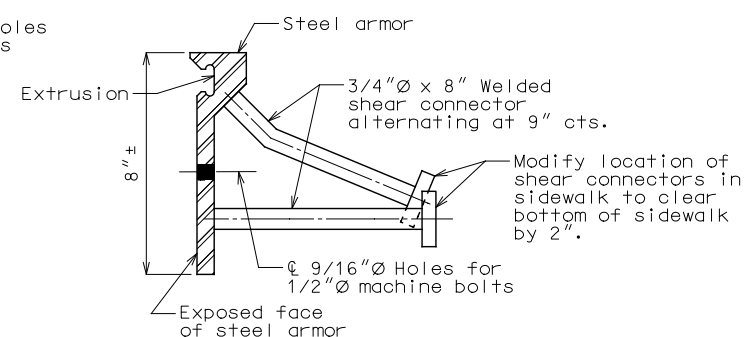

DETAIL OF JOINT ARMOR

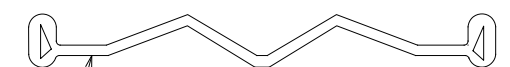

DETAIL OF GLAND

GENERAL NOTES:

Expansion joint system shall be fabricated
in one section, except for stage
construction and when the length is over 50
feet. A complete joint penetration groove
welded splice shall be required. Welds
shall be ground flush to provide a smooth
surface. The expansion joint system shall be
fabricated and installed to the crown and
grade of the roadway.

The strip seal gland shall be installed in
joints in one continuous piece without field
splices. Factory splicing will be permitted
for joints in excess of 53 feet.

Structural steel for the expansion joint
system shall be ASTM A709 Grade 36 except
the steel armor may be ASTM A709 Grade 50W.
Anchors for the expansion joint system
shall be in accordance with Sec 1037. Strip
seal expansion joint system shall be in
accordance with Sec 717.

Structural steel for the expansion joint
system shall be coated with a minimum of two
coats of inorganic zinc primer (5 mils
minimum) or galvanized in accordance with
ASTM A123. Anchors need not be protected
from overspray.

Plan dimensions are based on installation at
60°F. The expansion gap and other dimensions
shall be increased or decreased 1/16" for
each 10° fall or rise in temperature at
installation.

Longitudinal reinforcing steel shall be
placed so that ends shall not be more than
±1" from vertical leg of the steel armor at
the expansion joint system.

Concrete shall be forced under and around
steel armor and anchors. Proper
consolidation of the concrete shall be
achieved by localized internal vibration.

All concrete above the upper construction
joint in backwall shall be Class B-2.

DETAILED: NOV 2014
CHECKED: NOV 2014



Professional Engineer
Mark Huck
PE-22266

DATE PREPARED
11-10-2014

ROUTE 35 STATE MO

DISTRICT BR SHEET NO. 3

COUNTY CLAY

JOB NO. J413028

CONTRACT ID.

PROJECT NO.

BRIDGE NO. L06552

DESCRIPTION

DATE

MISSOURI HIGHWAYS AND TRANSPORTATION COMMISSION

MoDOT

105 WEST CAPITOL
JEFFERSON CITY, MO 65102

1-888-ASK-MODOT (1-888-275-6636)

REV.

IF A SEAL IS PRESENT ON THIS SHEET IT HAS BEEN ELECTRONICALLY SEALED AND DATED.

MoDOT

MoDOT


MoDOT

MoDOT
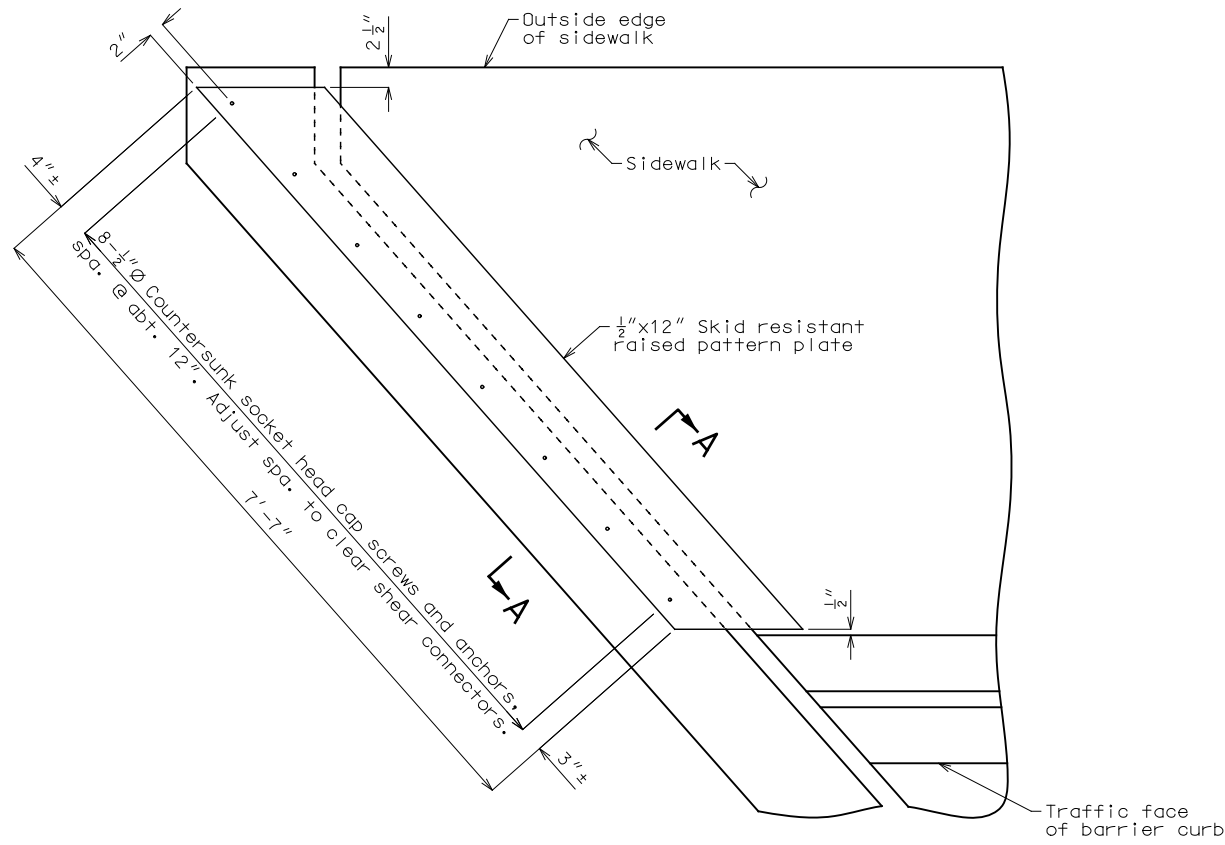

PART PLAN OF SLIDING PLATE

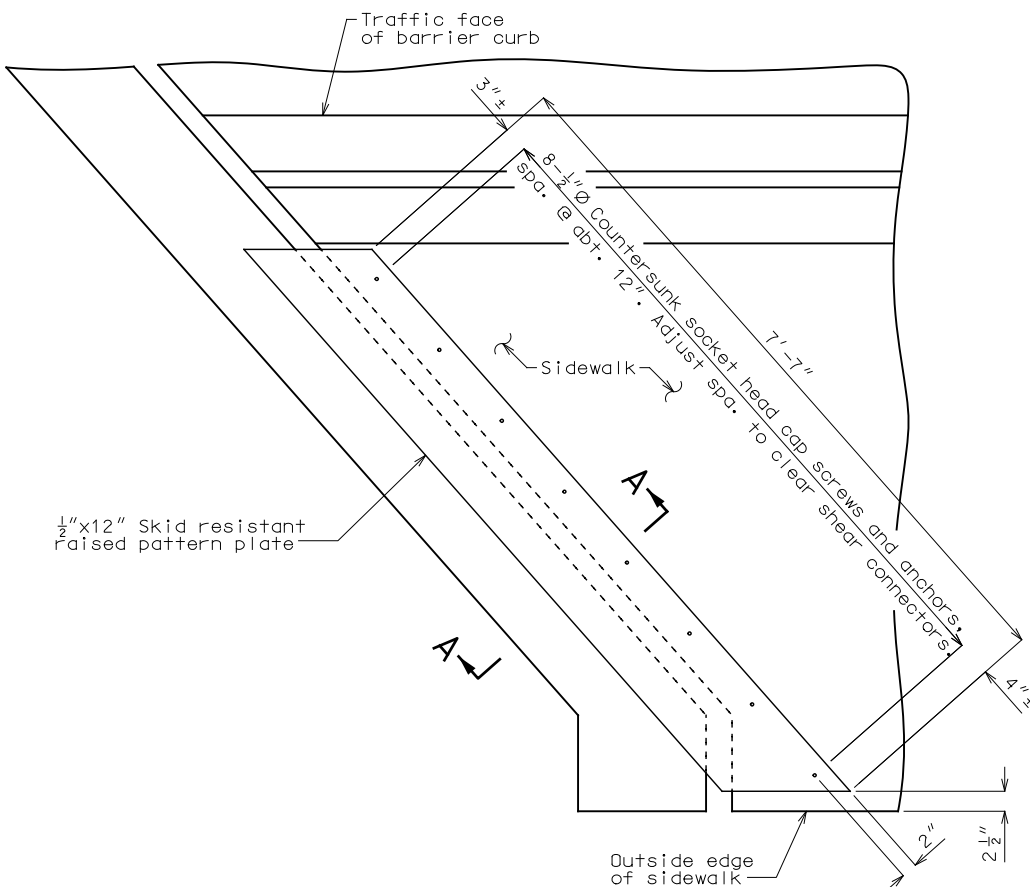

PART PLAN OF SLIDING PLATE

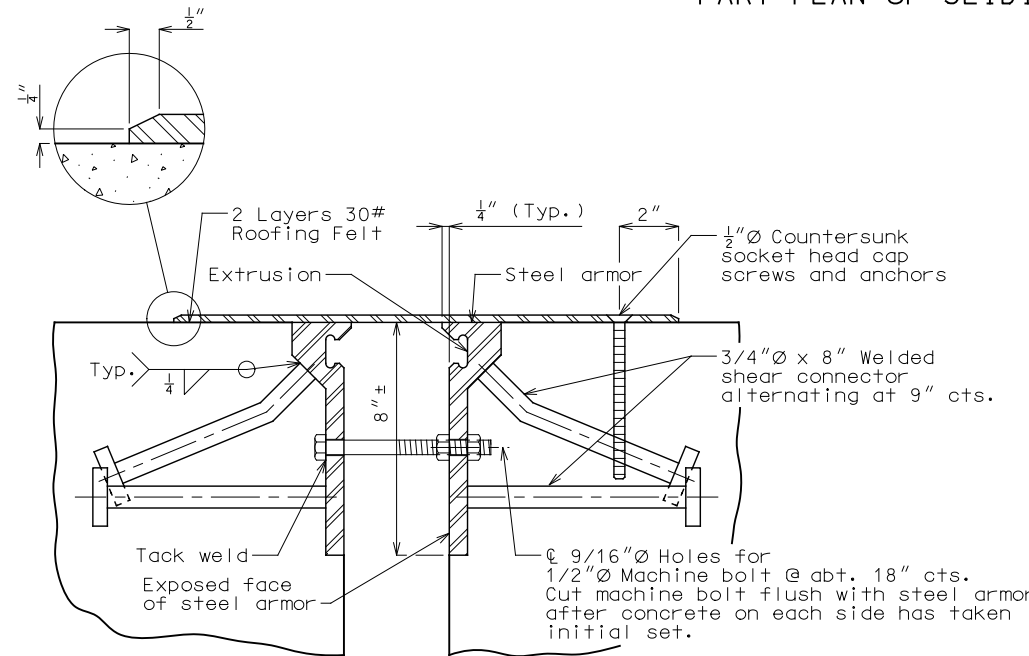

SECTION A-A

SLIDING PLATE DETAILS

Notes:

Cost of skid resistant plates, cap screws and anchors, complete in place, will be considered completely covered by the contract unit price for Strip Seal Expansion Joint System.

Skid resistant raised pattern plate anchors shall be a drilled cone expansion or a cast-in-place wing type threaded insert. The minimum ultimate pullout capacity for these anchors shall be 2,700 lbs. in f'c = 4,000 psi concrete. Lead anchors will not be permitted. Holes in the sidewalk for anchors shall not be drilled until the concrete is at least 7 days old.



Professional Engineer
Mark Huck
PE-22266

DATE PREPARED
11-10-2014

ROUTE 35 STATE MO
DISTRICT BR SHEET NO. 4

COUNTY
CLAY

JOB NO.
J413028

CONTRACT ID.

PROJECT NO.

BRIDGE NO.
L06552

DATE	DESCRIPTION

MISSOURI HIGHWAYS AND TRANSPORTATION COMMISSION

MoDOT

105 WEST CAPITOL
JEFFERSON CITY, MO 65102
1-888-ASK-MODOT (1-888-275-6636)

Burns & McDonnell Engineering Co., Inc.

9400 Ward Parkway
Kansas City, Missouri 64114
816-333-9400

Certificate of Authority
No. : 000165

BMoD Project No. 80028

Burns & McDonnell
SINCE 1898



DETAIL A

DETAIL B

DETAIL C

SIDEWALK DETAIL

*Contractor to verify dimensions of S10 and S13 bars after haunches are determined.

Note: This drawing is not to scale. Follow dimensions.

Sheet No. 5 of 14

\\trnsrv\trn\Projects\MoDOT\80028_44_Rehab_Br\Cadd\Bridge-Sheets\Br_No_L06552\B_L06552_005_J4I3028_Slab-Section.dgn 4:54:43 PM 11/7/2014

Professional Engineer
Mark Huck
PE-22266

DATE PREPARED
11-10-2014

ROUTE	STATE
35	MO

DISTRICT	SHEET NO.
BR	5

COUNTY
CLAY

JOB NO.
1417000

0415020
CONTRACT ID.

PROJECT NO.

BRIDGE NO.

L06552

[illegible]MISSOURI HIGHWAYS AND TRANSPORTATION
COMMISSION

105 WEST CAPITOL
JEFFERSON CITY, MO 65102
1-888-ASK-MODOT (1-888-275-6636)

Burns & McDonnell Engineering Co., Inc.

9400 Ward Parkway
Kansas City, Missouri 64114
816-333-9400


Certificate of Authority

No. : 000165


BMCD Project No. 80028



REV.

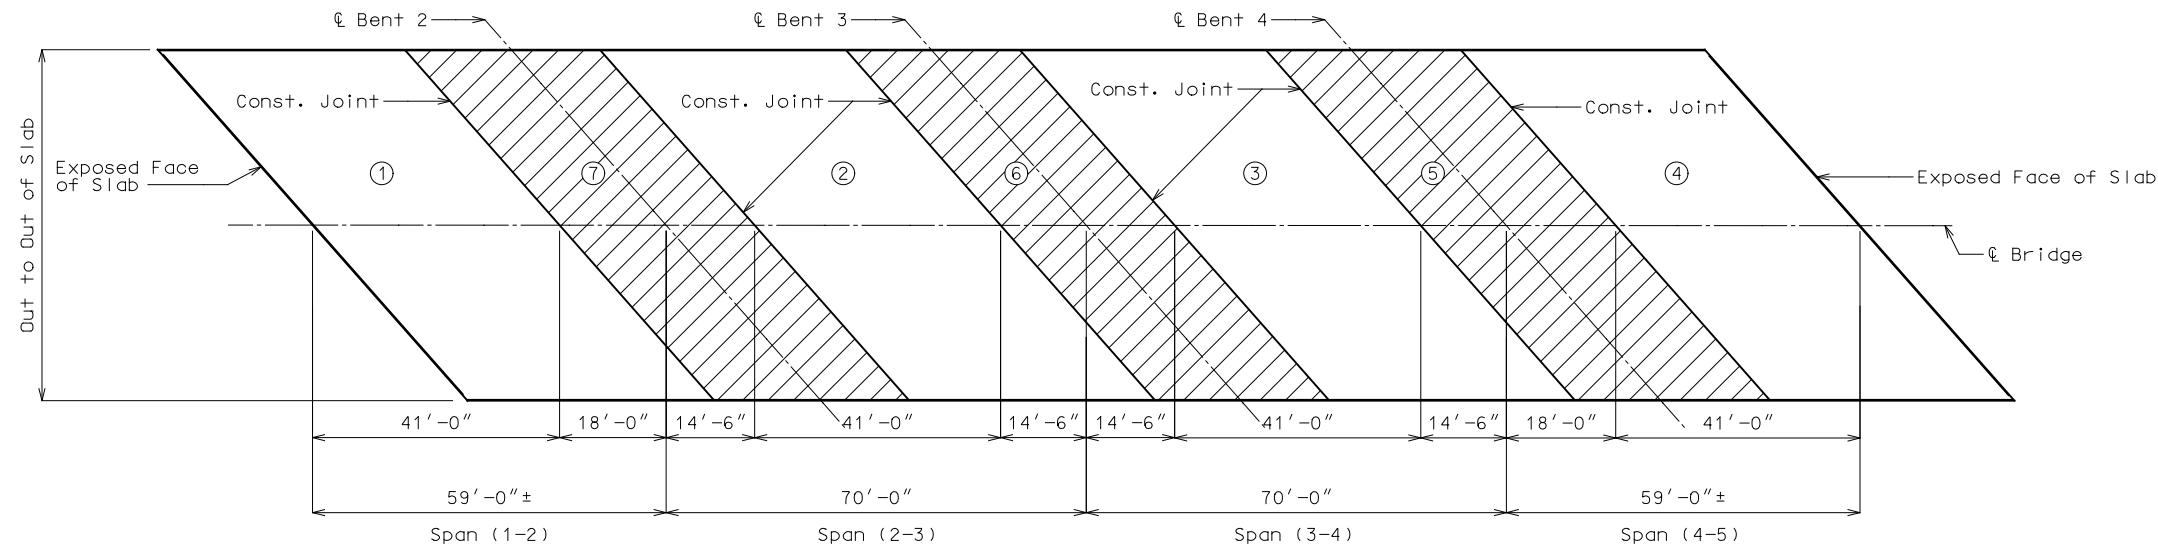

SLAB POURING SEQUENCE

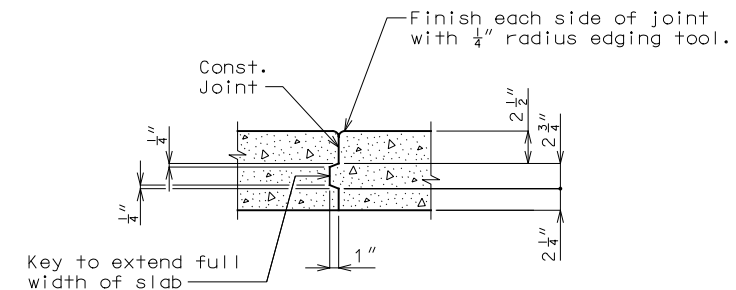

PERMISSIBLE CONSTRUCTION JOINT

Notes:
Corrugated steel bridge deck forms, supports closure elements and accessories shall be in accordance with grade requirement and coating designation G165 of ASTM A653. Complete shop drawings of the permanent steel deck forms shall be required in accordance with Sec 1080.



Corrugations of stay-in-place forms shall be filled with an expanded polystyrene material. The polystyrene material shall be placed in the forms with an adhesive in accordance with the manufacturer's recommendations.

Form sheets shall not rest directly on the top of girders, stringers or floorbeams flanges. Sheets shall be securely fastened to form supports with a minimum bearing length of one inch on each end. Form supports shall be placed in direct contact with the flange. Welding on or drilling holes in the flanges of the girders, stringers or floorbeams will not be permitted. All steel fabrication and construction shall be in accordance with Sec's 1080 and 712. Certified field welders will not be required for welding of the form supports.

The design of stay in place corrugated steel forms is per manufacturer which shall be in accordance with Sec 703 for false work and forms. Maximum actual weight of corrugated steel forms allowed shall be 4 psf assumed for girder loading.

The contractor shall provide temporary bracing as necessary to prevent girders from rotating during slab pour. The cost for temporary bracing shall be considered completely covered by the contract unit price for Slab on Steel.

Slab is to be considered at a uniform depth as shown on the plans. Haunching will vary.

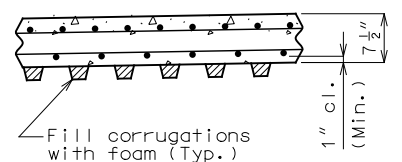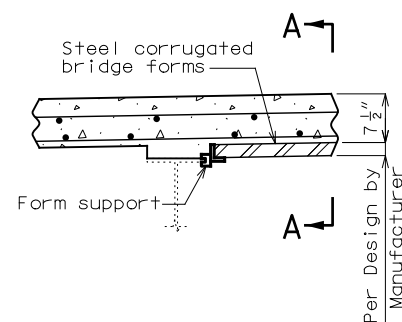

SECTION A-A
OPTIONAL STAY-IN-PLACE
FORM DETAILS

	Sequence of Pours							Min. Rate of Pour Cu. Yds./Hr.			
	Direction							With Retarder	No Retarder		
Basic Sequence	1	2	3	4	5	6	7	25	25		
	Either Direction										
Alternate pours to the basic skip sequence are subject to the approval of the engineer in accordance with Sec 703.											
Alternate Pours "A"	1		7 + 2		6 + 3		5 + 4		27	44	
	End to 7		1 to 6		2 to 5		3 to End				
Alternate Pours "B"	1 + 7 + 2			6 + 3			5 + 4			41	68
	End to 6			2 to 5			3 to End				
Alternate Pours "C"	1 + 7 + 2				6 + 3 + 5 + 4				51	<div></div>	
	End to 6				2 to End						
Alternate Pours "D"	1 + 7 + 2 + 6 + 3 + 5 + 4							<div></div>	<div></div>		
	End to End										

Note: The contractor shall pour and satisfactorily finish the slab pours at the rate given. Retarder, if used, shall be an approved type and retard the set of concrete to 2.5 hours.

Deflection Note:
The contractor shall determine dead load deflections and haunching based on field measurements and/or existing bridge plans and may be adjusted based on the difference between the new and existing dead load weights and bridge cross slope.

DETAILED: NOV 2014
CHECKED: NOV 2014

Note: This drawing is not to scale. Follow dimensions.

Sheet No. 7 of 14

\\trnsrv\trn\Projects\MoDOT\80028_44_Rehab_Br\Cadd\Bridge_Sheets\Br_No_L06552\B_L06552_007_J413028_Slab_Pour.dgn 4:54:49 PM 11/7/2014



Professional Engineer
Mark Huck
PE-22266

DATE PREPARED
11-10-2014

ROUTE 35 STATE MO
DISTRICT BR SHEET NO. 7

COUNTY CLAY
JOB NO. J413028
CONTRACT ID.

PROJECT NO.

BRIDGE NO. L06552

DESCRIPTION

DATE

MISSOURI HIGHWAYS AND TRANSPORTATION COMMISSION

105 WEST CAPITOL
JEFFERSON CITY, MO 65102
1-888-ASK-MODOT (1-888-275-6636)

MoDOT

Burns & McDonnell Engineering Co., Inc.







9400 Ward Parkway
Kansas City, Missouri 64114
816-333-9400

Certificate of Authority
No. : 000165

BMoD Project No. 80028

SINCE 1898

REV.

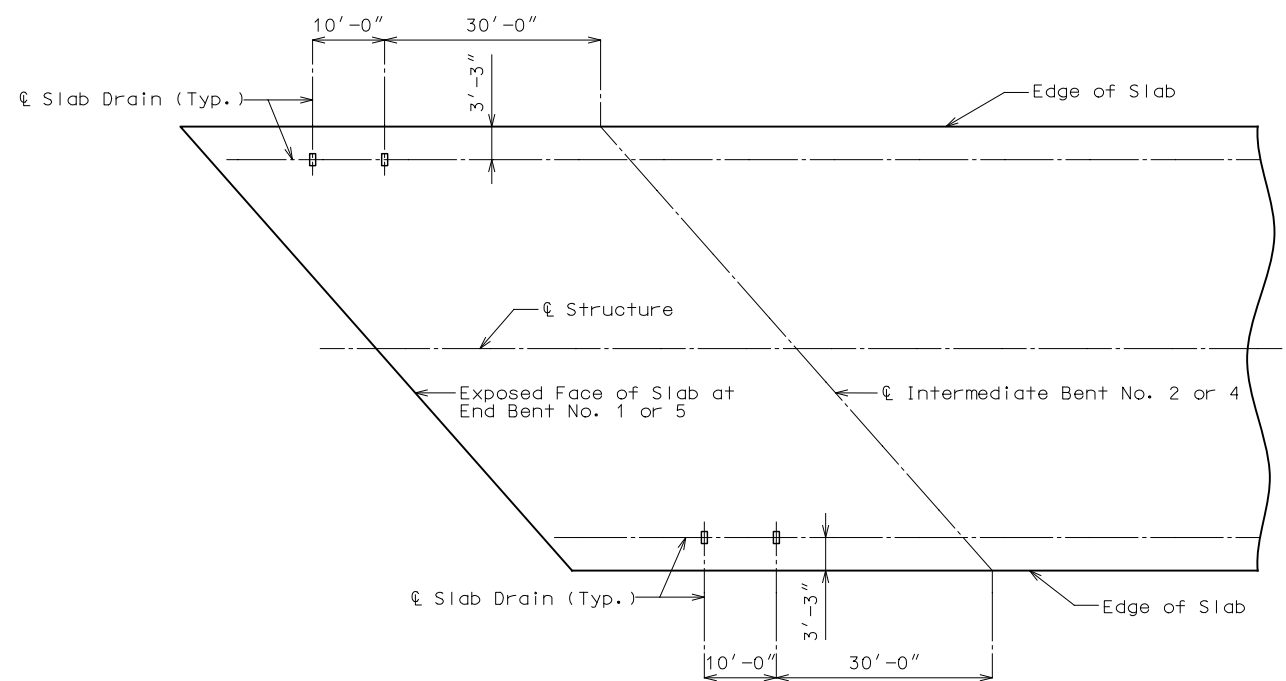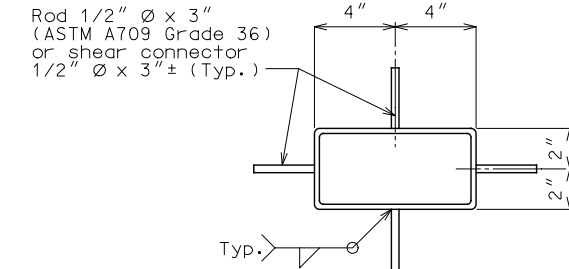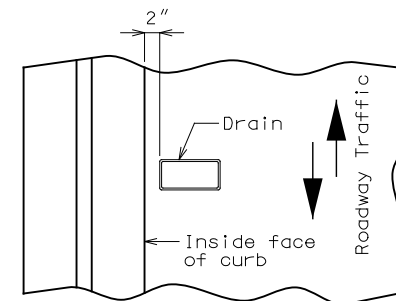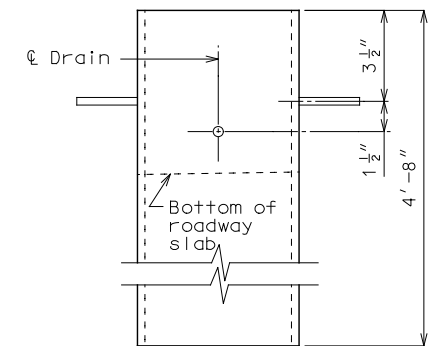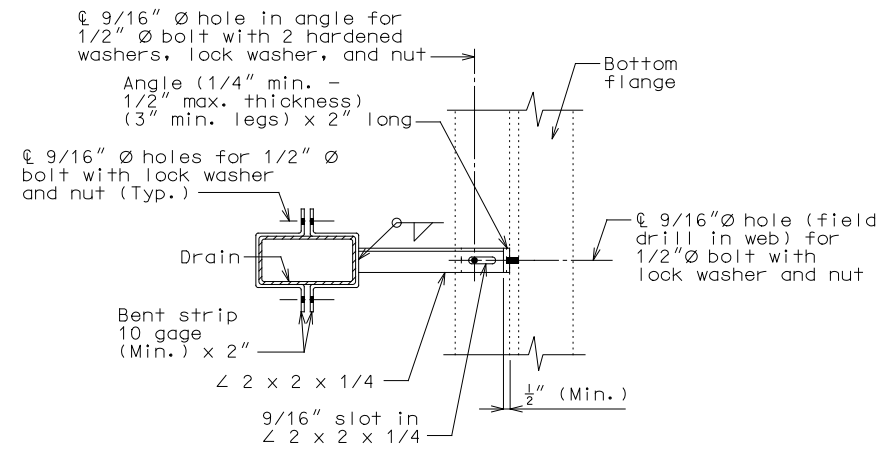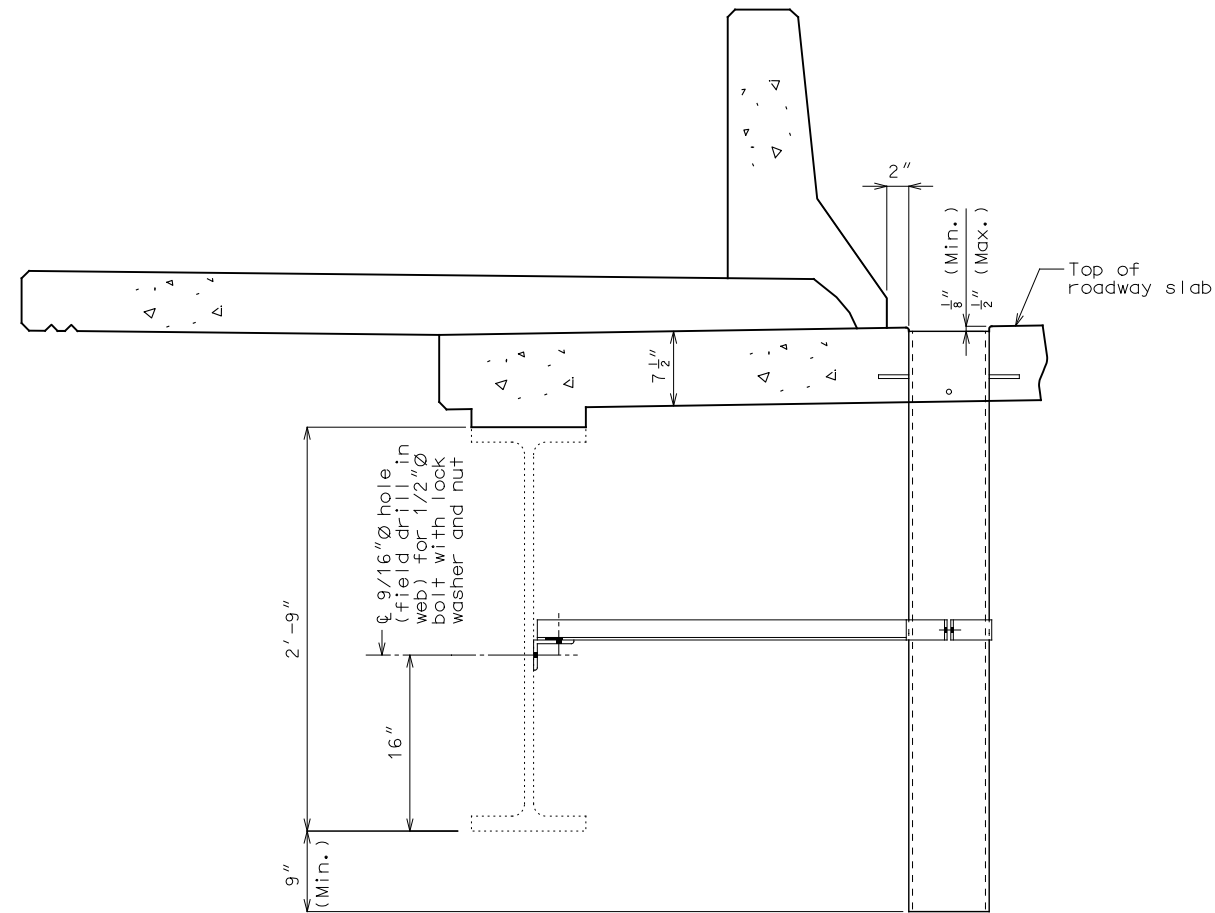

DETAILS OF DRAINS
TRANSVERSE TO ROADWAY

SLAB DRAIN DETAILS

Notes:

Slab drains may be fabricated of either 1/4" welded sheets of ASTM A709 Grade 36 steel or from 1/4" structural steel tubing ASTM A500 or A501.

Slab drain bracket assembly shall be ASTM A709 Grade 36 steel.

Outside dimensions of drains are 8" x 4".

Locate drains in slab by dimensions shown in Part Section Near Drain.

Reinforcing steel shall be shifted to clear drains.

The drains and bracket assembly shall be galvanized in accordance with ASTM A123.

All bolts, hardened washers, lock washers and nuts shall be galvanized in accordance with ASTM A153.

Shop drawings will not be required for the slab drains and the bracket assembly.

The bolt hole for the bracket assembly attachment should be shifted to the minimum extent necessary to field drill in the existing web.



Professional Engineer

DATE PREPARED
1-10-2014

ROUTE 35	STATE MO	LECTURE

DISTRICT	SHEET NO.
BR	8

COUNTY
CLAY

J4I3028


CONTRACT ID.	
--------------	--

PROJECT NO.	SHE
-------------	-----

BRIDGE NO.
L06552

[illegible]

MISSOURI HIGHWAYS AND TRANSPORTATION
COMMISSION

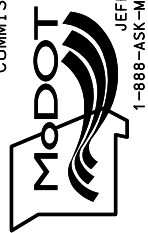

105 WEST CAPITOL
JEFFERSON CITY, MO 65102
1-888-ASK-MODOT (1-888-275-6636)

Burns & McDonnell Engineering Co., Inc.

9400 Ward Parkway
Kansas City, Missouri 64114
816-333-9400

Certificate of Authority
No. : 000165

BMcD Project No. 80028










DETAILED: NOV 2014
CHECKED: NOV 2014

Note: This drawing is not to scale. Follow dimensions.

Sheet No. 8 of 14

\\trnsrv\trn\Projects\MoDOT\80028_44_Rehab_Br\Cadd\Bridge_Sheets\Br_No_L06552\B_L06552_008_J4I3028_slab_drains.dgn 4:54:53 PM 11/7/2014

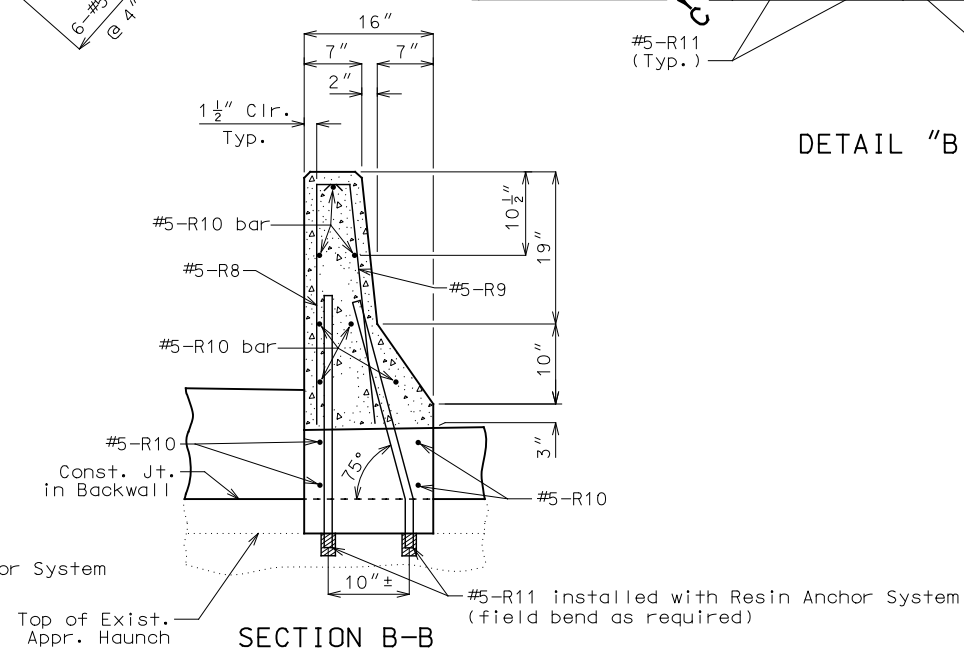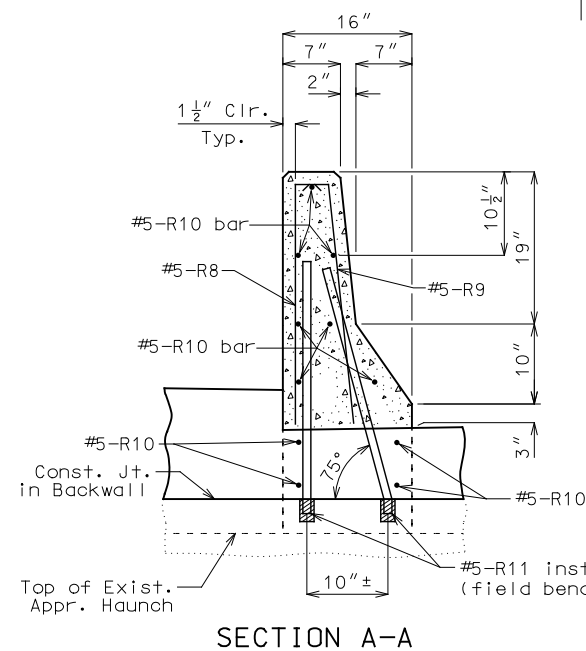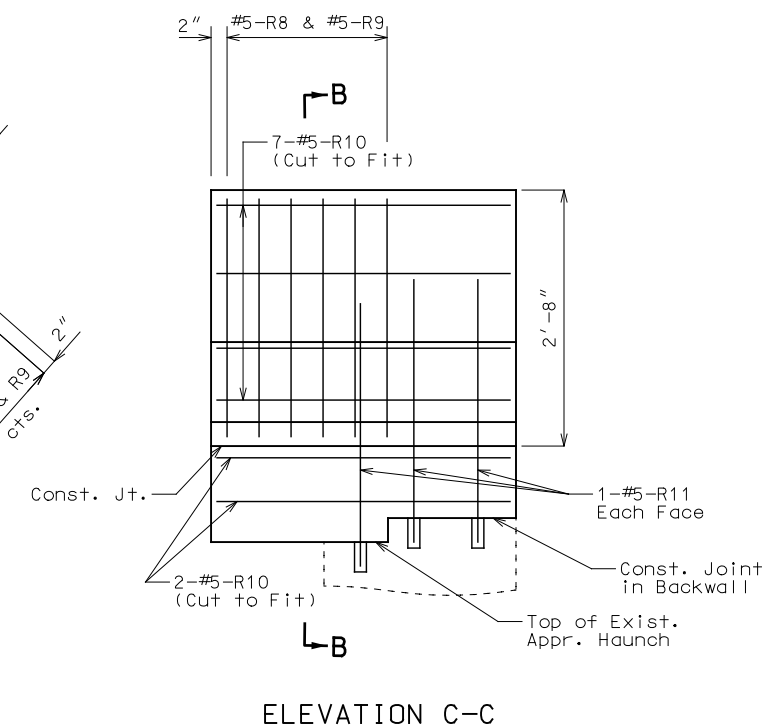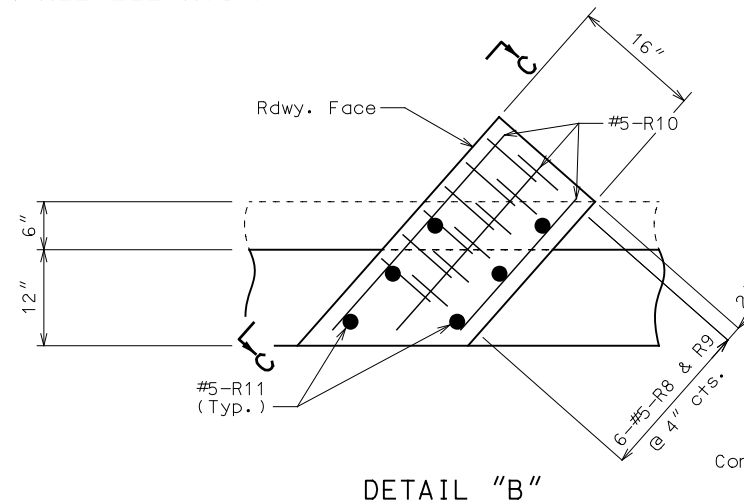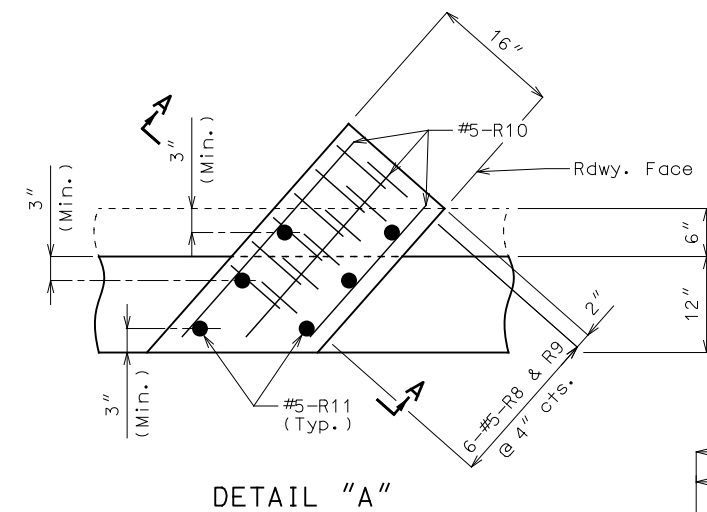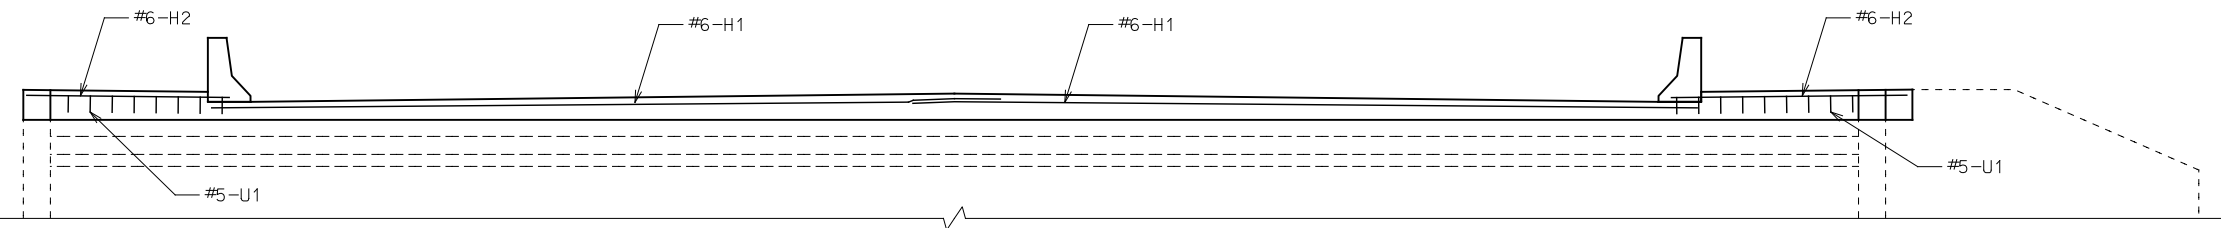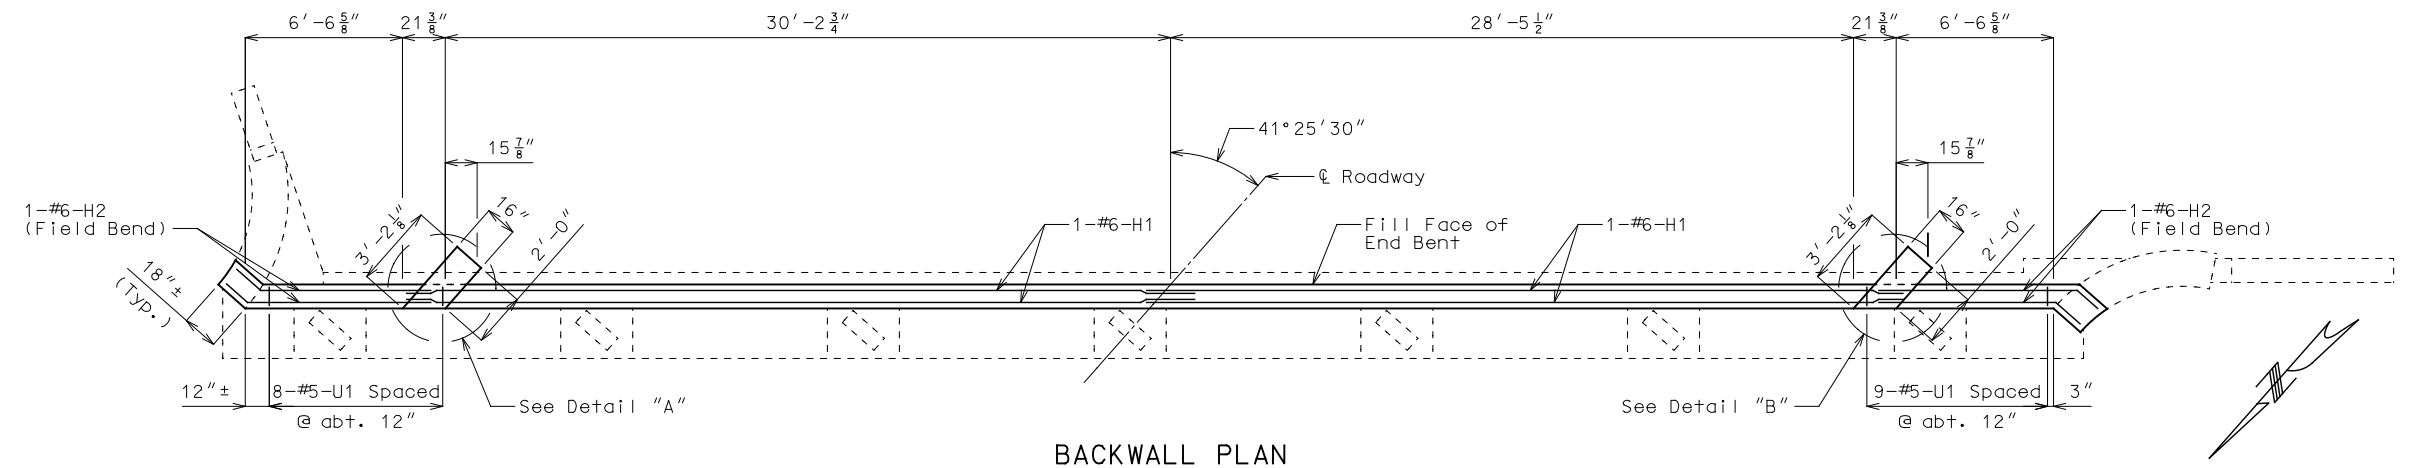

NOTES:

The contractor shall use one of the qualified resin anchor systems in accordance with Sec 1039.

Cost of furnishing and installing the resin anchor system complete-in-place will be considered completely covered by the contract unit price for Safety Barrier Curb per linear foot.

The minimum embedment depth in concrete with $f'c = 4,000$ psi for the resin anchor system shall be that required to meet the minimum ultimate pullout strength in accordance with Sec 1039 but shall not be less than 5".

Lap Splice #6 Bar = 3'-10"

Professional Engineer
Mark Huck
PE-22266


DATE PREPARED
11-10-2014

ROUTE 35	STATE MO
DISTRICT BR	SHEET NO. 10

COUNTY	CLAY
JOB NO.	J4I3028
CONTRACT ID.	

PROJECT NO.	SHEET

BRIDGE NO.	THIS
L06552	

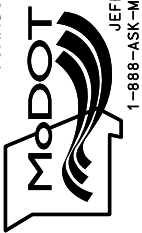[illegible]MISSOURI HIGHWAYS AND TRANSPORTATION
COMMISSION

**105 WEST CAPITOL
JEFFERSON CITY, MO 65102
1-888-ASK-MODOT (1-888-275-6636)**

Burns & McDonnell Engineering Co., Inc.

9400 Ward Parkway
Kansas City, Missouri 64114
816-333-9400

Certificate of Authority
No. : 000165

BMcD Project No. 80028



IF A SEAL IS PRESENT ON THIS SHEET IT HAS BEEN ELECTRONICALLY SEALED AND DATED:

REV.

DETAILED: NOV 2014
CHECKED: NOV 2014


Note: This drawing is not to scale. Follow dimensions.

Sheet No. 10 of 14

\\trnsrv\trn\Projects\MoDOT\80028_44_Rehab_Br\Cadd\Bridge_Sheets\Br_No_L06552\B_L06552_010_J4I3028_Barrier-End.dgn 4:55:00 PM 11/7/2014


BILL OF REINFORCING STEEL

NO.	REQ'D.	MARK NO.	LOCATION	EPOXY (E)	SHAPE NO.	STIRRUP (S)	SUBSTR. (X)	VARIES (V)	NO. EACH	DIMENSIONS												NOMINAL LENGTH	ACTUAL LENGTH	WEIGHT				
										B		C		D		E		F		H					K			
										FT.	IN.	FT.	IN.	FT.	IN.	FT.	IN.	FT.	IN.	FT.	IN.	FT.	IN.	FT.	IN.	FT.	IN.	LBS.
			END BENT 1																									
4	6	H1	BACKWALL	E	20					34	8.000											34	8	34	8	208		
6	6	H2	BACKWALL	E	20					8	10.000											8	10	8	10	80		
17	5	U1	BACKWALL	E	10	S					0	11.000	0	9.000								2	7	2	5	43		
			END BENT 5																									
4	6	H1	BACKWALL	E	20					34	8.000											34	8	34	8	208		
4	6	H2	BACKWALL	E	20					8	10.000											8	10	8	10	53		
17	5	U1	BACKWALL	E	10	S					0	11.000	0	9.000								2	7	2	5	43		
			SLAB																									
850	5	S1	SLAB	E	20					51	3.000											51	3	51	3	45,436		
352	5	S2	SLAB	E	20			V	4	0	18.000											0	18	0	18			
			Incr. = 6.80"							50	10.000											50	10	50	10	9,607		
504	5	S3	SIDEWALK	E	9	S				6	5.000	0	9.875	0	15.000			0	7.000	0	7.000	8	6	8	5	4,424		
8	5	S4	SIDEWALK	E	9	S		V	2	0	12.000	0	9.875	0	15.000			0	7.000	0	7.000	3	13	0				
			Incr. = 13.67"							4	5.000	0	9.875	0	15.000			0	7.000	0	7.000	6	6	6	5	39		
102	4	S5	SIDEWALK	E	20					53	8.000											53	8	53	8	3,657		
555	5	S6	SLAB	E	20					54	2.000											54	2	54	2	31,355		
160	6	S7	SLAB	E	20					35	6.000											35	6	35	6	8,531		
80	6	S8	SLAB	E	20					38	6.000											38	6	38	6	4,626		
12	5	S9	SIDEWALK	E	20			V	2	0	18.000											0	18	0	18			
			Incr. = 13.60"							7	2.000											7	2	7	2	54		
1260	4	S10	SLAB	E	10	S				0	8.000	0	7.000	0	8.000	0	8.000					3	23	0	2,525			
4	5	S11	SLAB	E	20					35	10.000											35	10	35	10	149		
96	5	S12	END HAUNCH	E	10	S					2	3.000	0	10.000								5	4	5	2	517		
504	4	S13	SLAB	E	11	S				0	8.000	0	7.000	0	8.000	0	7.000					3	23	0	1,010			
			SAFETY BARRIER CURB																									
536	5	R1	BARRIER CURB	E	26	S				2	6.000	0	4.250				2	6.000	0	3.000		5	3	5	3	2,935		
536	5	R3	BARRIER CURB	E	19	S				0	17.000	0	6.000									0	23	0	22	1,025		
536	5	R4	BARRIER CURB	E	27	S					0	6.000	0	11.250	0	7.000	0	12.000	0	9.250	0	6.375	3	0	2	10	1,584	
86	5	R5	BARRIER CURB	E	20					9	9.000											9	9	9	9	875		
56	5	R6	BARRIER CURB	E	20					26	2.000											26	2	26	2	1,528		
28	5	R7	BARRIER CURB	E	20					49	9.000											49	9	49	9	1,453		
24	5	R8	BARRIER CURB	E	19	S				2	6.000	0	3.500									2	10	2	9	69		
24	5	R9	BARRIER CURB	E	15	S				2	6.125	0	3.500				2	6.000	0	3.000		2	10	2	9	69		
44	5	R10	BARRIER CURB	E	20					2	10.000											2	10	2	10	130		
24	5	R11	BARRIER CURB	E	20					2	6.000											2	6	2	6	63		
3	5	U41	LIGHT SUPPORT	E	28	S				2	5.500	0	14.000	2	5.500	0	6.000					6	7	6	3	20		
2	5	U42	LIGHT SUPPORT	E	28	S				2	5.500	0	7.250	2	5.500	0	6.000					6	0	5	8	12		
6	5	U43	LIGHT SUPPORT	E	13	S				0	22.500	0	14.500	0	22.500	0	14.500					7	1	6	9	42		
6	6	U44	LIGHT SUPPORT	E	20					3	0.000											3	0	3	0	27		
6	5	R50	LIGHT SUPPORT	E	30					0	18.000	0	20.506	0	22.500	0	20.506	0	18.000	0	14.500	0	14.500	8	4	8	3	52

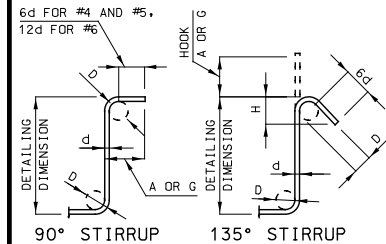

STIRRUP HOOK DIMENSIONS				
GRADES 40 - 50 - 60 KSI				
BAR SIZE	D (IN.)	90° HOOK A OR G	135° HOOK A OR G	APPROX. H
#4	2"	4 1/2"	4 1/2"	3"
#5	2 1/2"	6"	5 1/2"	3 3/4"
#6	4 1/2"	12"	8"	4 1/2"

NOTE: UNLESS OTHERWISE NOTED DIAMETER "D" IS THE SAME FOR ALL BENDS AND HOOKS ON A BAR.

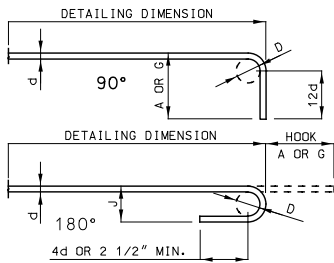


END HOOK DIMENSIONS				
ALL GRADES				
BAR SIZE	D (IN.)	180° HOOKS A OR G	90° HOOKS J	A OR G
#3	2 1/4"	5"	3"	6"
#4	3"	6"	4"	8"
#5	3 3/4"	7"	5"	10"
#6	4 1/2"	8"	6"	12"
#7	5 1/4"	10"	7"	14"
#8	6"	11"	8"	16"
#9	9 1/2"	15"	11 3/4"	19"
#10	10 3/4"	17"	13 1/4"	22"
#11	12"	19"	14 3/4"	2'-0"
#14	18 1/4"	2'-3"	21 3/4"	2'-7"

TWO ADDITIONAL #6-H2, #5-R5 and #4-S5 ARE INCLUDED IN THE BAR BILL FOR TESTING.

NOTE:
ALL STANDARD HOOKS AND BENDS OTHER THAN 180 DEGREE ARE TO BE BENT WITH SAME PROCEDURE AS FOR 90 DEGREE STANDARD HOOKS.
HOOKS AND BENDS SHALL BE IN ACCORDANCE WITH THE PROCEDURES AS SHOWN ON THIS SHEET.
E = EPOXY COATED REINFORCEMENT.
S = STIRRUP.
X = BAR IS INCLUDED IN SUBSTRUCTURE QUANTITIES.
V = BAR DIMENSIONS VARY IN EQUAL INCREMENTS BETWEEN DIMENSIONS SHOWN ON THIS LINE AND THE FOLLOWING LINE.
NO. EA. = NUMBER OF BARS OF EACH LENGTH.
NOMINAL LENGTHS ARE BASED ON OUT TO OUT DIMENSIONS SHOWN IN BENDING DIAGRAMS AND ARE LISTED FOR FABRICATORS USE. (NEAREST INCH)
ACTUAL LENGTHS ARE MEASURED ALONG CENTERLINE BAR TO THE NEAREST INCH.
PAYWEIGHTS ARE BASED ON ACTUAL LENGTHS.
FOUR ANGLE OR CHANNEL SPACERS ARE REQUIRED FOR EACH COLUMN SPIRAL. SPACERS ARE TO BE PLACED ON INSIDE OF SPIRALS. LENGTH AND WEIGHT OF COLUMN SPIRALS DO NOT INCLUDE SPLICES OR SPACERS.
REINFORCING STEEL (GRADE 60) FY = 60,000 PSI.

BILL OF REINFORCING STEEL

NO.	REQ'D.		MARK NO.	LOCATION	EPOXY (E)	SHAPE NO.	STIRRUP (S)	SUBSTR. (X)	VARIES (V)	NO. EACH	DIMENSIONS												NOMINAL LENGTH	ACTUAL LENGTH	WEIGHT		
	SIZE	MARK									B		C		D		E		F		H					K	
											FT.	IN.	FT.	IN.	FT.	IN.	FT.	IN.	FT.	IN.	FT.	IN.				FT.	IN.
				OPTIONAL SLIP FORM BARRIER																							
56	5	C1	BARRIER CURB	E	20						10	0.000											10	0	10	0	584
			TOTALS																								
	4			E																							7,192
	5			E																							101,524
	6			E																							13,733
			TOTAL	E																							122,449
			SLAB ON GIRDER																								
	4			E																							7,192
	5			E																							91,667
	6			E																							13,706
			TOTAL	E																							112,565
			BARRIER CURB																								
	5			E																							9,857
	6			E																							27
			TOTAL	E																							9,884
			OPTIONAL SLIP FORM BARRIER																								
	5			E																							584
			TOTAL	E																							584

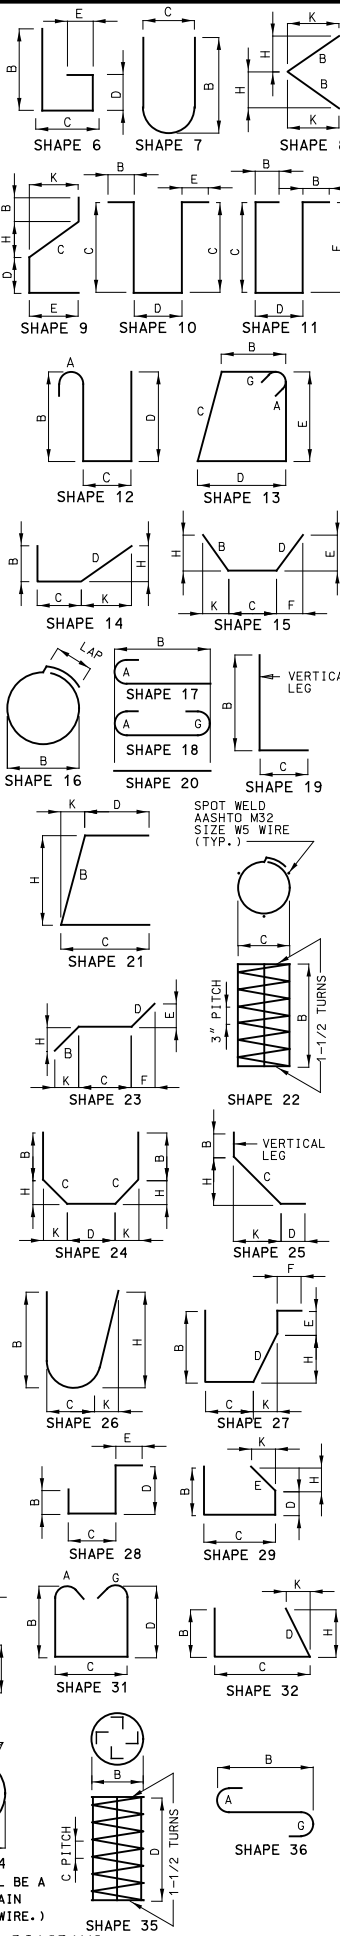

Professional Engineer
Mark Huck
PE-22266

DATE PREPARED
11-10-2014

ROUTE 35
DISTRICT BR
STATE MO
SHEET NO. 14

COUNTY CLAY
JOB NO. J413028
CONTRACT ID.

PROJECT NO.

BRIDGE NO. L06552



Missouri Department of Transportation
Bridge Inventory and Inspection System
Structural Inventory & Appraisal Sheet

October 1, 2024
3:59:05pm

COUNTY : CLAY BRIDGE : L0642 R1 REVIEW STATUS : APPROVED NBI STATUS : T
RECORD TYPE : ROUTE CARRIED 'ON' STRUCT RUN DATE : 9/30/2024 SUBMITTAL YEAR : 2024

GENERAL STRUCTURE INFORMATION			ROUTE DESIGNATION INFORMATION		
1	State	MISSOURI	5A	Record Type	ROUTE CARRIED 'ON' STRUCT
2	District	KC	5B	Route Signing Prefix	IS
3	County	CLAY	5C	Designated Level of Service	MAINLINE
8	Federal ID No.	6401	5D	Route Number	00035
27	Year Built	1954	5E	Directional Suffix	NOT APPLICABLE
106	Year Reconstructed	1989	7	Facility Carried	IS 35 N
42A	Type of Service On	HIGHWAY	12	Base Hwy. Network	YES
21	Structure Maintenance	STATE HIGHWAY AGENCY	13A	LRS Inventory Route No.	0000004984
22	Structure Owner	STATE HIGHWAY AGENCY	13B	Subroute No.	00
33	Br. Median Code	NO MEDIAN	20	Toll Status	ON FREE ROAD
37	Historical Significance	NOT ELIGIBLE FOR NR OF HP	26	Functional Classification	11-UR PRNCPL ARTERIAL-IS
101	Parallel Struc Desg	RIGHT	28A	Lanes on Structure	02
103	Temporary Structure	NOT TEMPORARY	100	STRAHNET Designation	ON A DEFENSE HWY
112	NBIS Bridge Length	YES	104	National Highway System	ON NHS
			105	Federal Lands Highway	NOT APPLICABLE
			110	Designated Nat. Network	YES
STRUCTURE LOCATION INFORMATION			STRUCTURE TRAFFIC INFORMATION		
4	Place	AVONDALE CITY	29	AADT	36619
	Code	02800	30	AADT Year	2023
9	Location	S 6 T 50 N R 32 W	102	Direction of Traffic	1-WAY TRAFFIC
11	Milepoint	9.89 miles	109	AADT Truck Percent	18%
16	Latitude	39 D 10 M 27 S	114	Future AADT	65914
17	Longitude	94 D 32 M 12 S	115	Future AADT Year	2043
UNDERRECORD INFORMATION			STRUCTURE GEOMETRIC INFORMATION		
6	Features Intersected	CST CHOUTEAU TRFY	10	Inventory Rte. Vert. Clear	99 Ft. 99 In.
42B	Type of Service Under	HIGHWAY	19	By pass Detour Length	0.63 miles
28B	Lanes Under Structure	04	32	Approach Roadway Width	47 Ft. 11 In.
54A	Vert. Clearance Ref.	HIGHWAY	34	Skew	24.00 Degrees
54B	Vert. Clearance	16 Ft. 0 In.	35	Struct. Flared	NO
55A	Rt. Lat Clear Ref.	HIGHWAY	47	Total Horiz. Clear	41 Ft. 4 In.
55B	Rt. Lat Clearance	6 Ft. 7 In.	48	Maximum Span Length	66 Ft. 7 In.
56	Left Lat Clearance	0 Ft. 0 In.	49	Structure Length	148 Ft. 11 In.
38	Navigation Control	N/A	50A	Left Curb/Sidewalk Width	0 Ft. 8 In.
39	Nav Vertical Clear	0 Ft. 0 In.	50B	Right Curb/Sidewalk Width	0 Ft. 8 In.
40	Nav Horizontal Clear	0 Ft. 0 In.	51	Curb to Curb Br. Width	40 Ft. 0 In.
111	Nav. Pier Protection		52	Deck Width (Out-Out)	42 Ft. 8 In.
116	Nav. Cl. Vert. Clear		53	Vert. Clearance Over Deck	99 Ft. 99 In.

Design_No = 10642



Missouri Department of Transportation
Bridge Inventory and Inspection System
Structural Inventory & Appraisal Sheet

October 1, 2024
3:59:05pm

COUNTY : CLAY BRIDGE : L0642 R1 REVIEW STATUS : APPROVED NBI STATUS : T
RECORD TYPE : ROUTE CARRIED 'ON' STRUCT RUN DATE : 9/30/2024 SUBMITTAL YEAR : 2024

LOAD RATING AND POSTING INFORMATION			MATERIAL/CONSTRUCTION INFORMATION		
31	Design Load	HS 20+MOD	43A	Main Struc. Mat type	STEEL CONTINUOUS
41	Structure Status	OPEN NO RESTRICTIONS	43B	Main struc Constr. Type	STRINGER/MULTIBEAM - GRD
63	Oper. Rating Meth.	LOAD FACTOR	45	# of Main Spans	3
64	Operating Rating	67 Tons.	44A	Appr Struc. Mat type	000
65	Inventory Rating Meth	LOAD FACTOR	44B	Appr Struc. Cnstr. type	000
66	Inventory Rating	41 Tons.	46	# of Approach Span	0
70	Bridge Posting Code	=>LEGAL LOADS	107	Deck Mat/Constr.	1 CONCRETE CIP
PROPOSED IMPROVEMENT INFORMATION			108A	Wear Surf Mat/Constr.	1 MONO CONCRETE
Sufficiency Rating 77.8 Percent			108B	Membrane Mat/Constr.	0 NONE
Deficiency Rating NOT DEFICIENT			108C	Deck Protect Mat/Constr.	1 EPOXY
Funding Eligibility			CONDITION RATING INFORMATION		
75A	Proposed Work		58	Deck Cond. Rating	6
75B	Work Done By		59	Superstructure Cond. Rating	5
76	New Struc Length	0 Ft. 0 In.	60	Substructure Cond. Rating	5
94	Struc Improve Cost	\$ 0,000	61	Channel /Channel Protection Cond. Rating	N
95	Roadway Improve Cost	\$ 0,000	62	Culvert Cond. Rating	N
96	Total Project Cost	\$ 0,000	INSPECTION INFORMATION		
97	Year of Cost Estimates	0	90	Gen. Insp Date	9 / 24
APPRAISAL RATING INFORMATION			91	Gen. Insp. Frequency	24 Months
36A	Br. Rail App. Rating	MEETS ACCEPTBLE STND	92A	Frac. Critical Inspection	N Months
36B	Transition Rail App. Rating	MEETS ACCEPTBLE STND	93A	Frac. Critical Insp. Date	
36C	Approach Rail App. Rating	MEETS ACCEPTBLE STND	92B	Underwater Inspection	N Months
36D	Rail End Treat. App. Rating	MEETS ACCEPTBLE STND	93B	Underwater Insp. Date	
67	Struc Eval App. Rating	5	92C	Special Inspection	N Months
68	Deck Geometry App. Rating	7	93C	Special Inspection Date	
69	Underclearance App. Rating	4	BORDER BRIDGE INFORMATION		
71	Waterway Adeq. App. Rating	N	98	Neighboring State Code	
72	Approach Road App. Rating	8	98B	Neighboring State % Respon	
113	Scour Assess App. Rating	N	99	Neighboring State Struc. No.	
APPROVED POSTING INFORMATION			FIELD POSTING INFORMATION		
Approved Posting Category S-1			Field Posting Category S-1		
Ton1 Ton2 Ton3			Ton1 Ton2 Ton3		
Tonnage Values for Posting Sign			Tonnage Values for Posting Sign		
General Text for Posting Sign			General Text for Posting Sign		
NO POSTING REQUIRED			NO POSTING REQUIRED		

Design_No = 10642



Missouri Department of Transportation
Bridge Inventory and Inspection System
Structural Inventory & Appraisal Sheet

October 1, 2024
3:59:05pm

COUNTY : CLAY BRIDGE : L0642 R1 REVIEW STATUS : APPROVED NBI STATUS : T
RECORD TYPE : ROUTE 'UNDER' STRUCT RUN DATE : 9/30/2024 SUBMITTAL YEAR : 2024

GENERAL STRUCTURE INFORMATION			ROUTE DESIGNATION INFORMATION		
1	State	MISSOURI	5A	Record Type	ROUTE 'UNDER' STRUCT Code : 2
2	District	KC	5B	Route Signing Prefix	CST
3	County	CLAY	5C	Designated Level of Service	MAINLINE
8	Federal ID No.	6401	5D	Route Number	00000
27	Year Built	1954	5E	Directional Suffix	NOT APPLICABLE
106	Year Reconstructed	0	7	Facility Carried	IS 35 N
42A	Type of Service On	HIGHWAY	12	Base Hwy. Network	
21	Structure Maintenance		13A	LRS Inventory Route No.	
22	Structure Owner		13B	Subroute No.	
33	Br. Median Code		20	Toll Status	ON FREE ROAD
37	Historical Significance		26	Functional Classification	16-URBAN MINOR ARTERIAL
101	Parallel Struc Desg	RIGHT	28A	Lanes on Structure	02
103	Temporary Structure	NOT TEMPORARY	100	STRAHNET Designation	RTE NOT A DEFENSE HWY
112	NBIS Bridge Length		104	National Highway System	NOT ON NHS
			105	Federal Lands Highway	
			110	Designated Nat. Network	NO
STRUCTURE LOCATION INFORMATION			STRUCTURE TRAFFIC INFORMATION		
4	Place	AVONDALE CITY	29	AADT	11518
	Code	02800	30	AADT Year	2023
9	Location	S 6 T 50 N R 32 W	102	Direction of Traffic	2-WAY TRAFFIC
11	Milepoint	1.65 miles	109	AADT Truck Percent	5%
16	Latitude	39 D 10 M 27 S	114	Future AADT	
17	Longitude	94 D 32 M 12 S	115	Future AADT Year	
UNDERRECORD INFORMATION			STRUCTURE GEOMETRIC INFORMATION		
6	Features Intersected	MO 269	10	Inventory Rte. Vert. Clear	16 Ft. 0 In.
42B	Type of Service Under	HIGHWAY	19	By pass Detour Length	0.63 miles
28B	Lanes Under Structure	04	32	Approach Roadway Width	
54A	Vert. Clearance Ref.		34	Skew	
54B	Vert. Clearance		35	Struct. Flared	
55A	Rt. Lat Clear Ref.		47	Total Horiz. Clear	41 Ft. 4 In.
55B	Rt. Lat Clearance		48	Maximum Span Length	66 Ft. 7 In.
56	Left Lat Clearance		49	Structure Length	148 Ft. 11 In.
38	Navigation Control		50A	Left Curb/Sidewalk Width	
39	Nav Vertical Clear		50B	Right Curb/Sidewalk Width	
40	Nav Horizontal Clear		51	Curb to Curb Br. Width	
111	Nav. Pier Protection		52	Deck Width (Out-Out)	
116	Nav. Cl. Vert. Clear		53	Vert. Clearance Over Deck	

Design_No = 10642



Missouri Department of Transportation
Bridge Inventory and Inspection System
Structural Inventory & Appraisal Sheet

October 1, 2024
3:59:05pm

COUNTY : CLAY BRIDGE : L0642 R1 REVIEW STATUS : APPROVED NBI STATUS : T
RECORD TYPE : ROUTE 'UNDER' STRUCT RUN DATE : 9/30/2024 SUBMITTAL YEAR : 2024

LOAD RATING AND POSTING INFORMATION		MATERIAL/CONSTRUCTION INFORMATION	
31	Design Load	43A	Main Struc. Mat type STEEL CONTINUOUS
41	Structure Status	43B	Main struc Constr. Type STRINGER/MULTIBEAM - GRD
63	Oper. Rating Meth.	45	# of Main Spans
64	Operating Rating	44A	Appr Struc. Mat type
65	Inventory Rating Meth	44B	Appr Struc. Cnstr. type
66	Inventory Rating	46	# of Approach Span
70	Bridge Posting Code	107	Deck Mat/Constr.
PROPOSED IMPROVEMENT INFORMATION		108A	Wear Surf Mat/Constr.
Sufficiency Rating		108B	Membrane Mat/Constr.
Deficiency Rating		108C	Deck Protect Mat/Constr.
Funding Eligibility		CONDITION RATING INFORMATION	
75A	Proposed Work	58	Deck Cond. Rating
75B	Work Done By	59	Superstructure Cond. Rating
76	New Struc Length	60	Substructure Cond. Rating
94	Struc Improve Cost	61	Channel /Channel Protection Cond. Rating
95	Roadway Improve Cost	62	Culvert Cond. Rating
96	Total Project Cost	INSPECTION INFORMATION	
97	Year of Cost Estimates	90	Gen. Insp Date
APPRAISAL RATING INFORMATION		91	Gen. Insp. Frequency
36A	Br. Rail App. Rating	92A	Frac. Critical Inspection
36B	Transition Rail App. Rating	93A	Frac. Critical Insp. Date
36C	Approach Rail App. Rating	92B	Underwater Inspection
36D	Rail End Treat. App. Rating	93B	Underwater Insp. Date
67	Struc Eval App. Rating	92C	Special Inspection
68	Deck Geometry App. Rating	93C	Special Inspection Date
69	Underclearance App. Rating	BORDER BRIDGE INFORMATION	
71	Waterway Adeq. App. Rating	98	Neighboring State Code
72	Approach Road App. Rating	98B	Neighboring State % Respon
113	Scour Assess App. Rating	99	Neighboring State Struc. No.
APPROVED POSTING INFORMATION		FIELD POSTING INFORMATION	
Approved Posting Category		Field Posting Category	
Ton1 Ton2 Ton3		Ton1 Ton2 Ton3	
Tonnage Values for Posting Sign		Tonnage Values for Posting Sign	
General Text for Posting Sign		General Text for Posting Sign	

Design_No = 10642



Missouri Department of Transportation
Bridge Inventory and Inspection System
Structural Inventory & Appraisal Sheet

October 1, 2024
3:59:42pm

COUNTY : CLAY BRIDGE : L0655 2 REVIEW STATUS : APPROVED NBI STATUS : T
RECORD TYPE : ROUTE CARRIED 'ON' STRUCT RUN DATE : 9/30/2024 SUBMITTAL YEAR : 2024

GENERAL STRUCTURE INFORMATION			ROUTE DESIGNATION INFORMATION		
1	State	MISSOURI	5A	Record Type	ROUTE CARRIED 'ON' STRUCT
2	District	KC	5B	Route Signing Prefix	CST
3	County	CLAY	5C	Designated Level of Service	MAINLINE
8	Federal ID No.	6409	5D	Route Number	00000
27	Year Built	1954	5E	Directional Suffix	NOT APPLICABLE
106	Year Reconstructed	1976	7	Facility Carried	N BRIGHTON AVE S
42A	Type of Service On	HIGHWAY-PEDESTRIAN	12	Base Hwy. Network	NO
21	Structure Maintenance	STATE HIGHWAY AGENCY	13A	LRS Inventory Route No.	
22	Structure Owner	STATE HIGHWAY AGENCY	13B	Subroute No.	
33	Br. Median Code	NO MEDIAN	20	Toll Status	ON FREE ROAD
37	Historical Significance	NOT ELIGIBLE FOR NR OF HP	26	Functional Classification	16-URBAN MINOR ARTERIAL
101	Parallel Struc Desg	NONE EXISTS	28A	Lanes on Structure	04
103	Temporary Structure	NOT TEMPORARY	100	STRAHNET Designation	RTE NOT A DEFENSE HWY
112	NBIS Bridge Length	YES	104	National Highway System	NOT ON NHS
			105	Federal Lands Highway	NOT APPLICABLE
			110	Designated Nat. Network	NO
STRUCTURE LOCATION INFORMATION			STRUCTURE TRAFFIC INFORMATION		
4	Place	KANSAS CITY CITY	29	AADT	4914
	Code	38000	30	AADT Year	2023
9	Location	S 32 T 51 N R 32 W	102	Direction of Traffic	2-WAY TRAFFIC
11	Milepoint	5.82 miles	109	AADT Truck Percent	5%
16	Latitude	39 D 11 M 1 S	114	Future AADT	7862
17	Longitude	94 D 31 M 16 S	115	Future AADT Year	2043
UNDERRECORD INFORMATION			STRUCTURE GEOMETRIC INFORMATION		
6	Features Intersected	IS 35	10	Inventory Rte. Vert. Clear	99 Ft. 99 In.
42B	Type of Service Under	HIGHWAY	19	By pass Detour Length	1.25 miles
28B	Lanes Under Structure	04	32	Approach Roadway Width	43 Ft. 12 In.
54A	Vert. Clearance Ref.	HIGHWAY	34	Skew	41.00 Degrees
54B	Vert. Clearance	16 Ft. 12 In.	35	Struct. Flared	NO
55A	Rt. Lat Clear Ref.	HIGHWAY	47	Total Horiz. Clear	43 Ft. 12 In.
55B	Rt. Lat Clearance	11 Ft. 10 In.	48	Maximum Span Length	69 Ft. 11 In.
56	Left Lat Clearance	13 Ft. 9 In.	49	Structure Length	261 Ft. 2 In.
38	Navigation Control	N/A	50A	Left Curb/Sidewalk Width	4 Ft. 11 In.
39	Nav Vertical Clear	0 Ft. 0 In.	50B	Right Curb/Sidewalk Width	4 Ft. 11 In.
40	Nav Horizontal Clear	0 Ft. 0 In.	51	Curb to Curb Br. Width	43 Ft. 12 In.
111	Nav. Pier Protection		52	Deck Width (Out-Out)	58 Ft. 5 In.
116	Nav. Cl. Vert. Clear		53	Vert. Clearance Over Deck	99 Ft. 99 In.

Design_No = 10655



Missouri Department of Transportation
Bridge Inventory and Inspection System
Structural Inventory & Appraisal Sheet

October 1, 2024
3:59:42pm

COUNTY : CLAY BRIDGE : L0655 2 REVIEW STATUS : APPROVED NBI STATUS : T
RECORD TYPE : ROUTE CARRIED 'ON' STRUCT RUN DATE : 9/30/2024 SUBMITTAL YEAR : 2024

LOAD RATING AND POSTING INFORMATION			MATERIAL/CONSTRUCTION INFORMATION		
31	Design Load	H 20	43A	Main Struc. Mat type	STEEL CONTINUOUS
41	Structure Status	OPEN NO RESTRICTIONS	43B	Main struc Constr. Type	STRINGER/MULTIBEAM - GRD
63	Oper. Rating Meth.	LOAD FACTOR	45	# of Main Spans	4
64	Operating Rating	62 Tons.	44A	Appr Struc. Mat type	000
65	Inventory Rating Meth	LOAD FACTOR	44B	Appr Struc. Cnstr. type	000
66	Inventory Rating	38 Tons.	46	# of Approach Span	0
70	Bridge Posting Code	=>LEGAL LOADS	107	Deck Mat/Constr.	1 CONCRETE CIP
PROPOSED IMPROVEMENT INFORMATION			108A	Wear Surf Mat/Constr.	1 MONO CONCRETE
Sufficiency Rating 77.4 Percent			108B	Membrane Mat/Constr.	0 NONE
Deficiency Rating FUNCTIONAL			108C	Deck Protect Mat/Constr.	0 NONE
Funding Eligibility PARTIAL			CONDITION RATING INFORMATION		
75A	Proposed Work	REHAB-GENERAL DETERIORAT	58	Deck Cond. Rating	8
75B	Work Done By	Contract	59	Superstructure Cond. Rating	7
76	New Struc Length	295 Ft. 3 In.	60	Substructure Cond. Rating	6
94	Struc Improve Cost	\$ 2,006,000	61	Channel /Channel Protection Cond. Rating	N
95	Roadway Improve Cost	\$ 201,000	62	Culvert Cond. Rating	N
96	Total Project Cost	\$ 3,009,000	INSPECTION INFORMATION		
97	Year of Cost Estimates	2024	90	Gen. Insp Date	9 / 24
APPRAISAL RATING INFORMATION			91	Gen. Insp. Frequency	24 Months
36A	Br. Rail App. Rating	MEETS ACCEPTBLE STND	92A	Frac. Critical Inspection	N Months
36B	Transition Rail App. Rating	DOES NOT MEET ACCEPT STND	93A	Frac. Critical Insp. Date	
36C	Approach Rail App. Rating	DOES NOT MEET ACCEPT STND	92B	Underwater Inspection	N Months
36D	Rail End Treat. App. Rating	DOES NOT MEET ACCEPT STND	93B	Underwater Insp. Date	
67	Struc Eval App. Rating	6	92C	Special Inspection	N Months
68	Deck Geometry App. Rating	2	93C	Special Inspection Date	
69	Underclearance App. Rating	5	BORDER BRIDGE INFORMATION		
71	Waterway Adeq. App. Rating	N	98	Neighboring State Code	
72	Approach Road App. Rating	8	98B	Neighboring State % Respon	
113	Scour Assess App. Rating	N	99	Neighboring State Struc. No.	
APPROVED POSTING INFORMATION			FIELD POSTING INFORMATION		
Approved Posting Category S-1			Field Posting Category S-1		
Ton1 Ton2 Ton3			Ton1 Ton2 Ton3		
Tonnage Values for Posting Sign			Tonnage Values for Posting Sign		
General Text for Posting Sign			General Text for Posting Sign		
NO POSTING REQUIRED			NO POSTING REQUIRED		

Design_No = 10655



Missouri Department of Transportation
Bridge Inventory and Inspection System
Structural Inventory & Appraisal Sheet

October 1, 2024
3:59:42pm

COUNTY : CLAY BRIDGE : L0655 2 REVIEW STATUS : APPROVED NBI STATUS : T
RECORD TYPE : 1 RTE THAT GOES 'UNDER' S RUN DATE : 9/30/2024 SUBMITTAL YEAR : 2024

GENERAL STRUCTURE INFORMATION			ROUTE DESIGNATION INFORMATION		
1	State	MISSOURI	5A	Record Type	1 RTE THAT GOES 'UNDER' S Code : A
2	District	KC	5B	Route Signing Prefix	IS
3	County	CLAY	5C	Designated Level of Service	MAINLINE
8	Federal ID No.	6409	5D	Route Number	00035
27	Year Built	1954	5E	Directional Suffix	NOT APPLICABLE
106	Year Reconstructed	0	7	Facility Carried	N BRIGHTON AVE S
42A	Type of Service On	HIGHWAY-PEDESTRIAN	12	Base Hwy. Network	
21	Structure Maintenance		13A	LRS Inventory Route No.	
22	Structure Owner		13B	Subroute No.	
33	Br. Median Code		20	Toll Status	ON FREE ROAD
37	Historical Significance		26	Functional Classification	11-UR PRNCPL ARTERIAL-IS
101	Parallel Struc Desg	NONE EXISTS	28A	Lanes on Structure	04
103	Temporary Structure	NOT TEMPORARY	100	STRAHNET Designation	ON A DEFENSE HWY
112	NBIS Bridge Length		104	National Highway System	ON NHS
			105	Federal Lands Highway	
			110	Designated Nat. Network	YES
STRUCTURE LOCATION INFORMATION			STRUCTURE TRAFFIC INFORMATION		
4	Place	KANSAS CITY CITY	29	AADT	33788
	Code	38000	30	AADT Year	2023
9	Location	S 32 T 51 N R 32 W	102	Direction of Traffic	1-WAY TRAFFIC
11	Milepoint	104.10 miles	109	AADT Truck Percent	18%
16	Latitude	39 D 11 M 1 S	114	Future AADT	
17	Longitude	94 D 31 M 16 S	115	Future AADT Year	
UNDERRECORD INFORMATION			STRUCTURE GEOMETRIC INFORMATION		
6	Features Intersected	IS 35	10	Inventory Rte. Vert. Clear	16 Ft. 12 In.
42B	Type of Service Under	HIGHWAY	19	By pass Detour Length	0.00 miles
28B	Lanes Under Structure	02	32	Approach Roadway Width	
54A	Vert. Clearance Ref.		34	Skew	
54B	Vert. Clearance		35	Struct. Flared	
55A	Rt. Lat Clear Ref.		47	Total Horiz. Clear	43 Ft. 12 In.
55B	Rt. Lat Clearance		48	Maximum Span Length	69 Ft. 11 In.
56	Left Lat Clearance		49	Structure Length	261 Ft. 2 In.
38	Navigation Control		50A	Left Curb/Sidewalk Width	
39	Nav Vertical Clear		50B	Right Curb/Sidewalk Width	
40	Nav Horizontal Clear		51	Curb to Curb Br. Width	
111	Nav. Pier Protection		52	Deck Width (Out-Out)	
116	Nav. Cl. Vert. Clear		53	Vert. Clearance Over Deck	

Design_No = 10655



Missouri Department of Transportation
Bridge Inventory and Inspection System
Structural Inventory & Appraisal Sheet

October 1, 2024
3:59:42pm

COUNTY : CLAY BRIDGE : L0655 2 REVIEW STATUS : APPROVED NBI STATUS : T
RECORD TYPE : 1 RTE THAT GOES 'UNDER' S RUN DATE : 9/30/2024 SUBMITTAL YEAR : 2024

LOAD RATING AND POSTING INFORMATION		MATERIAL/CONSTRUCTION INFORMATION	
31	Design Load	43A	Main Struc. Mat type STEEL CONTINUOUS
41	Structure Status	43B	Main struc Constr. Type STRINGER/MULTIBEAM - GRD
63	Oper. Rating Meth.	45	# of Main Spans
64	Operating Rating	44A	Appr Struc. Mat type
65	Inventory Rating Meth	44B	Appr Struc. Cnstr. type
66	Inventory Rating	46	# of Approach Span
70	Bridge Posting Code	107	Deck Mat/Constr.
PROPOSED IMPROVEMENT INFORMATION		108A	Wear Surf Mat/Constr.
Sufficiency Rating		108B	Membrane Mat/Constr.
Deficiency Rating		108C	Deck Protect Mat/Constr.
Funding Eligibility		CONDITION RATING INFORMATION	
75A	Proposed Work	58	Deck Cond. Rating
75B	Work Done By	59	Superstructure Cond. Rating
76	New Struc Length	60	Substructure Cond. Rating
94	Struc Improve Cost	61	Channel /Channel Protection Cond. Rating
95	Roadway Improve Cost	62	Culvert Cond. Rating
96	Total Project Cost	INSPECTION INFORMATION	
97	Year of Cost Estimates	90	Gen. Insp Date
APPRAISAL RATING INFORMATION		91	Gen. Insp. Frequency
36A	Br. Rail App. Rating	92A	Frac. Critical Inspection
36B	Transition Rail App. Rating	93A	Frac. Critical Insp. Date
36C	Approach Rail App. Rating	92B	Underwater Inspection
36D	Rail End Treat. App. Rating	93B	Underwater Insp. Date
67	Struc Eval App. Rating	92C	Special Inspection
68	Deck Geometry App. Rating	93C	Special Inspection Date
69	Underclearance App. Rating	BORDER BRIDGE INFORMATION	
71	Waterway Adeq. App. Rating	98	Neighboring State Code
72	Approach Road App. Rating	98B	Neighboring State % Respon
113	Scour Assess App. Rating	99	Neighboring State Struc. No.
APPROVED POSTING INFORMATION		FIELD POSTING INFORMATION	
Approved Posting Category		Field Posting Category	
Ton1 Ton2 Ton3		Ton1 Ton2 Ton3	
Tonnage Values for Posting Sign		Tonnage Values for Posting Sign	
General Text for Posting Sign		General Text for Posting Sign	

Design_No = 10655



Missouri Department of Transportation
Bridge Inventory and Inspection System
Structural Inventory & Appraisal Sheet

October 1, 2024
3:59:42pm

COUNTY : CLAY BRIDGE : L0655 2 REVIEW STATUS : APPROVED NBI STATUS : T
RECORD TYPE : 2ND RTE THAT GOES 'UNDR'S RUN DATE : 9/30/2024 SUBMITTAL YEAR : 2024

GENERAL STRUCTURE INFORMATION			ROUTE DESIGNATION INFORMATION		
1	State	MISSOURI	5A	Record Type	2ND RTE THAT GOES 'UNDR'S Code : B
2	District	KC	5B	Route Signing Prefix	IS
3	County	CLAY	5C	Designated Level of Service	MAINLINE
8	Federal ID No.	6409	5D	Route Number	00035
27	Year Built	1954	5E	Directional Suffix	NOT APPLICABLE
106	Year Reconstructed	0	7	Facility Carried	N BRIGHTON AVE S
42A	Type of Service On	HIGHWAY-PEDESTRIAN	12	Base Hwy. Network	
21	Structure Maintenance		13A	LRS Inventory Route No.	
22	Structure Owner		13B	Subroute No.	
33	Br. Median Code		20	Toll Status	ON FREE ROAD
37	Historical Significance		26	Functional Classification	11-UR PRNCPL ARTERIAL-IS
101	Parallel Struc Desg	NONE EXISTS	28A	Lanes on Structure	04
103	Temporary Structure	NOT TEMPORARY	100	STRAHNET Designation	ON A DEFENSE HWY
112	NBIS Bridge Length		104	National Highway System	ON NHS
			105	Federal Lands Highway	
			110	Designated Nat. Network	YES
STRUCTURE LOCATION INFORMATION			STRUCTURE TRAFFIC INFORMATION		
4	Place	KANSAS CITY CITY	29	AADT	33788
	Code	38000	30	AADT Year	2023
9	Location	S 32 T 51 N R 32 W	102	Direction of Traffic	1-WAY TRAFFIC
11	Milepoint	10.96 miles	109	AADT Truck Percent	18%
16	Latitude	39 D 11 M 1 S	114	Future AADT	
17	Longitude	94 D 31 M 16 S	115	Future AADT Year	
UNDERRECORD INFORMATION			STRUCTURE GEOMETRIC INFORMATION		
6	Features Intersected	IS 35	10	Inventory Rte. Vert. Clear	17 Ft. 3 In.
42B	Type of Service Under	HIGHWAY	19	By pass Detour Length	0.00 miles
28B	Lanes Under Structure	02	32	Approach Roadway Width	
54A	Vert. Clearance Ref.		34	Skew	
54B	Vert. Clearance		35	Struct. Flared	
55A	Rt. Lat Clear Ref.		47	Total Horiz. Clear	43 Ft. 12 In.
55B	Rt. Lat Clearance		48	Maximum Span Length	69 Ft. 11 In.
56	Left Lat Clearance		49	Structure Length	261 Ft. 2 In.
38	Navigation Control		50A	Left Curb/Sidewalk Width	
39	Nav Vertical Clear		50B	Right Curb/Sidewalk Width	
40	Nav Horizontal Clear		51	Curb to Curb Br. Width	
111	Nav. Pier Protection		52	Deck Width (Out-Out)	
116	Nav. Cl. Vert. Clear		53	Vert. Clearance Over Deck	

Design_No = 10655




Missouri Department of Transportation
Bridge Inventory and Inspection System
Structural Inventory & Appraisal Sheet

October 1, 2024
3:59:42pm

COUNTY : CLAY BRIDGE : L0655 2 REVIEW STATUS : APPROVED NBI STATUS : T
RECORD TYPE : 2ND RTE THAT GOES 'UNDR'S RUN DATE : 9/30/2024 SUBMITTAL YEAR : 2024

LOAD RATING AND POSTING INFORMATION		MATERIAL/CONSTRUCTION INFORMATION	
31	Design Load	43A	Main Struc. Mat type STEEL CONTINUOUS
41	Structure Status	43B	Main struc Constr. Type STRINGER/MULTIBEAM - GRD
63	Oper. Rating Meth.	45	# of Main Spans
64	Operating Rating	44A	Appr Struc. Mat type
65	Inventory Rating Meth	44B	Appr Struc. Cnstr. type
66	Inventory Rating	46	# of Approach Span
70	Bridge Posting Code	107	Deck Mat/Constr.
PROPOSED IMPROVEMENT INFORMATION		108A	Wear Surf Mat/Constr.
Sufficiency Rating		108B	Membrane Mat/Constr.
Deficiency Rating		108C	Deck Protect Mat/Constr.
Funding Eligibility		CONDITION RATING INFORMATION	
75A	Proposed Work	58	Deck Cond. Rating
75B	Work Done By	59	Superstructure Cond. Rating
76	New Struc Length	60	Substructure Cond. Rating
94	Struc Improve Cost	61	Channel /Channel Protection Cond. Rating
95	Roadway Improve Cost	62	Culvert Cond. Rating
96	Total Project Cost	INSPECTION INFORMATION	
97	Year of Cost Estimates	90	Gen. Insp Date
APPRAISAL RATING INFORMATION		91	Gen. Insp. Frequency
36A	Br. Rail App. Rating	92A	Frac. Critical Inspection
36B	Transition Rail App. Rating	93A	Frac. Critical Insp. Date
36C	Approach Rail App. Rating	92B	Underwater Inspection
36D	Rail End Treat. App. Rating	93B	Underwater Insp. Date
67	Struc Eval App. Rating	92C	Special Inspection
68	Deck Geometry App. Rating	93C	Special Inspection Date
69	Underclearance App. Rating	BORDER BRIDGE INFORMATION	
71	Waterway Adeq. App. Rating	98	Neighboring State Code
72	Approach Road App. Rating	98B	Neighboring State % Respon
113	Scour Assess App. Rating	99	Neighboring State Struc. No.
APPROVED POSTING INFORMATION		FIELD POSTING INFORMATION	
Approved Posting Category		Field Posting Category	
Ton1 Ton2 Ton3		Ton1 Ton2 Ton3	
Tonnage Values for Posting Sign		Tonnage Values for Posting Sign	
General Text for Posting Sign		General Text for Posting Sign	


Design_No = 10655


		Missouri Department of Transportation				October 01, 2024	
		State Bridge Inspection Report				3:52:35PM	
COUNTY: CLAY		DISTRICT: KC		CLASS: STATBR		FED-ID: 6401	
						BRIDGE: L0642	
GENERAL STRUCTURE INFORMATION						***BRIDGE INSPECTION INFORMATION***	
ROUTE: IS35N FEATURE: CST CHOUTEAU TRFY STATUS: A-OPEN LOG MILE: 9.831 DETOUR: 1.00 MILES NHS: YES BUILT: 1954 REHAB: 1989 LOCATION: S 6 T 50 R 32 W LATITUDE: 39 10 26.83 (DMS) LONGITUDE: 94 32 12.21 (DMS)		# SPANS: 3 LANES ON: 2 LANES UNDER: 4 COMPASS DIRECTION: WEST to EAST DIRECTION OF TRAFFIC: 1-WAY TRAF FUNCTIONAL CLASS: UR-INTERSTATE NBI OWNER: MODOT NBI MAINTAINED: MODOT MAINTENANCE DISTRICT: KC MAINTENANCE COUNTY: CLAY SUB AREA: 7C25		PLACE CODE: 02800 AVONDALE CITY LENGTH: 149 FT 0 IN MAXIMUM SPAN: 66 FT 9 IN APPROACH ROADWAY: 48 FT 0 IN CURB TO CURB: 40 FT 0 IN OUT TO OUT: 42 FT 8 IN AADT: 36619 AADT YEAR: 2023 AADT TRUCK: 18.4% FUTURE AADT: 65914 FUTURE AADT YEAR: 2043		DATE: 09/03/2024 RESPONSIBILITY: DISTRICT FREQUENCY: 24 CALCULATED INTERVAL**: TEAM LEADER: JARED YOST ELEMENT: YES INSPECTOR 2: INSPECTOR 4: INSPECTOR 3: ** When calculated interval exceeds the frequency, a justification comment per BIRM is required.	
						GENERAL INSPECTION COMMENTS	
FRACTURE CRITICAL INSPECTION INFORMATION				***INDEPTH INSPECTION INFORMATION***			
DATE: RESPONSIBILITY: CATEGORY: FREQUENCY: CALCULATED INTERVAL**: TEAM LEADER: INSPECTOR 3: NBI: INSPECTOR 2: INSPECTOR 4: METHOD: ** When calculated interval exceeds the frequency, a justification comment per BIRM is required.				DATE: RESPONSIBILITY: CATEGORY: FREQUENCY: CALCULATED INTERVAL**: TEAM LEADER: INSPECTOR 3: NBI: INSPECTOR 2: INSPECTOR 4: METHOD: ** When calculated interval exceeds the frequency, a justification comment per BIRM is required.			
FRACTURE CRITICAL INSPECTION COMMENTS				INDEPTH INSPECTION COMMENTS			
SPECIAL INSPECTION INFORMATION				***UNDERWATER INSPECTION INFORMATION***			
DATE: RESPONSIBILITY: CATEGORY: FREQUENCY: CALCULATED INTERVAL**: TEAM LEADER: INSPECTOR 3: NBI: INSPECTOR 2: INSPECTOR 4: METHOD: ** When calculated interval exceeds the frequency, a justification comment per BIRM is required.				DATE: RESPONSIBILITY: CATEGORY: FREQUENCY: CALCULATED INTERVAL**: TEAM LEADER: INSPECTOR 3: NBI: INSPECTOR 2: INSPECTOR 4: METHOD: ** When calculated interval exceeds the frequency, a justification comment per BIRM is required.			
SPECIAL INSPECTION COMMENTS				UNDERWATER INSPECTION COMMENTS			
OTHER SPECIAL INSPECTIONS				OTHER UNDERWATER INSPECTIONS			
<u>DATE</u> <u>FREQUENCY</u> <u>CATEGORY</u> <u>NBI</u> <u>CALCULATED INTERVAL</u> <u>RESPONSIBILITY</u> <u>METHOD</u>				<u>DATE</u> <u>FREQUENCY</u> <u>CATEGORY</u> <u>NBI</u> <u>CALCULATED INTERVAL</u> <u>RESPONSIBILITY</u> <u>METHOD</u>			


Design_No = L0642


Page 1


This report contains information that is protected from disclosure by federal law, 23 USC Section 409 and the Missouri Open Records Law (Sunshine Act), Section 610.021 RSMo. Please review MoDOT's policy and procedure manual on the Sunshine Act before releasing any of the information contained herein.


		Missouri Department of Transportation			October 01, 2024																	
		State Bridge Inspection Report			3:52:35PM																	
COUNTY: CLAY		DISTRICT: KC		CLASS: STATBR	FED-ID: 6401	BRIDGE: L0642																
STRUCTURE POSTING																						
APPROVED CATEGORY: S-1 NO POSTING REQUIRED																						
Ton 1: Ton 2: Ton 3:																						
COMMENTS: (HOLZBJ, 01/03/2013)--LOAD POSTING LETTER 1/3/2013, MODOT.																						
FIELD CATEGORY: S-1 NO POSTING REQUIRED																						
Ton 1: Ton 2: Ton 3: PROBLEM: PROBLEM DIRECTION:																						
COMMENTS:																						
GENERAL COMMENTS/MAJOR RATED ITEMS																						
GENERAL COMMENTS: (BOWDEJ1, 09/30/2008)--(41'-66'-41') CONT COMP WF GDR SPANS																						
[ITEM 58] DECK: 6-SATISFACTORY CONDITION COMMENTS: (OTISL1, 09/30/2014)--T-CRACKS																						
RATING : 05/18/2001																						
[ITEM 59] SUPER: 5-FAIR CONDITION COMMENTS: (BATUSJ1, 09/19/2012)--UNTIL REPAIRS ARE MADE TO BEARING																						
RATING : 09/19/2012																						
[ITEM 60] SUB: 5-FAIR CONDITION COMMENTS: (OTISL1, 09/30/2014)--ABUTMENT CAPS SPALLING																						
RATING : 01/12/2011																						
[ITEM 61] BANK/CHANNEL: N-NOT APPLIC NO WATRWAY COMMENTS:																						
RATING : 05/18/2001																						
[ITEM 113] SCOUR: N-NOT APPLIC NOT WATERW COMMENTS:																						
RATING : 05/18/2001																						
EVALUATION TYPE :																						
[ITEM 71] WATERWAY ADEQUACY: NOT APPLICABLE COMMENTS:																						
RATING : 05/18/2001																						
[ITEM 72] APPRRDWY ALIGNMENT: 8-VERYGOOD COMMENTS:																						
RATING : 05/18/2001																						
RAILING AND APPROACH PAVEMENT COMPONENTS AND RATINGS																						
[ITEM 36A] BRIDGE RAILING RATING: MEETS CURRENT STANDARDS-1 RATING : 05/18/2001 COMMENTS:																						
<table><tr><td><u>MATERIAL</u></td><td><u>CONSTRUCTION</u></td><td><u>DIRECTION</u></td><td><u>COMMENTS</u></td></tr><tr><td>REINFORCED CONCRETE</td><td>SAFETY BARRIER CURB</td><td>BOTH</td><td></td></tr><tr><td><u>CONDITION</u></td><td><u>LOCATION 1</u></td><td><u>LOCATION 2</u></td><td><u>SEVERITY</u></td></tr><tr><td>VERTICAL CRACKS</td><td>THROUGHOUT</td><td></td><td>FEW</td></tr></table>							<u>MATERIAL</u>	<u>CONSTRUCTION</u>	<u>DIRECTION</u>	<u>COMMENTS</u>	REINFORCED CONCRETE	SAFETY BARRIER CURB	BOTH		<u>CONDITION</u>	<u>LOCATION 1</u>	<u>LOCATION 2</u>	<u>SEVERITY</u>	VERTICAL CRACKS	THROUGHOUT		FEW
<u>MATERIAL</u>	<u>CONSTRUCTION</u>	<u>DIRECTION</u>	<u>COMMENTS</u>																			
REINFORCED CONCRETE	SAFETY BARRIER CURB	BOTH																				
<u>CONDITION</u>	<u>LOCATION 1</u>	<u>LOCATION 2</u>	<u>SEVERITY</u>																			
VERTICAL CRACKS	THROUGHOUT		FEW																			
[ITEM 36B] TRANSITION RAILING RATING: MEETS CURRENT STANDARDS-1 RATING : 09/26/2016 COMMENTS:																						
<table><tr><td><u>MATERIAL</u></td><td><u>CONSTRUCTION</u></td><td><u>DIRECTION</u></td><td><u>COMMENTS</u></td></tr><tr><td>GALVANIZED STEEL</td><td>THRIE BEAM TO W-BEAM</td><td>BOTH-WEST</td><td></td></tr></table>							<u>MATERIAL</u>	<u>CONSTRUCTION</u>	<u>DIRECTION</u>	<u>COMMENTS</u>	GALVANIZED STEEL	THRIE BEAM TO W-BEAM	BOTH-WEST									
<u>MATERIAL</u>	<u>CONSTRUCTION</u>	<u>DIRECTION</u>	<u>COMMENTS</u>																			
GALVANIZED STEEL	THRIE BEAM TO W-BEAM	BOTH-WEST																				
[ITEM 36C] APPROACH RAILING RATING: MEETS CURRENT STANDARDS-1 RATING : 05/18/2001 COMMENTS:																						
<table><tr><td><u>MATERIAL</u></td><td><u>CONSTRUCTION</u></td><td><u>DIRECTION</u></td><td><u>COMMENTS</u></td></tr><tr><td>GALVANIZED STEEL</td><td>W-BEAM</td><td>BOTH-WEST</td><td></td></tr></table>							<u>MATERIAL</u>	<u>CONSTRUCTION</u>	<u>DIRECTION</u>	<u>COMMENTS</u>	GALVANIZED STEEL	W-BEAM	BOTH-WEST									
<u>MATERIAL</u>	<u>CONSTRUCTION</u>	<u>DIRECTION</u>	<u>COMMENTS</u>																			
GALVANIZED STEEL	W-BEAM	BOTH-WEST																				
[ITEM 36D] RAIL END TREATMENT RATING: MEETS CURRENT STANDARDS-1 RATING : 01/12/2011 COMMENTS:																						
Design_No = L0642																						
Page 2																						
This report contains information that is protected from disclosure by federal law, 23 USC Section 409 and the Missouri Open Records Law (Sunshine Act), Section 610.021 RSMo. Please review MoDOT's policy and procedure manual on the Sunshine Act before releasing any of the information contained herein.																						

		Missouri Department of Transportation				October 01, 2024	
		State Bridge Inspection Report				3:52:35PM	
COUNTY: CLAY		DISTRICT: KC		CLASS: STATBR		FED-ID: 6401	
				BRIDGE: L0642			
<u>MATERIAL</u> GALVANIZED STEEL		<u>CONSTRUCTION</u> BREKAWAY SYSTEM		<u>DIRECTION</u> BOTH-WEST		<u>COMMENTS</u>	
APPROACH PAVEMENT: *Overall condition assigned for each approach pavemenet component is shown below.							
<u>MATERIAL</u> REINFORCED CONCRETE		<u>CONSTRUCTION</u> SLAB		<u>DIRECTION</u> BOTH		<u>CONDITION*</u> FAIR	
<u>COMMENTS</u> (OTISL1, 10/09/2018)--ASPHALT WEARING SURFACE: 2018							
<u>CONDITION</u> SPALLS		<u>LOCATION 1</u> ENDS		<u>LOCATION 2</u>		<u>SEVERITY</u> FEW	
DRAINAGE, EXPANSION DEVICES, BANK/SLOPE, AND DECK PROTECTIVE COMPONENTS							
<u>DECK PROTECTIVE COMPONENTS:</u>							
<u>SERIES TYPE-#</u> MAIN SERIES-1		<u>COMPONENT</u> WEARING SURFACE		<u>MATERIAL</u> PLAIN CONCRETE		<u>CONSTRUCTION</u> MONOLITHIC	
<u>THICKNESS</u>		<u>YEAR APPLIED</u>		<u>MANUFACTURE</u>		<u>OVERALL CONDITION</u>	
<u>COMMENT:</u>							
		<u>DECK PROTECTION</u>		<u>EPOXY POLYMER</u>		<u>COATED REBAR</u>	
<u>COMMENT:</u>							
		<u>MEMBRANE</u>		<u>NOTAPPLICABLE</u>		<u>NONE</u>	
<u>COMMENT:</u>							
		<u>SECONDARY DECK PROTECTION</u>		<u>LIQUID SEALANT</u>		<u>INTERNALLY SEALED</u>	
<u>COMMENT:</u>							
<u>DRAINAGE COMPONENTS:</u>							
<u>COMPONENT</u>		<u>MATERIAL</u>		<u>CONSTRUCTION</u>		<u>DIRECTION</u>	
						<u>COMMENTS</u>	
<u>EXPANSION DEVICE COMPONENTS:</u>							
<u>SUB UNIT-#</u> ABUTMENT-1		<u>SUB LABEL</u>		<u>COMPONENT</u> CLOSED EXPANSION JOINT		<u>MATERIAL</u> ELASTOMERIC	
<u>CONSTRUCTION</u> COMPRESSION SEAL		<u>GAP</u>		<u>YEAR APPLIED</u>		<u>MANUFACTURE</u> XJS JOINT	
<u>OVERALL CONDITION</u> POOR							
<u>COMMENT:</u>							
<u>BANK/SLOPE PROTECTION COMPONENTS:</u>							
<u>COMPONENT</u> SLOPE PROTECTION		<u>MATERIAL</u> PLAIN CONCRETE		<u>CONSTRUCTION</u> PAVEDSLOPE		<u>DIRECTION</u> BOTH	
						<u>COMMENTS</u>	
DECK COMPONENTS							
<u>SPAN TYPE-#</u> MAIN SPANS-1		<u>COMPONENT</u> DECK		<u>MATERIAL</u> REINFORCED CONCRETE		<u>CONSTRUCTION</u> CAST-IN-PLACE	
<u>COMMENTS</u> (BATUSJ1, 10/01/2012)--D.L. DROP 1.5" OVER GIRDER 3-4							
<u>CONDITION</u> EFFLORESCENCE		<u>LOCATION 1</u> THROUGHOUT		<u>LOCATION 2</u>		<u>SEVERITY</u> MEDIUM	
<u>SCALING</u>		<u>DRIVING SURFACE</u>				<u>MEASUREMENT</u> LIGHT	
<u>SPALLS</u>		<u>LONGITUDINAL JOINT</u>				<u>COMMENT</u> MINOR	
<u>TRANSVERSE CRACKS</u>		<u>THROUGHOUT</u>				<u>MANY</u>	
<u>MAIN SPANS-2</u>		<u>DECK</u>		<u>REINFORCED CONCRETE</u>		<u>CAST-IN-PLACE</u>	
<u>CONDITION</u>		<u>LOCATION 1</u>		<u>LOCATION 2</u>		<u>SEVERITY</u>	
						<u>MEASUREMENT</u>	
						<u>COMMENT</u>	
Design_No = L0642							
Page 3							
This report contains information that is protected from disclosure by federal law, 23 USC Section 409 and the Missouri Open Records Law (Sunshine Act), Section 610.021 RSMo. Please review MoDOT's policy and procedure manual on the Sunshine Act before releasing any of the information contained herein.							

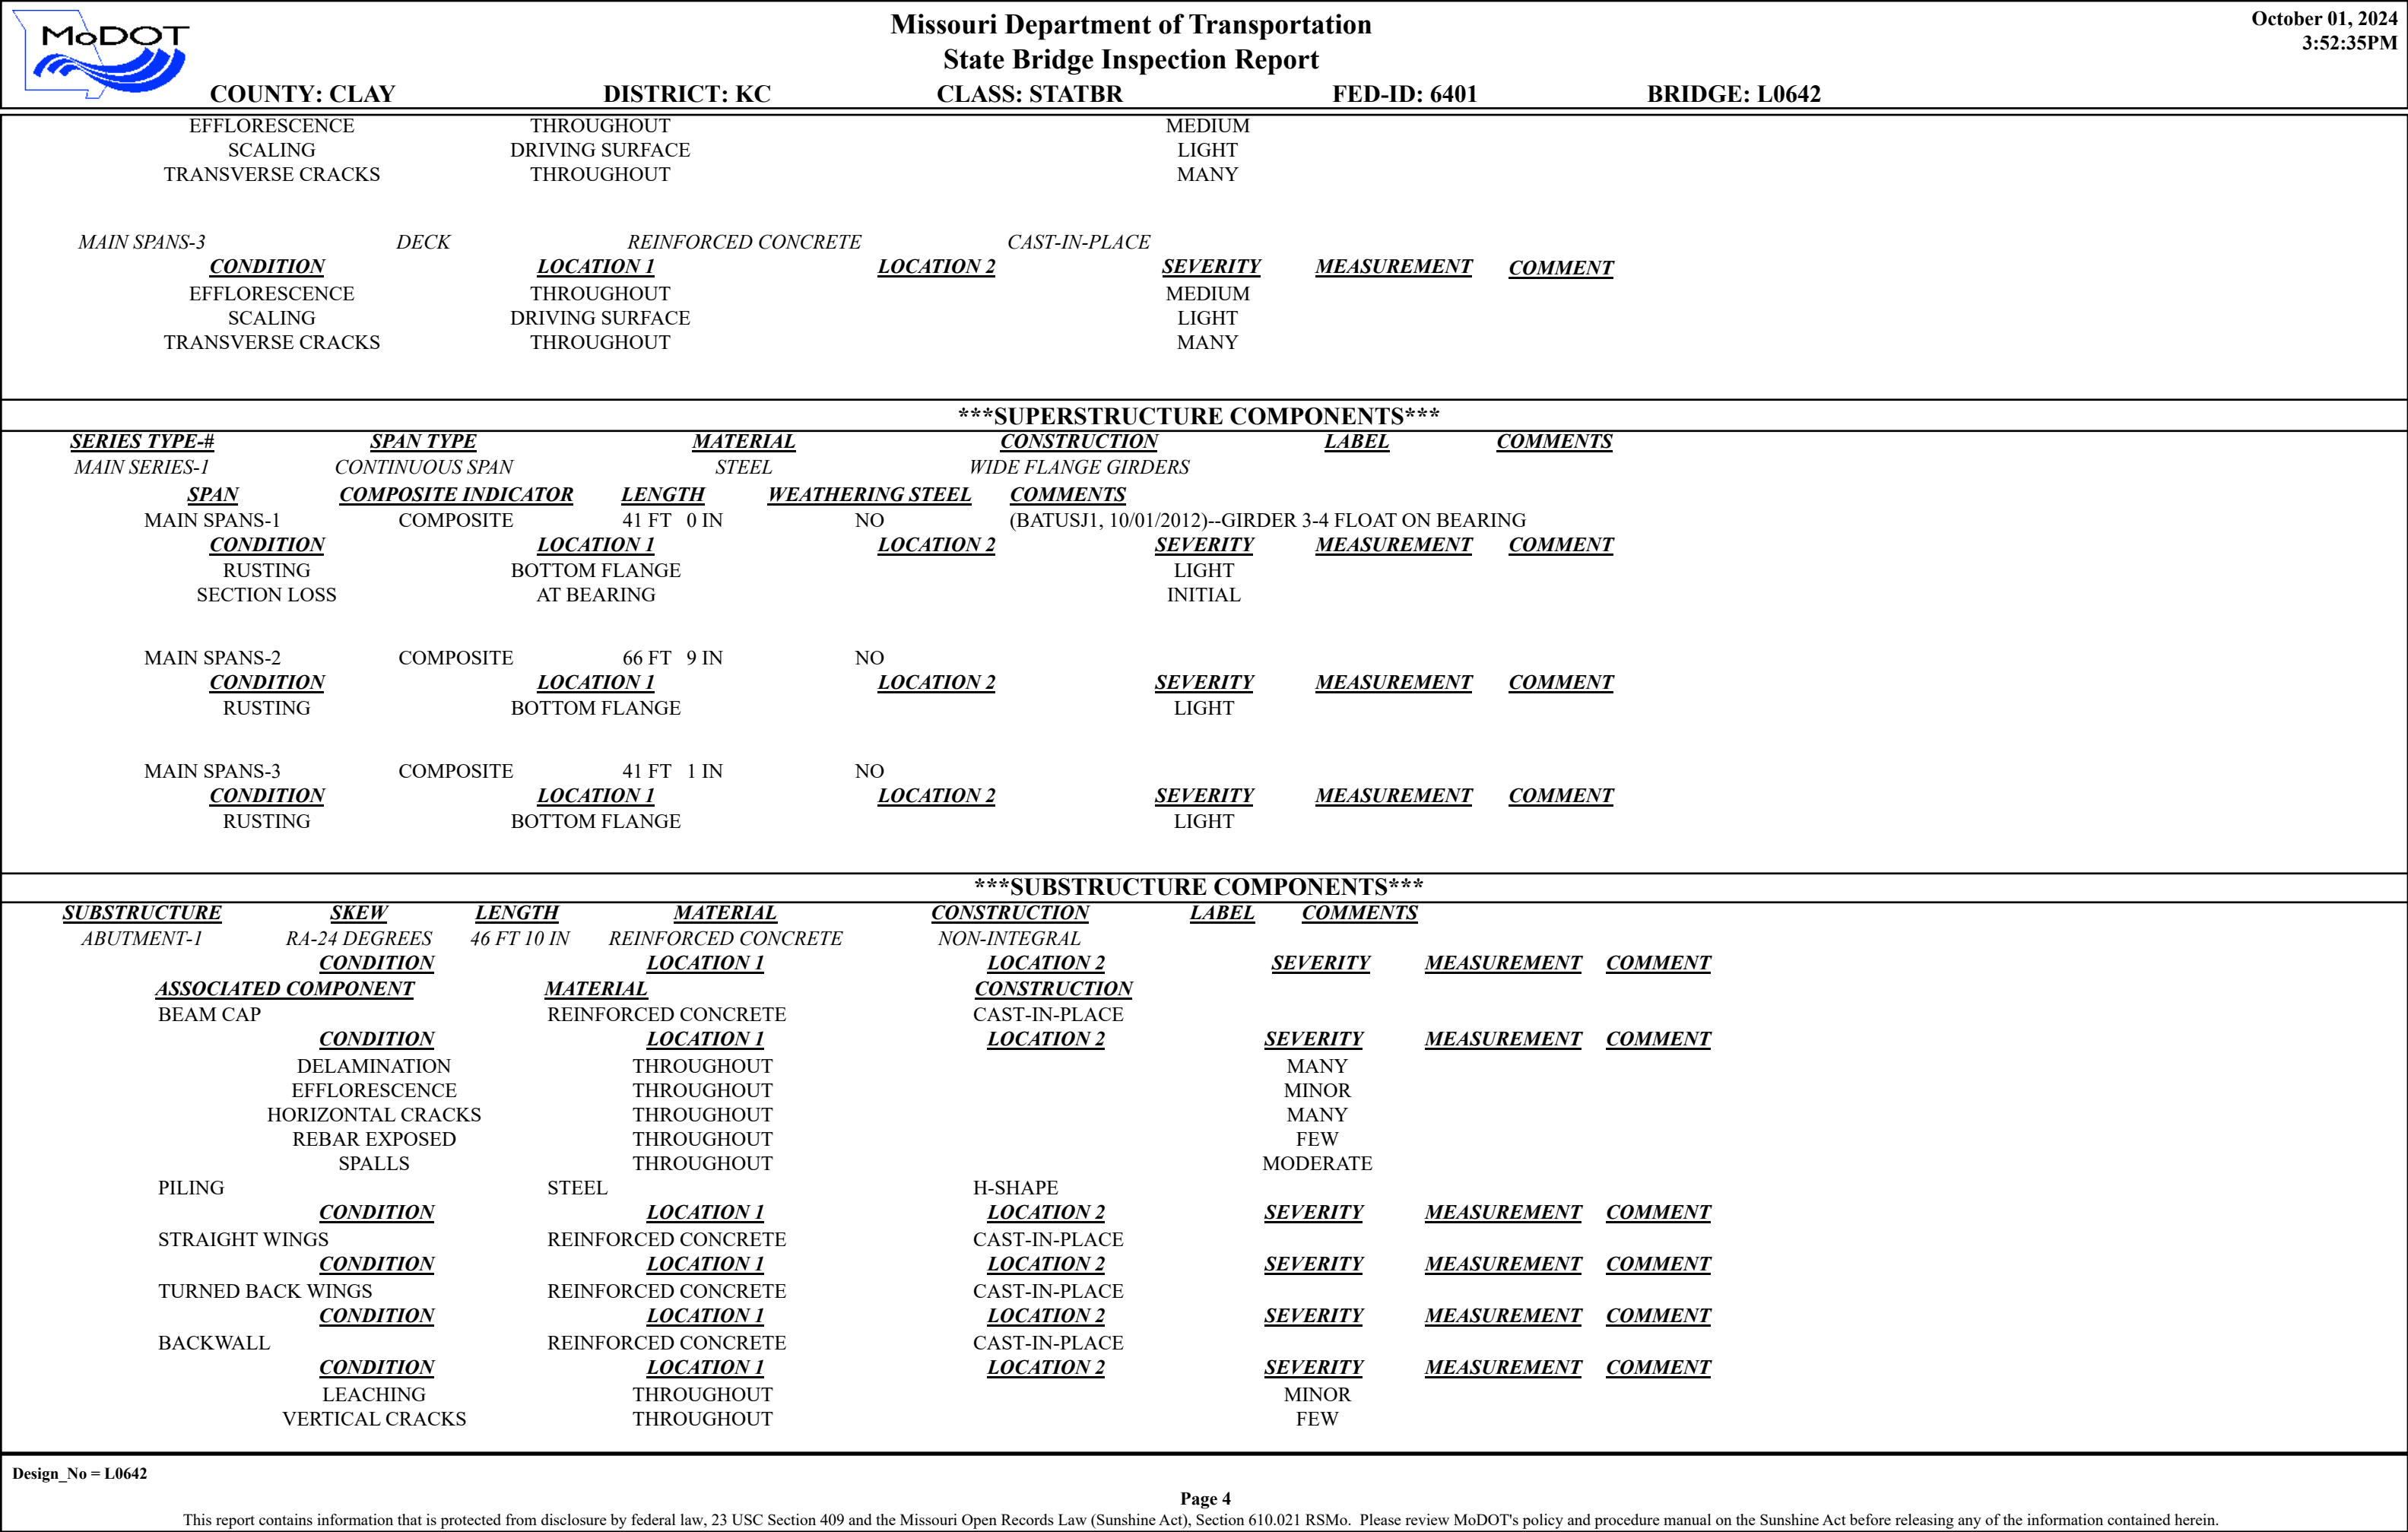

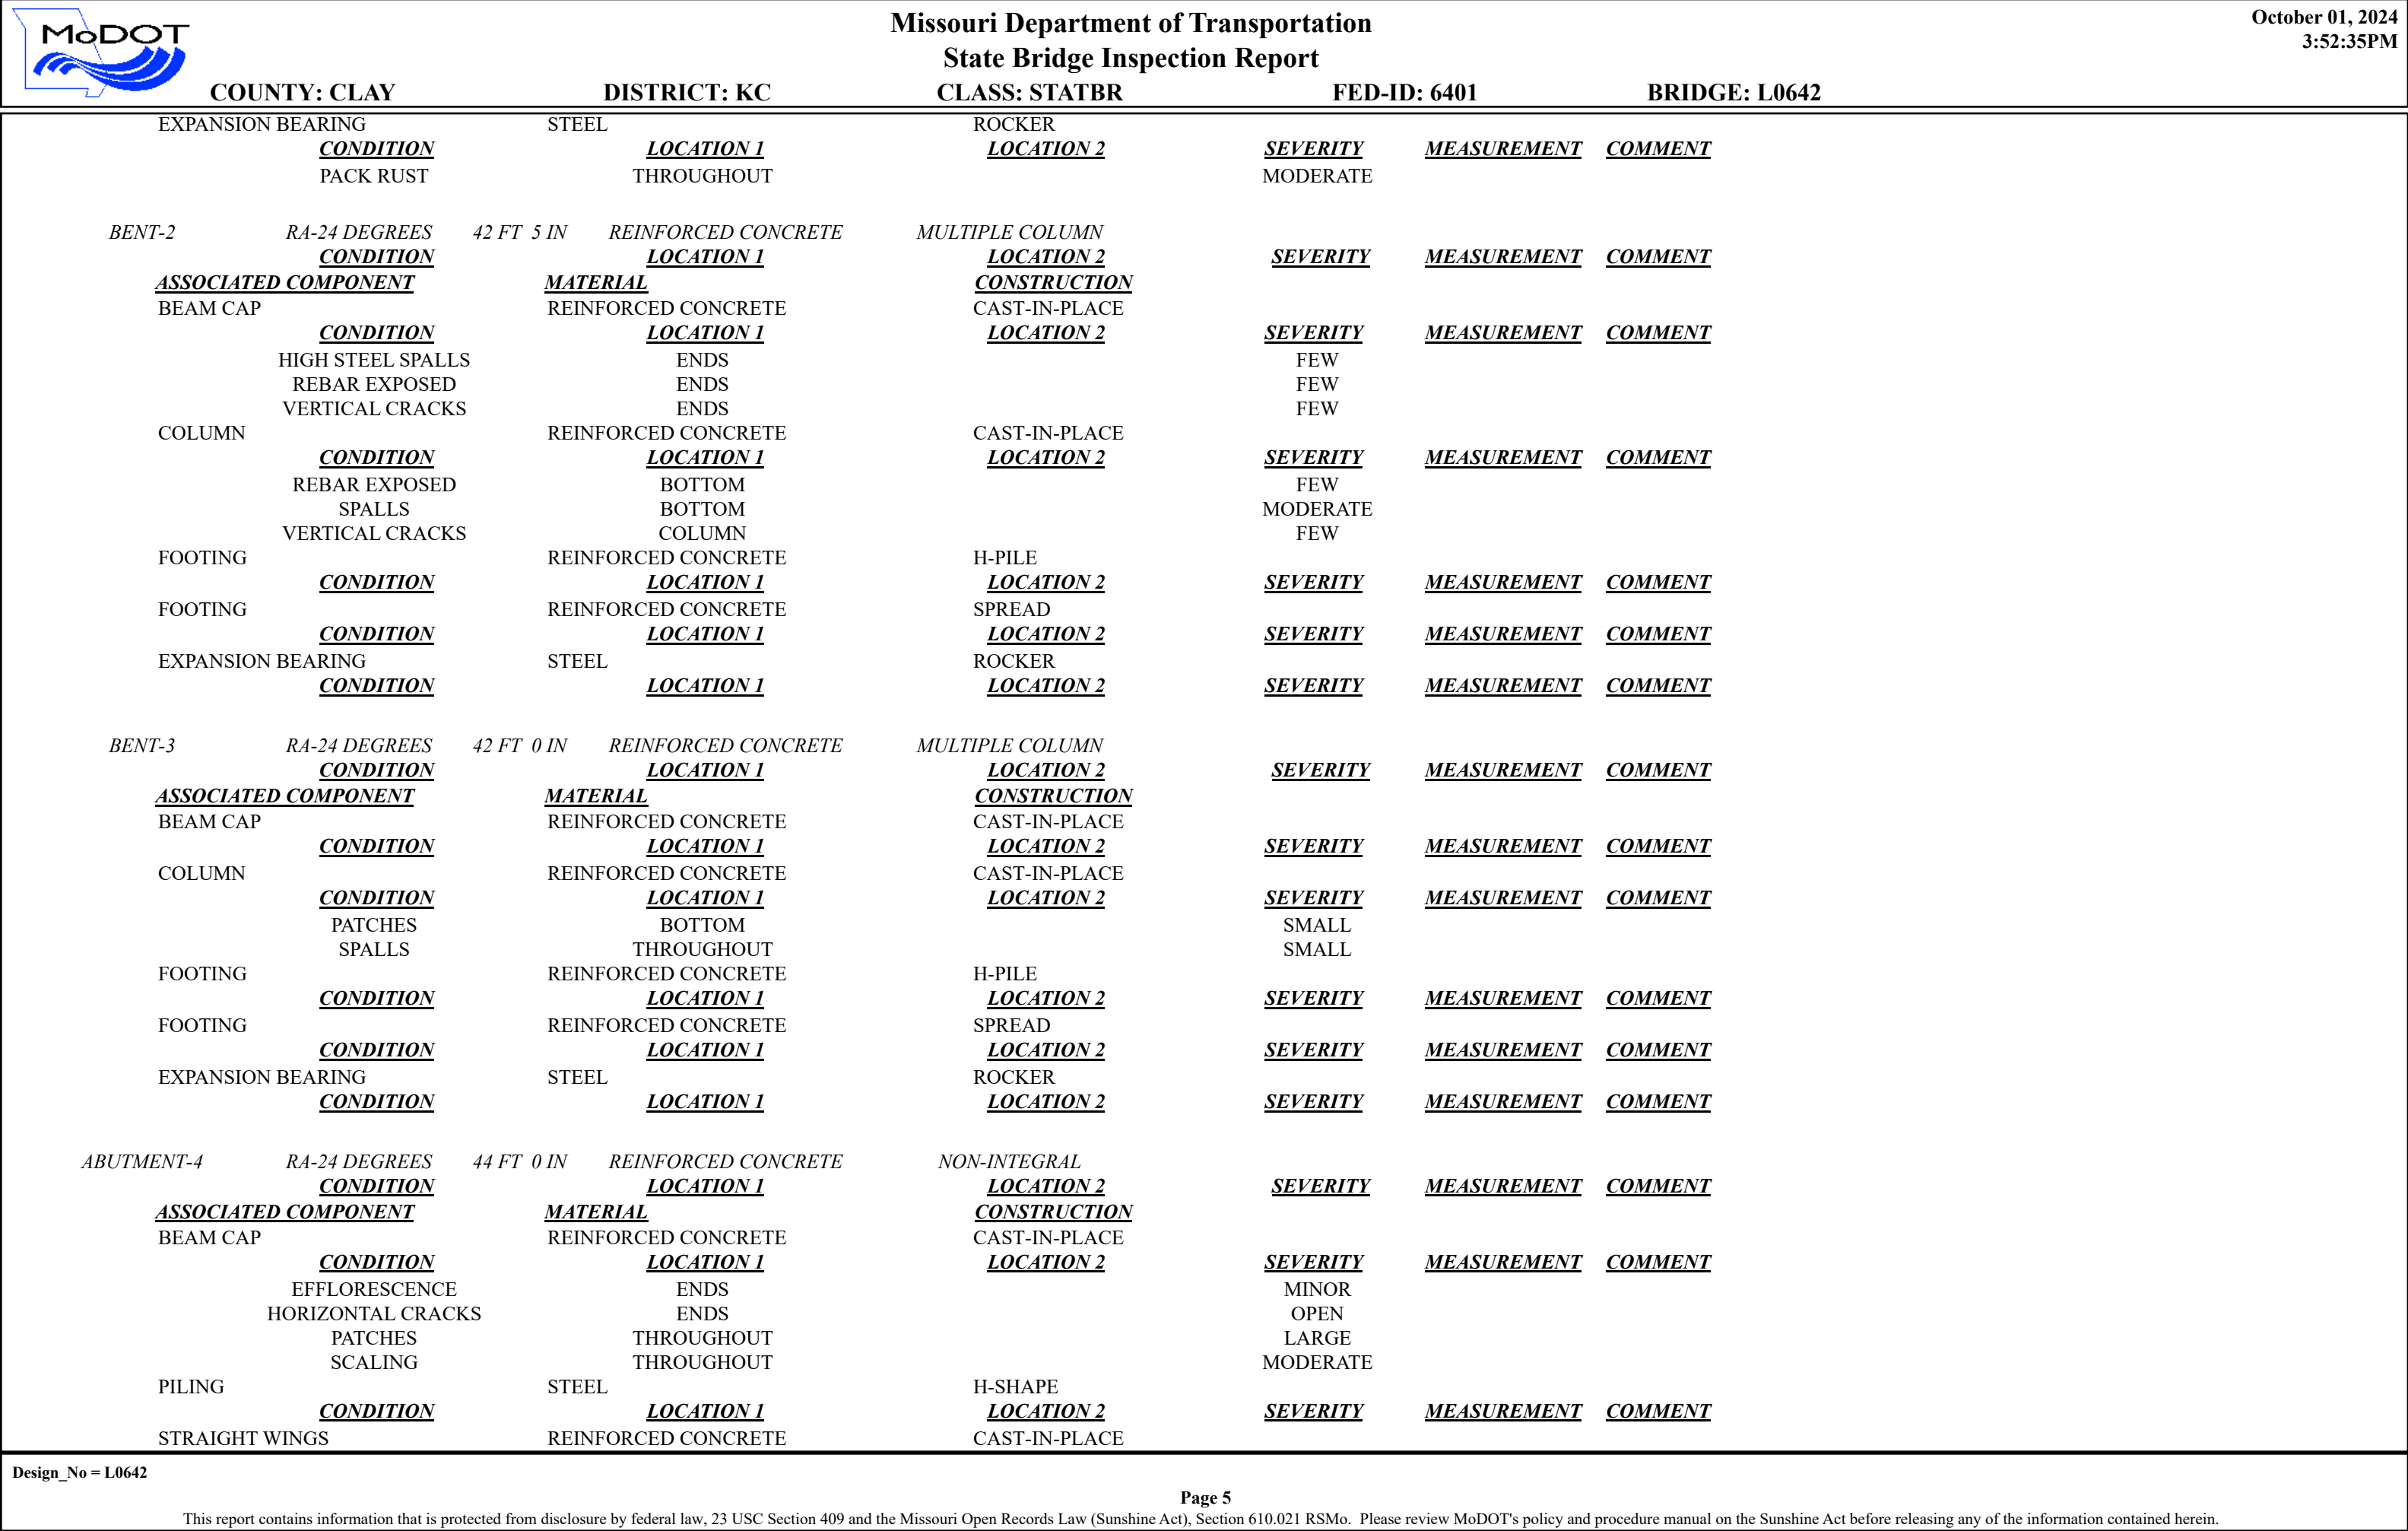

		Missouri Department of Transportation			October 01, 2024	
		State Bridge Inspection Report			3:52:35PM	
COUNTY: CLAY		DISTRICT: KC	CLASS: STATBR	FED-ID: 6401	BRIDGE: L0642	
<div>CONDITION</div> <div>TURNED BACK WINGS</div> <div>CONDITION</div> <div>BACKWALL</div> <div>CONDITION</div> <div>DELAMINATION</div> <div>LEACHING</div> <div>REBAR EXPOSED</div> <div>SPALLS</div> <div>VERTICAL CRACKS</div> <div>EXPANSION BEARING</div> <div>CONDITION</div> <div>PACK RUST</div>		<div>LOCATION 1</div> <div>REINFORCED CONCRETE</div> <div>LOCATION 1</div> <div>REINFORCED CONCRETE</div> <div>LOCATION 1</div> <div>THROUGHOUT</div> <div>THROUGHOUT</div> <div>THROUGHOUT</div> <div>THROUGHOUT</div> <div>THROUGHOUT</div> <div>STEEL</div> <div>LOCATION 1</div> <div>BOTTOM</div>	<div>LOCATION 2</div> <div>CAST-IN-PLACE</div> <div>LOCATION 2</div> <div>CAST-IN-PLACE</div> <div>LOCATION 2</div> <div></div> <div></div> <div></div> <div>ROCKER</div> <div>LOCATION 2</div> <div></div>	<div>SEVERITY</div> <div></div> <div>SEVERITY</div> <div></div> <div>SEVERITY</div> <div>MODERATE</div> <div>MINOR</div> <div>FEW</div> <div>MODERATE</div> <div>FEW</div> <div>SEVERITY</div> <div>MINOR</div>	<div>MEASUREMENT</div> <div></div> <div>MEASUREMENT</div> <div></div> <div>MEASUREMENT</div> <div></div> <div></div> <div></div> <div></div> <div></div> <div>MEASUREMENT</div> <div></div>	<div>COMMENT</div> <div></div> <div>COMMENT</div> <div></div> <div>COMMENT</div> <div></div> <div></div> <div></div> <div></div> <div></div> <div>COMMENT</div> <div></div>
OVER/UNDER ROUTES CLEARANCE INFORMATION						
CLEARANCES OVER DECK		**NOTE: Vertical clearances for permitting purposes are taken as 2 inches less than the actual field measured clearance.				
VERTICAL CLEARANCE TYPE**		VALUE	DIRECTION	DATE	COMMENT	
CLEARANCES UNDER BRIDGE		**NOTE: Vertical clearances for permitting purposes are taken as 2 inches less than the actual field measured clearance.				
RECORD #	ROUTE	# LANES	DIRECTION OF TRAFFIC	RIGHT LATERAL CLEARANCE	LEFT LATERAL CLEARANCE	UR-ID
1	CST CHOUTEAU TRFY S	4	2-WAY TRAF	6 FT 5 IN		14165
VERTICAL CLEARANCE TYPE**		VALUE	DIRECTION	DATE	COMMENT	
ACTUAL		16 FT 0 IN				
STRUCTURE PAINT INFORMATION						
CONDITION: FAIR		RUST AMOUNT : 6=1.0% OF SURFACE RUSTED		STEEL TONS : 60		
ORIGINAL PAINT		CONTRACT REPAINT		DEPARTMENT REPAINT		
PAINT TYPE :		PAINT TYPE : C SYSTEM		PAINT TYPE :		MANUFACTURE :
NAME :		NAME : INORGANIC ZINC/VINYL		NAME :		SURFACE PREP :
PAINT COLOR :		PAINT COLOR : GREEN		PAINT COLOR :		
PAINT YEAR :		PAINT YEAR : 1990		PAINT YEAR :		
MILS :		MILS : 7		MILS :		
REQUESTED WORK ITEMS						
Design_No = L0642						
Page 6						
This report contains information that is protected from disclosure by federal law, 23 USC Section 409 and the Missouri Open Records Law (Sunshine Act), Section 610.021 RSMo. Please review MoDOT's policy and procedure manual on the Sunshine Act before releasing any of the information contained herein.						

		Missouri Department of Transportation				October 01, 2024	
		State Bridge Inspection Report				3:52:35PM	
COUNTY: CLAY		DISTRICT: KC		CLASS: STATBR		FED-ID: 6401	
						BRIDGE: L0642	
GENERAL WORK COMMENTS:							
RESPONSIBILITY		LOCATION		ITEM		CATEGORY	
DISTRICT SPECIAL		SEE COMMENT		REPLACE EXPANSION DEVICE		EXPANSION DEVICE	
DISTRICT SPECIAL				SEAL DECK WITH IN DECK		DECK	
				PRIORITY		DATE	
				3		09/28/2020	
				3		04/03/2029	
						WORK ITEM COMMENT	
						(OTISL1, 10/01/2020)--REPLACE/REPAIR EXPANSION JOINTS & CHECK BEARINGS UNDER JOINT	
UTILITY ATTACHMENTS							
UTILITY		OWNER		METHOD		MEASUREMENT TYPE	
STRUCTURAL SIGN				MOUNTED			
				VALUE		NUMBER	
						1	
						UTILITY ATTACHMENT COMMENT	
PROGRAM NOTES INFORMATION							
YEAR		PROJECT #		MONTH LET		YEAR LET	
						ITEMS	
						COMMENT	
COMPUTER GENERATED RATINGS AND DEFICIENCY ITEMS				***ADVANCED SIGN INFORMATION***			
NOTE: The items listed in this section are updated whenever computer edits are ran on a structure after the inspection updates have been entered in to TMS.				SIGN #			
				1			
Rated Item				SIGN TYPE			
[Item 67] Structure Evaluation Rating:				PROBLEM			
5-BETTER THAN MINIMUM				PROBLEM DIRECTION			
[Item 68] Deck Geometry Rating:							
7-BETTER THAN PRESENT MIN							
[Item 69] Underclearance:							
4-MEETS MINIMUM TOLERABLE							
Sufficiency Rating:							
77.8%							
Deficiency:							
NOT DEFICIENT							
Funding Eligibility:							


Estimated New Structure Length:							


Estimated Structure Cost:							


Estimated Total Project Cost:							


Year of Cost Estimate:							


NOTE: The above structure length and cost estimates are computer generated using algorithms in the TMS system. These algorithms are generalized to use NBI items to come up with a new structure length and width to calculate a new area which is taken times a representative cost per square foot. The actual structure size and cost may vary significantly from these numbers once site specific engineering is done.							
				OUTFALL INSPECTION INFORMATION			
				# OUTFALLS:			
				INSPECTOR:			
				STATUS:			
				DATE:			
				NOTES:			


		Missouri Department of Transportation				October 01, 2024	
		State Bridge Inspection Report				3:53:42PM	
COUNTY: CLAY		DISTRICT: KC		CLASS: STATBR		FED-ID: 6409	
						BRIDGE: L0655	
GENERAL STRUCTURE INFORMATION						***BRIDGE INSPECTION INFORMATION***	
ROUTE: CSTN BRIGHTON AVES FEATURE: IS 35 STATUS: A-OPEN LOG MILE: 5.781 DETOUR: 1.00 MILES NHS: NO BUILT: 1954 REHAB: 1976 LOCATION: S 32 T 51 R 32 W LATITUDE: 39 11 .84 (DMS) LONGITUDE: 94 31 16.43 (DMS)		# SPANS: 4 LANES ON: 4 LANES UNDER: 4 COMPASS DIRECTION: SOUTH to NORTH DIRECTION OF TRAFFIC: 2-WAY TRAF FUNCTIONAL CLASS: UR-MINOR ARTERIAL NBI OWNER: MODOT NBI MAINTAINED: MODOT MAINTENANCE DISTRICT: KC MAINTENANCE COUNTY: CLAY SUB AREA: 7C25		PLACE CODE: 38000 KANSAS CITY CITY LENGTH: 261 FT 0 IN MAXIMUM SPAN: 70 FT 0 IN APPROACH ROADWAY: 44 FT 0 IN CURB TO CURB: 44 FT 0 IN OUT TO OUT: 58 FT 6 IN AADT: 4914 AADT YEAR: 2023 AADT TRUCK: 5.0% FUTURE AADT: 7862 FUTURE AADT YEAR: 2043		DATE: 09/04/2024 RESPONSIBILITY: DISTRICT FREQUENCY: 24 CALCULATED INTERVAL**: 24 TEAM LEADER: TIMOTHY HAZLETT ELEMENT: NO INSPECTOR 2: INSPECTOR 4: INSPECTOR 3: ** When calculated interval exceeds the frequency, a justification comment per BIRM is required.	
						GENERAL INSPECTION COMMENTS	
FRACTURE CRITICAL INSPECTION INFORMATION				***INDEPTH INSPECTION INFORMATION***			
DATE: RESPONSIBILITY: CATEGORY: FREQUENCY: CALCULATED INTERVAL**: NBI: TEAM LEADER: INSPECTOR 3: METHOD: INSPECTOR 2: INSPECTOR 4:				DATE: RESPONSIBILITY: CATEGORY: FREQUENCY: CALCULATED INTERVAL**: NBI: TEAM LEADER: INSPECTOR 3: METHOD: INSPECTOR 2: INSPECTOR 4:			
** When calculated interval exceeds the frequency, a justification comment per BIRM is required.				** When calculated interval exceeds the frequency, a justification comment per BIRM is required.			
FRACTURE CRITICAL INSPECTION COMMENTS				INDEPTH INSPECTION COMMENTS			
SPECIAL INSPECTION INFORMATION				***UNDERWATER INSPECTION INFORMATION***			
DATE: RESPONSIBILITY: CATEGORY: FREQUENCY: CALCULATED INTERVAL**: NBI: TEAM LEADER: INSPECTOR 3: METHOD: INSPECTOR 2: INSPECTOR 4:				DATE: RESPONSIBILITY: CATEGORY: FREQUENCY: CALCULATED INTERVAL**: NBI: TEAM LEADER: INSPECTOR 3: METHOD: INSPECTOR 2: INSPECTOR 4:			
** When calculated interval exceeds the frequency, a justification comment per BIRM is required.				** When calculated interval exceeds the frequency, a justification comment per BIRM is required.			
SPECIAL INSPECTION COMMENTS				UNDERWATER INSPECTION COMMENTS			
OTHER SPECIAL INSPECTIONS				OTHER UNDERWATER INSPECTIONS			
<u>DATE</u> <u>FREQUENCY</u> <u>CATEGORY</u> <u>NBI</u> <u>CALCULATED INTERVAL</u> <u>RESPONSIBILITY</u> <u>METHOD</u>				<u>DATE</u> <u>FREQUENCY</u> <u>CATEGORY</u> <u>NBI</u> <u>CALCULATED INTERVAL</u> <u>RESPONSIBILITY</u> <u>METHOD</u>			
Design_No = L0655							
Page 1							
This report contains information that is protected from disclosure by federal law, 23 USC Section 409 and the Missouri Open Records Law (Sunshine Act), Section 610.021 RSMo. Please review MoDOT's policy and procedure manual on the Sunshine Act before releasing any of the information contained herein.							


		Missouri Department of Transportation			October 01, 2024	
		State Bridge Inspection Report			3:53:42PM	
COUNTY: CLAY		DISTRICT: KC		CLASS: STATBR	FED-ID: 6409	BRIDGE: L0655
STRUCTURE POSTING						
APPROVED CATEGORY: S-1		NO POSTING REQUIRED				
Ton 1:		Ton 2:		Ton 3:		
COMMENTS:						
FIELD CATEGORY: S-1		NO POSTING REQUIRED				
Ton 1:		Ton 2:		Ton 3:		PROBLEM:
COMMENTS:		PROBLEM DIRECTION:				
GENERAL COMMENTS/MAJOR RATED ITEMS						
GENERAL COMMENTS: (BOWDEJ1, 09/30/2008)--(60'-70'-70'-60') CONT WF GDR SPANS (RIVETED)						
[ITEM 58] DECK: 8-VERY GOOD CONDITION		COMMENTS: (OTISL1, 09/28/2016)--T CRACKS				
RATING : 09/28/2016						
[ITEM 59] SUPER: 7-GOOD CONDITION		COMMENTS: (KIMM1, 10/02/2018)--LIGHT RUST W/ NO SECTION LOSS.				
RATING : 10/02/2018						
[ITEM 60] SUB: 6-SATISFACTORY CONDITION		COMMENTS: (OTISL1, 09/28/2016)--REHAB				
RATING : 10/01/2020		(OTISL1, 10/01/2020)--NONE				
		(RAITHK, 08/23/2023)--DET SEALED OVER				
[ITEM 61] BANK/CHANNEL: N-NOT APPLIC NO WATRWAY		COMMENTS:				
RATING : 05/18/2001						
[ITEM 113] SCOUR: N-NOT APPLIC NOT WATERW		COMMENTS:				
RATING : 05/18/2001						
EVALUATION TYPE :						
[ITEM 71] WATERWAY ADEQUACY: NOT APPLICABLE		COMMENTS:				
RATING : 05/18/2001						
[ITEM 72] APPRRDWY ALIGNMENT: 8-VERYGOOD		COMMENTS:				
RATING : 05/18/2001						
RAILING AND APPROACH PAVEMENT COMPONENTS AND RATINGS						
[ITEM 36A] BRIDGE RAILING RATING: MEETS CURRENT STANDARDS-1		RATING : 09/28/2016		COMMENTS:		
<u>MATERIAL</u>	<u>CONSTRUCTION</u>	<u>DIRECTION</u>	<u>COMMENTS</u>			
REINFORCED CONCRETE	SIDEWALKS	BOTH				
<u>CONDITION</u>	<u>LOCATION 1</u>	<u>LOCATION 2</u>	<u>SEVERITY</u>	<u>COMMENT</u>		
TRANSVERSE CRACKS	THROUGHOUT		FEW			
REINFORCED CONCRETE	SAFETY BARRIER CURB	BOTH				
<u>CONDITION</u>	<u>LOCATION 1</u>	<u>LOCATION 2</u>	<u>SEVERITY</u>	<u>COMMENT</u>		
COLLISION DAMAGE	THROUGHOUT		MODERATE	(OTISL1, 10/01/2020)--NW CORNER		
VERTICAL CRACKS	THROUGHOUT		FEW			
GALVANIZED STEEL	PEDESTRIAN FENCE	BOTH				
[ITEM 36B] TRANSITION RAILING RATING: NOT PROVIDED-0		RATING : 05/18/2001		COMMENTS:		
Design_No = L0655						
Page 2						
This report contains information that is protected from disclosure by federal law, 23 USC Section 409 and the Missouri Open Records Law (Sunshine Act), Section 610.021 RSMo. Please review MoDOT's policy and procedure manual on the Sunshine Act before releasing any of the information contained herein.						

		Missouri Department of Transportation				October 01, 2024	
		State Bridge Inspection Report				3:53:42PM	
COUNTY: CLAY		DISTRICT: KC		CLASS: STATBR		FED-ID: 6409	
				BRIDGE: L0655			
[ITEM 36C] APPROACH RAILING RATING: NOT PROVIDED-0				RATING : 05/18/2001		COMMENTS:	
[ITEM 36D] RAIL END TREATMENT RATING: NOT PROVIDED-0				RATING : 05/18/2001		COMMENTS:	
APPROACH PAVEMENT: *Overall condition assigned for each approach pavemenet component is shown below.							
<u>MATERIAL</u>		<u>CONSTRUCTION</u>		<u>DIRECTION</u>		<u>CONDITION*</u>	
ASPHALT		BITUMINOUS MAT		BOTH		GOOD	
DRAINAGE, EXPANSION DEVICES, BANK/SLOPE, AND DECK PROTECTIVE COMPONENTS							
<u>DECK PROTECTIVE COMPONENTS:</u>							
<u>SERIES TYPE-#</u>		<u>COMPONENT</u>		<u>MATERIAL</u>		<u>CONSTRUCTION</u>	
MAIN SERIES-1		WEARING SURFACE		PLAIN CONCRETE		MONOLITHIC	
<u>COMMENT:</u>							
		DECK PROTECTION		NOTAPPLICABLE		NONE	
<u>COMMENT:</u>							
		MEMBRANE		NOTAPPLICABLE		NONE	
<u>COMMENT:</u>							
		SECONDARY DECK PROTECTION		LIQUID SEALANT		INTERNALLY SEALED	
<u>COMMENT:</u>							
<u>DRAINAGE COMPONENTS:</u>							
		<u>COMPONENT</u>		<u>MATERIAL</u>		<u>CONSTRUCTION</u>	
						<u>DIRECTION</u>	
						<u>COMMENTS</u>	
<u>EXPANSION DEVICE COMPONENTS:</u>							
<u>SUB UNIT-#</u>		<u>SUB LABEL</u>		<u>COMPONENT</u>		<u>MATERIAL</u>	
ABUTMENT-1				CLOSED EXPANSION JOINT		ELASTOMERIC	
<u>COMMENT:</u>							
		ABUTMENT-5		CLOSED EXPANSION JOINT		ELASTOMERIC	
<u>COMMENT:</u>							
<u>BANK/SLOPE PROTECTION COMPONENTS:</u>							
		<u>COMPONENT</u>		<u>MATERIAL</u>		<u>CONSTRUCTION</u>	
		SLOPE PROTECTION		PLAIN CONCRETE		PAVEDSLOPE	
						<u>DIRECTION</u>	
						<u>COMMENTS</u>	
DECK COMPONENTS							
<u>SPAN TYPE-#</u>		<u>COMPONENT</u>		<u>MATERIAL</u>		<u>CONSTRUCTION</u>	
MAIN SPANS-1		DECK		REINFORCED CONCRETE		CAST-IN-PLACE	
<u>CONDITION</u>		<u>LOCATION 1</u>		<u>LOCATION 2</u>		<u>SEVERITY</u>	
EFFLORESCENCE		OVERHANGS				LIGHT	
						<u>MEASUREMENT</u>	
						<u>COMMENT</u>	
Design_No = L0655							
Page 3							
This report contains information that is protected from disclosure by federal law, 23 USC Section 409 and the Missouri Open Records Law (Sunshine Act), Section 610.021 RSMo. Please review MoDOT's policy and procedure manual on the Sunshine Act before releasing any of the information contained herein.							

		Missouri Department of Transportation State Bridge Inspection Report				October 01, 2024 3:53:42PM	
COUNTY: CLAY		DISTRICT: KC		CLASS: STATBR		FED-ID: 6409	
						BRIDGE: L0655	
COLUMN		REINFORCED CONCRETE		CAST-IN-PLACE			
	<u>CONDITION</u>		<u>LOCATION 1</u>	<u>LOCATION 2</u>	<u>SEVERITY</u>	<u>MEASUREMENT</u>	<u>COMMENT</u>
STRAIGHT WINGS		REINFORCED CONCRETE		CAST-IN-PLACE			
	<u>CONDITION</u>		<u>LOCATION 1</u>	<u>LOCATION 2</u>	<u>SEVERITY</u>	<u>MEASUREMENT</u>	<u>COMMENT</u>
TURNED BACK WINGS		REINFORCED CONCRETE		CAST-IN-PLACE			
	<u>CONDITION</u>		<u>LOCATION 1</u>	<u>LOCATION 2</u>	<u>SEVERITY</u>	<u>MEASUREMENT</u>	<u>COMMENT</u>
FOOTING		REINFORCED CONCRETE		SPREAD			
	<u>CONDITION</u>		<u>LOCATION 1</u>	<u>LOCATION 2</u>	<u>SEVERITY</u>	<u>MEASUREMENT</u>	<u>COMMENT</u>
BACKWALL		REINFORCED CONCRETE		CAST-IN-PLACE			
	<u>CONDITION</u>		<u>LOCATION 1</u>	<u>LOCATION 2</u>	<u>SEVERITY</u>	<u>MEASUREMENT</u>	<u>COMMENT</u>
SPALLS		THROUGHOUT			FEW		
EXPANSION BEARING		STEEL		ROCKER			
	<u>CONDITION</u>		<u>LOCATION 1</u>	<u>LOCATION 2</u>	<u>SEVERITY</u>	<u>MEASUREMENT</u>	<u>COMMENT</u>
RUSTING		THROUGHOUT			LIGHT		
BENT-2	RA-41 DEGREES	70 FT 2 IN	REINFORCED CONCRETE	MULTIPLE COLUMN			
	<u>CONDITION</u>		<u>LOCATION 1</u>	<u>LOCATION 2</u>	<u>SEVERITY</u>	<u>MEASUREMENT</u>	<u>COMMENT</u>
<u>ASSOCIATED COMPONENT</u>		<u>MATERIAL</u>		<u>CONSTRUCTION</u>			
BEAM CAP		REINFORCED CONCRETE		CAST-IN-PLACE			
	<u>CONDITION</u>		<u>LOCATION 1</u>	<u>LOCATION 2</u>	<u>SEVERITY</u>	<u>MEASUREMENT</u>	<u>COMMENT</u>
DELAMINATION		THROUGHOUT			MINOR		
VERTICAL CRACKS		THROUGHOUT			FEW		
COLUMN		REINFORCED CONCRETE		CAST-IN-PLACE			
	<u>CONDITION</u>		<u>LOCATION 1</u>	<u>LOCATION 2</u>	<u>SEVERITY</u>	<u>MEASUREMENT</u>	<u>COMMENT</u>
DELAMINATION		BOTTOM			MINOR		
PATCHES		THROUGHOUT			MANY		
VERTICAL CRACKS		THROUGHOUT			FEW		
FOOTING		REINFORCED CONCRETE		SPREAD			
	<u>CONDITION</u>		<u>LOCATION 1</u>	<u>LOCATION 2</u>	<u>SEVERITY</u>	<u>MEASUREMENT</u>	<u>COMMENT</u>
EXPANSION BEARING		STEEL		ROCKER			
	<u>CONDITION</u>		<u>LOCATION 1</u>	<u>LOCATION 2</u>	<u>SEVERITY</u>	<u>MEASUREMENT</u>	<u>COMMENT</u>
BENT-3	RA-41 DEGREES	70 FT 2 IN	REINFORCED CONCRETE	MULTIPLE COLUMN			
	<u>CONDITION</u>		<u>LOCATION 1</u>	<u>LOCATION 2</u>	<u>SEVERITY</u>	<u>MEASUREMENT</u>	<u>COMMENT</u>
<u>ASSOCIATED COMPONENT</u>		<u>MATERIAL</u>		<u>CONSTRUCTION</u>			
BEAM CAP		REINFORCED CONCRETE		CAST-IN-PLACE			
	<u>CONDITION</u>		<u>LOCATION 1</u>	<u>LOCATION 2</u>	<u>SEVERITY</u>	<u>MEASUREMENT</u>	<u>COMMENT</u>
DELAMINATION		THROUGHOUT			MINOR		
SPALLS		ENDS			MINOR		
VERTICAL CRACKS		THROUGHOUT			FEW		
COLUMN		REINFORCED CONCRETE		CAST-IN-PLACE			
	<u>CONDITION</u>		<u>LOCATION 1</u>	<u>LOCATION 2</u>	<u>SEVERITY</u>	<u>MEASUREMENT</u>	<u>COMMENT</u>
DELAMINATION		THROUGHOUT			MODERATE		
FOOTING		REINFORCED CONCRETE		SPREAD			
	<u>CONDITION</u>		<u>LOCATION 1</u>	<u>LOCATION 2</u>	<u>SEVERITY</u>	<u>MEASUREMENT</u>	<u>COMMENT</u>
EXPANSION BEARING		STEEL		ROCKER			
	<u>CONDITION</u>		<u>LOCATION 1</u>	<u>LOCATION 2</u>	<u>SEVERITY</u>	<u>MEASUREMENT</u>	<u>COMMENT</u>
BENT-4	RA-41 DEGREES	70 FT 2 IN	REINFORCED CONCRETE	MULTIPLE COLUMN			
	<u>CONDITION</u>		<u>LOCATION 1</u>	<u>LOCATION 2</u>	<u>SEVERITY</u>	<u>MEASUREMENT</u>	<u>COMMENT</u>
<u>ASSOCIATED COMPONENT</u>		<u>MATERIAL</u>		<u>CONSTRUCTION</u>			

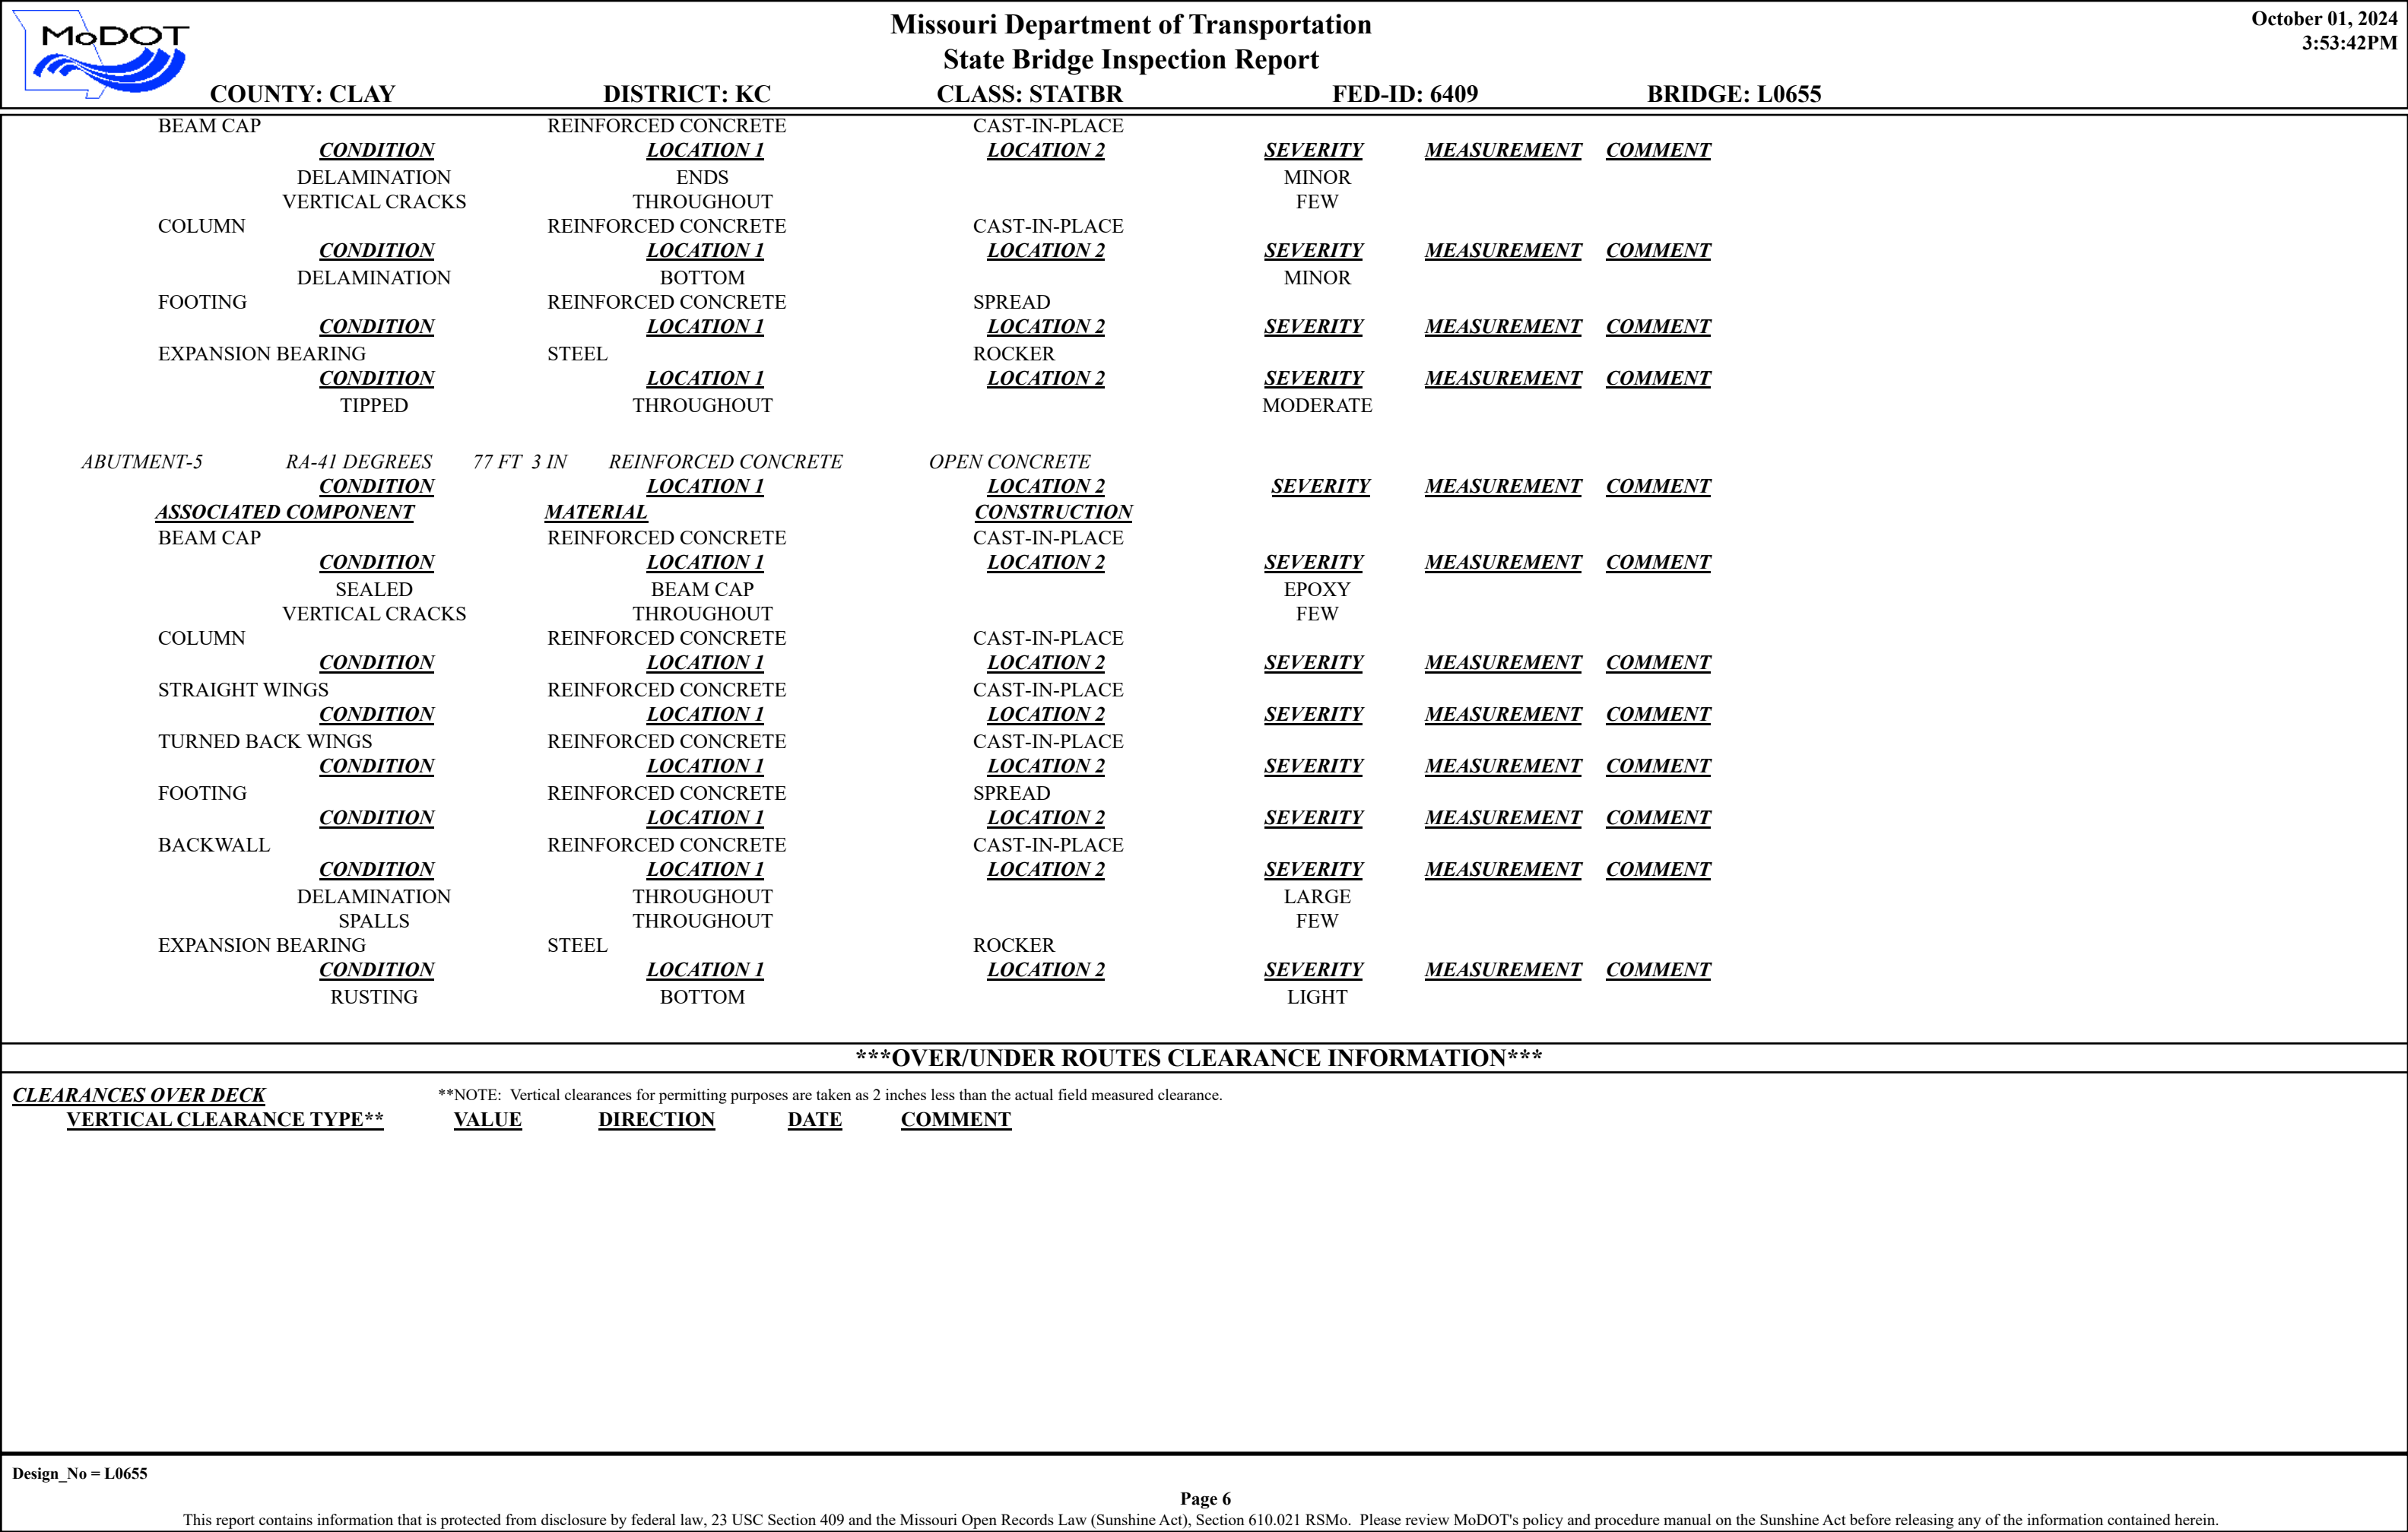

		Missouri Department of Transportation				October 01, 2024	
		State Bridge Inspection Report				3:53:42PM	
COUNTY: CLAY		DISTRICT: KC		CLASS: STATBR		FED-ID: 6409	
						BRIDGE: L0655	
<u>CLEARANCES UNDER BRIDGE</u>		**NOTE: Vertical clearances for permitting purposes are taken as 2 inches less than the actual field measured clearance.					
<u>RECORD #</u>	<u>ROUTE</u>	<u># LANES</u>	<u>DIRECTION OF TRAFFIC</u>		<u>RIGHT LATERAL CLEARANCE</u>	<u>LEFT LATERAL CLEARANCE</u>	<u>UR-ID</u>
1	IS 35 S	2	1-WAY TRAF		11 FT 11 IN	13 FT 10 IN	14184
<u>VERTICAL CLEARANCE TYPE**</u>		<u>VALUE</u>	<u>DIRECTION</u>	<u>DATE</u>	<u>COMMENT</u>		
ACTUAL		17 FT 0 IN					
<u>RECORD #</u>	<u>ROUTE</u>	<u># LANES</u>	<u>DIRECTION OF TRAFFIC</u>		<u>RIGHT LATERAL CLEARANCE</u>	<u>LEFT LATERAL CLEARANCE</u>	<u>UR-ID</u>
2	IS 35 N	2	1-WAY TRAF		11 FT 11 IN	13 FT 10 IN	14185
<u>VERTICAL CLEARANCE TYPE**</u>		<u>VALUE</u>	<u>DIRECTION</u>	<u>DATE</u>	<u>COMMENT</u>		
ACTUAL		17 FT 4 IN					
STRUCTURE PAINT INFORMATION							
CONDITION: FAIR		RUST AMOUNT : 5=3.0% OF SURFACE RUSTED		STEEL TONS : 174			
<u>ORIGINAL PAINT</u>		<u>CONTRACT REPAINT</u>		<u>DEPARTMENT REPAINT</u>			
PAINT TYPE :		PAINT TYPE : B SYSTEM		PAINT TYPE : G SYSTEM		MANUFACTURE :	
NAME :		NAME : BASIC LEAD CHROMIUM		NAME : ZINC/EPOXY/ACRYLIC		SURFACE PREP :	
PAINT COLOR :		PAINT COLOR : ALUMINUM		PAINT COLOR : GRAY			
PAINT YEAR :		PAINT YEAR : 1978		PAINT YEAR : 2016			
MILS :		MILS : 5		MILS :			
REQUESTED WORK ITEMS							
GENERAL WORK COMMENTS:							
<i>RESPONSIBILITY</i>	<i>LOCATION</i>	<i>ITEM</i>	<i>CATEGORY</i>	<i>PRIORITY</i>	<i>DATE</i>	<i>WORK ITEM COMMENT</i>	
DISTRICT SPECIAL	ROADWAY SURFACE	SEAL WITH SILANE	DECK	3	06/03/2030		
UTILITY ATTACHMENTS							
<i>UTILITY</i>	<i>OWNER</i>	<i>METHOD</i>	<i>MEASUREMENT TYPE</i>	<i>VALUE</i>	<i>NUMBER</i>	<i>UTILITY ATTACHMENT COMMENT</i>	
STRUCTURAL SIGN		MOUNTED			1		
LIGHTING		MOUNTED			1		
PROGRAM NOTES INFORMATION							
<u>YEAR</u>	<u>PROJECT #</u>	<u>MONTH LET</u>	<u>YEAR LET</u>	<u>ITEMS</u>	<u>COMMENT</u>		
2016		0	0	REPLACE DECK, SUBSTRUCTURE REPAIR			
Design_No = L0655							
Page 7							
This report contains information that is protected from disclosure by federal law, 23 USC Section 409 and the Missouri Open Records Law (Sunshine Act), Section 610.021 RSMo. Please review MoDOT's policy and procedure manual on the Sunshine Act before releasing any of the information contained herein.							

			Missouri Department of Transportation			October 01, 2024					
			State Bridge Inspection Report			3:53:42PM					
COUNTY: CLAY			DISTRICT: KC			CLASS: STATBR					
			FED-ID: 6409			BRIDGE: L0655					
COMPUTER GENERATED RATINGS AND DEFICIENCY ITEMS						***ADVANCED SIGN INFORMATION***					
NOTE: The items listed in this section are updated whenever computer edits are ran on a structure after the inspection updates have been entered in to TMS.						SIGN #					
						SIGN TYPE					
						PROBLEM					
						PROBLEM DIRECTION					
<u>Rated Item</u>											
<u>Rating</u>											
<u>Rating Date</u>											
[Item 67] Structure Evaluation Rating: 6-EQ TO PRESENT MIN CRITR 10/6/2020											
[Item 68] Deck Geometry Rating: 2-BASICALLY INTOLRBLE REQ 10/27/2015											
[Item 69] Underclearance: 5-BETTER THAN MINIMUM 1/19/2022											
Sufficiency Rating: 77.4% 1/19/2022											
Deficiency: FUNCTIONAL 10/6/2020											
Funding Eligibility: PARTIAL ----						***OUTFALL INSPECTION INFORMATION***					
Estimated New Structure Length: 217 FT. ----						# OUTFALLS: INSPECTOR:					
Estimated Structure Cost: \$2,005,799 ----											
Estimated Total Project Cost: \$3,008,699 ----											
Year of Cost Estimate: 2024 ----											
NOTE: The above structure length and cost estimates are computer generated using algorithms in the TMS system. These algorithms are generalized to use NBI items to come up with a new structure length and width to calculate a new area which is taken times a representative cost per square foot. The actual structure size and cost may vary significantly from these numbers once site specific engineering is done.						STATUS: DATE:					
						NOTES:					