
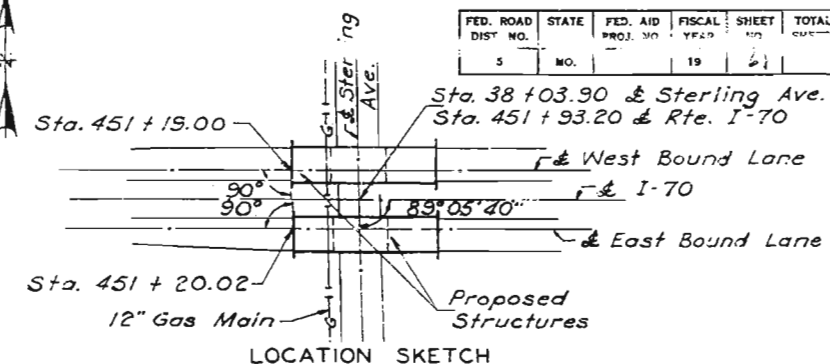


FED. ROAD DIST. NO.	STATE	FED. AID PROJ. NO.	FISCAL YEAR	SHEET NO.	TOTAL CUT
5	MO.		19	21	

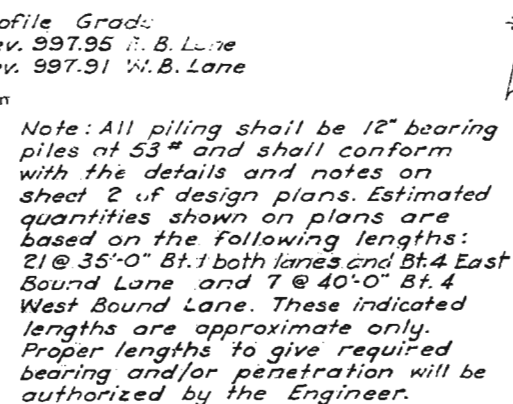

ESTIMATED QUANTITIES			
ITEM	SUBSTR.	SUPERSTR.	TOTAL
Class I Excavation for Structures Cu.Yd.	395	_____	395
Steel Piles in Place (12") Lin. Ft.	931	_____	931
Steel Pile Cut-offs (12") Lin. Ft.	84	_____	84
Class B Concrete Cu.Yd.	272.6	_____	272.6
Class B1 Concrete Cu.Yd.	_____	398.2	398.2
Reinforcing Steel Lb.	45,920	129,060	174,980
Fabricated Structural Carbon Steel Lb.	_____	241,930	241,930
Painting Ton	_____	118.1	118.1
Bridge Rail (Single Tube Type) Lin. Ft.	_____	591	591
Conduit System (on Structure) Lump Sum	_____	1	1

Note: All excavation for bridge will be paid for as Class I Excavation for Structures.
Weight of shear connectors is included in weight of Fabricated Structural Carbon Steel but not included for painting.

GENERAL NOTES:

Design Specifications: A.A.S.H.O. - 1961.
Loading: H20-S16-44 (15 #/sq.ft. Future
Wearing Surface) (Modified 24,000 # Tandem Axle)
Structural Steel Stress: ASTM-A36, 20,000 #
Structural Steel Stress: ASTM-A7 or
A373, 18,000 #/in²
Reinforcing Steel Stress: 20,000 #/in²
Concrete Class B Stress: 1,200 #/in²
Concrete Class B1 Stress: 1,600 #/in²
Material for Stringers and cover plates
welded to Stringers shall be structural
steel conforming to ASTM-A36. Other
steel shall be as noted on the plans or
A7 steel if not otherwise noted.
Concrete for Substructure shall be
Class B air-entrained.
Concrete for Superstructure shall be
Class B1 air-entrained.
Superstructure deck to be surface
sealed. (See special provisions.)
Rivets $\frac{3}{4}$ "; holes $\frac{1}{2}$ "; except where
otherwise noted.
Field connections may be riveted or
bolted with high strength bolts. Final pay
weight for Fabricated Structural Carbon
Steel will be based on the use of field
rivets.
Qualification of welding operators will
be required.

Paint: Shop, none; Field, contact surfaces of bolted field connections, except where high strength bolts are used, one coat of red lead and surfaces inaccessible after erection three coats of red lead. All other exposed surfaces first coat red lead, second coat brown, third coat aluminum. Payment for paint, cleaning and painting such surfaces will be included in price bid for Painting.

See Section 52.4.7 of Standard Specifications for required painting of steel piles.

Where joint filler is specified on the plans it shall conform with the requirements of Section 157.2.4 of the Standard Specifications.

Permits must be obtained for all truck loads over legal length.

Note: Class I Excavation for Structures will be measured from the ground line (1955) or from the lower limits of roadway excavation, whichever is lower, regardless of the sequence of operations or method of removal.

B.M. No. 21 - Elev. 1010.73 - "X" in S.E. Corner of
Headwall N. side Route 40 65' Lt of
Sta. 464 + 70

BRIDGE OVER STERLING AVENUE

STATE ROAD INTERSTATE ROUTE 70
IN KANSAS CITY
PROJECT NO. I-70-1(46) (RT. I-70) STA. { 451 + 19.00 (W. B. LANE)
451 + 20.02 (E. B. LANE)

JACKSON COUNTY

SUBMITTED BY E. LYN CROWLEY

SIGNATURE *E. Lynn Crowley*
REGISTERED PROFESSIONAL ENGINEER
SERIAL NUMBER E-5993


SUBMITTED BY DB Jensen DATE 3/14/62
BRIDGE ENGINEER
APPROVED BY J J Corbett DATE 3/14/62

STD-54.00

L-972

Sheet No. 1 of 8

FOR FINAL PLANS SUBMIT LINES

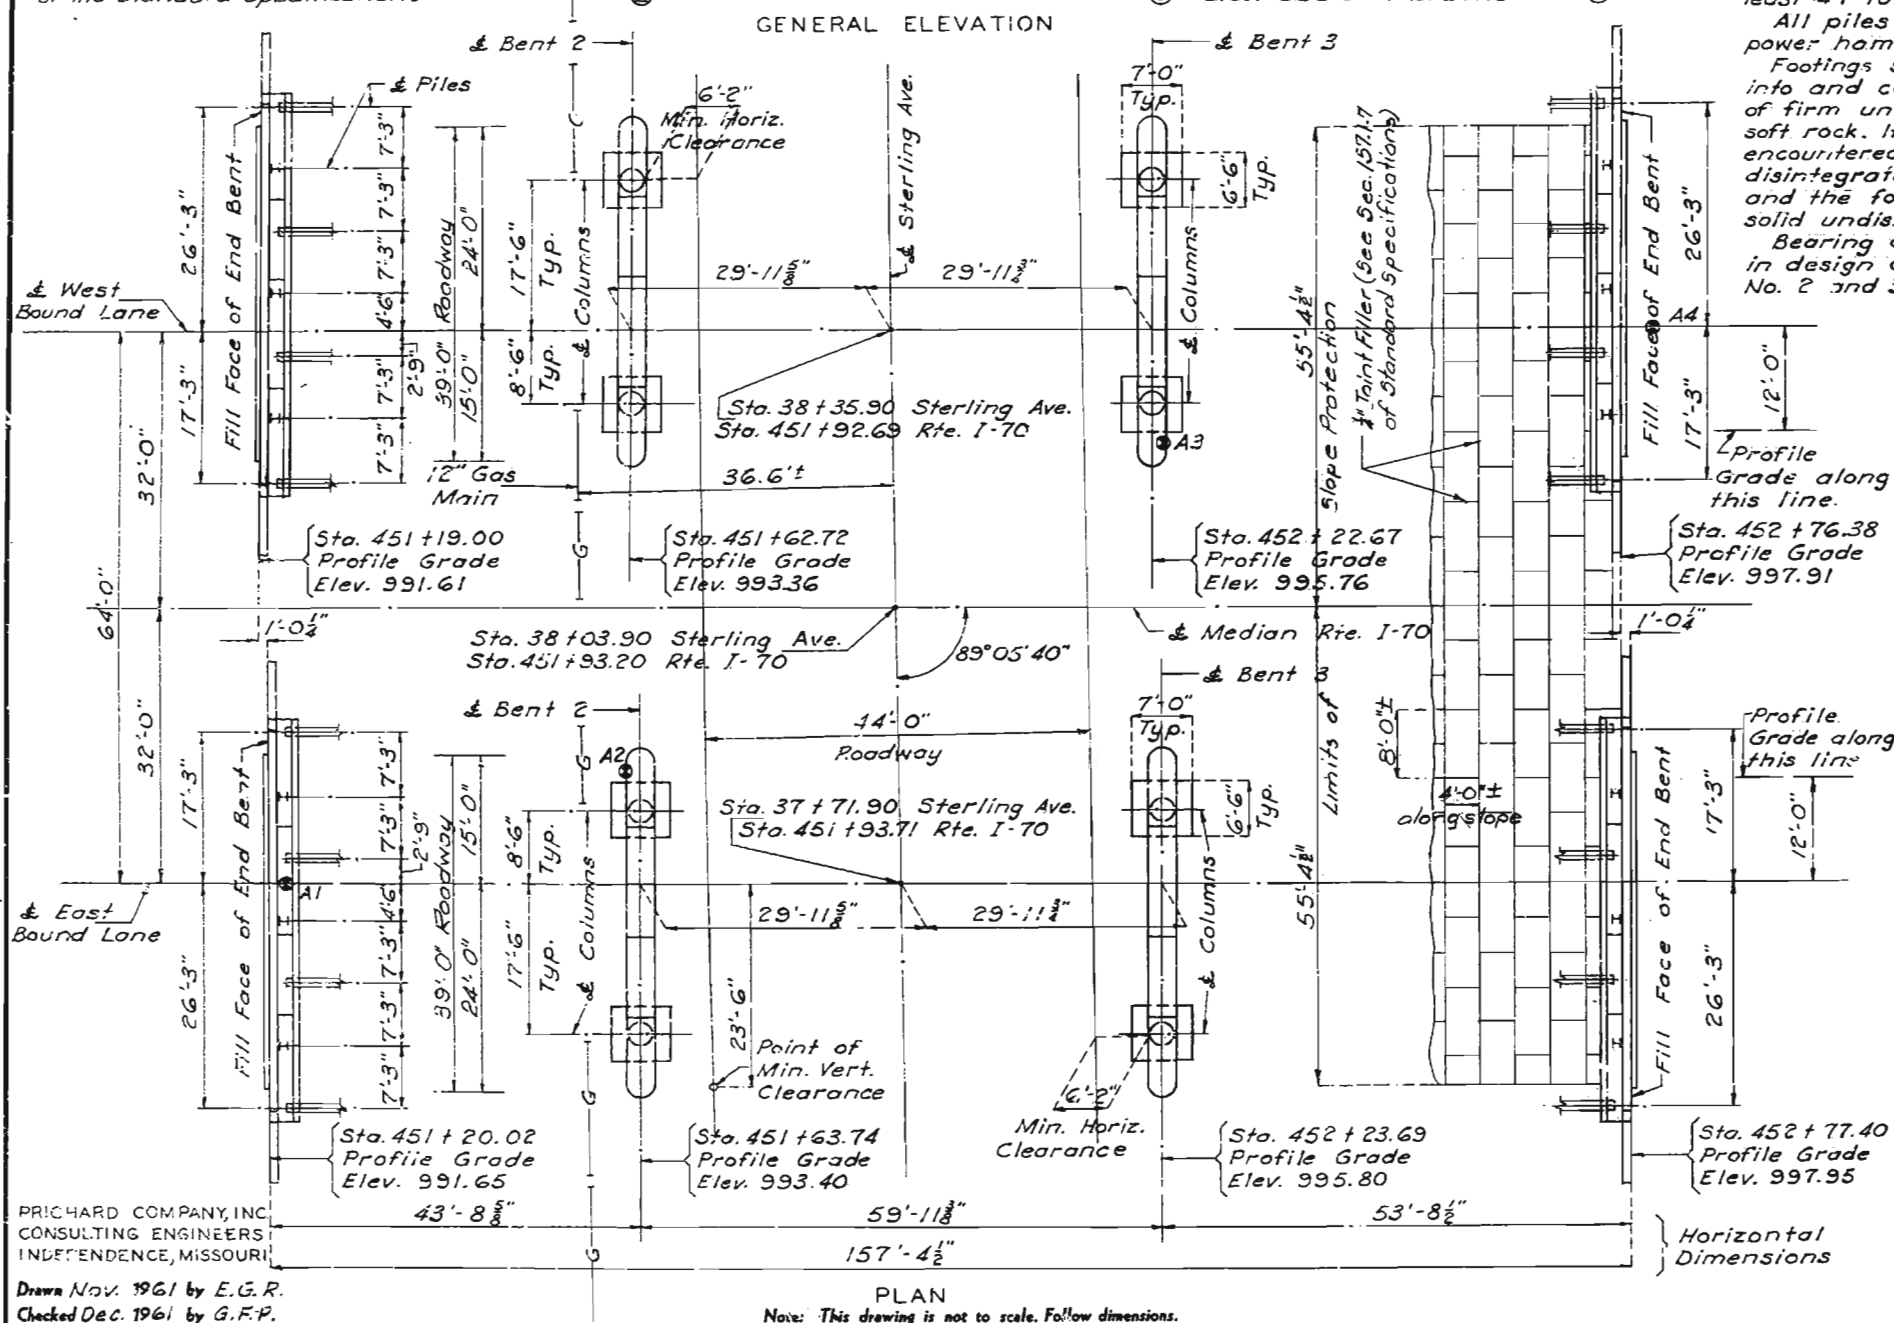




PRICHARD COMPANY, INC.
CONSULTING ENGINEERS
INDEPENDENCE, MISSOURI

Drawn Nov. 1961 by E.G.R.
Checked Dec. 1961 by G.F.P.

PLAN

Note: This drawing is not to scale. Follow dimensions.

FED. ROAD DIST. NO.	STATE	FED. AID PROJ. NO.	FISCAL YEAR	SHEET NO.	TOTAL SHEETS
5	MO.		19	62	

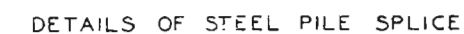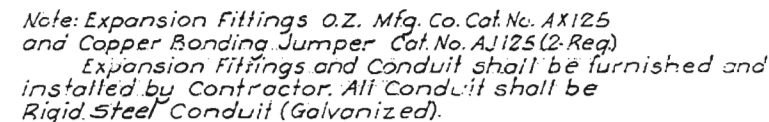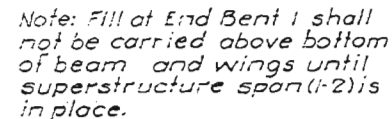


L-972

JACKSON COUNTY


MISSOURI STATE HIGHWAY DEPARTMENT

FED. ROAD DIST. NO.	DATE	FED. AID PROJ. NO.	FISCAL YEAR	SHEET NO.	TOTAL SHEETS
5			19	63	

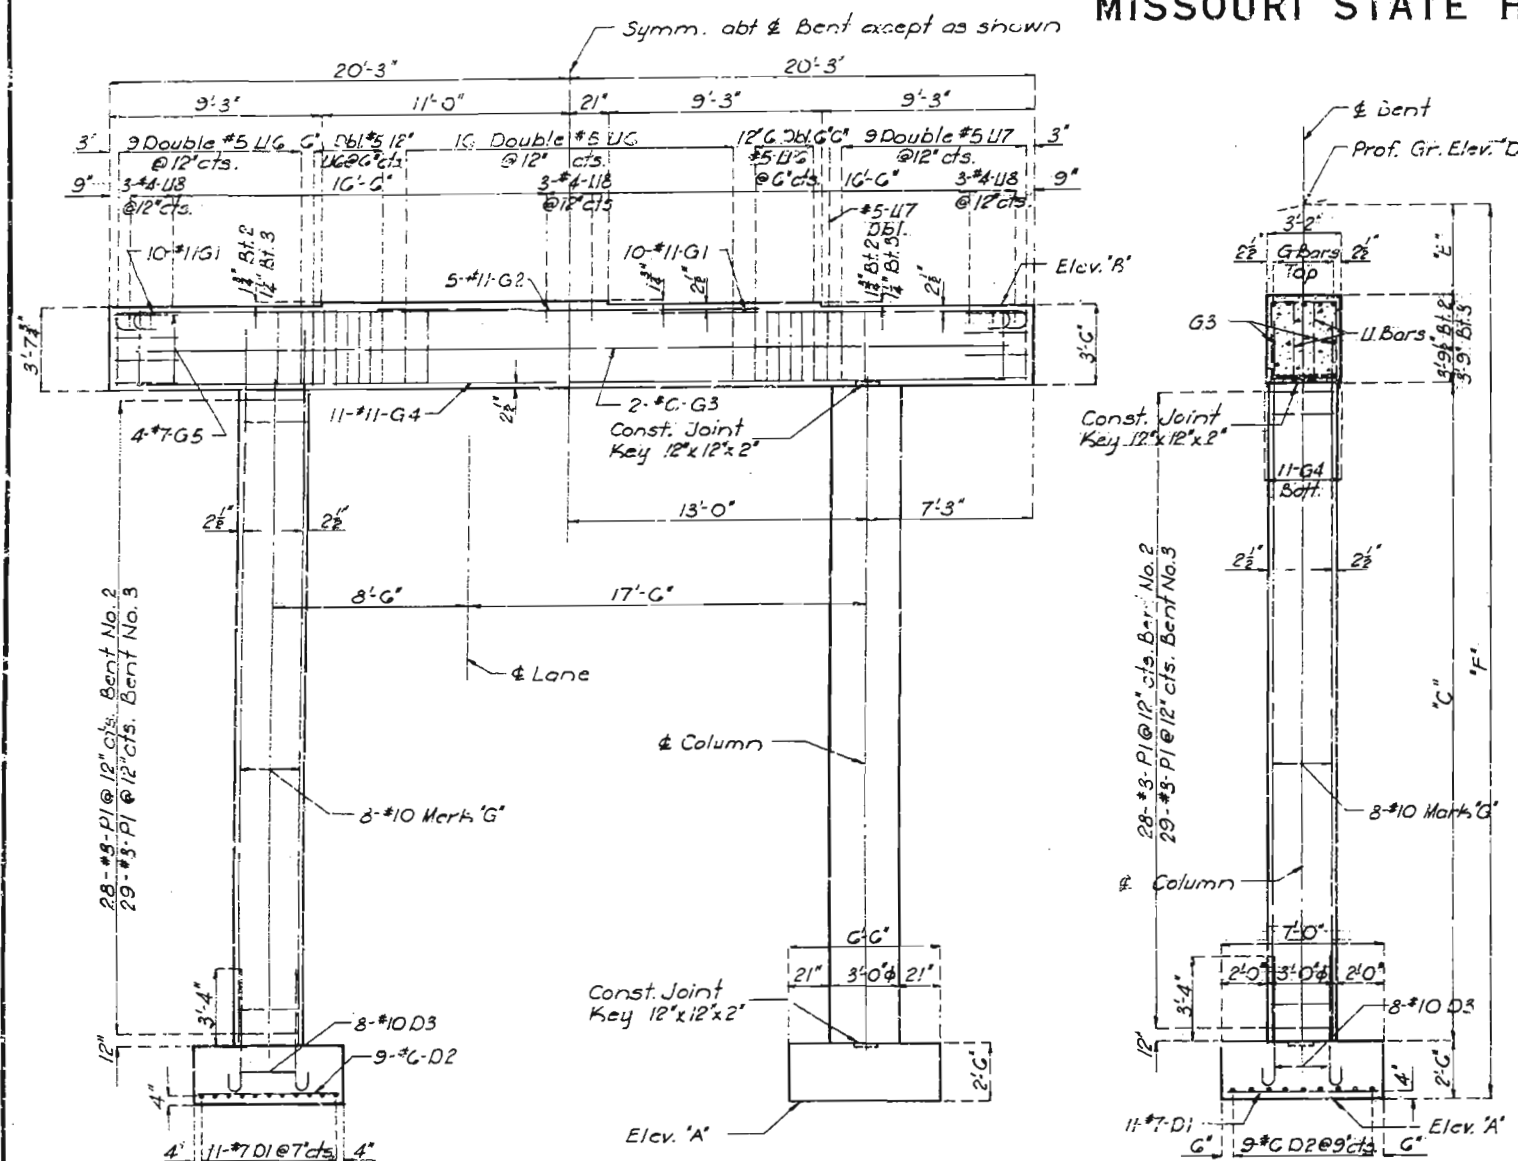

ELEVATION

SECTION AT C

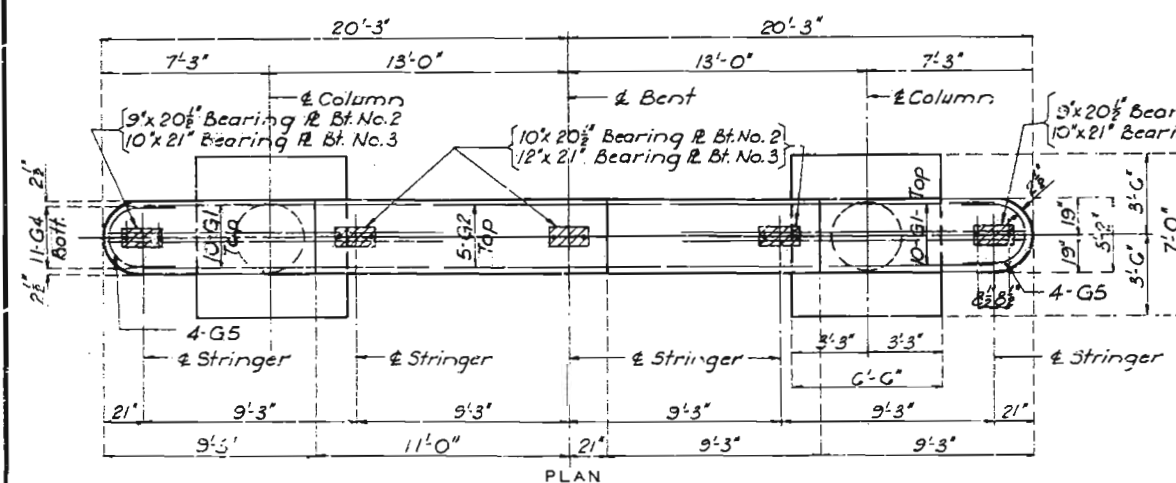

PLAN

DETAILS OF INTERMEDIATE BENTS NO. 2 AND 3
(East Bound Lane Shown, West Bound Lane Opposite Hand)

TABLE OF VARIABLES				
Mark	E. B. Lane	W. B. Lane	Bent 2	Bent 3
A	354.50	355.50	355.00	355.00
B	389.20	390.93	389.10	390.95
C	28-8 1/2	29-5 3/8	28-1 1/2	29-1 1/8
D	993.40	995.80	993.30	995.70
E	3-10 3/4	4-6 3/8	3-10 3/8	4-6 3/4
F	33-10 1/2	40-3 3/8	38-4 1/2	40-9 3/8
G	P2	P3	P4	P5

COMPLETE BILL OF REINFORCING STEEL					BENDING SKETCHES & CUTTING DIAGRAMS				
NO.	SIZE	LENGTH	MARK	LOCATION					
SUPERSTRUCTURE									
588	#5	4'-0"	C1	Curb					
588	#4	4'-9"	C2	Parapet					
40	#5	4'-3"	C3	Curb					
10	#5	21'-0"	C4	Parapet					
24	#5	22'-0"	C5	Curb					
40	#5	30'-9"	C6	Curb & Parapet					
10	#5	20'-0"	C7	Parapet					
24	#5	27'-0"	C8	Curb					
8	#5	5'-5"	C9	.					
64	#4	3'-9"	R1	End Post					
10	#5	8'-0"	R2	.					
8	#5	7'-9"	R3	.					
8	#5	7'-0"	R4	.					
8	#5	7'-0"	R5	.					
1248	#6	28'-3"	S1	Slab					
1248	#6	17'-0"	S2	.					
224	#4	10'-0"	S3	.					
530	#4	32'-3"	S4	.					
620	#5	32'-0"	S5	.					
END BENTS									
					BENT 1	BENT 2	BENT 3	BENT 4	
8	#6	24'-3"	H1	Backwall	4	4			
24	#4	24'-0"	H2	.	8	8	4	4	
10	#6	15'-0"	H3	Beam	4	4	4	4	
10	#6	35'-0"	H4	Beam	4	4	4	4	
10	#6	24'-3"	H5	.	4	4	4	4	
32	#6	25'-3"	H6	.	8	8	8	8	
48	#6	9'-0"	H7	Wing	12	12	12	12	
20	#6	13'-0"	H8	.	5	5	5	5	
8	#4	20'-0"	H9	Slab Notch	2	2	2	2	
10	#6	23'-0"	H10	Backwall			8	8	
8	#6	5'-0"	H11	Wing			4	4	
4	#6	14'-3"	T1	Wing	2	2			
4	#6	14'-0"	T2	.	2	2			
8	#6	15'-3"	T3	.			4	4	
48	#4	12'-0"	U1	Beam	12	12	12	12	
64	#4	12'-3"	U2	.	32	32			
60	#4	3'-0"	U3	.	15	15	15	15	
150	#3	21'	U4	Slab Notch	39	39	39	39	
64	#4	12'-3"	U5	Beam			32	32	
170	#4	4'-9"	V1	Backwall	88	88			
48	#4	0'-3"	V2	.	8	8	10	10	
6	#4	11'-0"	V3	Wing	3	3			
6	#4	11'-3"	V4	.	3	3			
100	#4	5'-9"	V5	Backwall			80	80	
6	#4	11'-0"	V6	Wing			3	3	
6	#4	10'-9"	V7	.			3	3	
40	#2	19'-9"	W1	A.B. Wells	10	10	10	10	
INTERMEDIATE BENTS NO. 2 & 3									
					BENT 2	BENT 3	BENT 4	BENT 5	
38	#7	0'-0"	D1	Footings	22	22	22	22	
72	#6	0'-0"	D2	.	18	18	18	18	
64	#10	0'-0"	D3	.	10	10	10	10	
80	#11	10'-0"	G1	Beam	20	20	20	20	
20	#11	17'-0"	G2	.	5	5	5	5	
8	#6	38'-0"	G3	.	2	2	2	2	
84	#11	38'-0"	G4	.	11	11	11	11	
32	#7	7'-0"	G5	.	8	8	8	8	
228	#3	9'-0"	P1	Column	50	50	58	58	
70	#10	31'-9"	P2	.	10				
10	#10	32'-0"	P3	.			10		
10	#10	31'-3"	P4	.				10	
10	#10	33'-0"	P5	.					10
304	#5	11'-0"	U6	Beam	70	70	70	70	
80	#5	11'-0"	U7	.	20	20	20	20	
30	#4	4'-0"	U8	.	9	9	9	9	
40	#2	19'-9"	W1	A.B. Wells	10	10	10	10	

C9	G5	P1	U6, U7
Spot Weld #2 Bars			
D3, G1, H3, H4, H6	T1, T2, T3	N1	
U1, U2, U5	C1, C2, C3, R2, R3, R4, R5, U3, U8		
U4			

BRIDGE OVER STERLING AVENUE

STATE ROAD INTERSTATE ROUTE 70

IN KANSAS CITY

PROJECT NO. I-70-I (46) RT. I-70) STA. 451+19.00 (W.B. LANE)
451+20.02 (E.B. LANE)

JACKSON COUNTY

1-972

Sheet No. 3 of 8

BRIDGE OVER STERLING AVENUE

STATE ROAD INTERSTATE ROUTE 70

IN KANSAS CITY

PROJECT NO. I-70-1(46) RT. I-70 STA. 451+19.00 (W.B. LANE) 451+20.02 (E.B. LANE)

JACKSON

COUNTY




Drawn Nov. 1961 by R.E.H.
Checked Dec 1961 by G.F.P.

Note: This drawing is not to scale. Follow dimensions.

SEE FINAL PLANS BROWN LINES

L-972

FED. ROAD DIST. NO.	STATE	FED. AID PROJ. NO.	FISCAL YEAR	SHEET NO.	TOTAL SHEET
5	MO.		19	64	

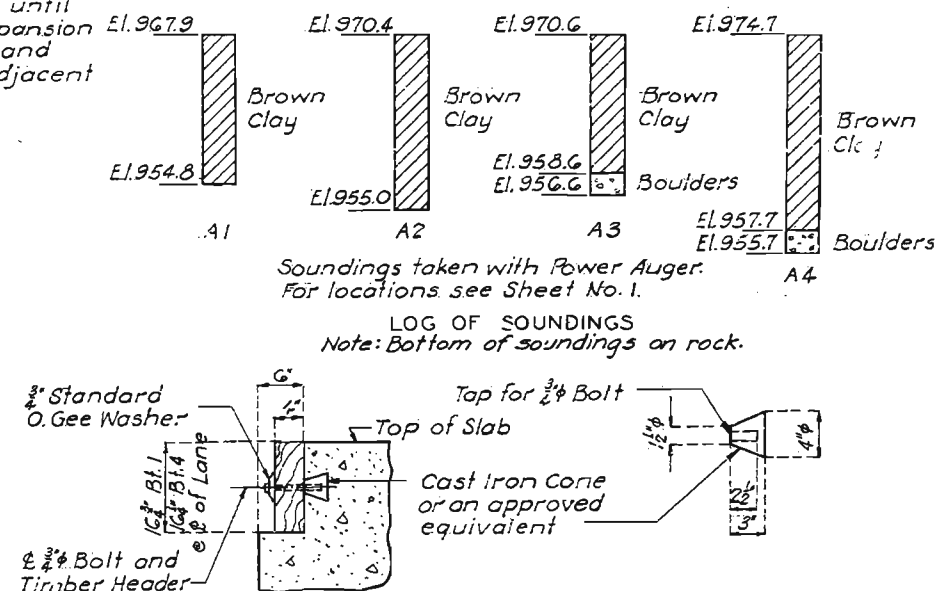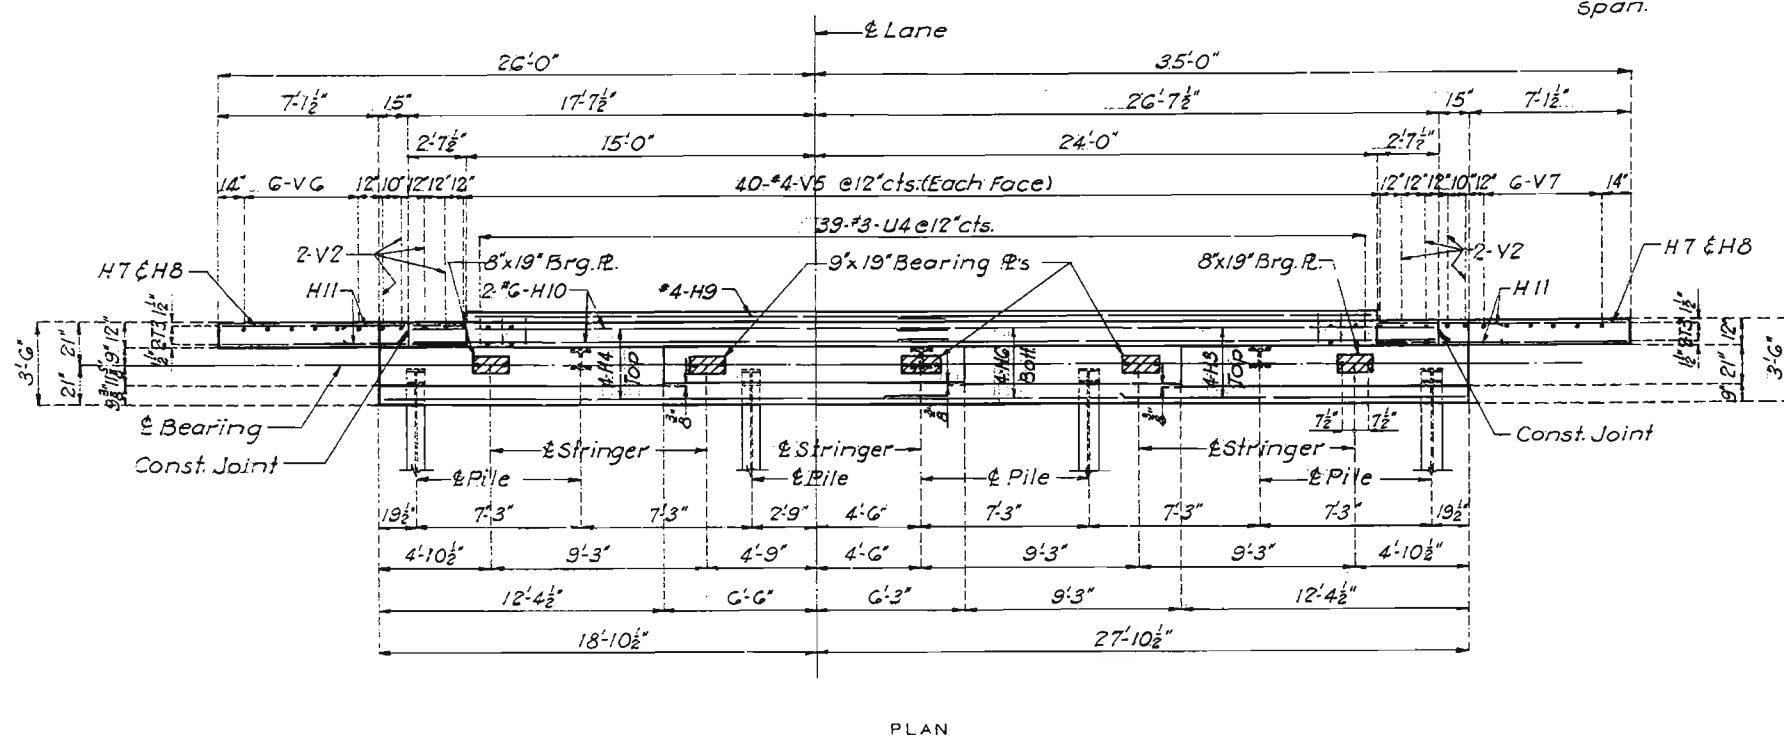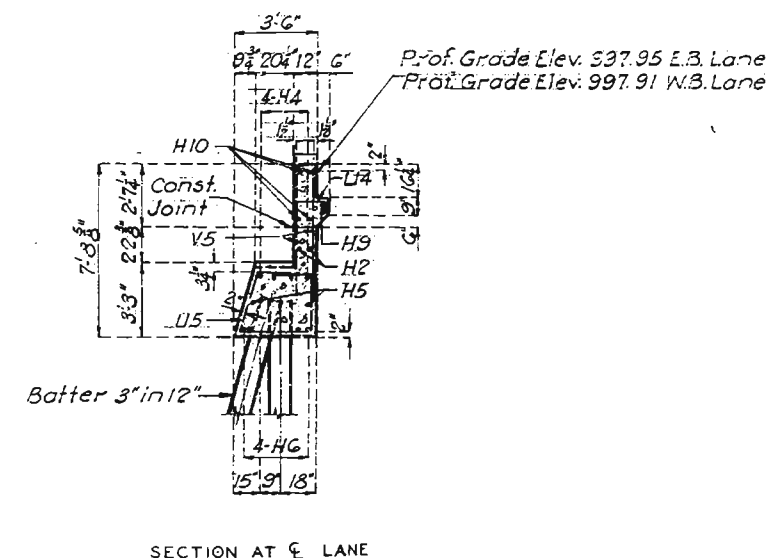

Note: $\frac{3}{4}$ " bolt shall be 6" long with square head, threaded 3" long and placed at about 3' 0" cts.

BRIDGE OVER STERLING AVENUE

STATE ROAD INTERSTATE ROUTE 70

IN KANSAS CITY

PROJECT NO. I-70-1(46)(RT. I-70) STA. { 451+19.00 (W.B. LANE)
451+20.02 (E.B. LANE)

JACKSON

COUNTY

Drawn Nov. 1961 by H.H.B.
Checked Dec. 1961 by G.F.P.


Note: This drawing is not to scale. Follow dimensions.

Sheet No. 4 of 8


NO CONSTRUCTION CHANGES

L-972


FED. ROAD DIST. NO.	STATE	FED. AID PROJ. NO.	FISCAL YEAR	SHEET NO.	TOTAL SHEETS
5	MO.		19	65	

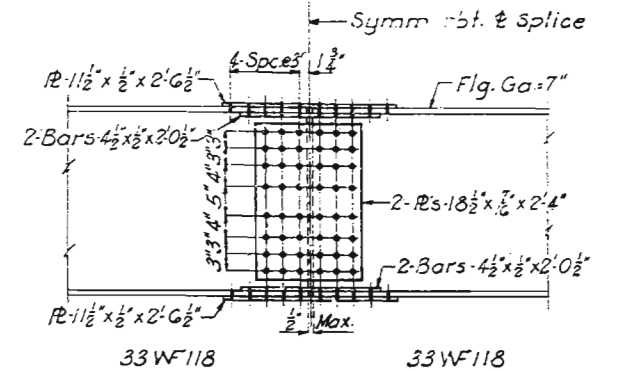


Note: Anchor bolts may be set in wells as shown or in holes drilled into concrete substructure. See Standard Specifications for setting Anchor bolts.

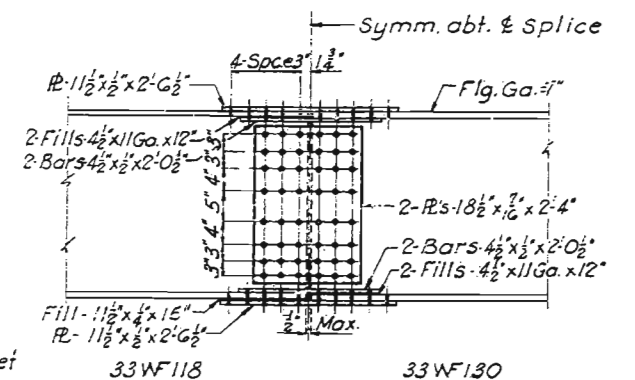


DETAILS OF FIELD SPLICES

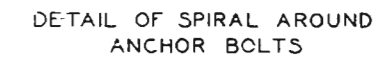

ffener P Ben

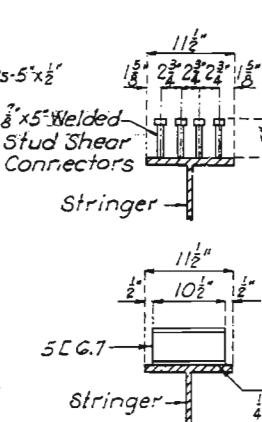

DETAILS OF SHEAR CONNECTORS


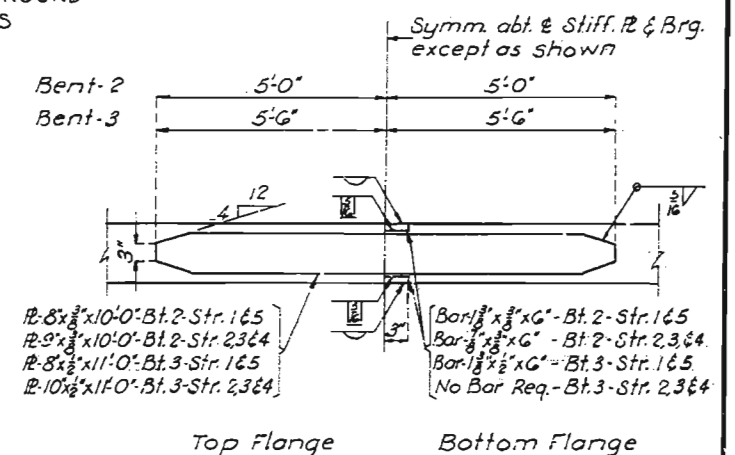


DETAILS OF FLANGE PLATES INT. BENTS 2 & 3

Sheet No. 5 of 8


L-972

FED. ROAD DIST. NO.	STATE	FED. AID PROJ. NO.	FISCAL YEAR	SHEET NO.	TOTAL SHEET
5	MO.		19	613	

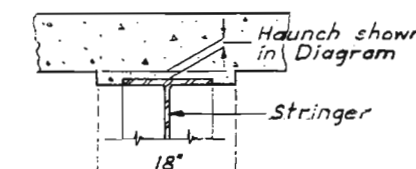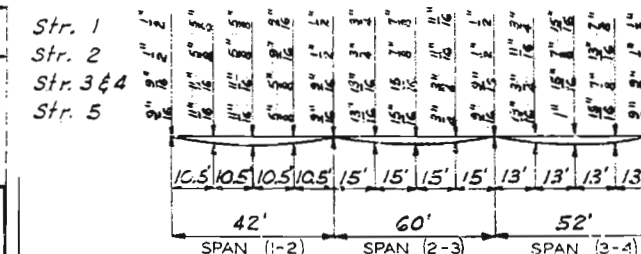

Note: The slab shall be built parallel to grade and to a minimum thickness of 7". Dead load deflection & end haunch shall be taken care of by haunching to the top of stringers by the dimensions shown. (The dead load deflection of the structural steel is 1/4" of the difference between the total haunch and end haunch.) The additional concrete (flange, flange plates, and splice plates excluded) is included in Estimated Quantities.


SLAB HAUNCHING DIAGRAM

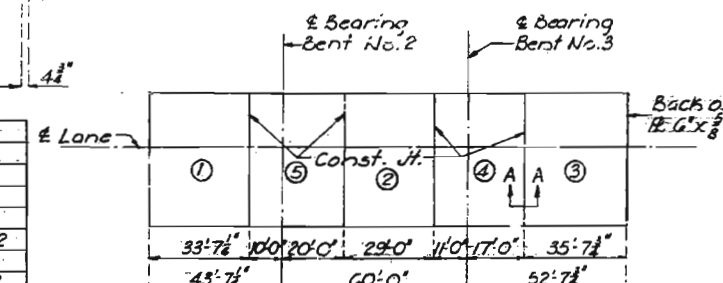

Note: No longitudinal construction joints will be permitted in the roadway slabs and to properly finish the required full slab width, the contractor shall use an approved oscillating screed type, self propelled mechanical finisher.

The "Basic" pouring sequence shall be observed unless the contractor can demonstrate to the satisfaction of the Engineer that he is equipped to pour and satisfactorily finish the bridge slabs at a rate of not less than 30 Cu. Yds. per hour and can maintain this rate throughout the alternate pour he elects to use.


SLAB POURING SEQUENCE

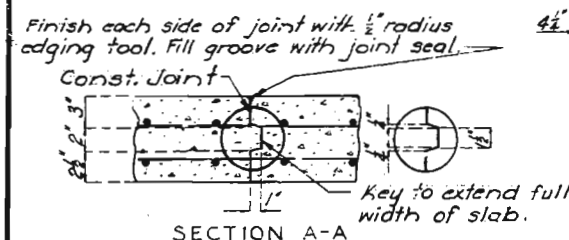

SECTION A-A



SPAN (3-4)					
Sequence of Pours					
Direction					
Basic	1	2	3	4	5
Sequence	Either Direction				
Alternate A	1	2+5		3+4	
Pours	Either Dir.	4 to 1		End Bent to 1	
Alternate B	1+5+2		3+4		
Pours	End Bent to 4		End Bent to 2		
Alternate C	1+2+3+4+5				
Pours	End Bent to End Bent				

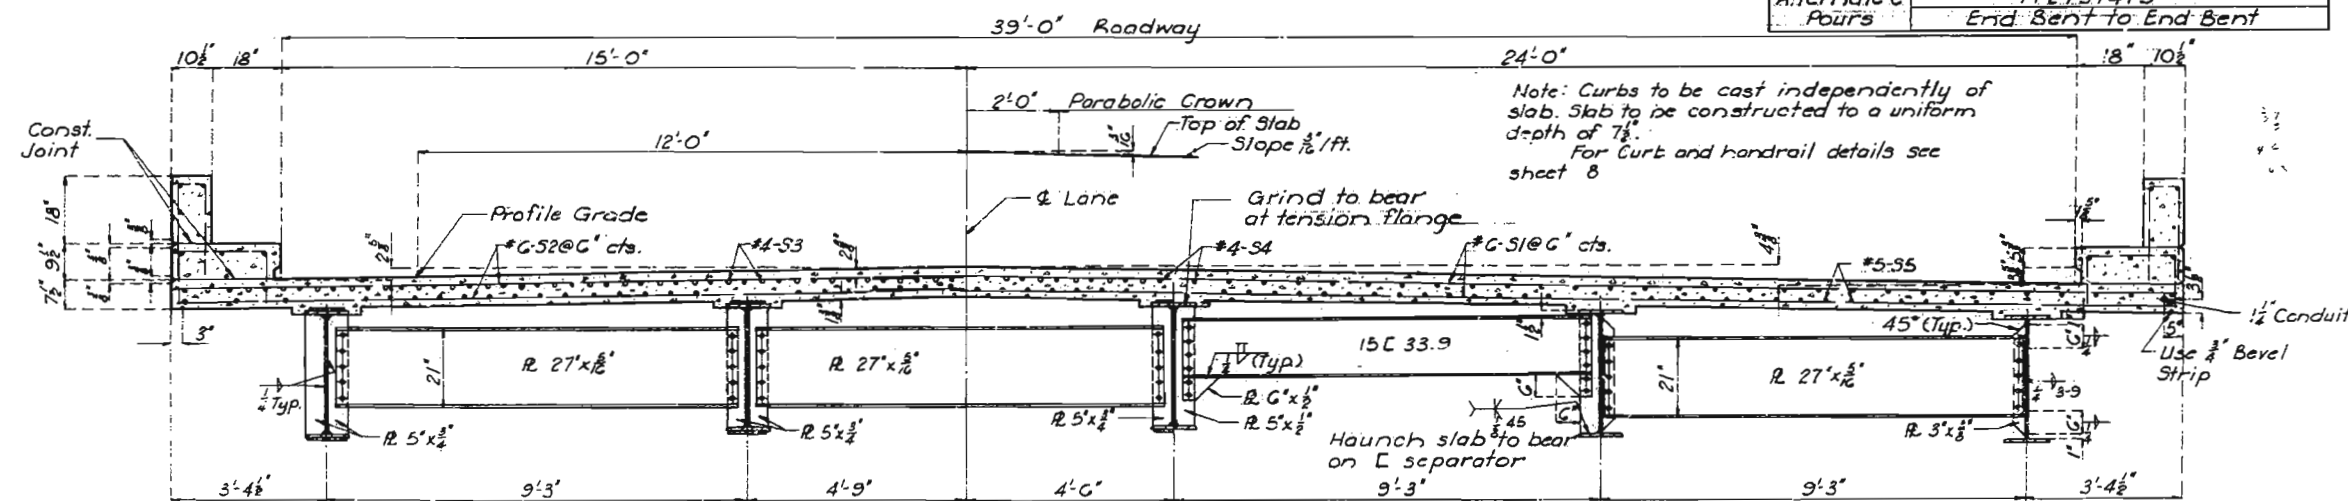


PART SECTION SHOWING CROSS FRAMES

PART SECTION SHOWING
END CHANNEL SEPARATOR

PART SECTION SHOWING
INTERMEDIATE DIAPHRAGMS

East Bound Lane - West Bound Lane Opposite Hand
(Looking East) Level ✓

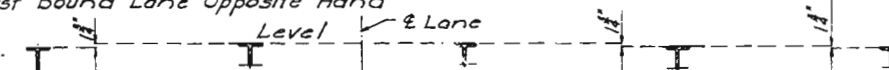

Section Showing Tops of Stringers

Sheet No. 6 of 8

Drawn Oct 1961 by REH
Checked Dec 1961 by GFP


Note: This drawing is not to scale. Follow dimensions

NO CONSTRUCTION CHANGES


L-972

MISSOURI STATE HIGHWAY DEPARTMENT

FED. ROAD DIST. NO.	STATE	FED. AID PROJ. NO.	FISCAL YEAR	SHEET NO.	TOTAL SHEETS
5	MO		19	37	

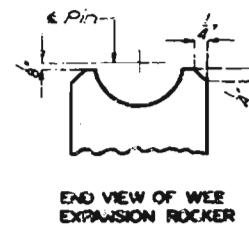


Bottom Flange or Flange R.
(Narrower than Strg. Top R.)

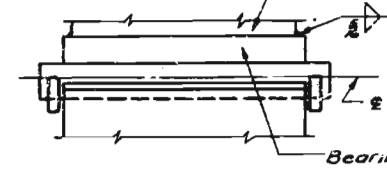

WELDING DETAILS

Bottom Flange or Flange R.
(Wider than Strg. Top R.)

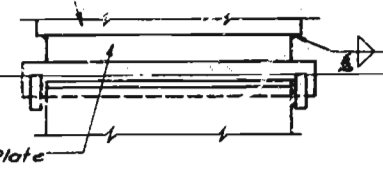

One Layer Roofing Felt or
Coat with Asphaltic Paint.

3/8" Curb R.

Recess curb to permit
free movement of R.

3/8" x 1/4" Slot in R. Top L.
for 1/2" bolt @ abt. 6'-0"
cts. Remove bolt
after concrete has set.

3ar 1 1/2" x 1/2"

Subpunch 1/8" and
to 1/16" in field

R. 11" x 3/4"

*5 x 8" long @ abt. 18' cts.


*5 x 6" long @ abt. 18' cts.

L-G' x 4" x 1/2"


R-G' x 5/8"

PLAN

Note: Expansion Device shall be
fabricated in one section and
shall be bent to conform to
crown and grade of roadway.
#5 Bars for expansion
device shall be structural grade.
Approved stud welded anchors
may be used in lieu of #5 bars
shown.

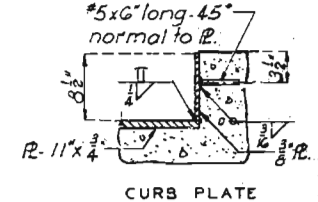

CURB PLATE

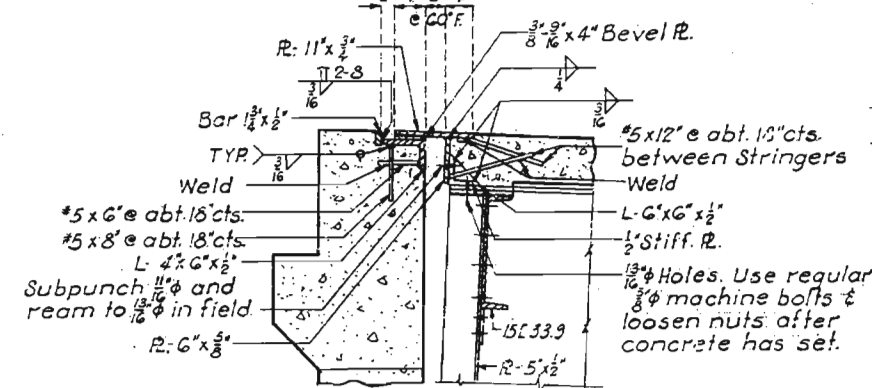


SECTION A-A
DETAILS OF EXPANSION DEVICE AT BENT NO. 4

BRIDGE OVER STERLING AVENUE
STATE ROAD INTERSTATE ROUTE 70
IN KANSAS CITY
PROJECT NO. I-70-1(46) (RT. I-70) STA. 451+19.00 (W.B. LANE)
451+20.02 (E. B. LANE)
JACKSON COUNTY


FINISHED

FINISHED

L-972

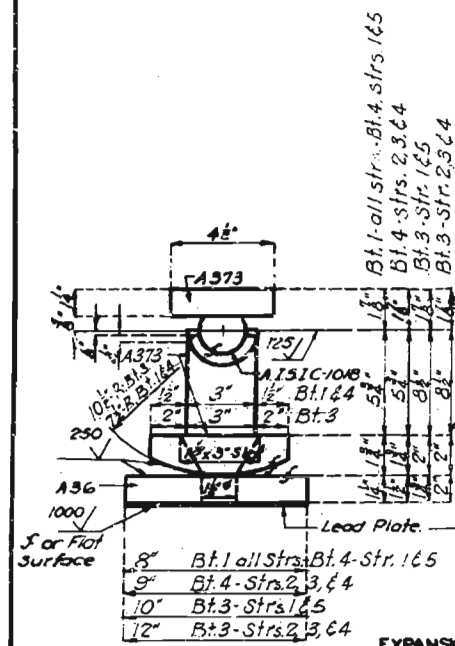


EXPANSION
30-Required - Bents 1,3,4,4

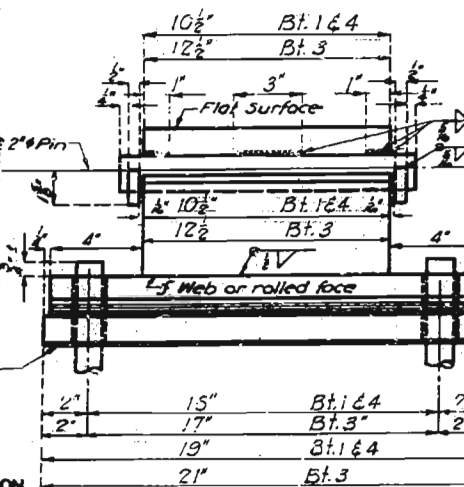


TYPE "D" BEARINGS
(Estimated Weight 8,480 Lbs)
Including Anchor Bolts


Note: Finish all surfaces as indicated.
Material for Type "D" Bearings shall be as noted except A.S.T.M. A7 steel
meeting the carbon and manganese requirements of A-373 steel may be
substituted for A-373.
Material for Alternate Type "D" Bearings shall be as noted.
Anchor Bolts for Type "D" Bearings and alternate Type "D" Bearings shall
be 1/2" swaged bolts and shall extend 12" into concrete with hexagon nuts
and plain washers for Fixed Bearings, no nuts for Expansion Bearings.
Lead plates under bearings shall be approximately 3/8" thickness and
weigh 875 sq. ft. Cost of lead plates shall be included in price bid for other items.
Alternate Type "D" Bearing may be furnished in place of Type "D" Bearing
if it is substituted for.
Material for Bearings will be paid for as Fabricated Structural Carbon Steel.

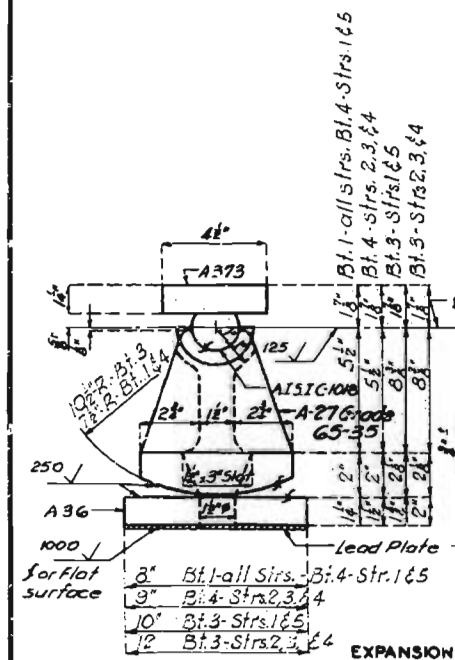


EXPANSION
30-Required - Bents 1,3,4,4

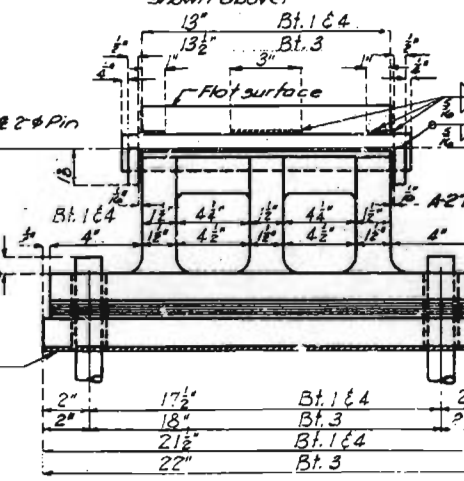

ALTERNATE TYPE "D" BEARINGS

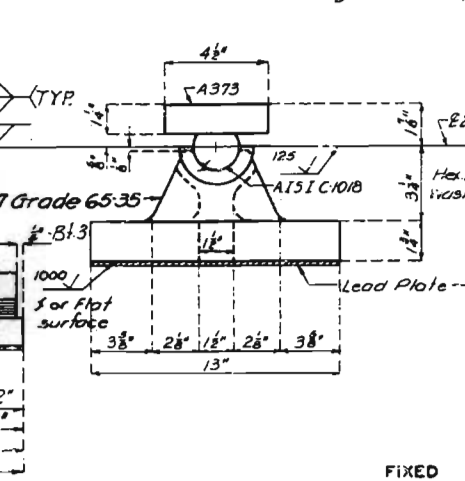

FIXED
10-Required - Bent-2

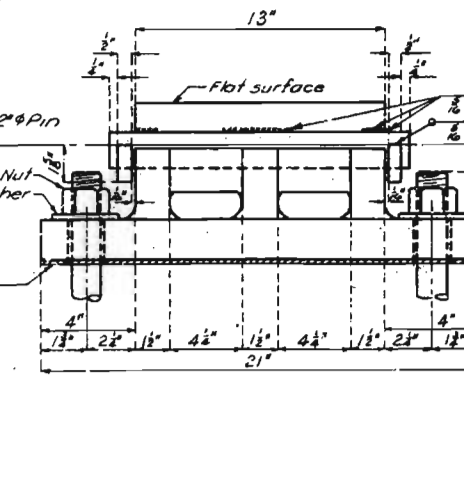



Note: This drawing is not to scale. Follow dimensions

Sheet No. 7 of 8

NO CONSTRUCTION CHANGES

Assembled Dec. 1961 by H.H.B.
Checked Dec. 1961 by G.F.P.

MISSOURI STATE HIGHWAY DEPARTMENT

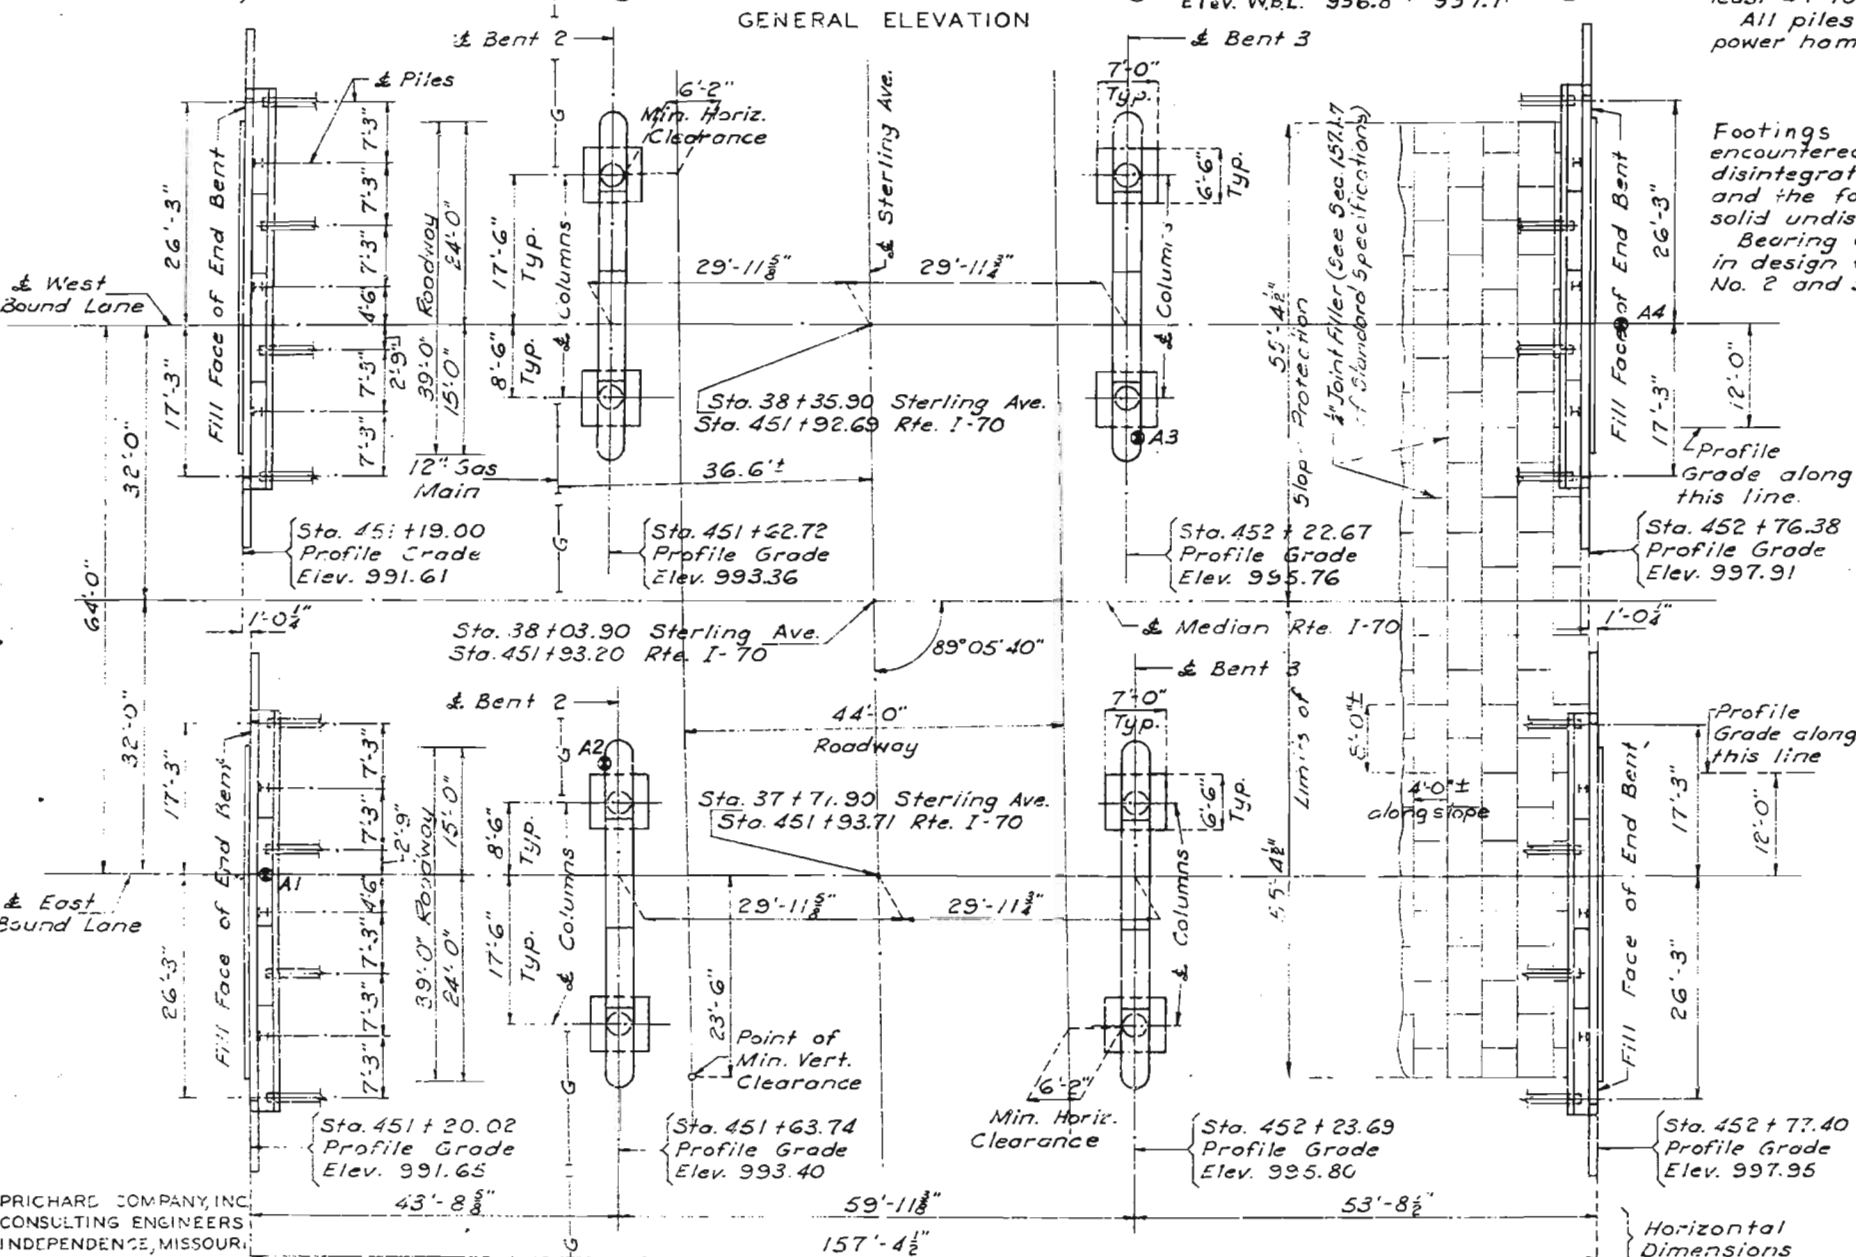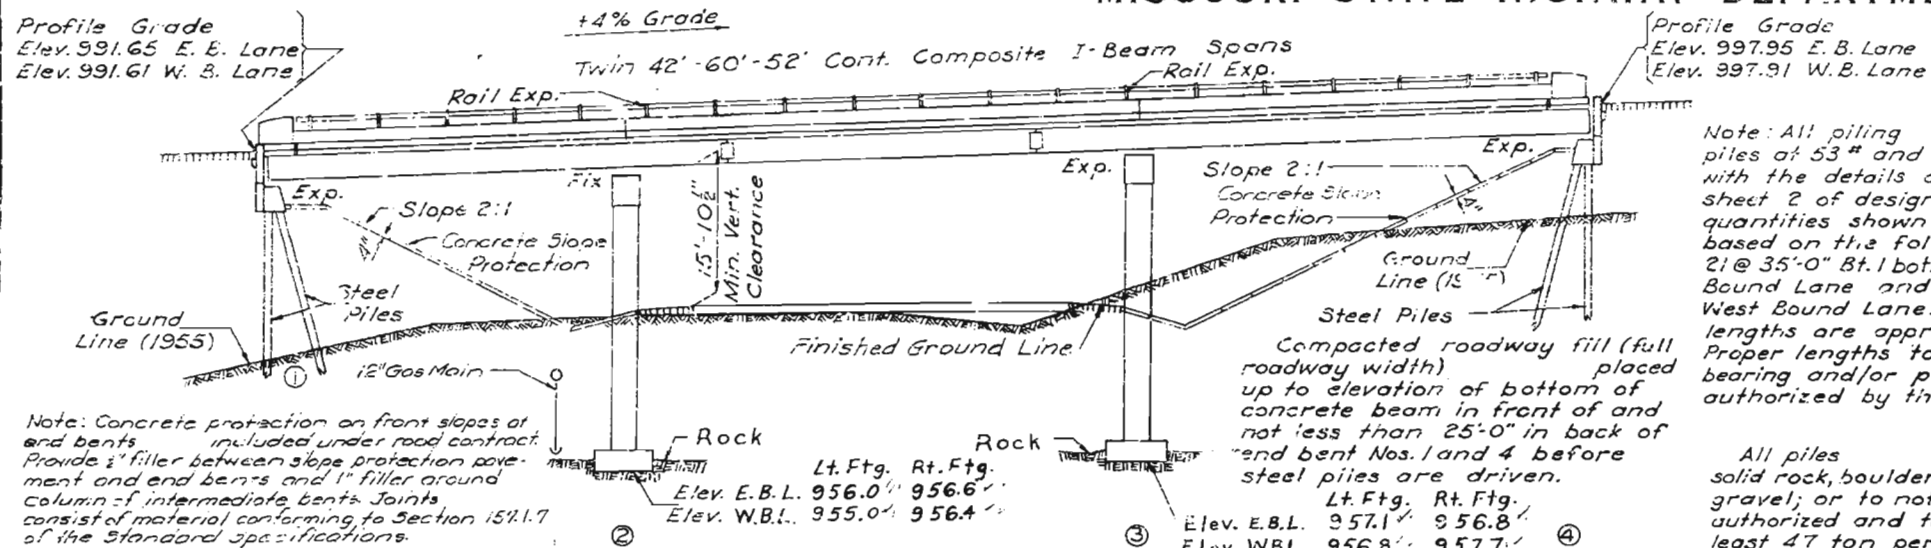

Drawn NOV. 1961 by E.G.R.
Checked DEC. 1961 by G.F.P.

PLAN

Note: This drawing is not to scale. Follow dimensions.

Note: All piling 12" bearing piles of 53# and conform with the details and notes on sheet 2 of design plans. Estimated quantities shown on plans are based on the following lengths: 21 @ 35'-0" Bt. 1 both lanes and Bt. 4 East Bound Lane and 7 @ 40'-0" Bt. 4 West Bound Lane. These indicated lengths are approximate only. Proper lengths to give required bearing and/or penetration authorized by the Engineer.

All piles driven to or into solid rock, boulders, shale, or cemented gravel; or to not less than full length authorized and to sustain a load of at least 47 ton per pile.

All piles driven with a power hammer.


Footings solid hard rock encountered, all loose, shelly, or disintegrated material removed and the footings placed on hard, solid undisturbed rock.

Bearing of 8 ton per sq. ft. used in design of footing for bents No. 2 and 3.

Design Specifications: A.A.S.H.O.-1961.
Loading: H20-S16-44 (15#/sq.ft. Future
Wearing Surface)(Modified 24,000* Tandem Axle)
Structural Steel Stress: ASTM-A36, 20,000*
Structural Steel Stress: ASTM-A7 or
A373, 18,000 #/in²
Reinforcing Steel Stress: 20,000 #/in²
Concrete Class B Stress: 1,200 #/in²
Concrete Class B1 Stress: 1,600 #/in²
Material for Stringers and cover plates
welded to Stringers structural
steel conforming to ASTM-A36. Other
steel as noted on the plans or
A7 steel if not otherwise noted.
Concrete for Substructure
Class B air-entrained.
Concrete for Superstructure
Class B1 air-entrained.
Superstructure deck surface
sealed. (See special provisions.)
Rivets $\frac{3}{4}$ "; holes $\frac{1}{8}$ "; except where
otherwise noted.
Field connections
bolted with high strength bolts. Final pay
weight for Fabricated Structural Carbon
Steel based on the use of field
rivets.
Qualification of welding operators
required.

FINAL PLANS

FED. ROAD DIST. NO.	STATE	FED. AID PROJ. NO.	FISCAL YEAR	SHEET NO.	TOTAL SHEETS
5	MO.		19	2	

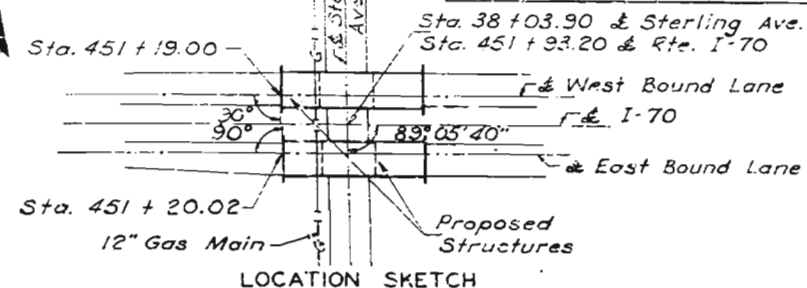

ITEM		SUBSTR.	SUPERSTR.	TOTAL
Class I Excavation for Structures	Cu.Yd.	379.5		379.5
Steel Piles in Place (12")	Lin.Ft.	887		887
Steel Pile Cut-offs (12")	Lin.Ft.	128		128
Class B Concrete	Cu.Yd.	270.6		270.6
Class B1 Concrete	Cu.Yd.		398.2	398.2
Reinforcing Steel	Lb.	45920	129060	174980
Fabricated Structural Carbon Steel	Lb.		244860	244860
Painting	Ton		118.1	118.1
Bridge Rail (Single Tube Type)	Lin. Ft.		591	591
Conduit System @n Structure	Lump Sum		1	1
* Test Holes	Lin. Ft.	37		37
* Class I +25 %	Cu.Yd.	1.0		1.0

Weight of shear connectors is included in weight of Fabricated Structural Carbon Steel but not included for painting.
All excavation for bridge paid for as C/A 221 Excavation for Structures.
* Contingent Item

GENERAL NOTES:

Paint: Shop, none; Field, contact surfaces of bolted field connections, except where high strength bolts are used, one coat of red lead and surfaces inaccessible after erection three coats of red lead. All other exposed surfaces first coat red lead, second coat brown, third coat aluminum. Payment for paint, cleaning and painting such surfaces included in price bid for Painting.

See Section 52.4.7 of Standard Specifications for required painting of steel piles.

Where joint filler is specified on the plans it conform with the requirements of Section 157.2.4 of the Standard Specifications.

Permits obtained for all truck loads over legal length.

Note: Class I Excavation for Structures measured from the ground line (1955) or from the lower limits of roadway excavation, whichever is lower, regardless of the sequence of operations or method of removal.

B.M. Conc. Nail S. Wing Bt^{#1} W.B.L. Elev. 992.34
Conc. Nail S. Wing Bt^{#4} W.B.L. Elev. 998.64

BRIDGE OVER STERLING AVENUE

STATE ROAD INTERSTATE ROUTE 70

IN KANSAS CITY
PROJECT NO. I-70-1(46) (RT. I-70) STA. { 451+19.00 (W. B. LANE)
451+20.02 (E. B. LANE)

JACKSON COUNTY

SUBMITTED BY E. LYN CROWLEY FINISHED

SIGNATURE *[Signature]*
REGISTERED PROFESSIONAL ENGINEER
SERIAL NUMBER E-5993

SUBMITTED BY E. B. Jenkins DATE 3/1/52
BRIDGE ENGINEER
APPROVED BY J. C. Corbett DATE 3/19/52

STD. 54.00

L-972



Sheet No. 14 of 2

FINAL PLANS

MISSOURI STATE HIGHWAY DEPARTMENT

FINAL PLANS

FED. ROAD DIST. NO.	STATE	FED. AID PROJ. NO.	FISCAL YEAR	SHEET NO.	TOTAL SHEETS
5	MO.		19	63	

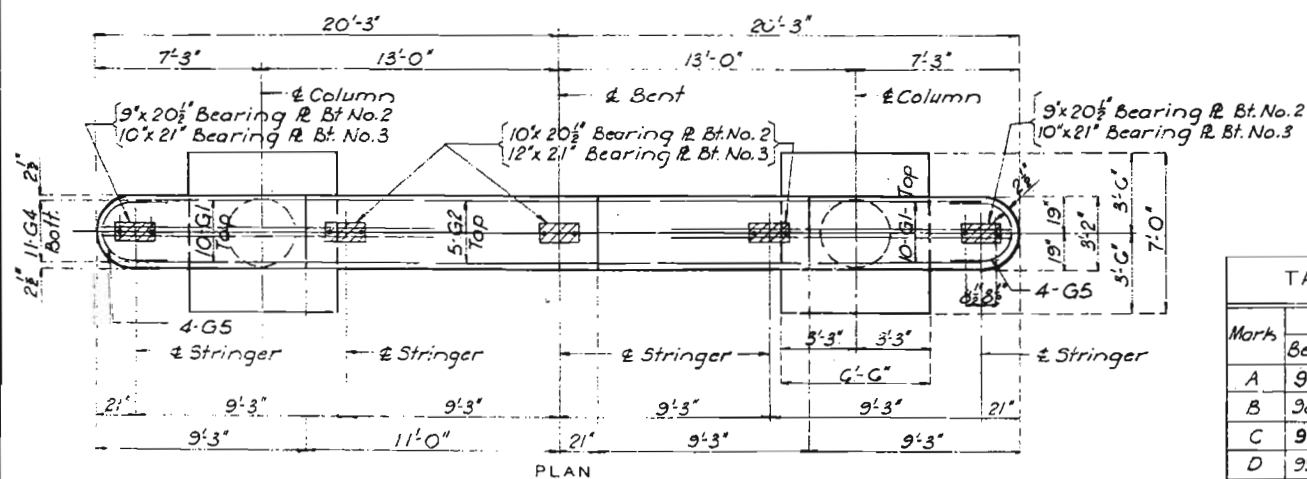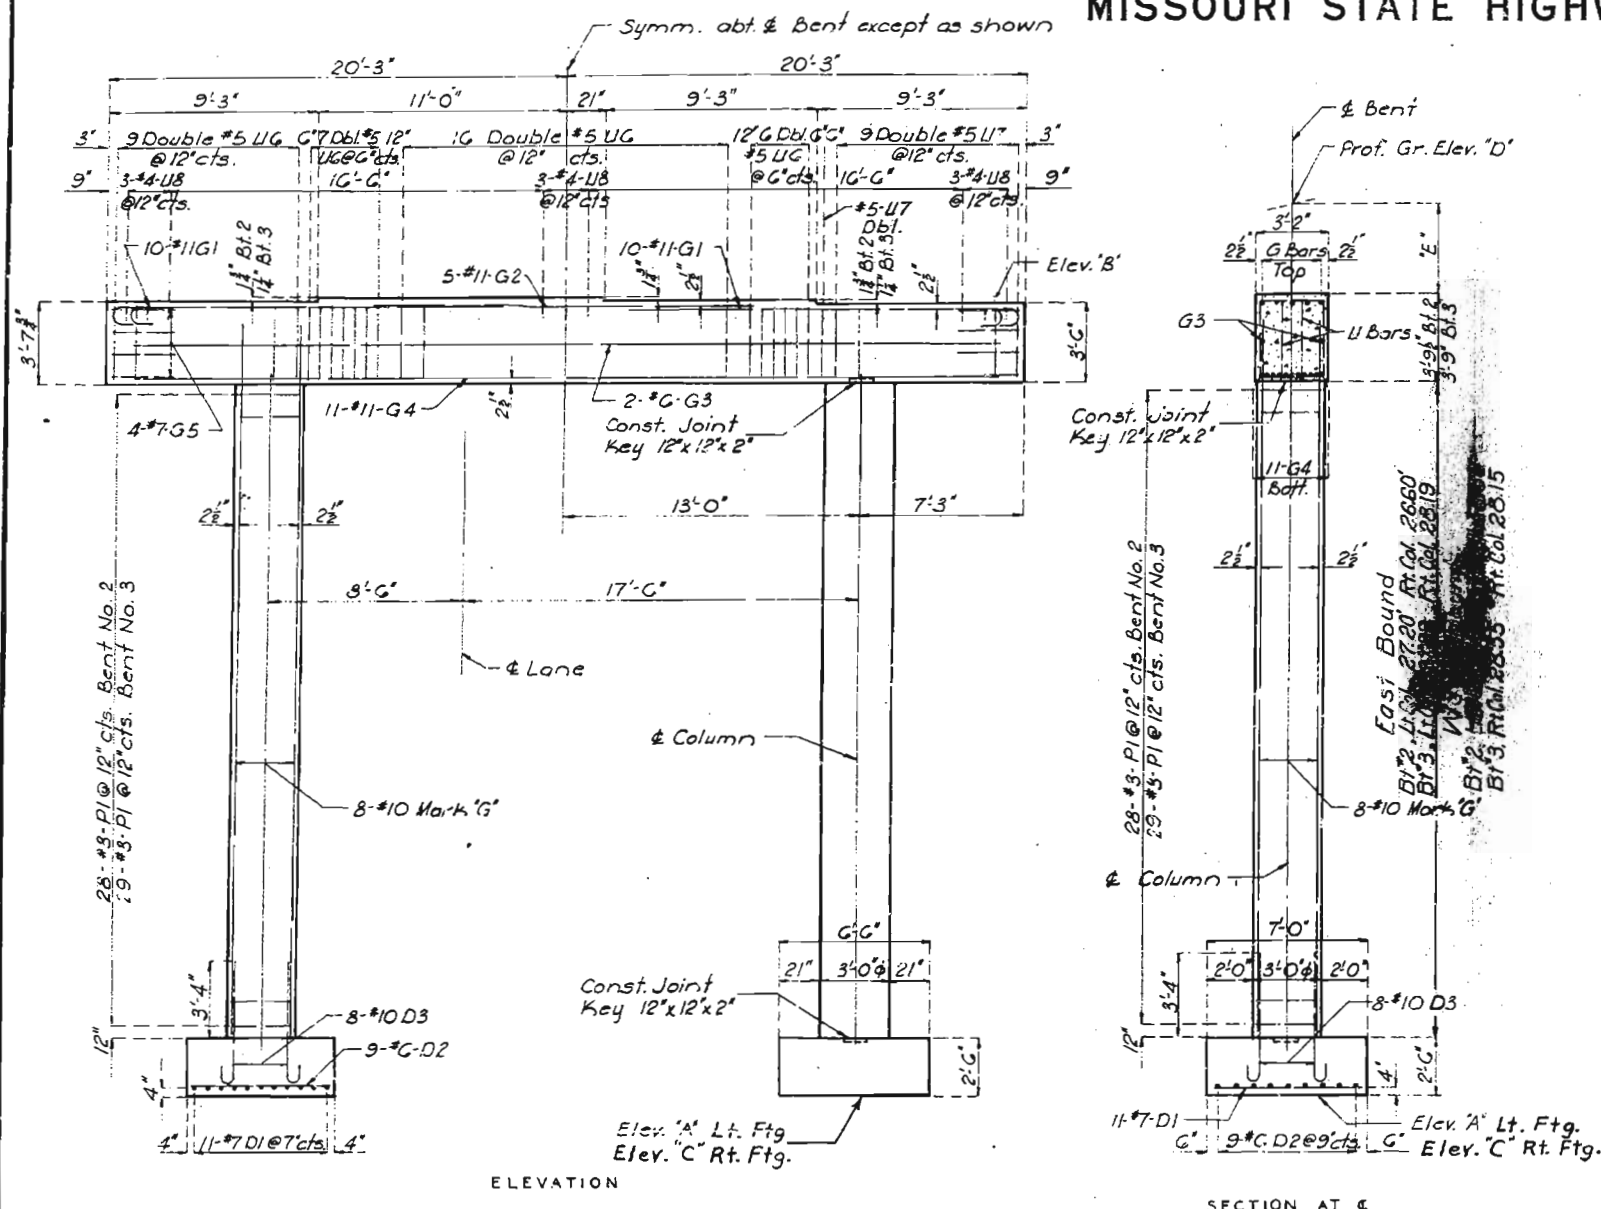

DETAILS OF INTERMEDIATE BENTS NO. 2 AND 3 (East Bound Lane Shown, West Bound Lane Opposite Hand)

TABLE OF VARIABLES				
Mark	E. B. Lane	W. B. Lane	Bent 2	Bent 3
A	956.0	957.1	955.0	956.4
B	989.20	990.39	989.16	990.35
C	956.6	956.8	956.8	956.8
D	993.40	995.80	993.36	995.76
E	3'-10"	4'-6"	3'-10"	4'-6"
G	P2	P3	P4	P5

COMPLETE BILL OF REINFORCING STEEL													
NO.	SIZE	LENGTH	MARK	LOCATION		BENDING SKETCHES & CUTTING DIAGRAMS							
SUPERSTRUCTURE													
588	#5	4'-0"	C1	Curb									
588	#4	4'-9"	C2	Parapet									
40	#5	4'-3"	C3	Curb									
16	#5	21'-6"	C4	Parapet									
24	#5	22'-6"	C5	Curb									
40	#5	32'-9"	C6	Curb & Parapet									
16	#5	26'-0"	C7	Parapet									
24	#5	27'-0"	C8	Curb									
8	#5	5'-3"	C9										
64	#4	3'-9"	R1	End Post									
16	#5	8'-0"	R2										
8	#5	7'-9"	R3										
8	#5	7'-6"	R4										
8	#5	7'-0"	R5										
1248	#6	28'-3"	S1	Slab									
1248	#6	17'-0"	S2										
224	#4	16'-0"	S3										
580	#4	32'-3"	S4										
620	#5	32'-6"	S5										
END BENTS													
8	#6	24'-3"	H1	Backwall		4	4	4	4				
24	#4	24'-0"	H2			8	8	4	4				
16	#6	15'-6"	H3	Beam		4	4	4	4				
16	#6	35'-0"	H4	Beam		4	4	4	4				
16	#6	24'-3"	H5			4	4	4	4				
32	#6	25'-3"	H6			8	8	8	8				
48	#6	9'-0"	H7	Wing		12	12	12	12				
20	#6	13'-6"	H8			5	5	5	5				
8	#4	20'-0"	H9	Slab Notch		2	2	2	2				
16	#6	23'-0"	H10	Backwall				8	8				
8	#6	5'-0"	H11	Wing				4	4				
4	#6	14'-3"	T1	Wing		2	2						
4	#6	14'-6"	T2			2	2						
8	#6	15'-3"	T3					4	4				
28	#4	12'-0"	U1	Beam		12	12	12	12				
4	#4	12'-3"	U2			32	32						
60	#4	3'-0"	U3			15	15	15	15				
156	#3	21'	U4	Slab Notch		39	39	39	39				
64	#4	12'-3"	U5	Beam				32	32				
4	#4	4'-9"	V1	Backwall		88	88						
48	#4	6'-3"	V2			8	8	16	16				
6	#4	11'-0"	V3	Wing		3	3						
6	#4	11'-3"	V4			3	3						
160	#4	5'-9"	V5	Backwall				80	80				
6	#4	11'-0"	V6	Wing				3	3				
6	#4	10'-9"	V7					3	3				
40	#2	19'-9"	W1	A.B. Wells		10	10	10	10				
INTERMEDIATE BENTS NO. 2 & 3													
88	#7	6'-0"	D1	Footing		22	22	22	22				
72	#6	6'-0"	D2			18	18	18	18				
64	#10	6'-9"	D3			16	16	16	16				
80	#11	16'-0"	G1	Beam		20	20	20	20				
20	#11	17'-0"	G2			5	5	5	5				
8	#6	38'-0"	G3			2	2	2	2				
44	#11	26'-0"	G4			11	11	11	11				
32	#7	7'-0"	G5			8	8	8	8				
228	#3	9'-6"	P1	Column		56	56	56	56				
16	#10	31'-2"	P2			16							
16	#10	32'-6"	P3				16						
16	#10	31'-3"	P4					16					
16	#10	33'-0"	P5						16				
304	#5	11'-6"	U6	Beam		76	76	76	76				
80	#5	11'-0"	U7			20	20	20	20				
36	#4	4'-0"	U8			9	9	9	9				
40	#2	19'-9"	W1	A.B. Wells		10	10	10	10				

BRIDGE OVER STERLING AVENUE

STATE ROAD INTERSTATE ROUTE 70 FINISHED
IN KANSAS CITY
PROJECT NO. I-70-1(46) (RT. I-70) STA. 451+19.00 (W.B. LANE)
451+20.02 (E.B. LANE)
JACKSON COUNTY

Drawn Nov. 1961 by R.E.H.
Checked Dec. 1961 by G.F.P.


Note: This drawing is not to scale. Follow dimensions.

FINAL PLANS

L-972

MISSOURI HIGHWAY AND TRANSPORTATION COMMISSION

FED. ROAD DIST. NO.	STATE	FED. AID PROJ. NO.	FISCAL YEAR	SHEET NO.	TOTAL SHEETS
5	MO.		15	48	
SEC. 21 SUR. 21 TWP. 49N RGE. 32W					

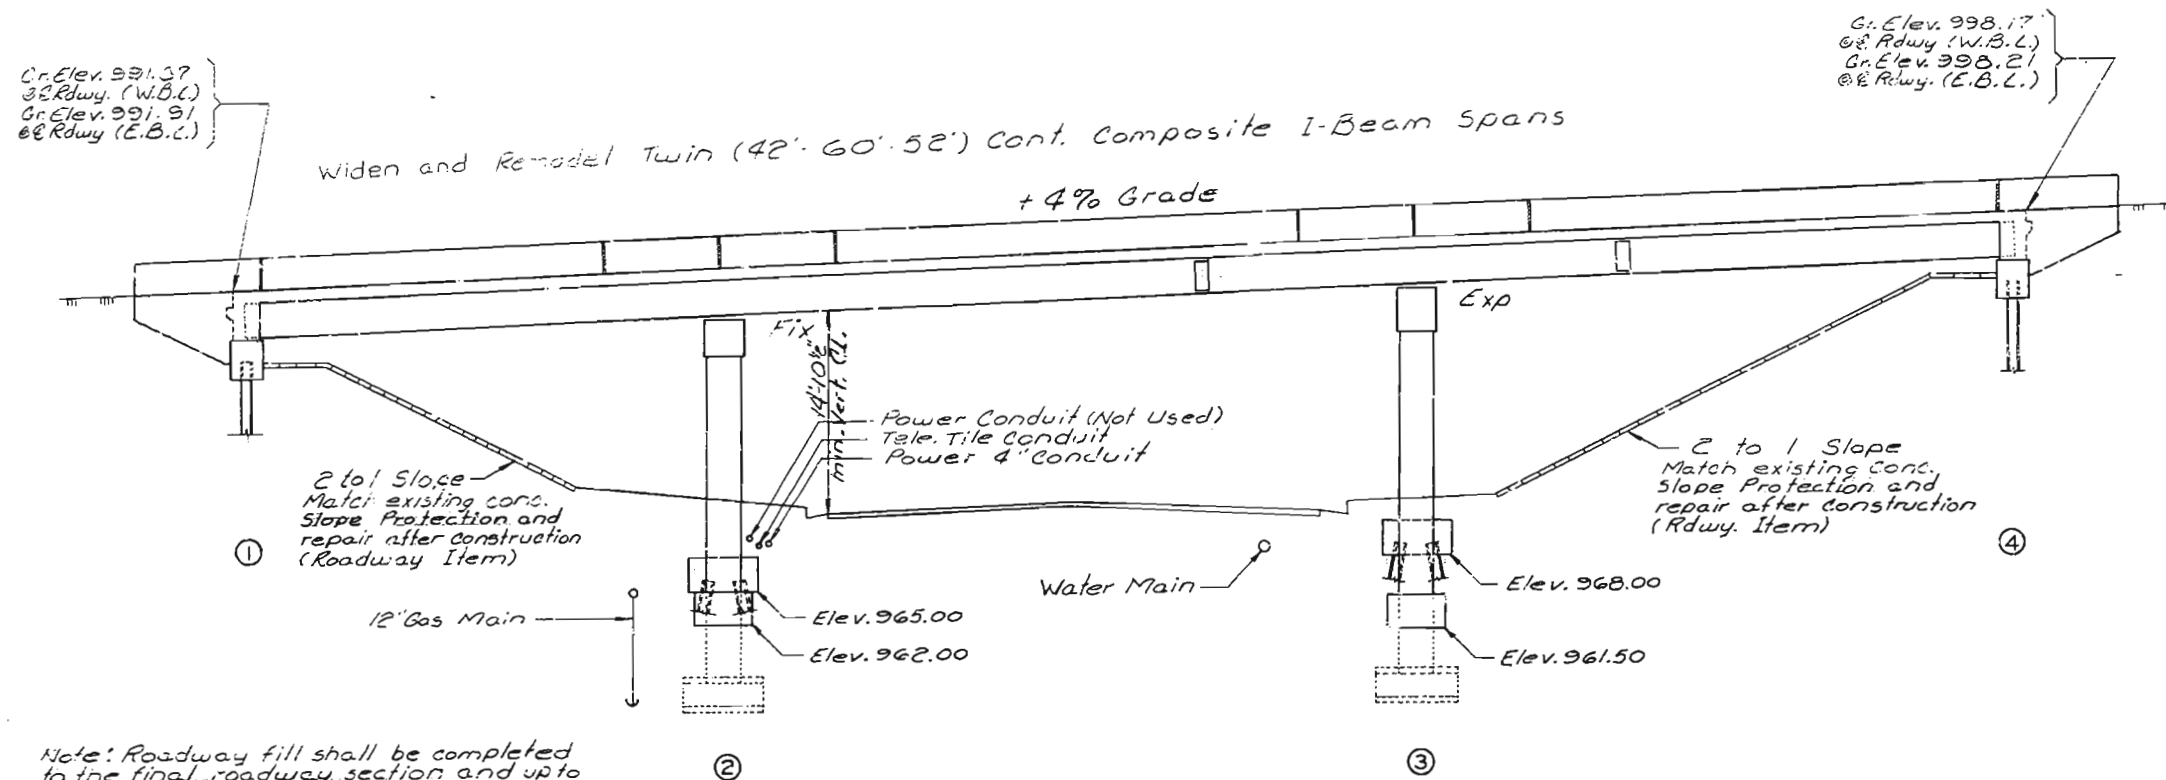

GENERAL ELEVATION

Note: Roadway fill shall be completed to the final roadway section and up to the elevation of the bottom of the conc. beam within the limits of the structure and for not less than 25' in back of the fill face of the end bents before piles are driven for any bents falling within the embankment section.

ESTIMATED QUANTITIES				
ITEM		SUBSTR.	SUPERSTR.	TOTAL
Special Work	Lump Sum			1
Class I Excavation	Cu. Yd.	170		170
Class B Concrete	Cu. Yd.	120.0		120.0
Class B2 Concrete	Cu. Yd.		283.4	283.4
Safety Barrier Curb	Lin. Ft.		662	662
Latex Concrete Wearing Surface	Sq. Yd.		1382	1382
Reinforcing Steel	Lb.	15370	24680	40050
Reinforcing Steel (Epoxy Coated)	Lb.		30130	30130
Fabricated Structural Carbon Steel	Lb.		126,740	126,740
Painting (System B) Green	Lump Sum			1
Conduit System on Structure	Lump Sum			1
Structural Steel Pile 10"	Lin. Ft.	594		594

Note:

Outline of old work is indicated by light dashed lines. Heavy lines indicate new work. Contractor shall verify all dimensions in field before ordering new steel.

Bars bonded in old concrete not removed shall be cleanly stripped and embedded into new concrete where possible. If length is available, old bars shall extend into new concrete at least 40 diameters for smooth bars and 30 diameters for deformed bars.

Anchors shall be of the self drilling expansion type, made of casehardened and drawn carburized steel, with self-cutting annular broaching grooves.

Cost of furnishing and installing hook anchor bolt assemblies shall be included in contract unit price for concrete.

Utility lines in vicinity of Bent 2 to be supported during construction and not relocated. See special Provisions

Note: All concrete and reinforcement in end bents (except pile cap beam) are included with superstructure quantities. For Plan of Structure see sheet No. 2

GENERAL NOTES:

Design Specifications:
A.A.S.H.T.O. - 1977

Design Loading:

H20-44

15' per Sq. Ft. Future Wearing Surface

Modified 24,000* Tandem Axle

Earth 120'cuft Equivalent Fluid Pressure 30'cuft

Fatigue Stress - Case I

Design Unit Stresses:

Class B Concrete (Substructure)

$f_c = 1,200 \text{ psi}$

Class B1 Concrete (Substructure)

Class B2 Concrete (Substructure)

except Safety Barrier Curb

Reinforcing Steel (Grade 60)

Structural Carbon Steel

Steel Pile

Fabricated Steel:

Field connections, High Strength

Bolts 3/4" holes 1/8" except as noted.

Joint Filler:

All joint filler shall meet the requirement of Std. Spec. 1057.24 except otherwise noted.

Reinforcing Steel:

Minimum clearance to reinforcing steel shall be 1 1/2" unless otherwise shown.

Paint:

Paint: System B by contractor in accordance with Std. Spec. 712.12. (Color of the final field coat for System B shall be green.)

Areas to be encased in end bent concrete shall be painted one coat of system C. primer and scratched or damaged surfaces are to be touched up in field before concrete is poured.

Construction Clearance:

A minimum vertical clearance of 14'0" from crown of existing lanes and a minimum lateral clearance of 28'0" centered on Sterling Ave. shall be maintained during construction.

Traffic Maintained:

Traffic over structure to be maintained during construction.

In order to maintain grade and a minimum 1 1/2" Latex Modified Concrete it is anticipated that an average application depth of 1 1/2" will be necessary. No payment will be allowed for additional labor, materials or equipment required for this necessary minimum and/or variable depth of Latex Modified Concrete.

B.M. #1 Elev. 992.34 Conc. nail S. wingwall bent No. 1 W.B.L.

BRIDGE OVER STERLING AVENUE

STATE ROAD FROM RTE. I-435 TO RTE. I-470

ABOUT 2.1 MILES EAST OF RTE. I-435

PROJECT NO.

STA. 451+93.20

JOB NO. 4- I070 - 343

RTE. I-70

JACKSON

COUNTY

STD. 611.60

STD. 706.35

L-972 R

DESIGNED JAN. 1981

DETAILED MAY 1981

CHECKED 1981

Note: This drawing is not to scale. Follow dimensions.

Sheet No. 1 of 24.

DATE Dec. 22, 1981

Standard Penetration Test

Depth	Blows/6"	PP(TSF)
5'	3-5-8	2.5
10'	4-7-8	4.0
15'	4-7-8	4.0
20'	5-8-9	3.5
25'	7-8-9	3.0
30'	11-11-11	No Recovery

Elev. 992.2
Concrete and base
Elev. 991.2

Fill, tan and gray shale, stiff

Elev. 973.2

Clay and shale, stiff.

Elev. 956.7
Limestone, gray, contains two thin shale seams.
Elev. 954.4
Limy shale and limestone layers.
Elev. 950.5
Shale, dark gray, very hard.
Elev. 946.7

①
(CORE)

Elev. 971.2

Gray shale, brown silty clay.

Elev. 959.4

Gray silty clay.

Elev. 954.5

Limestone, hard.
Elev. 954.2

②

Standard Penetration Test

Depth	Blows/6"	PP(TSF)
15.8'	3-21-100+	3.0

Elev. 973.6
Brown to grayish brown silty clay.
Elev. 970.1
Gray silty clay.
Elev. 967.4
Gray silty clay with scattered gravel, soft.
Elev. 963.6
Brown clay, stiff.
Elev. 959.6
Yellowish brown weathered shale.
Elev. 957.1
Gray limestone, medium to thick bedded.
Elev. 955.4
Gray shale.
Elev. 955.2
Gray limestone, medium bedded.
Elev. 953.6
Gray limy shale, laminated, with thin gray shale lenses.
Elev. 946.9

③
(CORE)

Elev. 998.0
Paved shoulder.
Elev. 997.0

Gray and tan shale and brown silty clay, P.R.W.T.

Elev. 978.0

Brown silty clay.

Elev. 966.0

Tan shale.
Elev. 960.8
Limy shale or weathered limestone.
Elev. 959.3
Limestone, hard.
Elev. 956.7

④

BORING DATA


Note: For location of borings see Sheet No. 2

PILE & FOOTING DATA											
BENT NO.		1			2			3			4
		EXT. (LT.)	INTERIOR	EXT. (RT.)	EXT. (LT.)	INTERIOR	EXT. (RT.)	EXT. (LT.)	INTERIOR	EXT. (RT.)	
BEARING PILE	PILE TYPE AND SIZE	HP10x42	HP10x42	HP10x42	HP10x42	HP10x42	-	HP10x42	HP10x42	-	HP10x42
	NUMBER	1	4	1	4	3	-	4	3	-	6
	APPROXIMATE LENGTH FT.	25	29	27	11	11	-	12	12	-	25
	DESIGN BEARING TONS	43	43	43	40	40	-	41	41	-	45
	HAMMER ENERGY REQD. FT. LBS.	9600	9600	9600	9400	9400	-	9600	9600	-	10000
SPREAD	FOUNDATION MATERIAL						Shale				Shale
FOOTINGS	DESIGN BEARING TONS / SQ. FT.						4.2				4.2


Minimum energy requirement of hammer based on plan length and design bearing value of piles.
All pile shall be driven to practical refusal.

FED. ROAD DIST. NO.	STATE	FED. AID PROJ. NO.	FISCAL YEAR	SHEET NO.	TOTAL SHEETS
5	MO.		19	51	


Note: Cost of special damp-proofing to be included in price bid for other items.

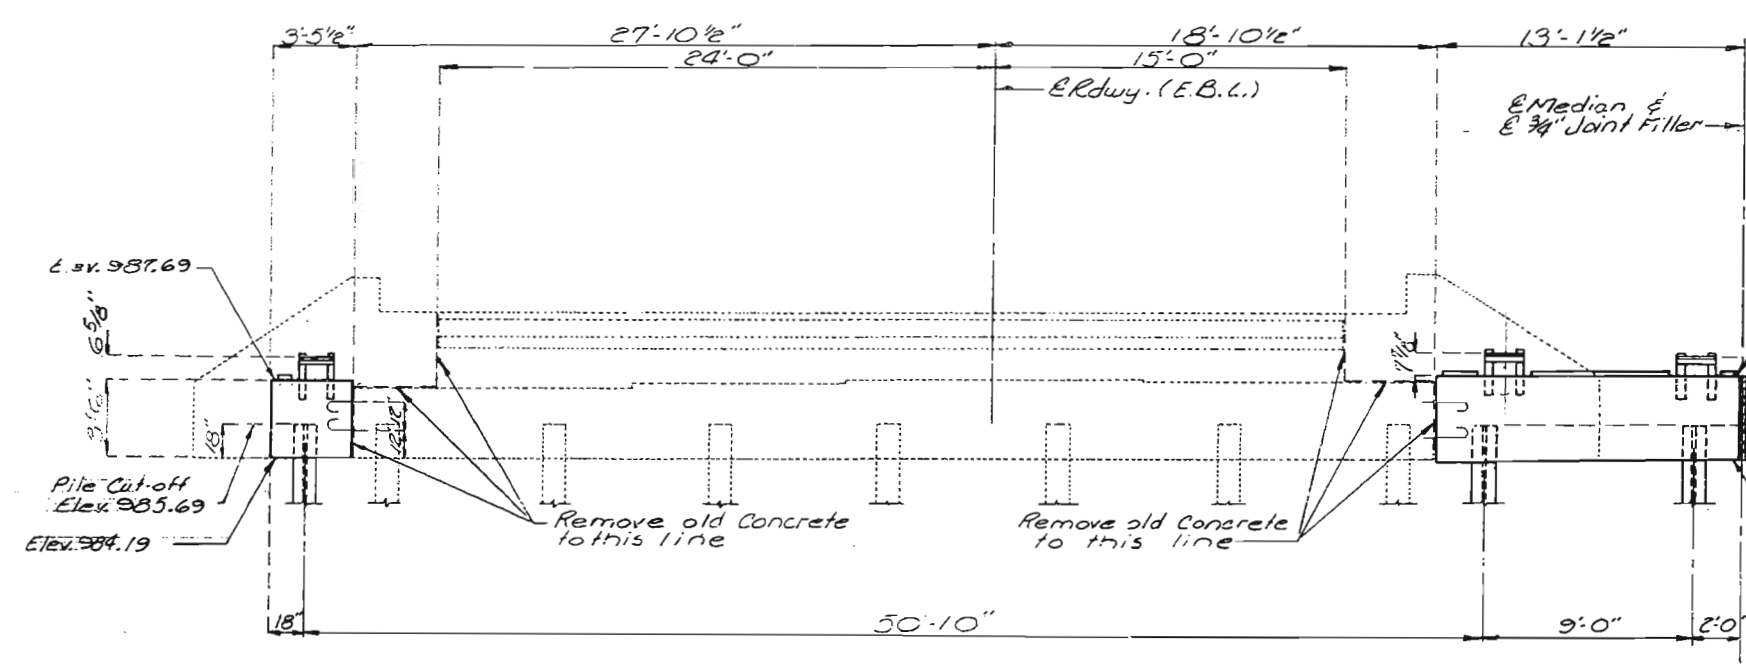


ELEVATION OF SUBSTRUCTURE

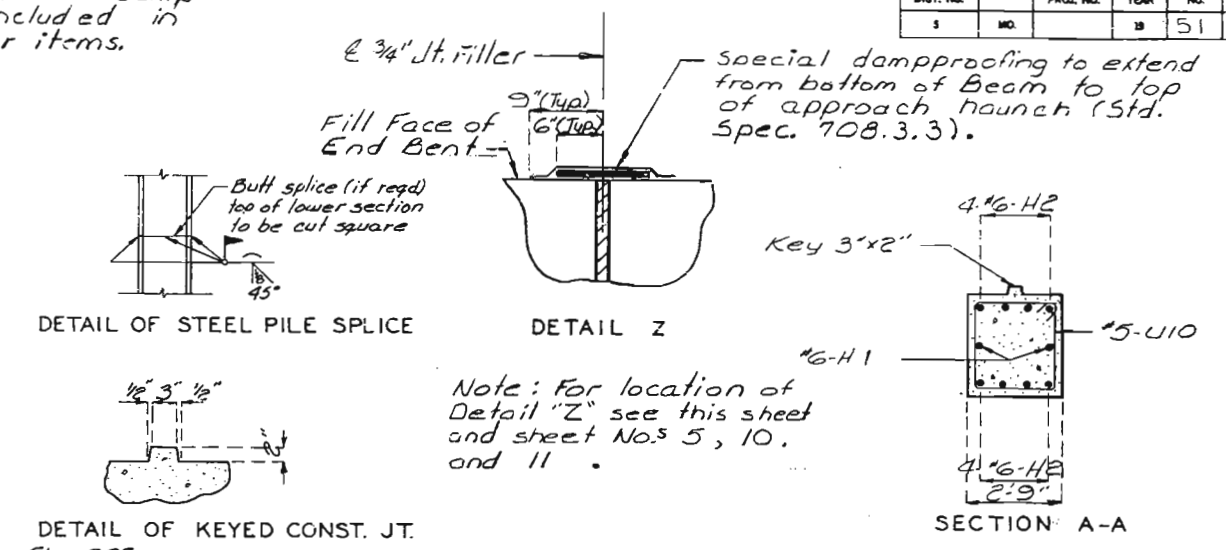


Note: For details of 3/4" Hooked Anchor Bolts see sheet No. 8

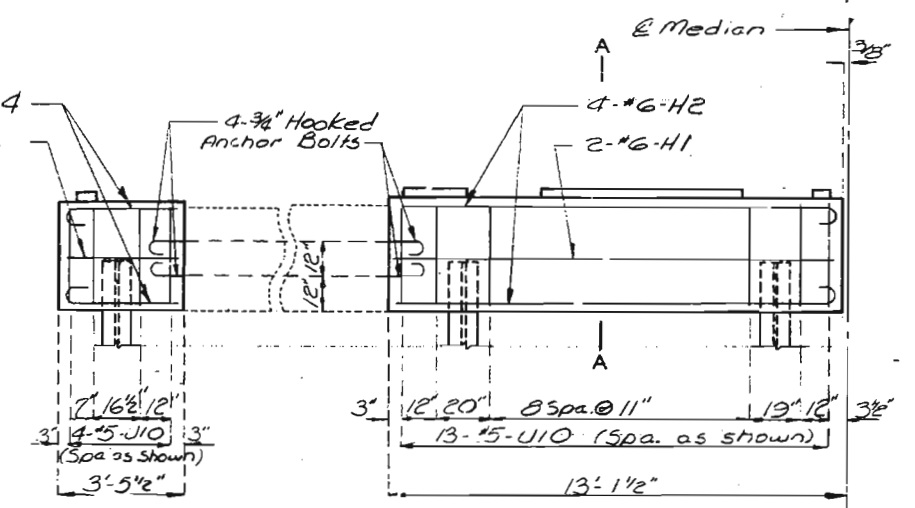

ELEVATION OF SUBSTRUCTURE SHOWING REINFORCEMENT

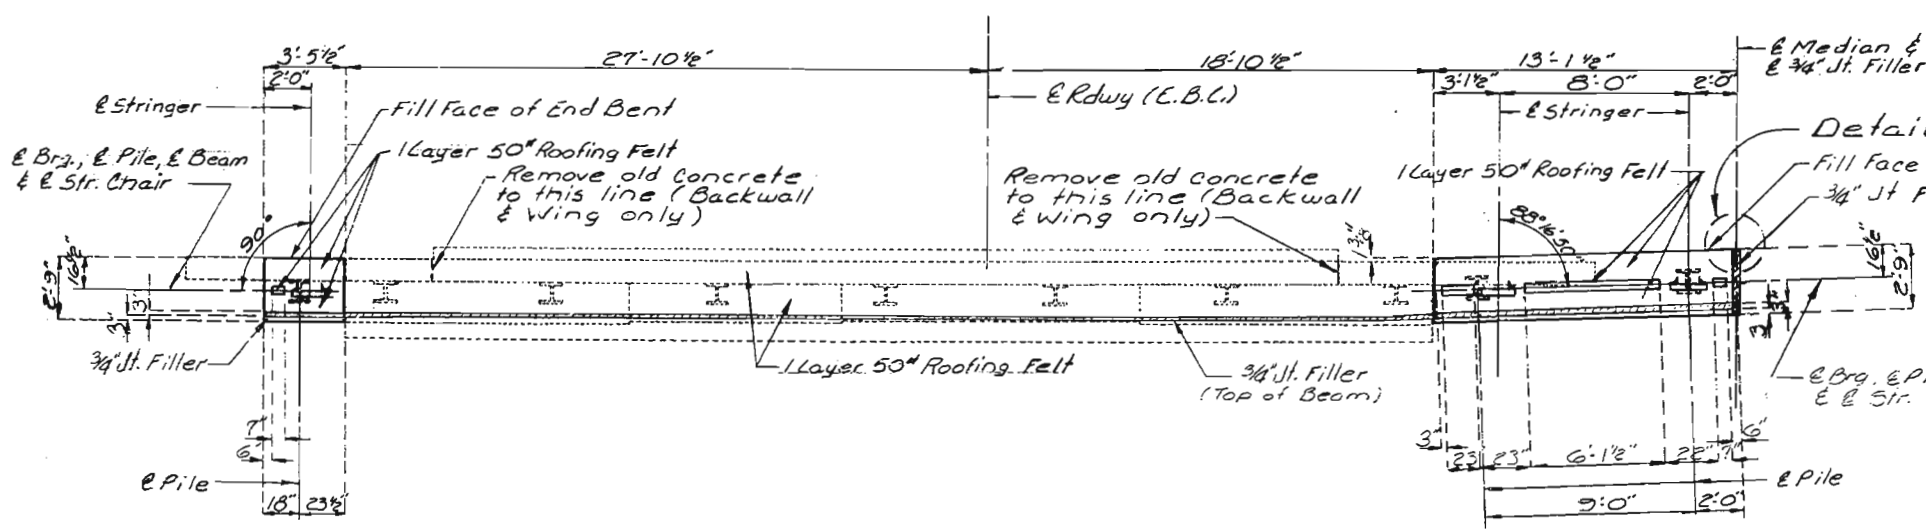


PLAN OF SUBSTRUCTURE

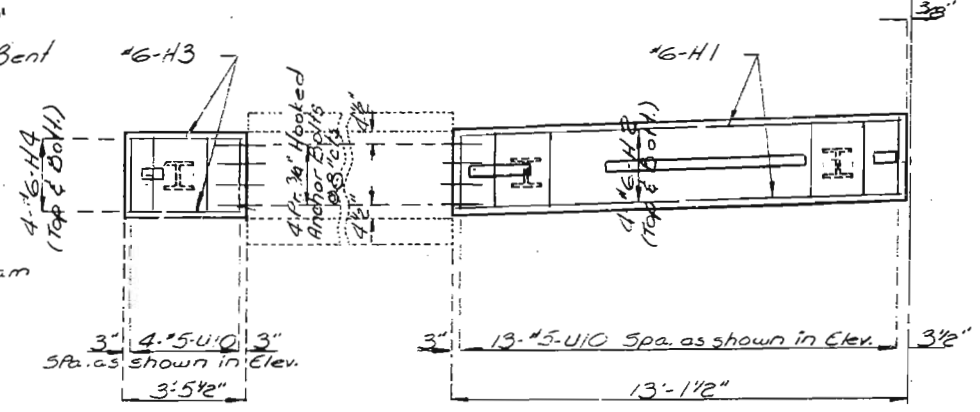


PLAN OF SUBSTRUCTURE SHOWING REINFORCEMENT

DETAILS OF END BENT NO. 1 (EAST BOUND LANE)

FED. ROAD DIST. NO.	STATE	FED. AID PROJ. NO.	FISCAL YEAR	SHEET NO.	TOTAL SHEETS
5	MO.		18	55	

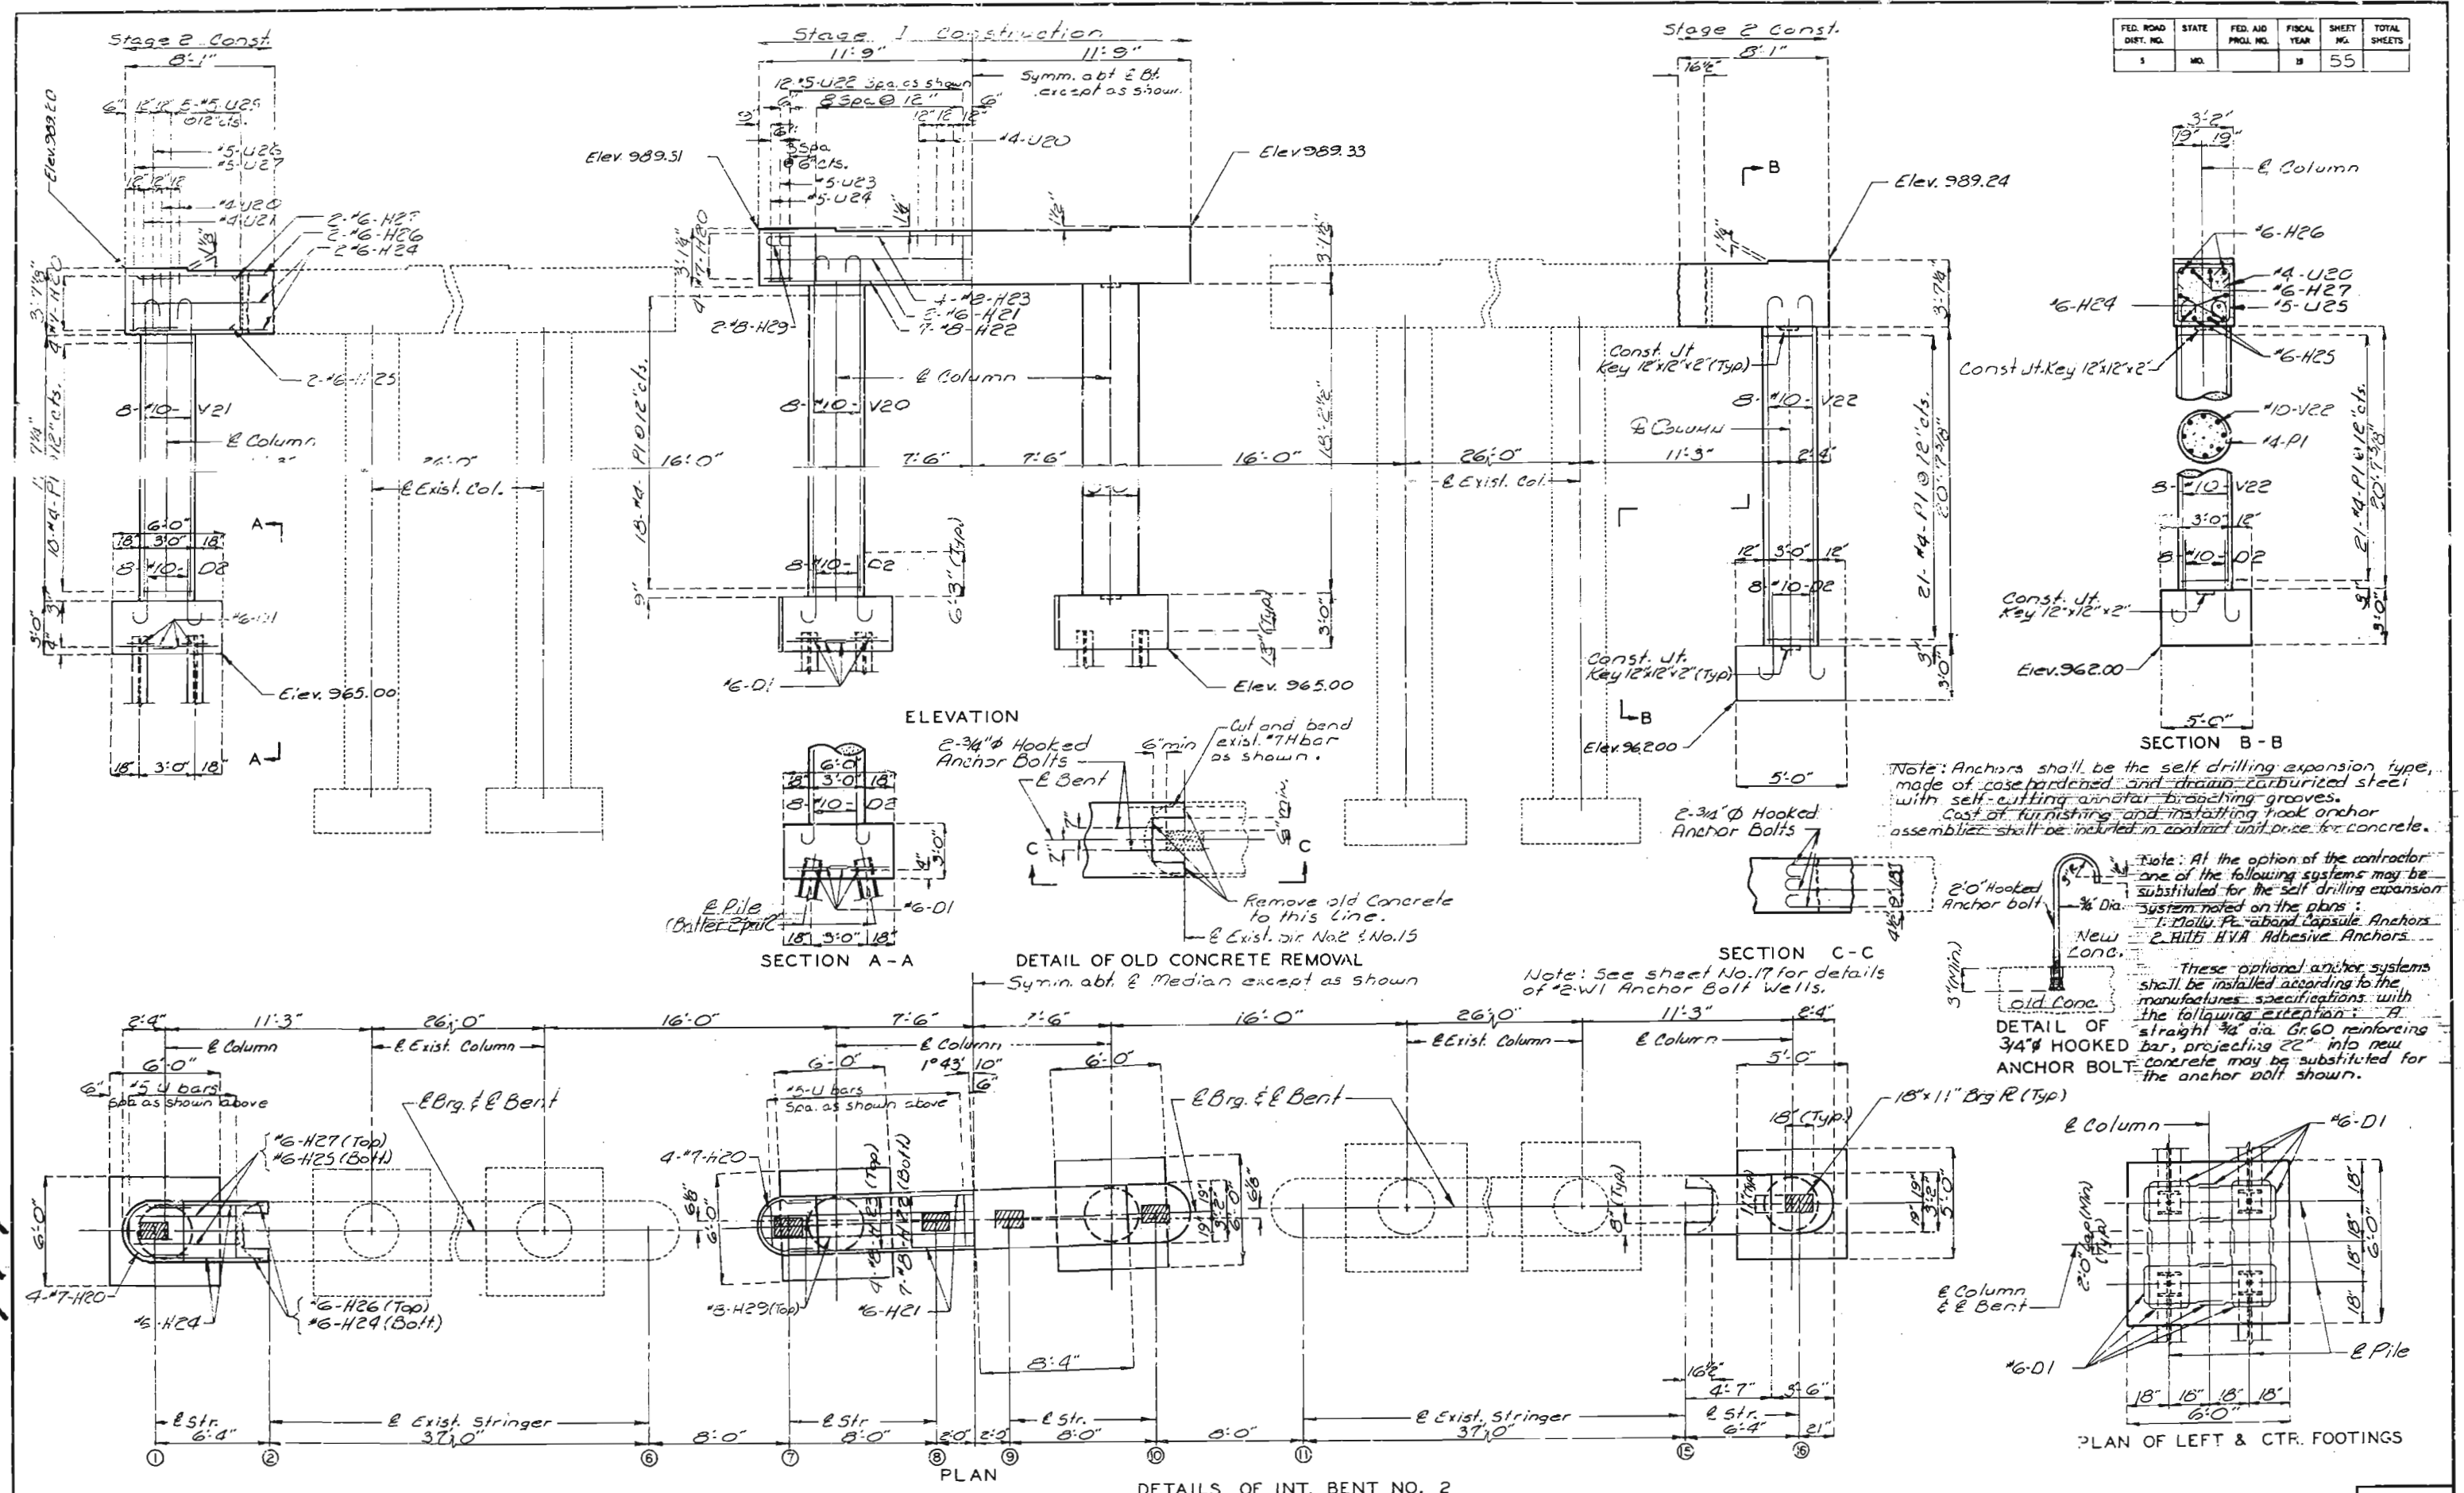





FED. ROAD DIST. NO.	STATE	FED. AID PROJ. NO.	FISCAL YEAR	SHEET NO.	TOTAL SHEETS
5	MO.		18	57	

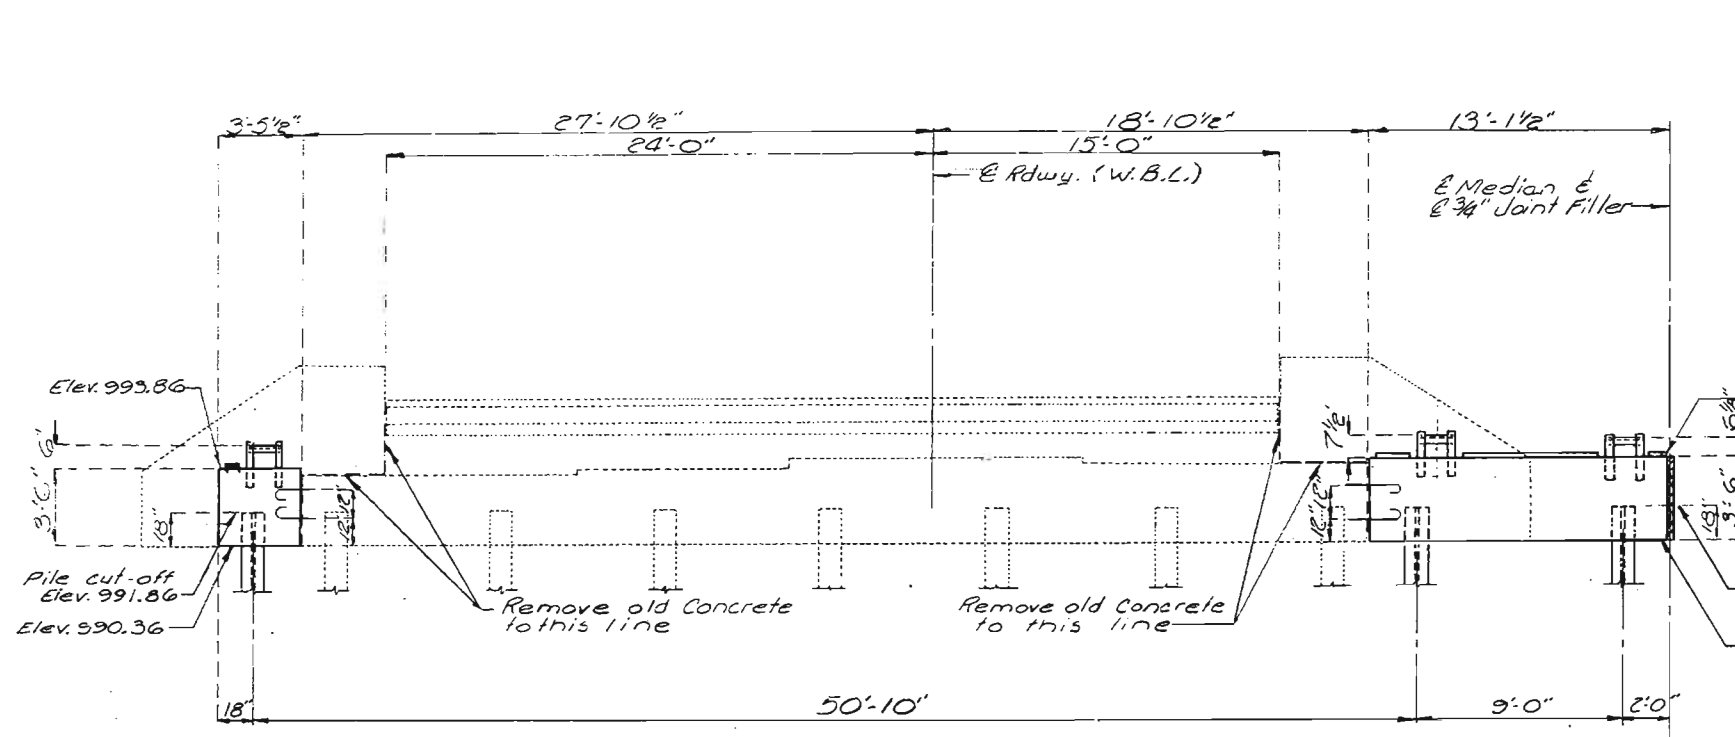


ELEVATION OF SUBSTRUCTURE

Note: For detail of 3/4" Hooked Anchor Bolts See sheet No. 3


Note: For Detail "Z" see sheet No. 4

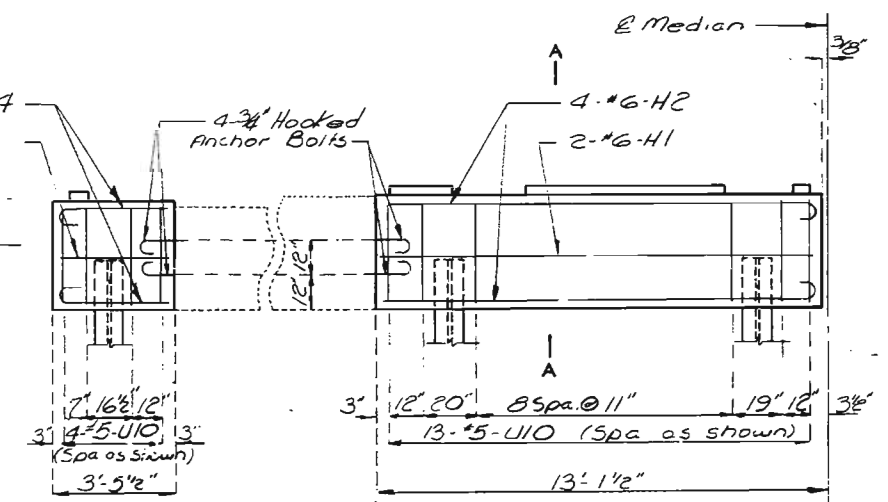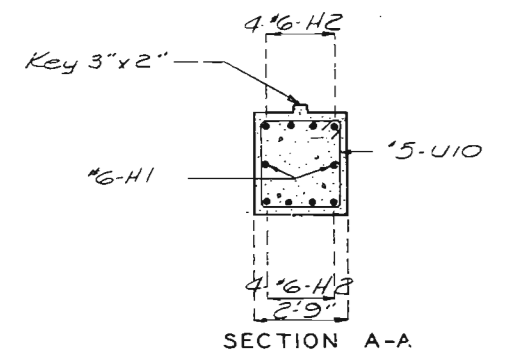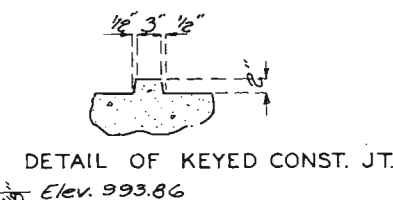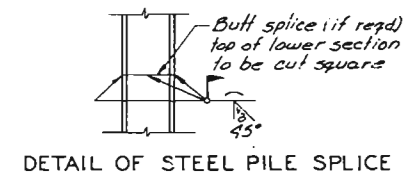

ELEVATION OF SUBSTRUCTURE SHOWING REINFORCEMENT

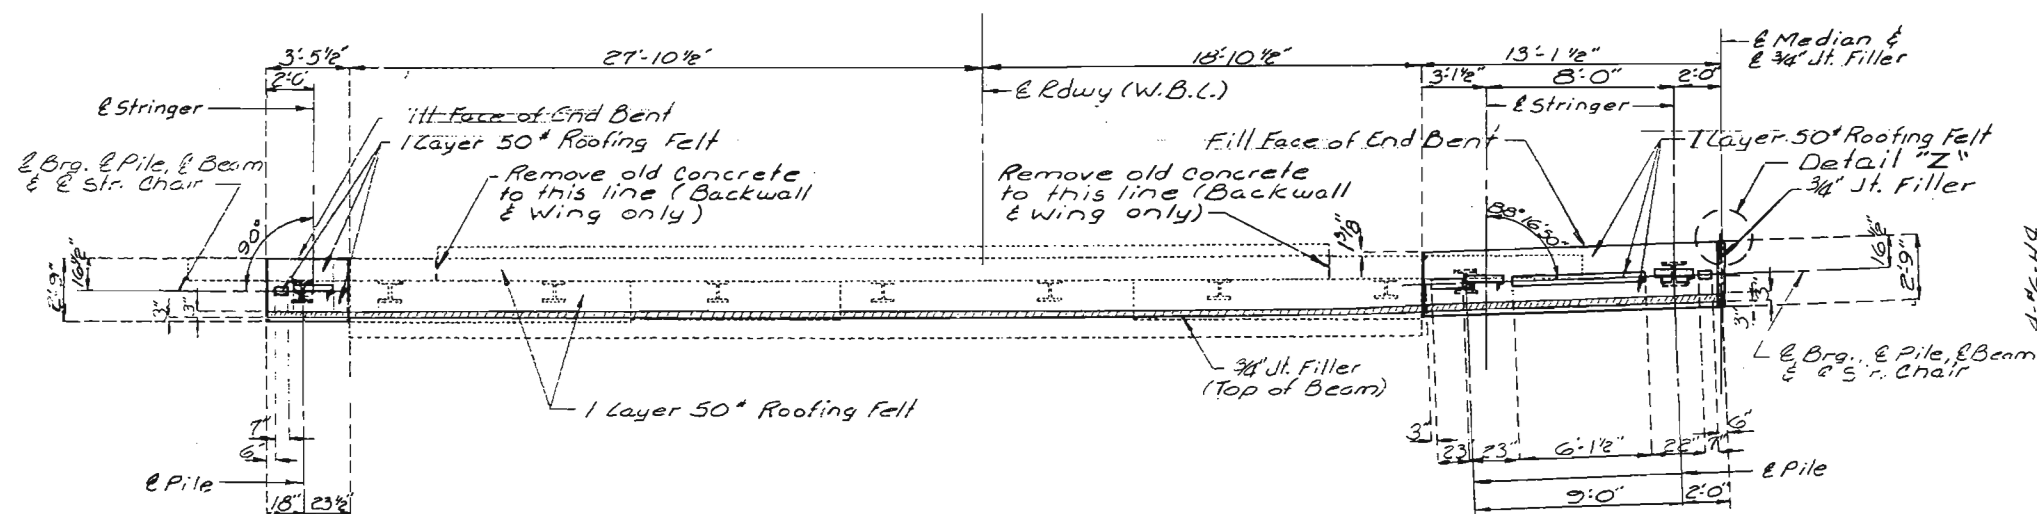


PLAN OF SUBSTRUCTURE

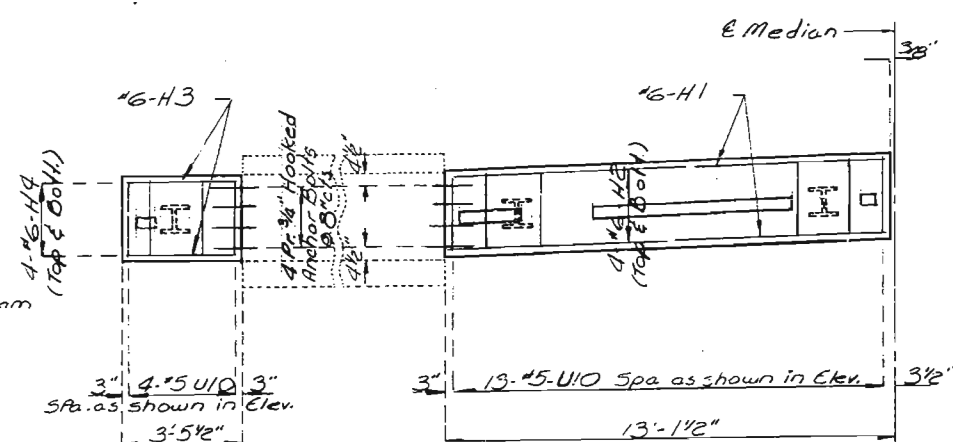

PLAN OF SUBSTRUCTURE SHOWING REINFORCEMENT


DETAILS OF END BENT NO. 4 (WEST BOUND LANE)

FED. ROAD DIST. NO.	STATE	FED. AID PROJ. NO.	FISCAL YEAR	SHEET NO.	TOTAL SHEETS
5	MO.		19	53	

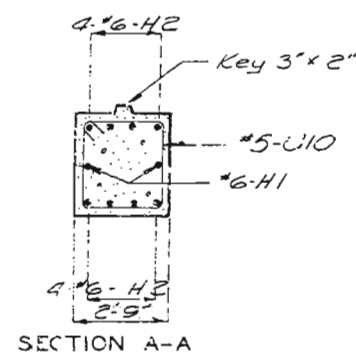


SECTION A-A


Note: For details of $\frac{3}{4}$ " Hooked Anchor Bolts see sheet No. 8

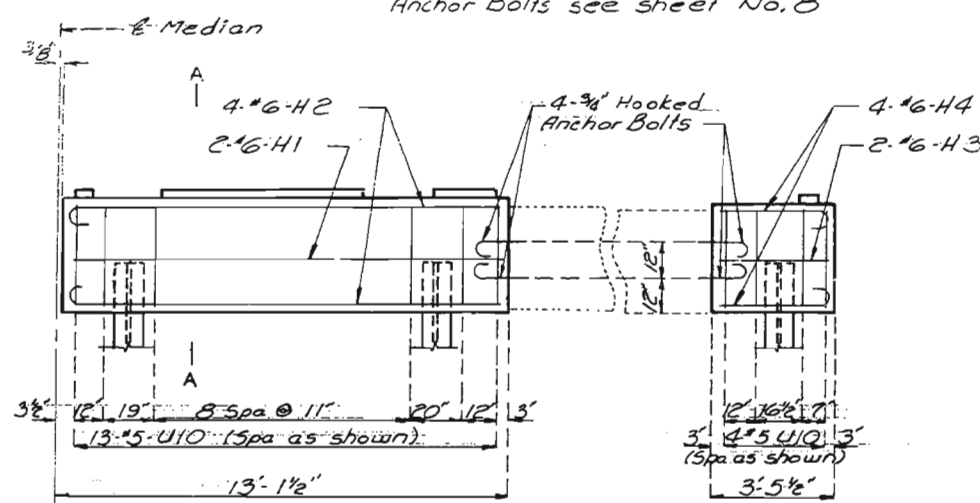

ELEVATION OF SUBSTRUCTURE
SHOWING REINFORCEMENT

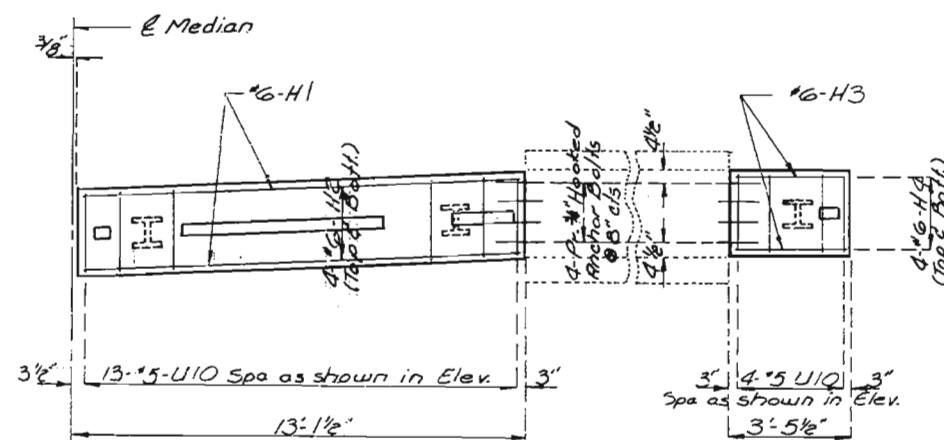


PLAN OF SUBSTRUCTURE
SHOWING REINFORCEMENT

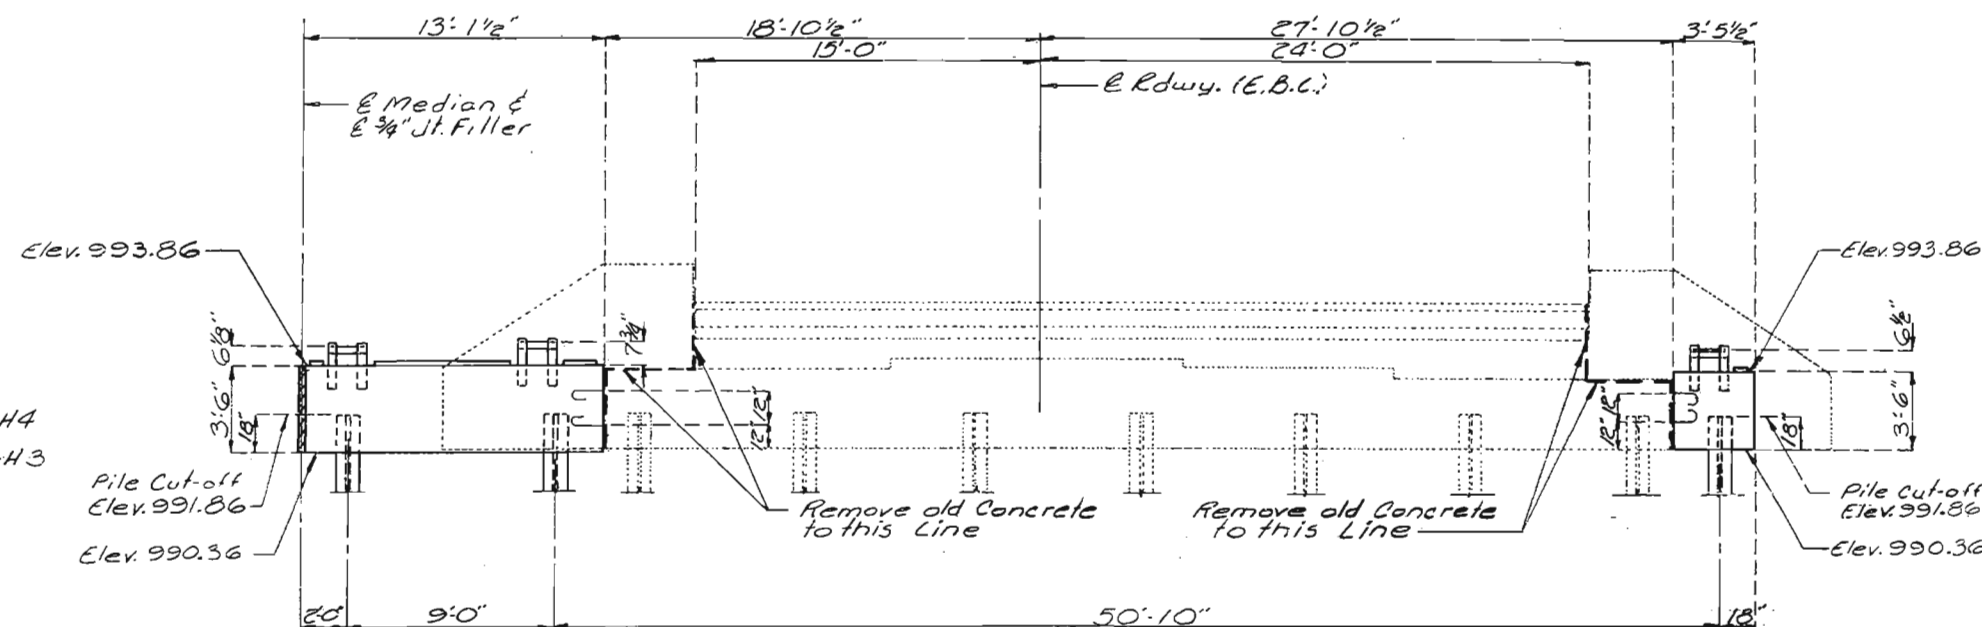

ELEVATION OF SUBSTRUCTURE


Note: For Detail "Z" see sheet No. 4.

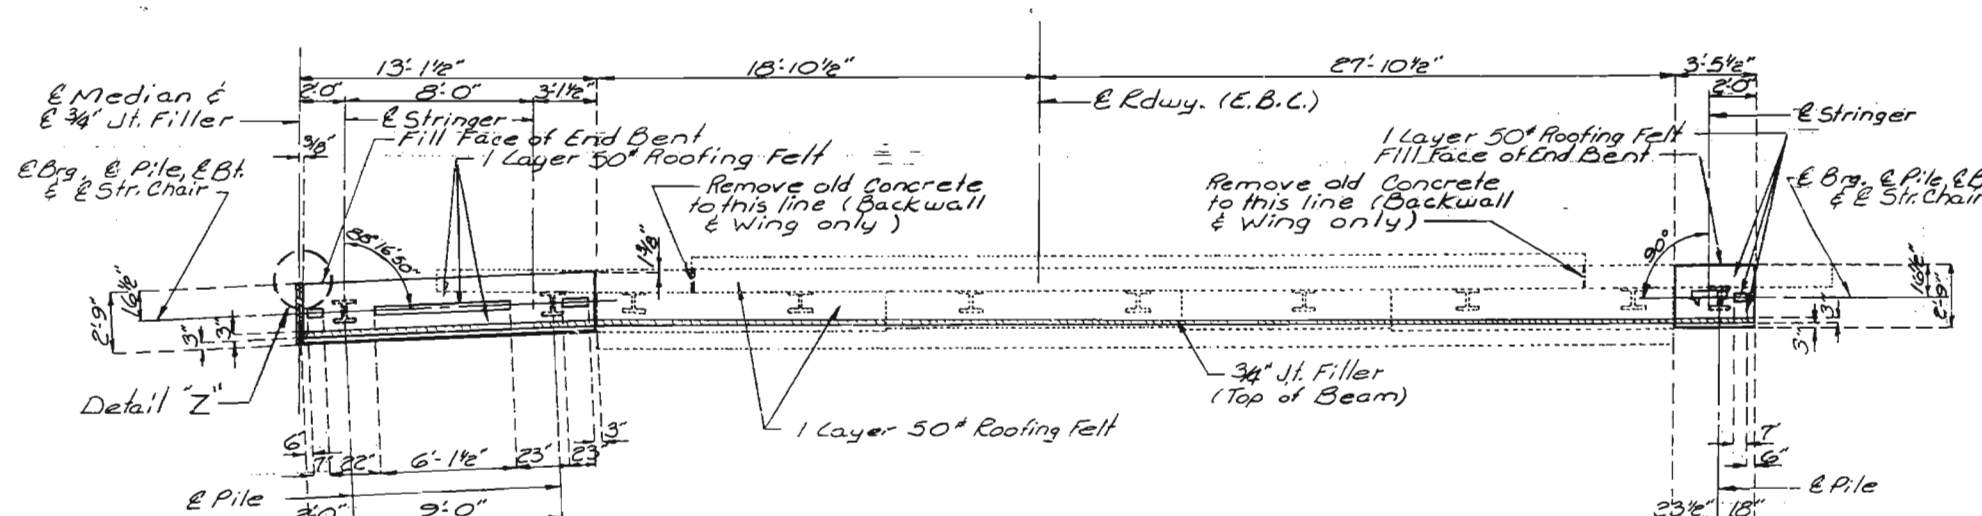

DETAILS OF END BENT NO. 4 (EAST BOUND LANE)


PLAN OF SUBSTRUCTURE

FED. ROAD DIST. NO.	STATE	FED. AID PROJ. NO.	FISCAL YEAR	SHEET NO.	TOTAL SHEETS
5	MO.		19	59	

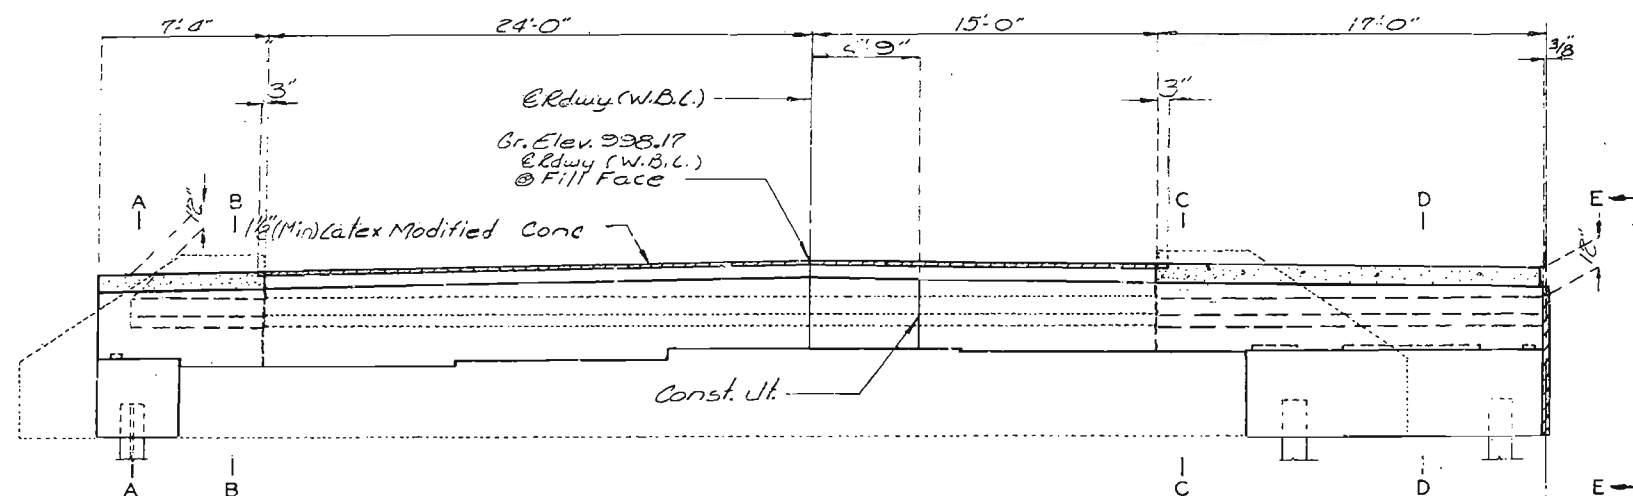


ELEVATION OF SUPERSTRUCTURE (W.B.L.)

Note: For Elevation LL See sheet No. 13.
For Sections J-J and K-K see sheet No. 6.
For Location of Sections M-M and N-N see sheets No. 7 & 13.
For details of Timber Header see sheet No. 17.
For Reinforcement not shown see sheet No. 13.

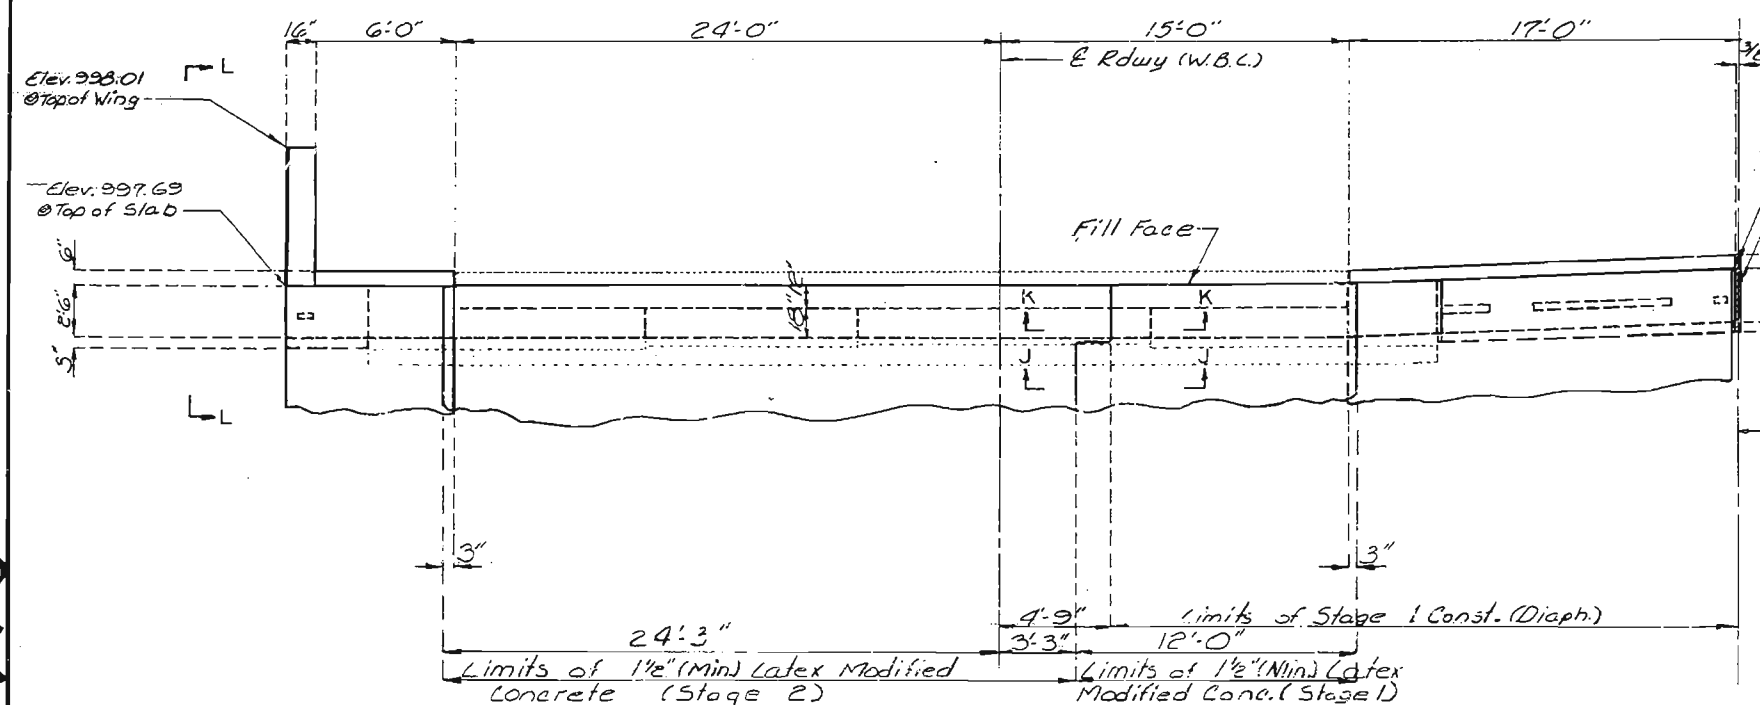


PLAN OF SUPERSTRUCTURE (W.B.L.)

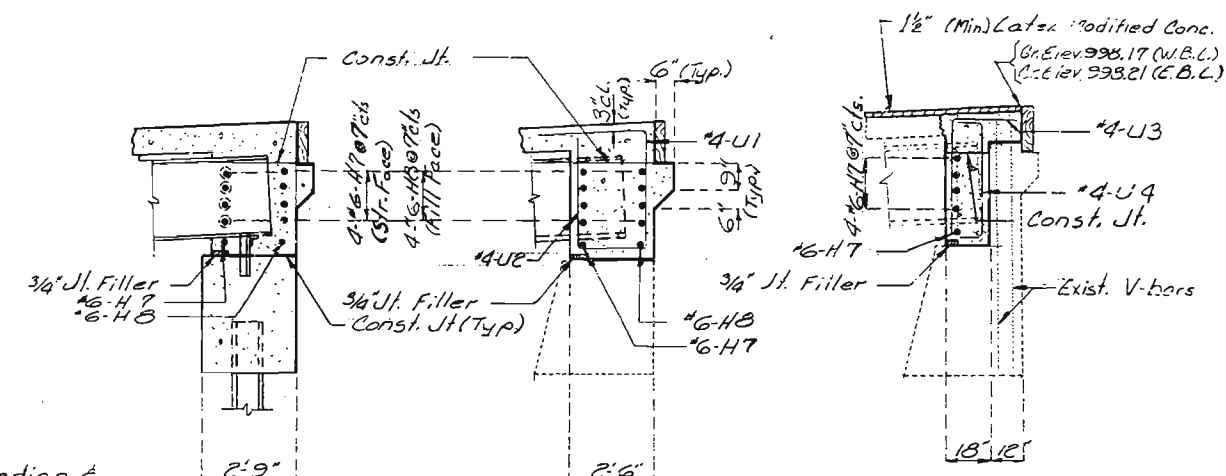

SECTION A-A

SECTION B-B


SECTION AT E RDWY.

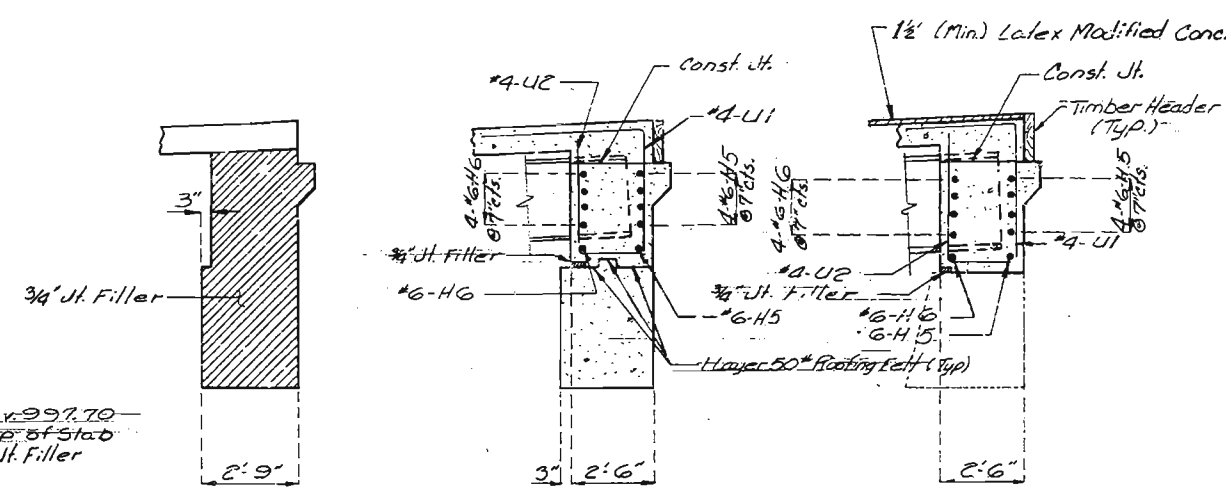

SECTION E-E

SECTION D-D

SECTION C-C

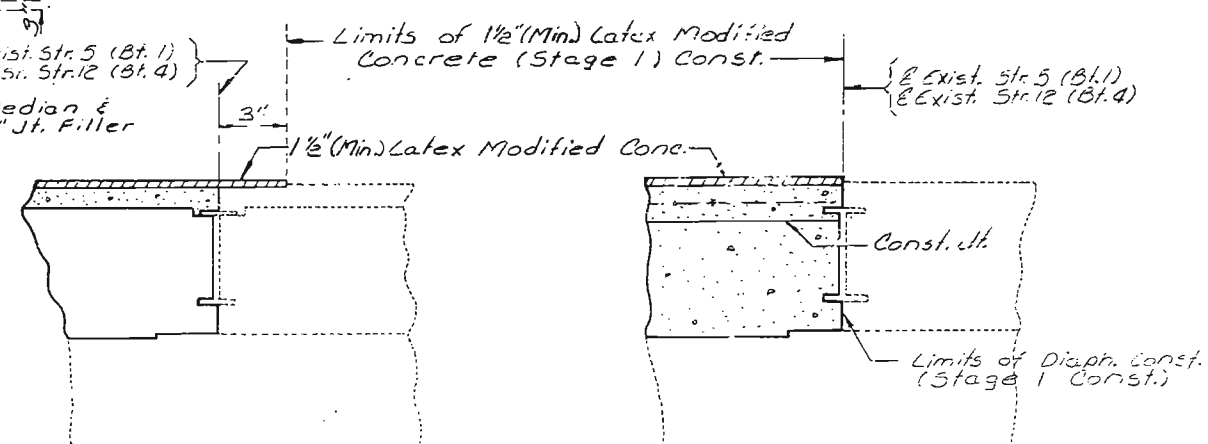


PART SECTION M-M (STAGE I CONST.)

PART SECTION N-N (STAGE I CONST.)

DETAILS OF END BENT NO. 4


FED. ROAD DIST. NO.	STATE	FED. AID PROJ. NO.	FISCAL YEAR	SHEET NO.	TO. L SHEETS
5	MO.		19	60	

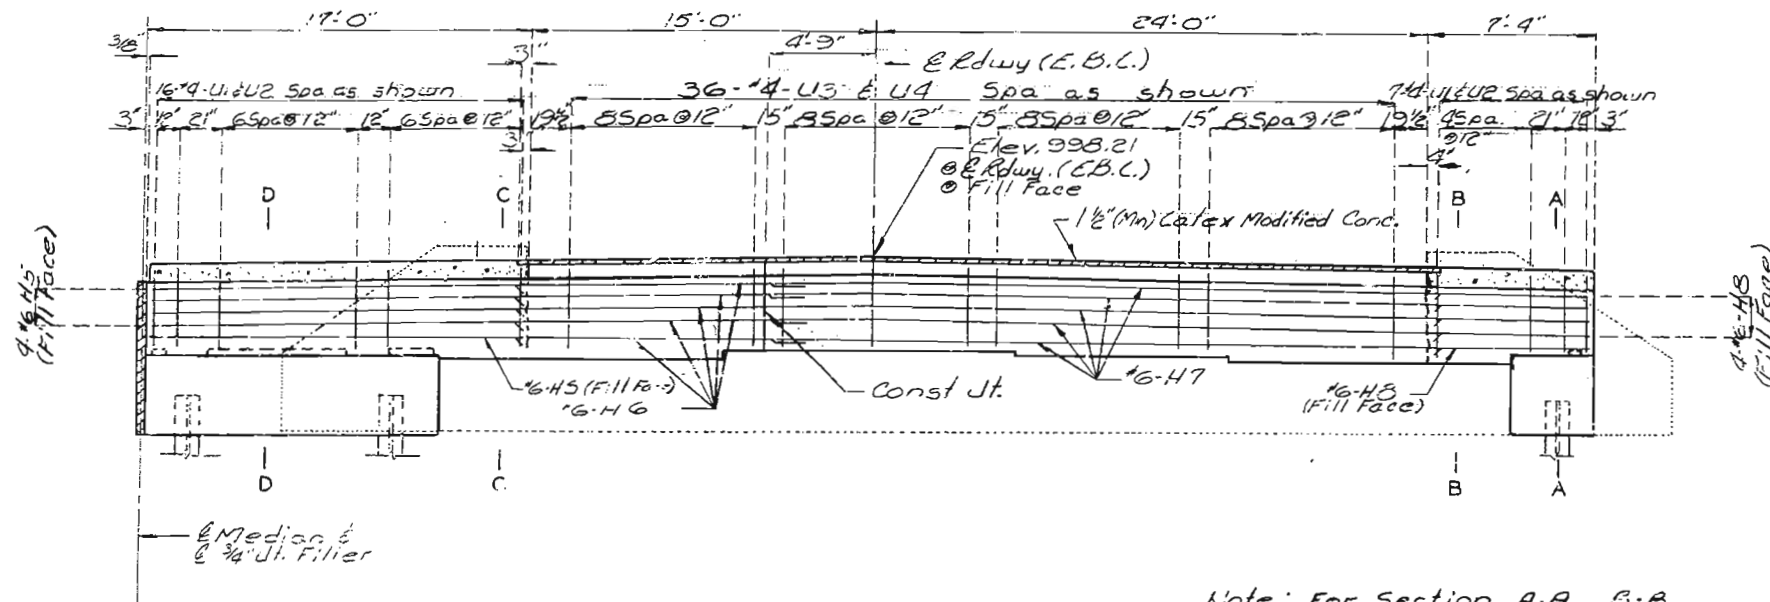

ELEVATION OF SUPERSTRUCTURE (E.B.L.)




Note: End Bent reinforcement shown symm. abt. @ Median.

Note: For Section A-A, B-B, C-C, D-D, E-E, and at E see sheet No. 12 for location of Elev. L-L see sheet No. 12 for Sections M-M & N-N see sheet No. 12

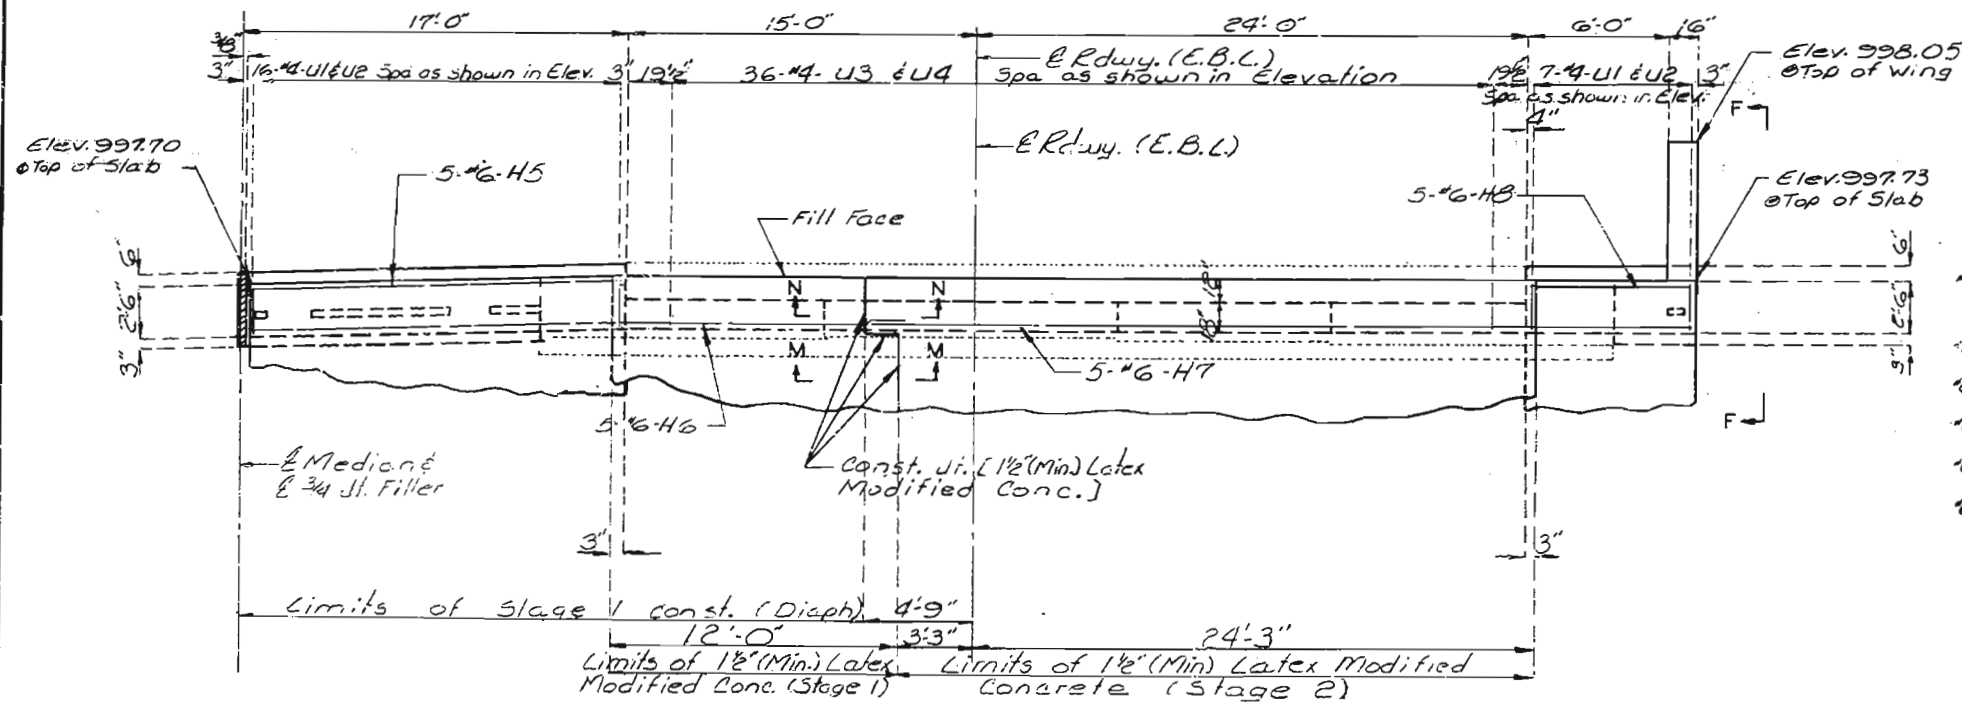


PLAN OF SUPERSTRUCTURE (E.B.L.)

DETAILS OF END BENT NO. 4

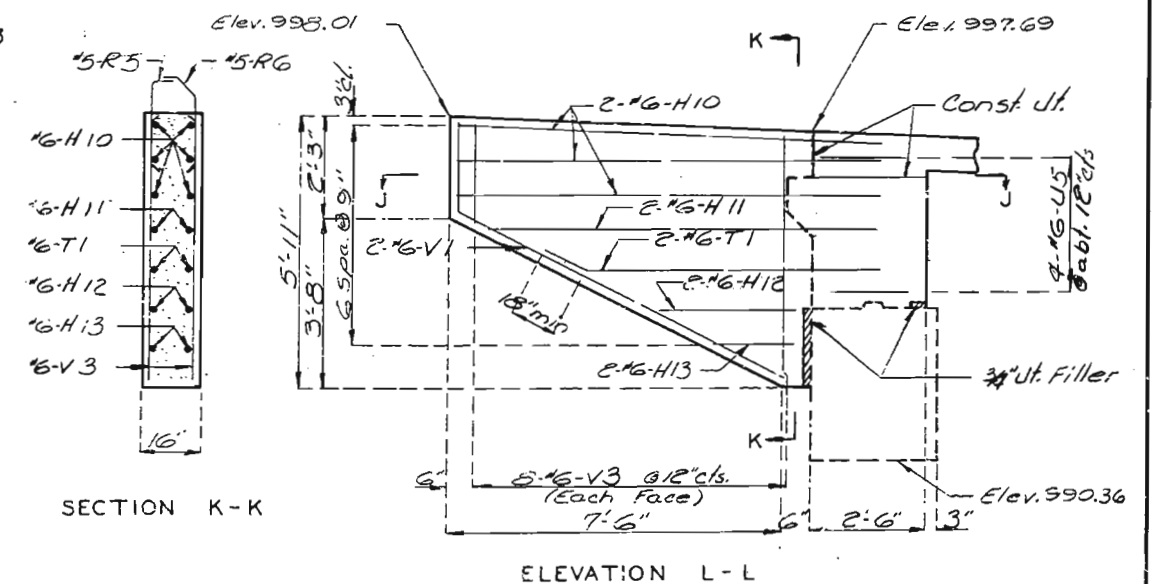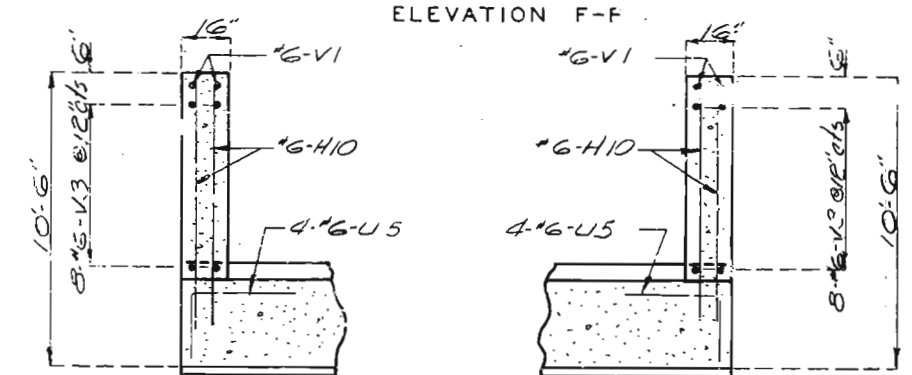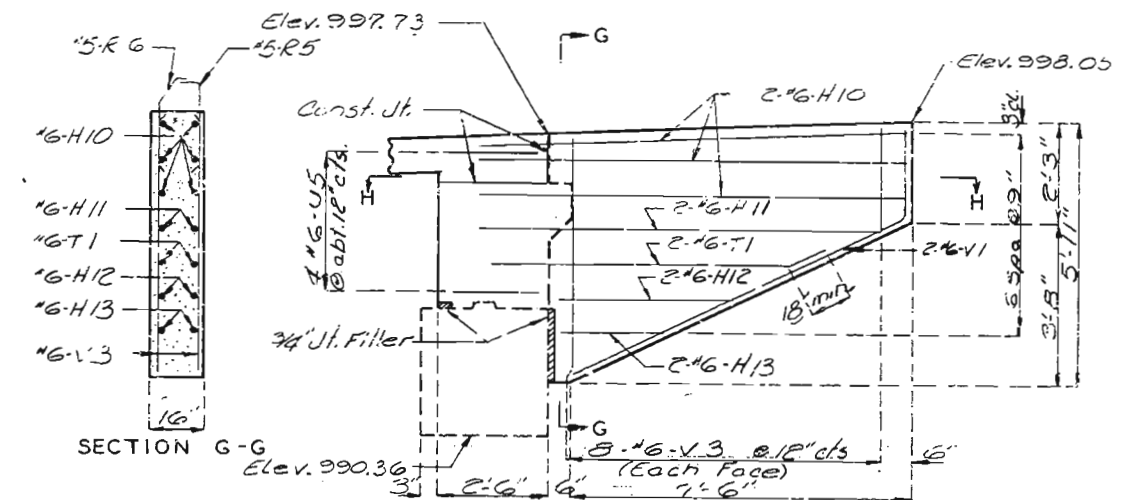


Note: For Details of R-bars in Wings see sheet No. 20 For Details of R-bars near @ Median see sheet No. 21

FED. ROAD DIST. NO.	STATE	FED. AID PROJ. NO.	FISCAL YEAR	SHEET NO.	TOTAL SHEETS
2	MO.		18	21	

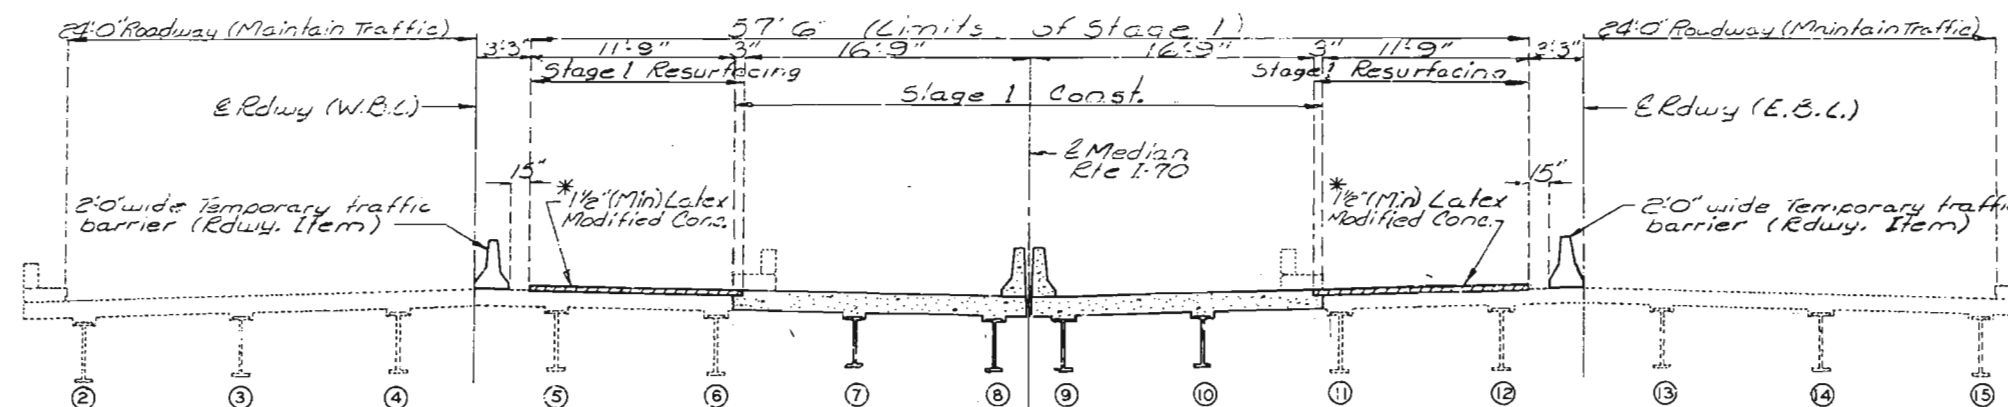


CONSTRUCTION SEQUENCE - STAGE 1

* Scarify 1/2" (Min) from existing slab surface before placing 1 1/2" (Min) Latex Modified conc.

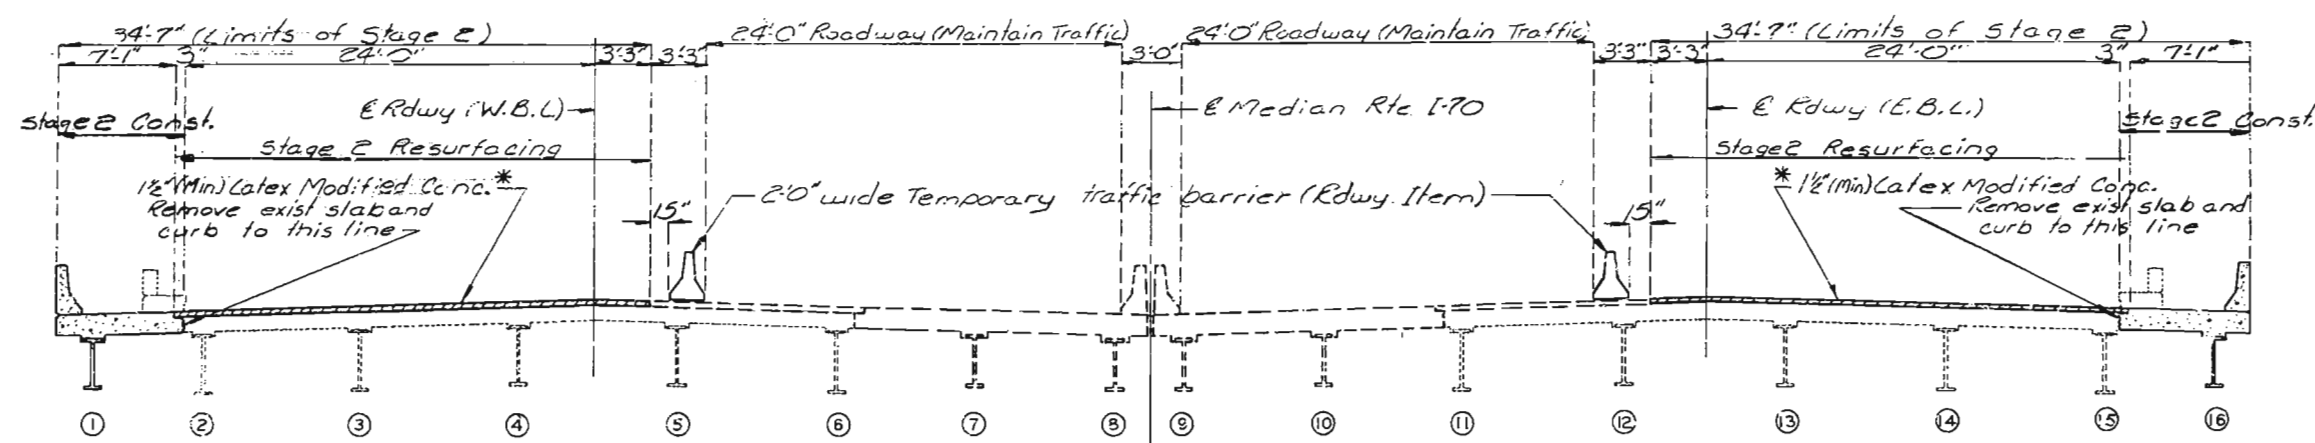


CONSTRUCTION SEQUENCE - STAGE 2

Note: Heavy dashed lines indicate previous Stage 1 construction.
Hatching indicates 1 1/2" (Min) Latex Modified Concrete.




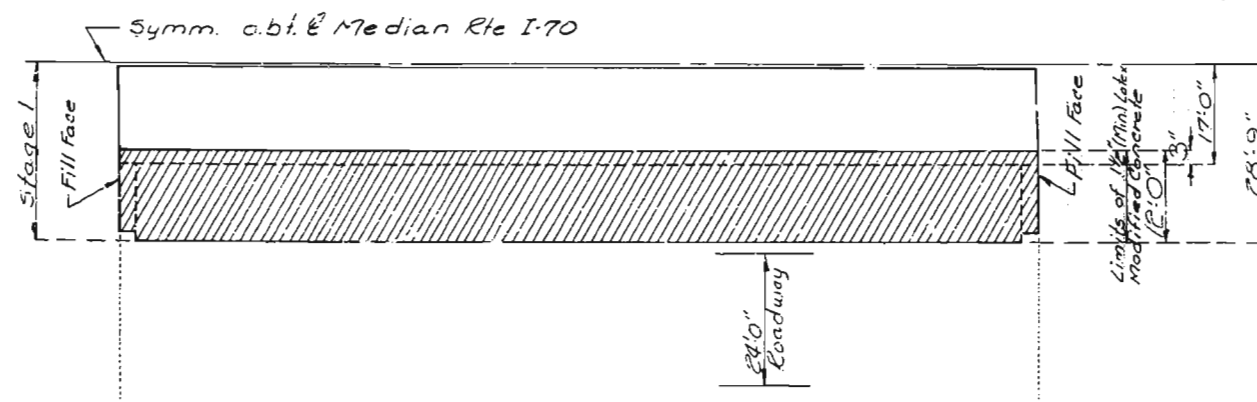


PART PLAN OF SLAB CONSTRUCTION SEQUENCE - STAGE 1




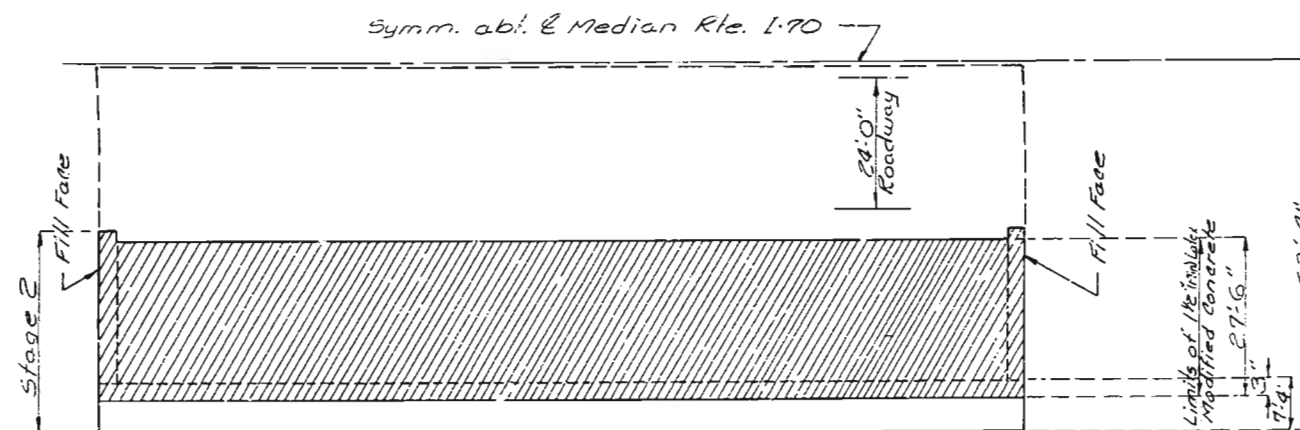


PART PLAN OF SLAB CONSTRUCTION - STAGE 2





FED. ROAD DIST. NO.	STATE	FED. AID PROJ. NO.	FISCAL YEAR	SHEET NO.	TOTAL SHEETS
5	MO.		19	63	

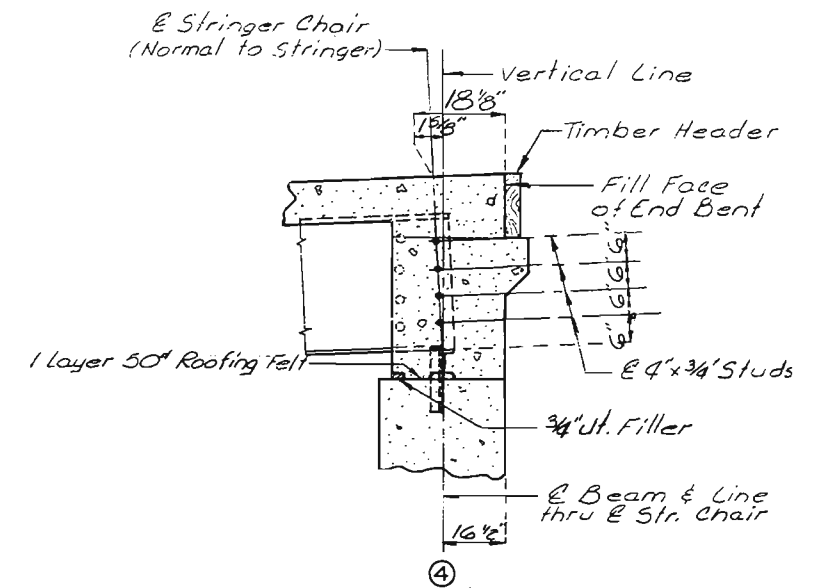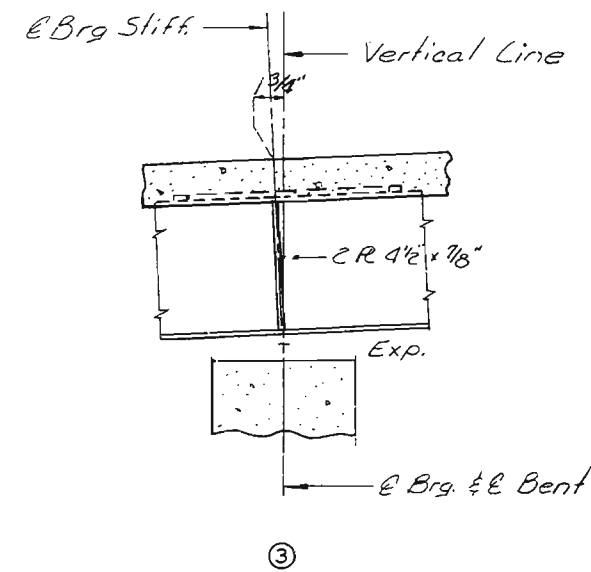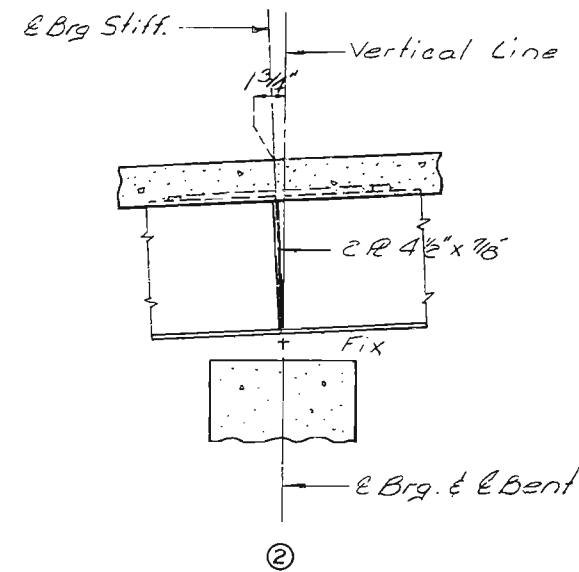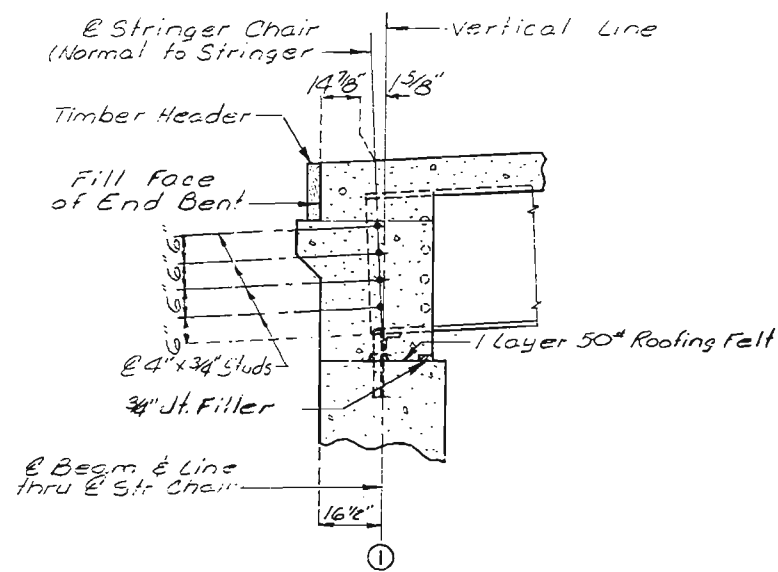

PART LONGITUDINAL SECTION

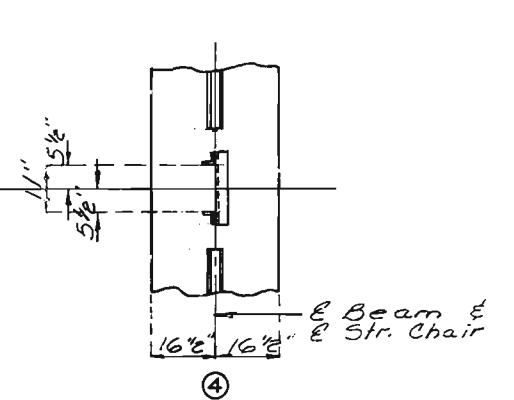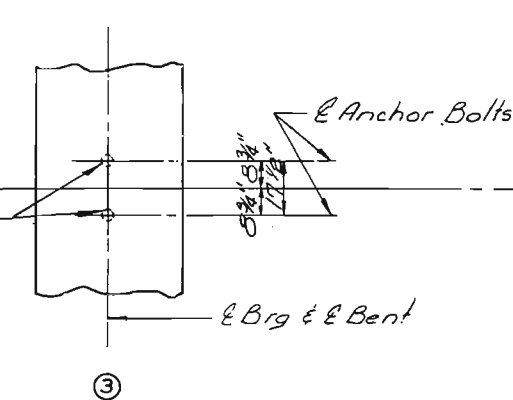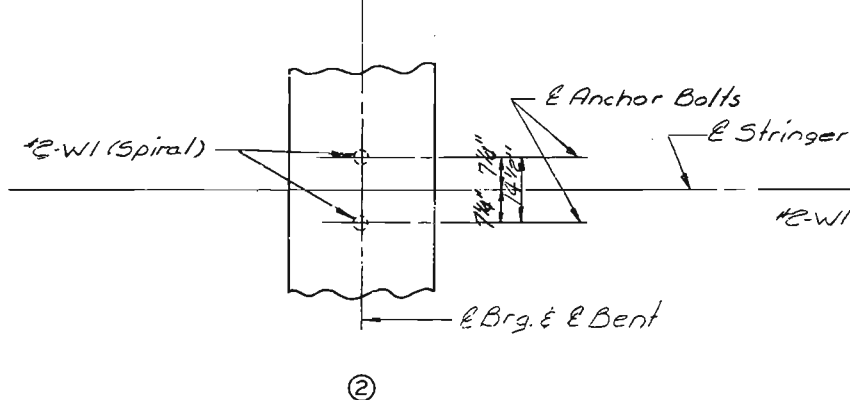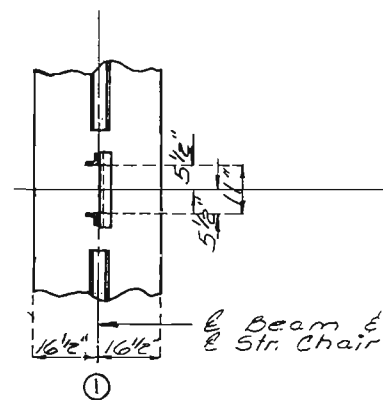

PART STRINGER CHAIR & ANCHOR BOLT PLAN
(STRINGER NO. 1 & NO. 16)

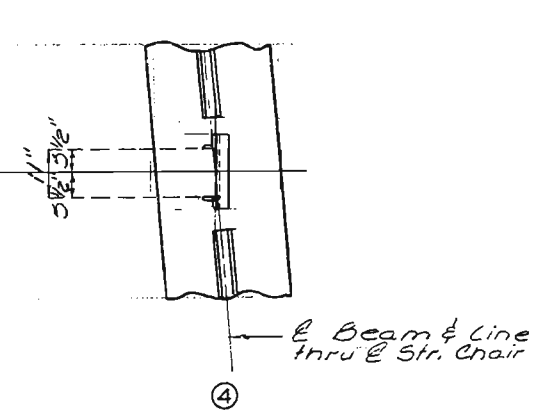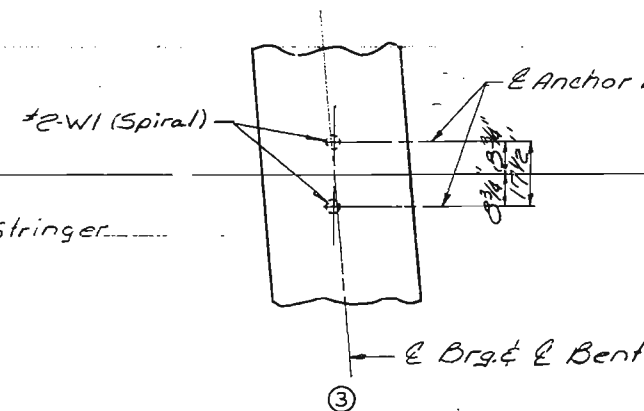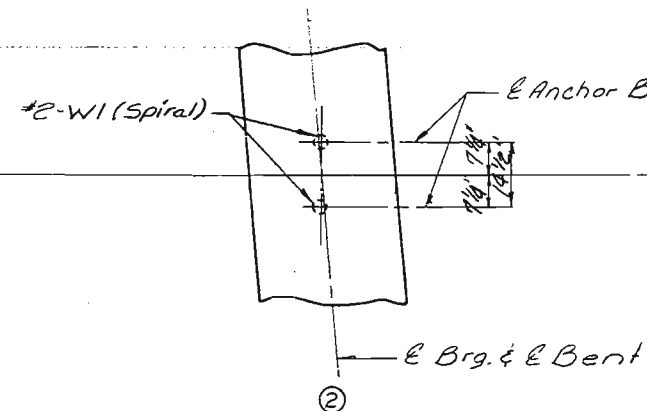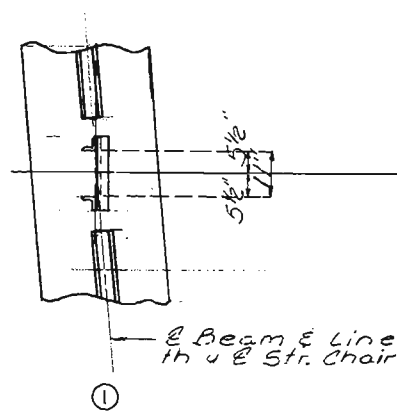

PART STRINGER CHAIR & ANCHOR BOLT PLAN
STRINGER NO. 7, 8, 9, & 10

183

STD. E.B. REVISED
MAR. 1973 OCT. 1977


DETAILED JAN. 1981
CHECKED Sept. 1981

Note: This drawing is not to scale. Follow dimensions.

Sheet No. 17 of 24

JACKSON COUNTY L-972R

FED. ROAD DIST. NO.	STATE	FED. AID PROJ. NO.	FISCAL YEAR	SHEET NO.	TOTAL SHEETS
5	MO.		19	64	

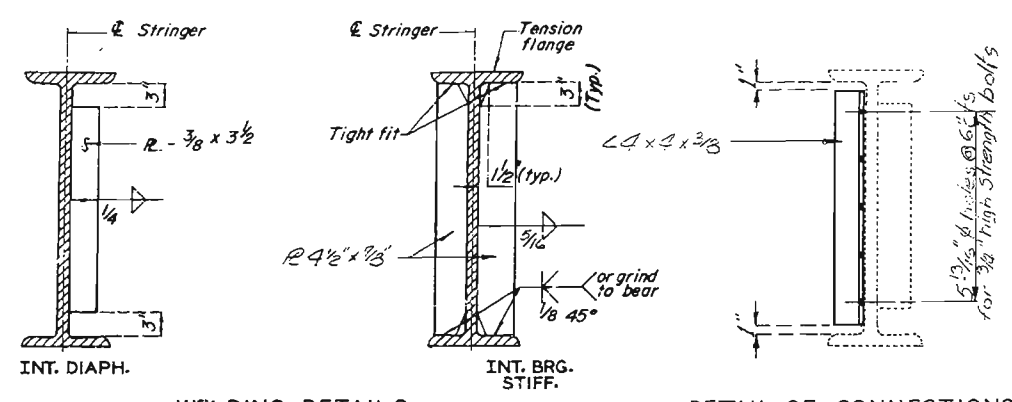

NOTES: TYPE "E" BEARINGS

ANCHOR BOLTS FOR TYPE "E" BEARINGS SHALL BE 1-1/4" SWAGED BOLTS AND SHALL EXTEND 12" INTO CONCRETE WITH HEXAGON NUTS AND PLAIN WASHERS FOR FIXED BEARINGS, NO NUTS FOR EXPANSION BEARINGS.

"ESTIMATED WEIGHT" DOES NOT INCLUDE WEIGHT OF ANCHOR BOLTS.



"C" INDICATES MACHINE FINISH SURFACE.

① BONDED LUBRICANT


A LUBRICANT COATING SHALL BE APPLIED IN THE SHOP TO BOTH MATING SURFACES OF THE BEARING ASSEMBLY. THE LUBRICANT, METHOD OF CLEANING, AND APPLICATION SHALL MEET THE REQUIREMENTS OF MIL-L-23398 AND MIL-L-46147 SUCH AS DOW CORNING'S MOLYKOTE 3402 BONDED LUBRICANT. THE COATED AREAS SHALL BE PROTECTED FOR SHIPPING AND ERECTION.

SHOP DRAWINGS ARE NOT REQUIRED FOR LEAD PLATES AND/OR PREFORMED FABRIC PADS.


Note: For Details of Flange Plates at Int. Bts. No 2 & No 3 see sheet No. 18.

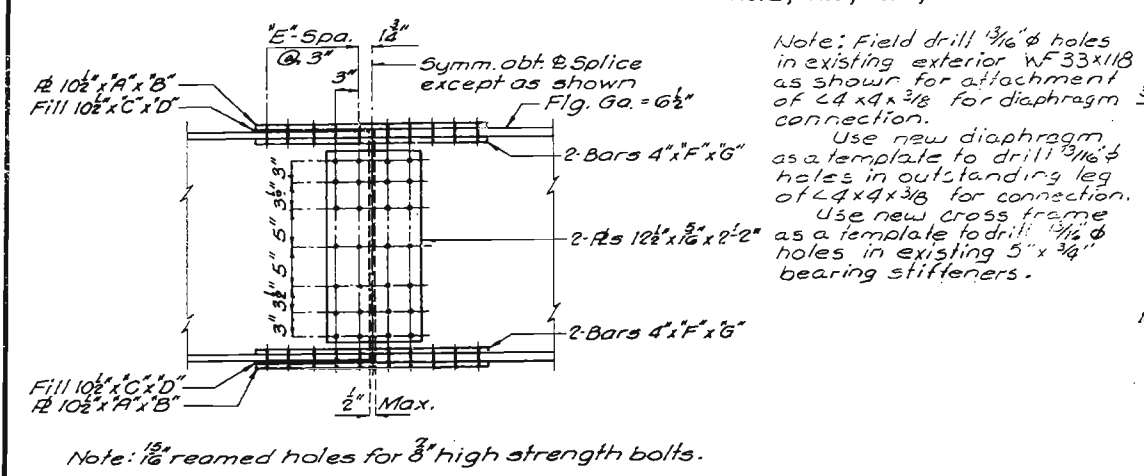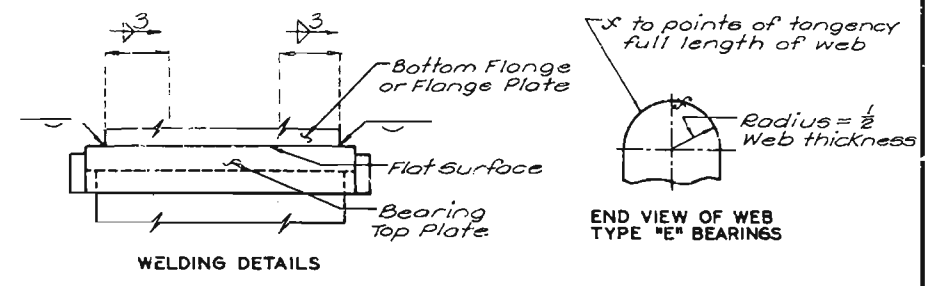

SIZE OF BEAM	A	B	C	D	E	F	G
W30x99 to 116	3/8"	18 1/2"	3/16"	9"	2"	1/2"	18 1/2"

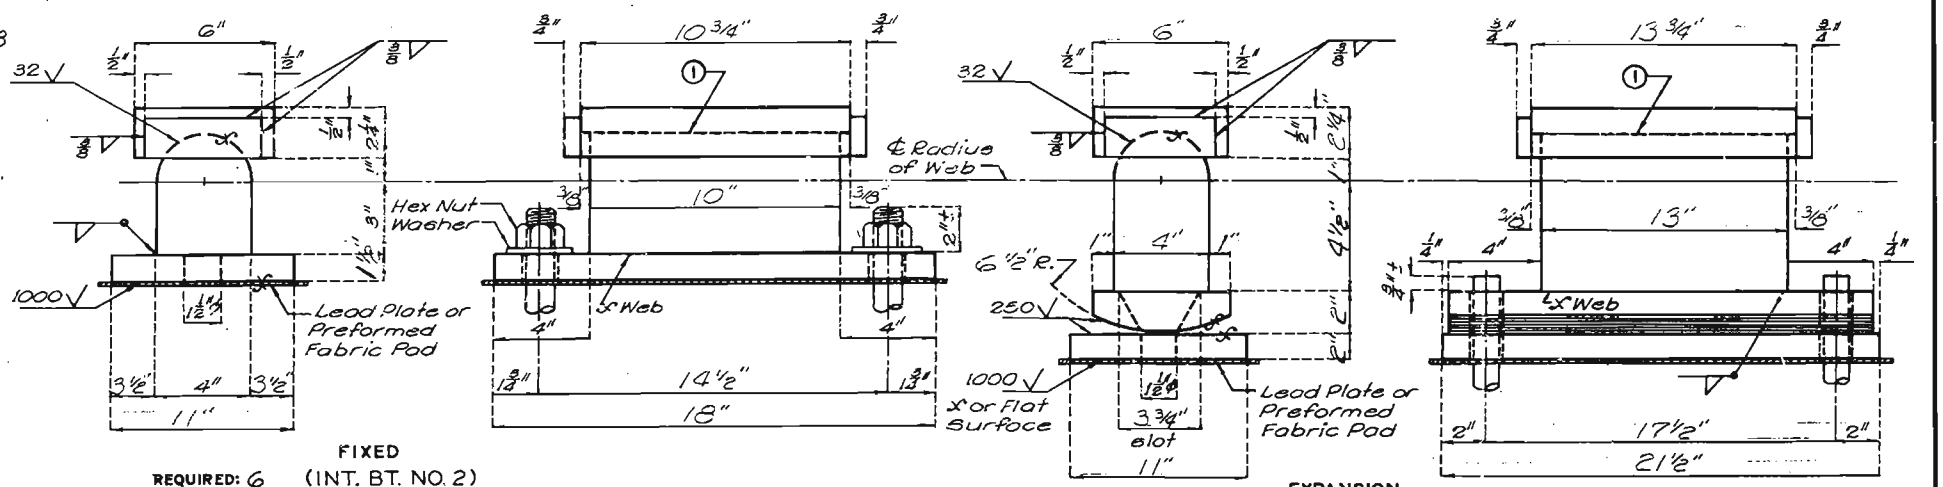


FED. ROAD DIST. NO.	STATE	FED. AID PROJ. NO.	FISCAL YEAR	SHEET NO.	TOTAL SHEETS
5	MO.		18	65	

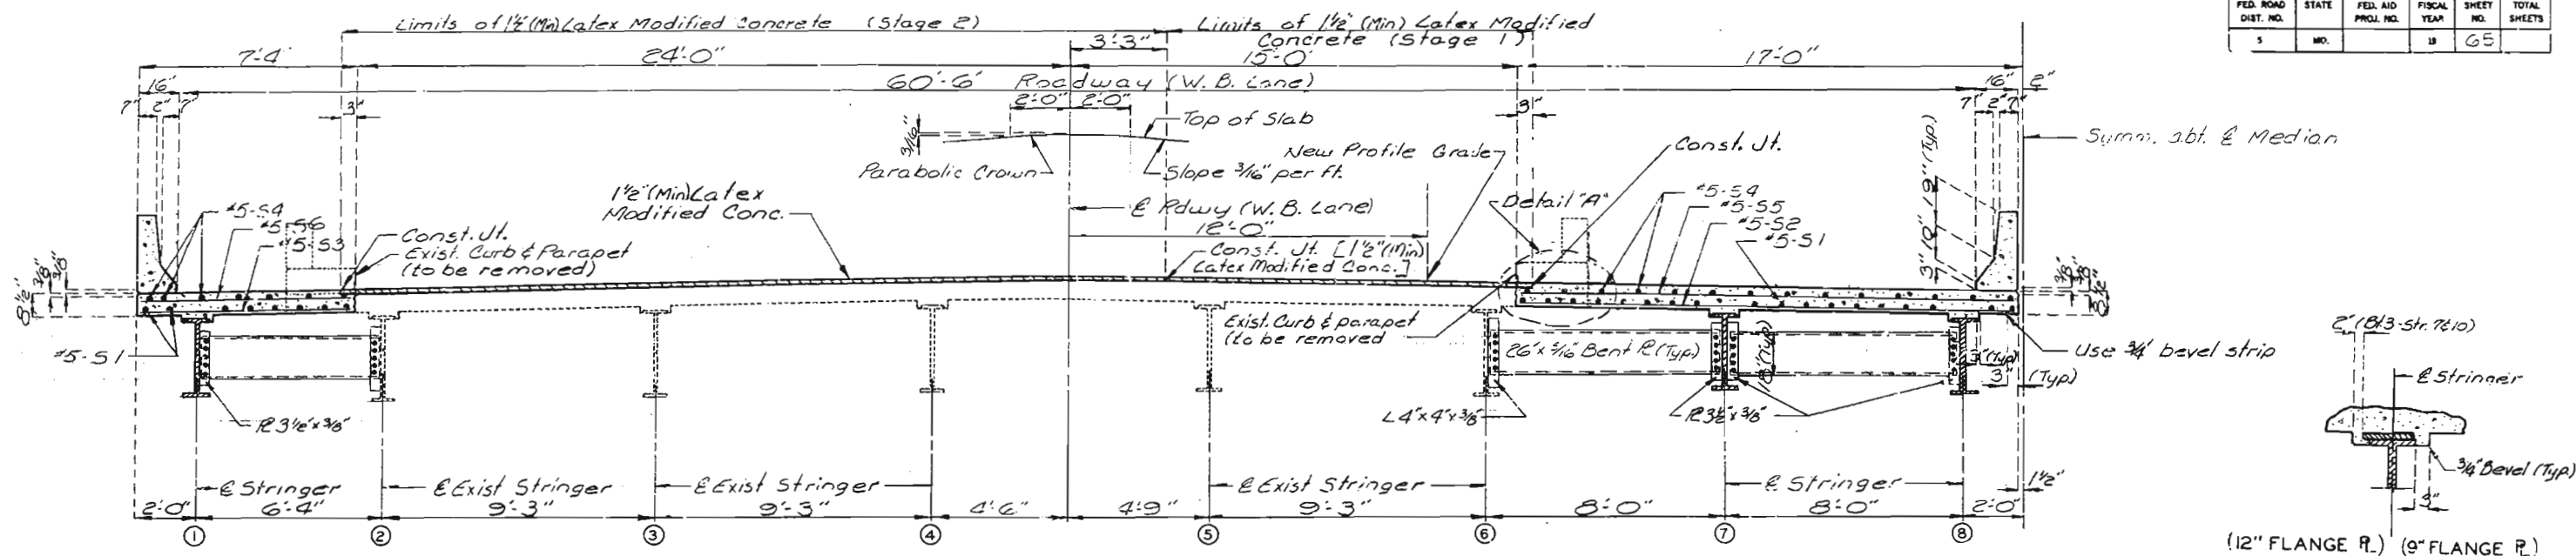


Note: For details of Barrier Curb not shown see sheets No. 20 & 21.
 ** Scarify 1/2" (Min) from existing slab surface before placing 1 1/2" (Min) Latex Modified Concrete.

HALF SECTION NEAR C. SPAN

PART SECTION SHOWING HAUNCHING NEAR INT. BENT

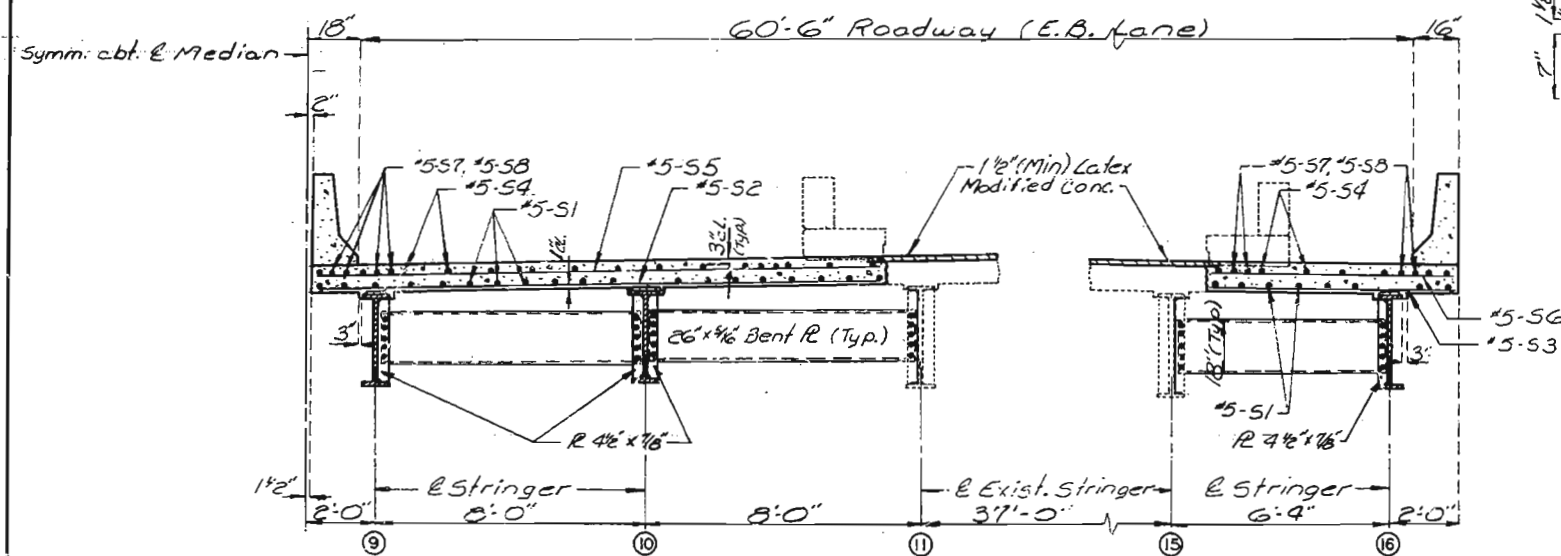


PART SECTION NEAR INT. BENT

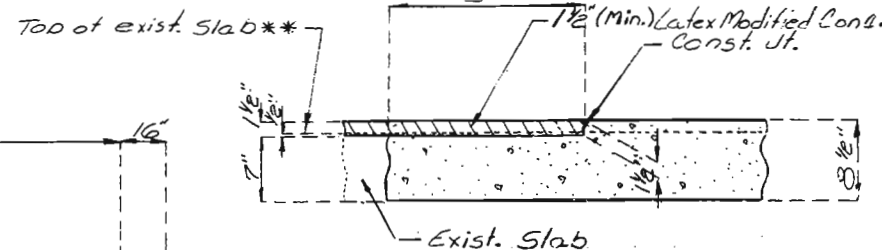


DETAIL "A"

Note: The contractor shall pour and satisfactorily finish the slab pours at a rate of not less than 25 cubic yards per hour and shall furnish an approved retarder to retard the set of concrete to 2.5 hours.
 Concrete shall be poured up grade beginning at Bent No. 1.

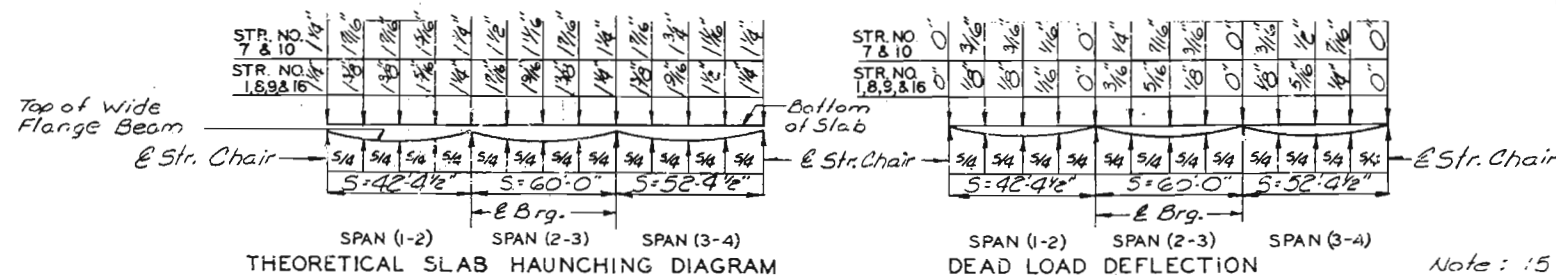

THEORETICAL SLAB HAUNCHING DIAGRAM


DEAD LOAD DEFLECTION

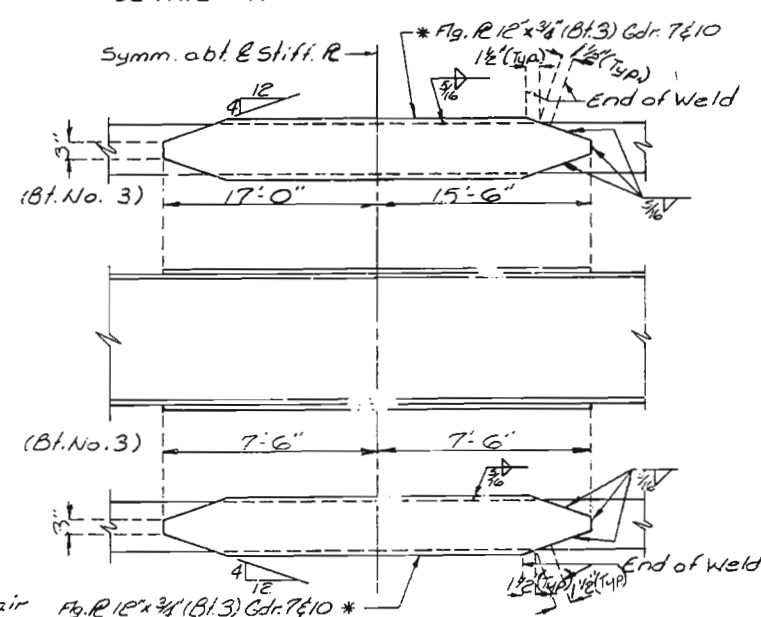

DETAILS OF FLANGE PLATES AT INTERMEDIATE BENTS NO. 2 & 3


Note: 15% of dead load deflection due to weight of structural steel.

FED. ROAD DIST. NO.	STATE	FED. AID F. 3.1.1. NO.	FISCAL YEAR	SHEET NO.	TOTAL SHEETS
5	MO.		11	66	

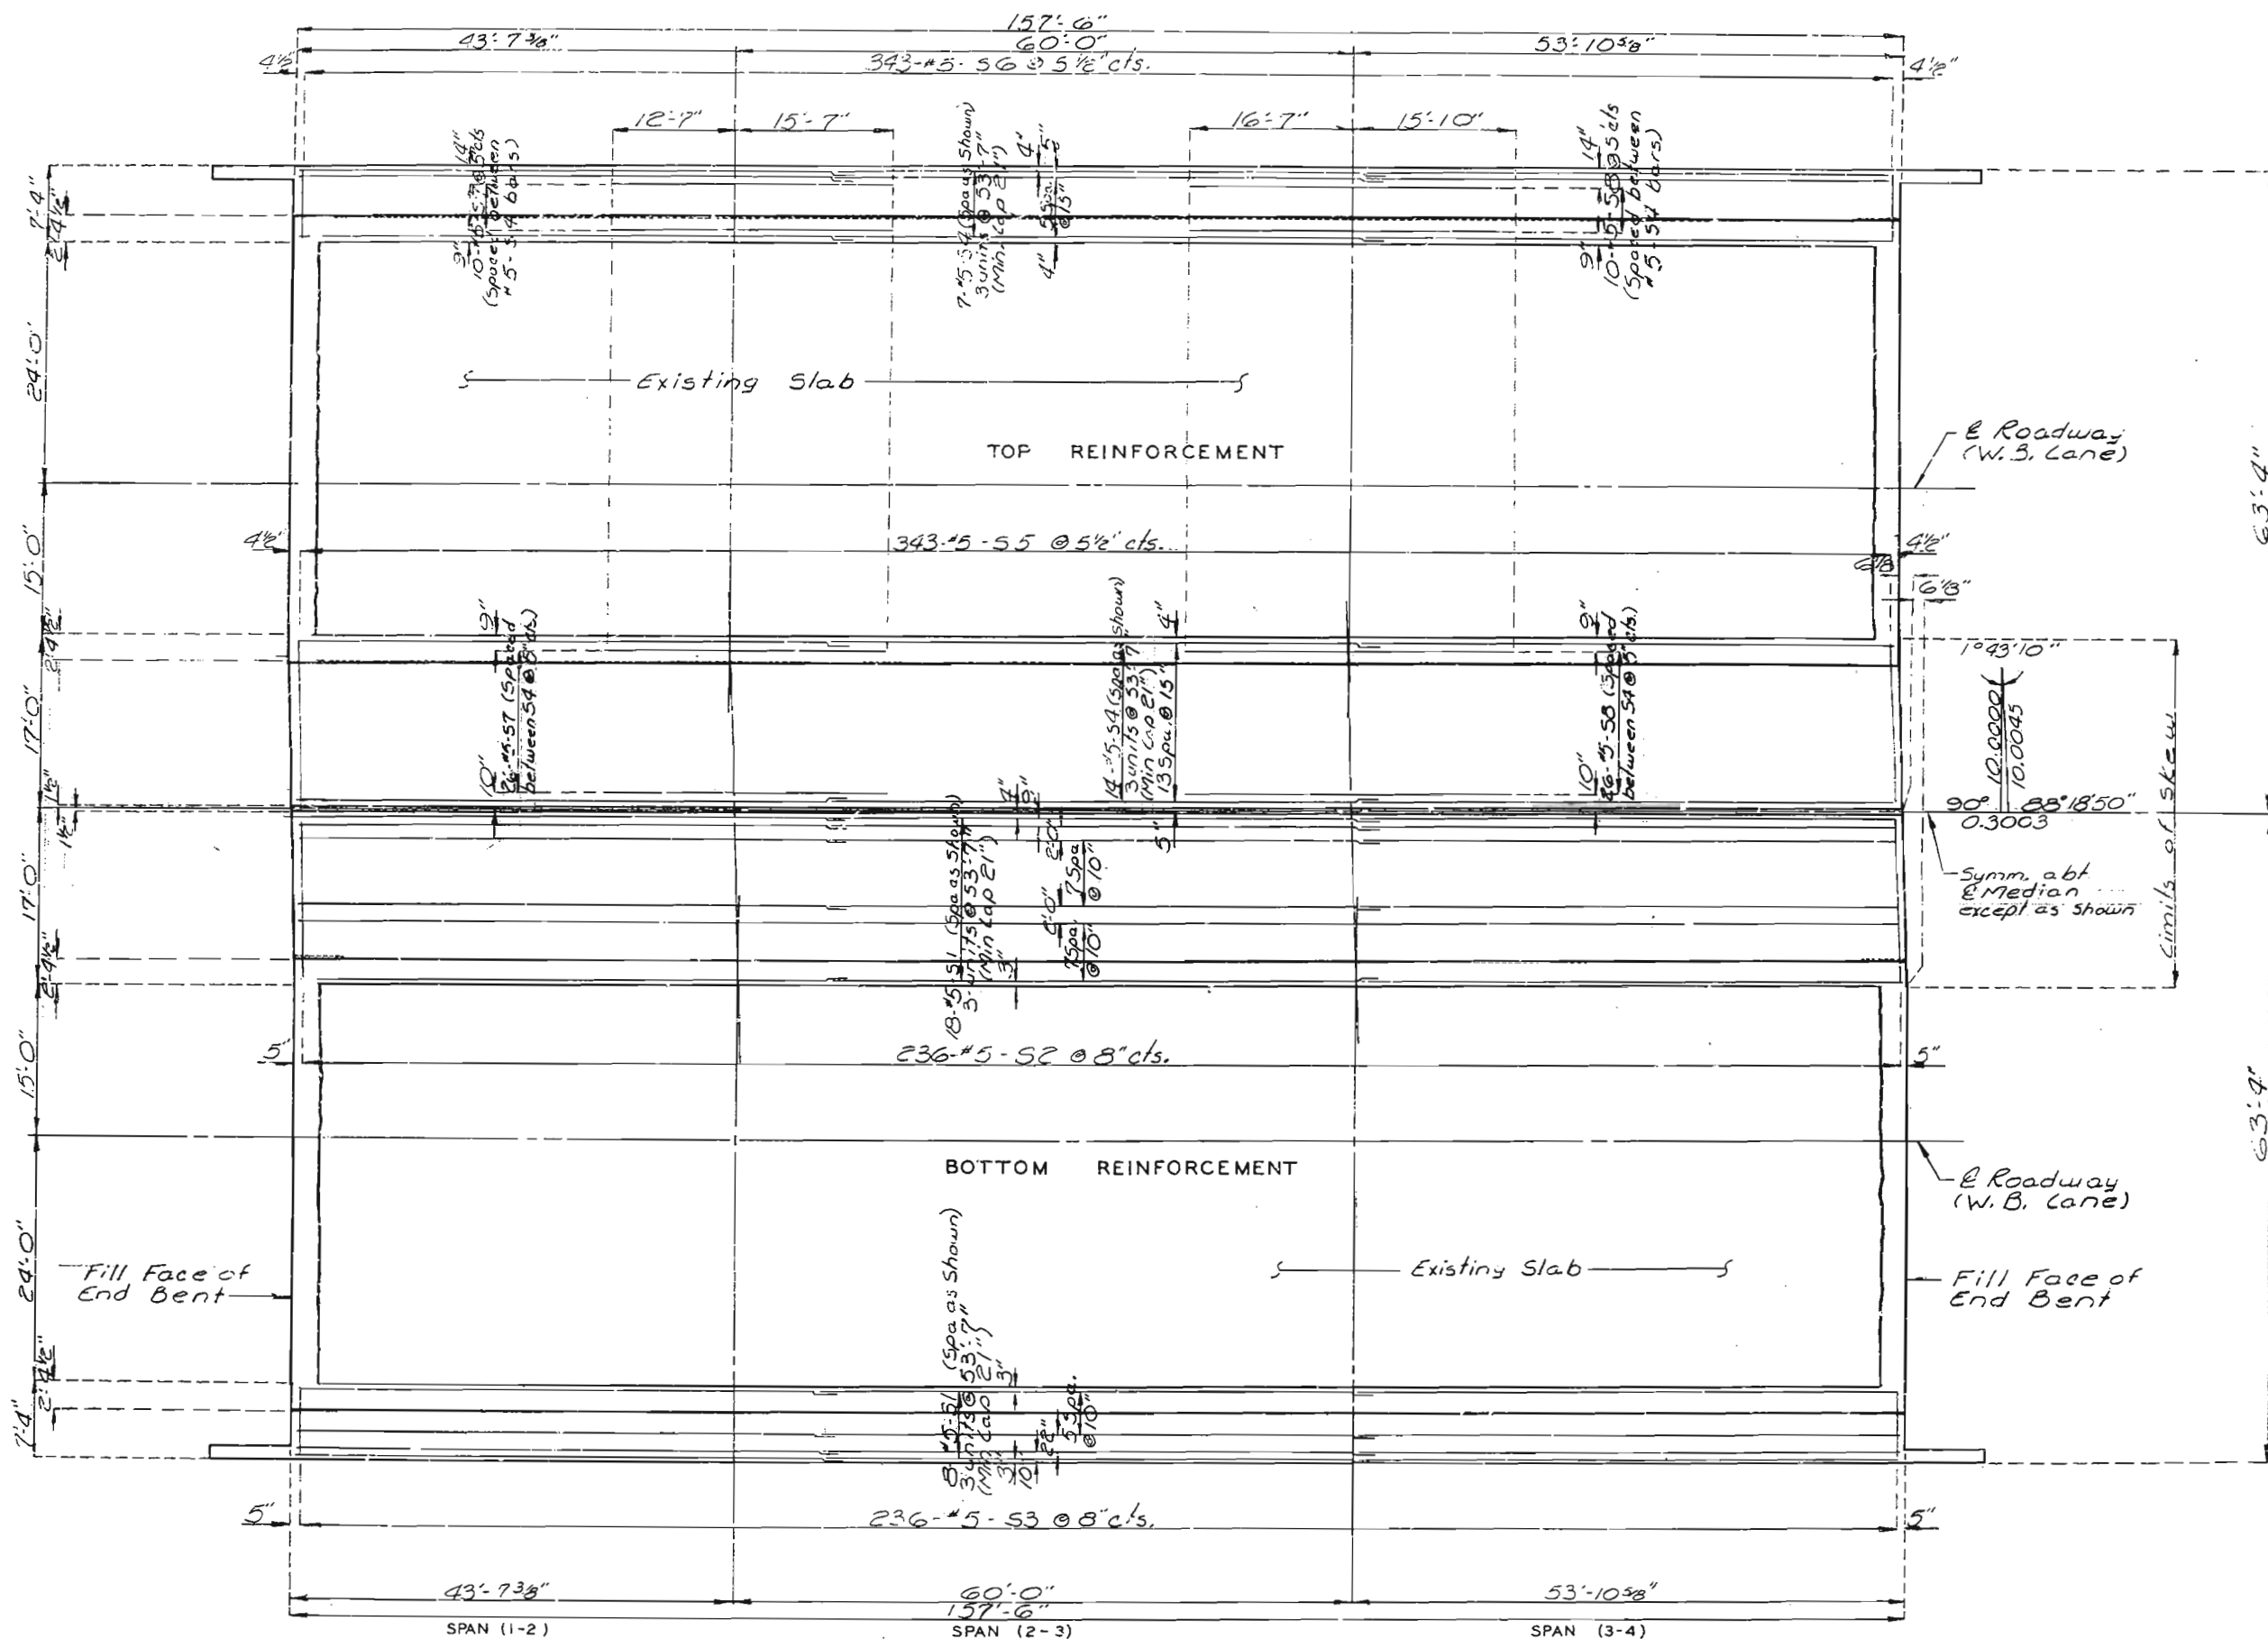


Note: Longitudinal dimensions shown are taken parallel to grade at top of slab.

FED. ROAD DIST. NO.	STATE	FED. AID PROJ. NO.	FISCAL YEAR	SHEET NO.	TOTAL SHEETS
5	MO.		19	65	

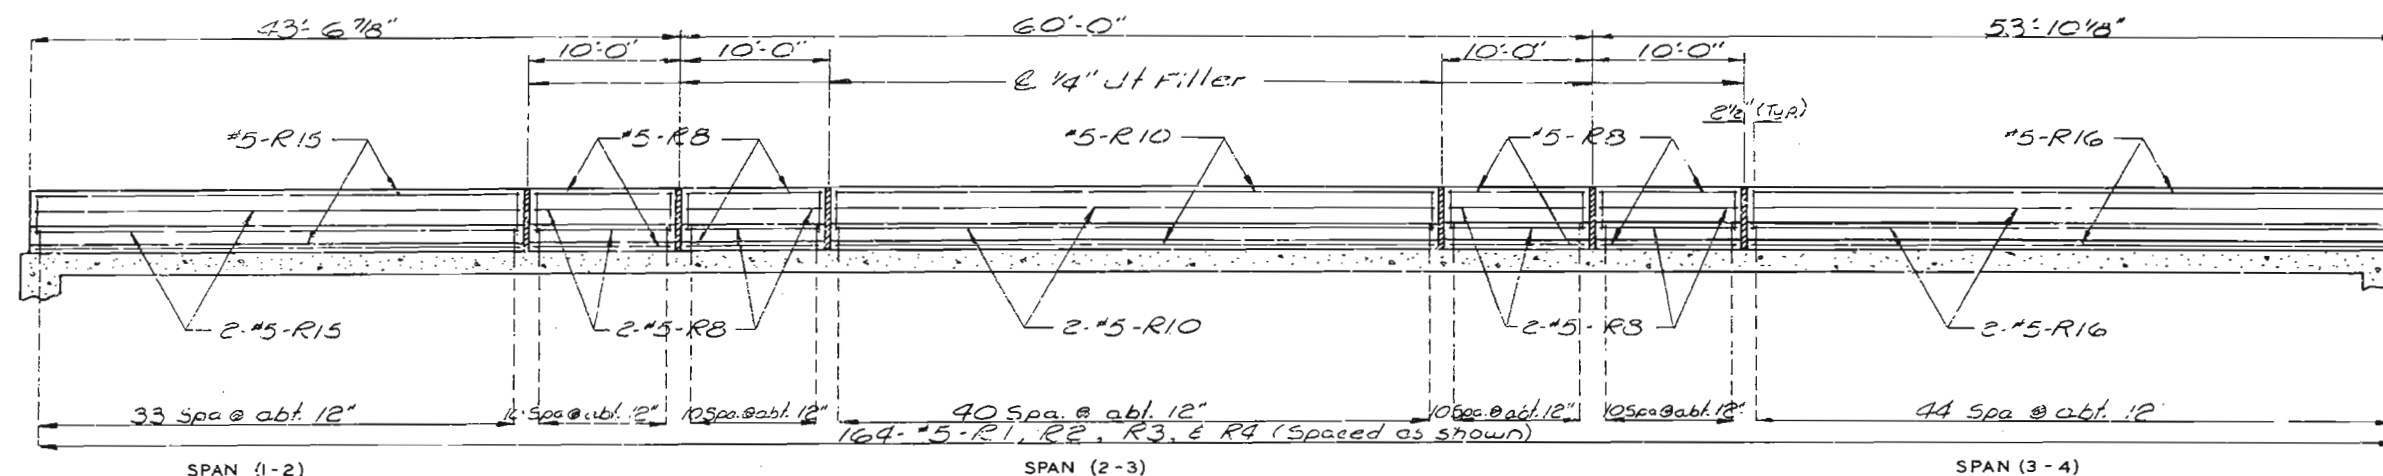


SECTION NEAR DOUBLE FACED MEDIAN BARRIER CURB

Note: Longitudinal dimensions are along top edge of slab parallel to grade.

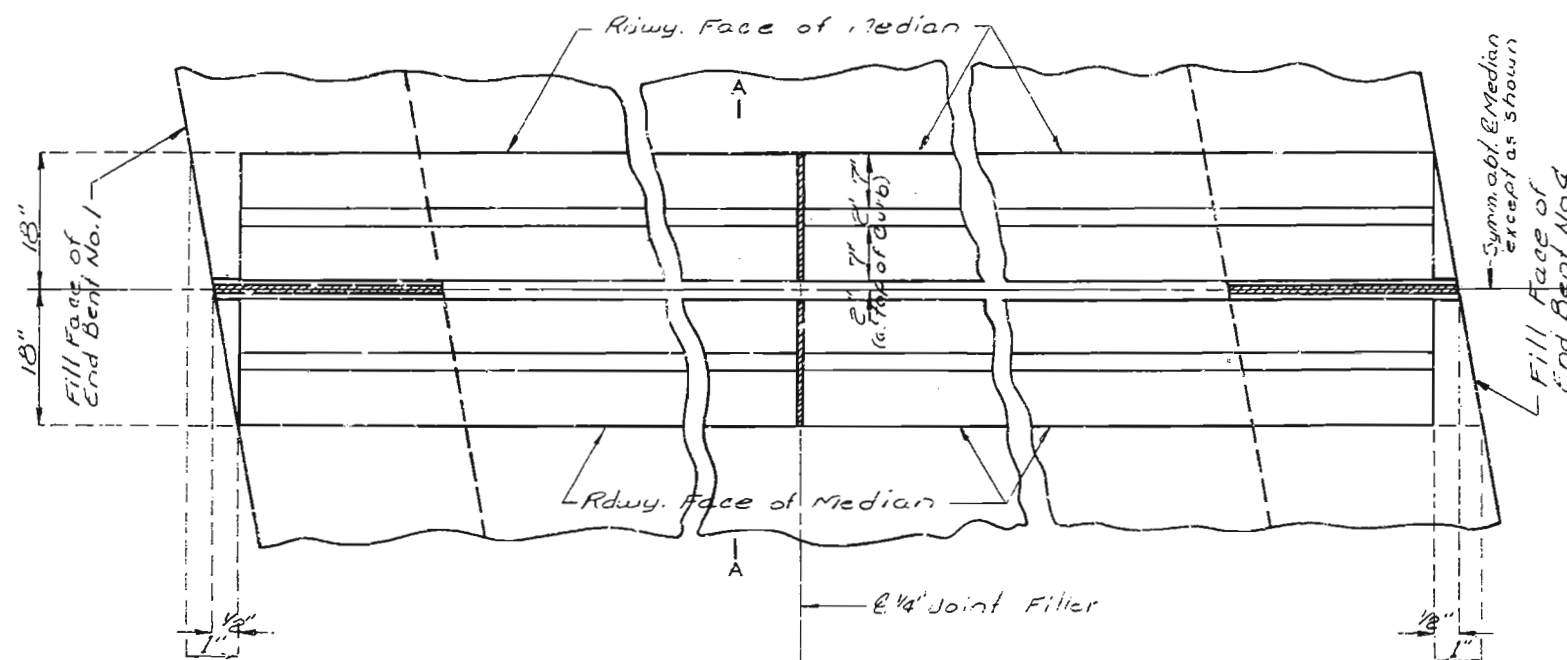

PART PLAN SHOWING DOUBLE FACED MEDIAN BARRIER CURB

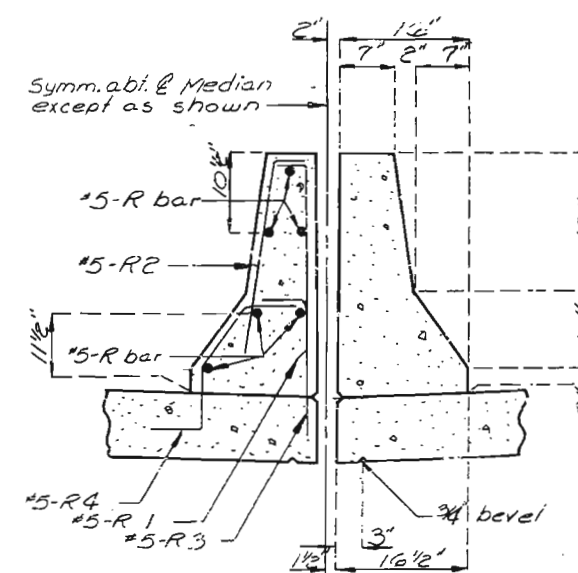


SECTION A-A


Note: Use a minimum lap of 17\"/>

Notes:
Top of median barrier curb to be built parallel to grade with barrier curb joints normal to grade.
All exposed edges of barrier curb shall have 1/2\"/>

FED. ROAD DIST. NO.	STATE	FED. AID PROJ. NO.	FISCAL YEAR	SHEET NO.	TOTAL SHEETS
5	MO.		19	69	

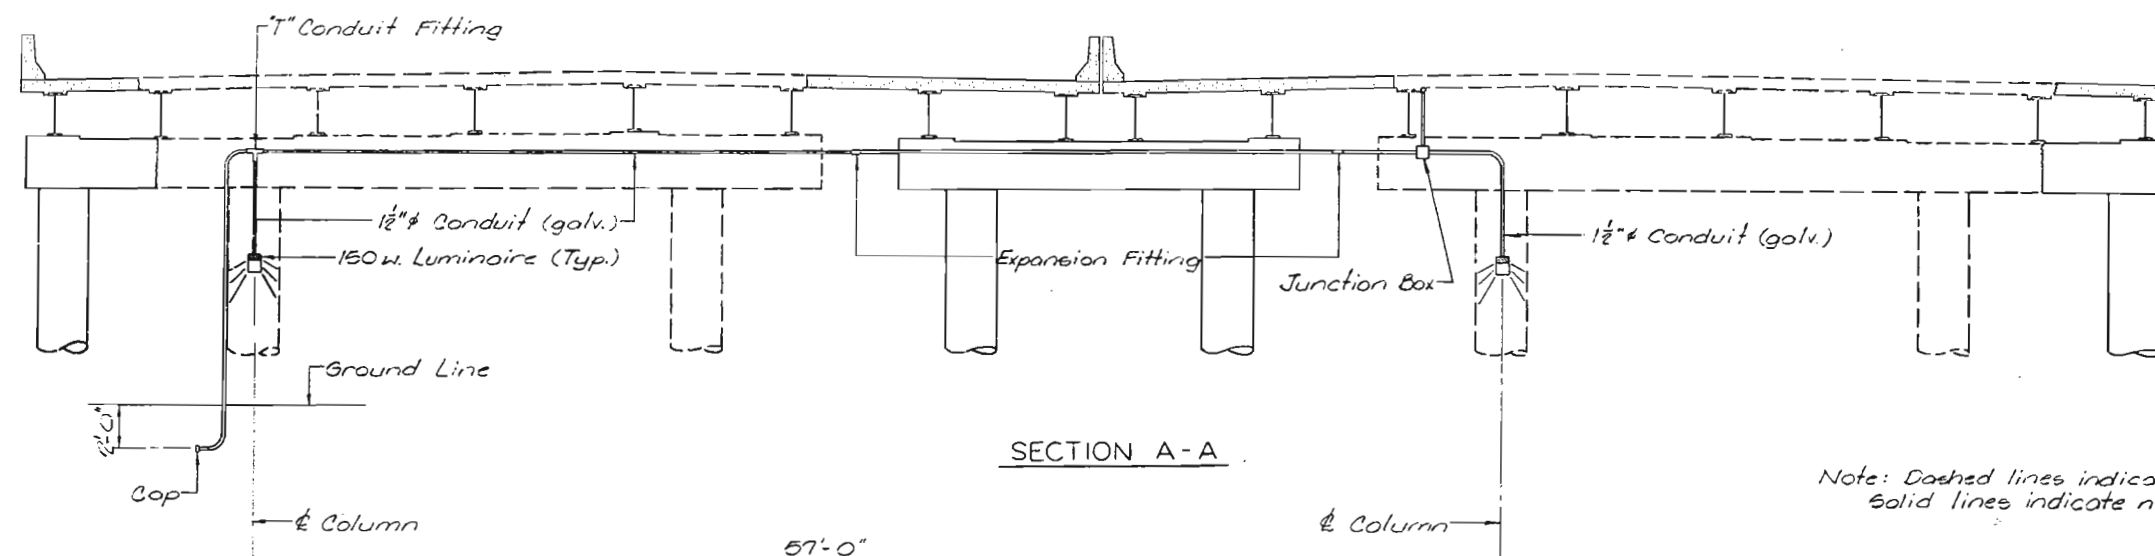

Note: Dashed lines indicate existing structure.
Solid lines indicate new construction.

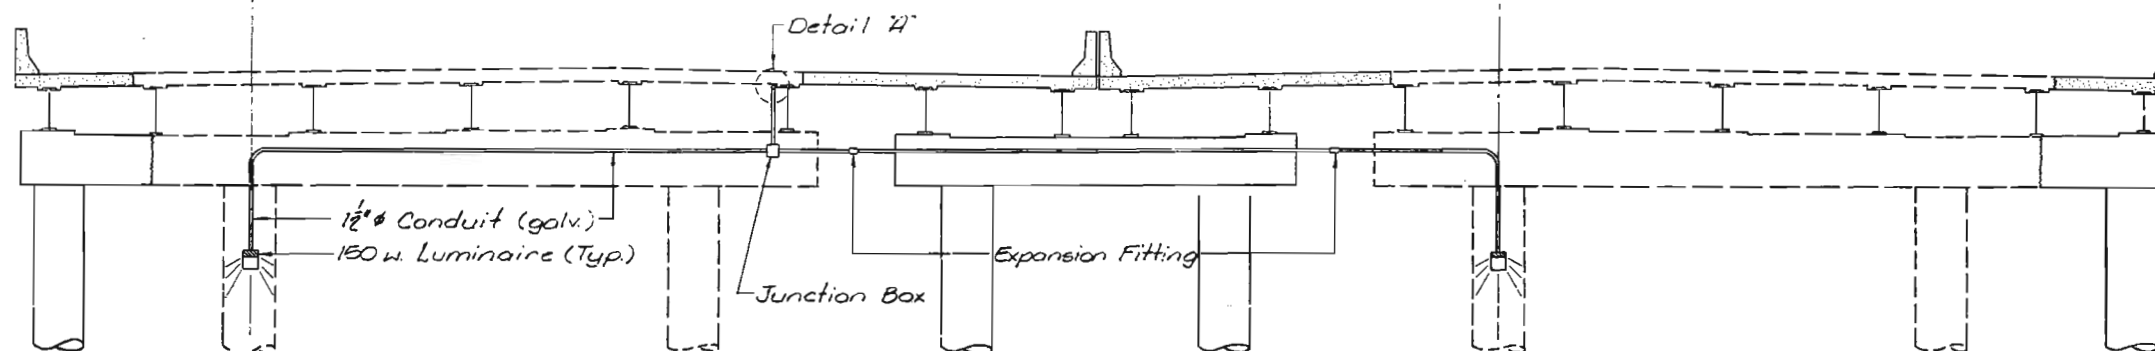

SECTION B-B

GENERAL NOTES:

All conduit shall be 1 1/2" rigid steel, galvanized, as shown, complete with all couplings, elbows, expansion fittings, junction boxes, caps and clamps.



Provide 4-1 1/2" Type "AX" or "AF" expansion fittings as shown. They shall provide a minimum movement of 2" in either direction. They shall be equal to O.Z. Gedney Co. Type "AX" or Spring City Electrical Manufacturing Co. Type "AF".

Provide 2-10"x8"x4" junction boxes as shown. They shall be O.Z. Gedney Co. Type "YH" or Spring City Electrical Manufacturing Co. Type "HF". Wall thickness shall be sufficient to provide 5 full threads for watertight conduit joint.

Conduit shall be secured to the concrete with clamps at about 5'-0" centers.

The conduit system, complete in place, including 4-150 watt high pressure sodium luminaires, shall be paid for as Conduit System on Structure, Lump Sum.

The wiring shall be furnished and installed by others (see Roadway Plans).

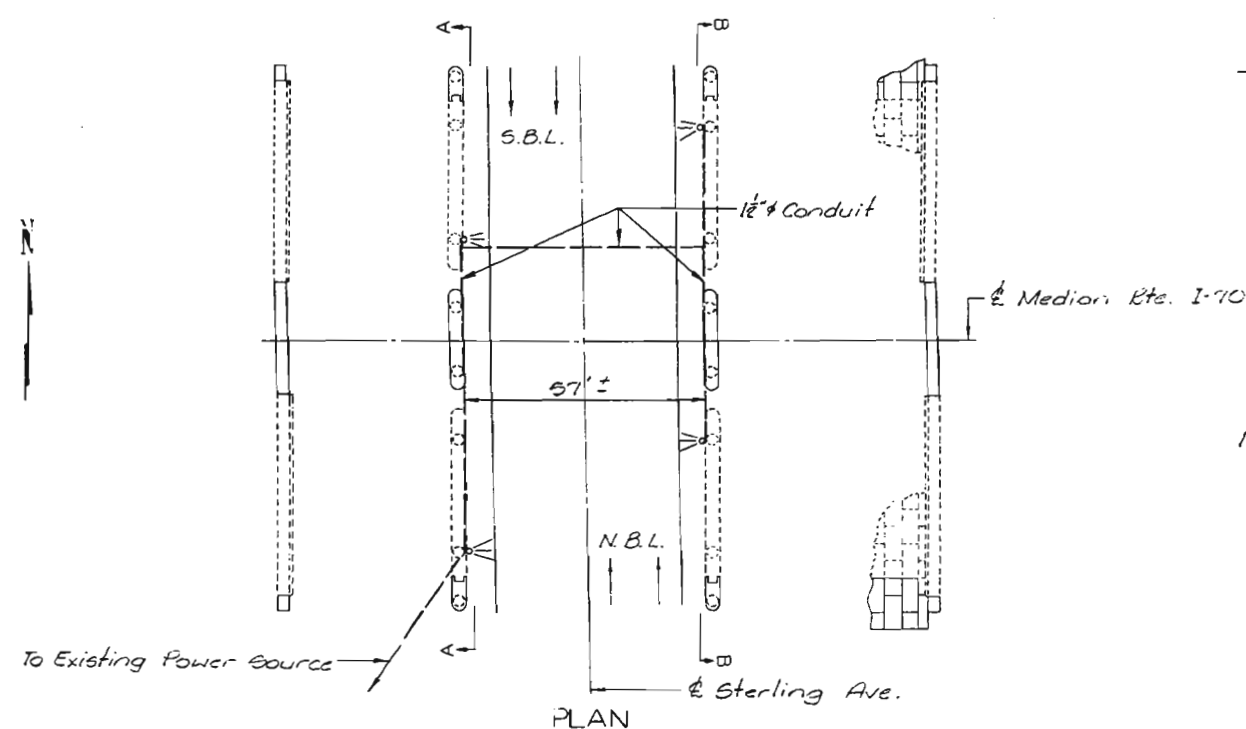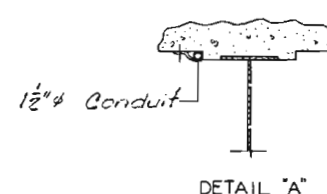

PLAN

Note: This drawing is not to scale. Follow dimensions.

188
DETAILED Feb., 1982
CHECKED Mar., 1982

Sheet No. 22 of 24.

JACKSON COUNTY

L - 972R

COMPLETE BILL OF REINFORCING STEEL

NO. REQ.	MARK NO.	LOCATION	EPOXY (E)	SHAPE NO.	STIRRUP (S)	SUBSTR. (V)	VARIES (V)	NO. EACH	DIMENSIONS										NOMINAL LENGTH	ACTUAL LENGTH	WEIGHT
									B	C	D	E	F	H	K						
									FT.	IN.	FT.	IN.	FT.	IN.	FT.	IN.	FT.	IN.			
		SUBSTRUCTURE																			
		END BENT NO.1																			
4	6H1	BEAM (INTERIOR)		20	X				12	10.000									12	10	77
16	6H2	BEAM (INTERIOR)		17	X				12	10.000									13	6	324
4	6H3	BEAM (EXTERIOR)		20	X				3	2.500									3	3	20
16	6H4	BEAM (EXTERIOR)		17	X				3	2.500									3	11	94
34	5U10	BEAM		13	S	X			2	6.000	3	3.000	2	6.000	3	3.000			12	5	428
		INT. BENT NO.2																			
24	6D1	FOOTINGS		10	S	X				3	5.000	16.000							8	2	282
32	10D2	FOOTINGS		17	X				7	10.000									9	3	1274
16	7H20	BEAM		7	X				4	0.000	2	9.500							9	6	311
2	6H21	BEAM (INTERIOR)		20	X				20	4.000									20	4	61
7	8H22	BEAM (INTERIOR)		20	X				20	4.000									20	4	380
4	8H23	BEAM (INTERIOR)		18	X				20	4.000									22	2	237
8	6H24	BEAM (EXTERIOR)		20	X				6	5.000									6	5	77
4	6H25	BEAM (EXTERIOR)		20	X				6	1.000									6	1	37
4	6H26	BEAM (EXTERIOR)		20	X				6	5.000									6	5	39
4	6H27	BEAM (EXTERIOR)		20	X				6	1.000									6	1	37
2	8H29	BEAM (INTERIOR)		18	X				23	2.000									25	0	134
75	4P1	COLUMNS		16	X				2	9.000									9	6	476
2	4U21	BEAM (EXTERIOR)		10	S	X				6.000	2	7.500							3	8	5
10	4U20	BEAMS		10	S	X				6.000	2	11.000							3	11	25
24	5U22	BEAM (INTERIOR)		13	S	X			2	11.000	2	9.000	2	11.000	2	9.000			12	3	298
2	5U23	BEAM (INTERIOR)		13	S	X			2	9.500	2	9.000	2	9.500	2	9.000			12	0	24
2	5U24	BEAM (INTERIOR)		13	S	X			2	4.000	2	9.000	2	4.000	2	9.000			11	1	22
10	5U25	BEAM (EXTERIOR)		13	S	X			2	11.000	3	3.000	2	11.000	3	3.000			13	3	108
2	5U26	BEAM (EXTERIOR)		13	S	X			2	10.500	3	3.000	2	10.500	3	3.000			13	2	27
2	5U27	BEAM (EXTERIOR)		13	S	X			22.000	3	3.000	22.000	3	3.000					11	1	22
16	10V20	COLUMN		17	X				19	10.000									21	3	1463
8	10V21	COLUMN		17	X				19	3.000									20	8	711
8	10V22	COLUMN		17	X				22	3.000									23	6	815
12	2W1	A.B. WELL		22	X				12.000	9.125									19	9	40
		INT. BENT NO.3																			
24	6D1	FOOTINGS		10	S	X				3	5.000	16.000							8	2	282
32	10D2	FOOTINGS		17	X				7	10.000									9	3	1274
16	7H20	BEAM		7	X				4	0.000	2	9.500							9	6	311
2	6H21	BEAM (INTERIOR)		20	X				20	4.000									20	4	61
7	8H22	BEAM (INTERIOR)		20	X				20	4.000									20	4	380
4	8H23	BEAM (INTERIOR)		18	X				20	4.000									22	2	237
8	6H24	BEAM (EXTERIOR)		20	X				6	5.000									6	5	77
4	6H25	BEAM (EXTERIOR)		20	X				6	1.000									6	1	37
4	6H26	BEAM (EXTERIOR)		20	X				6	5.000									6	5	39
4	6H27	BEAM (EXTERIOR)		20	X				6	1.000									6	1	37
8	6H28	BEAM (EXTERIOR)		20	X				2	4.000									2	4	28
2	8H29	BEAM (INTERIOR)		18	X				23	2.000									25	0	134
76	4P1	COLUMNS		16	X				2	9.000									9	6	482
10	4U20	BEAMS		10	S	X				6.000	2	11.000							3	11	25

COMPLETE BILL OF REINFORCING STEEL

NO. REQ.	MARK NO.	LOCATION	EPOXY (E)	SHAPE NO.	STIRRUP (S)	SUBSTR. (V)	VARIES (V)	NO. EACH	DIMENSIONS										NOMINAL LENGTH	ACTUAL LENGTH	WEIGHT				
									B		C		D		E		F					H		K	
									FT.	IN.	FT.	IN.	FT.	IN.	FT.	IN.	FT.	IN.				FT.	IN.	FT.	IN.
2	4U21	BEAM (EXTERIOR)		10	S	X				6.000	2	7.500							3	8	3	4			
24	5U22	BEAM (INTERIOR)		13	S	X			2	11.000	2	9.000	2	11.000	2	9.000			12	3	11	11			
2	5U23	BEAM (INTERIOR)		13	S	X			2	9.500	2	9.000	2	9.500	2	9.000			12	0	11	8			
2	5U24	BEAM (INTERIOR)		13	S	X			2	4.000	2	9.000	2	4.000	2	9.000			11	1	10	9			
8	5U25	BEAM (EXTERIOR)		13	S	X			2	11.000	3	3.000	2	11.000	3	3.000			13	3	12	11			
4	5U30	BEAM (EXTERIOR)		13	S	X			2	11.000	3	6.375	2	11.000	3	6.375			13	10	13	6			
2	5U31	BEAM (EXTERIOR)		13	S	X			2	10.500	3	6.375	2	10.500	3	6.375			13	9	13	5			
2	5U32	BEAM (EXTERIOR)		13	S	X			22.000	3	6.375	22.000	3	6.375					11	8	11	4			
16	10V30	COLUMNS		17	X				19	0.000									20	5	20	5			
8	10V31	COLUMN		17	X				18	0.000									19	5	19	5			
8	10V32	COLUMN		17	X				24	7.000									26	0	26	0			
12	2W1	A.B. WELL		22	X				12.000	9.125									19	9	19	9			
		END BENT NO.4																							
4	6H1	BEAM (EXT.)		20	X				12	10.000									12	10	12	10			
16	6H2	BEAM (EXT.)		17	X				12	10.000									13	6	13	6			
4	6H3	BEAM (INT.)		20	X				3	2.500									3	3	3	3			
16	6H4	BEAM (INT.)		17	X				3	2.500									3	11	3	11			
34	5U10	BEAM		13	S	X			2	6.000	3	3.000	2	6.000	3	3.000			12	5	12	1			
		SUPERSTRUCTURE																							
20	6H5	END BT. DIAPH.		20					16	8.000									16	8	16	8			
20	6H6	END BT. DIAPH.		20					29	10.000									29	10	29	10			
20	6H7	END BT. DIAPH.		20					35	10.000									35	10	35	10			
20	6H8	END BT. DIAPH.		20					7	1.000									7	1	7	1			
24	6H10	END BT. WINGS		20					9	5.000									9	5	9	5			
8	6H11	END BT. WINGS		20					8	8.000									8	8	8	8			
8	6H12	END BT. WINGS		20					3	11.000									3	11	3	11			
8	6H13	END BT. WINGS		20					2	5.000									2	5	2	5			
702	5R1	BARRIER CURBS		19	S				2	6.000	3.500								2	10	2	8			
702	5R2	BARRIER CURBS		15	S				2	6.125	3.500								2	10	2	9			
646	5R3	BARRIER CURBS		19	S				17.000	6.000									23	22	22	12			
646	5R4	BARRIER CURBS		27	S					6.000	11.125	7.000	12.000	9.125	6.375	3	0	2	10	19	19	19			
40	5R5	BARRIER CURB		19	S				2	1.000	6.000								2	7	2	6			
40	5R6	BARRIER CURB		27	S					6.000	11.125	15.000		9.125	6.375	2	8	2	7	10	10				
16	5R7	BARRIER CURB		10	S				2	1.000	6.000								4	8	4	4			
96	5R8	BARRIER CURBS		20					9	9.000									9	9	9	9			
12	5R9	BARRIER CURB		20					30	10.000									30	10	30	10			
24	5R10	BARRIER CURBS		20					39	9.000									39	9	39	9			
12	5R11	BARRIER CURB		20					41	1.000									41	1	41	1			
40	5R12	BARRIER CURB		20					10	3.000									10	3	10	3			
4	5R13	BARRIER CURB		20					10	0.000									10	0	10	0			
4	5R14	BARRIER CURB		20					8	6.000									8	6	8	6			
12	5R15	MED. BARRIER CURB		20					33	3.000									33	3	33	3			
12	5R16	MED. BARRIER CURB		20					43	7.000									43	7	43	7			
156	551	SLAB		20					53	7.000									53	7	53	7			
472	552	SLAB		20					16	8.000									16	8	16	8			
472	553	SLAB		20					7	1.000									7	1	7	1			
126	554	SLAB		20					53	7.000									53	7	53	7			
686	555	SLAB		20					16	8.000									16	8	16	8			
688	556	SLAB *		20					7	1.000									7	1	7	1			
72	557	SLAB		20					28	2.000									28	2	28	2			
72	558	SLAB		20					32	5.000									32	5	32	5			

190

STD. 90.8.5 REVISED
MAY 1974 JAN. 1981

DETAILED SEPT. 1981
CHECKED Sept. 1981


Note: This drawing is not to scale. Follow dimensions.

Sheet No. 24 of 24.


JACKSON

COUNTY


L-972R

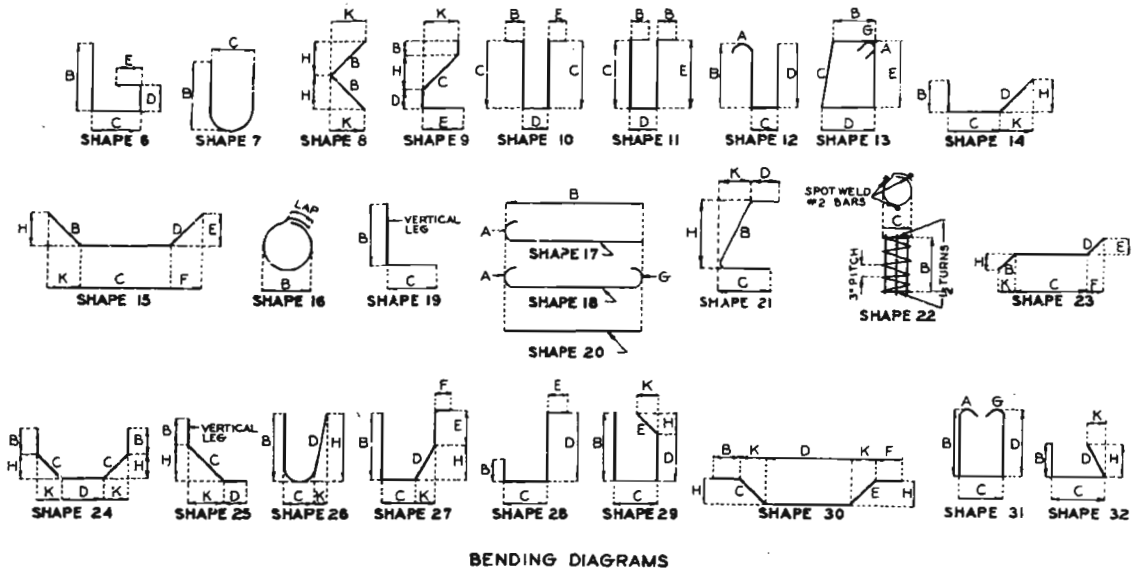

COMPLETE BILL OF REINFORCING STEEL															
NO. REQD.	MARK NO.	LOCATION	EPOXY (E)	SHAPE NO.	STIRRUP (S)	SUBSTR. (V)	NO. EACH	DIMENSIONS							
								B	C	D	E	F	H	K	WEIGHT
8	6T1	END BENT WINGS		23	S			17.000	7 1.000				0.900	17.000	102
94	4U1	END BT. DIAPH.	*	19	S			3 3.000	3 6.000						419
92	4U2	END BT. DIAPH.		19	S			3 3.000	2 3.000						333
144	4U3	END BT. DIAPH.		19	S			3 10.000	2 3.000						577
144	4U4	END BT. DIAPH.		10	S				15.000	3 10.000					593
16	6U5	END BT. DIAPH.		19	S			2 3.000	3 6.000						134
8	6V1	END BT. WINGS		23	S			8 0.625	2 1.000			7 3.000	3 6.000	10 2 10 1	121
32	6V2	END BT. WINGS		20	Y	4		2 3.000						2 3 2 3	196
		INCR = 6.250 IN						5 11.000						5 11 5 11	
32	6V3	END BT. WINGS		20	Y	4		2 2.000						2 2 2 2	178
		INCR = 5.250 IN						5 3.000						5 3 5 3	
		END OF BAR LIST													

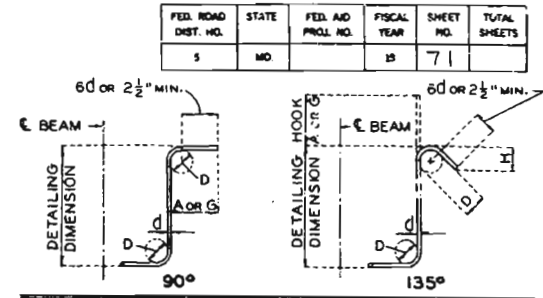

STIRRUP HOOK DIMENSIONS				
GRADES 40-50-60 KSI				
BAR SIZE	D (in.)	90° HOOK	135° HOOK	APPROX. H
#3	1-1/2"	4"	4"	2-1/2"
#4	2"	4-1/2"	4-1/2"	3"
#5	2-1/2"	6"	5-1/2"	3-3/4"
#6	4-1/2"	8"	7"	4-1/2"

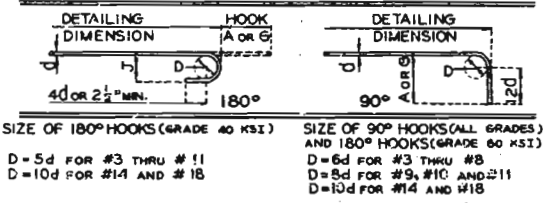

END HOOK DIMENSIONS				
BAR SIZE	180° HOOKS			
	GRADE 40		GRADE 60	
#3	5"	2-3/4"	5"	3"
#4	6"	3-1/2"	6"	4"
#5	7"	4-1/2"	7"	5"
#6	8"	5-1/4"	8"	6"
#7	9"	6-1/4"	10"	7"
#8	10"	7"	11"	8"
#9	12"	8"	15"	11-1/4"
#10	13"	9"	17"	12-3/4"
#11	14"	10"	19"	14-1/4"
#14	21-2"	20-1/2"	21-2"	20-1/2"
#18	21-11"	21-3"	21-11"	21-3"

NOTES: ALL STANDARD HOOKS AND BENDS OTHER THAN 180 DEG. TO BE BENT WITH SAME PROCEDURE AS FOR 90 DEG. STD. HOOKS. HOOKS AND BENDS SHALL BE IN ACCORDANCE WITH THE PROCEDURES AS SHOWN ON THIS SHEET. E - EPOXY COATED REINFORCEMENT. S - STIRRUP. X - BAR IS INCLUDED IN SUBSTRUCTURE QUANTITIES. V - BAR DIMENSIONS VARY IN EQUAL INCREMENTS BETWEEN DIMENSIONS SHOWN ON THIS LINE AND THE FOLLOWING LINE. NO. EA. - NUMBER OF BARS OF EACH LENGTH. NOMINAL LENGTHS - ARE BASED ON OUT TO OUT DIMENSIONS SHOWN IN BENDING DIAGRAMS AND ARE LISTED FOR FABRICATORS USE. (NEAREST INCH) ACTUAL LENGTHS - ARE MEASURED ALONG CENTERLINE BAR TO THE NEAREST INCH.

* Two additional #4U are included in Bar Bill for testing.

AVIAL PLANE

GENERAL NOTES:

Design Loading :

Design Unit Stresses:

Steel Pipe
Fabricated Steel:

Joint Filler;
All joint filler did meet the requirement
of Std. Spec. 1059.2.4 except as otherwise noted.

was
Paint:

Areas to be encased in end bent concrete were painted one coat of system C primer and scratched or damaged surfaces were touched up in field before concrete is poured.

Construction Clearance:

A minimum vertical clearance of 14'0" from crown of existing lanes and a minimum lateral clearance of 28'0" centered on Sterling Ave. was maintained during construction.

Traffic Maintained:

Traffic over structure was maintained during construction.

In order to maintain grade and a minimum 1 1/2" Latex Modified Concrete it is anticipated that an average application depth of 1 1/2" was necessary. No payment was allowed for additional labor, materials or equipment required for this necessary minimum and/or variable depth of Latex Modified Concrete.

B.M. #3 - Elev. 993.89 P.K. nail S.W. Wingwall.
#4 - Elev. 993.89 P.K. nail N.W. Wingwall.
#5 - Elev. 1000.71 P.K. nail S.E. Wingwall.
#6 - Elev. 1000.66 P.K. nail N.E. Wingwall.

BRIDGE OVER STERLING AVENUE

STATE ROAD FROM RTE. I-435 TO RTE. I-470

ABOUT 2.1 MILES EAST OF RTE. I-435

PROJECT NO. STA. 451 + 93.20

JOB NO. 4- 1070 - 343

JACKSON COUNTY

DATE *December 14, 1983*

STD. 611.60

STD. 706.35

L-972 R



Note: Roadway fill was completed to the final roadway section and up to the elevation of the bottom of the conc. beam within the limits of the structure and for not less than 25' in back of the fill face of the end bents before piles were driven for any bents falling within the embankment section.

Notes

Note: Outline of old work is indicated by light dashed lines. Heavy lines indicate new work.

Contractor did verify all dimensions in field before ordering new steel.

Bars bonded in old concrete not removed were cleanly stripped and embedded into new concrete where possible. If length is available, old bars did extend into new concrete at least 40 diameters for smooth bars and 30 diameters for deformed bars.


Anchors were of the self drilling expansion type, made of casehardened and drawn carburized steel, with self-cutting annular broaching grooves.

Cost of furnishing and installing hook anchor bolt assemblies was included in contract unit price for concrete.


Utility lines in vicinity of Bent 2 towers supported during construction and not relocated. See ~~Special Provisions~~

Note : All concrete and reinforcement in end vents (except pile cap beam) are included with superstructure quantities.
For Plan of Structure see sheet No. E

FED. ROAD DIST. NO.	STATE	FED. AID PROJ. NO.	FISCAL YEAR	SHEET NO.	TOTAL SHEETS
5	MO.		19	55	

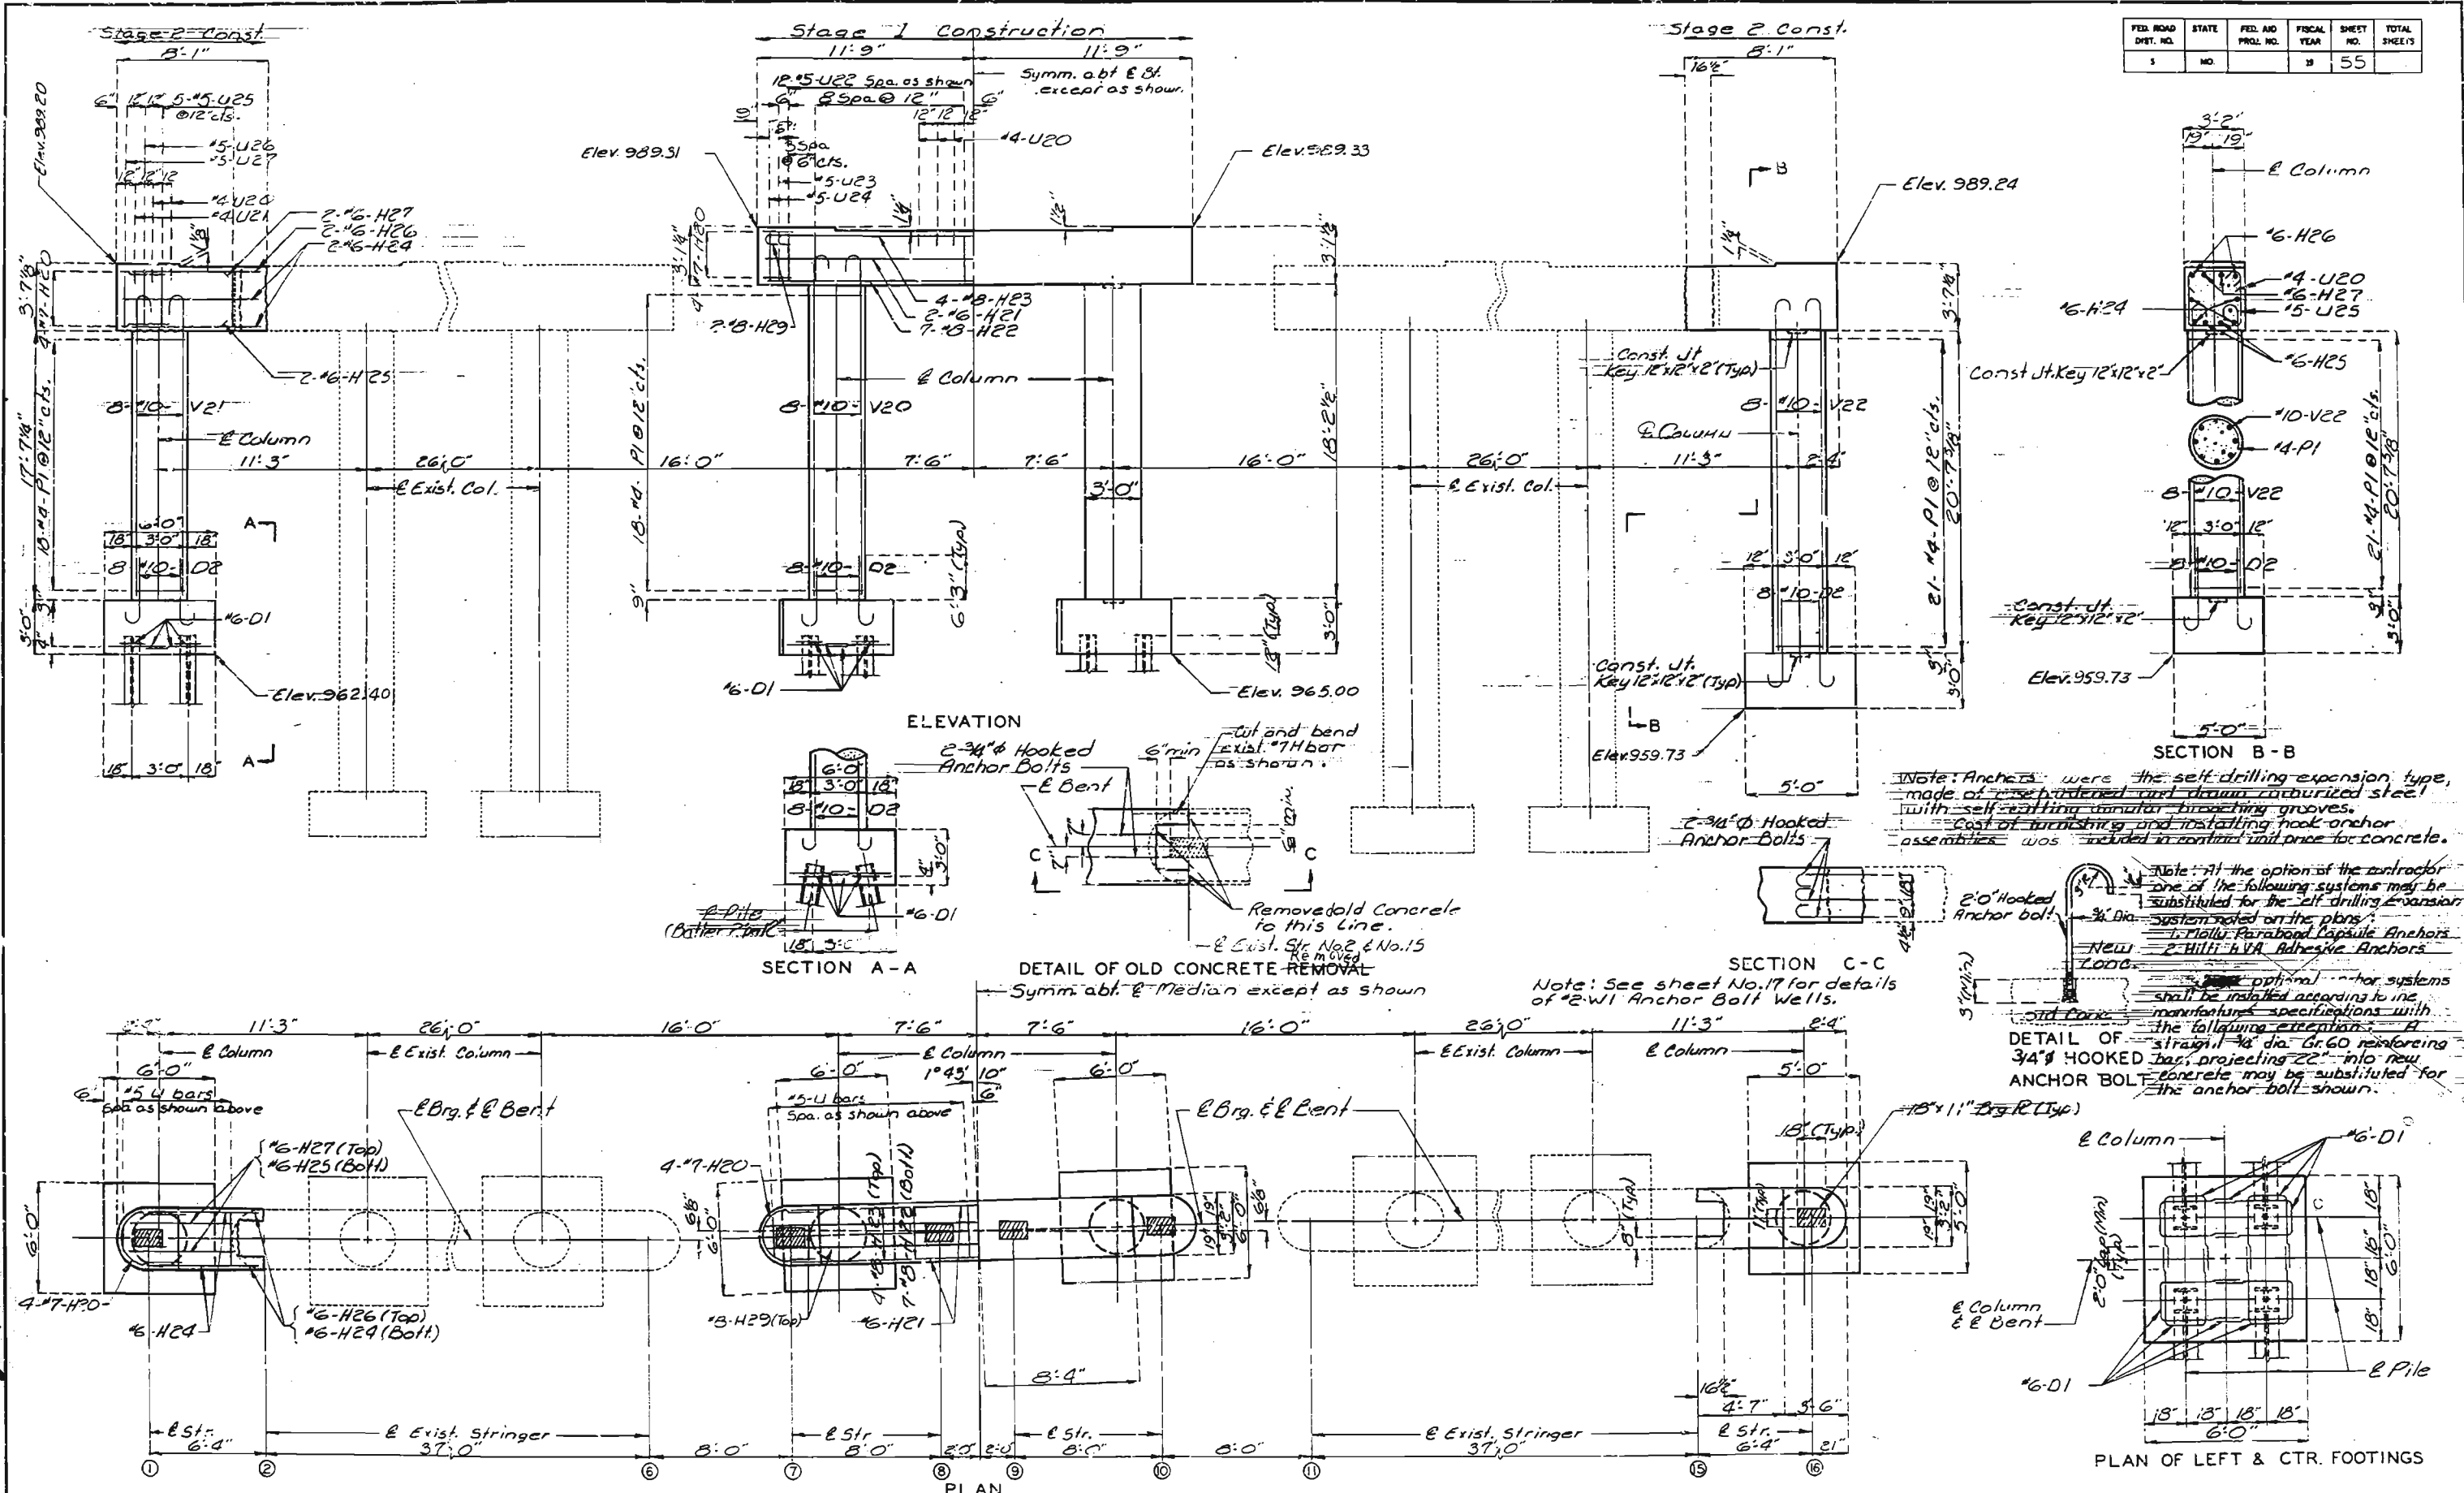


FED. ROAD DIST. NO.	STATE	FED. AID PROJ. NO.	FISCAL YEAR	SHEET NO.	TOTAL SHEETS
1	MD		56	56	

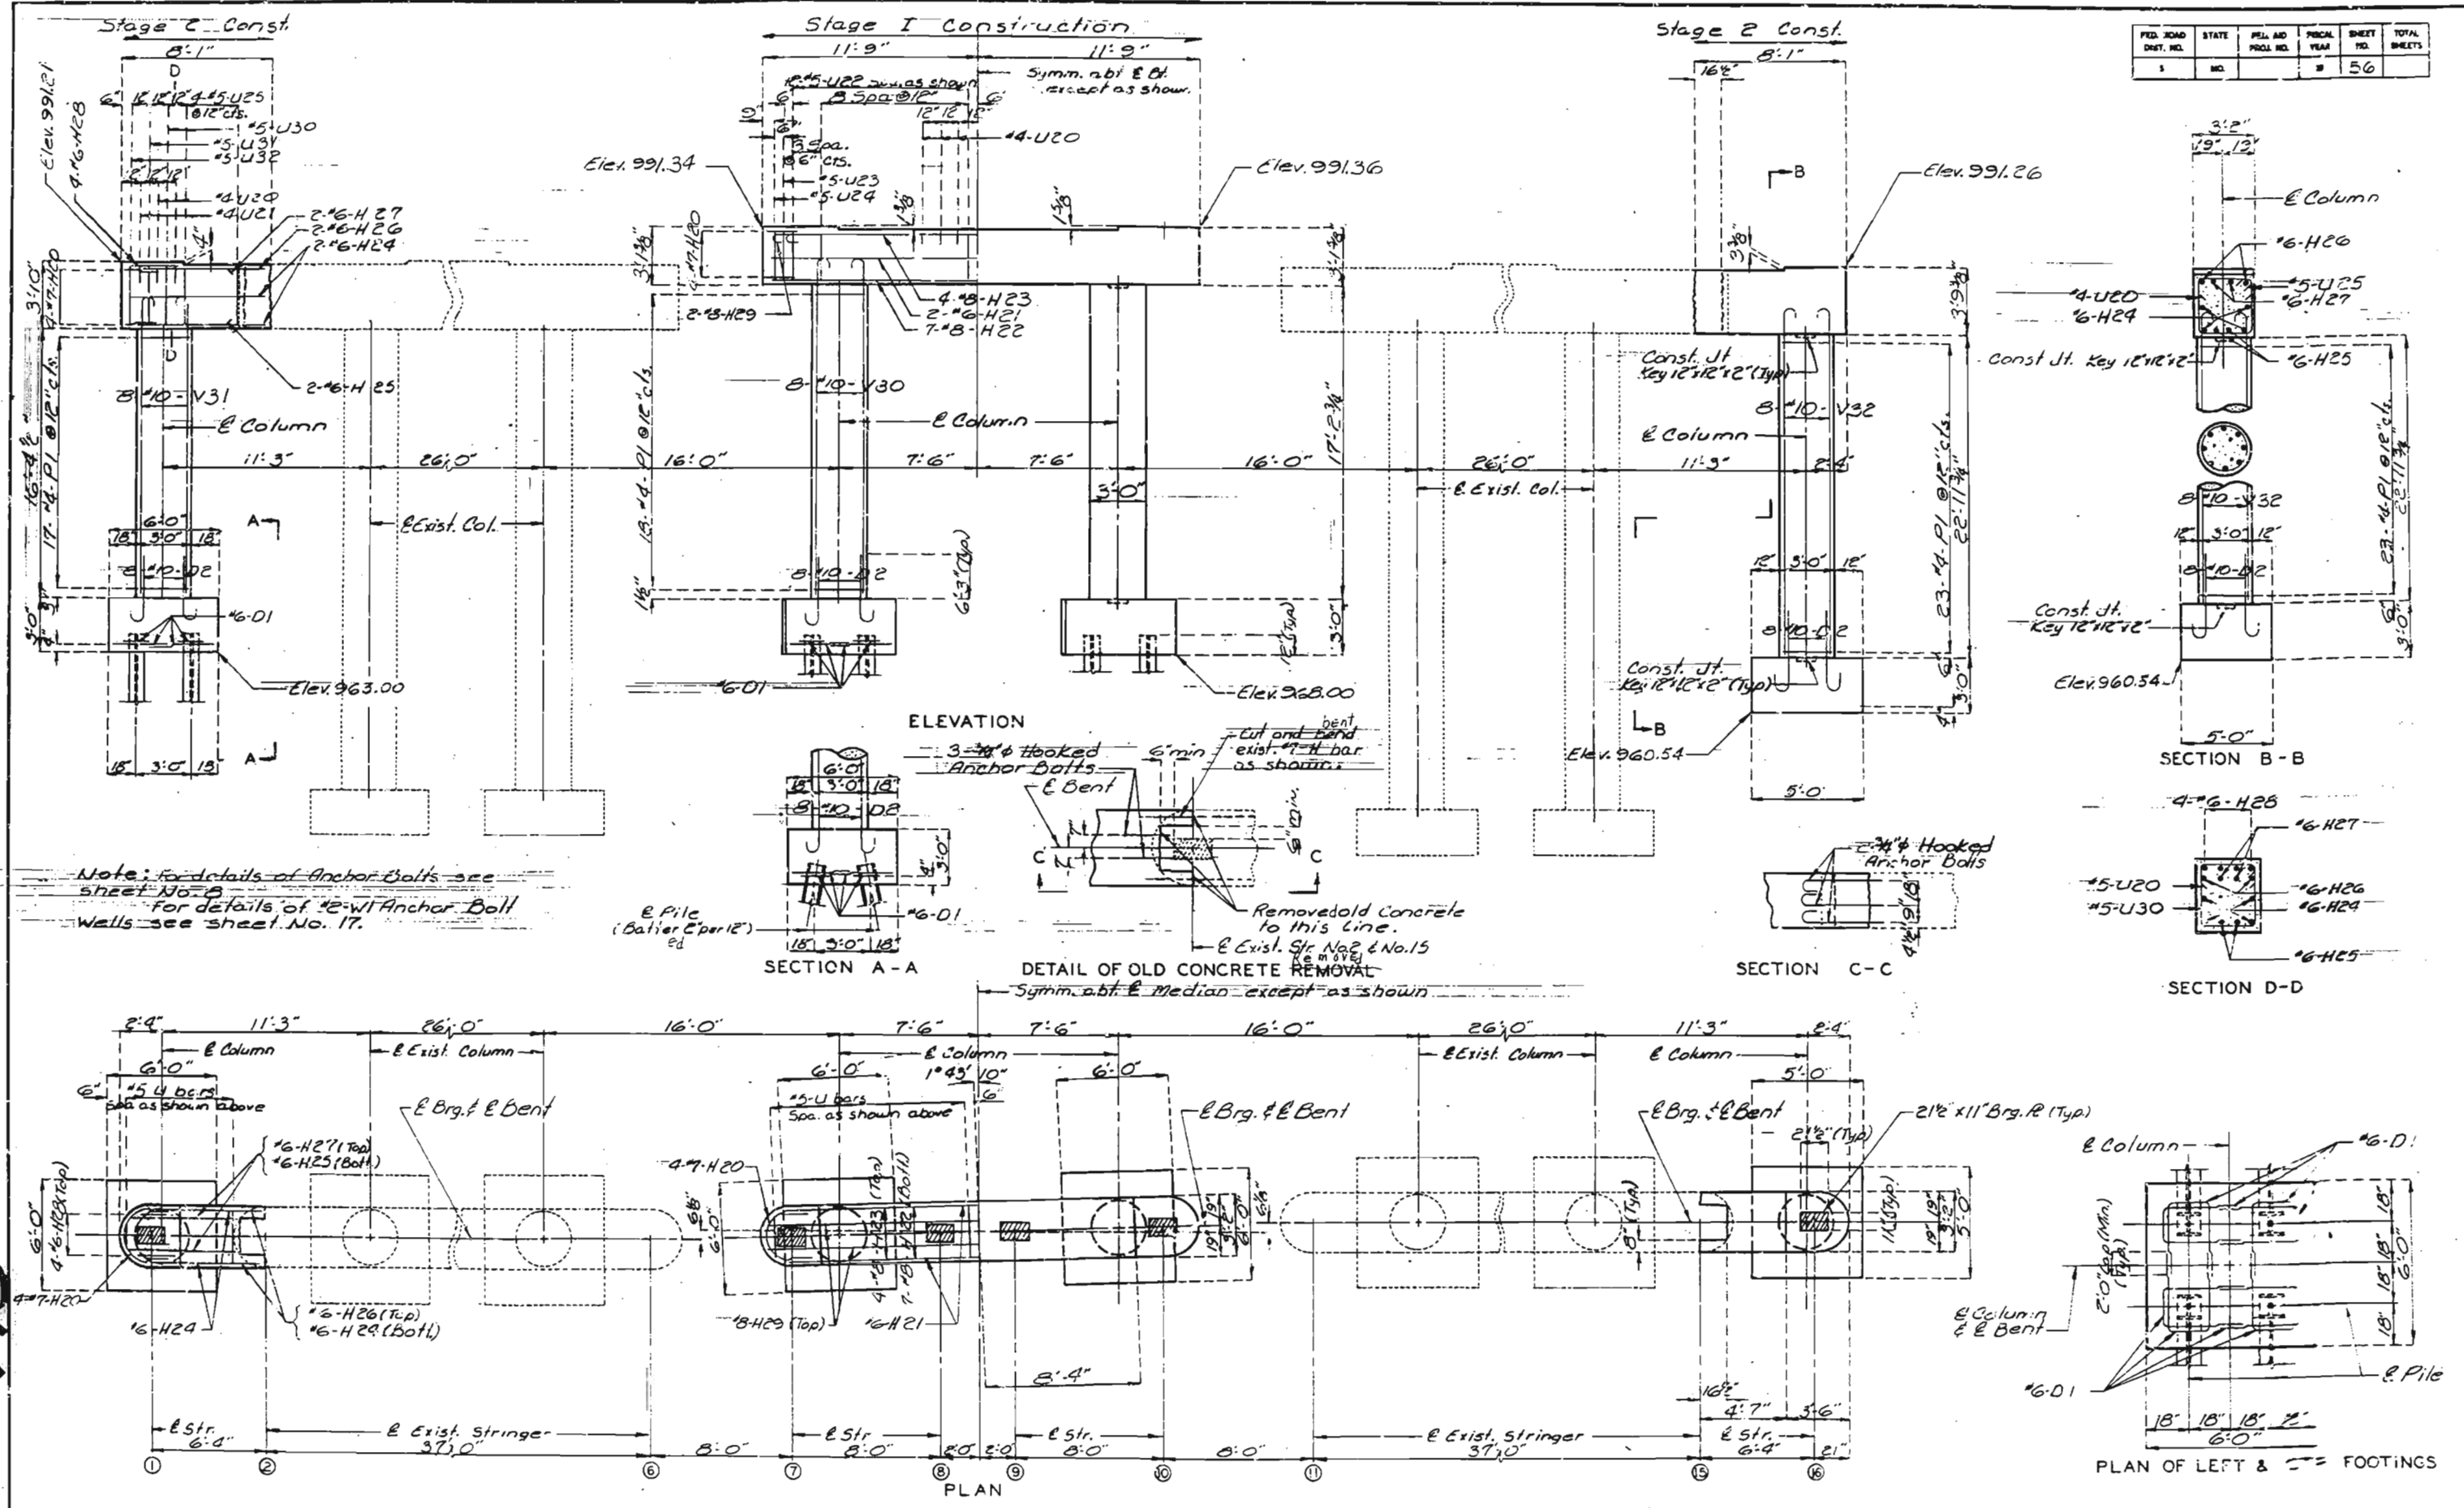

Note: for details of Anchor Bolts see sheet No. 16
for details of 2" W/ Anchor Bolt Walls see sheet No. 17.

MISSOURI HIGHWAYS AND TRANSPORTATION COMMISSION
U.I.P. & REHAB EXIST. (42'-60'-52') CONTINUOUS COMPOSITE WIDE FLANGE BEAM SPANS

SEC/SUR 21 TWP 49N RGE 32W

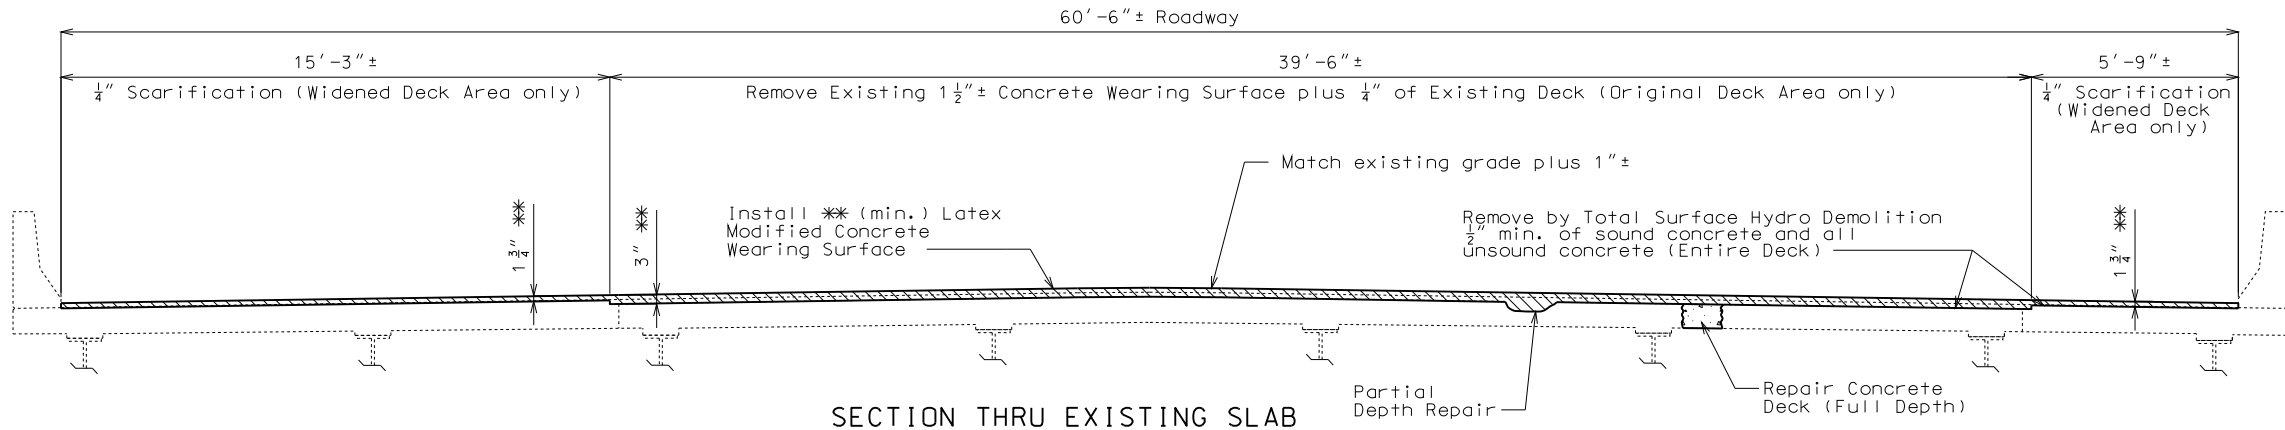

General Notes:

Design Specifications:
2002 - AASHTO 17th Edition
Bridge Deck Rating = 4

Structural Steel Protective Coating:
Protective Coating: Calcium Sulfonate System in accordance with Sec 1081.

Protective Coating Limits: The surfaces of all bearings and anchor bolts at Int. Bents No. 2 & 3.

Surface Preparation: Surface preparation of the bearings and anchor bolts shall be in accordance with Sec 1081 for "Overcoating of Structural Steel (Calcium Sulfonate System)".

Topcoat: The color of the topcoat shall be Gray (Federal Standard #26373).

The cost of the complete protective coating system will be considered completely covered by the contract unit price for "Cleaning and Coating Existing Bearings".

Miscellaneous:

Roadway surfacing adjacent to bridge ends shall match bridge overlay (Rdwy. Item).

"Sec" refers to the sections in the standard and supplemental specifications unless specified otherwise.




Outline of old work is indicated by light dashed lines. Heavy lines indicate new work.

Contractor shall verify all dimensions in field before ordering new material.




In order to maintain grade and a minimum thickness of overlay as shown on plans it may be necessary to use additional quantities of overlay at various locations throughout the structure. See Special Provisions for Method of Measurement.

Traffic Control:

Close structure during construction and maintain EB traffic on WB bridge (L09723). See Roadway Plans for Traffic Control.

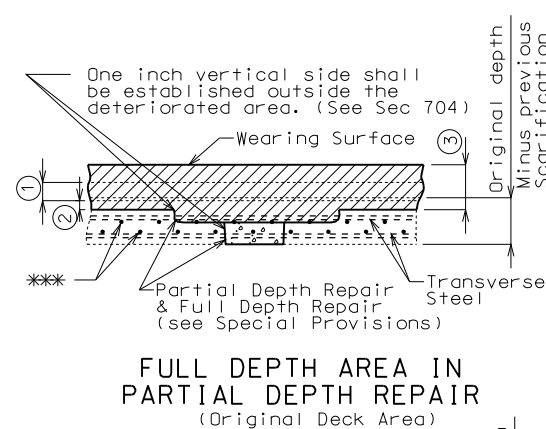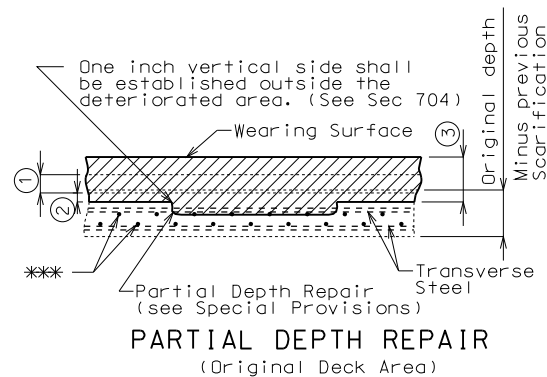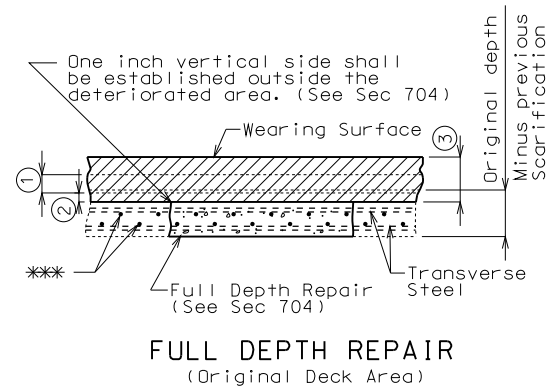



- 1 Remove existing 1 1/2" ± concrete wearing surface plus 1/4" of exist. deck.
- 2 Remove by Total Surface Hydro Demolition 1/2" min. sound concrete and all unsound concrete.
- 3 3" (Min.) Latex Modified Concrete Wearing Surface.

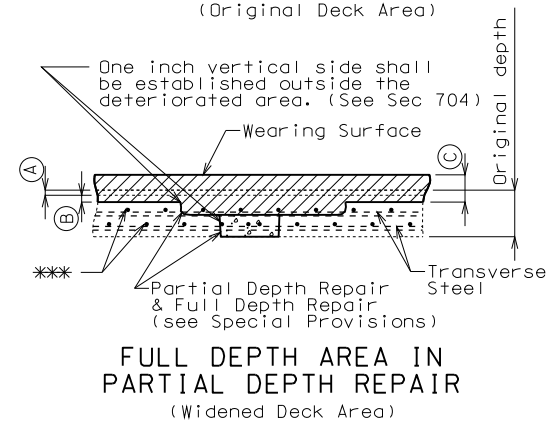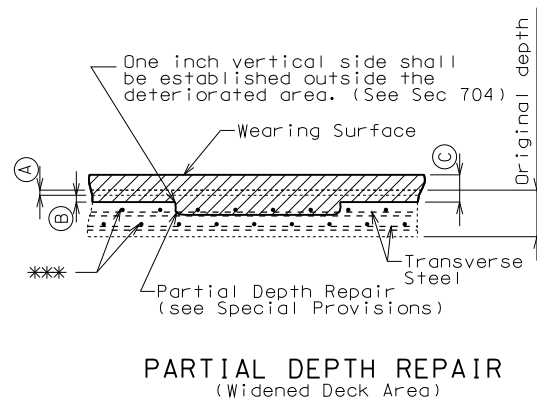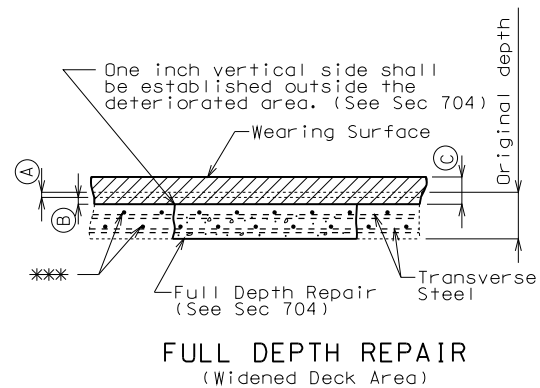


- A Scarify existing slab (1/4" min.)
- B Remove by Total Surface Hydro Demolition 1/2" min. of sound concrete and all unsound concrete.
- C 1 1/2" (min.) Latex Modified Concrete Wearing Surface.

*** Longitudinal Steel

Estimated Quantities		
Item		Total
Scarification of Bridge Decks	sq. yard	367
Removal of Concrete Wearing Surface	sq. foot	6,216
Latex Modified Concrete Wearing Surface	sq. yard	1,058
Substructure Repair (Unformed)	sq. foot	200
Full Depth Repair	sq. foot	3,750
Total Surface Hydro Demolition	sq. yard	1,058
Cleaning and Coating Existing Bearings	each	16

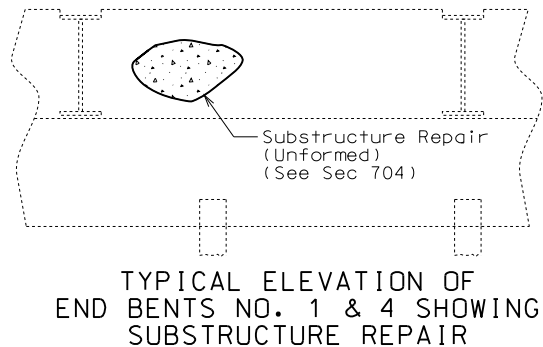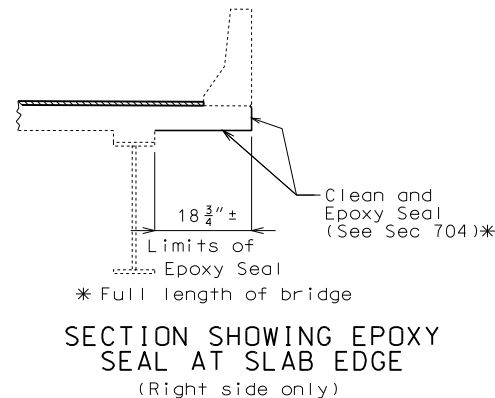

REPAIRS TO BRIDGE: RTE. I-70 EBL
OVER STERLING AVENUE
STATE ROAD FROM RTE. I-435 TO RTE. I-470
ABOUT 2.1 MILES EAST OF RTE. I-435
STA. 451+20.02 ± (Match Exist.)

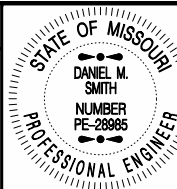

THIS SHEET HAS BEEN
SIGNED, SEALED AND DATED
ELECTRONICALLY.

DATE PREPARED
12/22/2010

ROUTE
I-70

STATE
MO

DISTRICT
BR

SHEET NO.
1

COUNTY
JACKSON

JOB NO.
J411790B

CONTRACT ID.

PROJECT NO.

BRIDGE NO.
L09722

DESCRIPTION

DATE

MISSOURI HIGHWAYS AND TRANSPORTATION COMMISSION

105 WEST CAPITOL
JEFFERSON CITY, MO 65102
1-888-ASK-MODOT (1-888-275-6636)

IF A SEAL IS PRESENT ON THIS SHEET IT HAS BEEN ELECTRONICALLY SEALED AND DATED.








MISSOURI HIGHWAYS AND TRANSPORTATION COMMISSION
U.I.P. & REHAB EXIST. (42'-60'-52') CONTINUOUS COMPOSITE WIDE FLANGE BEAM SPANS

SEC/SUR 21

TWP 49N



RGE 32W

FINAL PLANS

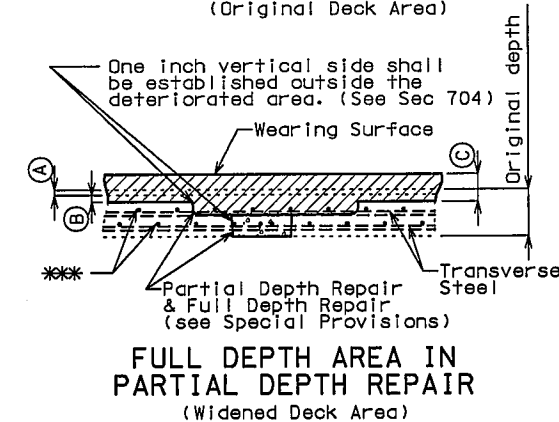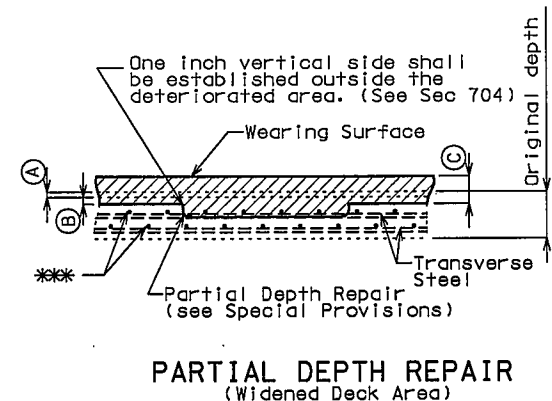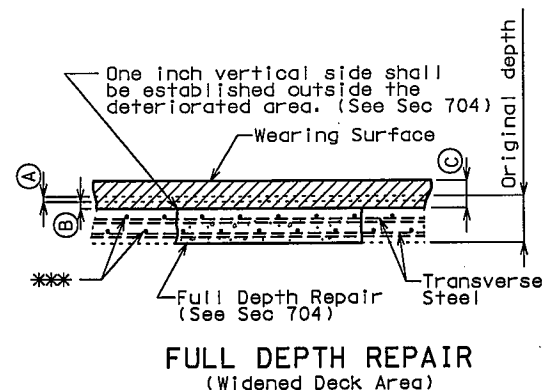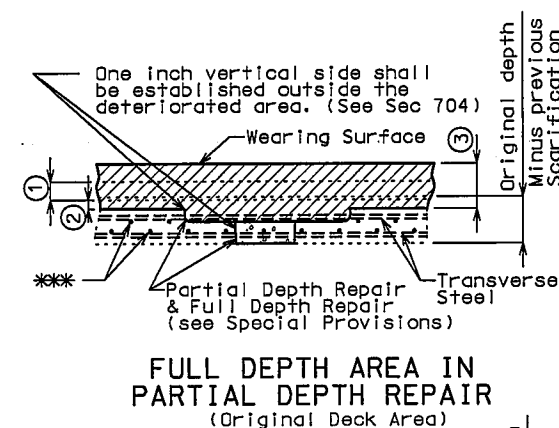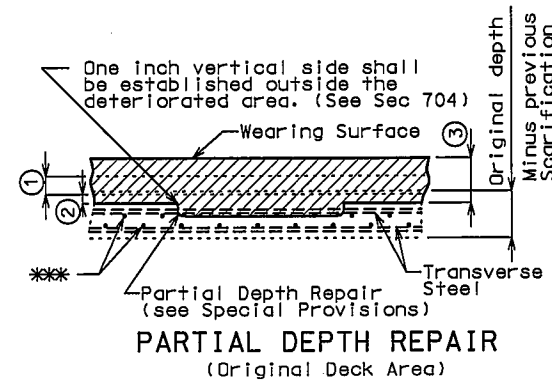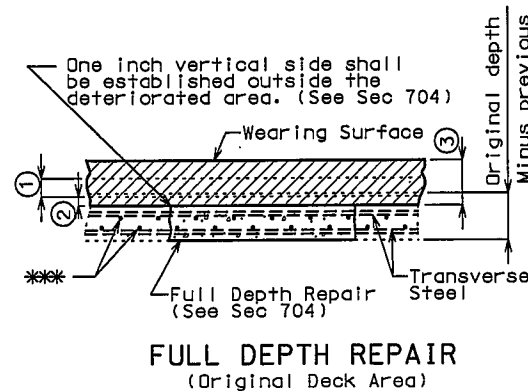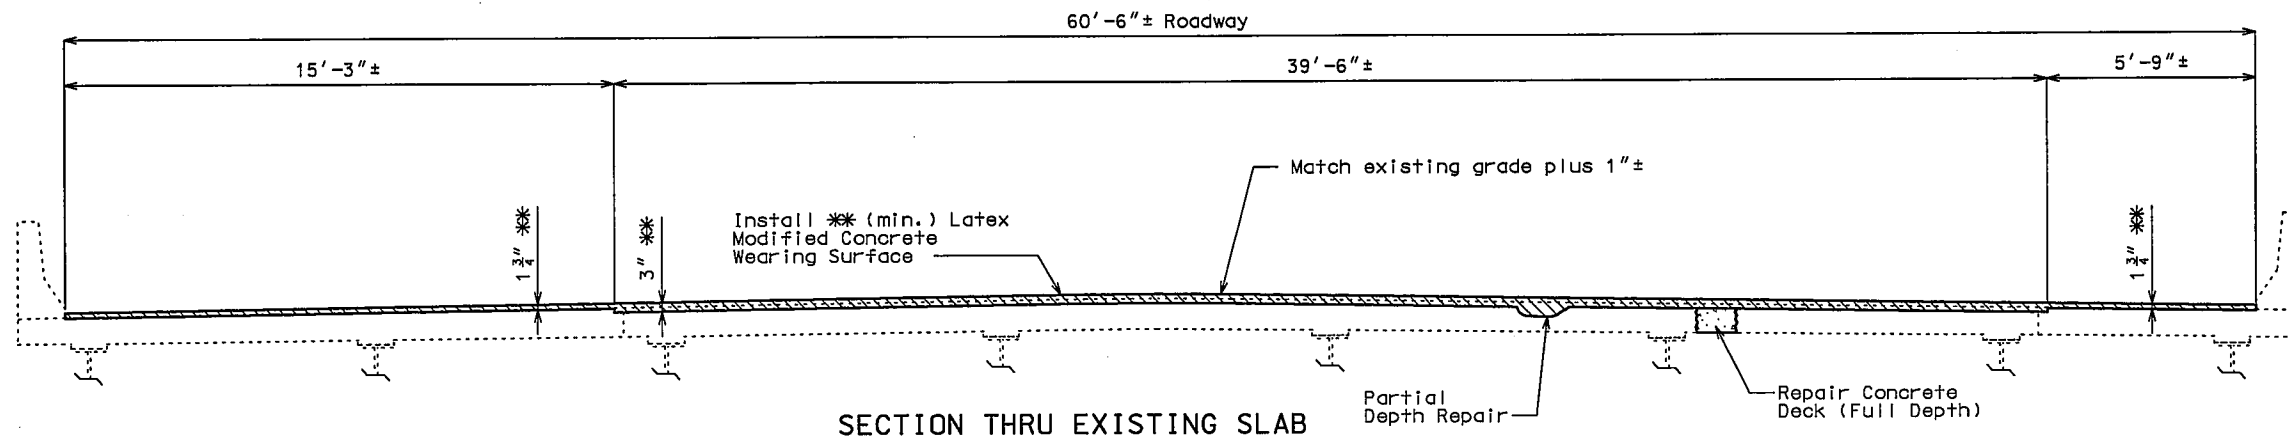

*** Longitudinal Steel

Final Quantities			
Item	Total	Line No.	
Scarification of Bridge Decks	sq. yard 367	0870	
Removal of Concrete Wearing Surface	sq. foot 6,216	0880	
Latex Modified Concrete Wearing Surface	sq. yard 1,058	0890	
Substructure Repair (Unformed)	sq. foot 188	0900	
Full Depth Repair	sq. foot 82	0910	
Total Surface Hydro Demolition	sq. yard 1,058	0920	
Cleaning and Coating Existing Bearings	each 16	0930	
Partial Depth Repair Line 5008	cu. yard 55	5008	

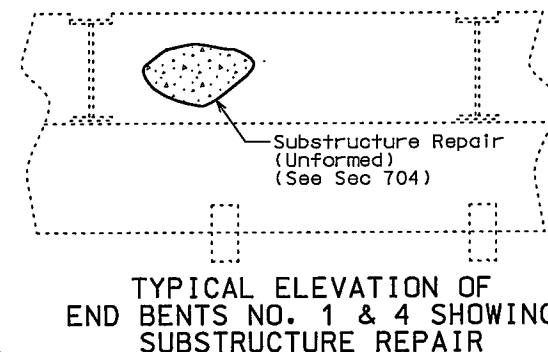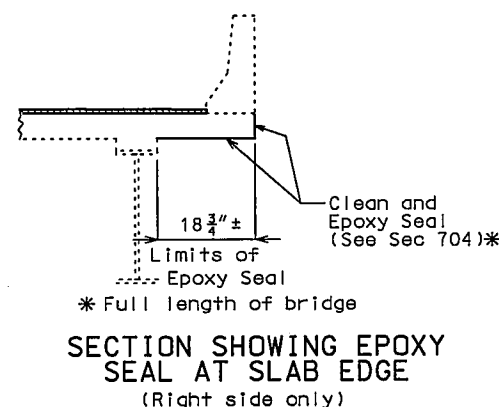

REPAIRS TO BRIDGE: RTE. I-70 EBL OVER STERLING AVENUE
 STATE ROAD FROM RTE. I-435 TO RTE. I-470
 ABOUT 2.1 MILES EAST OF RTE. I-435
 STA. 451+20.02± (Match Exst.)

Detailed July 2010
 Checked Sep. 2010

Note: This drawing is not to scale. Follow dimensions.

Sheet No. 1 of 1

V:\Contract Information Archive\04\4CD\110218-402\As Built Final Plans\J411790B-Bridges\L09722\B_L09722_001_J411790B_frontsheet.dgn 10:31:53 AM 6/12/2012

"THIS MEDIA SHOULD NOT BE CONSIDERED A CERTIFIED DOCUMENT."

DATE PREPARED
 6/12/2012
 ROUTE I-70 STATE MO
 DISTRICT KC SHEET NO. 1
 COUNTY JACKSON
 JOB NO. J411790B
 CONTRACT ID. 110218-402
 PROJECT NO. I-70-1 (192)
 BRIDGE NO. L09722

DESCRIPTION

DATE

MISSOURI HIGHWAYS AND TRANSPORTATION COMMISSION

105 WEST CAPITAL
 JEFFERSON CITY, MO 65102
 1-888-ASK-MODOT (1-888-275-6636)

IF A SEAL IS PRESENT ON THIS SHEET IT HAS BEEN ELECTRONICALLY SEALED AND DATED.


MISSOURI HIGHWAYS AND TRANSPORTATION COMMISSION
U.I.P. & REHAB EXIST. (42'-60'-52') CONTINUOUS COMPOSITE WIDE FLANGE BEAM SPANS

SEC/SUR 21


TWP 49N

RGE 32W


FINAL PLANS

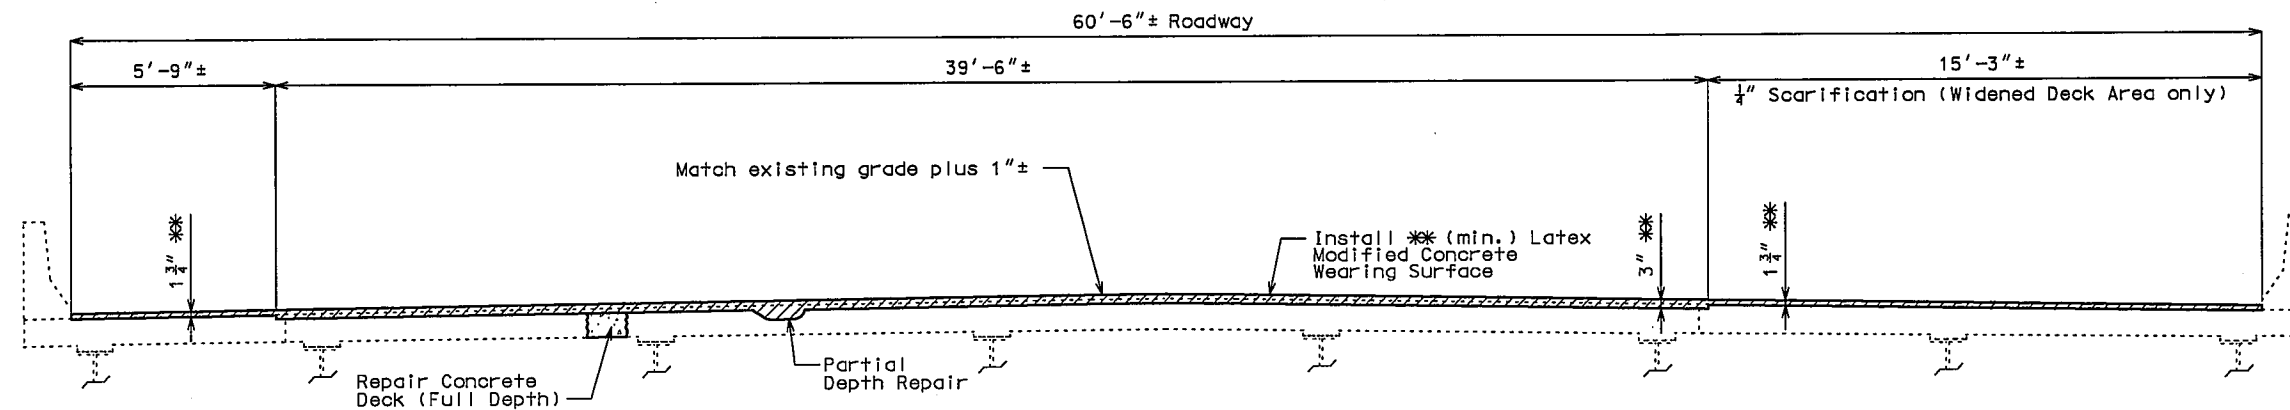


SECTION THRU EXISTING SLAB

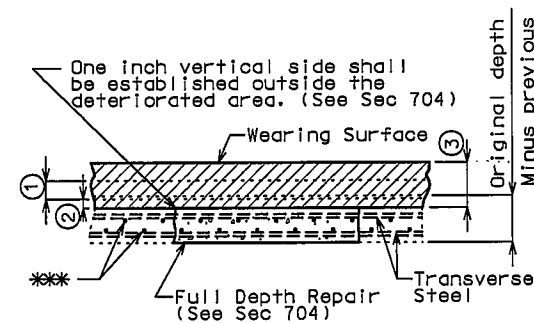


FULL DEPTH REPAIR
(Original Deck Area)

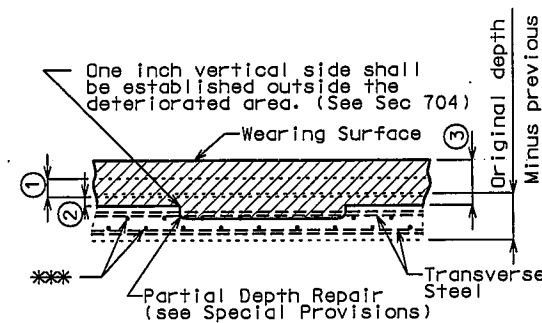


PARTIAL DEPTH REPAIR
(Original Deck Area)

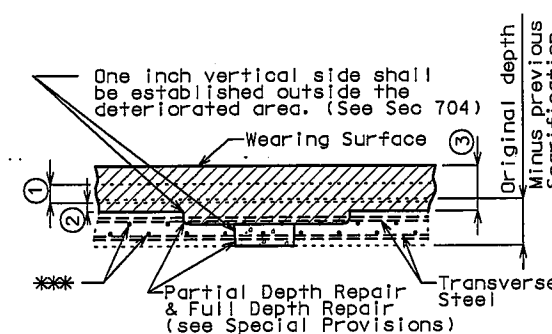


**FULL DEPTH AREA IN
PARTIAL DEPTH REPAIR**
(Original Deck Area)

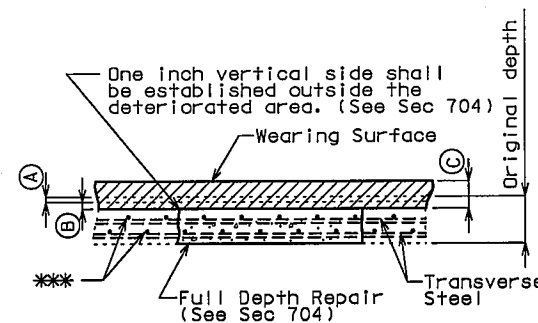

FULL DEPTH REPAIR
(Widened Deck Area)

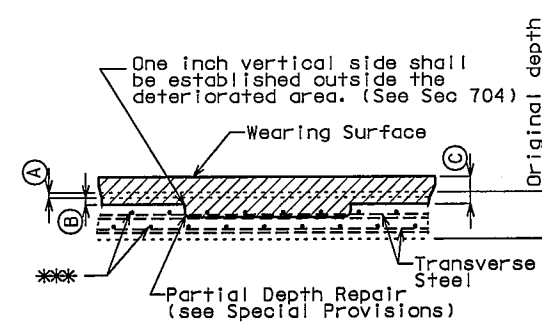

PARTIAL DEPTH REPAIR
(Widened Deck Area)

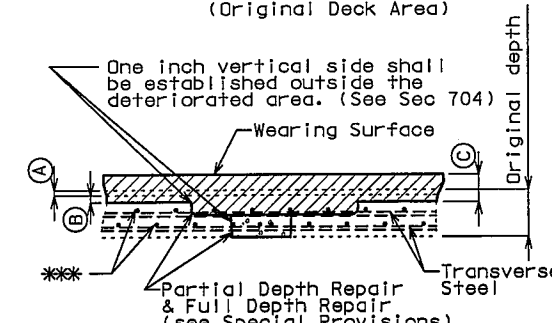


**FULL DEPTH AREA IN
PARTIAL DEPTH REPAIR**
(Widened Deck Area)


*** Longitudinal Steel

Final Quantities

Item	Total	Line No.
Scarification of Bridge Decks	sq. yard 367	0940
Removal of Concrete Wearing Surface	sq. foot 6,216	0950
Latex Modified Concrete Wearing Surface	sq. yard 1,058	0960
Substructure Repair (Unformed)	sq. foot 175	0970
Full Depth Repair	sq. foot 3,073	0980
Total Surface Hydro Demolition	sq. yard 1,058	0990
Cleaning and Coating Existing Bearings	each 16	1000
Partial Depth Repair	cu. yard 39.5	5011

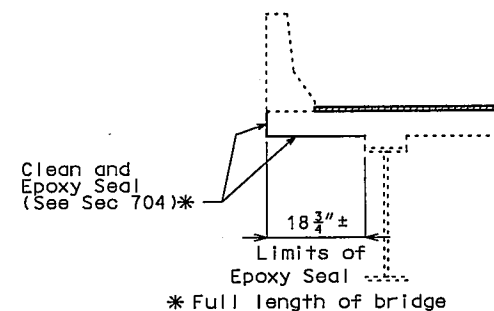

**SECTION SHOWING EPOXY
SEAL AT SLAB EDGE**
(Left side only)

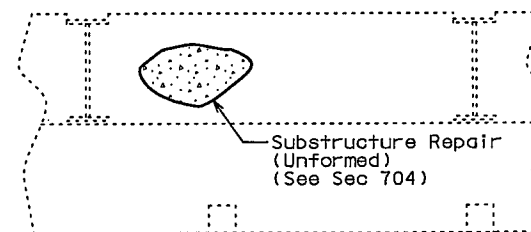

**TYPICAL ELEVATION OF
END BENTS NO. 1 & 4 SHOWING
SUBSTRUCTURE REPAIR**

**REPAIRS TO BRIDGE: RTE. I-70 WBL
OVER STERLING AVENUE**

STATE ROAD FROM RTE. I-435 TO RTE. I-470

ABOUT 2.1 MILES EAST OF RTE. I-435

STA. 451+19.00± (Match Exist.)

Detailed July 2010
Checked Sep. 2010

Note: This drawing is not to scale. Follow dimensions.

Sheet No. 1 of 1

V:\Contract Information Archive\004\4CD\110218-402\As Built Final Plans\J411790B-Bridges\L09723\B-L09723_001_J411790B_fronsheet.dgn 10:30:40 AM 6/12/2012

"THIS MEDIA SHOULD
NOT BE CONSIDERED
A CERTIFIED
DOCUMENT."

DATE PREPARED
6/12/2012
ROUTE **I-70** STATE **MO**
DISTRICT **KC** SHEET NO. **1**
COUNTY **JACKSON**
JOB NO. **J411790B**
CONTRACT ID. **110218-402**
PROJECT NO. **I-70-1 (192)**
BRIDGE NO. **L09723**

DESCRIPTION

DATE

MISSOURI HIGHWAYS AND TRANSPORTATION
COMMISSION

MoDOT
105 WEST CAPITOL
JEFFERSON CITY, MO 65102
1-888-ASK-MODOT (1-888-275-6636)

IF A SEAL IS PRESENT ON THIS SHEET IT HAS BEEN ELECTRONICALLY SEALED AND DATED.